

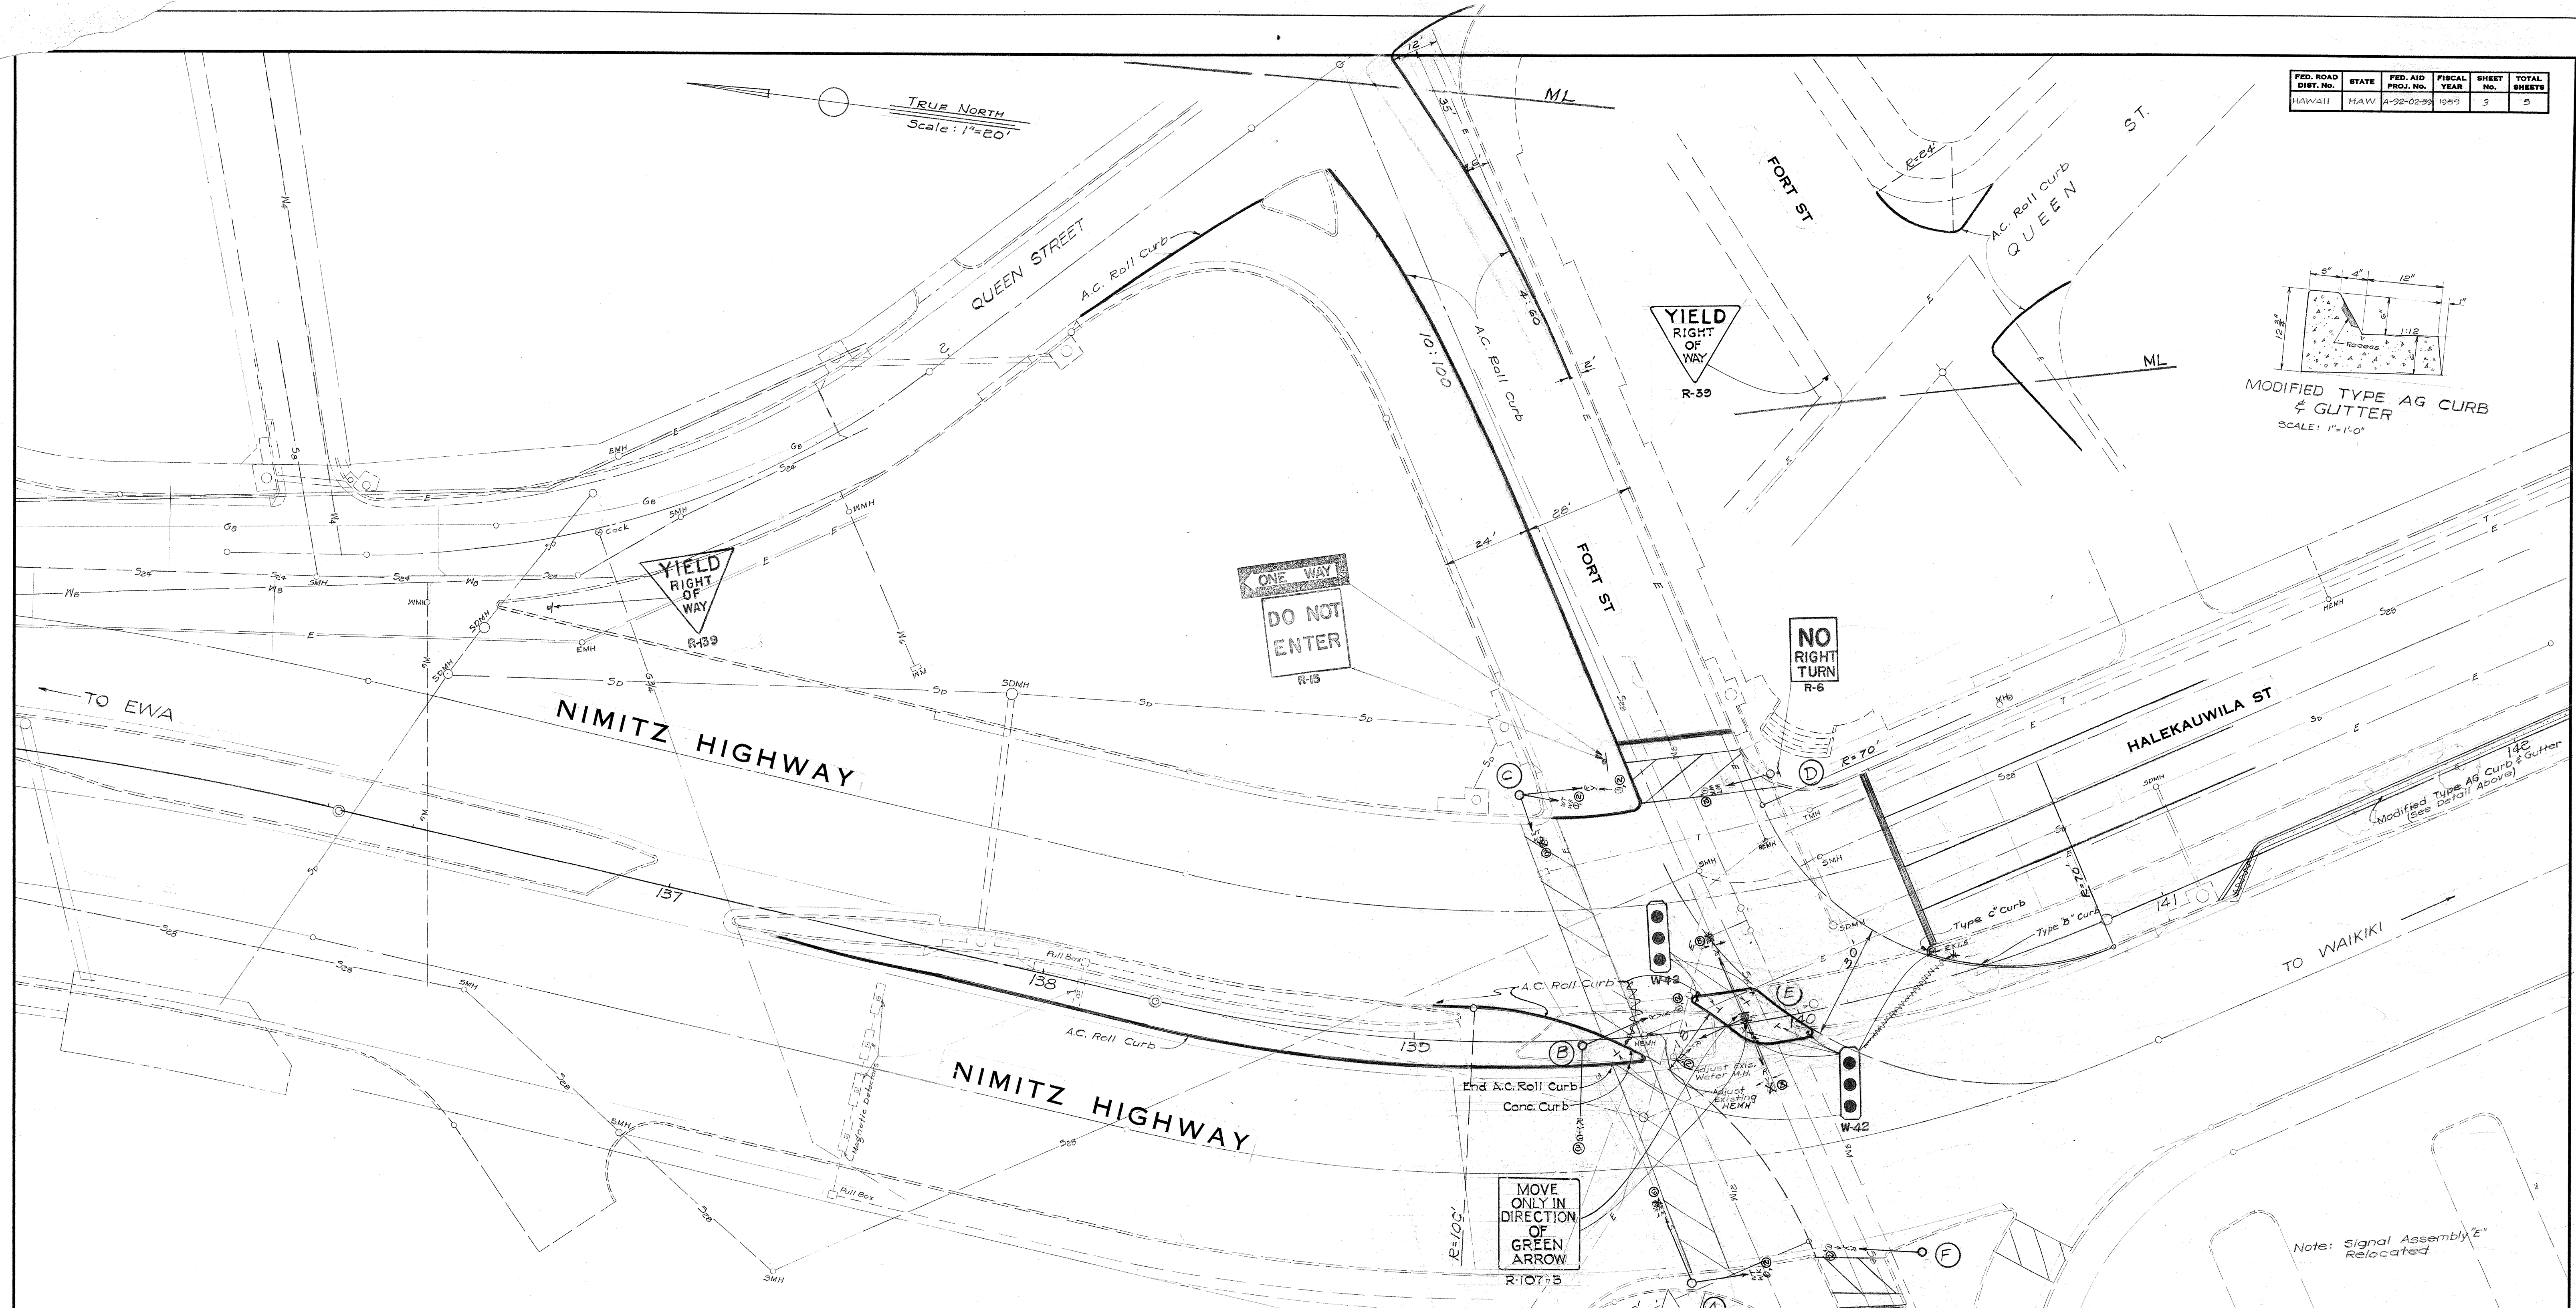


FED. ROAD DIST. NO.	STATE	FED. AID PROJ. NO.	FISCAL YEAR	SHEET NO.	TOTAL SHEETS
HAWAII	HAW	A-92-02-59	1959	3	5

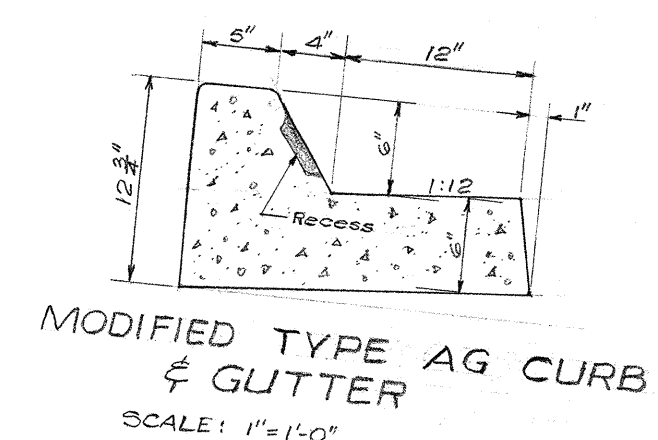

ORIGINAL PLAN No.	DATE	SURVEY PLOTTED BY
		DESIGNED BY
NOTE BOOK No.		TRACED BY
		QUANTITIES CHECKED BY

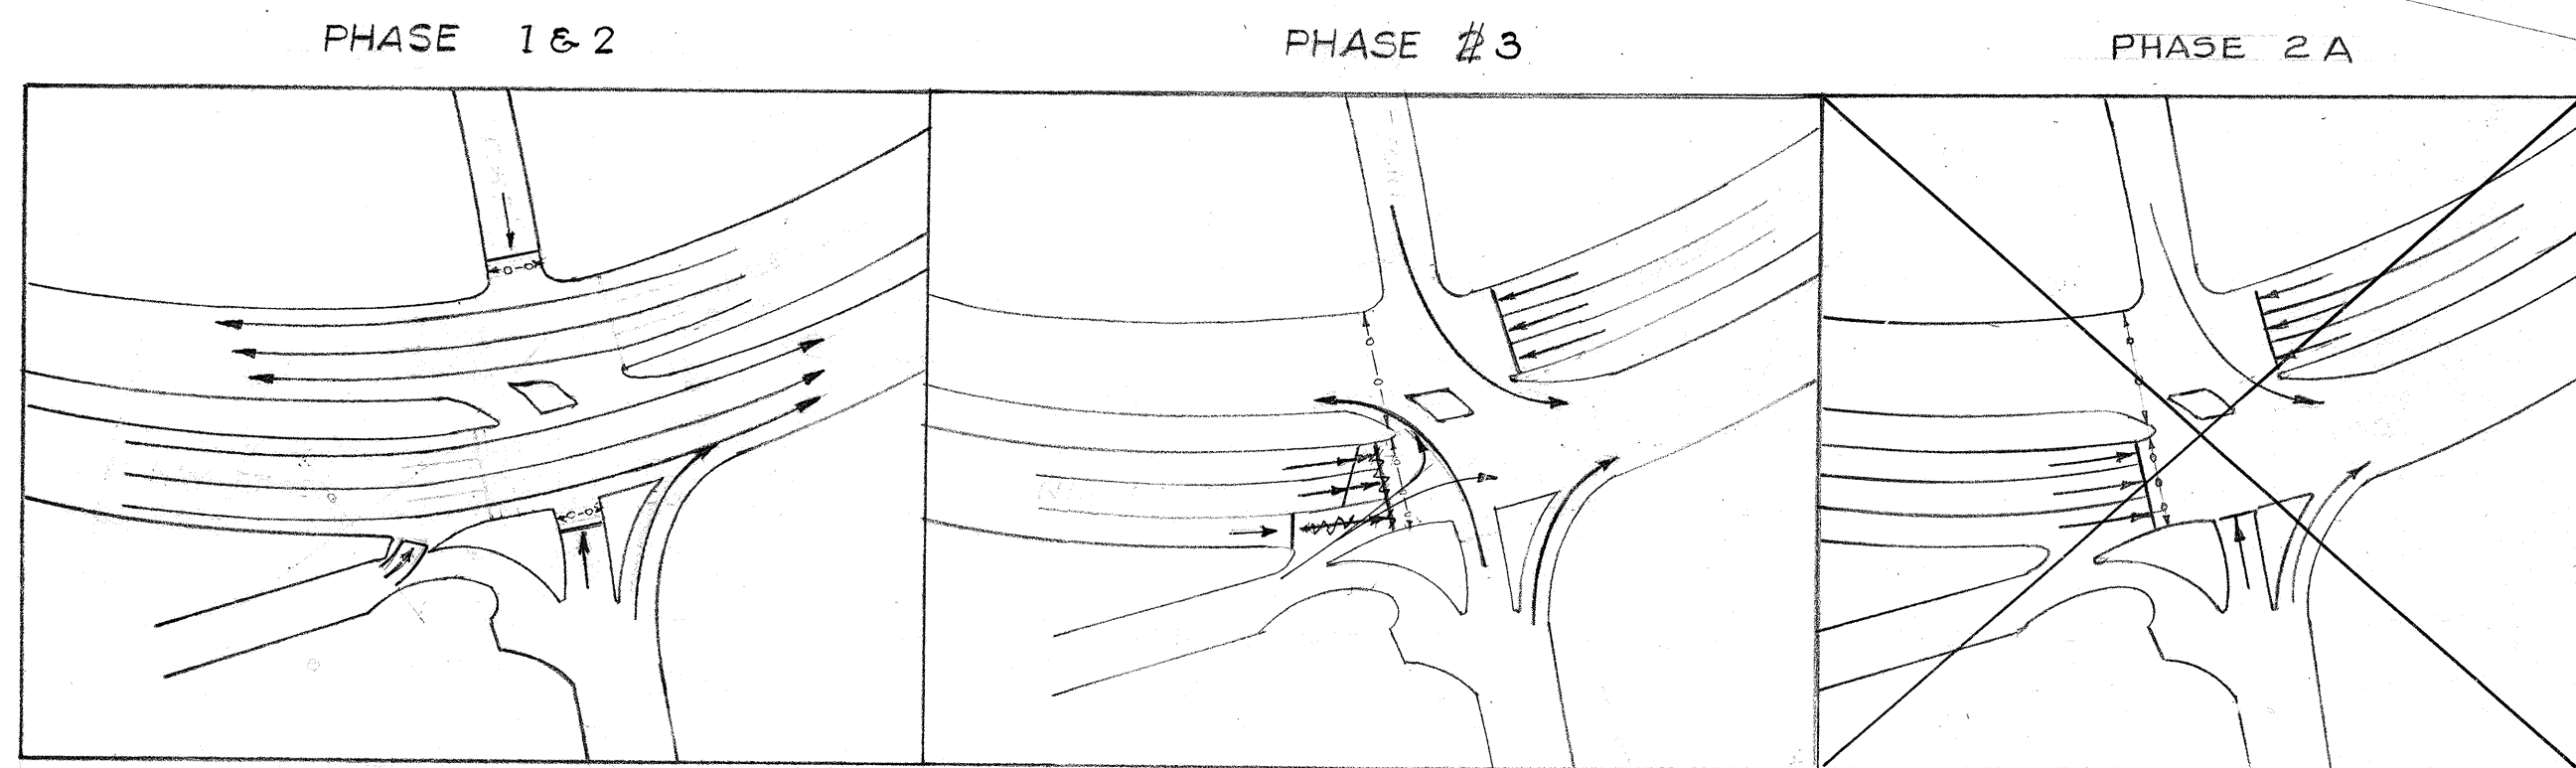

PHASE DIAGRAMS

Changes Approved : *Frank R. Carlson*
Division Engineer
Bureau of Public Roads
Date: Sept. 15, 1959

HAWAII STATE HIGHWAY DEPARTMENT
STATE OF HAWAII

MODIFICATION OF
NIMITZ HIGHWAY
RIVER ST. TO RICHARDS ST.
PROJ. NO. A-92-02-59

SCALE: AS SHOWN SEPT. 1959

SHEET NO. 3 OF 5 SHEETS

