


FED. ROAD DIST. NO.	STATE	FED. AID PROJ. NO.	FISCAL YEAR	SHEET NO.	TOTAL SHEETS
HAWAII	HAW.				

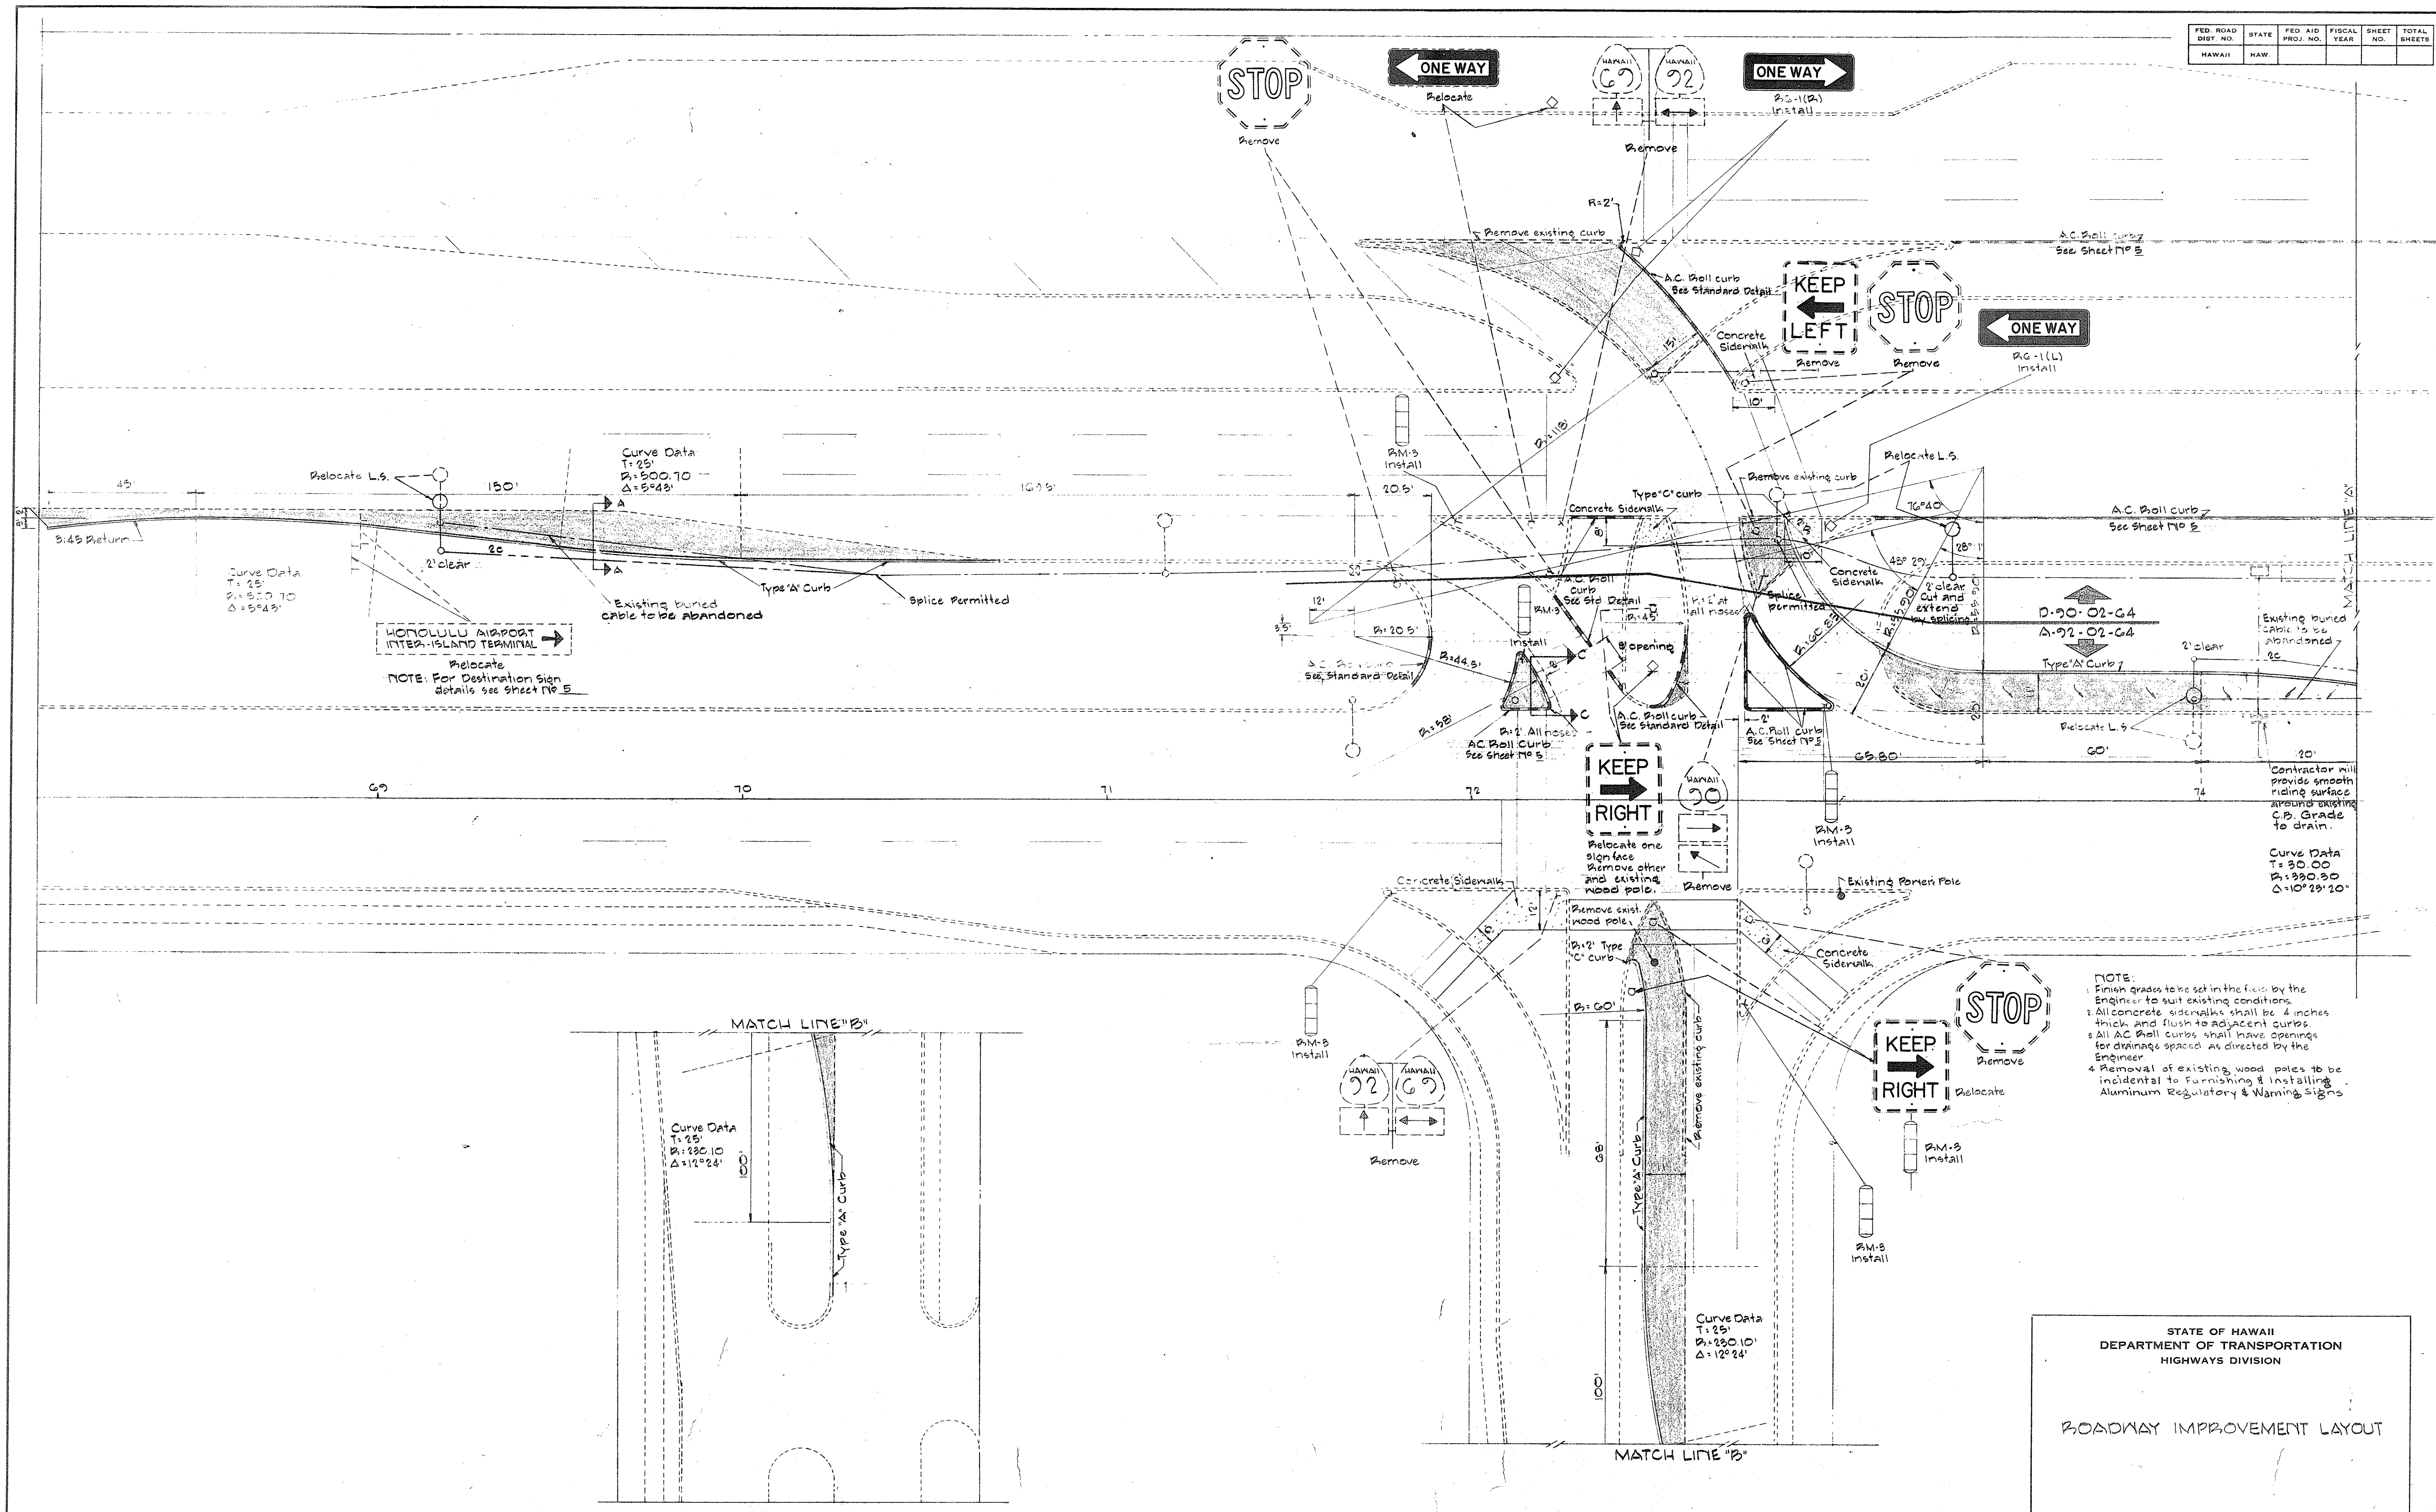

STATE OF HAWAII
DEPARTMENT OF TRANSPORTATION
HIGHWAYS DIVISION

ROADWAY IMPROVEMENT LAYOUT

SHEET No. OF SHEETS

A-92-02-64, D-90-02-64(4)

ORIGINAL PLAN	SURVEY PLOTTED BY _____ DATE _____ DRAWN BY _____ TRACED BY _____ DESIGNED BY _____ QUANTITIES BY _____ CHECKED BY _____	41 42 43 851 85
------------------	---	--

ORIGINAL PLAN	SURVEY PLOTTED BY	DATE
NOTE BOOK	DRAWN BY	BY
	DESIGNED BY	BY
	QUANTITIES BY	BY
	Checked by	BY
No.		

Roadway Excavation	388 cy.
Select Borrow	350 tons
Untreated Base	237 tons
Asphalt Concrete Mix III	64 tons
Asphalt Concrete Mix V	31 tons
Type 'A' Curb	265 L.F.
Type 'C' Curb	6 L.F.
Asphaltic Concrete Traffic Roll	13 tons
Highway Lights	Lump Sum
Traffic Signal System	Lump Sum

Curve Data
T = 25'
R = 230.10
 $\Delta = 120^\circ 24'$

Curve Data
T = 25'
R = 230.10'
 $\Delta = 120^\circ 24'$

NOTE:
Finish grades to be set in the field by the Engineer to suit existing conditions.

- 2 All AC & Roll curbs shall have openings for drainage spaced as directed by the Engineer.
- 3 Removal of existing wood poles to be incidental to furnishing & installing Aluminum Regulatory & Warning Signs & All Regulatory and Warning Signs, Route marker assemblies, Reflector markers and Destination signs shall be installed, relocated, or removed by others.

REVISED: MAY 1964

NOTE:
This sheet supersedes sheet #4




STATE OF HAWAII
DEPARTMENT OF TRANSPORTATION
HIGHWAYS DIVISION

ROADWAY IMPROVEMENT LAYOUT

SHEET No. OF SHEETS

A-92-02-64, D-90-02-64 (4)

FED. ROAD DIST. NO.	STATE	FED. AID PROJ. NO.	FISCAL YEAR	SHEET NO.	TOTAL SHEETS
HAWAII	HAW.				

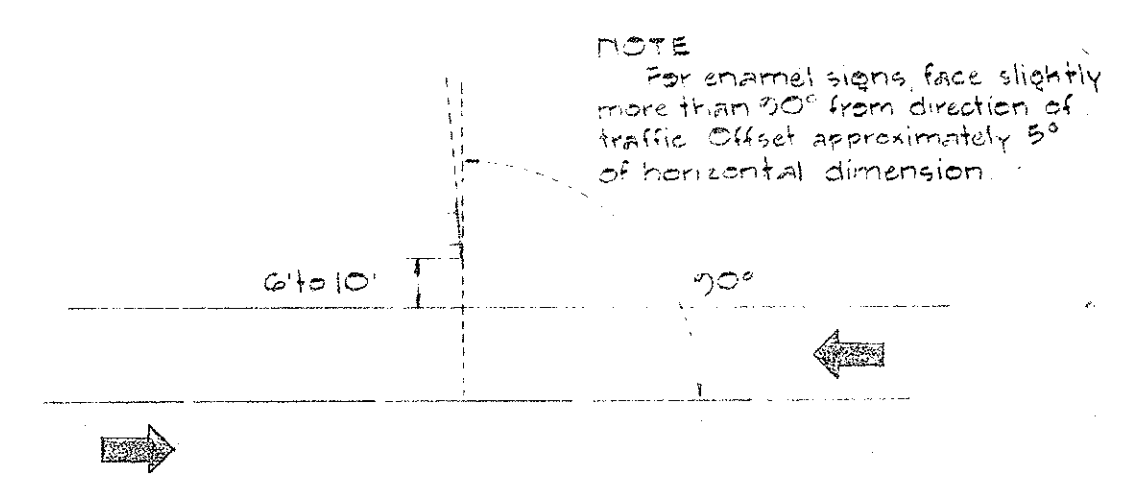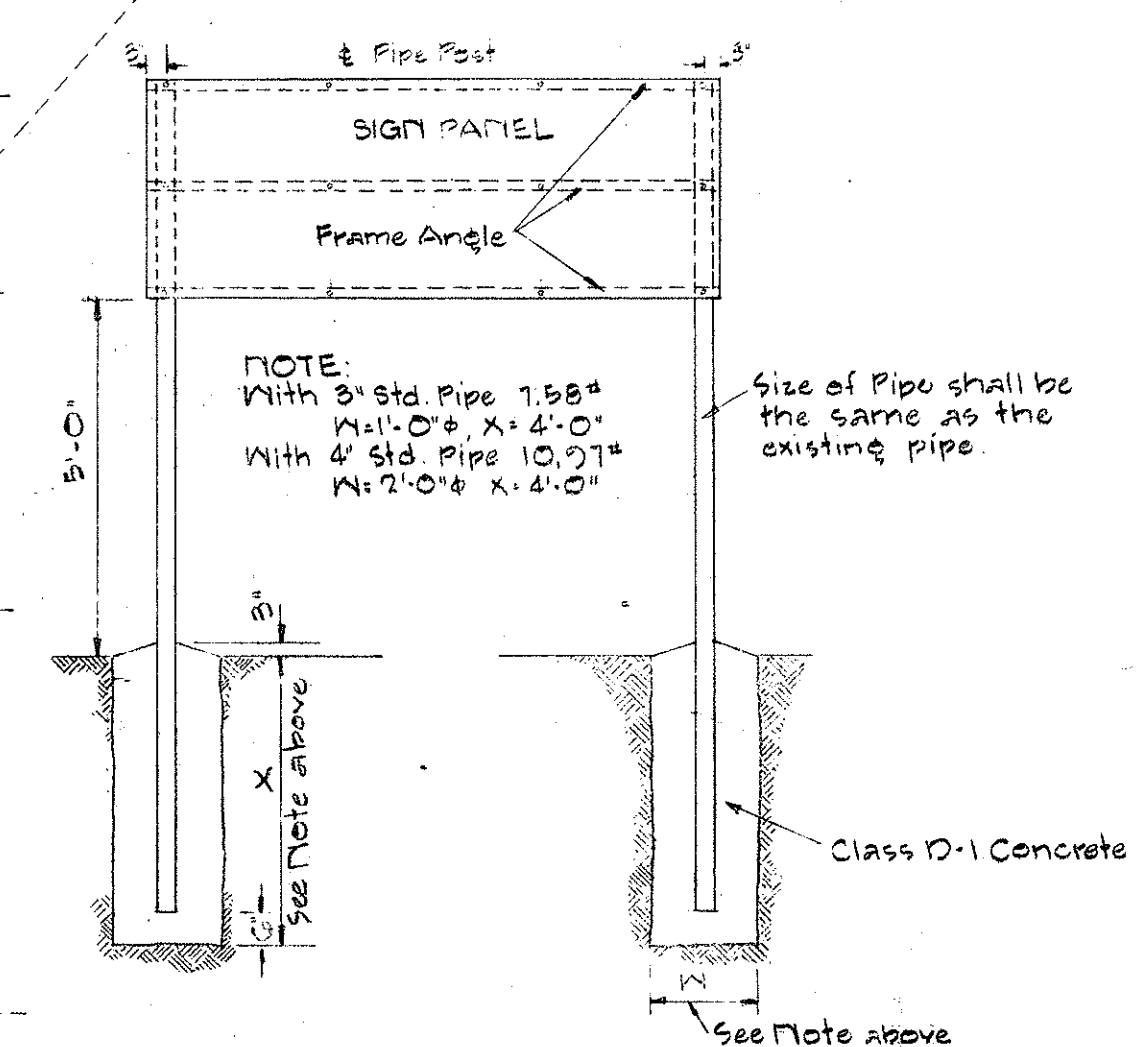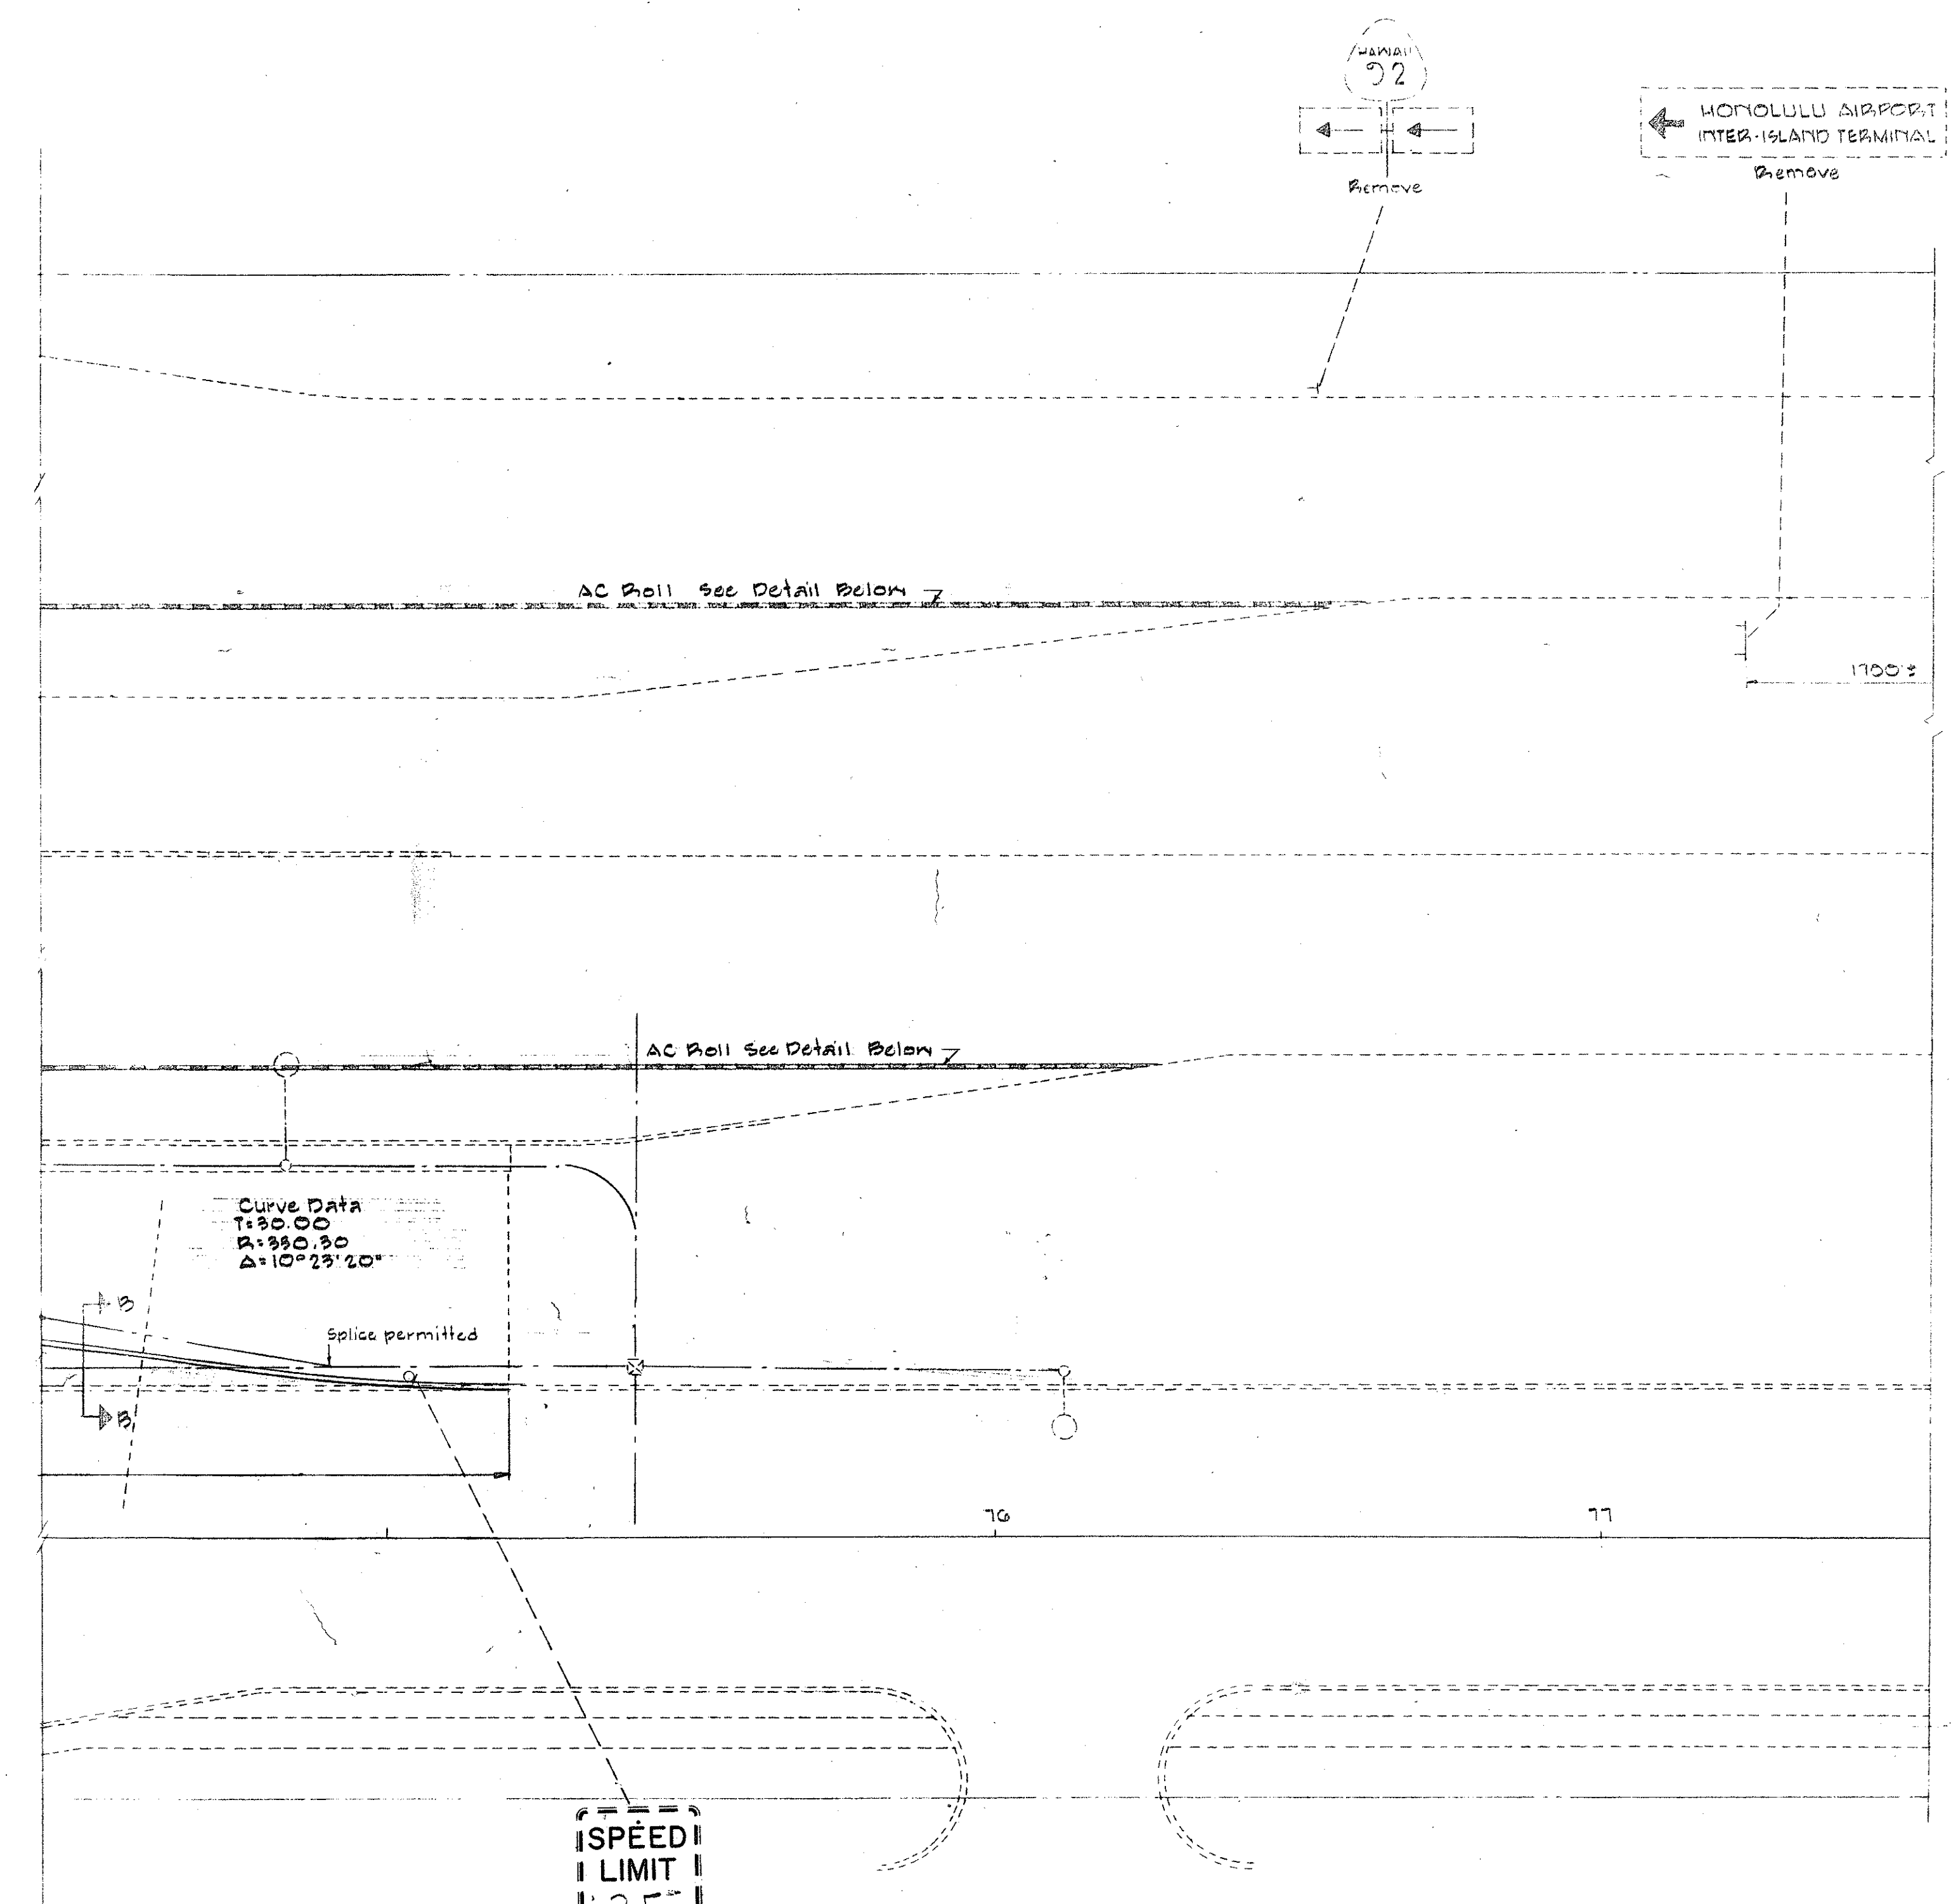

DESTINATION SIGNS ELEVATION



DESTINATION SIGN DETAILS NOT TO SCALE

GENERAL NOTES:


1. Location of existing underground structures such as culverts, pipelines, conduits, cables etc. shown on the plans are approximate only, other existing utilities may not be shown. The Contractor shall check and verify the location of same.
2. The exact location of traffic signal standards, light standards, pullboxes, conduits, controller base and detectors shall be determined in the field by the project engineer.
3. Pavement markings by others.

LEGEND


- ① 20' 12" Lens Assembly & Mast Arm Standard (Length and size as indicated)
- ② 12" Lens Assembly & Standard
- ③ 8" Lens Assembly & Standard
- ④ Vehicular detector (Type as indicated)
- ⑤ Type "A" Pullbox
- ⑥ Type "C" Pullbox
- ⑦ Existing Pullbox
- ⑧ Controller
- ⑨ 1.5" Steel or Polyvinyl Chloride Conduit (No & Size as indicated)
- ⑩ 2.0" Cement Asbestos Conduit (No & Size as indicated)
- ⑪ 1.5" Steel Conduit for power cable
- ⑫ 2.0" Flex directly buried cable (2c indicates 2 cables)
- ⑬ Existing directly buried cable
- ⑭ Sign mounted on highway lighting standard, traffic signal standard or utility pole
- ⑮ Reflector or route markers on galvanized channel
- ⑯ Sign mounted on galvanized iron pipe
- ⑰ Destination sign
- ⑱ Flex Asphalt Concrete Pavement

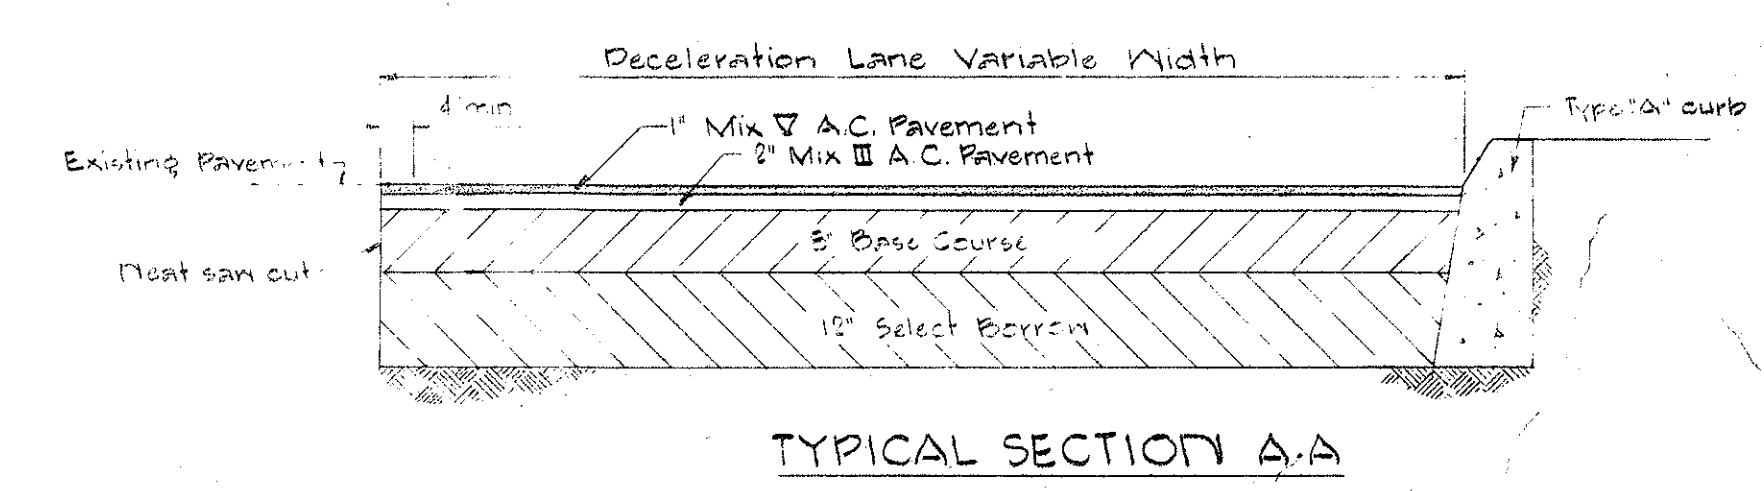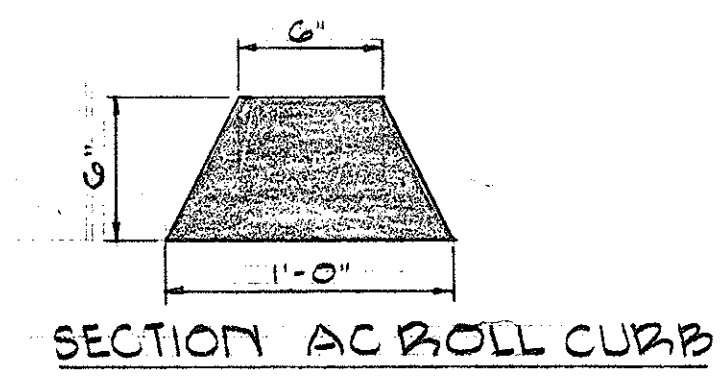

TYPICAL SECTION A-A

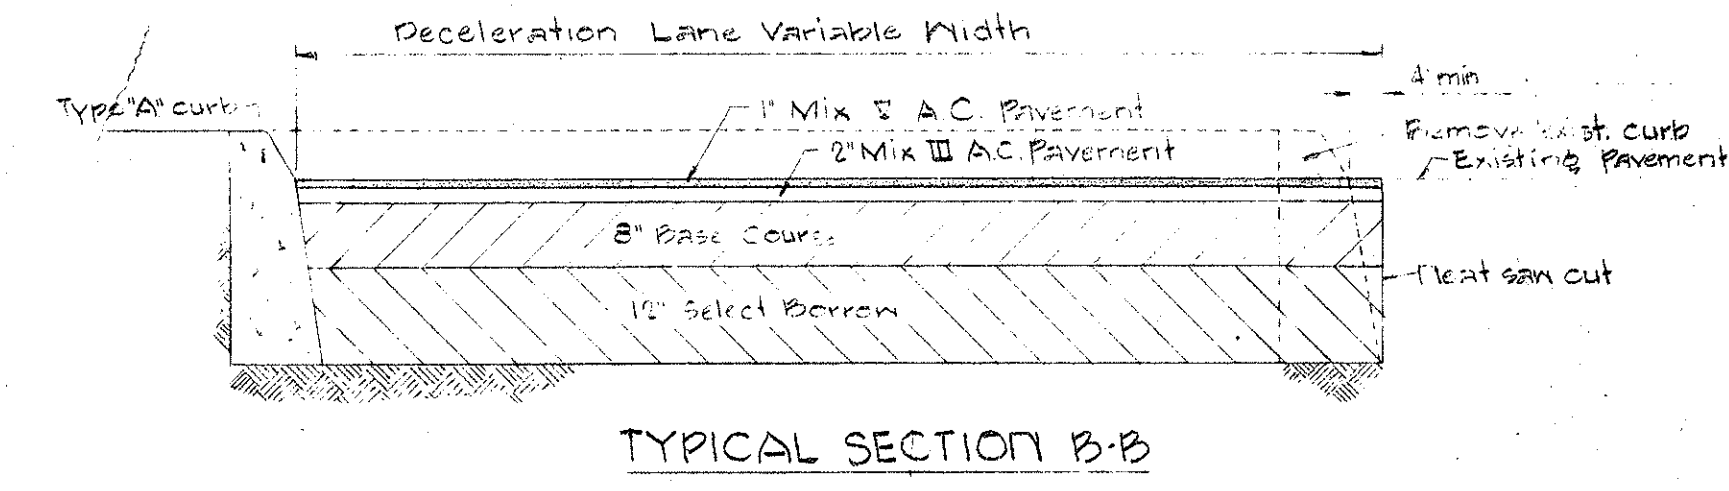

TYPICAL SECTION B-B

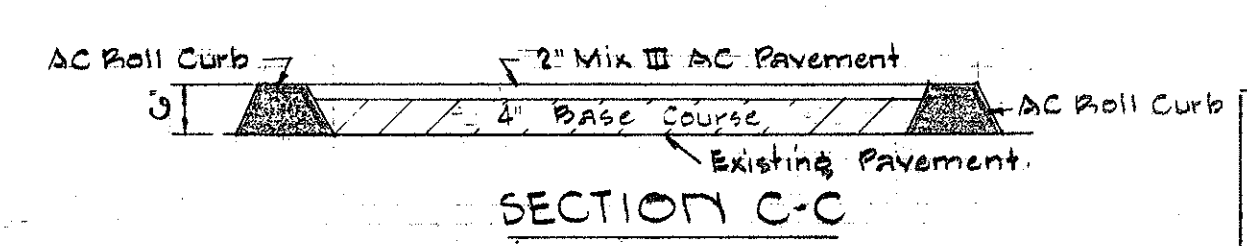




SECTION C-C

STATE OF HAWAII
DEPARTMENT OF TRANSPORTATION
HIGHWAYS DIVISION

ROADWAY IMPROVEMENT LAYOUT
TYPICAL SECTIONS
DESTINATION SIGN DETAIL

DESIGNED BY	DATE
DRAWN BY	
CHECKED BY	
NOTED BY	
NO.	

FED. ROAD DIST. NO.	STATE	FED. AID PROJ. NO.	FISCAL YEAR	SHEET NO.	TOTAL SHEETS
HAWAII	HAW.				

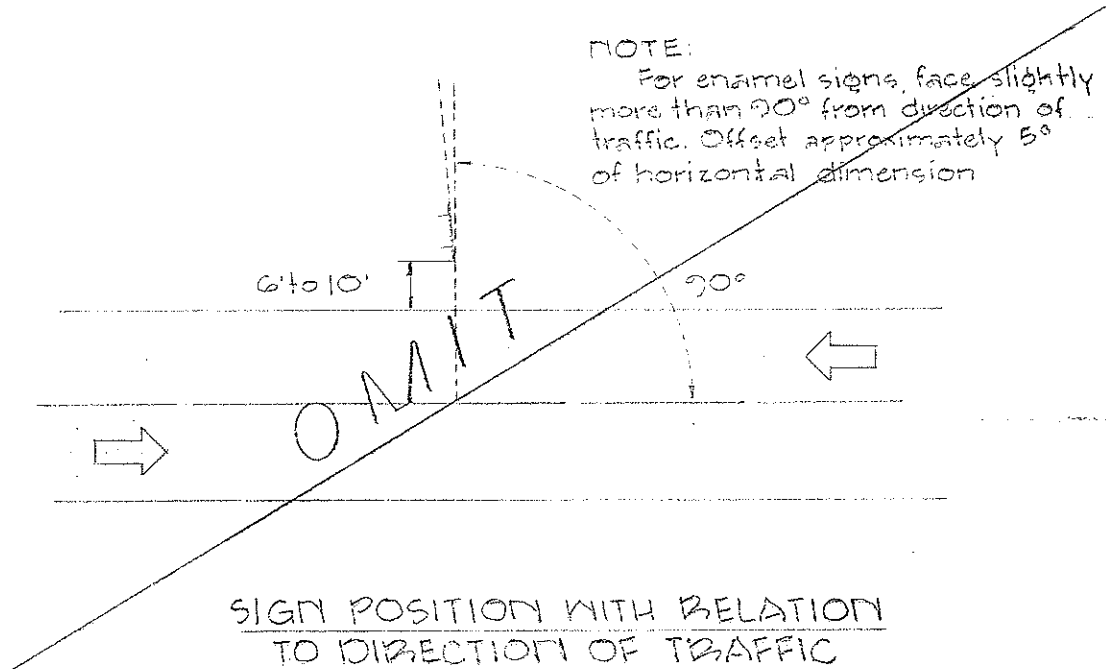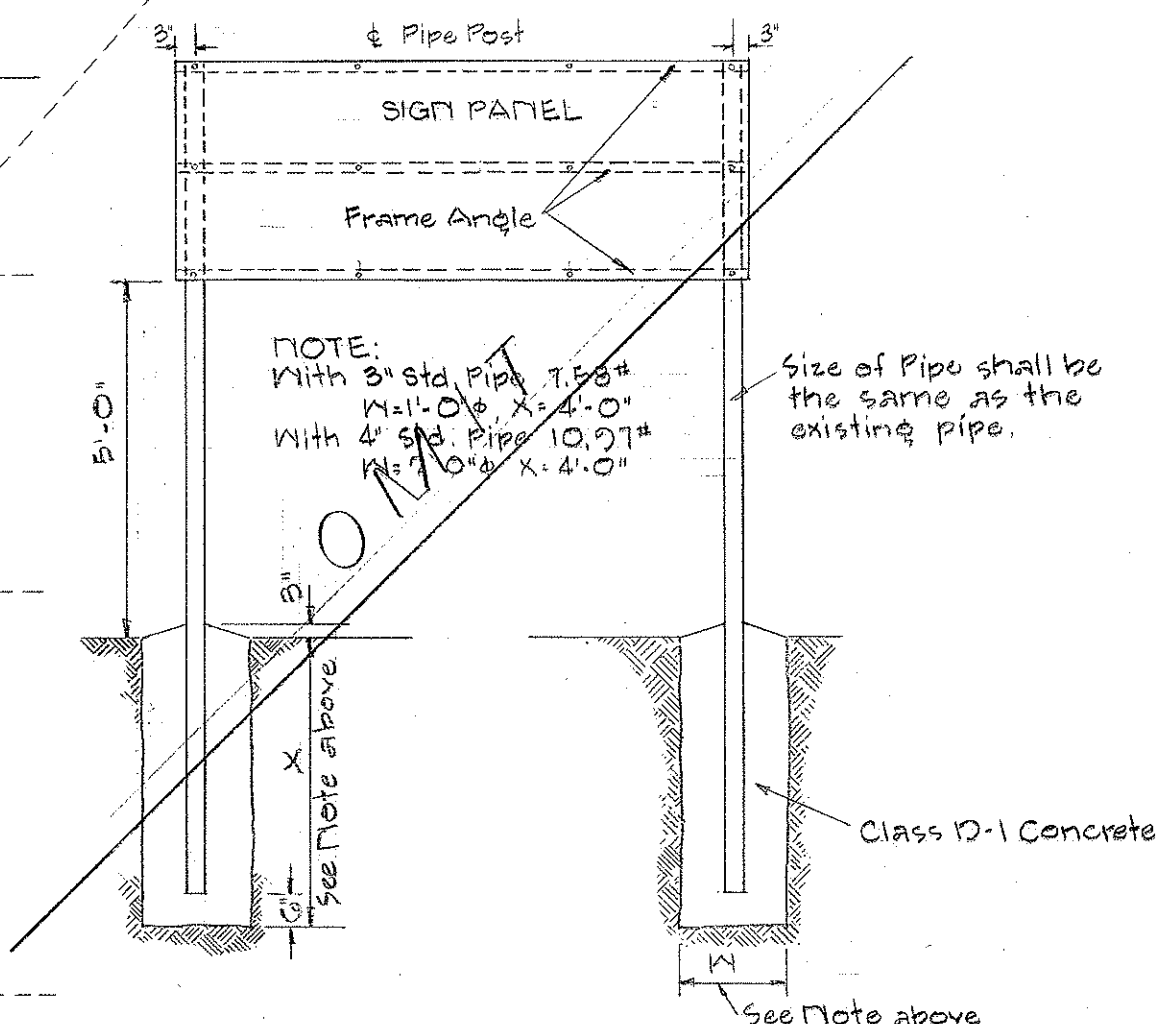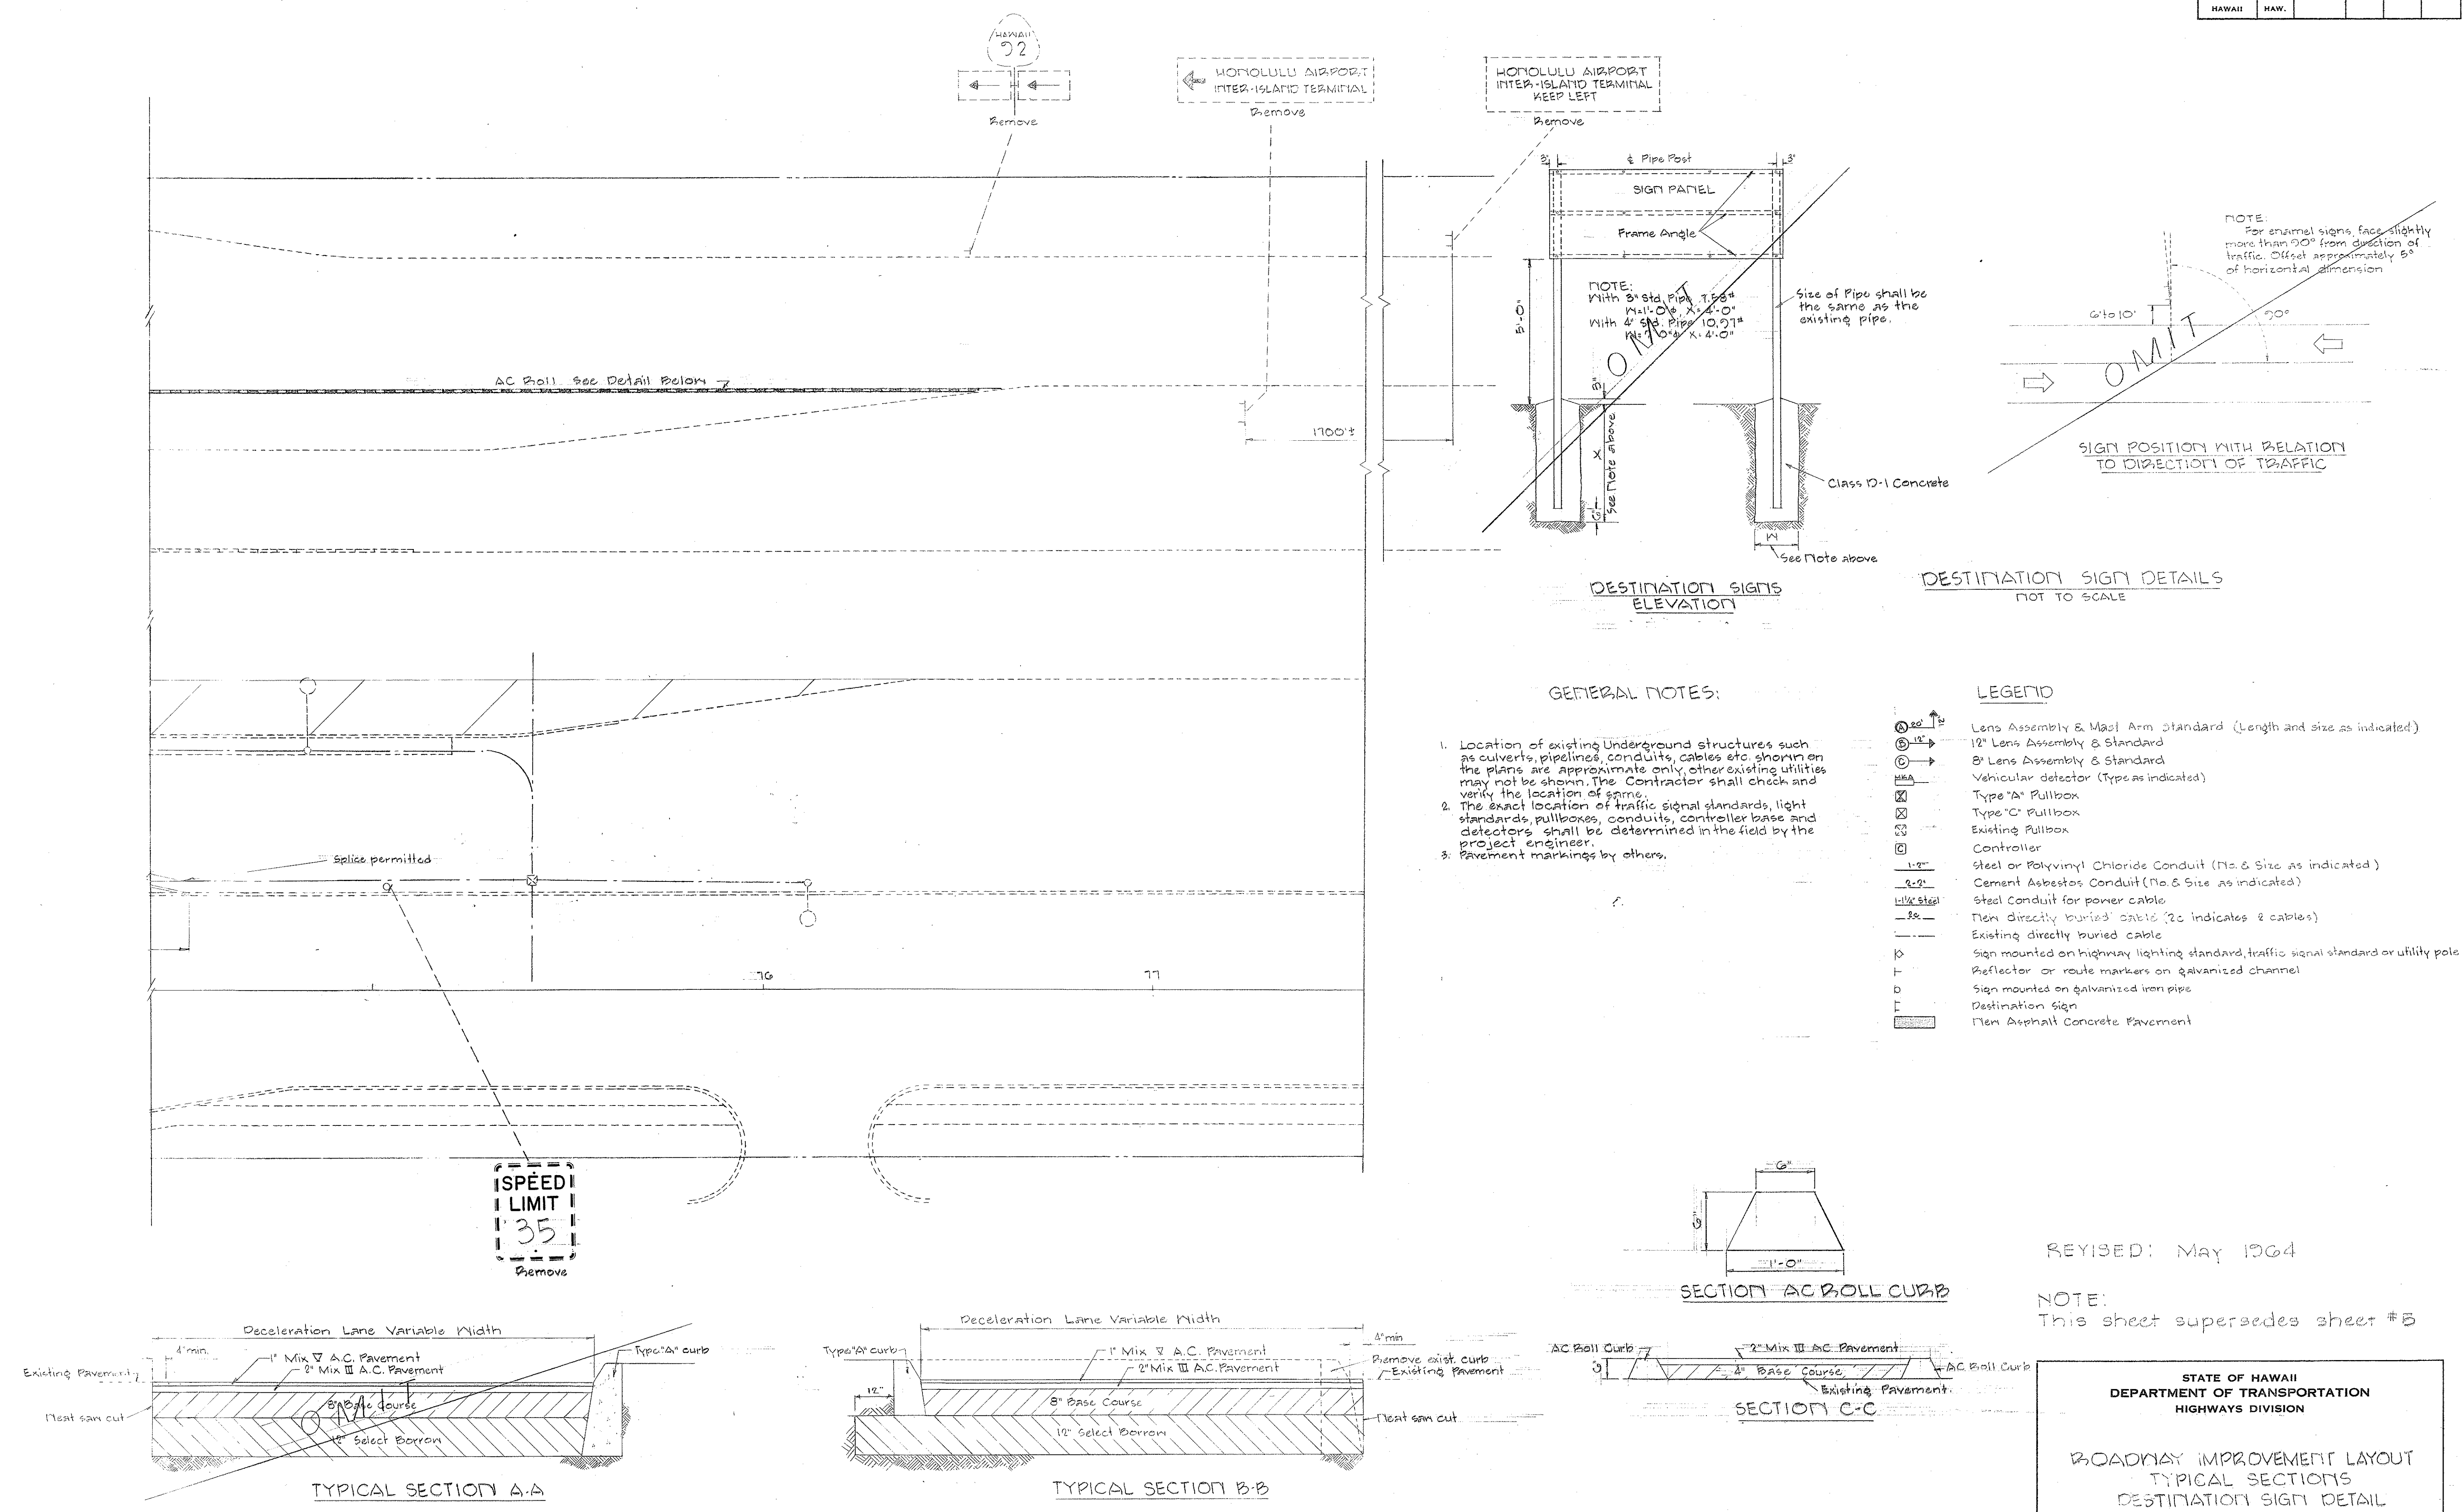

DESTINATION SIGNS ELEVATION


DESTINATION SIGN DETAILS NOT TO SCALE

GENERAL NOTES:


1. Location of existing Underground structures such as culverts, pipelines, conduits, cables etc. shown on the plans are approximate only, other existing utilities may not be shown. The Contractor shall check and verify the location of same.
2. The exact location of traffic signal standards, light standards, pullboxes, conduits, controller base and detectors shall be determined in the field by the project engineer.
3. Pavement markings by others.

LEGEND


- ① 20' Lens Assembly & Mast Arm Standard (Length and size as indicated)
- ② 12' Lens Assembly & Standard
- ③ 8' Lens Assembly & Standard
- VEH Vehicular detector (Type as indicated)
- ⊗ Type "A" Pullbox
- ⊗ Type "C" Pullbox
- ⊗ Existing Pullbox
- ⊗ Controller
- 1-2" Steel or Polyvinyl Chloride Conduit (No. & Size as indicated)
- 2-2" Cement Asbestos Conduit (No. & Size as indicated)
- 1 1/2" Steel Conduit for power cable
- 2c Trench directly buried cable (2c indicates 2 cables)
- Existing directly buried cable
- ⊗ Sign mounted on highway lighting standard, traffic signal standard or utility pole
- ⊗ Reflector or route markers on galvanized channel
- ⊗ Sign mounted on galvanized iron pipe
- ⊗ Destination Sign
- ⊗ New Asphalt Concrete Pavement

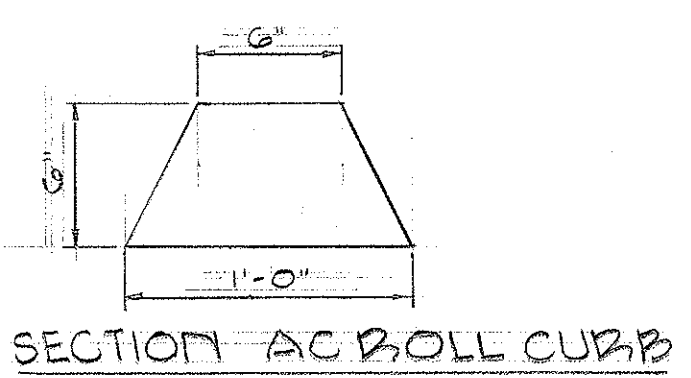


SECTION AC ROLL CURB

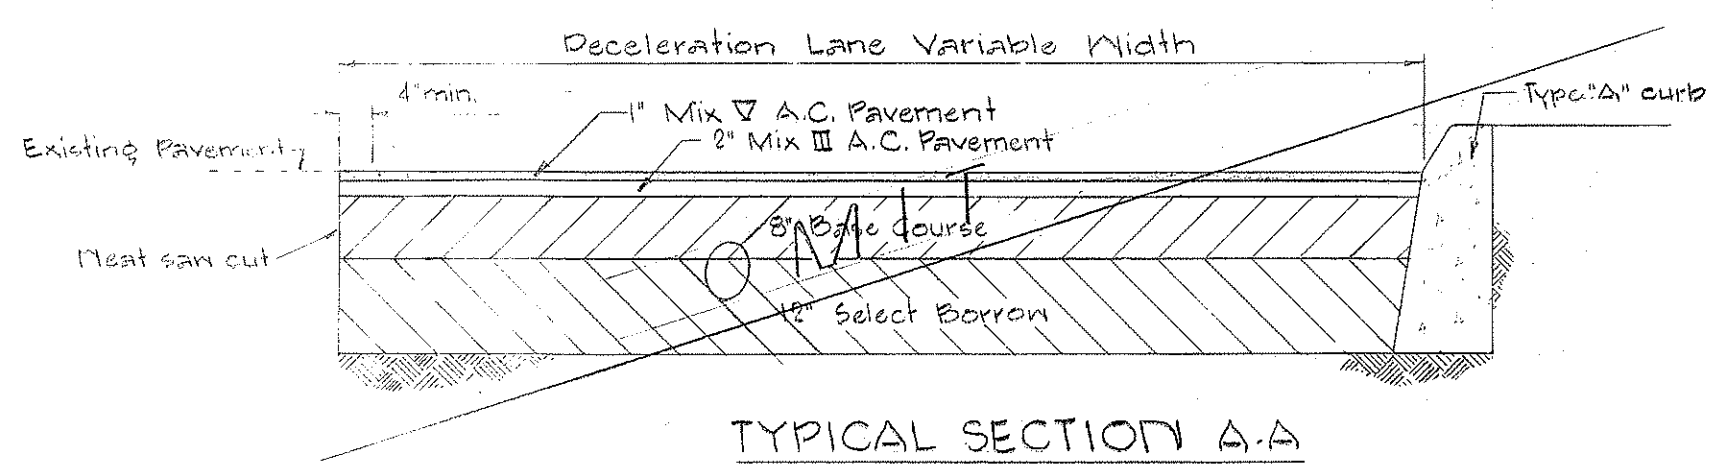

TYPICAL SECTION A-A

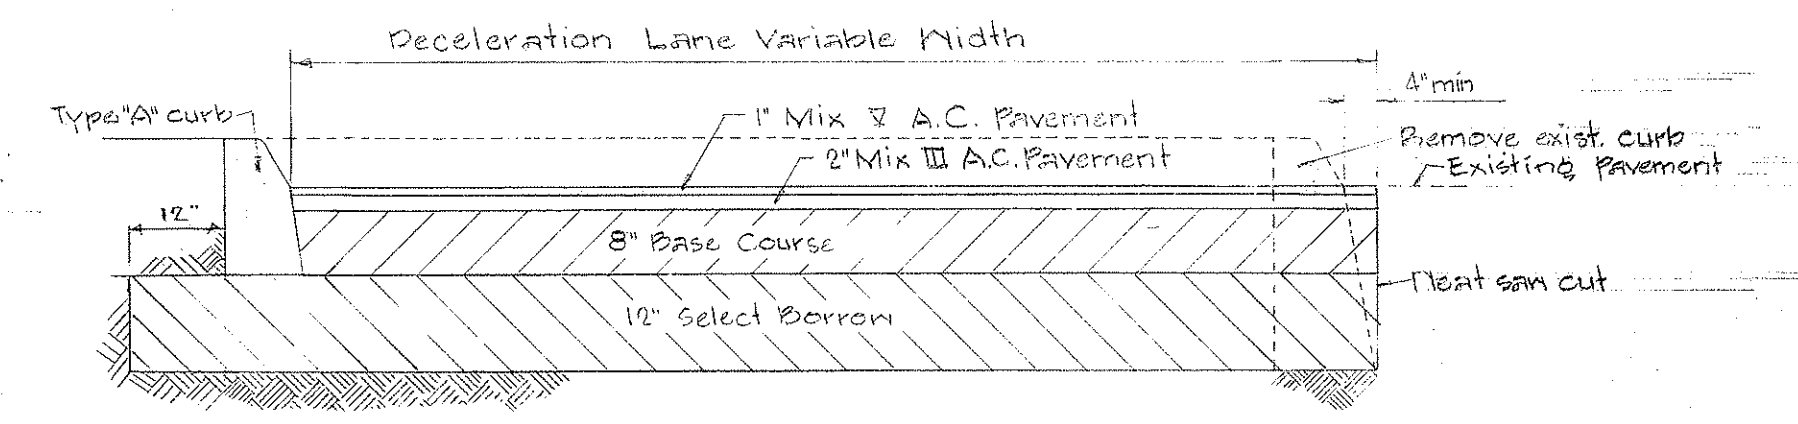

TYPICAL SECTION B-B

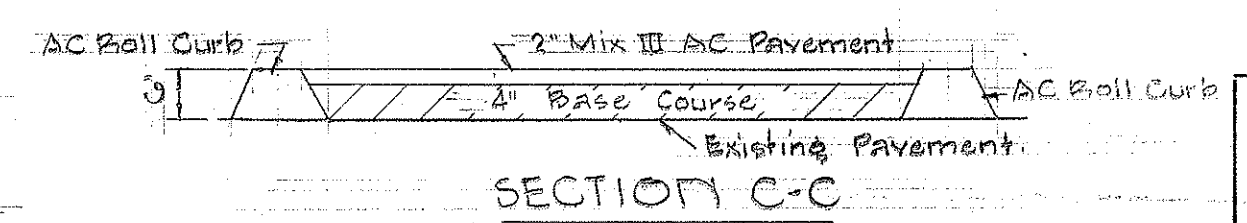

SECTION C-C

REVISED: MAY 1964

NOTE: This sheet supersedes sheet #5

STATE OF HAWAII
DEPARTMENT OF TRANSPORTATION
HIGHWAYS DIVISION

ROADWAY IMPROVEMENT LAYOUT
TYPICAL SECTIONS
DESTINATION SIGN DETAIL

SHEET No. OF SHEETS

SURVEY PLOTTED BY	DATE
DRAWN BY	
TRACED BY	
ENGINEER	
CHECKED BY	
NOTE BOOK	
No.	