

ORIGINAL PLAN	SURVEY PLOTTED BY _____		DATE _____	
	DRAWN BY _____		_____	
NOTE BOOK	TRACED BY _____		_____	
	DESIGNED BY _____		_____	
No. _____	QUANTITIES BY _____		_____	
	CHECKED BY _____		_____	

	1		2		3A		3B		2	3B	FL
SIGNALS	R/W	Clr	R/W	Clr	R/W	Clr	R/W	Clr	Ped	Ped	
1,3,4,6,8,28	G	G	G	Y	R	R	R	R	G	R	Y
2,5,10,12,29	R	R	R	R	G	G	G	Y	R	G	R
14,23	R	R	↑	↑	↑	Y	R	R	↑	R	R
15,17	R	R	←	←	←	Y	R	R	←	R	R
16,18,21,22,25,27	↑	Y	R	R	R	R	↑	↑	R	↑	Y
7	DW	DW	DW	DW	DW	DW	DW	DW	DW	W	
9,11	W	W	W	DW	DW	DW	DW	DW	W	DW	
19,20,24,26	DW	DW	DW	DW	DW	DW	DW	DW	W	DW	
13	W	DW	DW	DW	DW	DW	W	W	DW	W	



STATE OF HAWAII
DEPARTMENT OF TRANSPORTATION
HIGHWAYS DIVISION

TRAFFIC SIGNAL SYSTEM LAYOUT

SHEET No. OF SHEETS

A-92-02-64, D-90-02-64 (2)

FED. ROAD DIST. NO.	STATE	FED. AID PROJ. NO.	FISCAL YEAR	SHEET NO.	TOTAL SHEETS
HAWAII	HAW.				

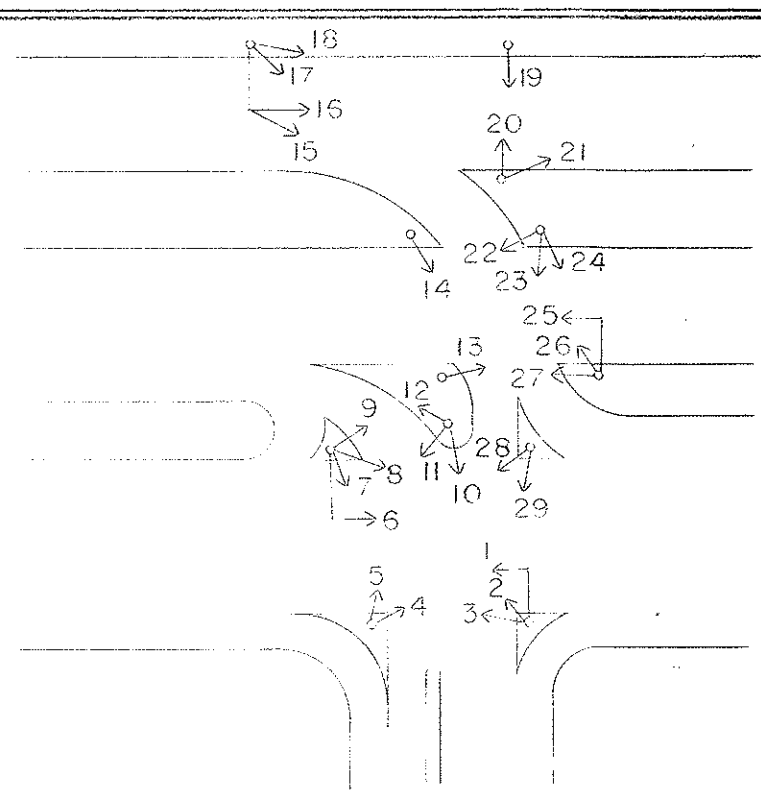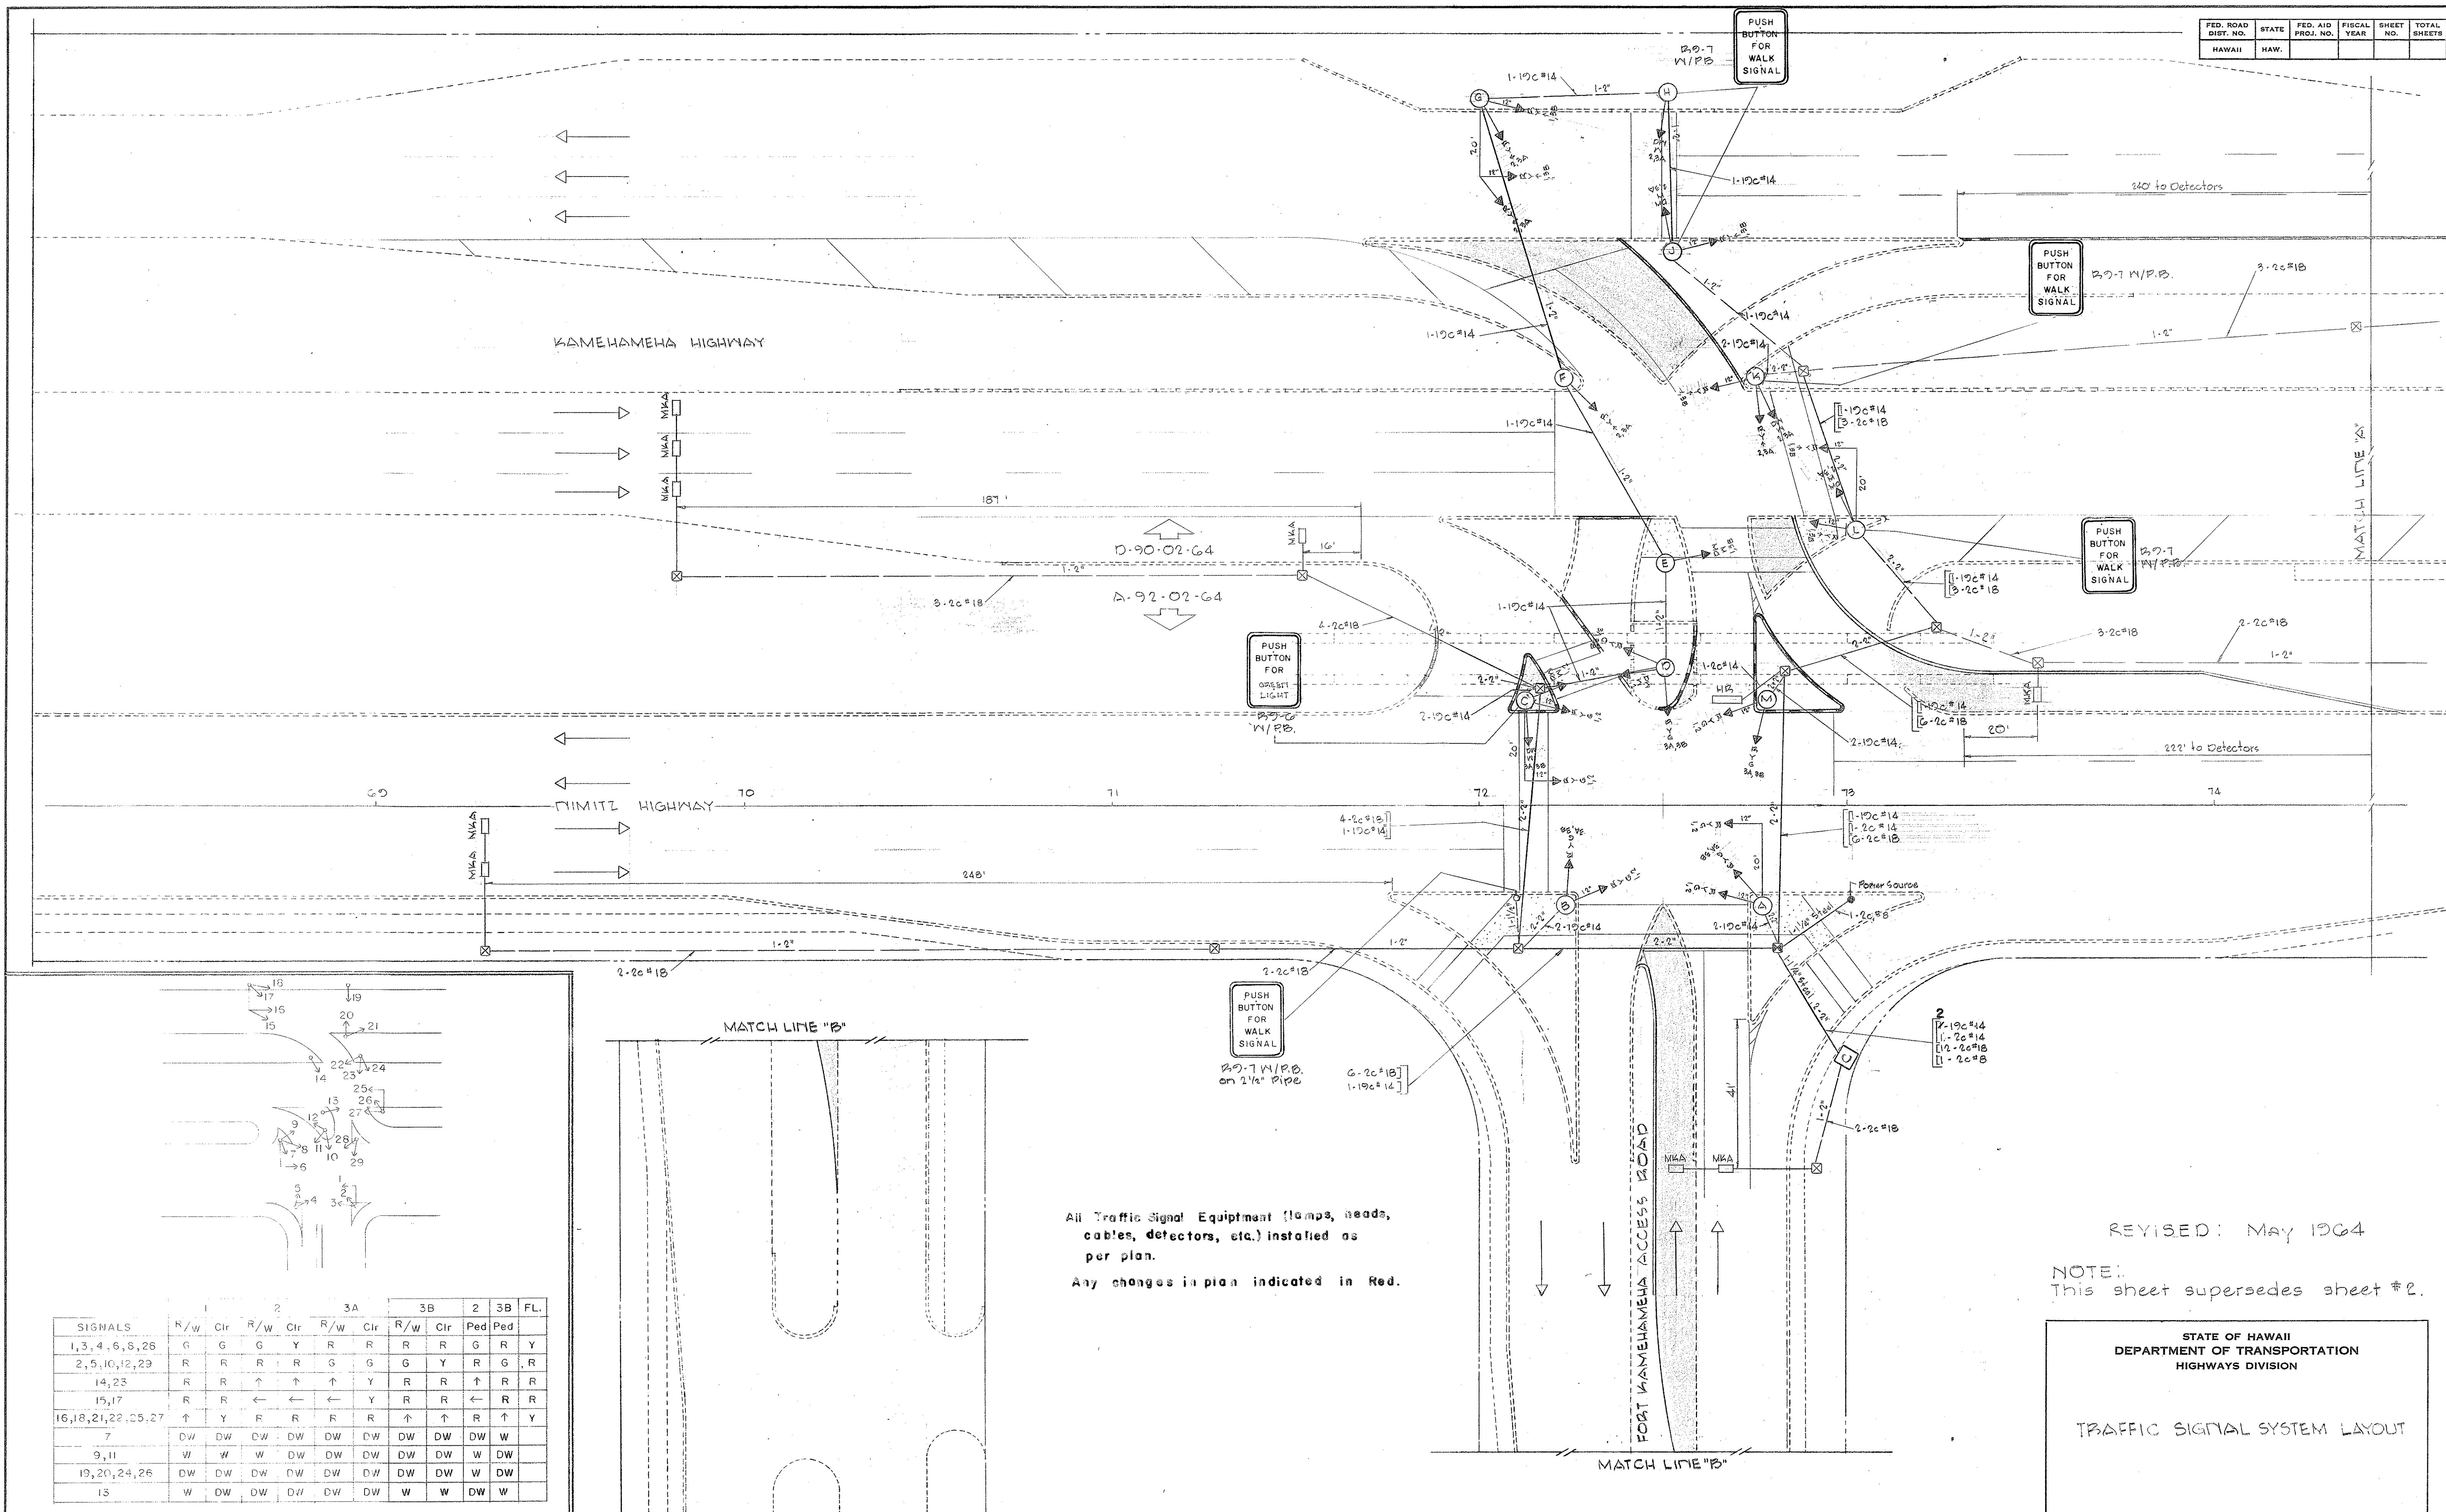

SIGNALS	1	2	3A	3B	2	3B	FL
1, 3, 4, 6, 8, 26	G	G	G	Y	R	R	R
2, 5, 10, 12, 29	R	R	R	Y	G	G	Y
14, 23	R	R	↑	↑	Y	R	↑
15, 17	R	R	←	←	Y	R	←
16, 18, 21, 22, 25, 27	↑	Y	R	R	↑	↑	Y
7	DW	DW	DW	DW	DW	DW	DW
9, 11	W	W	W	DW	DW	DW	W
19, 20, 24, 26	DW	DW	DW	DW	DW	DW	W
13	W	DW	DW	DW	W	W	DW

SIGNAL INDICATIONS

All Traffic Signal Equipment (lamps, heads, cables, detectors, etc.) installed as per plan.
Any changes in plan indicated in Red.

REVISED: MAY 1964

NOTE:
This sheet supersedes sheet #2.

STATE OF HAWAII
DEPARTMENT OF TRANSPORTATION
HIGHWAYS DIVISION



TRAFFIC SIGNAL SYSTEM LAYOUT

SHEET No. OF SHEETS


A-92-02-64, D-90-02-64(2)

Traffic Files and from Bottom


FED. ROAD DIST. NO.	STATE	FED. AID PROJ. NO.	FISCAL YEAR	SHEET NO.	TOTAL SHEETS
HAWAII	HAW.				

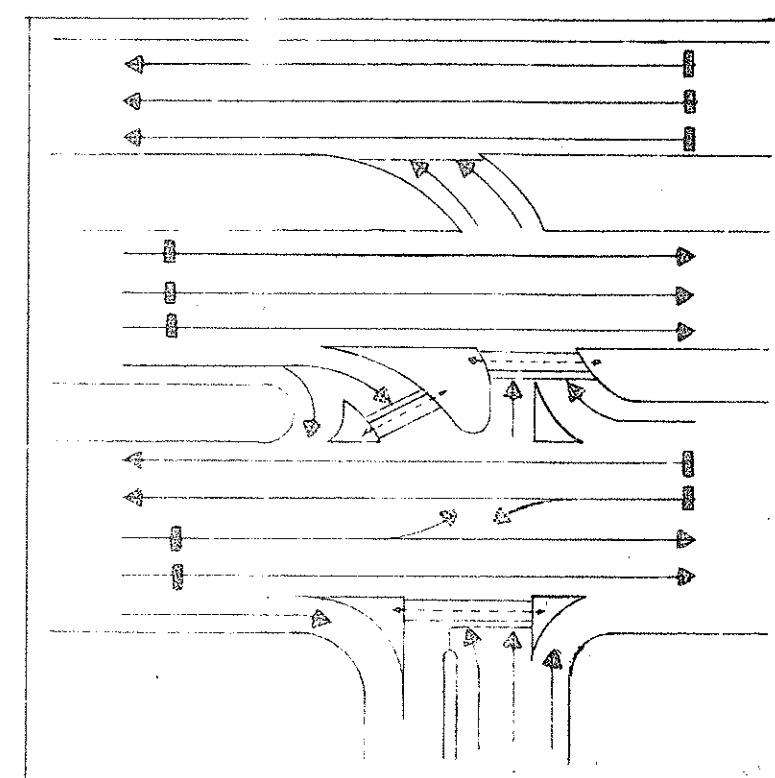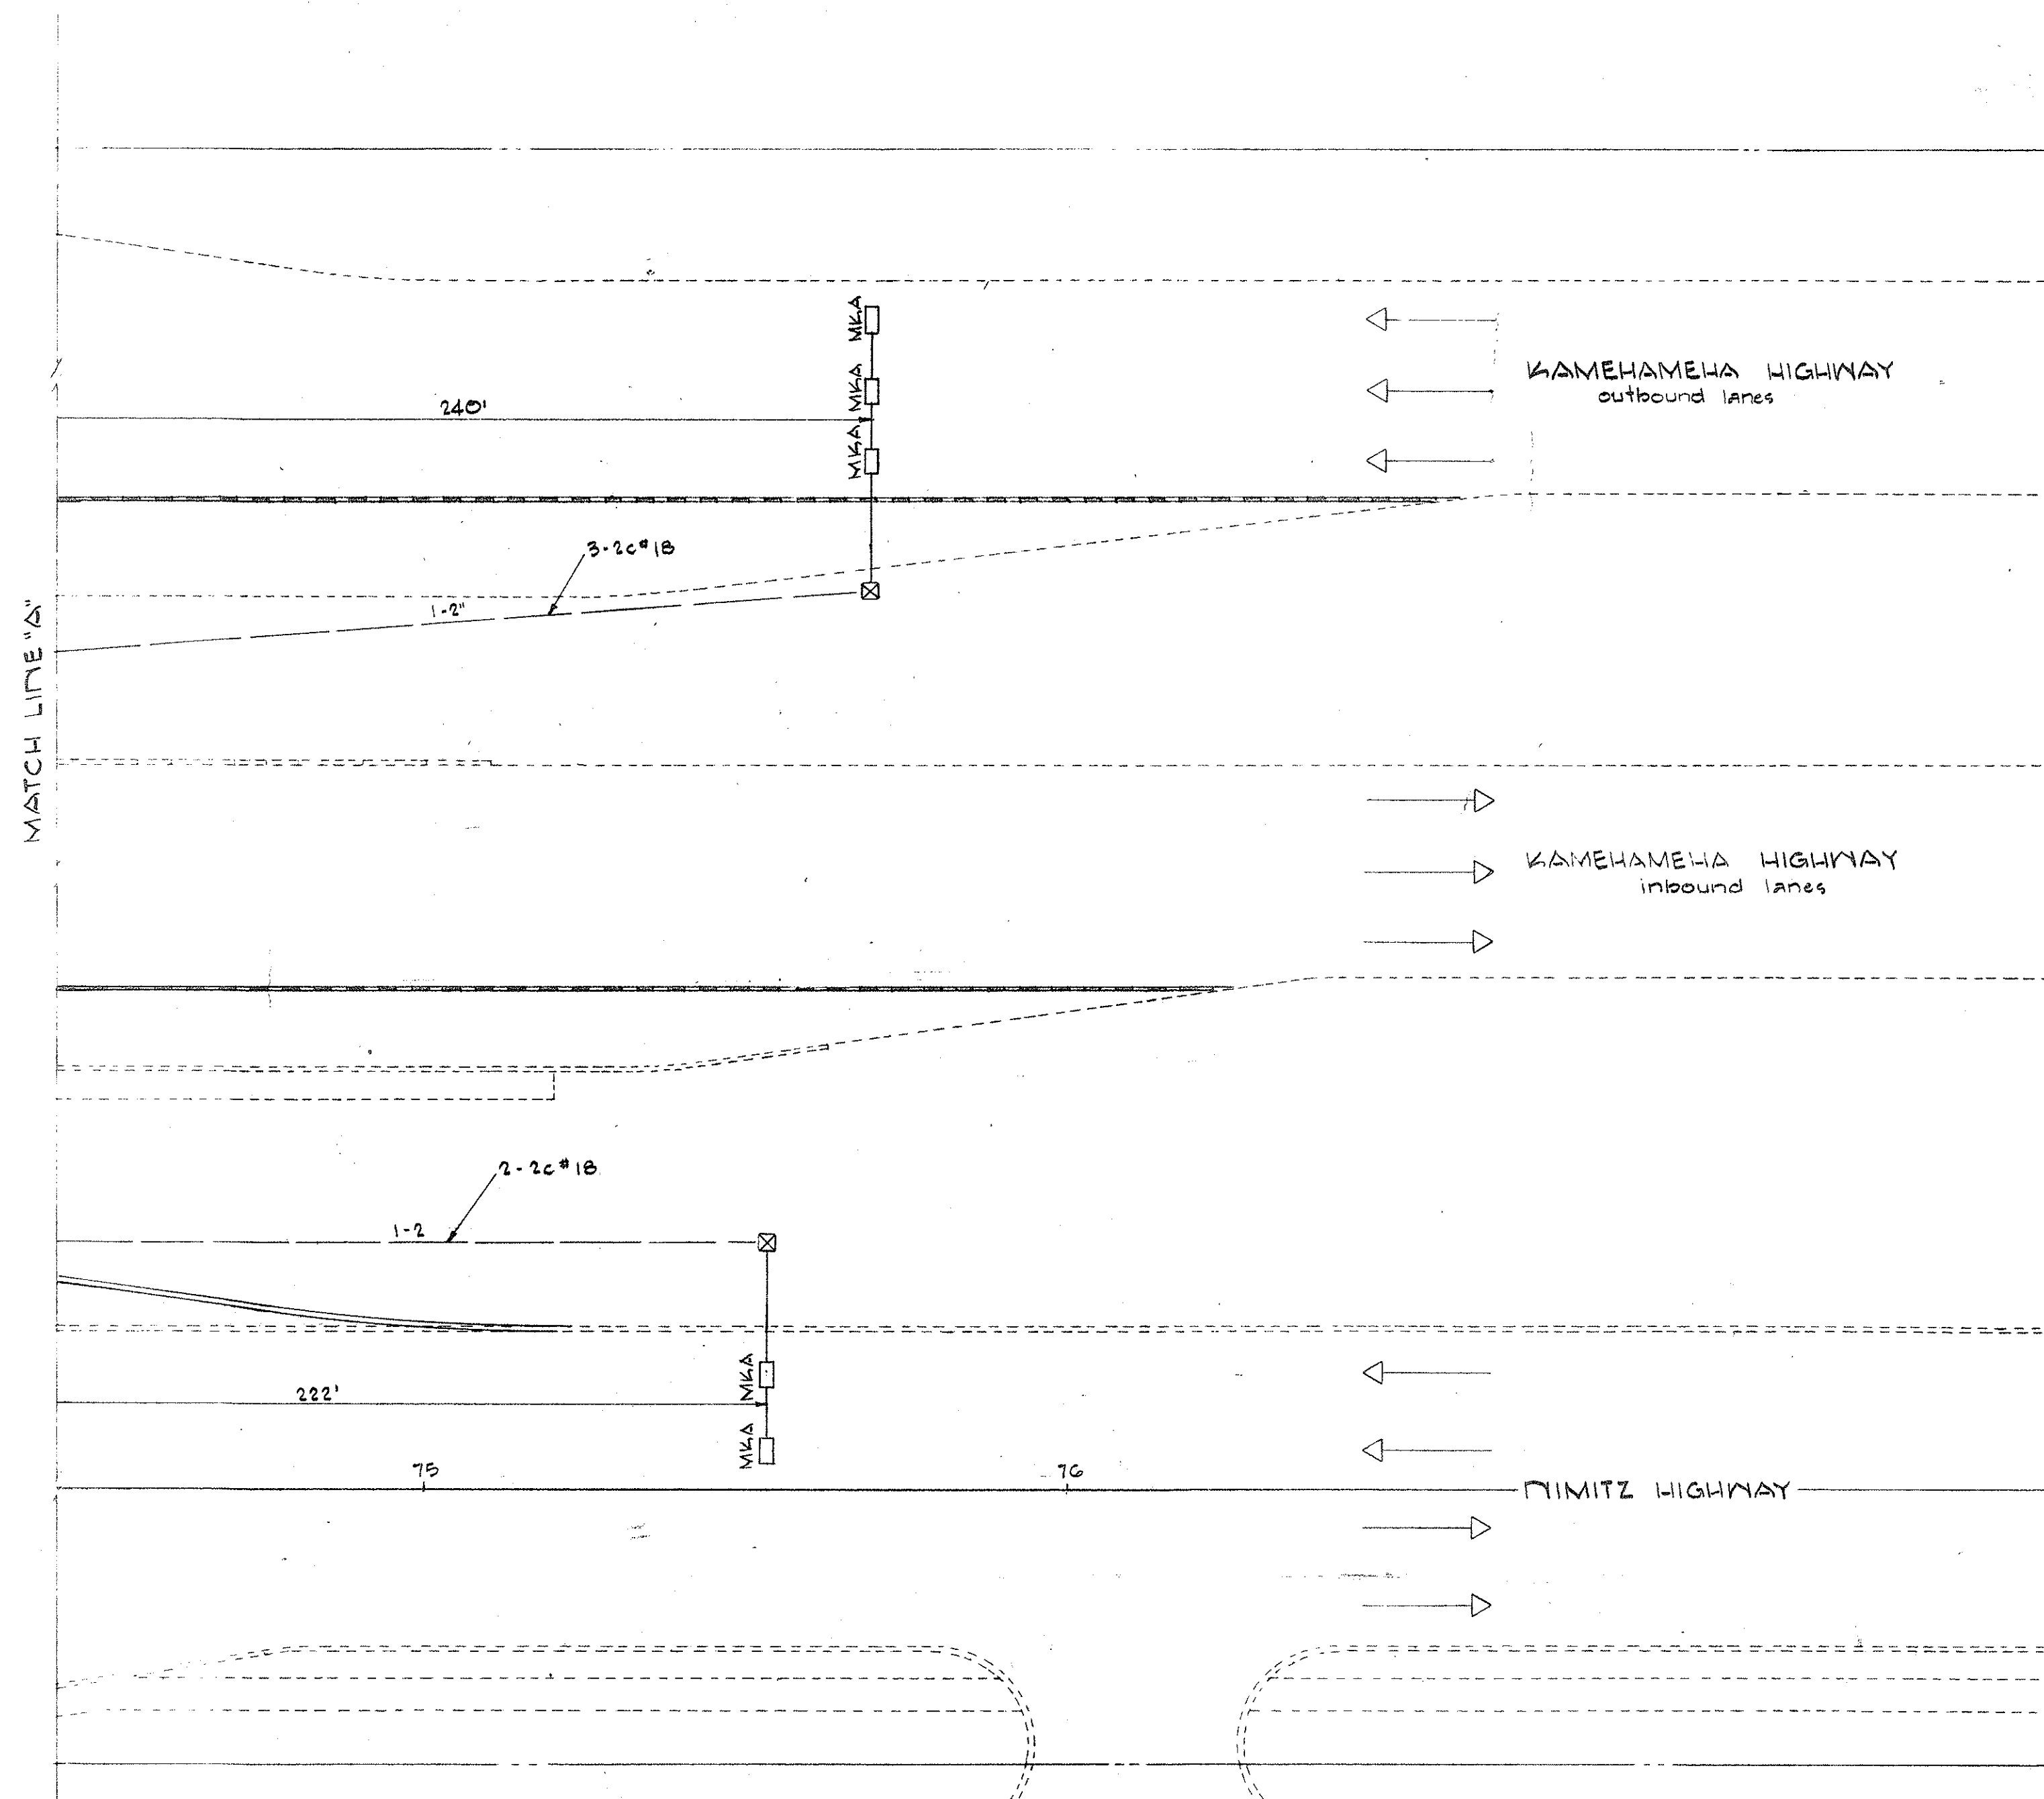


PHASE 1

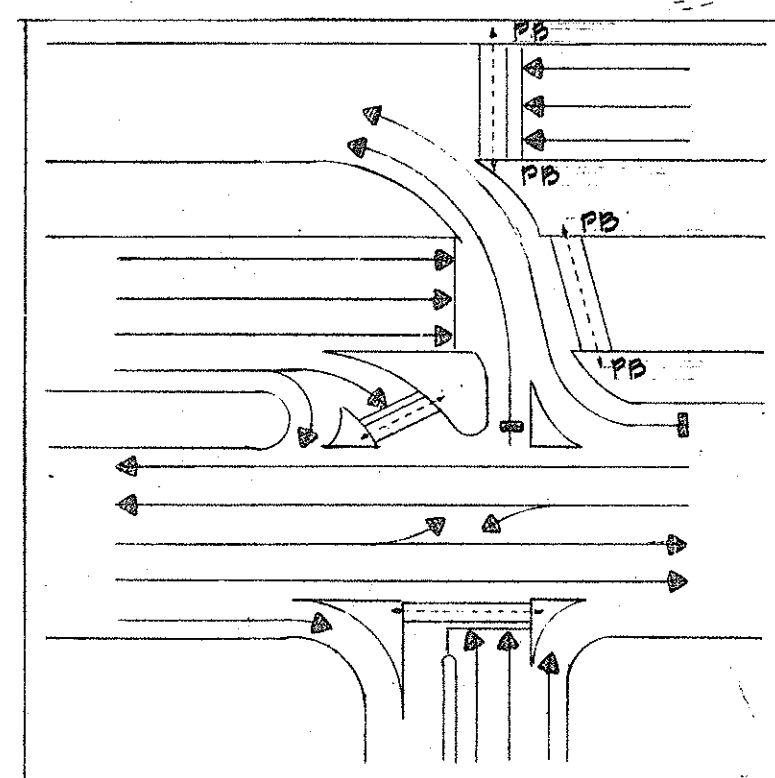

PHASE 2

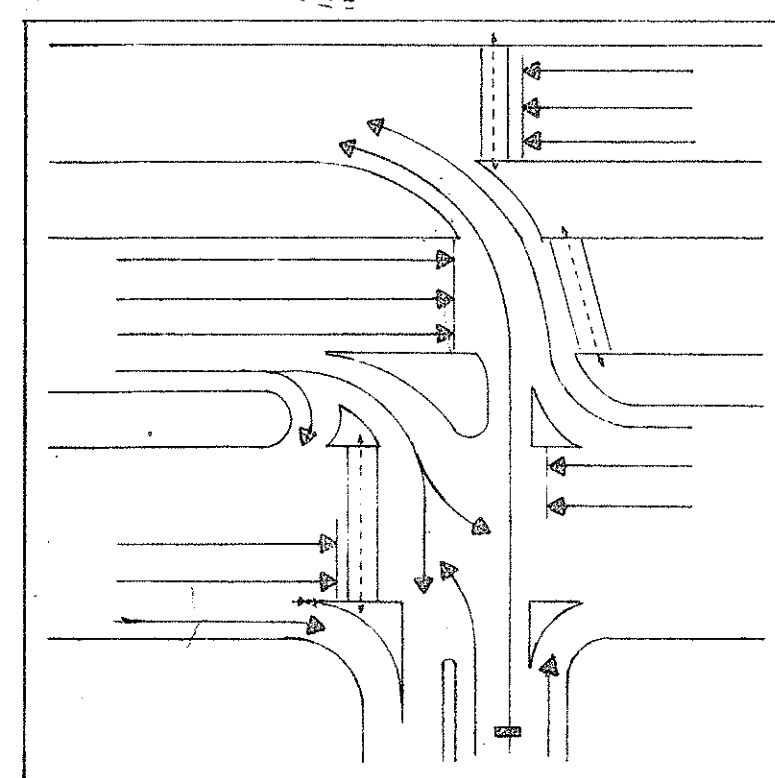


PHASE 3A

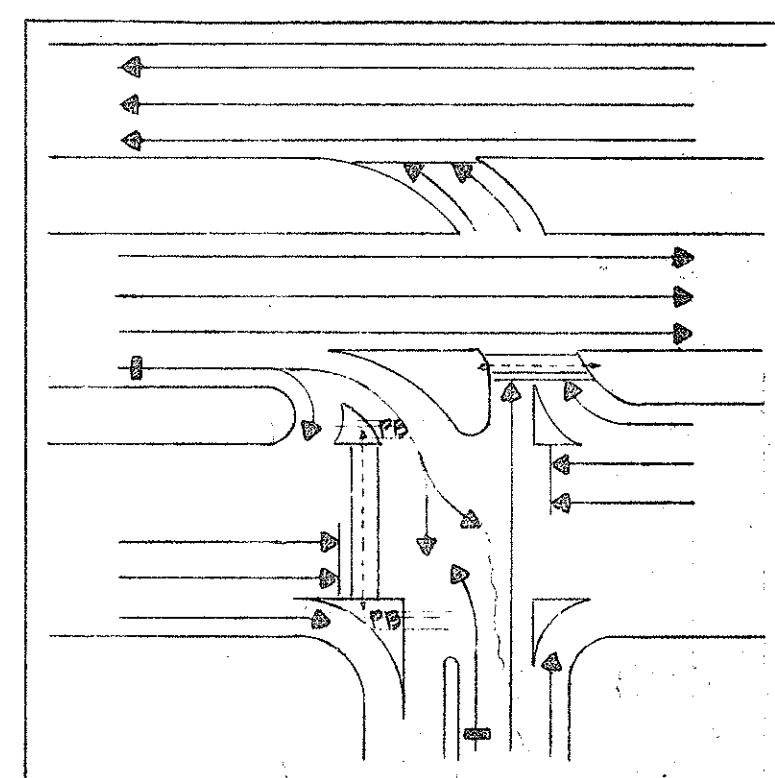

PHASE 3B

PHASE DIAGRAMS

— indicates detector actuation
PB indicates pedestrian pushbutton actuation

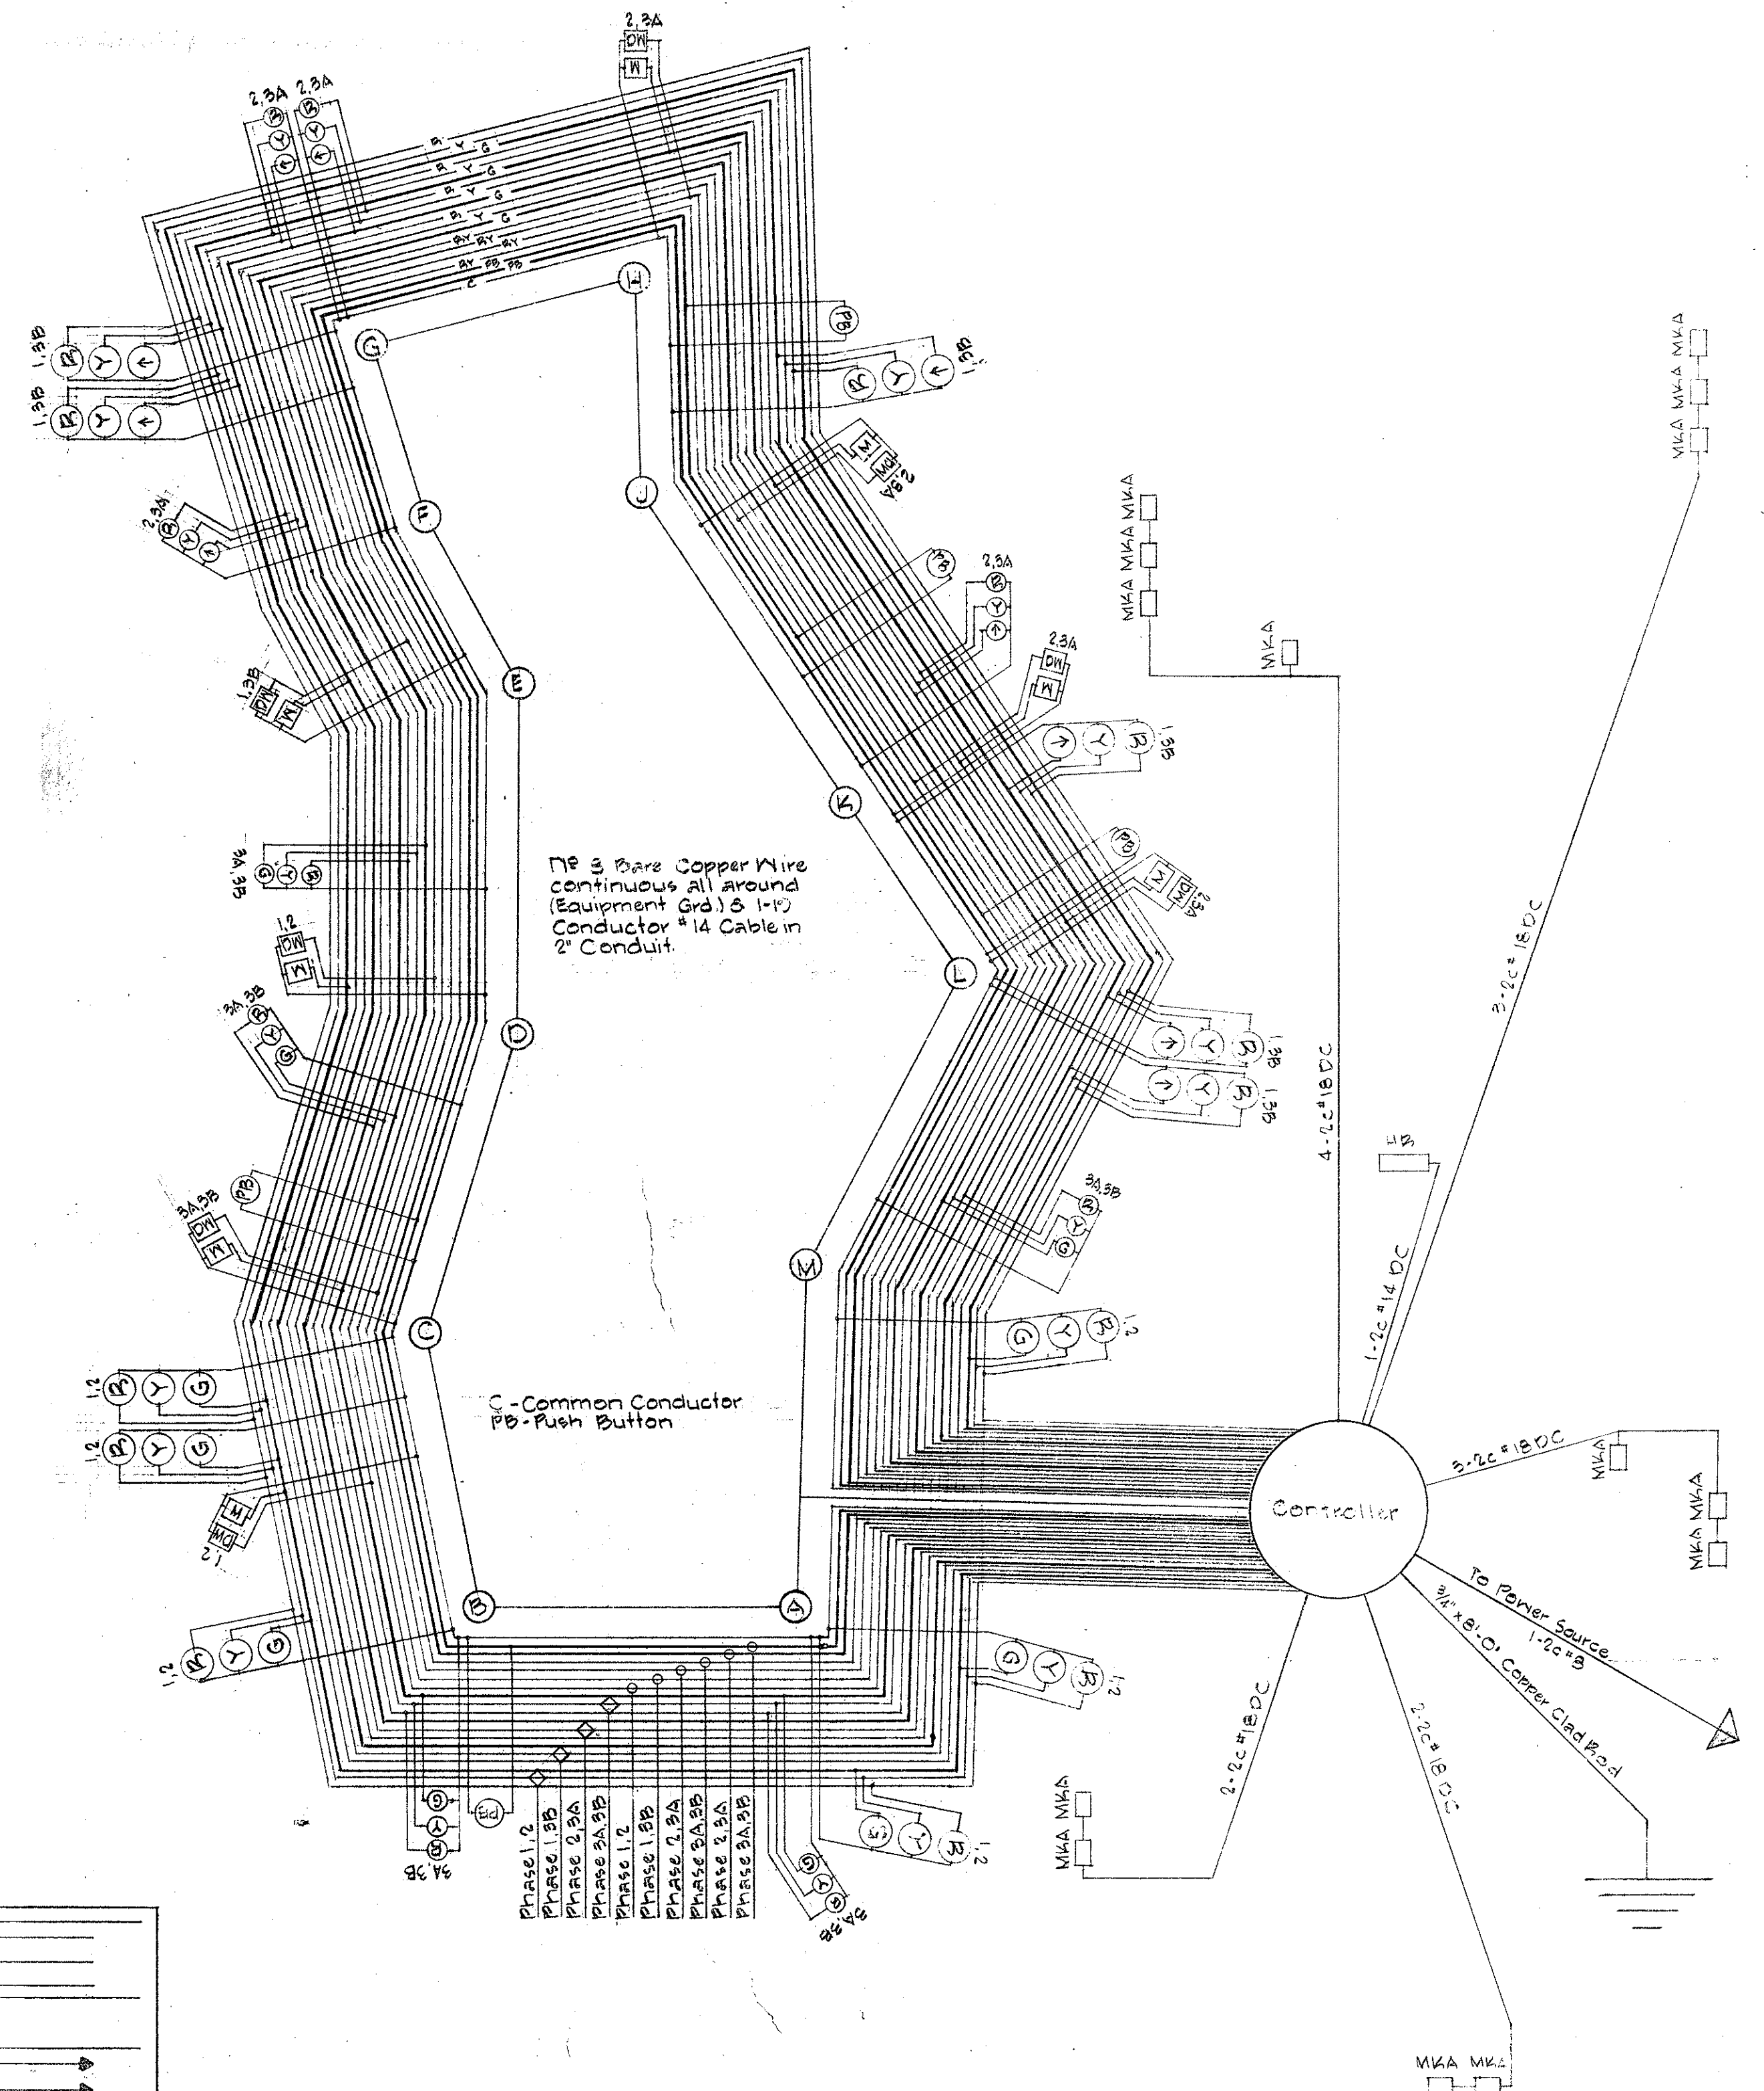

STATE OF HAWAII
DEPARTMENT OF TRANSPORTATION
HIGHWAYS DIVISION



TRAFFIC SIGNAL SYSTEM LAYOUT
CIRCUIT AND PHASE DIAGRAMS

SHEET No. OF SHEETS


A-92-02-64, D-90-02-64(3)

ORIGINAL PLAN	SURVEY PLOTTED BY	DATE
NOTED BOOK	DRAWN BY	
CHECKED BY	DESIGNED BY	
	QUANTITIES BY	
	CHECKED BY	


FED. ROAD DIST. NO.	STATE	FED. AID PROJ. NO.	FISCAL YEAR	SHEET NO.	TOTAL SHEETS
HAWAII	HAW.				

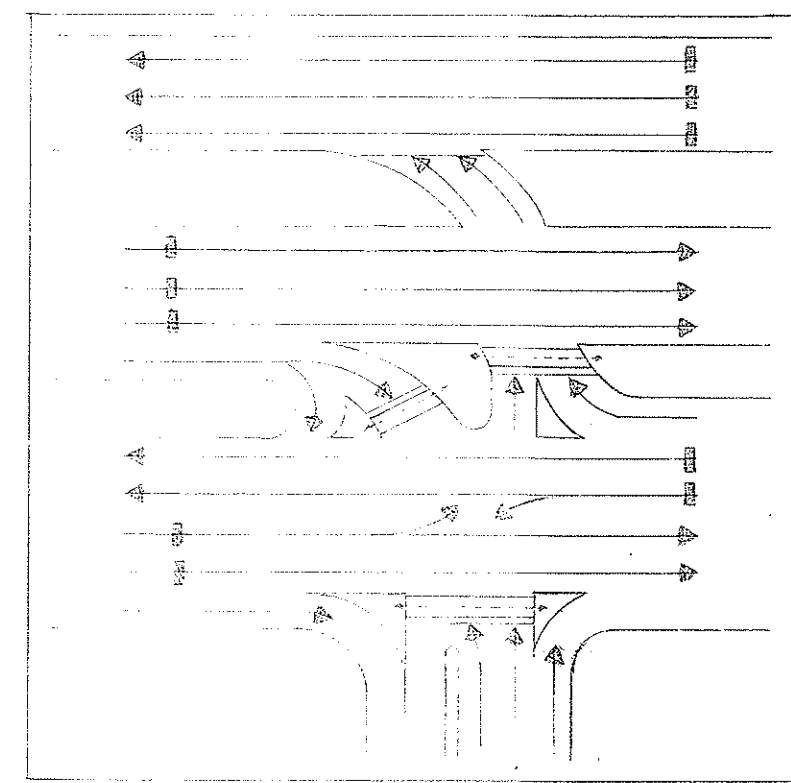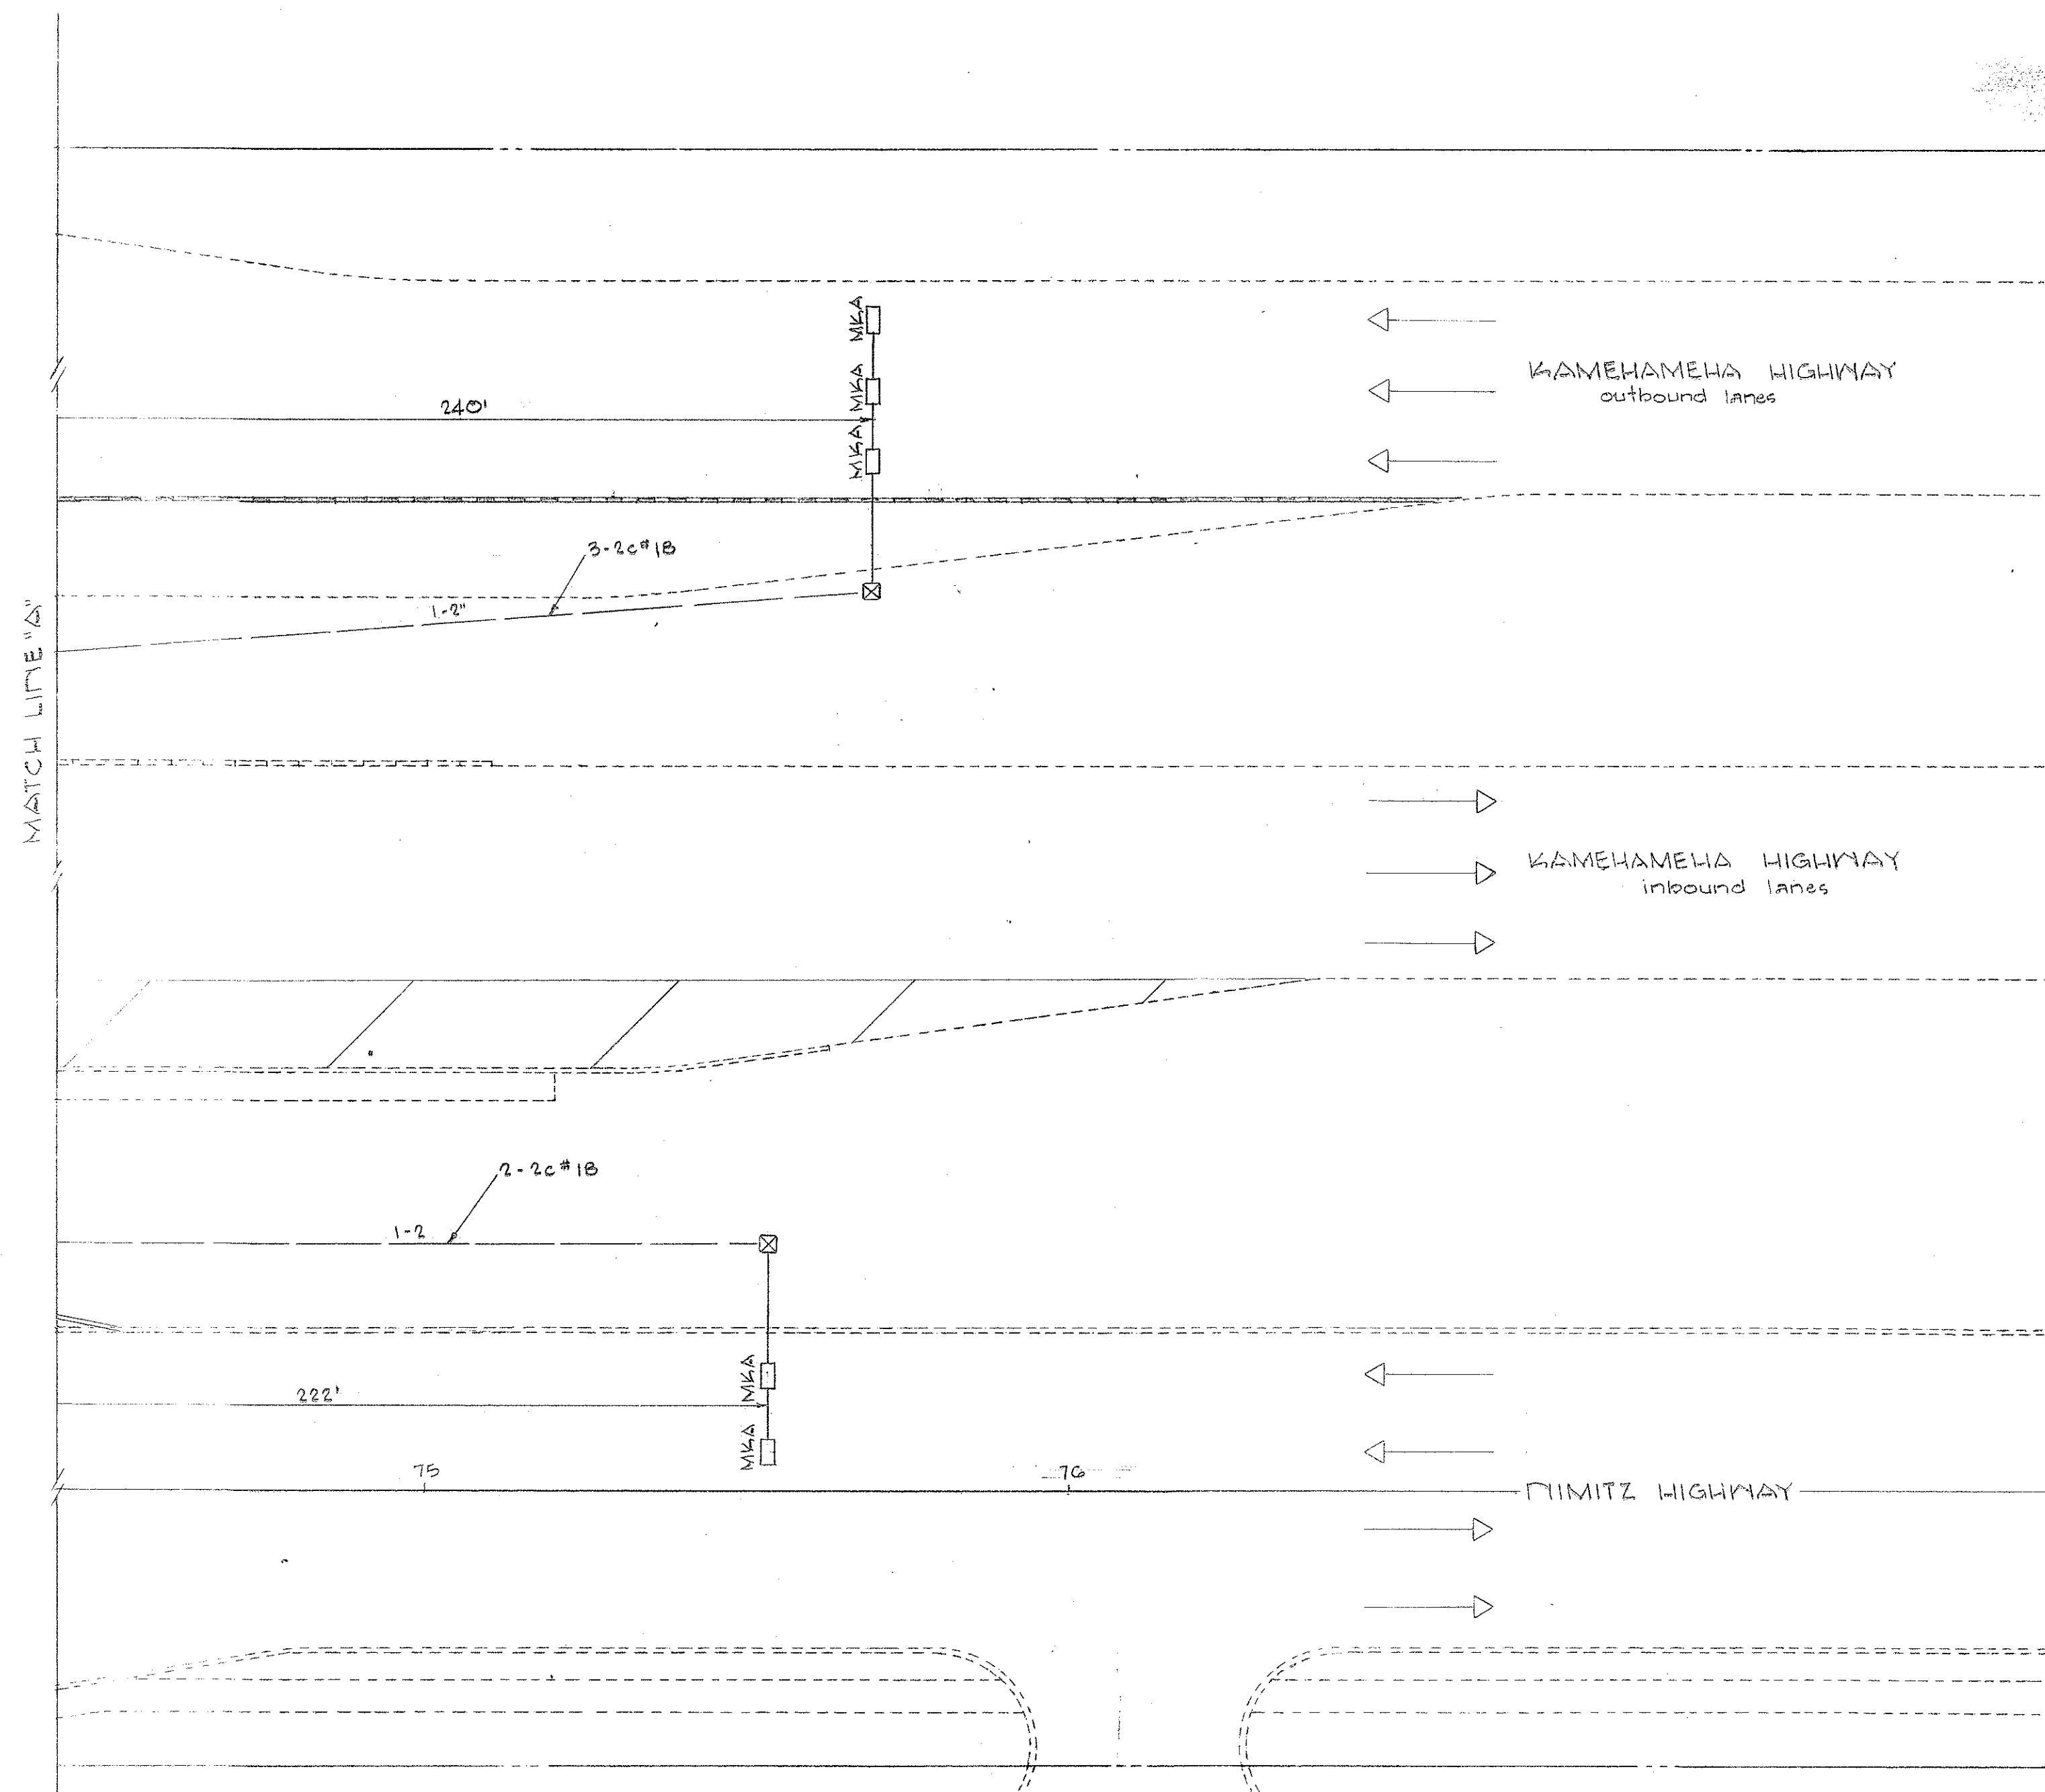


PHASE 1

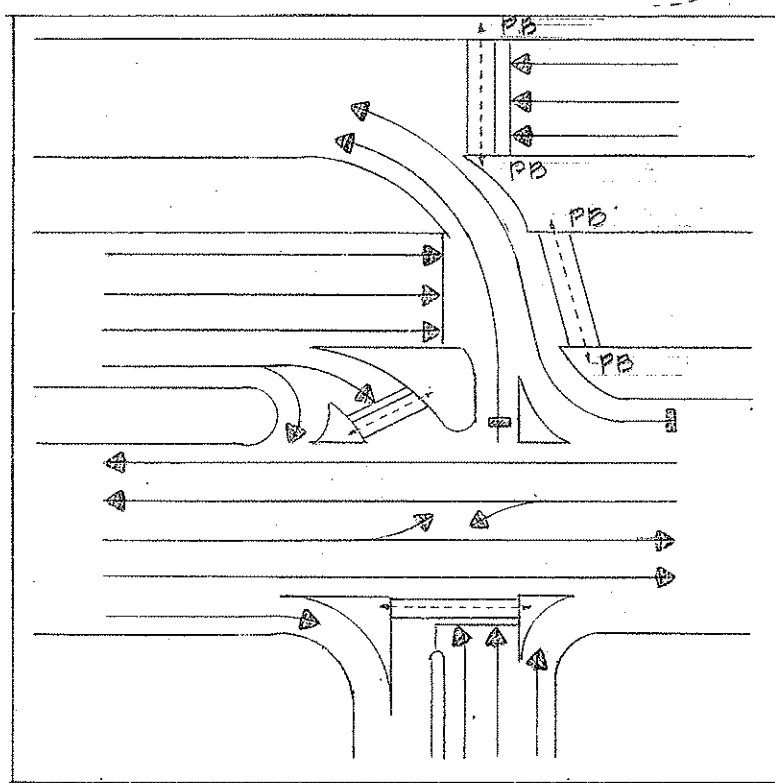

PHASE 2

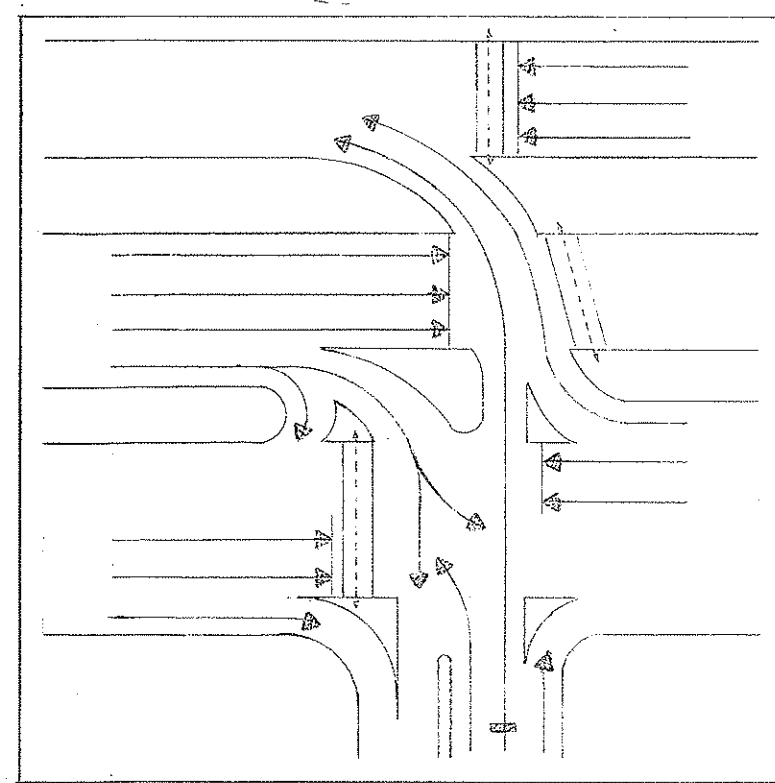


PHASE 3A

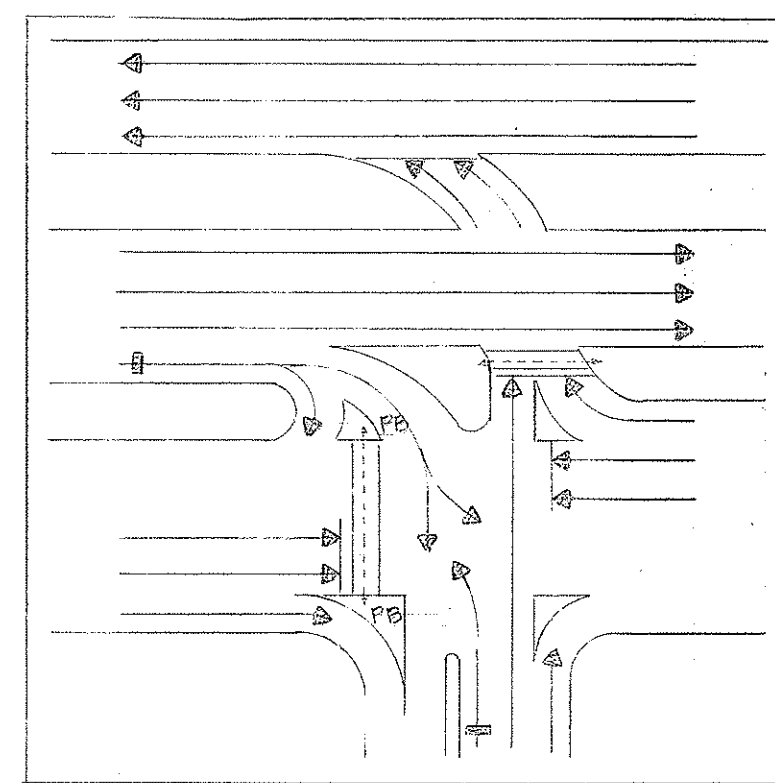

PHASE 3B

PHASE DIAGRAMS

■ indicates detector actuation
PB indicates pedestrian pushbutton actuation

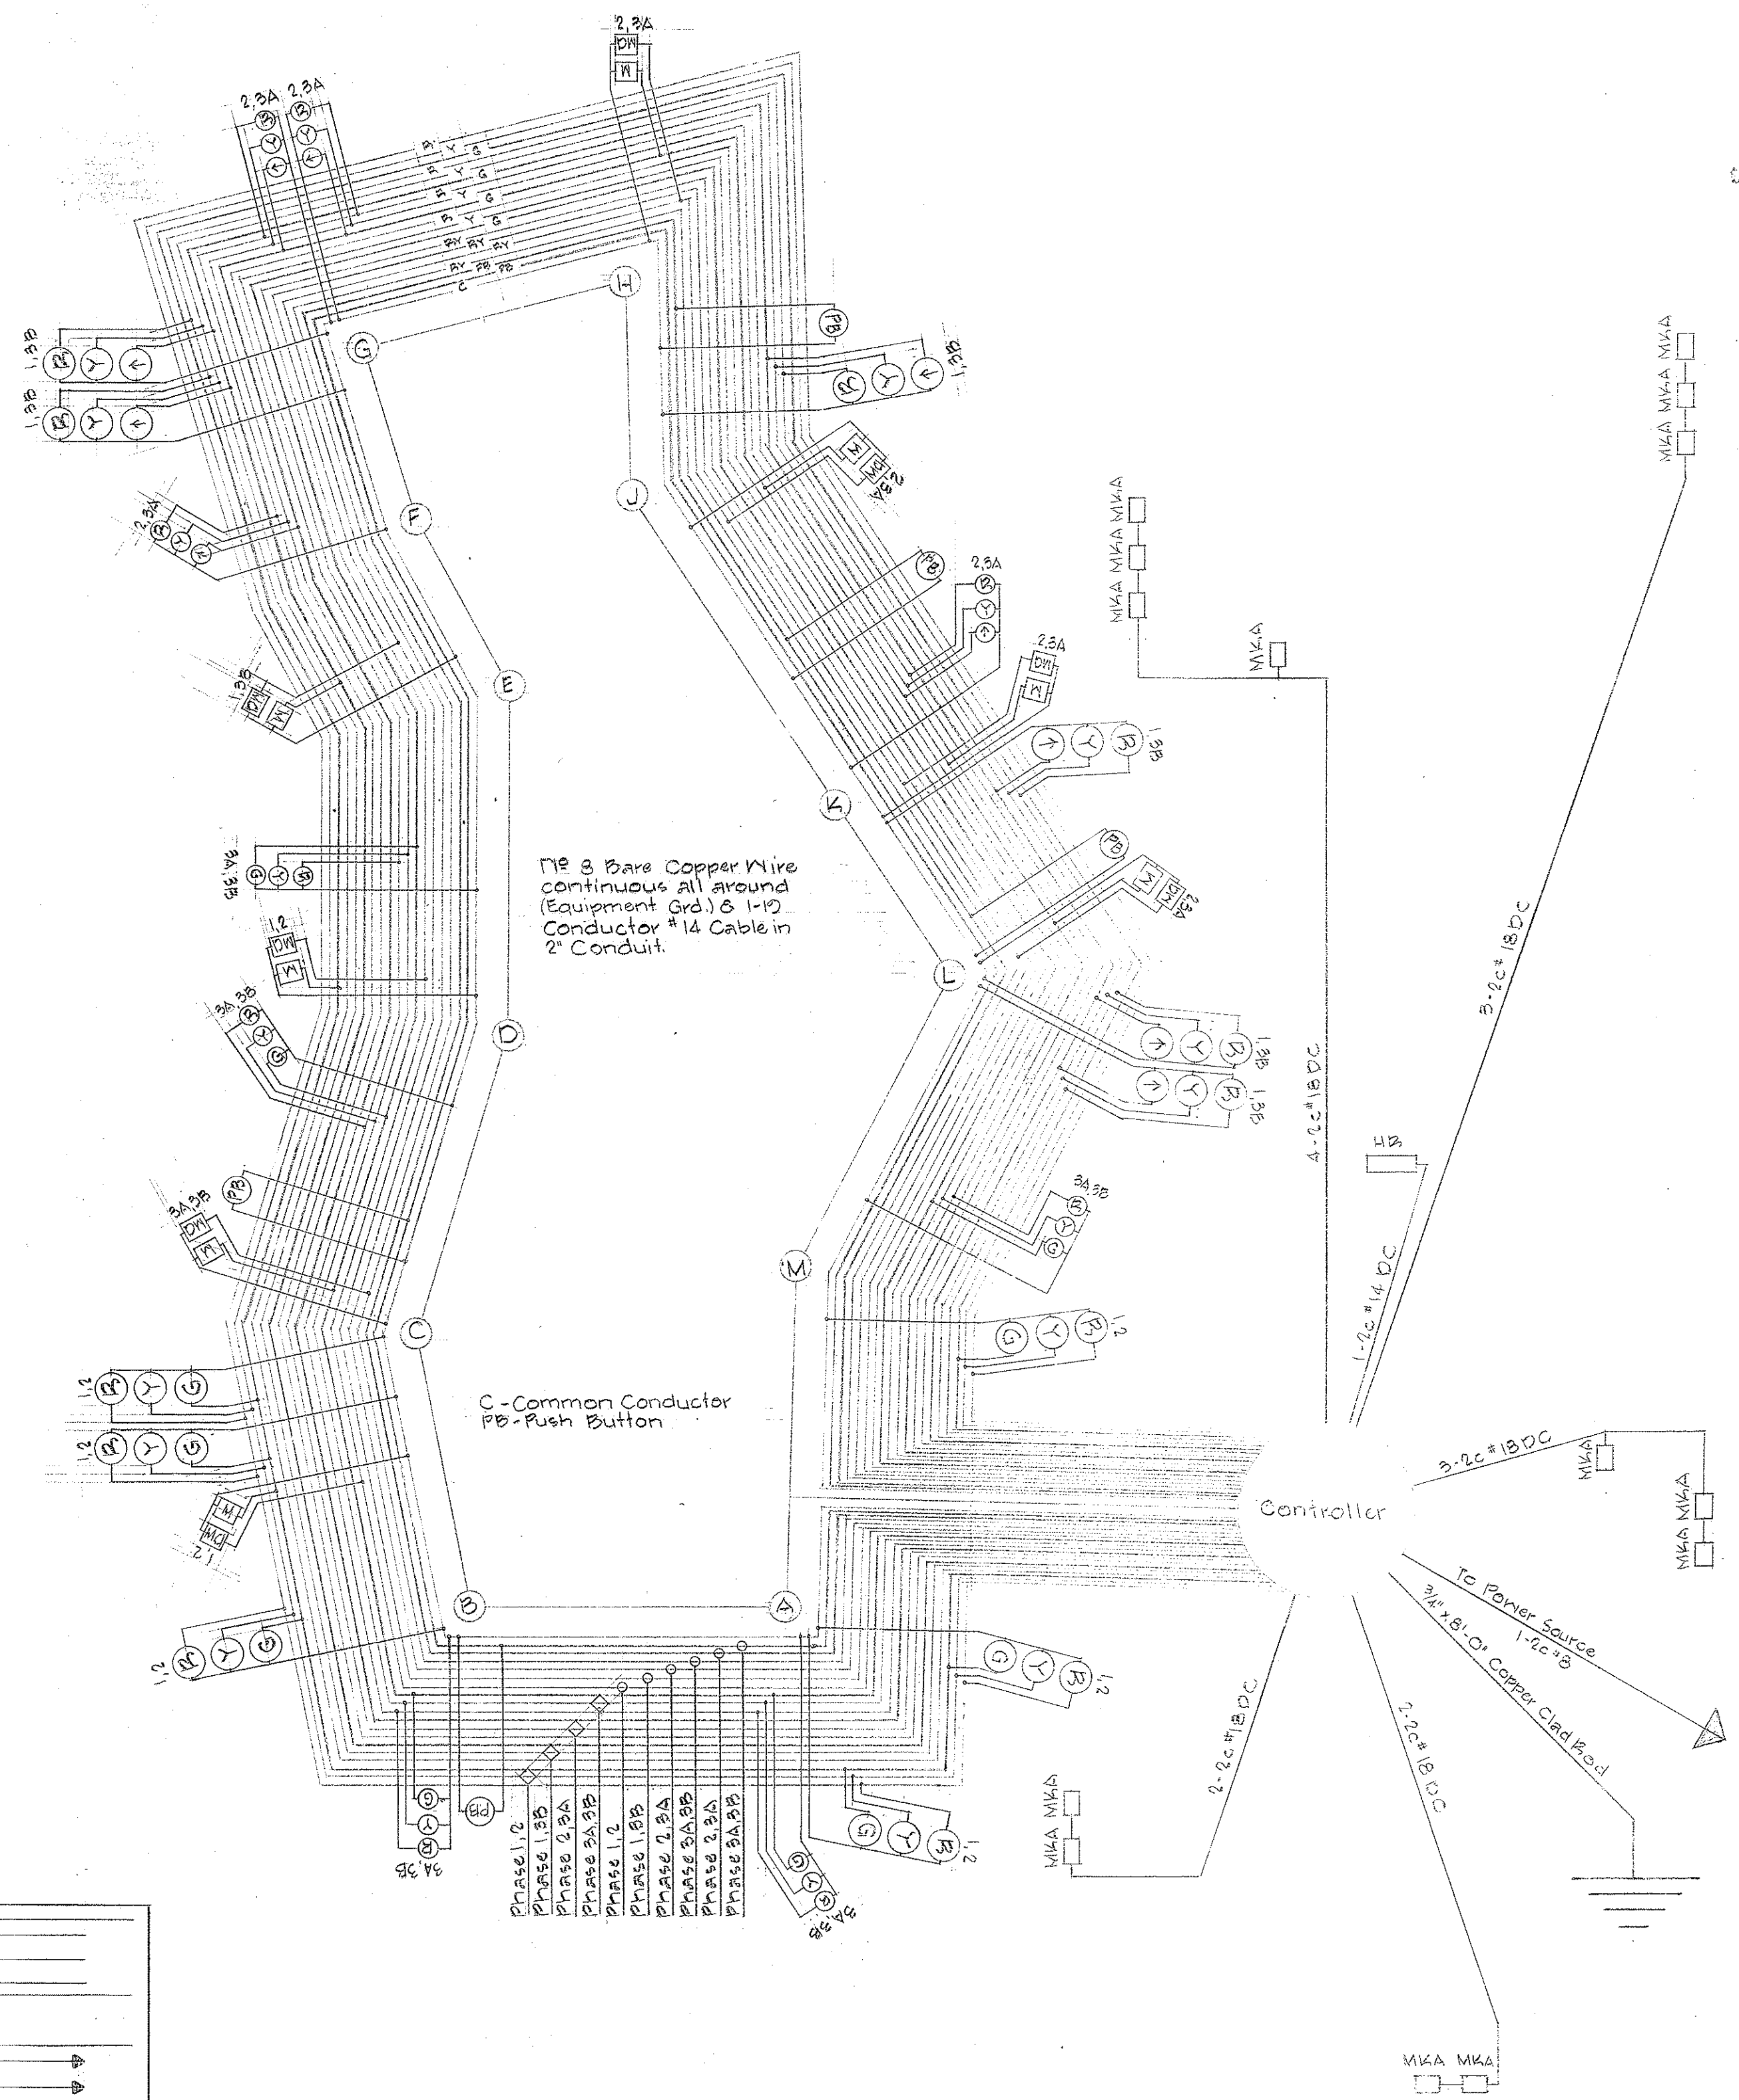

REVISED: MAY 1964

NOTE:
This sheet supersedes sheet #3

STATE OF HAWAII
DEPARTMENT OF TRANSPORTATION
HIGHWAYS DIVISION

TRAFFIC SIGNAL SYSTEM LAYOUT
CIRCUIT AND PHASE DIAGRAMS

SHEET No. OF SHEETS

ORIGINAL PLAN	SURVEY PLOTTED BY	DATE
NOTE BOOK	DESIGNED BY	
	QUANTITIES BY	
	CHECKED BY	