
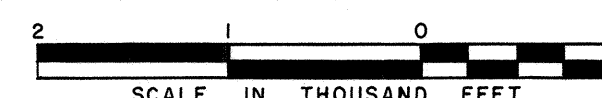
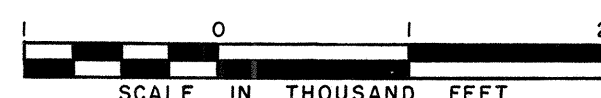



INDEX TO DRAWINGS	
SHT. NO.	DESCRIPTION
1	TITLE SHEET
2	GEN. NOTES & MISC. DETAILS
3-5	ROADWAY PLANS

STATE OF HAWAII
DEPARTMENT OF TRANSPORTATION
HIGHWAYS DIVISION
HONOLULU, HAWAII
"AS-BUILT"
PLANS FOR
RESURFACING OF A PORTION OF
NIMITZ HIGHWAY
MIDDLE STREET
TOWARDS
PACIFIC STREET
PROJECT No. A-92-01-65

DISTRICT OF HONOLULU
ISLAND OF OAHU

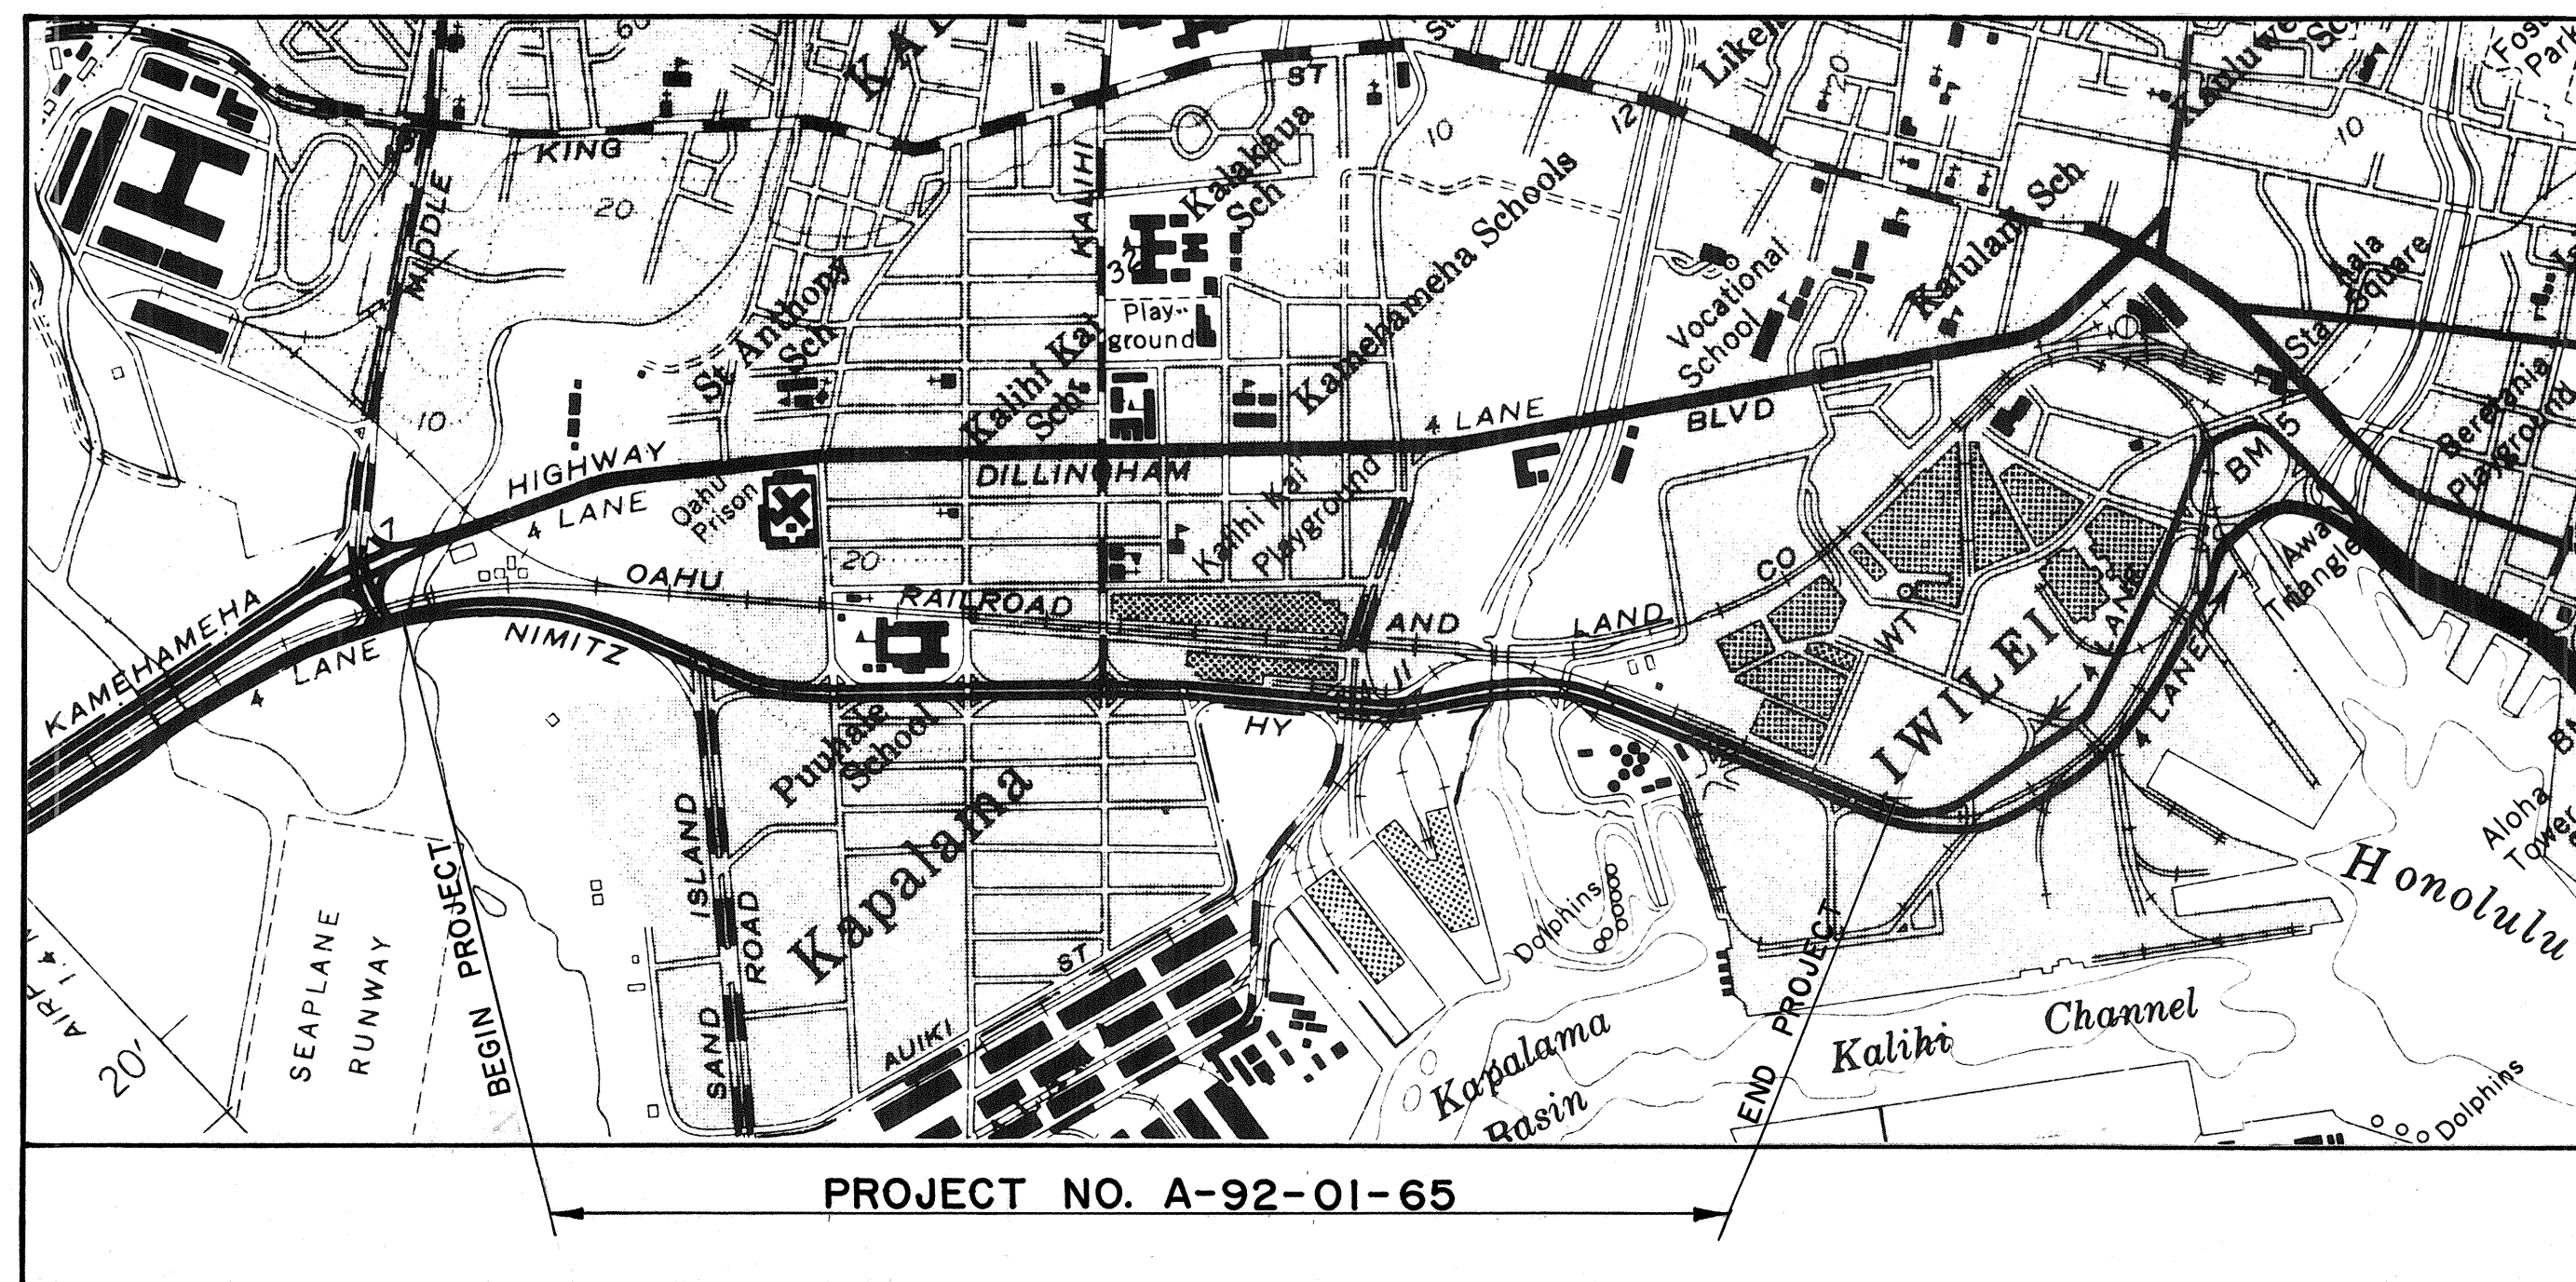

LAYOUT PLAN
LENGTH OF PROJECT.....1.594 MILES

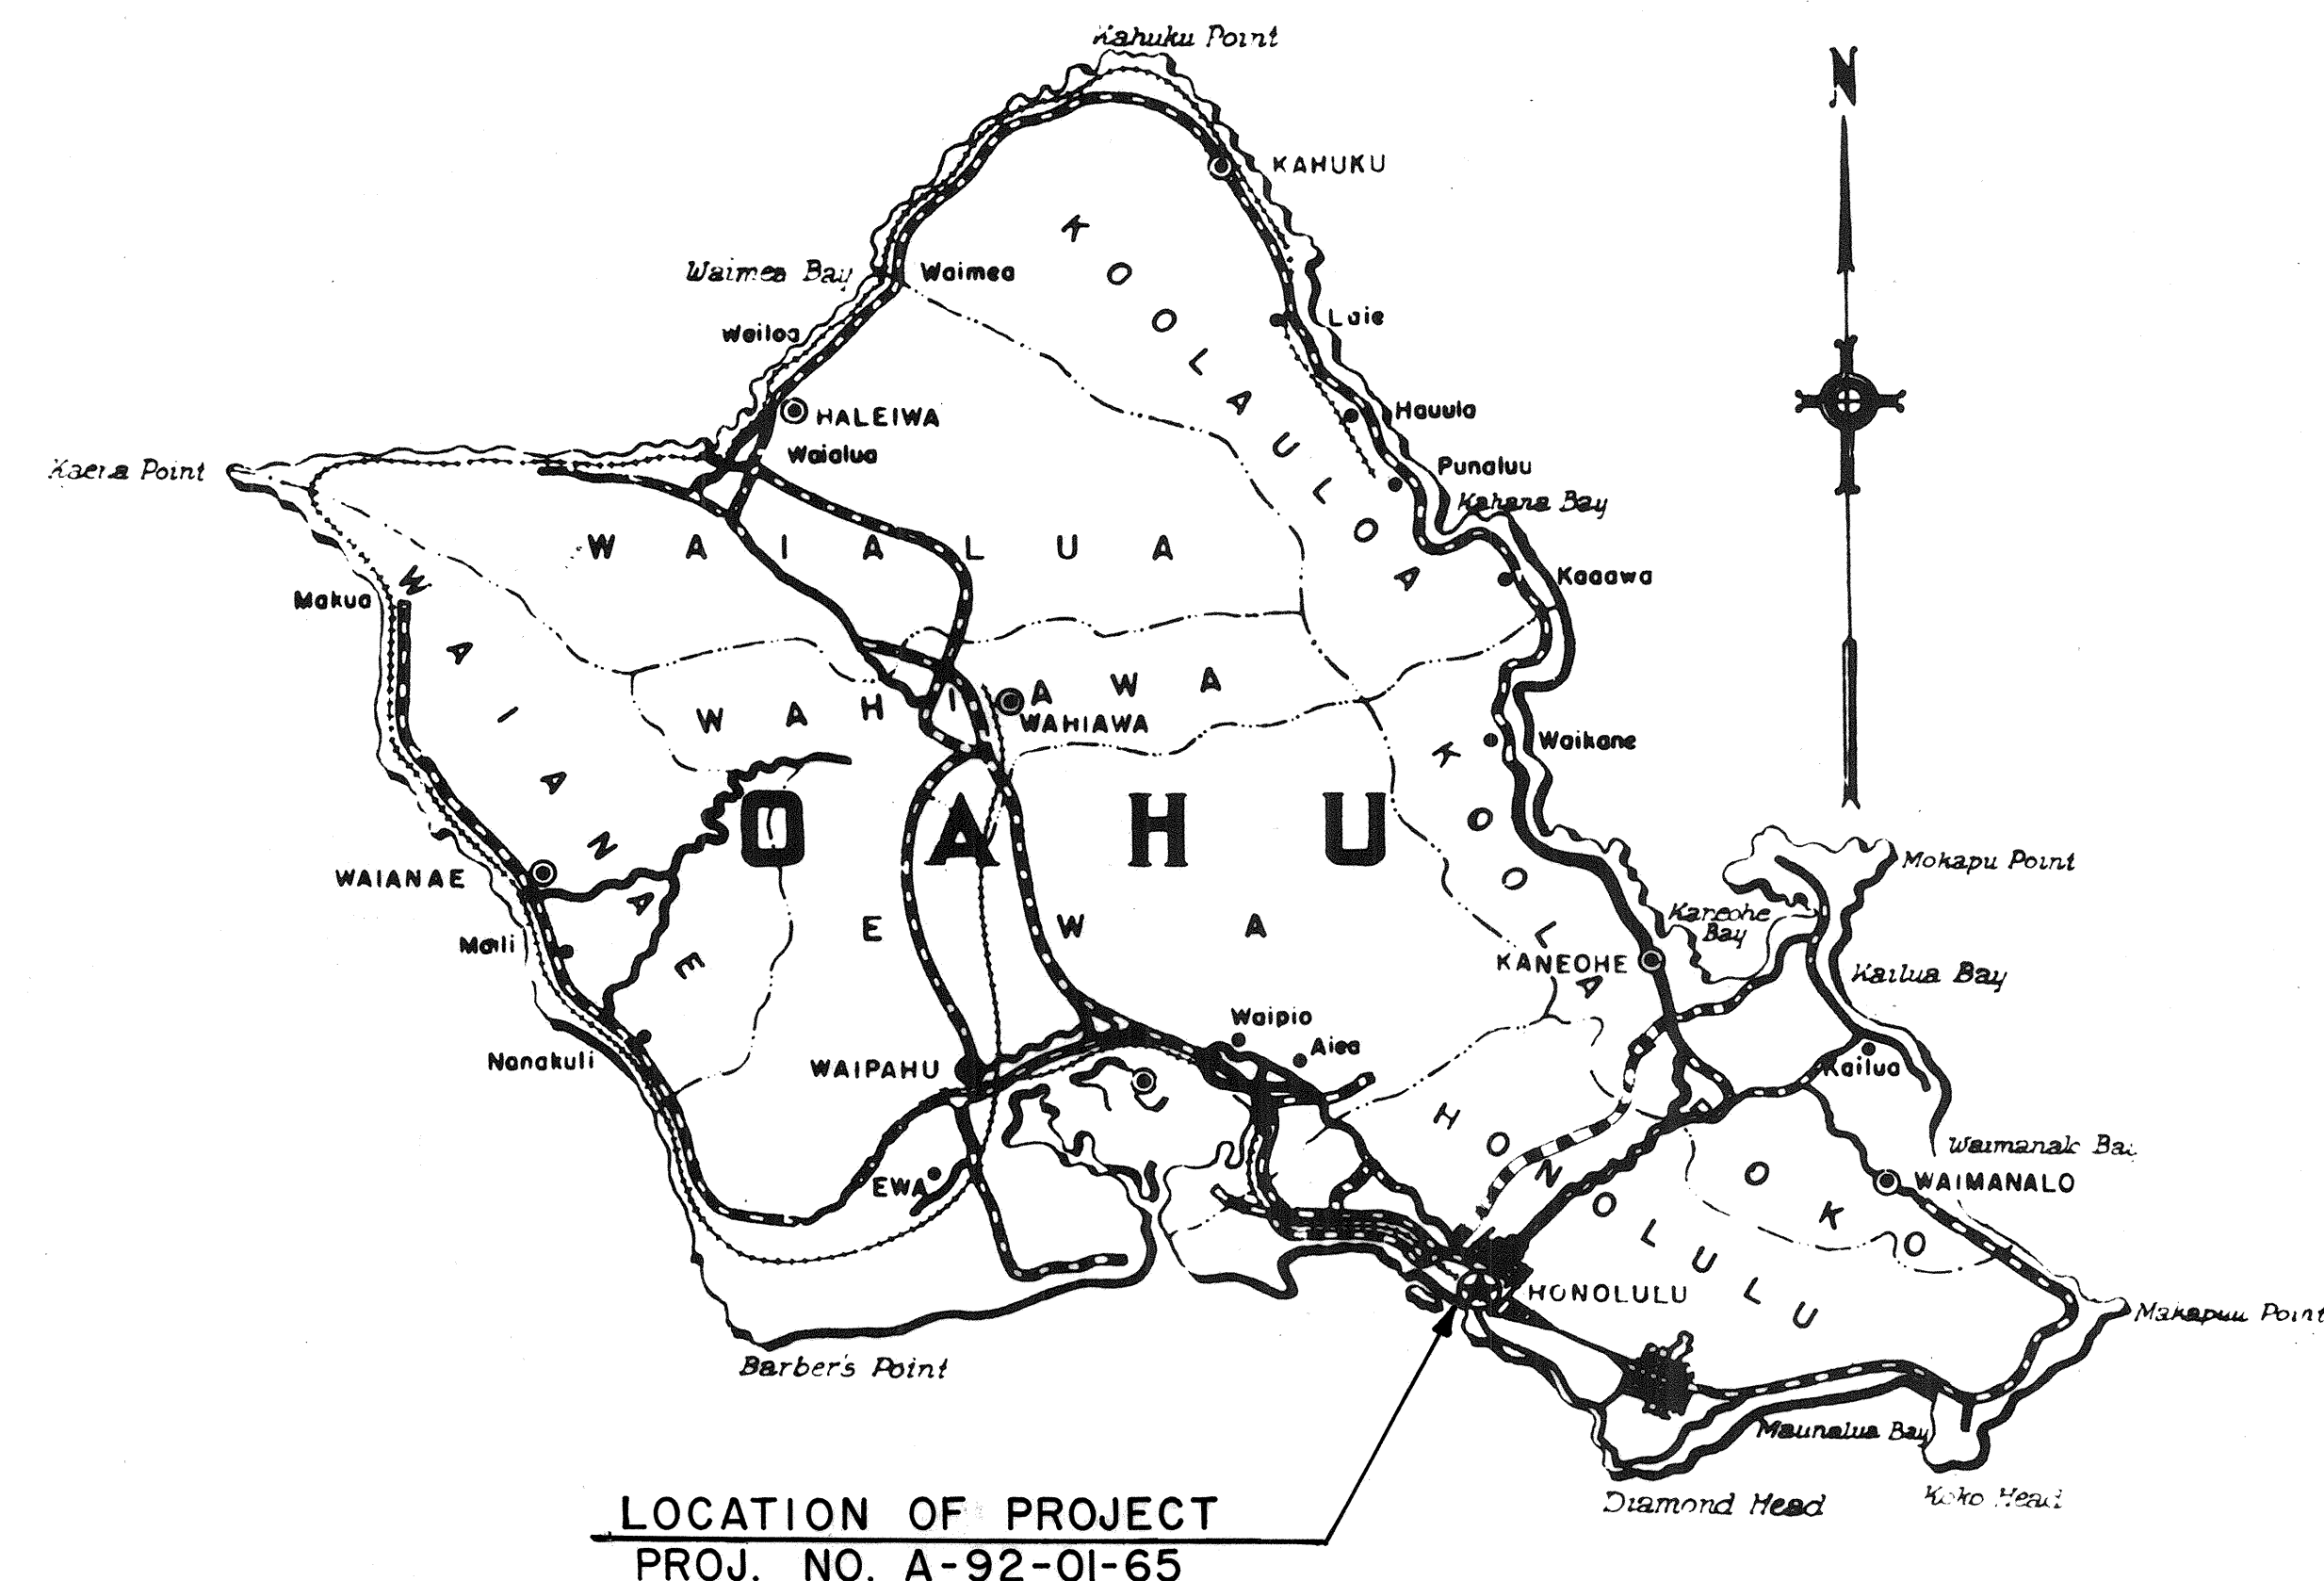

Federal Aid Projects Previously Constructed Or Under Construction

NO CHANGES WERE MADE DURING CONSTRUCTION ON THESE PLANS EXCEPT CHANGES IN THE ORIGINAL THEORETICAL QUANTITIES. FOR ACTUAL QUANTITIES, REFER TO PROJECT LEDGER AND/OR COMPUTATION BOOK.

R. T. J. J. J.
for RESIDENT ENGINEER

11-9-81
DATE

APPROVED: DATE: 19 Feb. 65.

J. J. J. J.
DIRECTOR OF TRANSPORTATION