. Y	
INDEX TO DRAWINGS	
SHEET NO.	DESCRIPTION
l	TITLE SHEET
2	PLAN
,	
3 4	v

STATE OF HAWAII

DEPARTMENT OF TRANSPORTATION
HIGHWAYS DIVISION

HONOLULU, HAWAII
"AS-BUILT"


PLANS FOR

## RESURFACING A PORTION OF NIMITZ HIGHWAY

PACIFIC STREET
TOWARDS
RICHARDS STREET

PROJECT No. 92A-01-67


DISTRICT OF HONOLULU
ISLAND OF OAHU

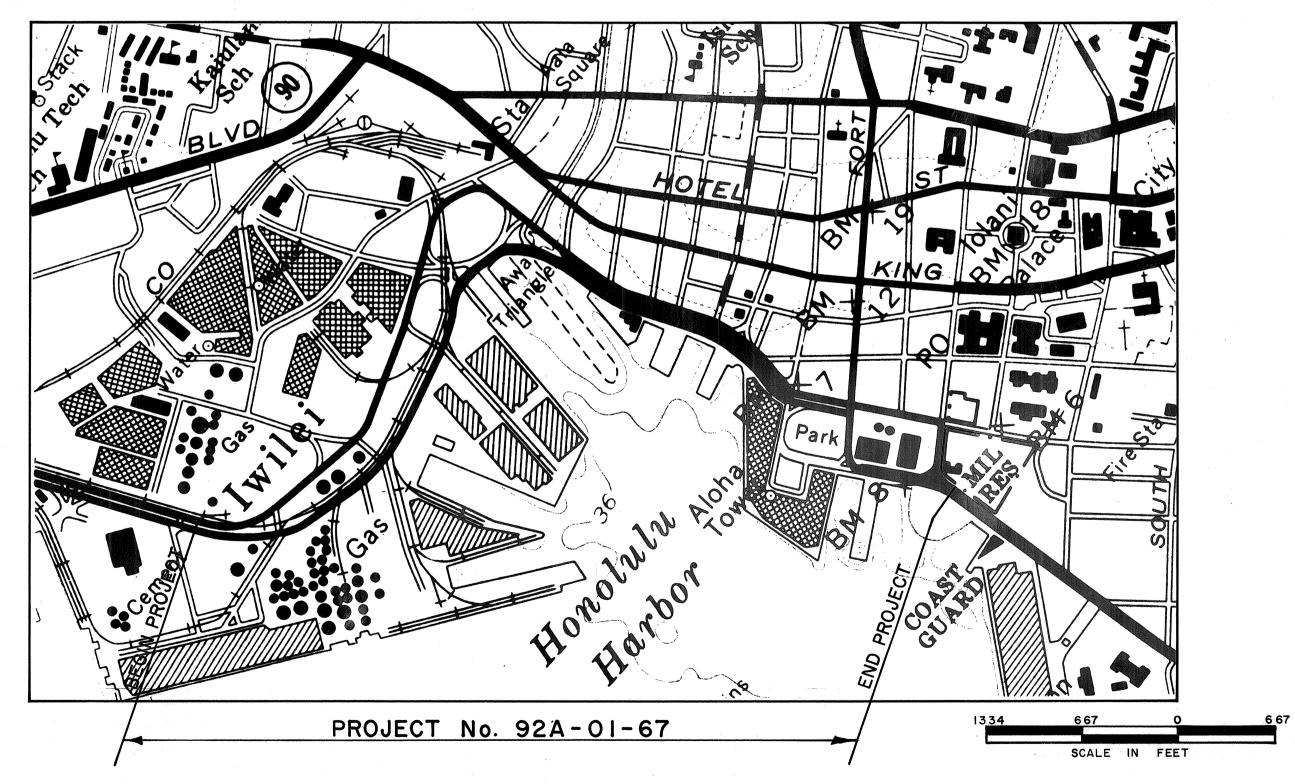

LAYOUT PLAN

FED. ROAD DIST. NO. STATE FED. AID FISCAL SHEET TOTAL SHEETS

HAWAII HAW. 92A-01-67 1966 1 2

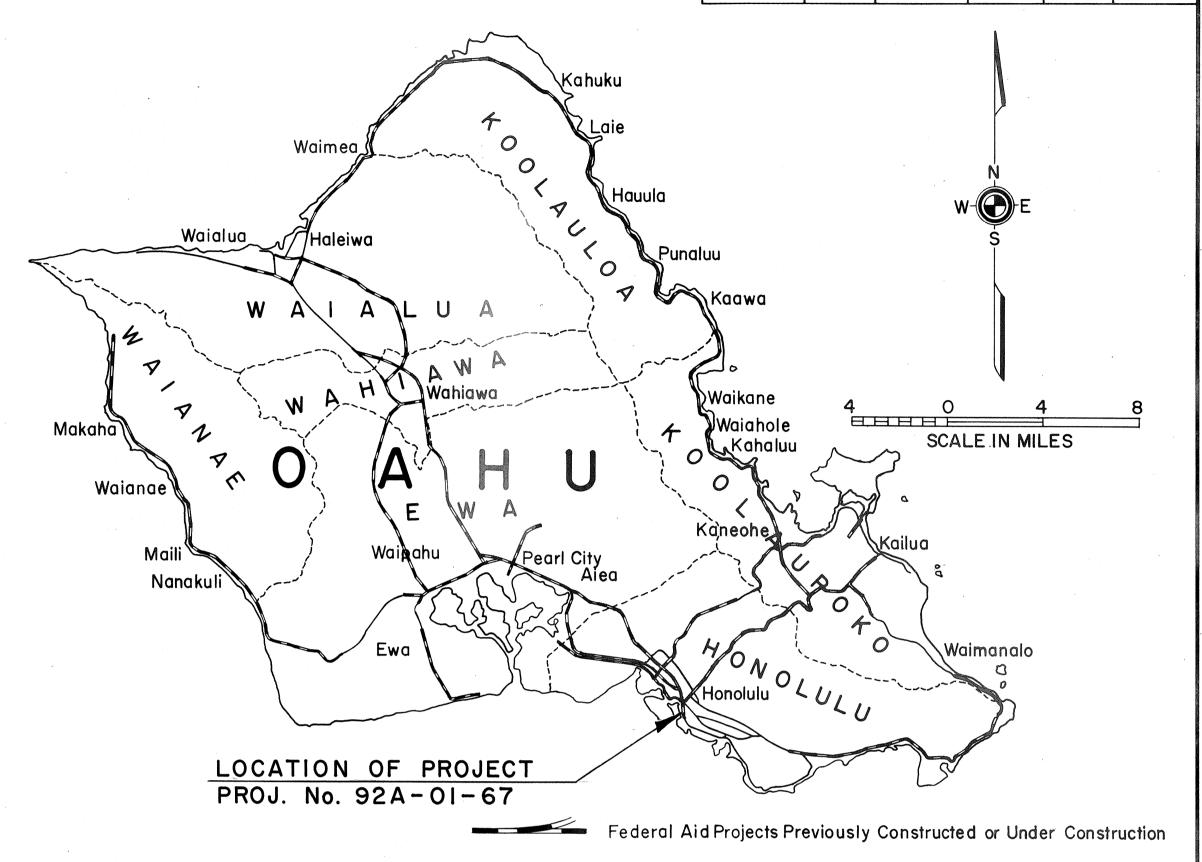

NO CHANGES WERE MADE DURING CONSTRUCTION ON THESE PLANS EXCEPT CHANGES IN THE ORIGINAL THEORETICAL QUANTITIES. FOR ACTUAL QUANTITIES, REFER TO PROJECT LEDGER AND/OR COMPUTATION BOOK.

R.T. Same

CA IER

11-9-81 DATE

DEPARTMENT OF TRANSPORTATION STATE OF HAWAII

JAMES WILL SEEN SIR. OF TRANSPORTATION

D10-6-79

10 - **6**6 DATE