
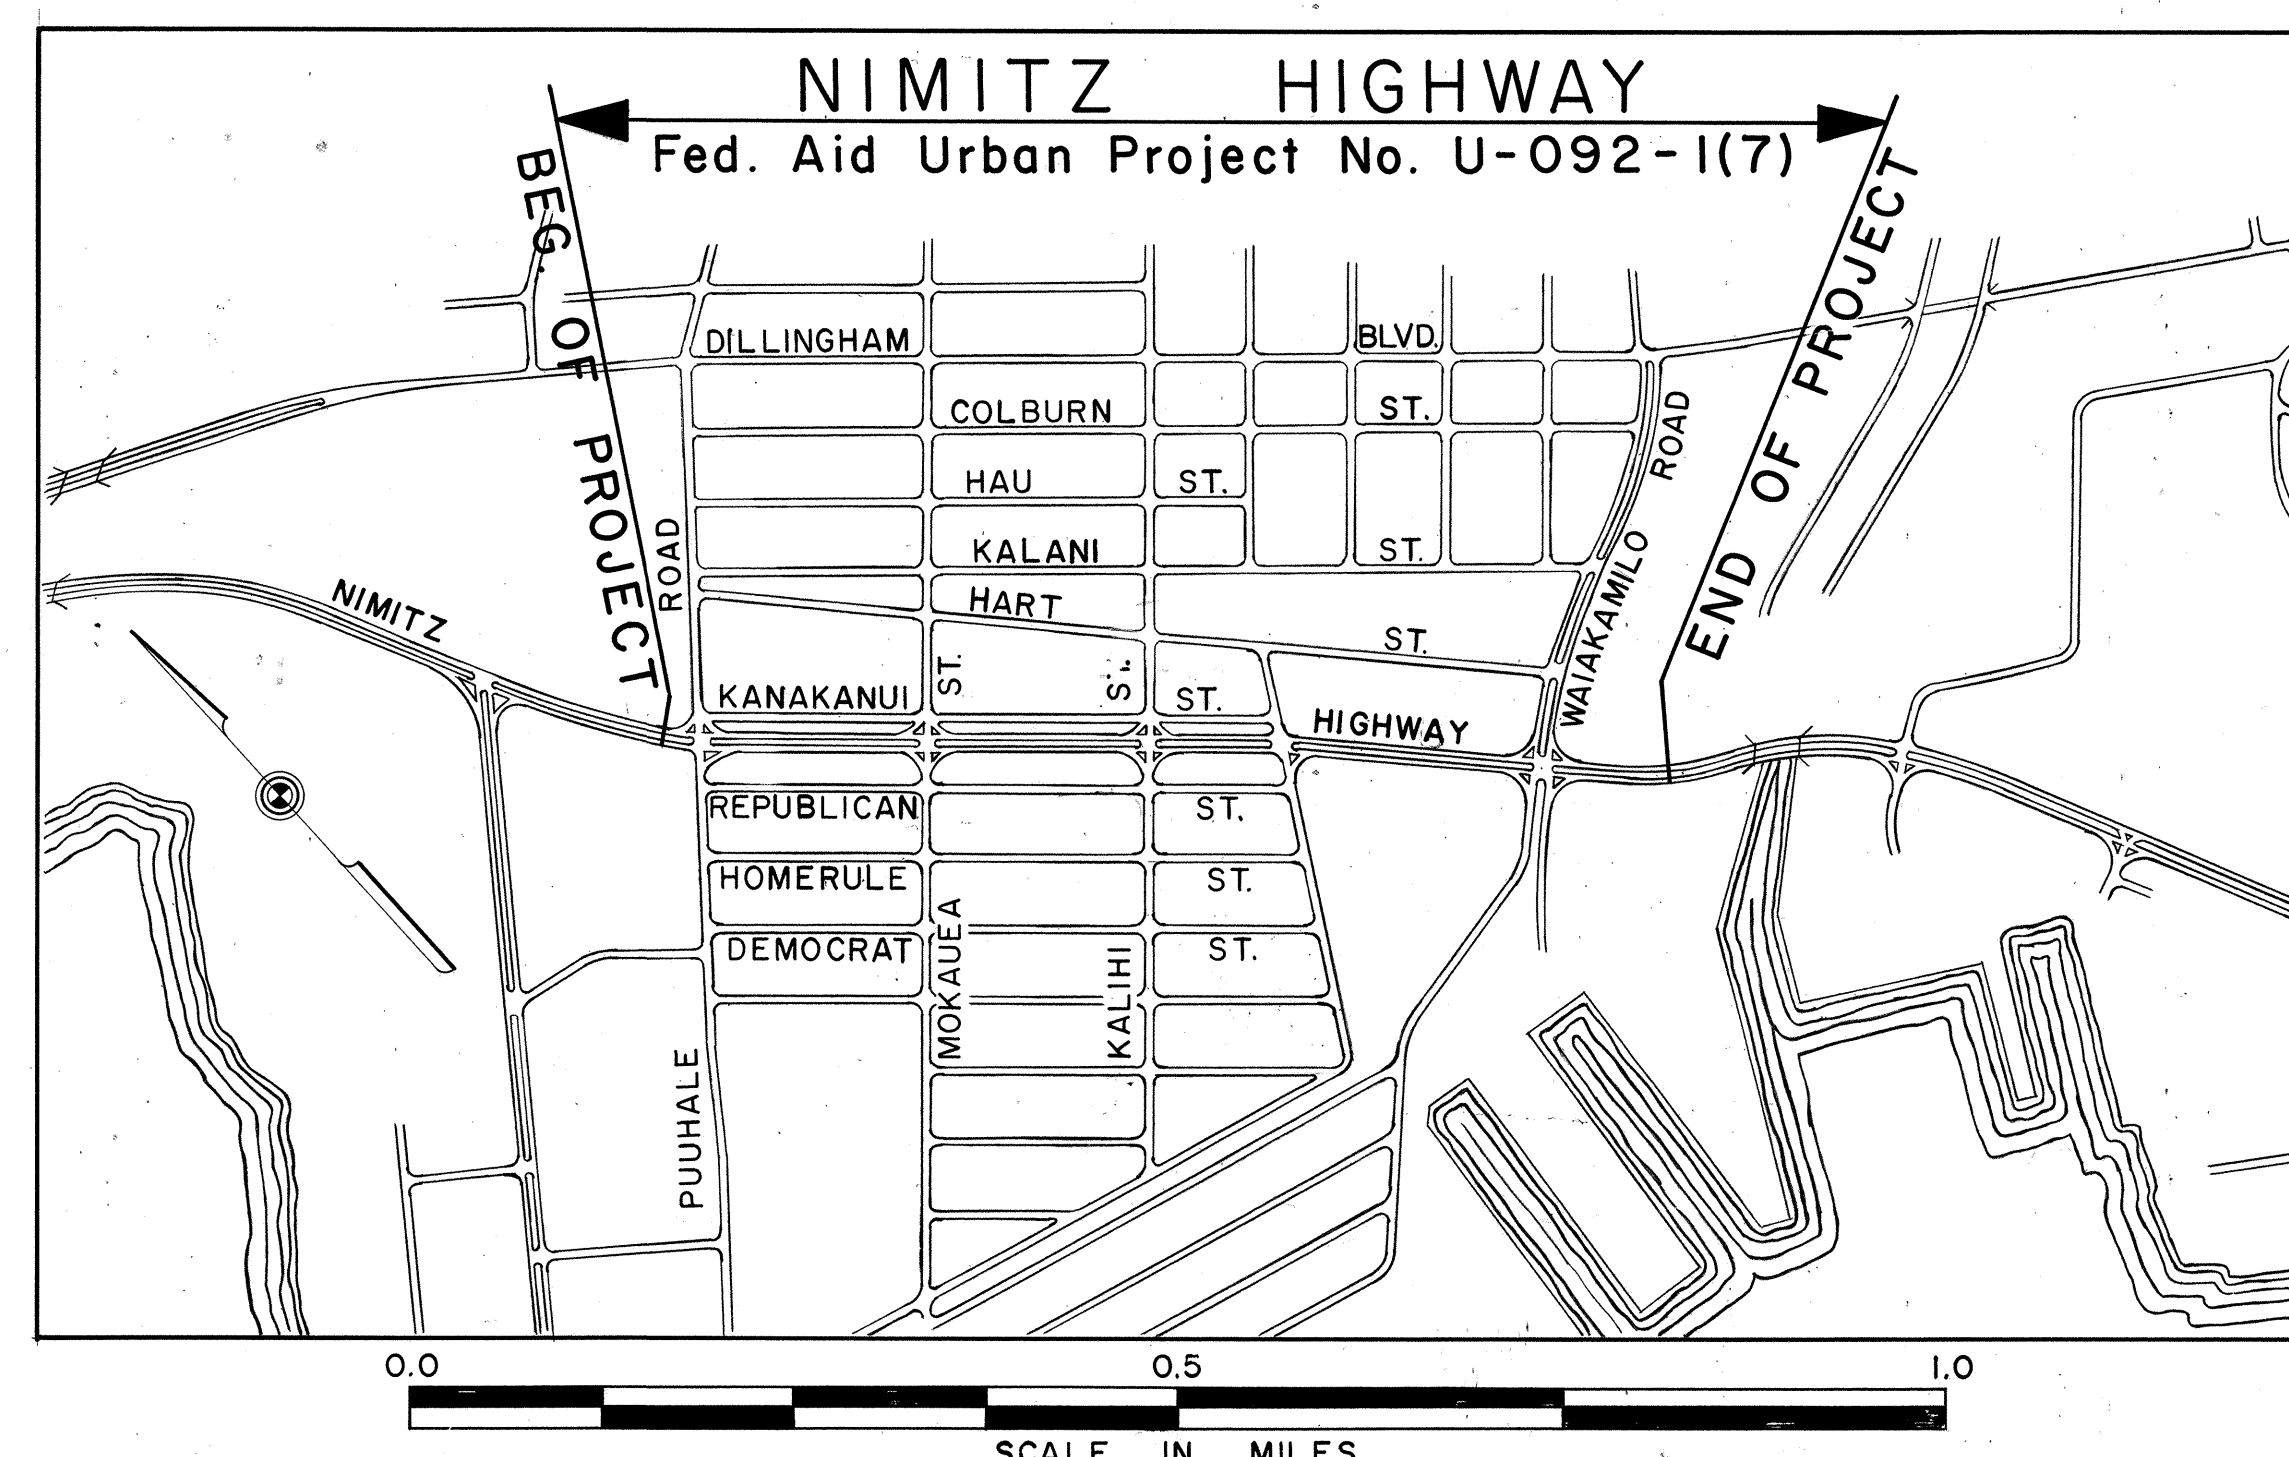


[illegible]

FED ROAD DIST. NO	STATE	FED. AID PROJ. NO.	FISCAL YEAR	SHEET NO.	TOTAL SHEETS
HAWAII	HAW.	U-092-1(7)	1968	1	10

STATE OF HAWAII  
DEPARTMENT OF TRANSPORTATION  
HIGHWAYS DIVISION  
HONOLULU, HAWAII  
"AS BUILT"  
PLANS FOR  
CONSTRUCTION OF  
INTERSECTION IMPROVEMENTS  
ON  
NIMITZ HIGHWAY  
PUUHALE ROAD TO WAIKAMULO ROAD  
FEDERAL AID URBAN PROJECT NO. U-092-1(7)  
DISTRICT OF HONOLULU  
ISLAND OF OAHU

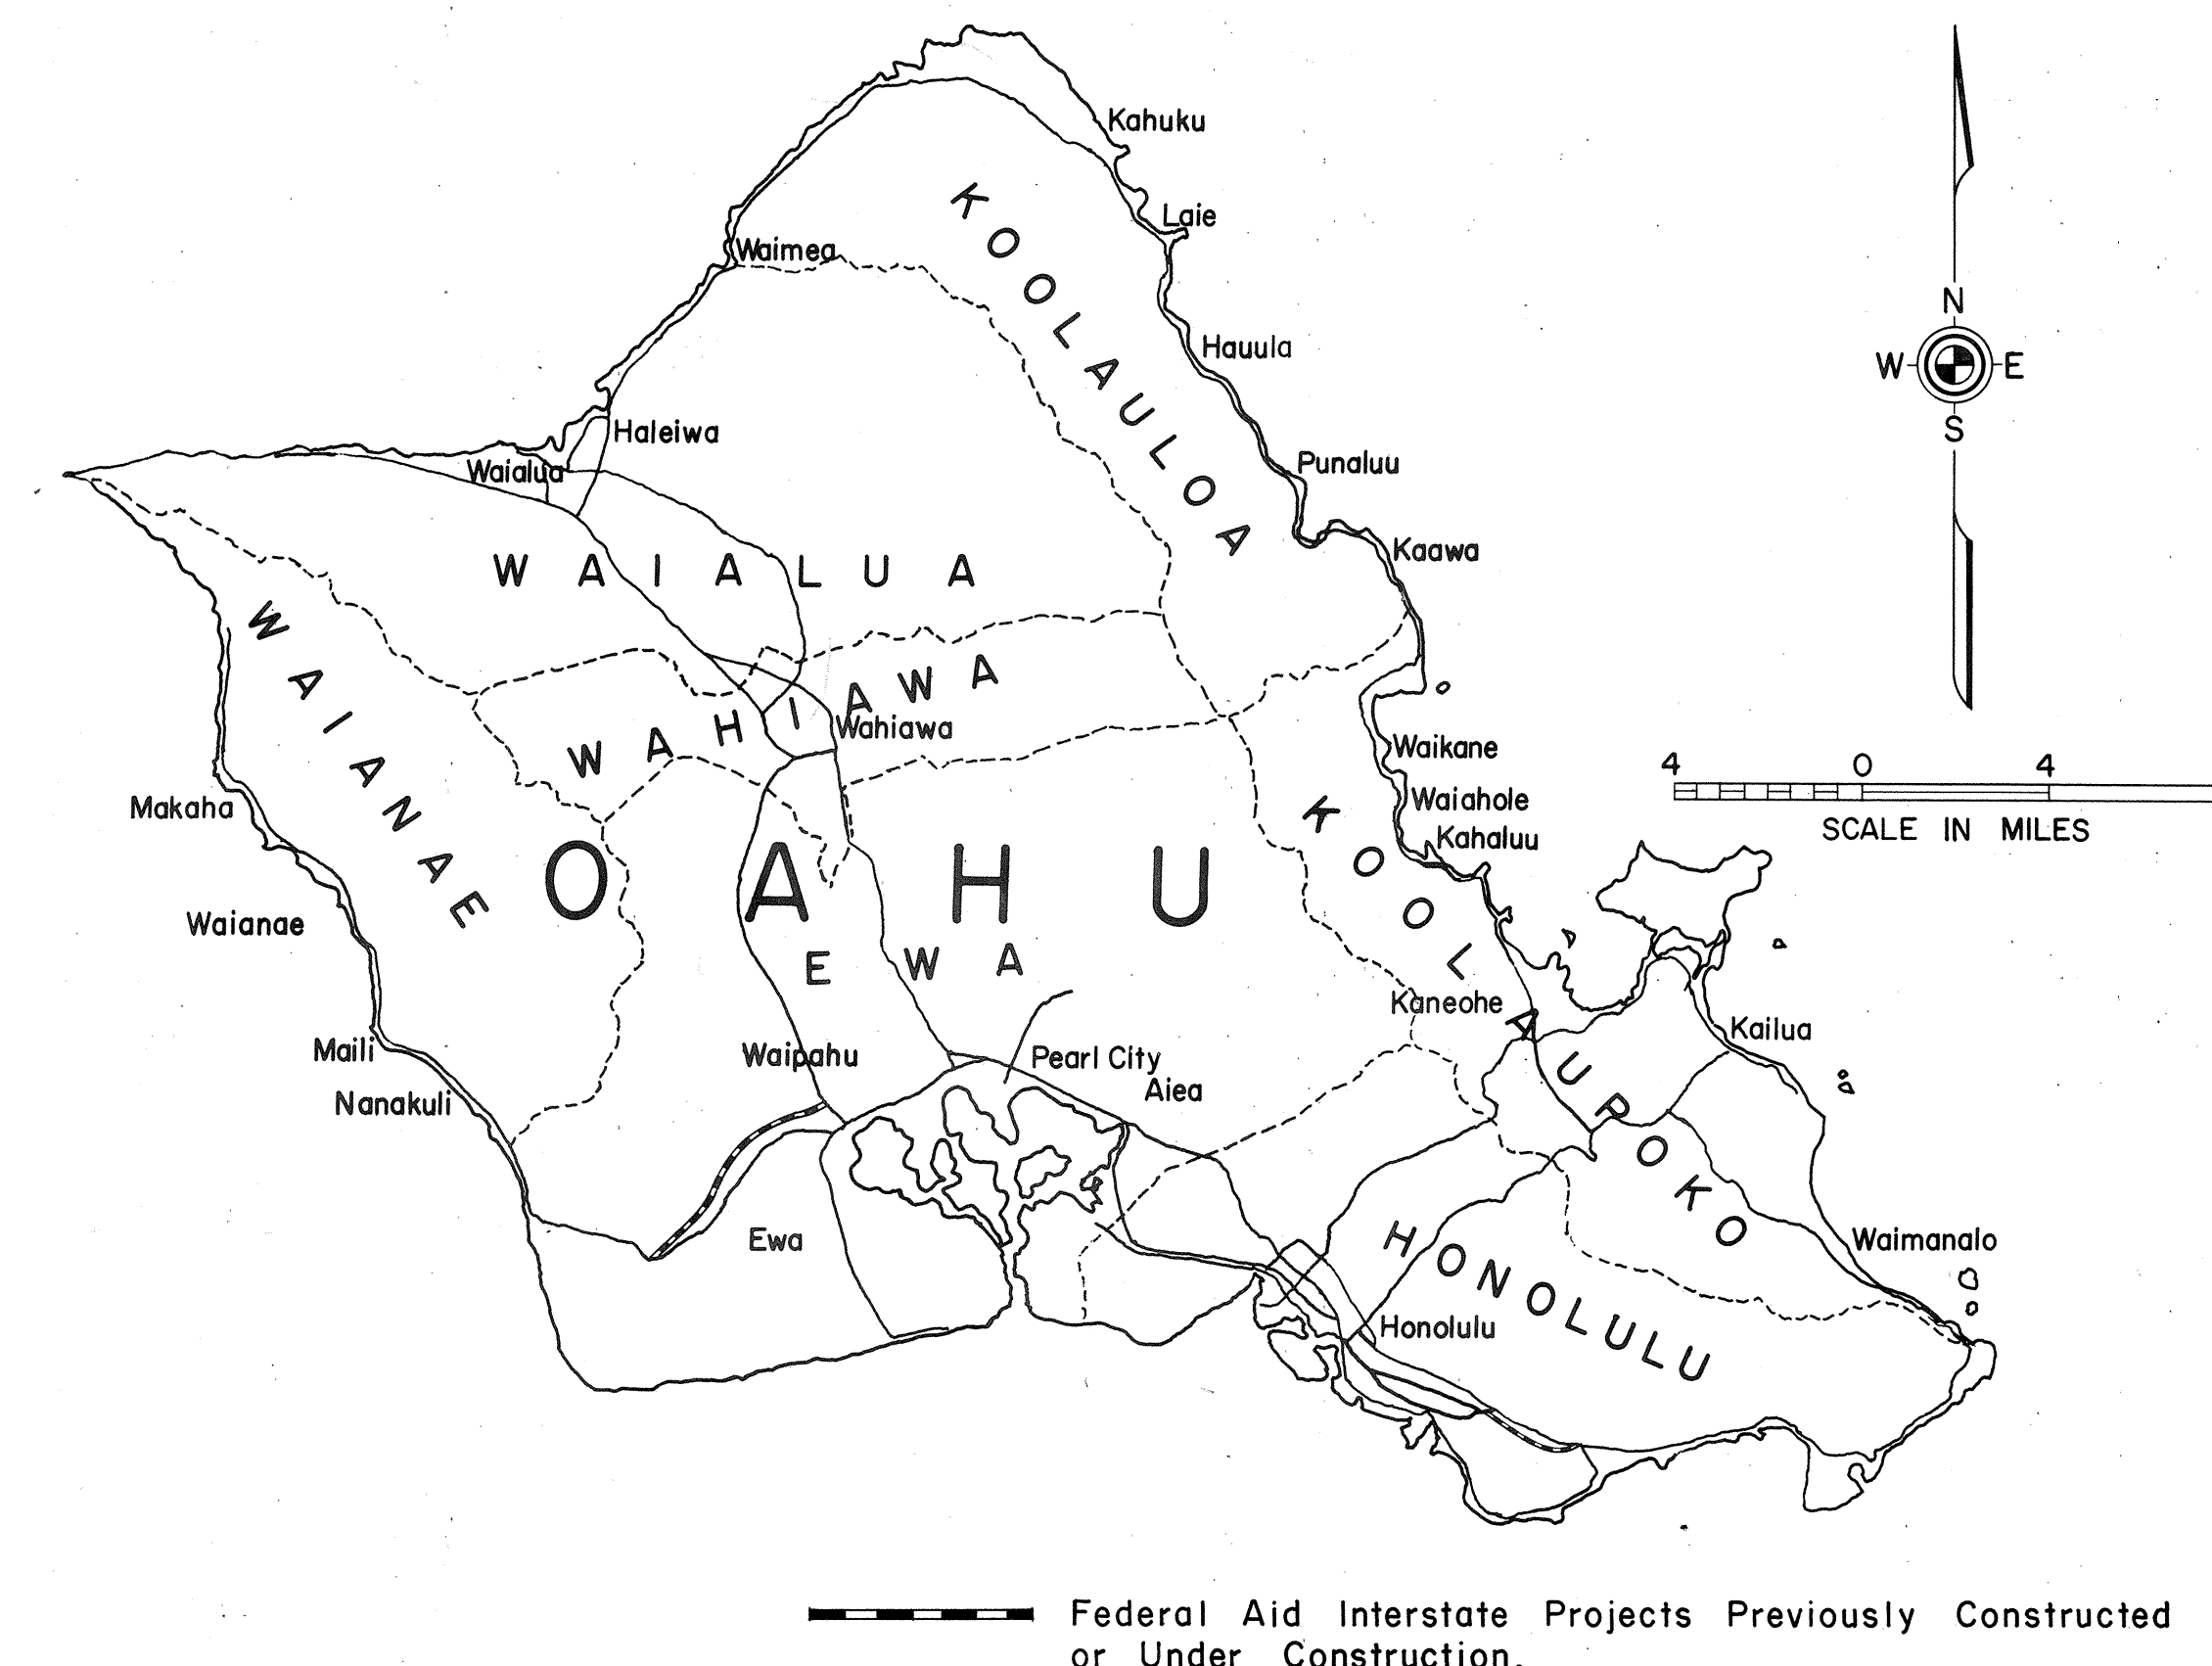

NOTE :  
ALL CHANGES MADE DURING CONSTRUCTION  
HAVE BEEN NOTED ON THESE TRACINGS IN  
RED AND CHECKED BY :

Mike Flynn  
PROJECT ENGINEER  
Feb. 25, 1969  
DATE

DEPARTMENT OF COMMERCE BUREAU OF PUBLIC ROADS	
APPROVED: <i>Neil J. Delabough</i>	
FOR DIVISION ENGINEER	4-10-6 DATE

<p align="center"><b>DEPARTMENT OF TRANSPORTATION STATE OF HAWAII</b></p>	
<p><b>APPROVED:</b></p> <p><i>John W. McArthur Jr</i></p> <p><b><u>DIR. OF TRANSPORTATION</u></b></p>	<p><u>3/25/68</u></p> <p><b><u>DATE</u></b></p>

LENGTH OF PROJECT..... 0.648 MILE..... CURRENT ADT (1968)..... 42,000