
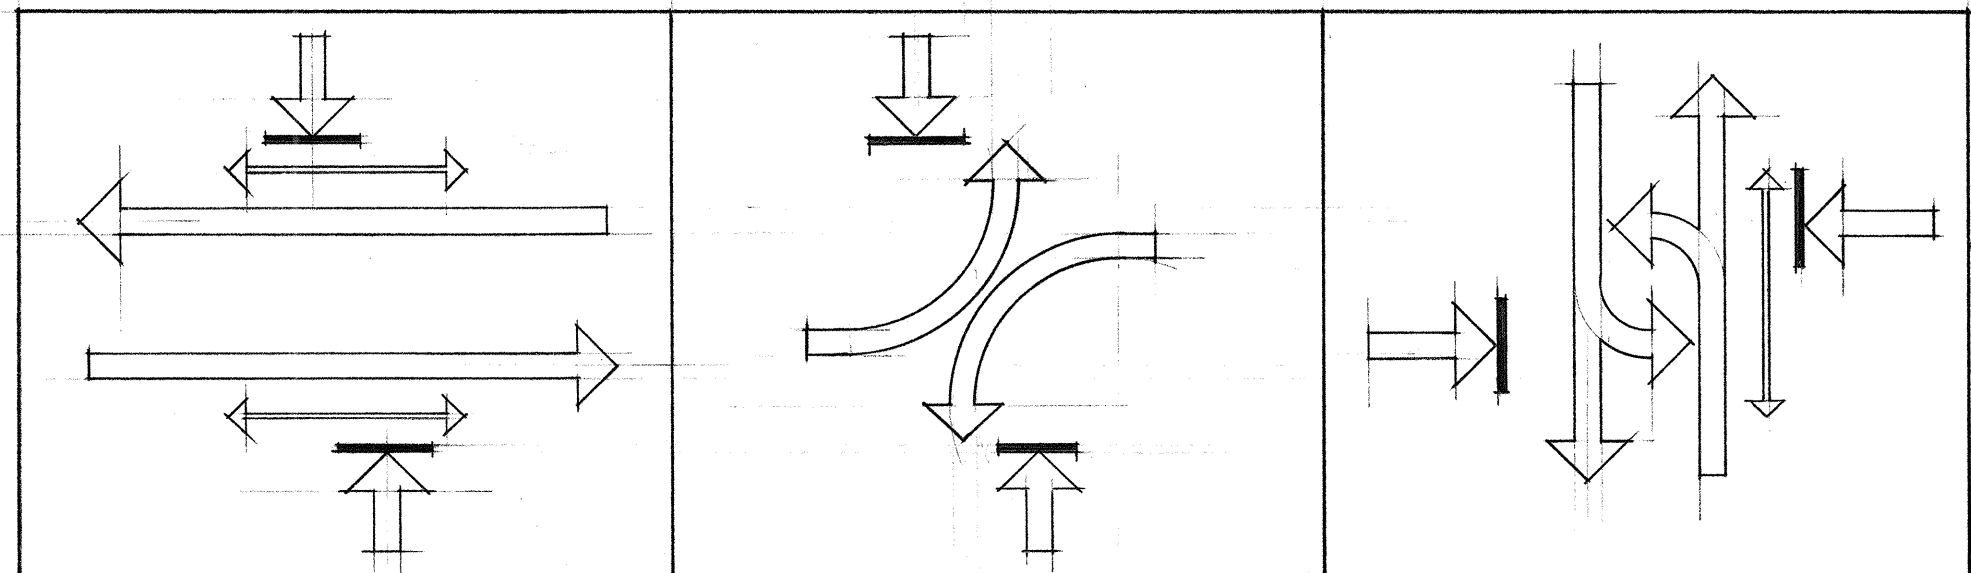


FED. ROAD DIST. NO.	STATE	FED. AID PROJ. NO.	FISCAL YEAR	SHEET NO.	TOTAL SHEETS
HAWAII	HAW.	U-092-1(7)	1968	4	10

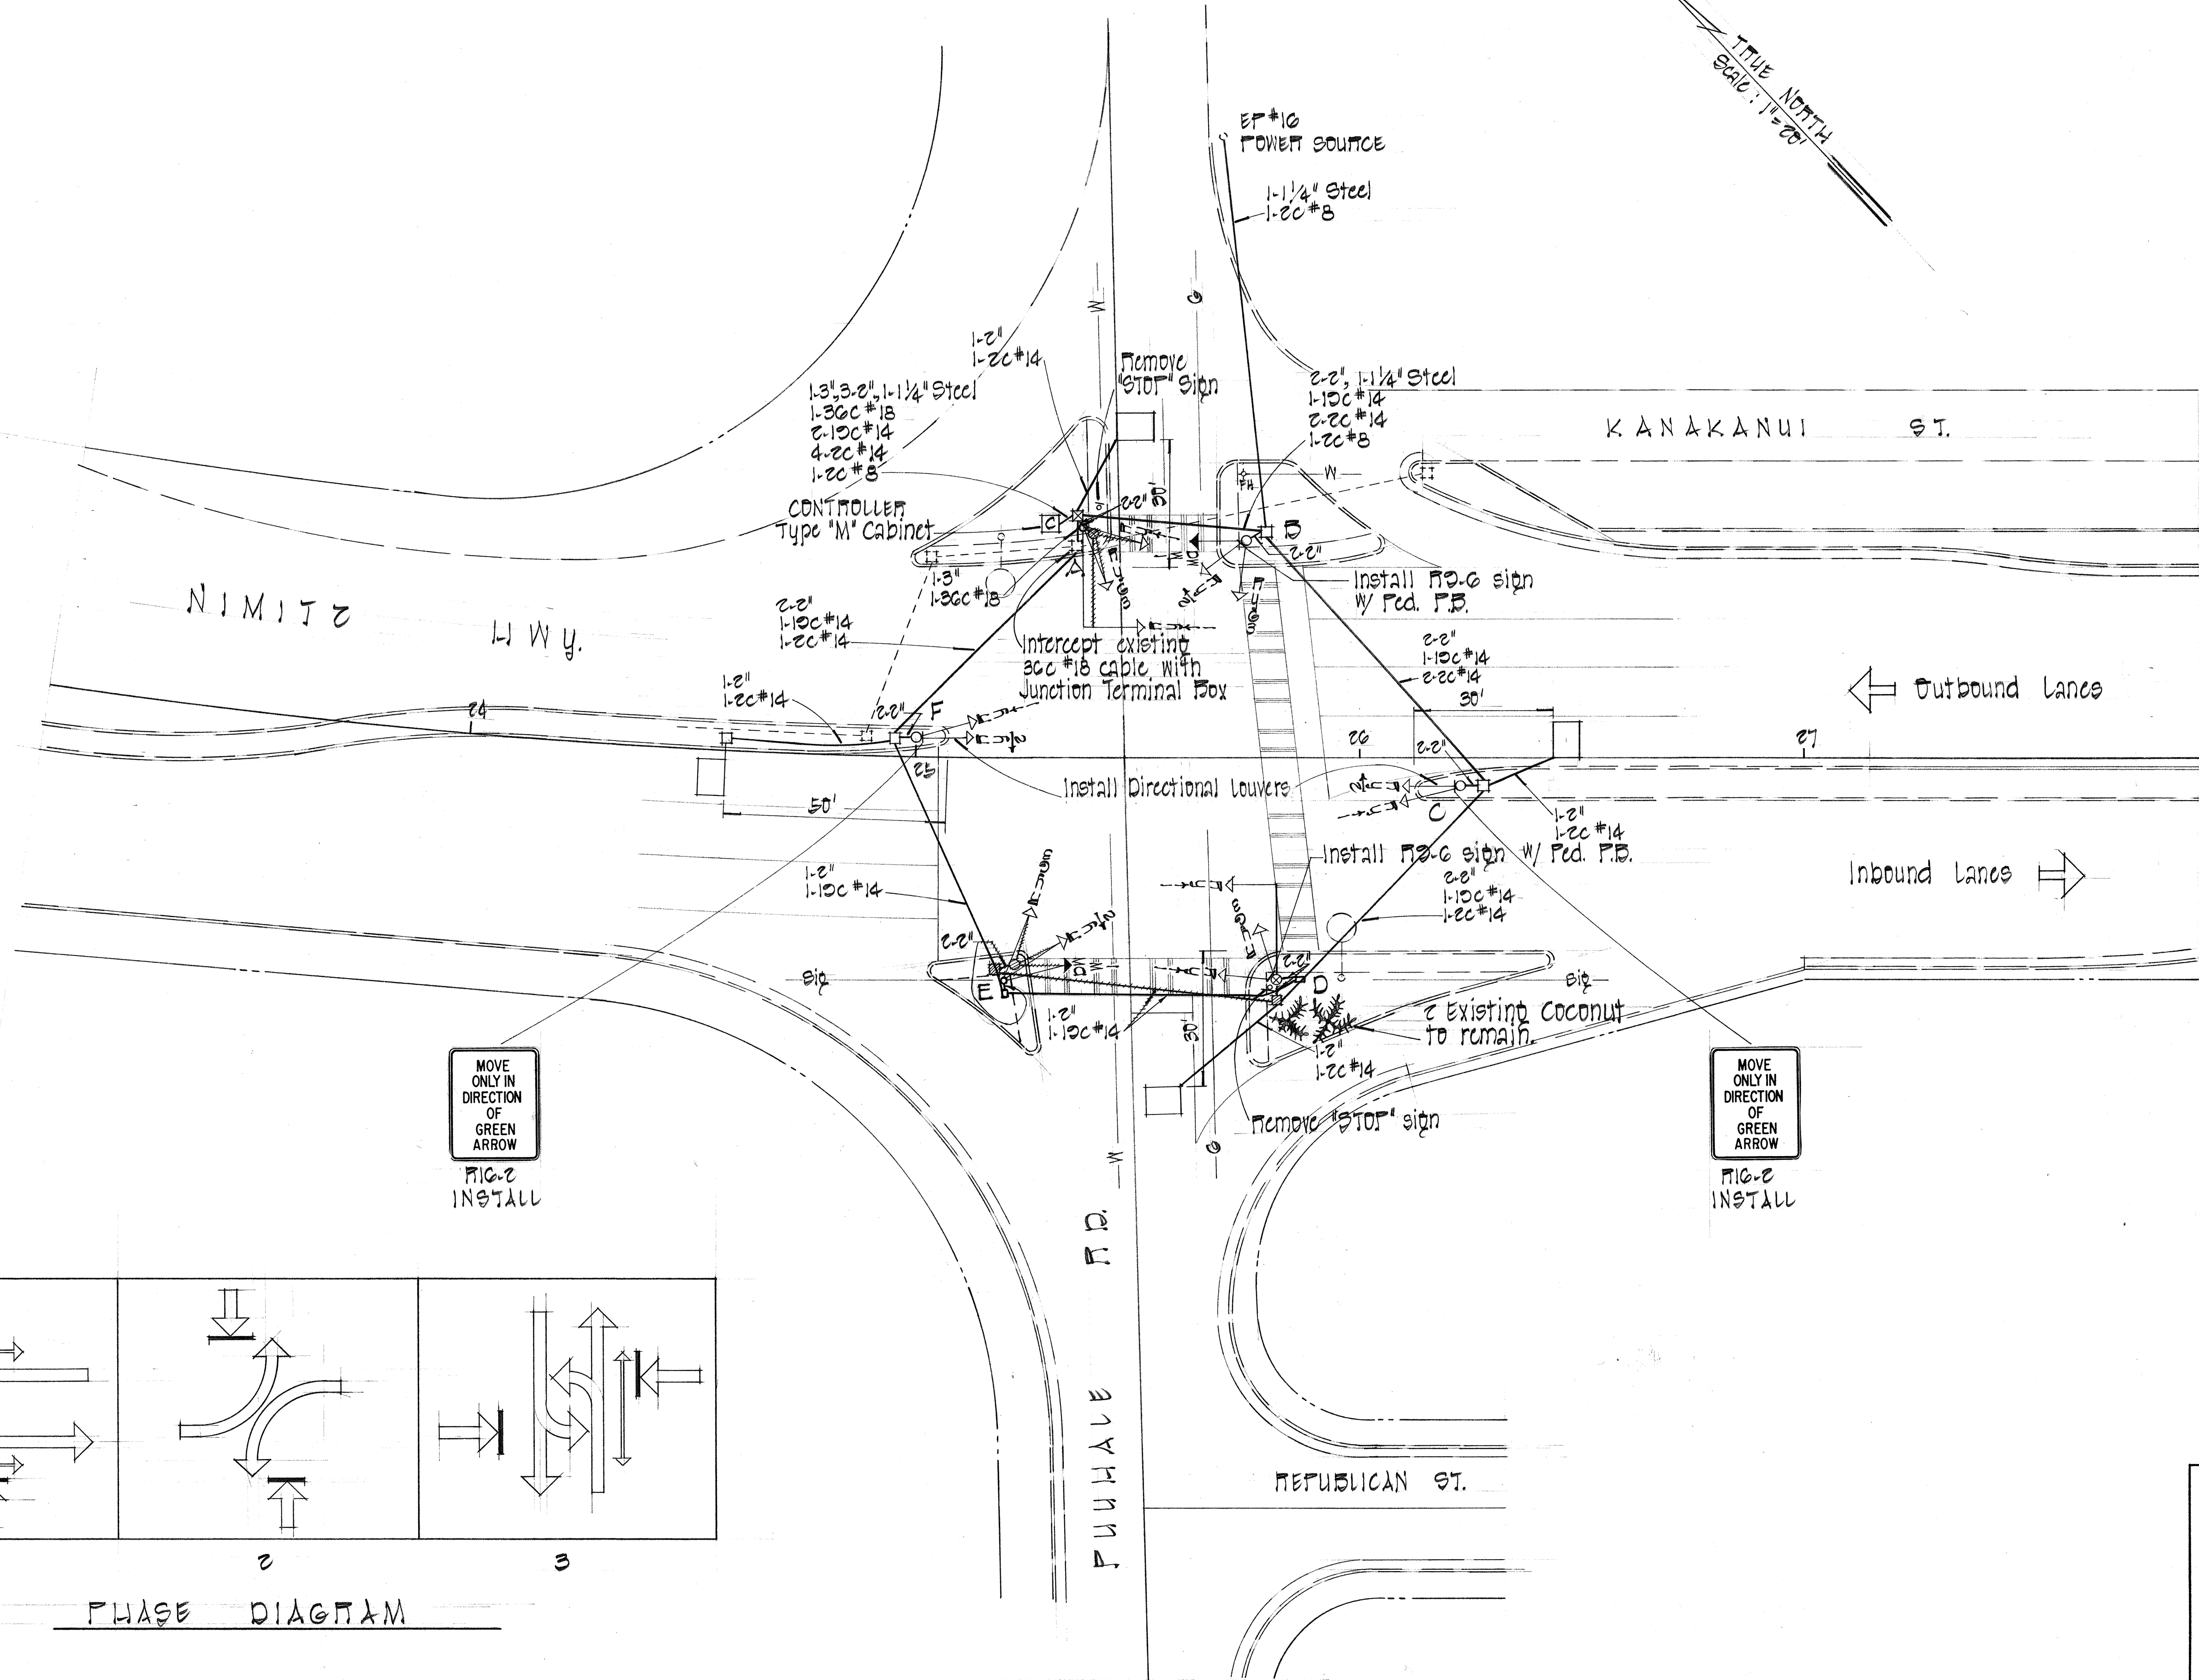

PHASE DIAGRAM

DATE	BY
DESIGNED BY	BY
NOTED BY	BY
CHECKED BY	BY
ORIGINAL PLAN	BY
NOTE BOOK	BY
No.	

STATE OF HAWAII
DEPARTMENT OF TRANSPORTATION
HIGHWAYS DIVISION

TRAFFIC SIGNAL SYSTEM
NIMITZ HWY. AT PUUHALE RD.
F.A. Proj. No. U-092-1(7)

Scale: As Shown
March 1968

SHEET No. 4 OF 10 SHEETS