
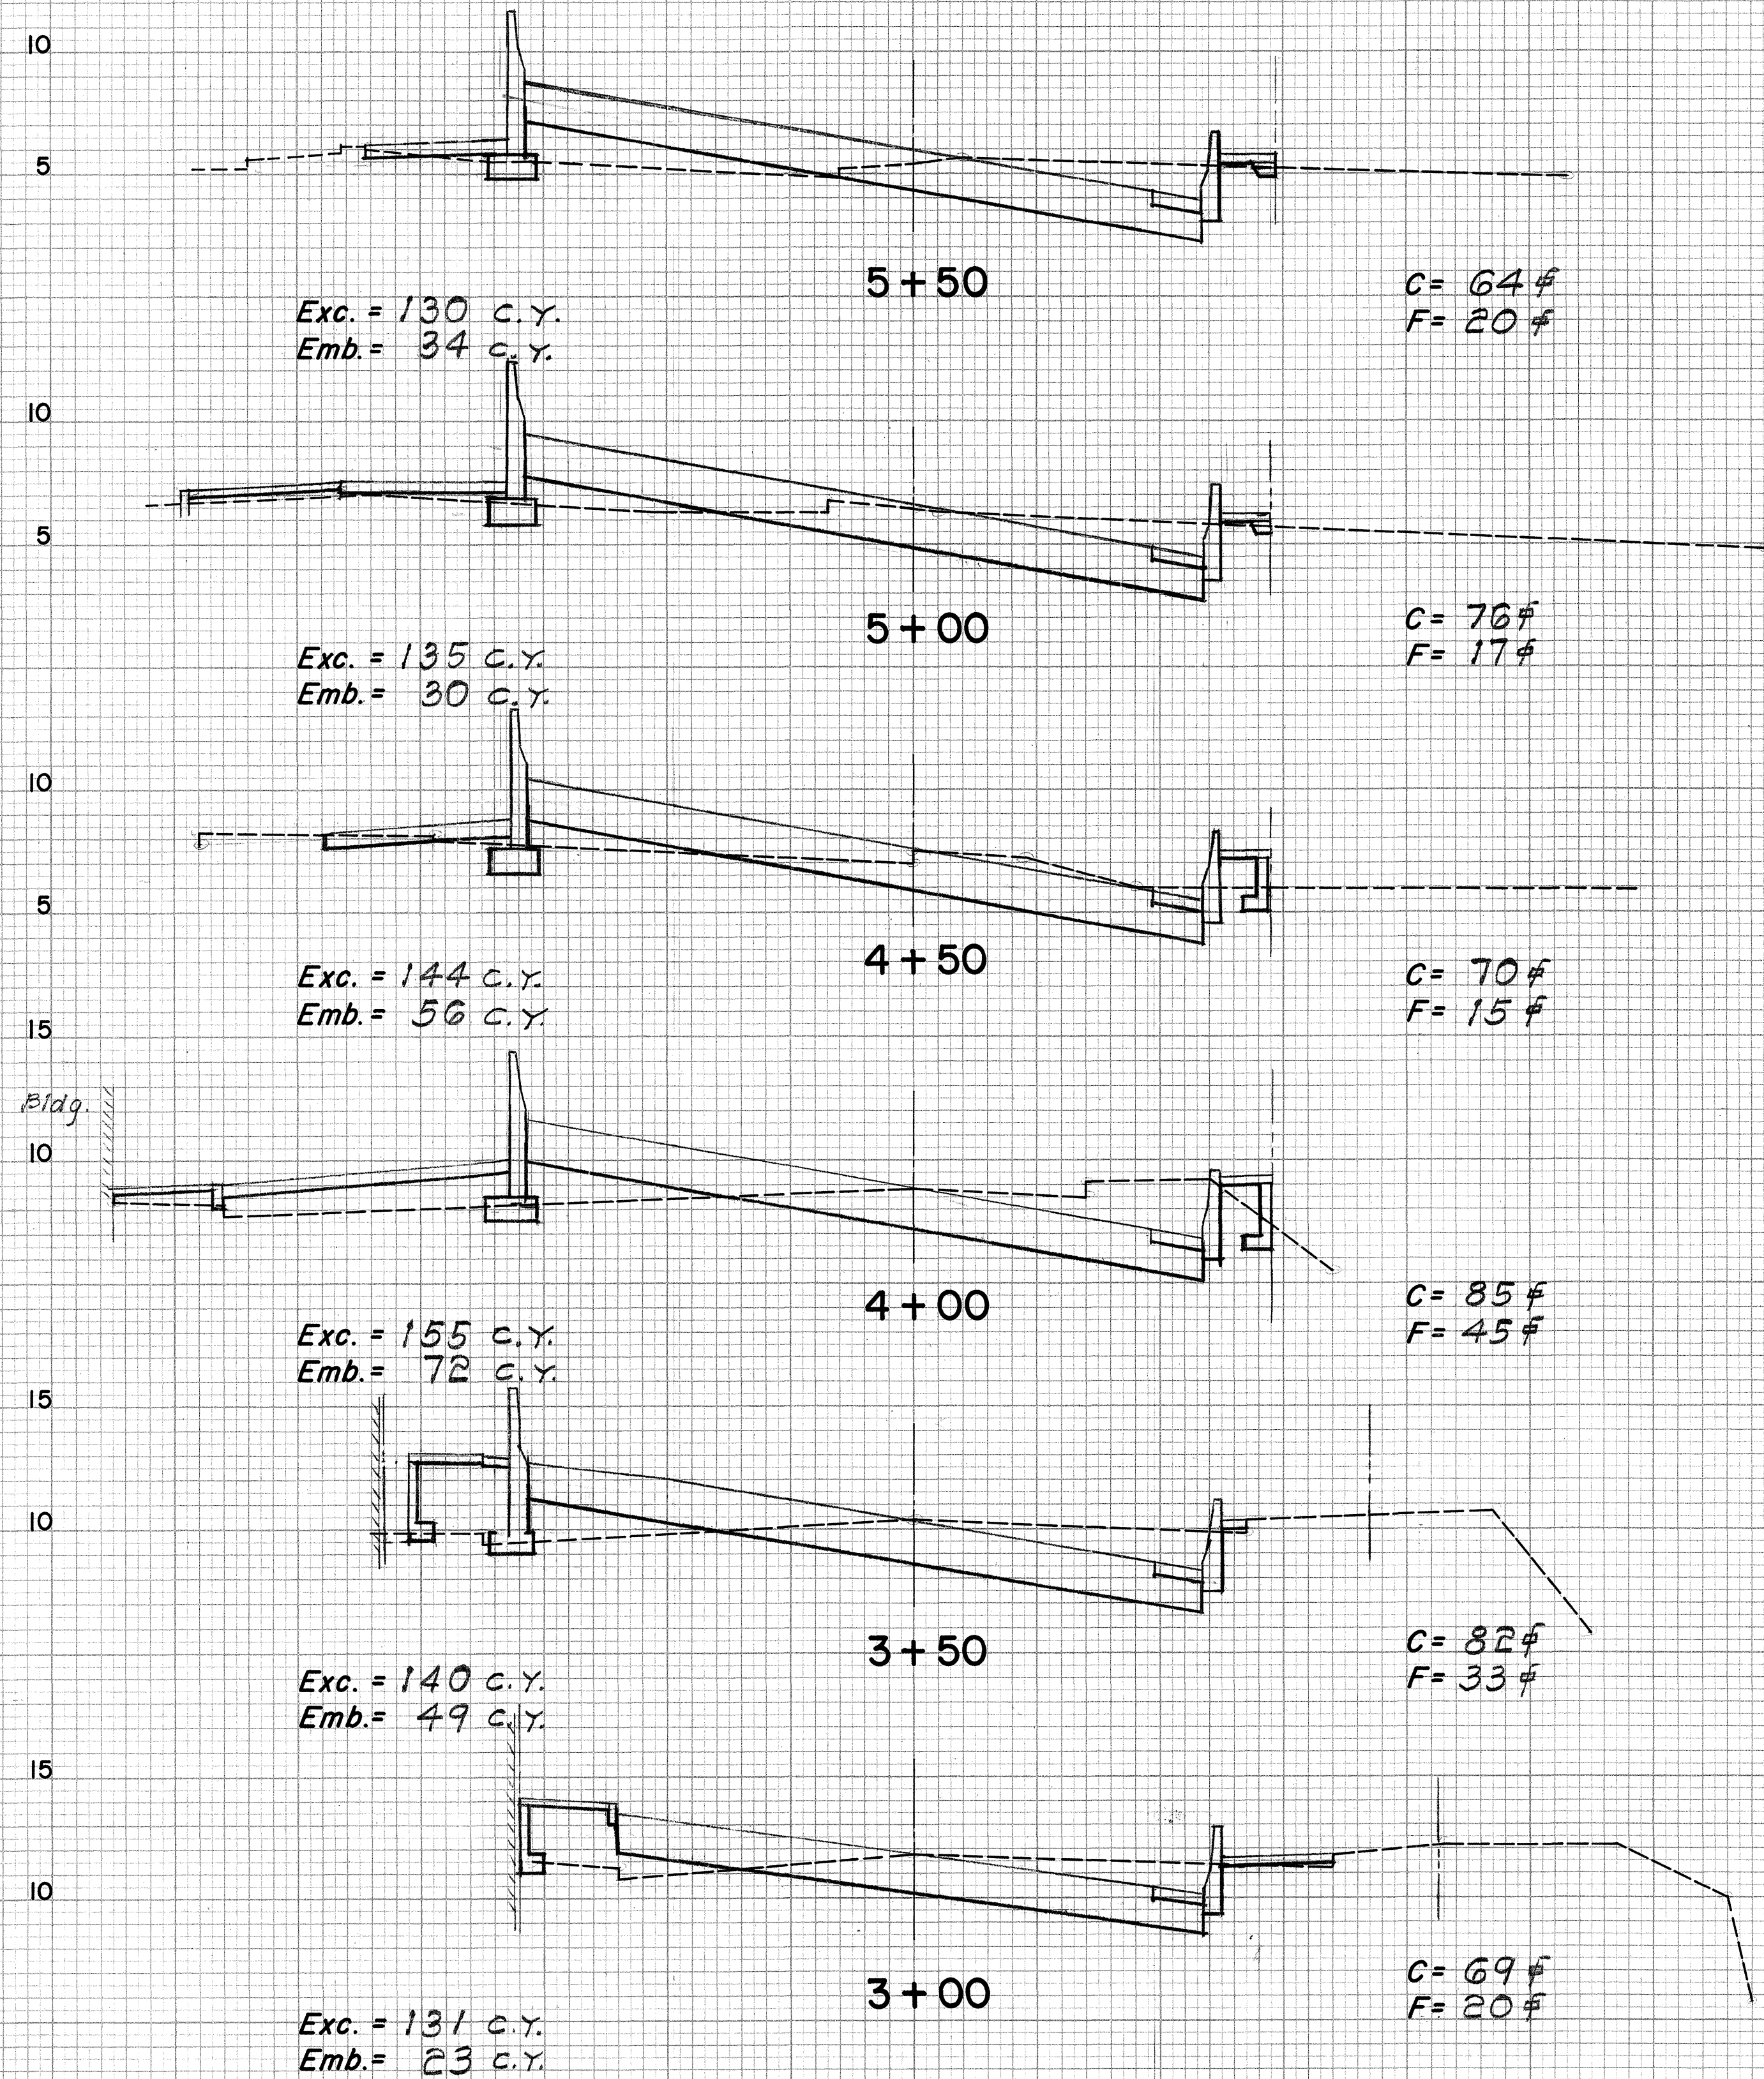


FED. ROAD DIST. NO.	STATE	FED. AID PROJ. NO.	FISCAL YEAR	SHEET NO.	TOTAL SHEETS
HAWAII	HAW.	U-092-1(8)	1970	32	40

FINAL SURVEY	BY	DATE
SURVEYED		
PLOTTED		
TEMPLATE		
AREAS		
AREAS CHECKED		
NO.		

ORIGINAL SURVEY		BY	DATE
NOTE BOOK			
SURVED			
PLOTTED			
TEMPLATE			
AREAS			
AREAS CHECKED			
NID			

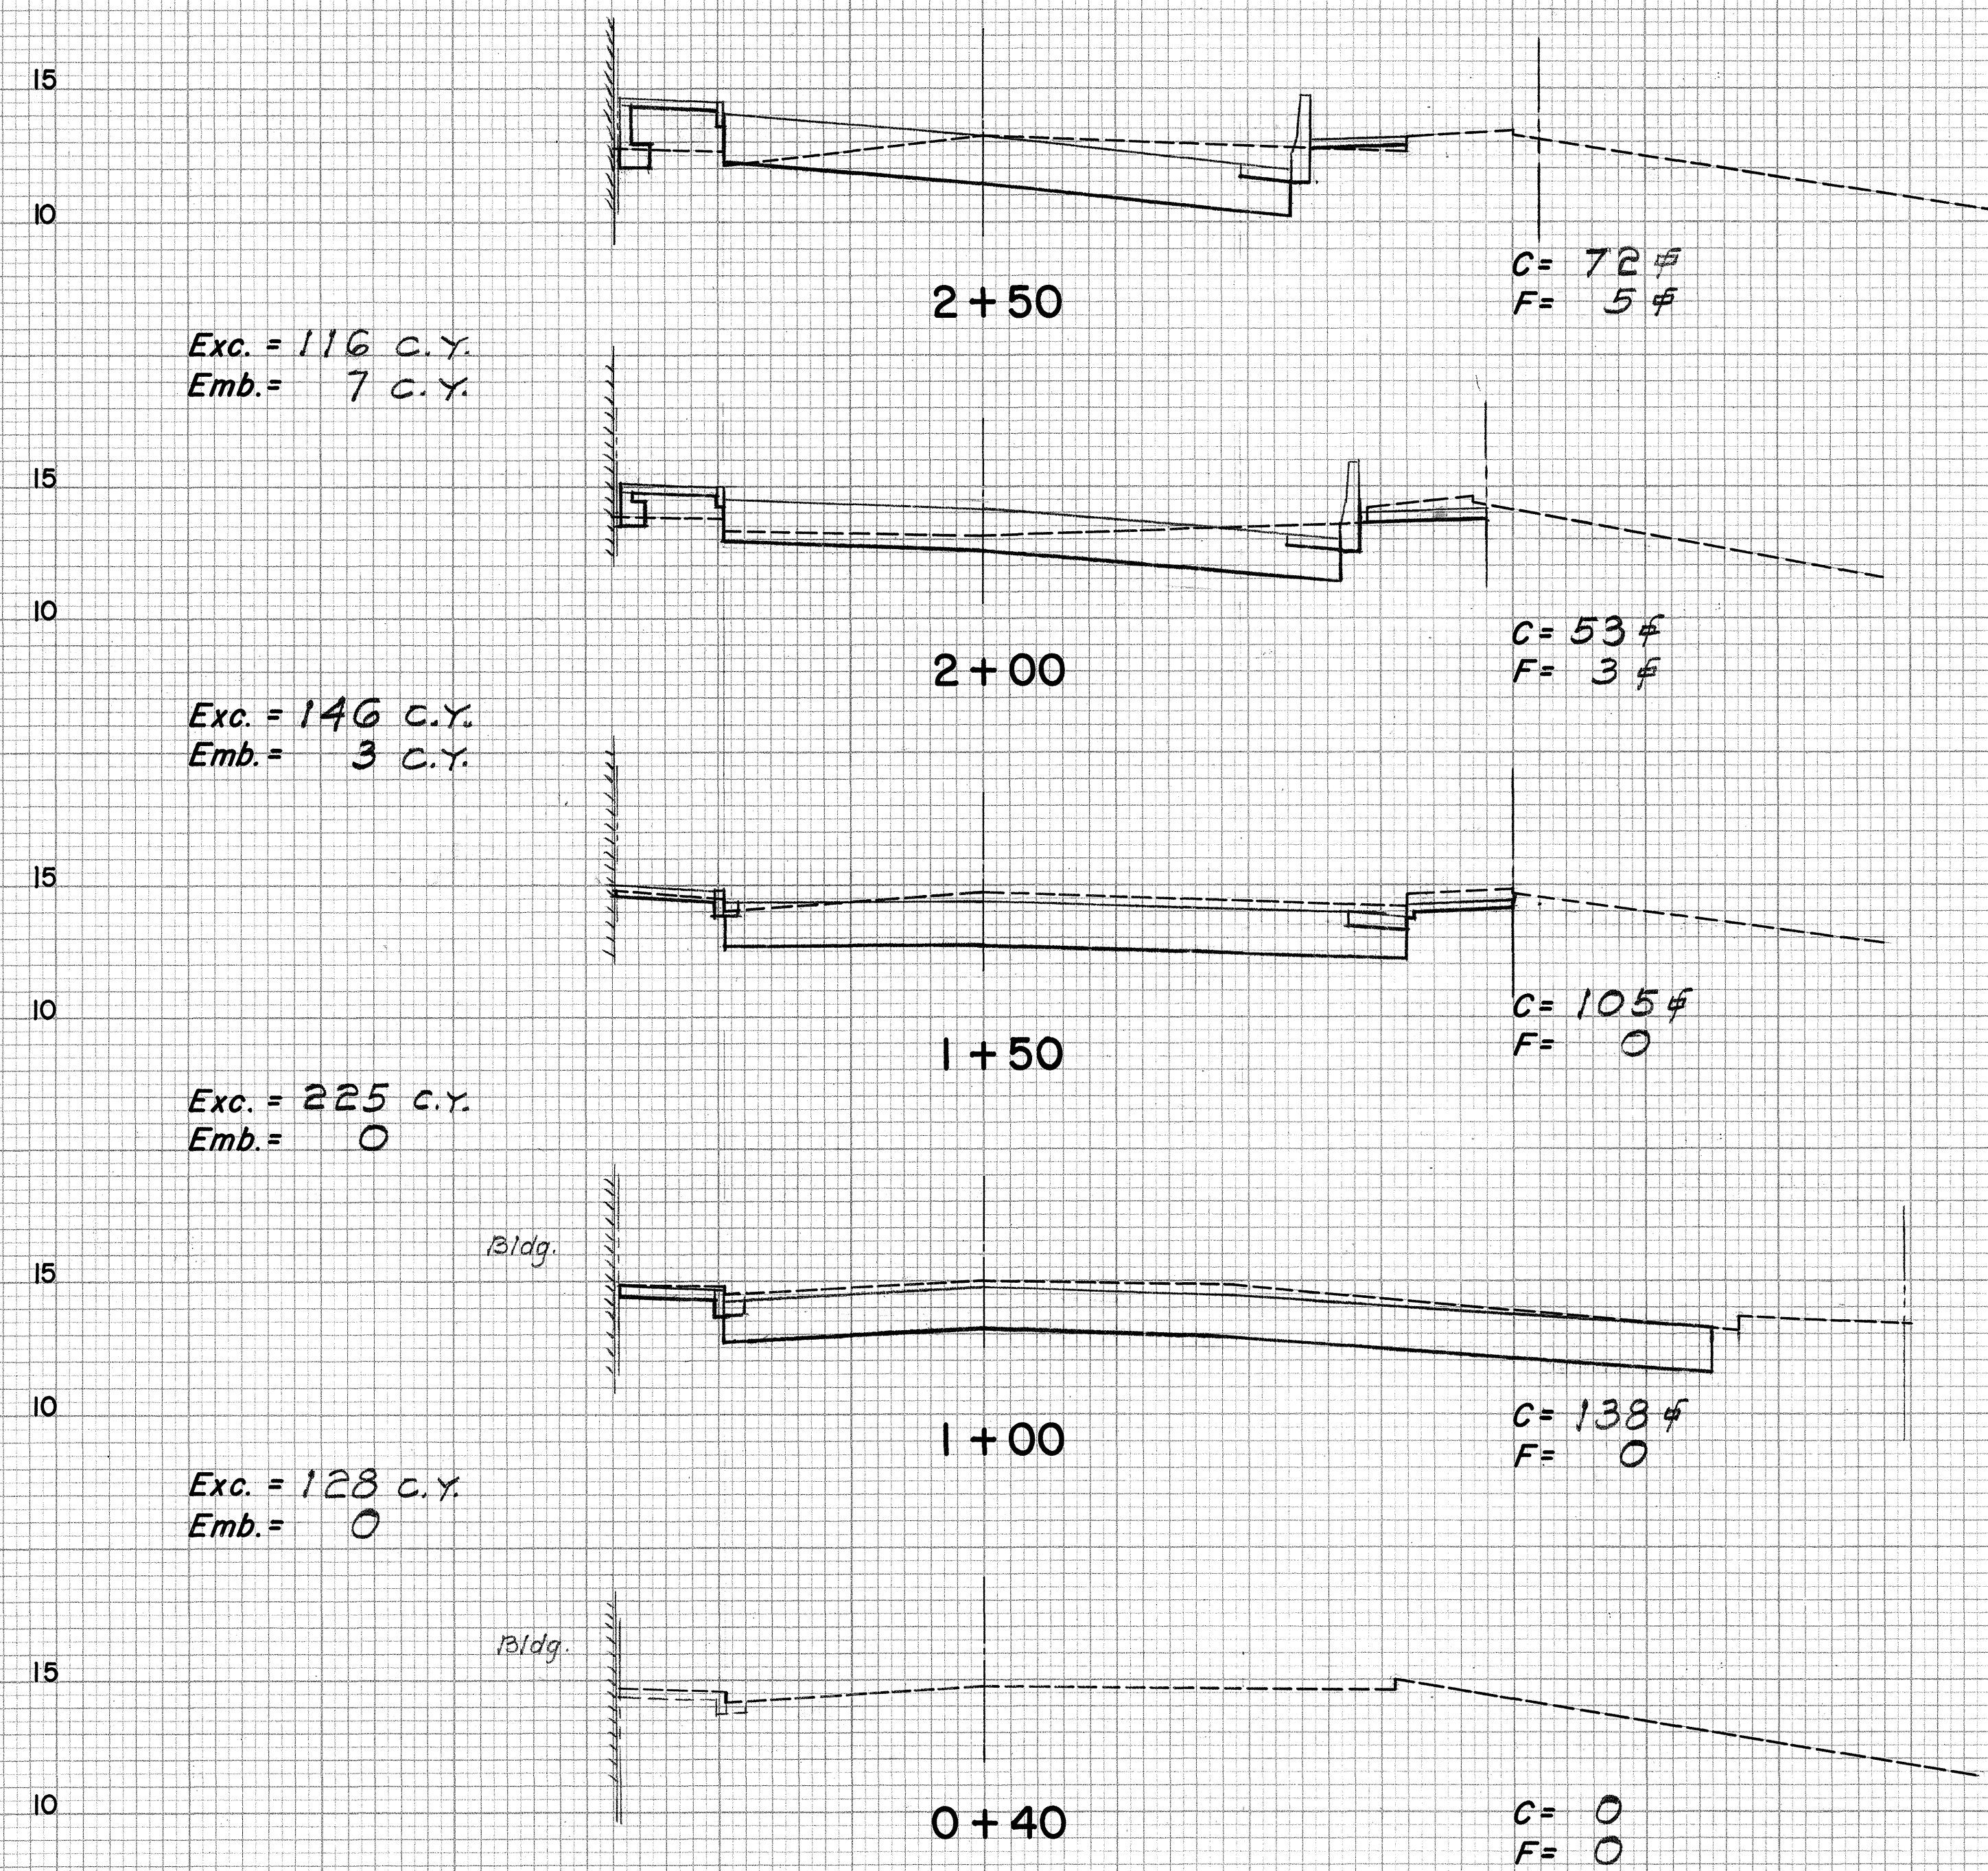

Scale: Horiz. 1" = 10'
Vert. 1" = 5'

PLATE 3 CROSS SECTION B P R STANDARD
EUGENE DIETZGEN CO., CHICAGO - NEW YORK

Printed in U.S.A.
On IMPERIAL Tracing Cloth



THIS WORK WAS PREPARED BY
ME OR UNDER MY SUPERVISION.



Ronald T. Yama

40 50 60
32 SHEET NO. 1 OF 2 SHEETS Printed in U.S.A.
On IMPERIAL Tracing Cloth


FED. ROAD DIST. NO.	STATE	FED. AID PROJ. NO.	FISCAL YEAR	SHEET NO.	TOTAL SHEETS
HAWAII	HAW.	U-092-1(8)	1970	33	41

DATE	BY
NO.	NO.
ORIGINAL SURVEY	FINAL SURVEY
NOTE BOOK	NOTE BOOK
TEMP.	TEMP.
AREAS CHECKED	AREAS CHECKED

DATE	BY
NO.	NO.
ORIGINAL SURVEY	FINAL SURVEY
NOTE BOOK	NOTE BOOK
TEMP.	TEMP.
AREAS CHECKED	AREAS CHECKED

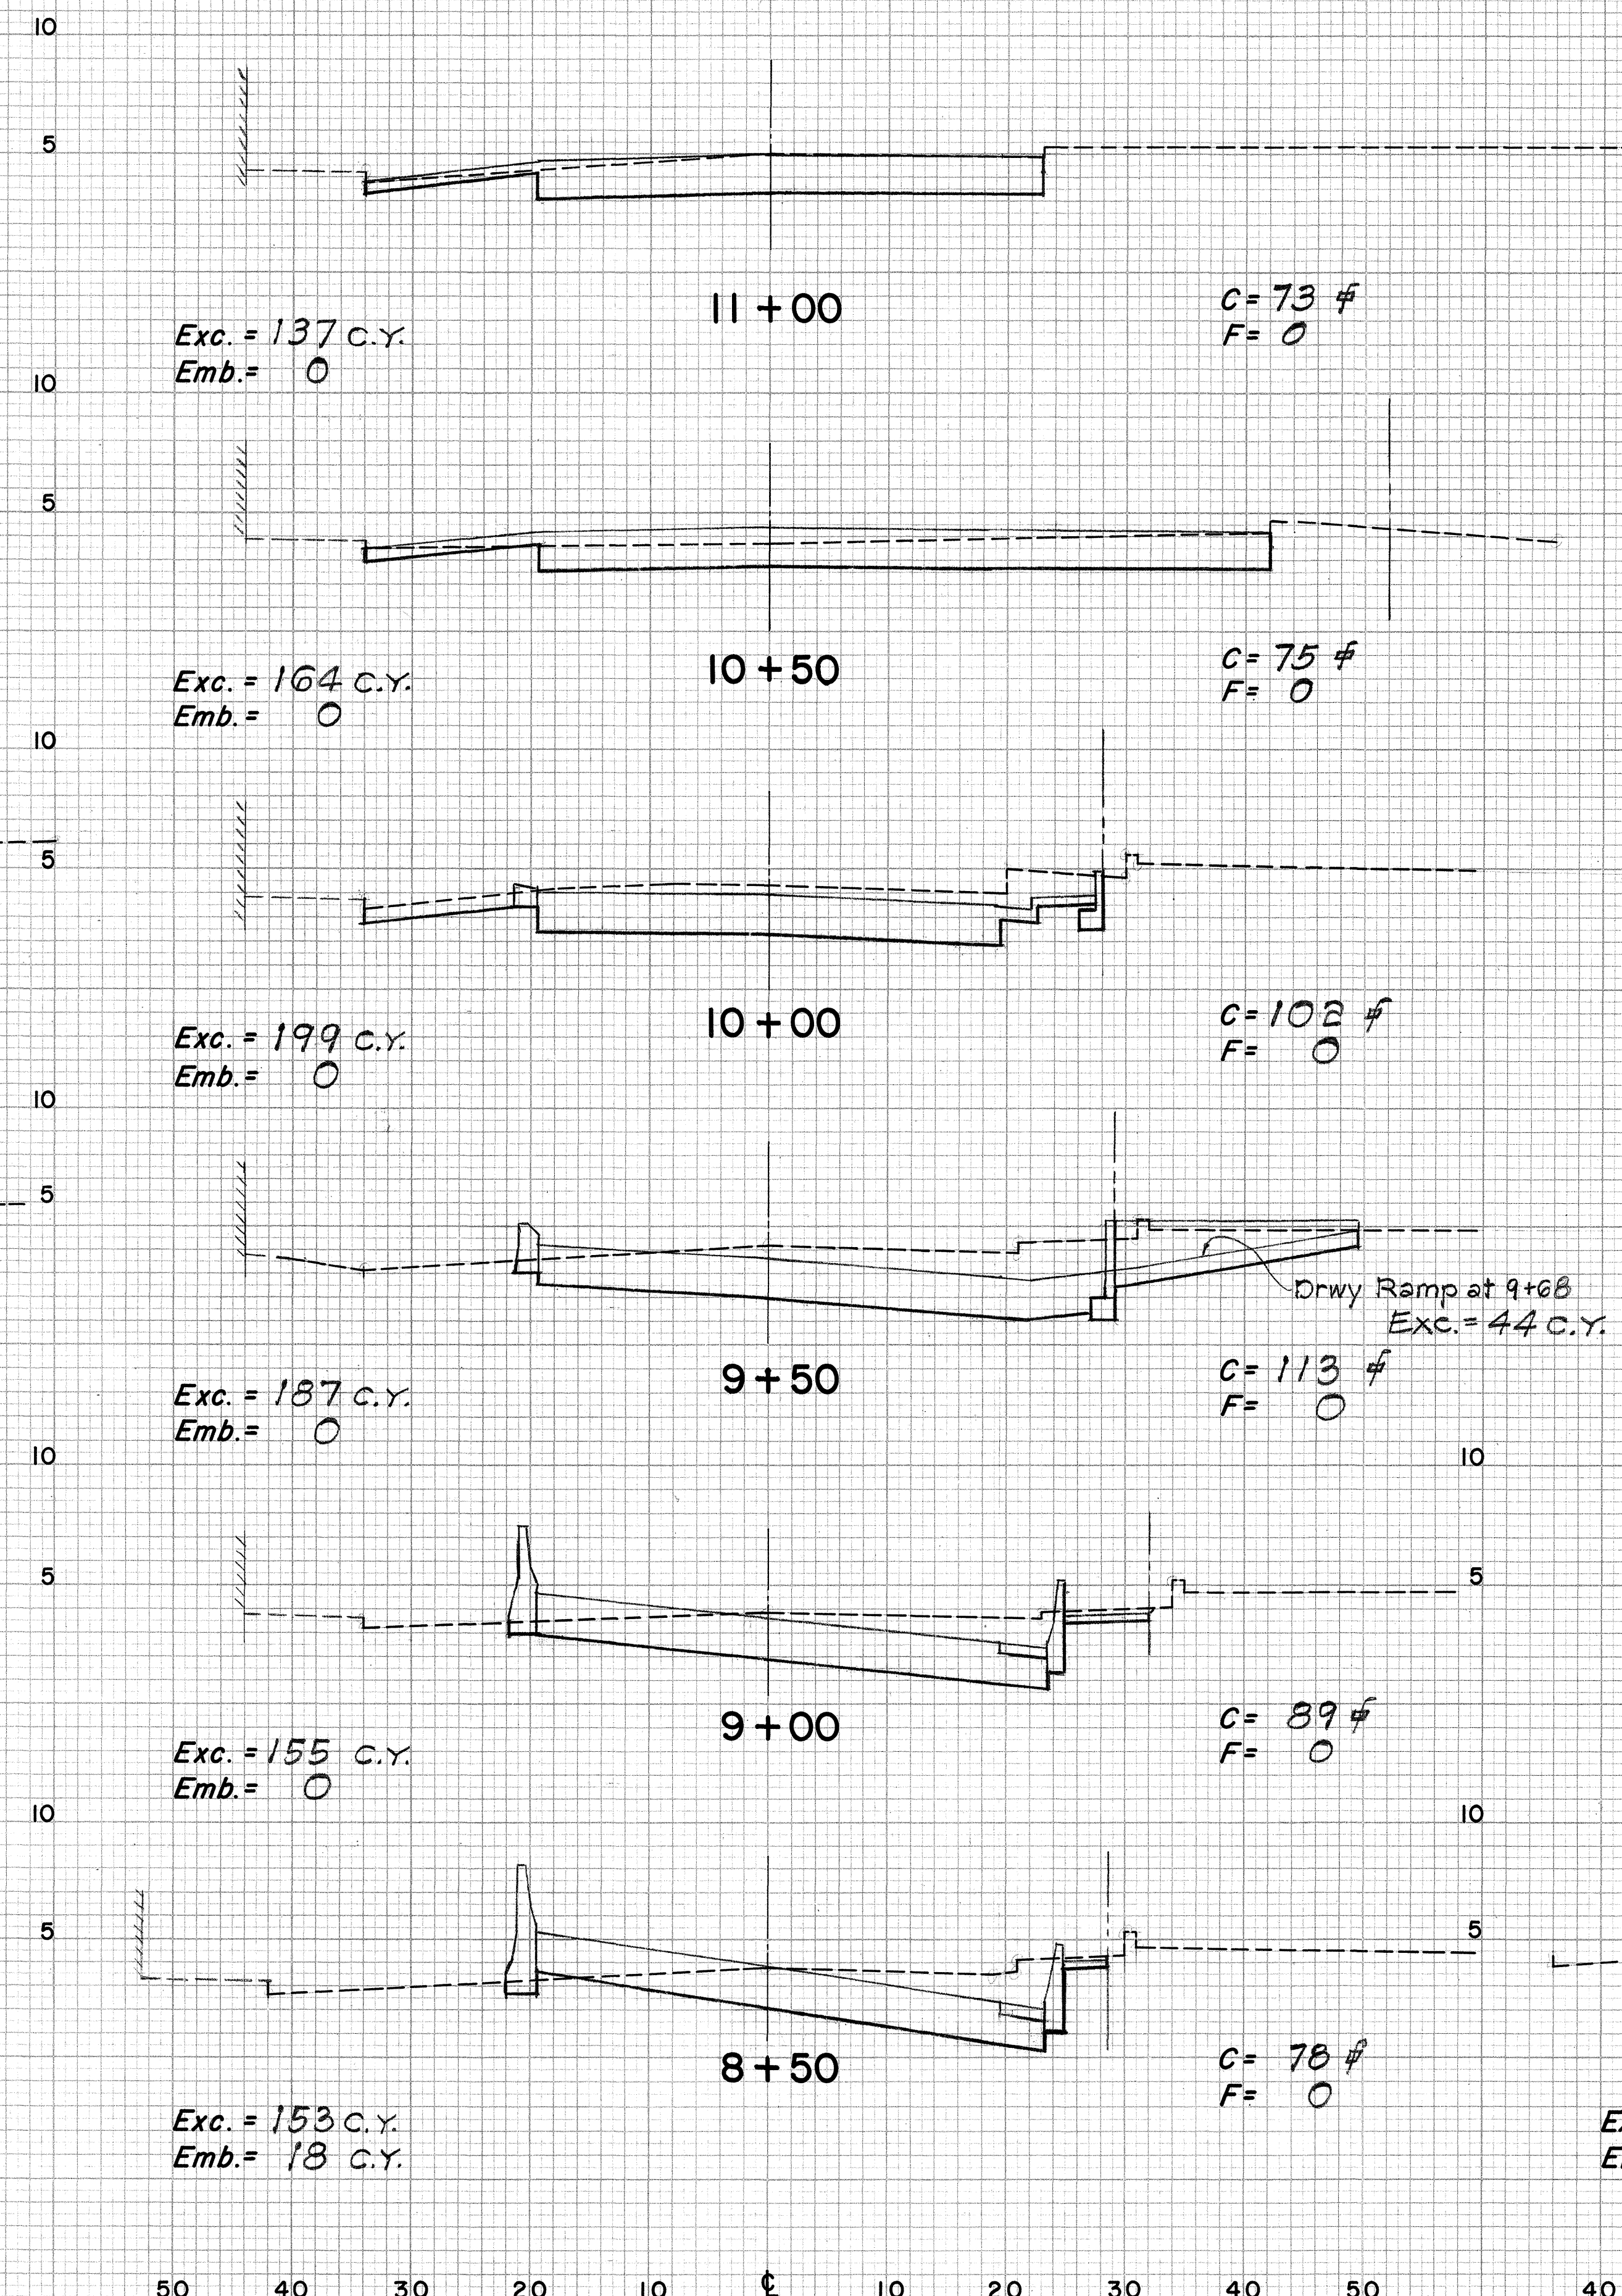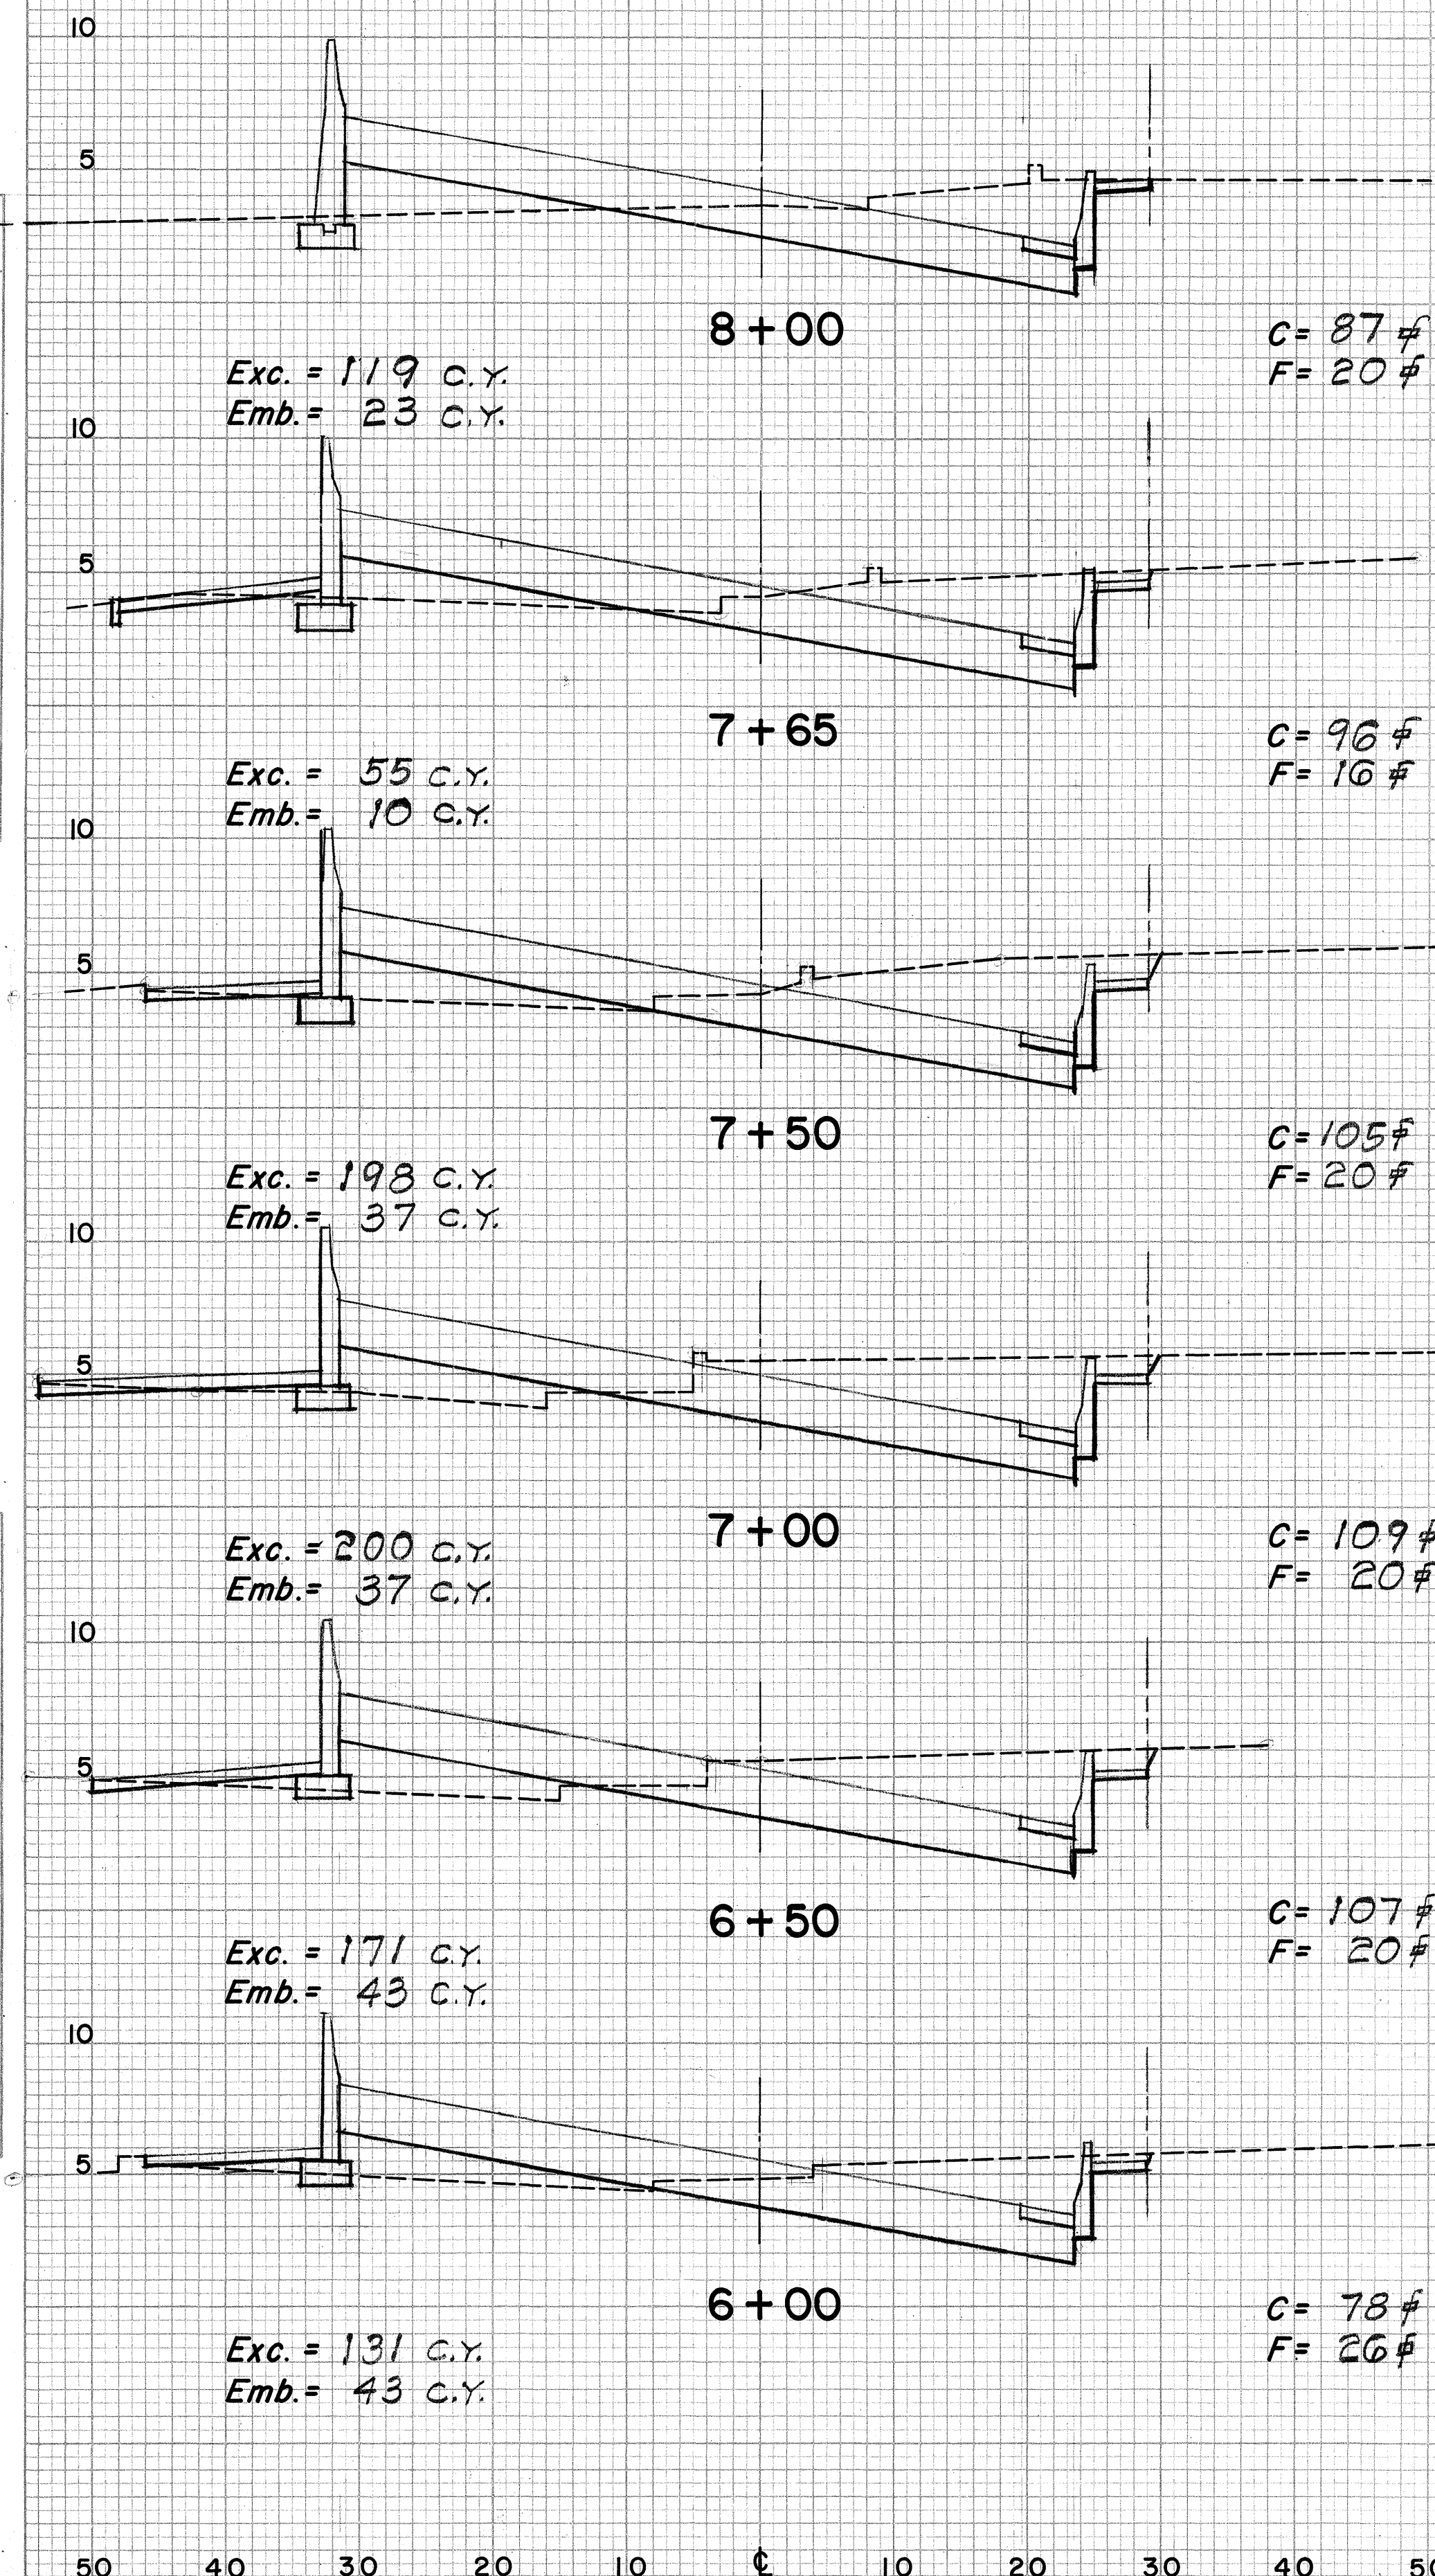

EARTHWORK SUMMARY
TOTAL EXCAVATION = 3,363 C.Y.
TOTAL EMBANKMENT = 485 C.Y.

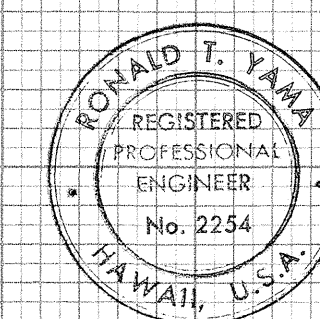

Scale: Horiz. 1" = 10'
Vert. 1" = 5'

THIS WORK WAS PREPARED BY
ME OR UNDER MY SUPERVISION.

Ronald T. Yama

Exc. = 0
Emb. = 0

C = 0
F = 0

33

SHEET NO. 2 OF 2 SHEETS

Printed in U.S.A.
On IMPERIAL Tracing Cloth

PLATE 3 CROSS SECTION B P R STANDARD
EUGENE DIEZGER CO., CHICAGO - NEW YORK