




FED. ROAD DIST. NO.	STATE	FED. AID PROJ. NO.	FISCAL YEAR	SHEET NO.	TOTAL SHEETS
HAWAII	HAW.	U-092-1(8)	1970	4	41

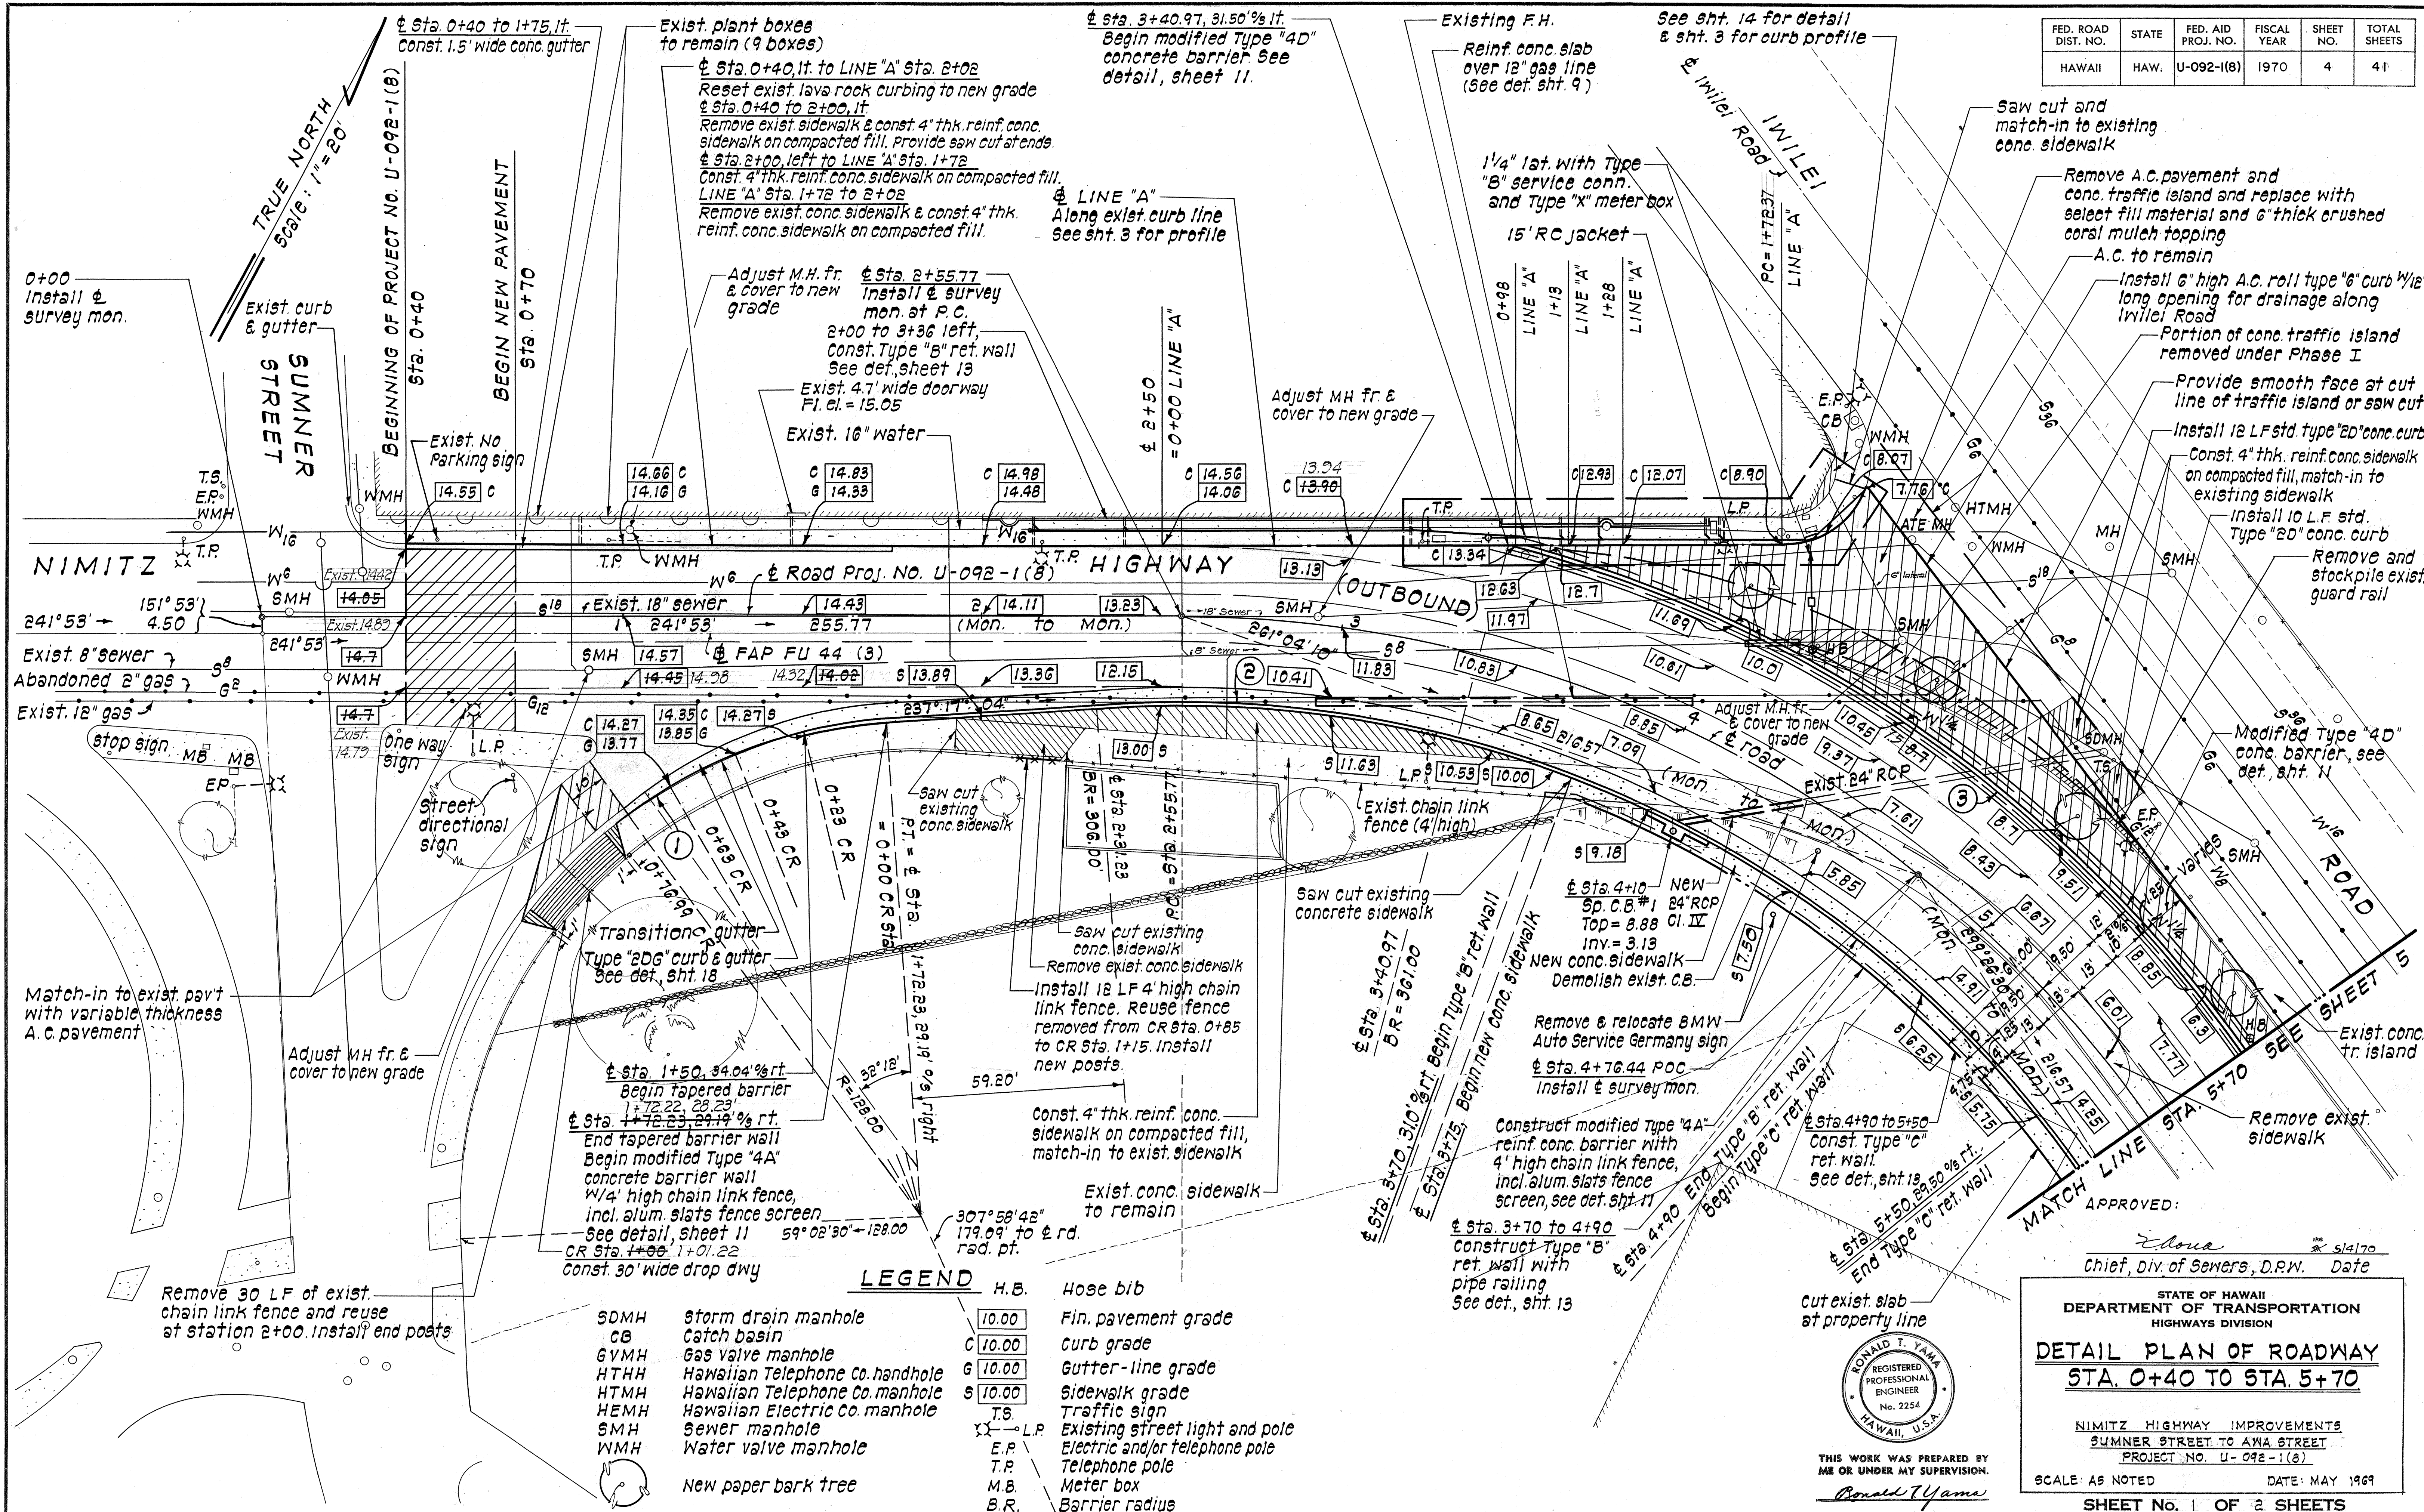

FED. ROAD DIST. NO.	STATE	FED. AID PROJ. NO.	FISCAL YEAR	SHEET NO.	TOTAL SHEETS
HAWAII	HAW.	U-092-1(8)	1970	5	41

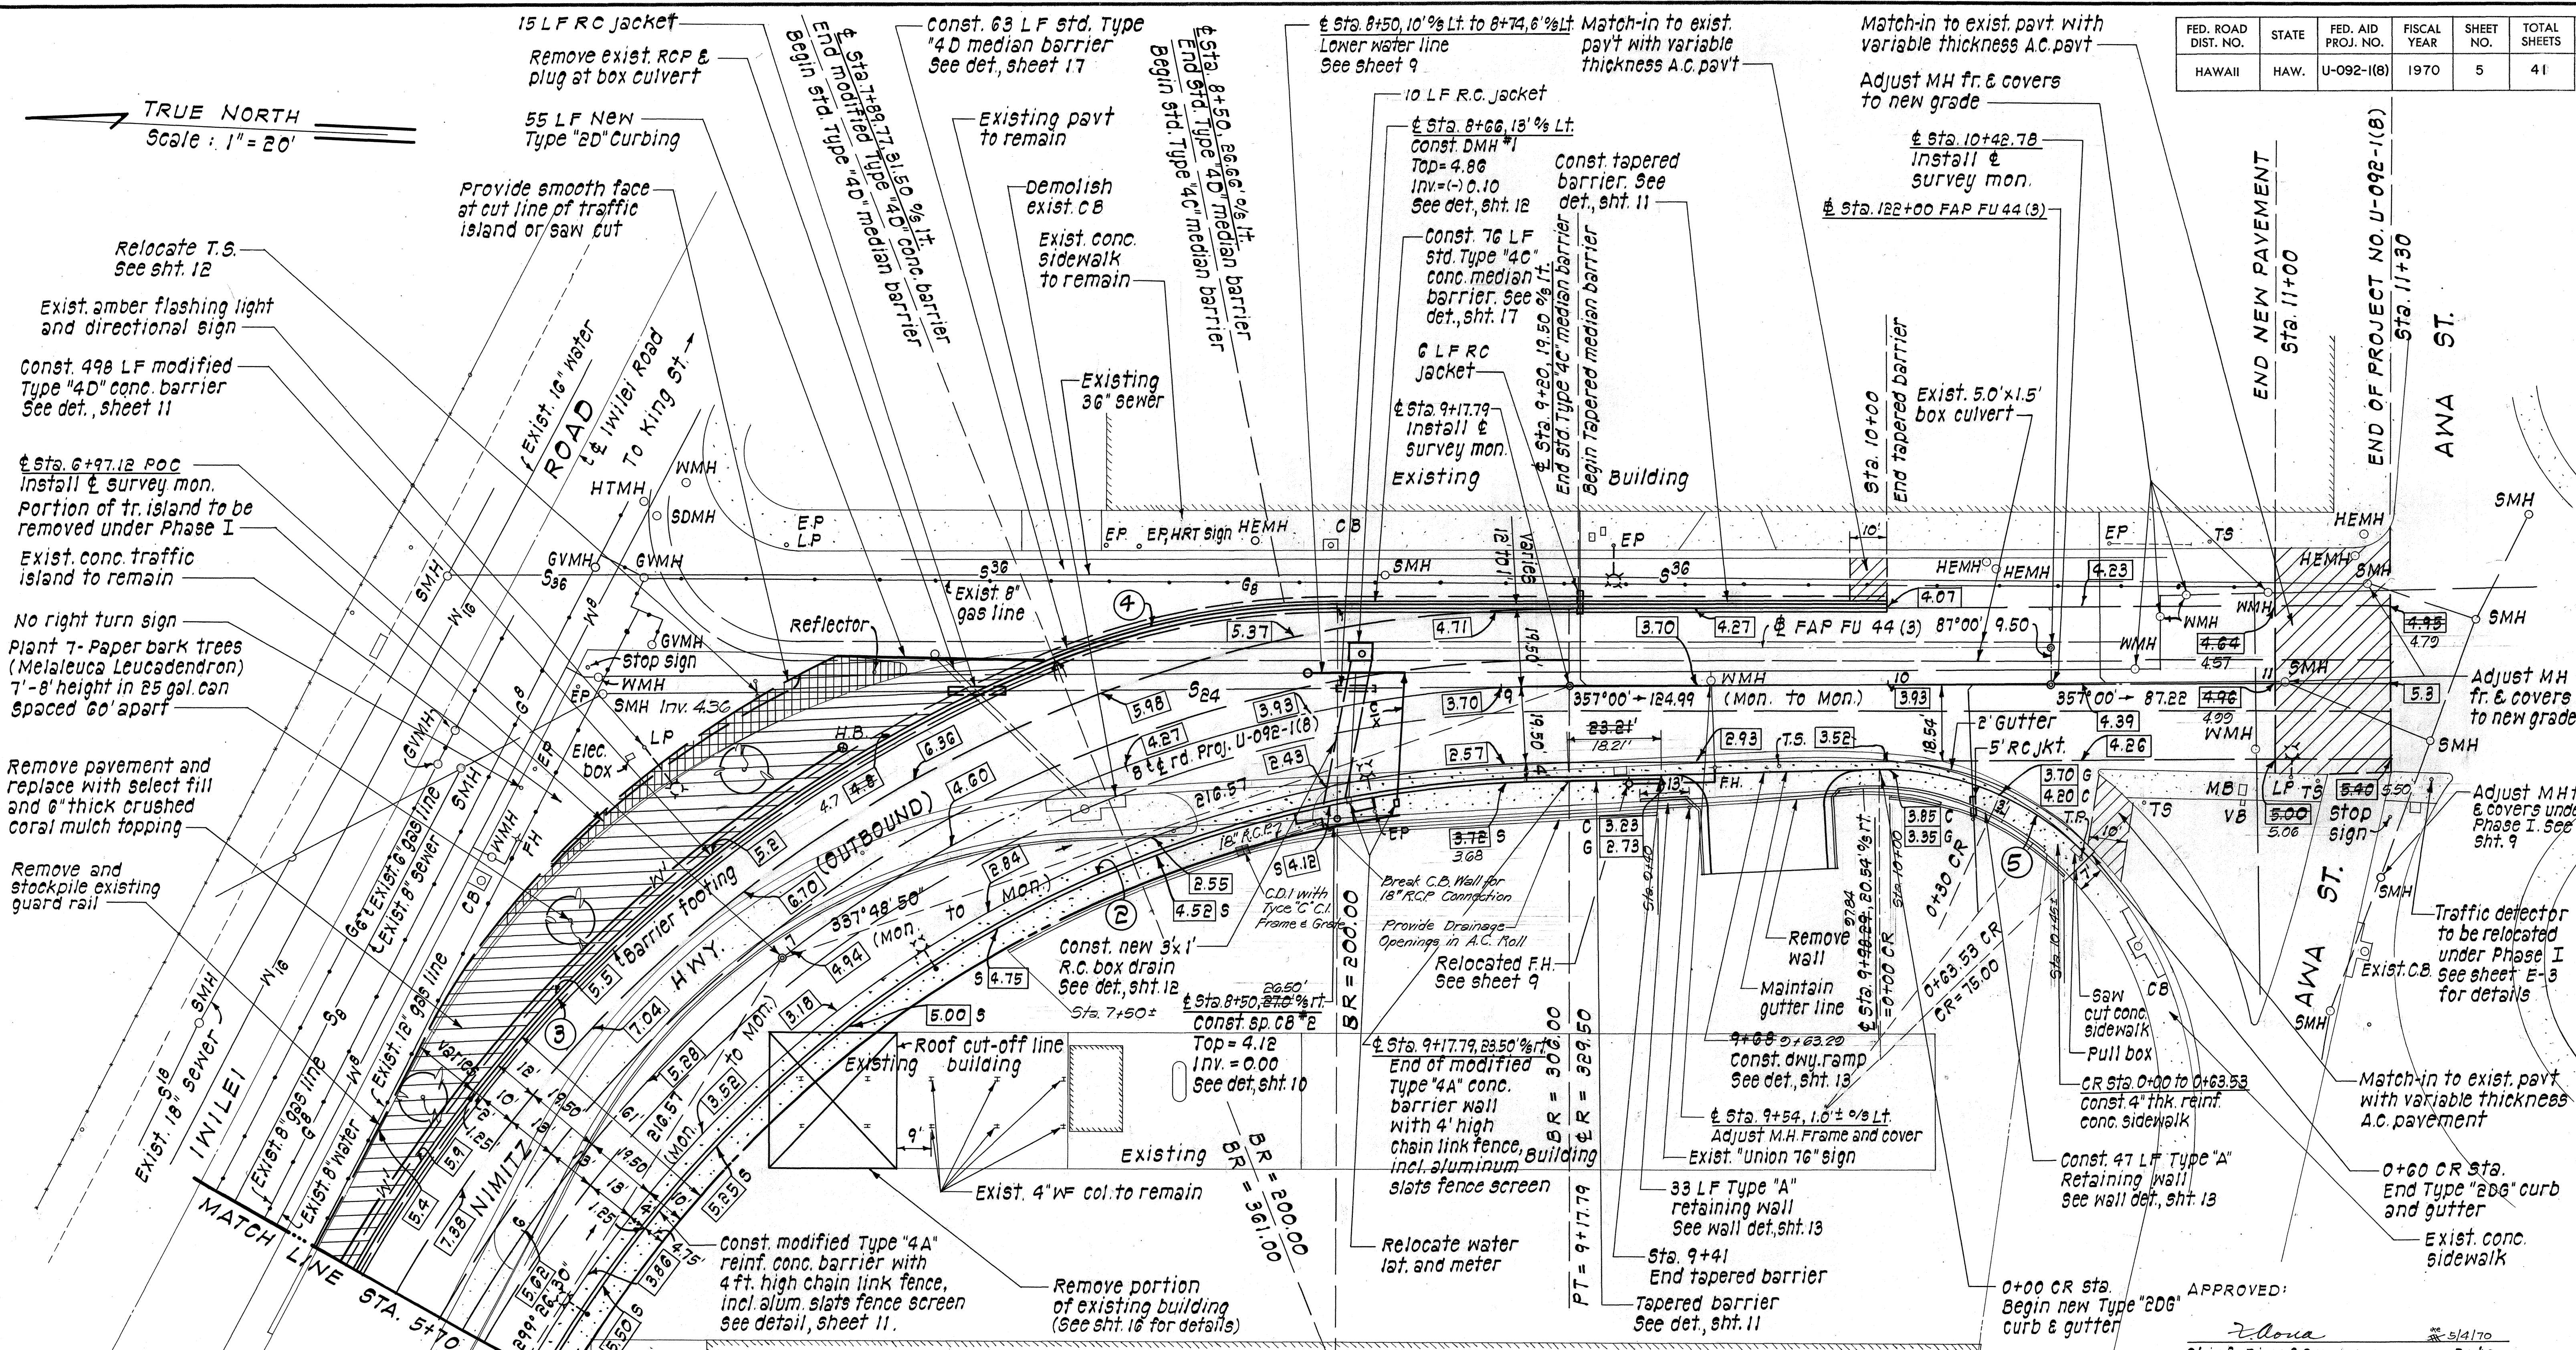

	1	2	3	4	5
Δ	115° 07' 00"	32° 12'	119° 42' 56"	79° 00'	21° 18' 08"
4/2	57° 33' 30"	16° 06'	59° 51' 28"	39° 30'	10° 39' 04"
R	329.50	137.00	306.00	361.00	200.00
T	518.38	39.54	526.98	297.59	37.61
C	556.16	75.98	529.25	459.25	73.93
Lc	662.02	76.99	639.37	497.75	74.36

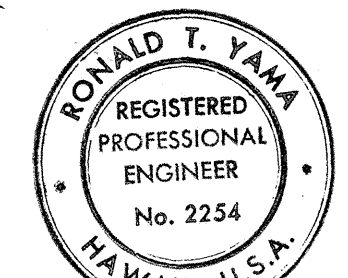

APPROVED: *[Signature]*
 Chief, Div. of Sewers, D.P.W. Date 5/4/70

STATE OF HAWAII
 DEPARTMENT OF TRANSPORTATION
 HIGHWAYS DIVISION

DETAIL PLAN OF ROADWAY
STA. 5+70 TO STA. 11+30

NIMITZ HIGHWAY IMPROVEMENTS
 SUMNER STREET TO AWA STREET
 PROJECT NO. U-092-1(8)

SCALE: AS NOTED DATE: MAY 1969

SHEET No. 2 OF 2 SHEETS

DATE	
DESIGNED BY	
DRAWN BY	
CHECKED BY	
NOTED BY	
NO.	

THIS WORK WAS PREPARED BY ME OR UNDER MY SUPERVISION.
Ronald T. Yama