

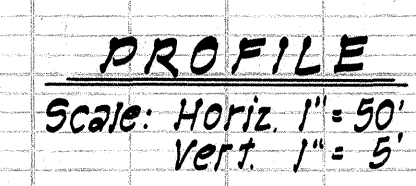


NOTES: 1. See sheet 9 for Utilities
2. For Traffic signing during Construction and Project Sign Location, see sheets 7 & 8
3. For Traffic Lane Markings see sheet 15.

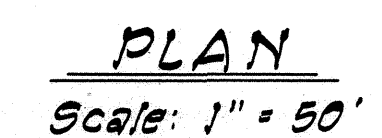

Scale: Horiz. 1" = 50'
Vert. 1" = 5'

MUTCD DESIG.	MESSAGE	PRESENT LOCATION	DISPOSITION	QUAN. (EA.)	REMARKS
R2-1(35)	Speed Limit 35	—	New install 1- With Post 1- On Hwy Lt. Std.	2	
R7-1	No Parking Anytime	—	New install 1- With Post 2- On Hwy Lt. Std.	3	
W1-1(L)		5+27 L 5+32 L	Reloc. 1- On Lite Std. 1- With post	2	See Phases I & II
RM-9	Reflector	7+57 L	Relocate Reflec. # Post to end of Barr. at 10+00	1	
DIREC. SIGN		7+75 L	Reloc. Sign With Post to 7+70 L	1	See sht. 12 of Plans
R1-2 W13-1(25)	Yield 25 MPH	4+00 L 5+27 L 5+33 L 9+60 R	Remove Sign & Post # salvage	4	See Phase I
R1-1	Stop	11+33 R Sumner & Nimitz	Relocate 1- With Post 1- On Post	2	See Phases I & II
R6-1(R)	One Way	11+33 R AWA, see sht. 7	Relocate 2- On Post	2	See Phases I & II

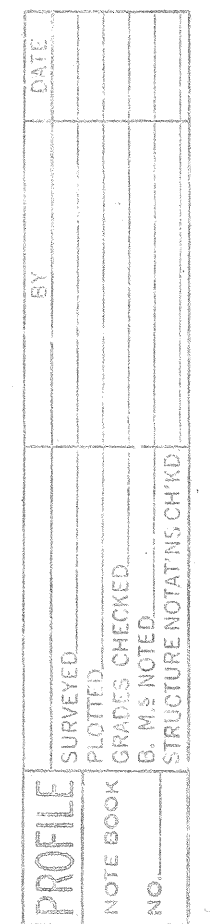

THIS WORK WAS PREPARED BY
ME OR UNDER MY SUPERVISION.
Ronald T. Yama

SCALE: AS NOTED DATE: MAY 1969
SHEET NO. 13 OF 16 SHEETS