
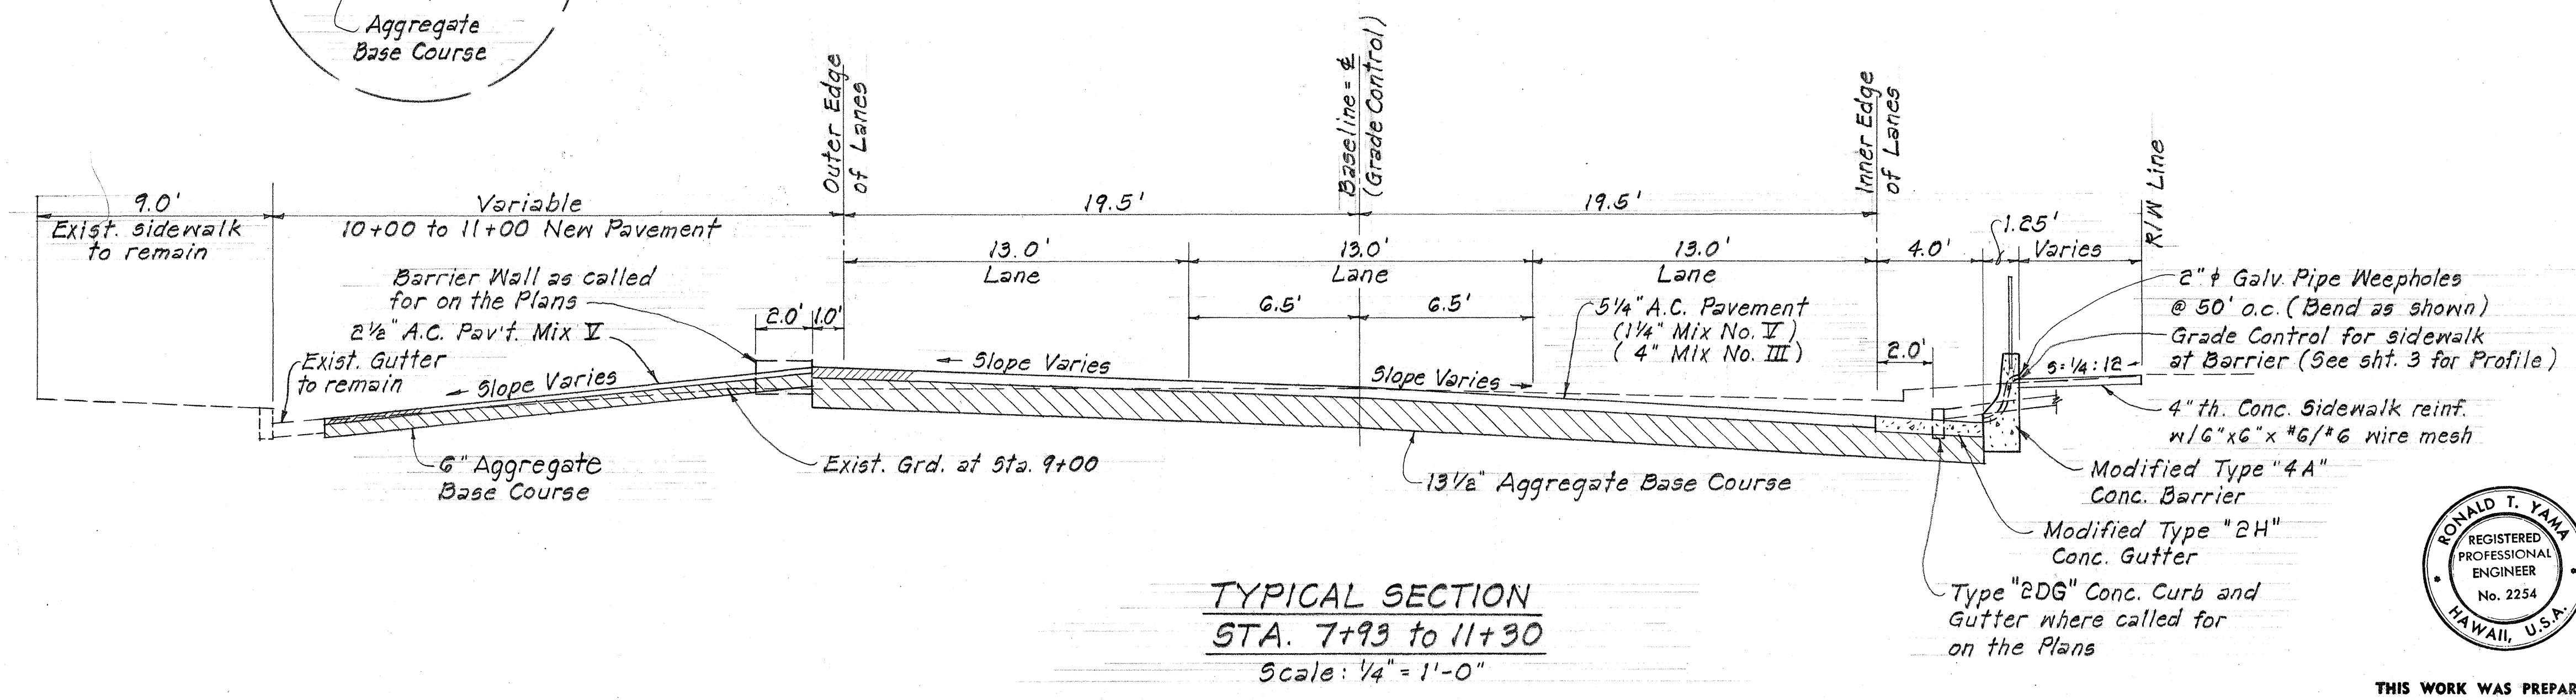
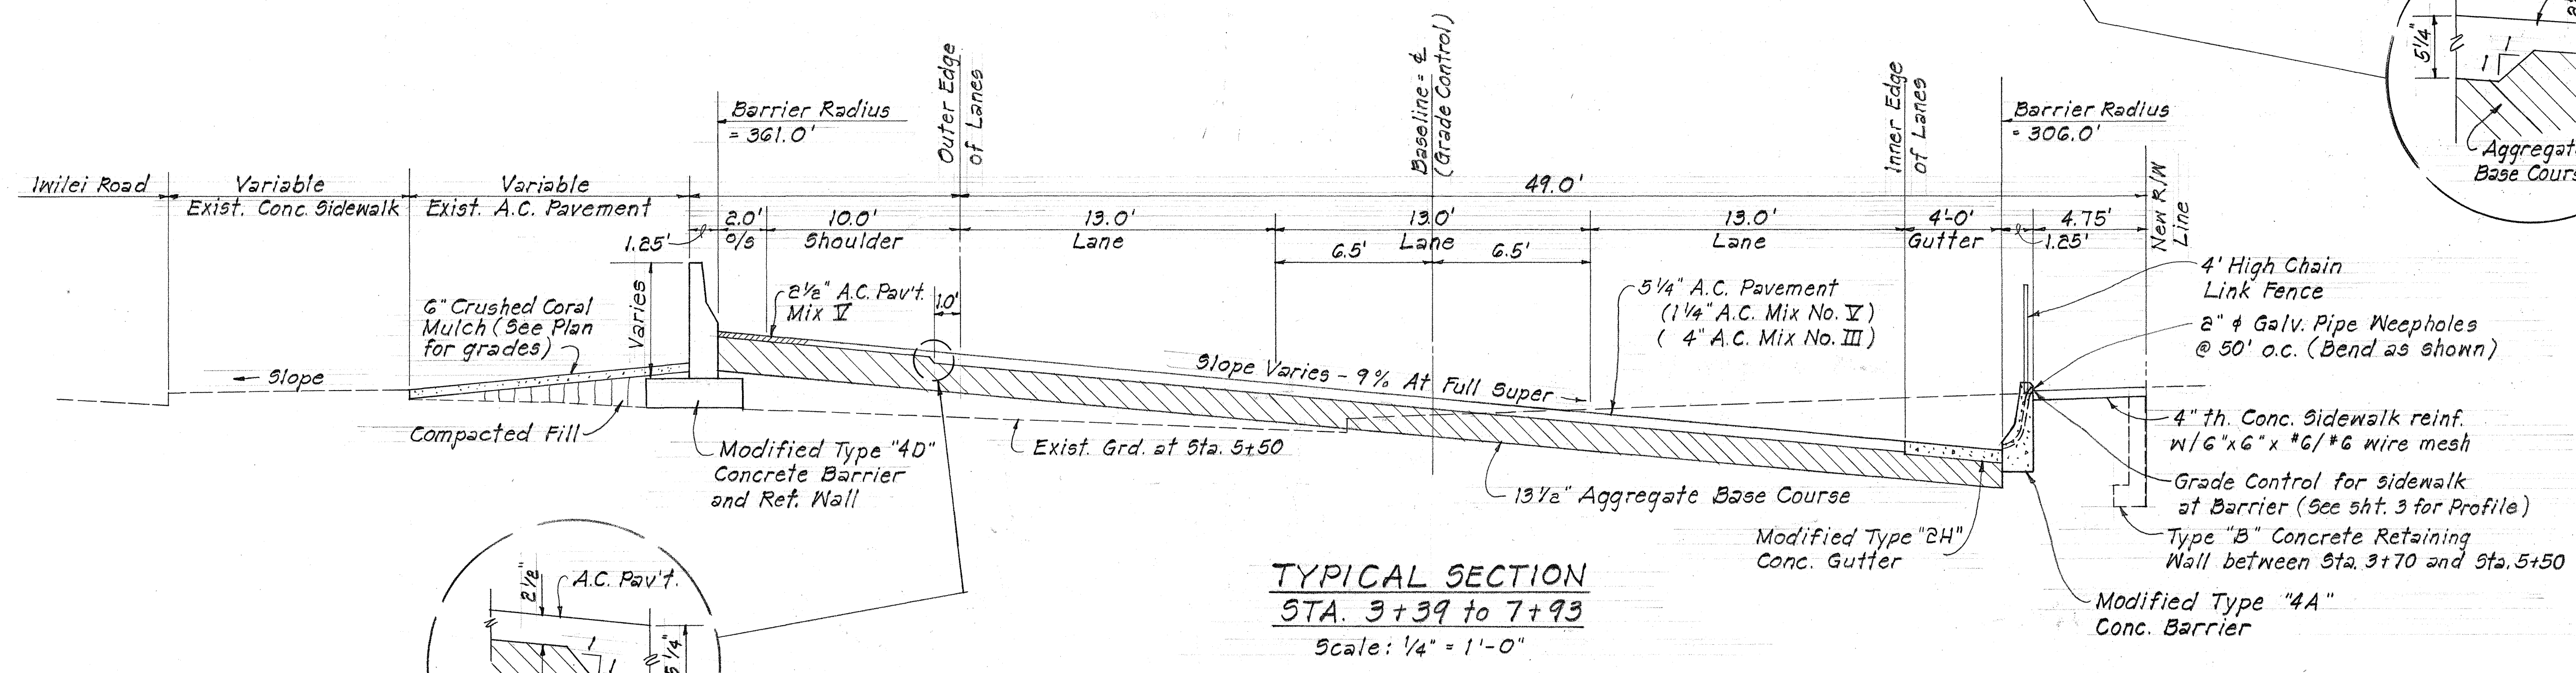


FED. ROAD DIST. NO.	STATE	FED. AID PROJ. NO.	FISCAL YEAR	SHEET NO.	TOTAL SHEETS
HAWAII	HAW.	U-092-1(8)	1970	2	4

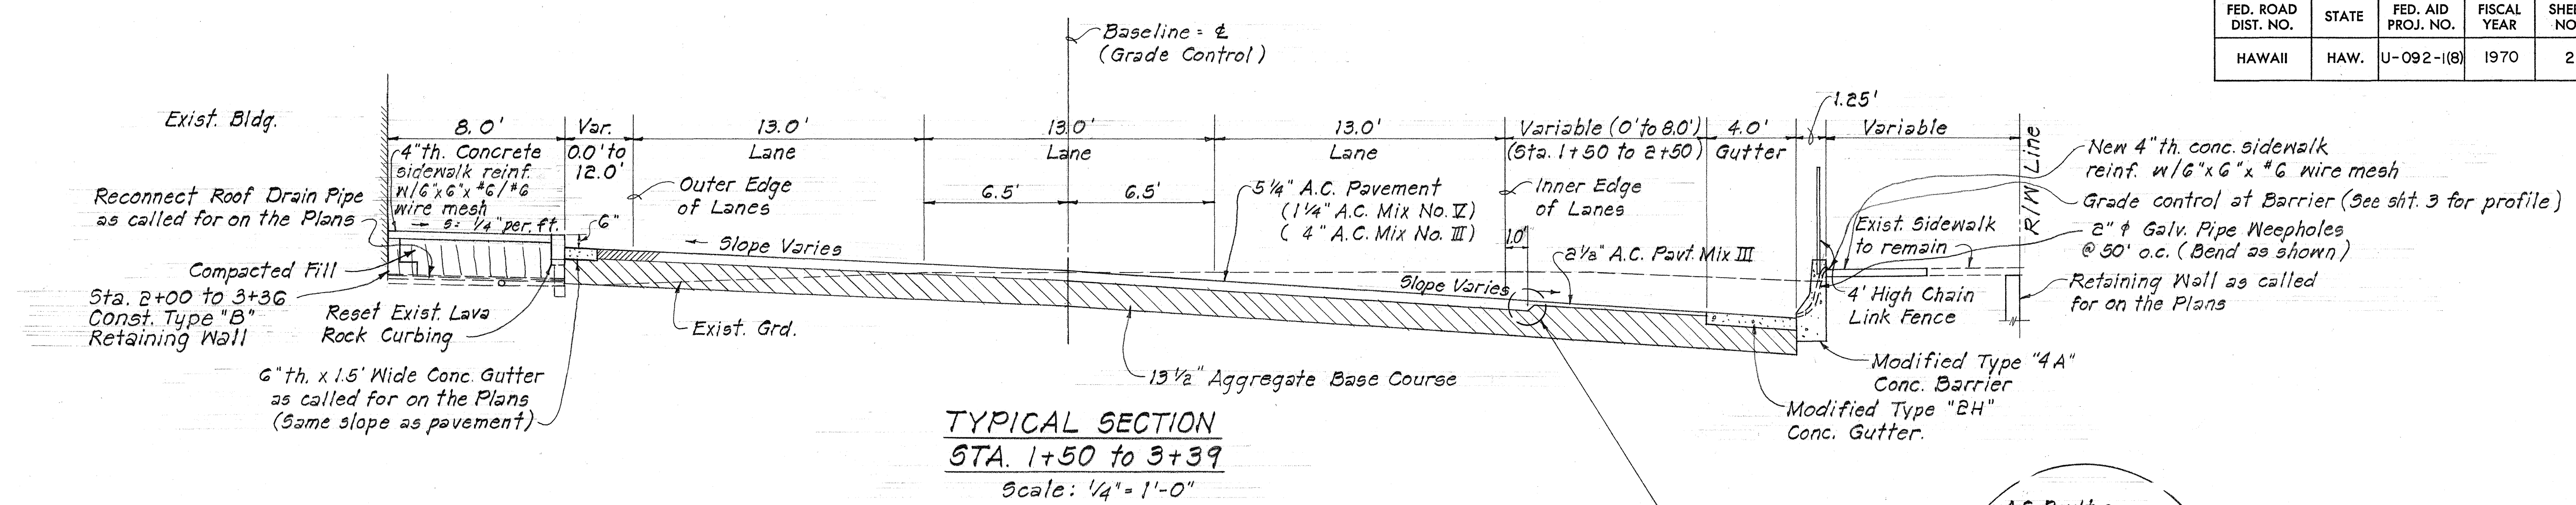

DATE	_____
SURVEY PLOTTED BY	_____
ORIGINAL PLAN	_____
DESIGNED BY	_____
NOTE BOOK	_____
QUANTITIES BY	_____
CHECKED BY	_____
NO.	_____

THIS WORK WAS PREPARED BY
ME OR UNDER MY SUPERVISION.
Ronald T. Yama

STATE OF HAWAII

DEPARTMENT OF TRANSPORTATION

HIGHWAYS DIVISION

TYPICAL ROAD SECTIONS

NIMITZ HIGHWAY IMPROVEMENTS

SUMNER STREET TO AWA STREET

PROJECT NO. U-092-1 (8)

SCALE: AS NOTED

DATE: DEC. 1969

RONALD T. YAMA

REGISTERED PROFESSIONAL ENGINEER

No. 2254

HAWAII, U.S.A.