INDEX TO DRAWINGS	
SHEET NO.	DESCRIPTION
1	TITLE SHEET
2-3	TYPICAL ROAD SECTION,
	LEGEND AND DETAILS
4 - 9	PLANS AND DETAILS
10	MISCELLANEOUS DETAILS
II - 15	CROSS - SECTIONS
16 - 25	STANDARD DETAILS
26	DESTINATION AND
	PROJECT INFORMATION SIGNS
4	
····	
,	
•	
Ÿ	
·	
,	

STATE OF HAWAII

DEPARTMENT OF TRANSPORTATION
HIGHWAYS DIVISION

HONOLULU, HAWAII "AS BUILT" PLANS FOR

KAMEHAMEHA HIGHWAY IMPROVEMENTS

PROJECT NO. 90BD - 03 - 70

PHASE II

INCLUDING

INTERSECTION IMPROVEMENTS

ON KAMEHAMEHA HIGHWAY AND MIDDLE STREET

AND MIDDLE STREET WIDENING


KAMEHAMEHA HIGHWAY TO H-I OFF-RAMP


AND


NIMITZ HIGHWAY LEFT TURN INBOUND LANE EXTENSION AT MIDDLE STREET

PROJECT NO. 92A - 01 - 71

DISTRICT OF HONOLULU ISLAND OF OAHU

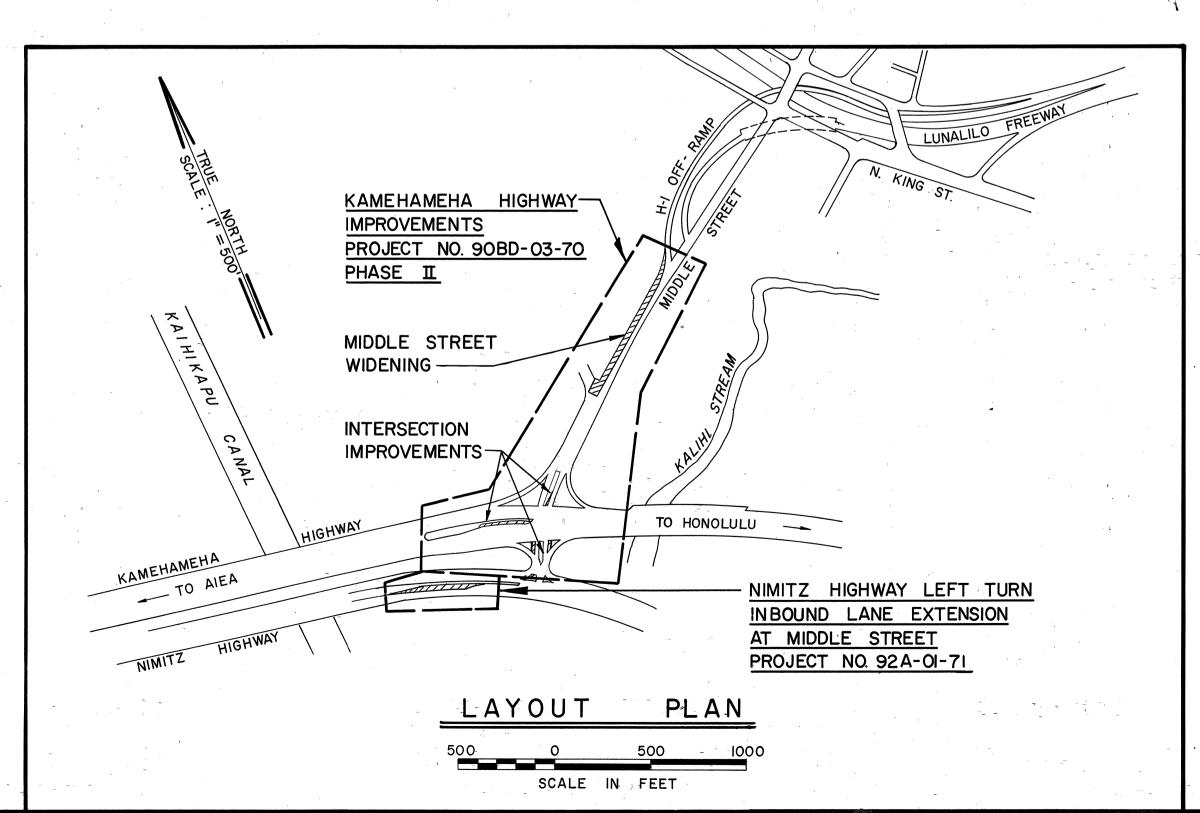

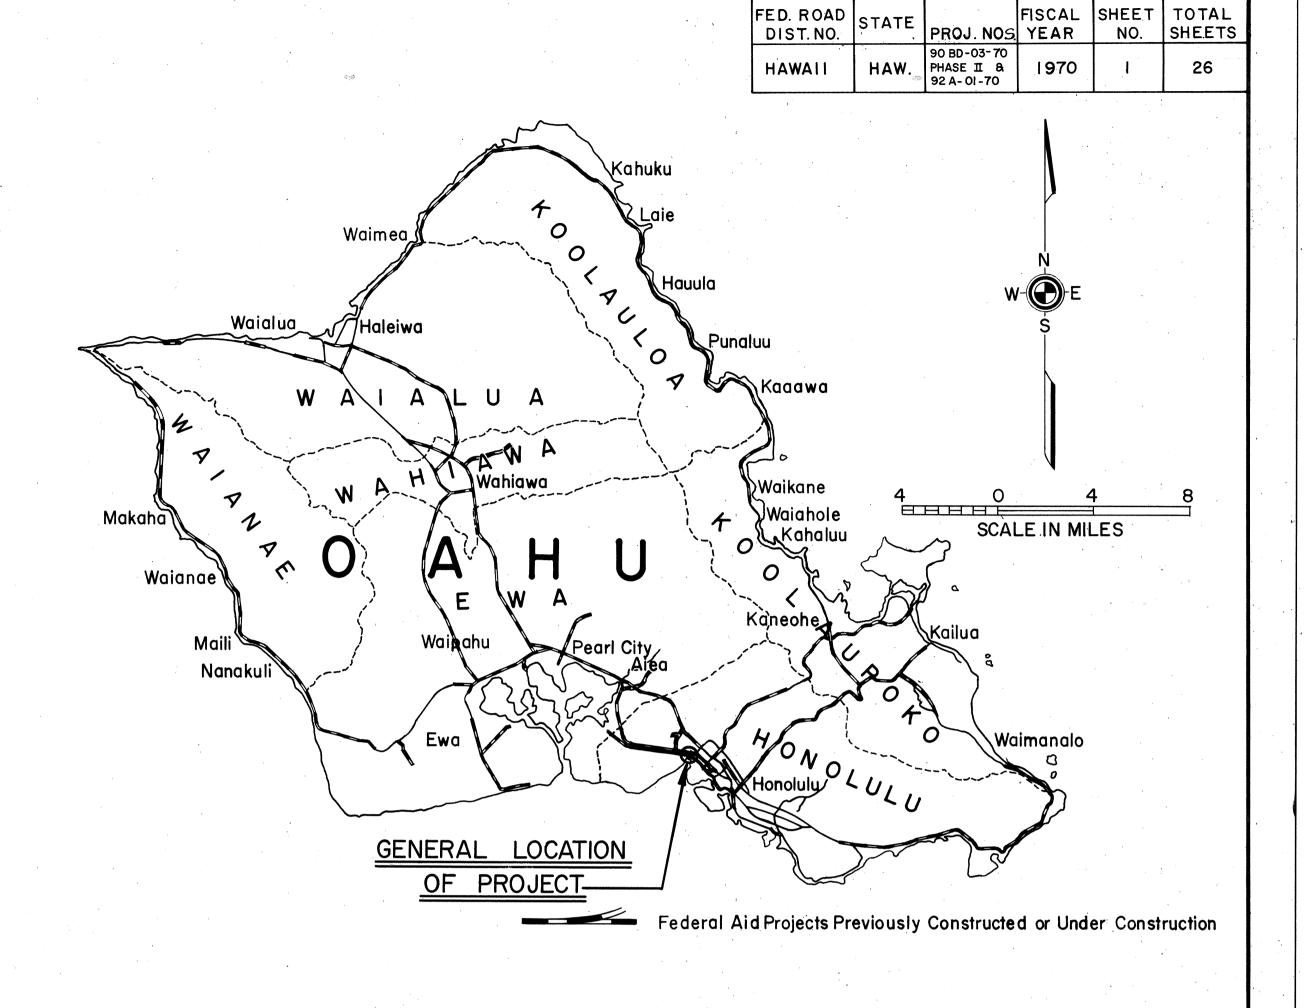

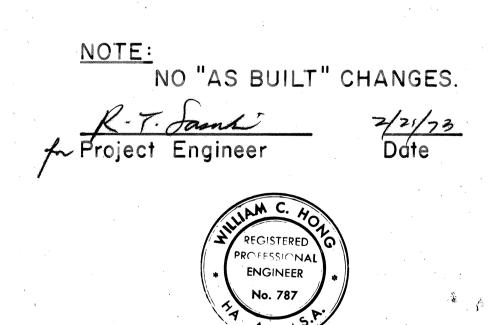

THIS WORK WAS PREPARED BY
ME OR UNDER MY SUPERVISION

William C. Aureg

DEPARTMENT OF TRANSPORTATION
STATE OF HAWAII

APPROVED:

6. alwey thright 11/6/2

DD-B-7-7

DIR. OF TRANSPORTATION

DATE :

54822 II - 372 PHONE LOCAL

> H. IWAI PS. 8. E. BY:

LLIAM C. HONG