




FED. ROAD DIST. NO.	STATE	PROJ. NOS.	FISCAL YEAR	SHEET NO.	TOTAL SHEETS
HAWAII	HAW.	90BD-03-70 Phase II & 92A-01-71	1970	2	26

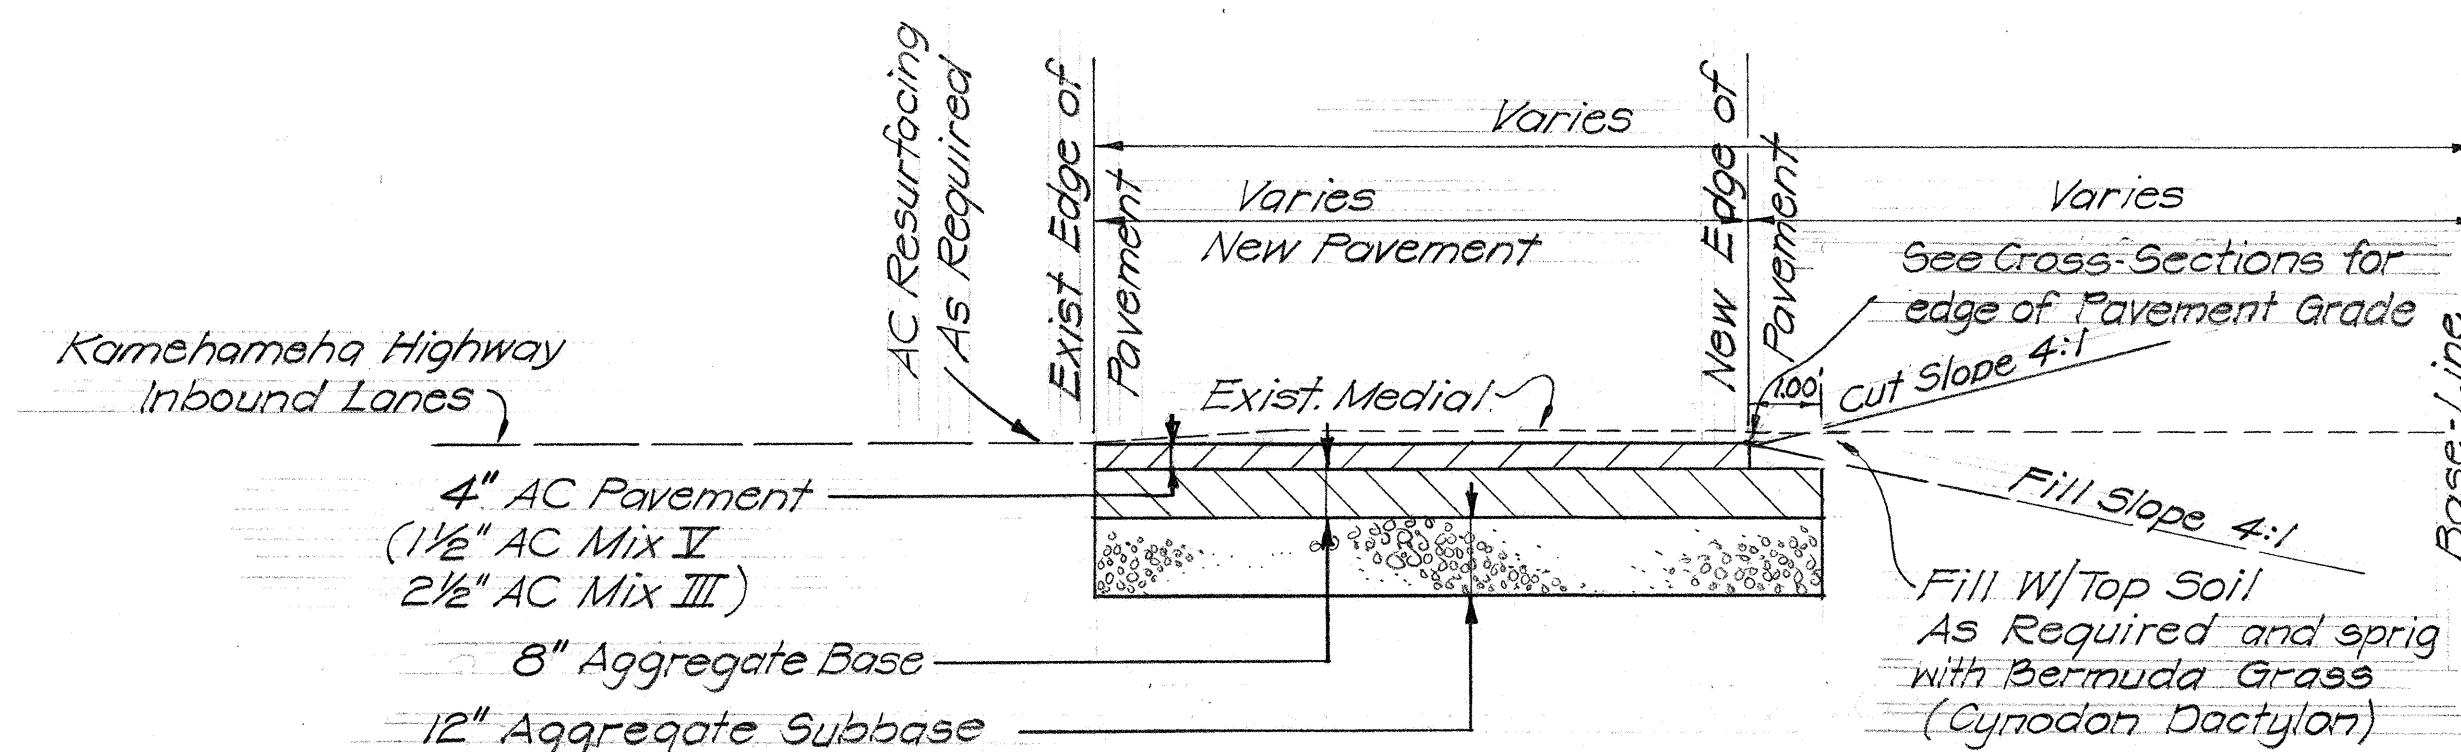


TYPICAL ROAD SECTION
KAMEHAMEHA HIGHWAY INBOUND AT MIDDLE STREET
6+20 (±) TO 7+32.20
Scale: 3/8" = 1'-0"

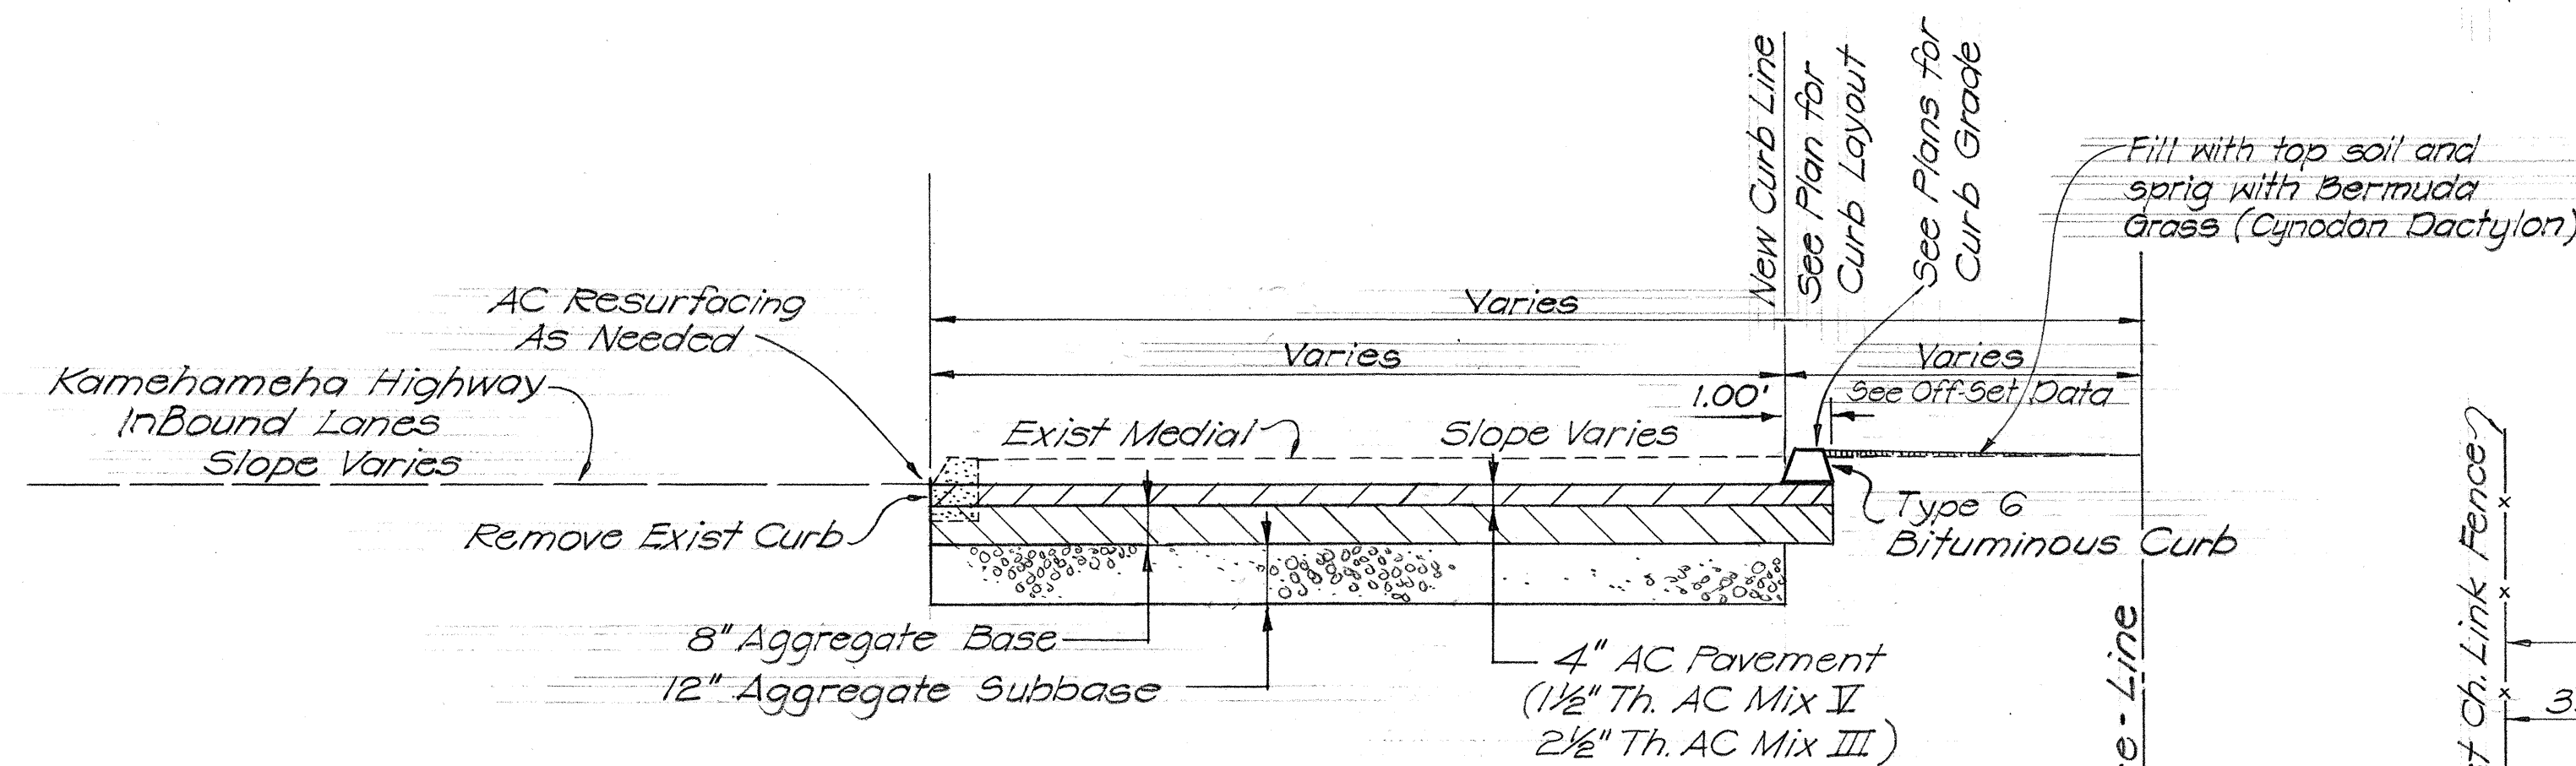


TYPICAL ROAD SECTION
KAMEHAMEHA HIGHWAY INBOUND AT MIDDLE STREET
(2+75 TO 6+20)
Scale: 3/8" = 1'-0"

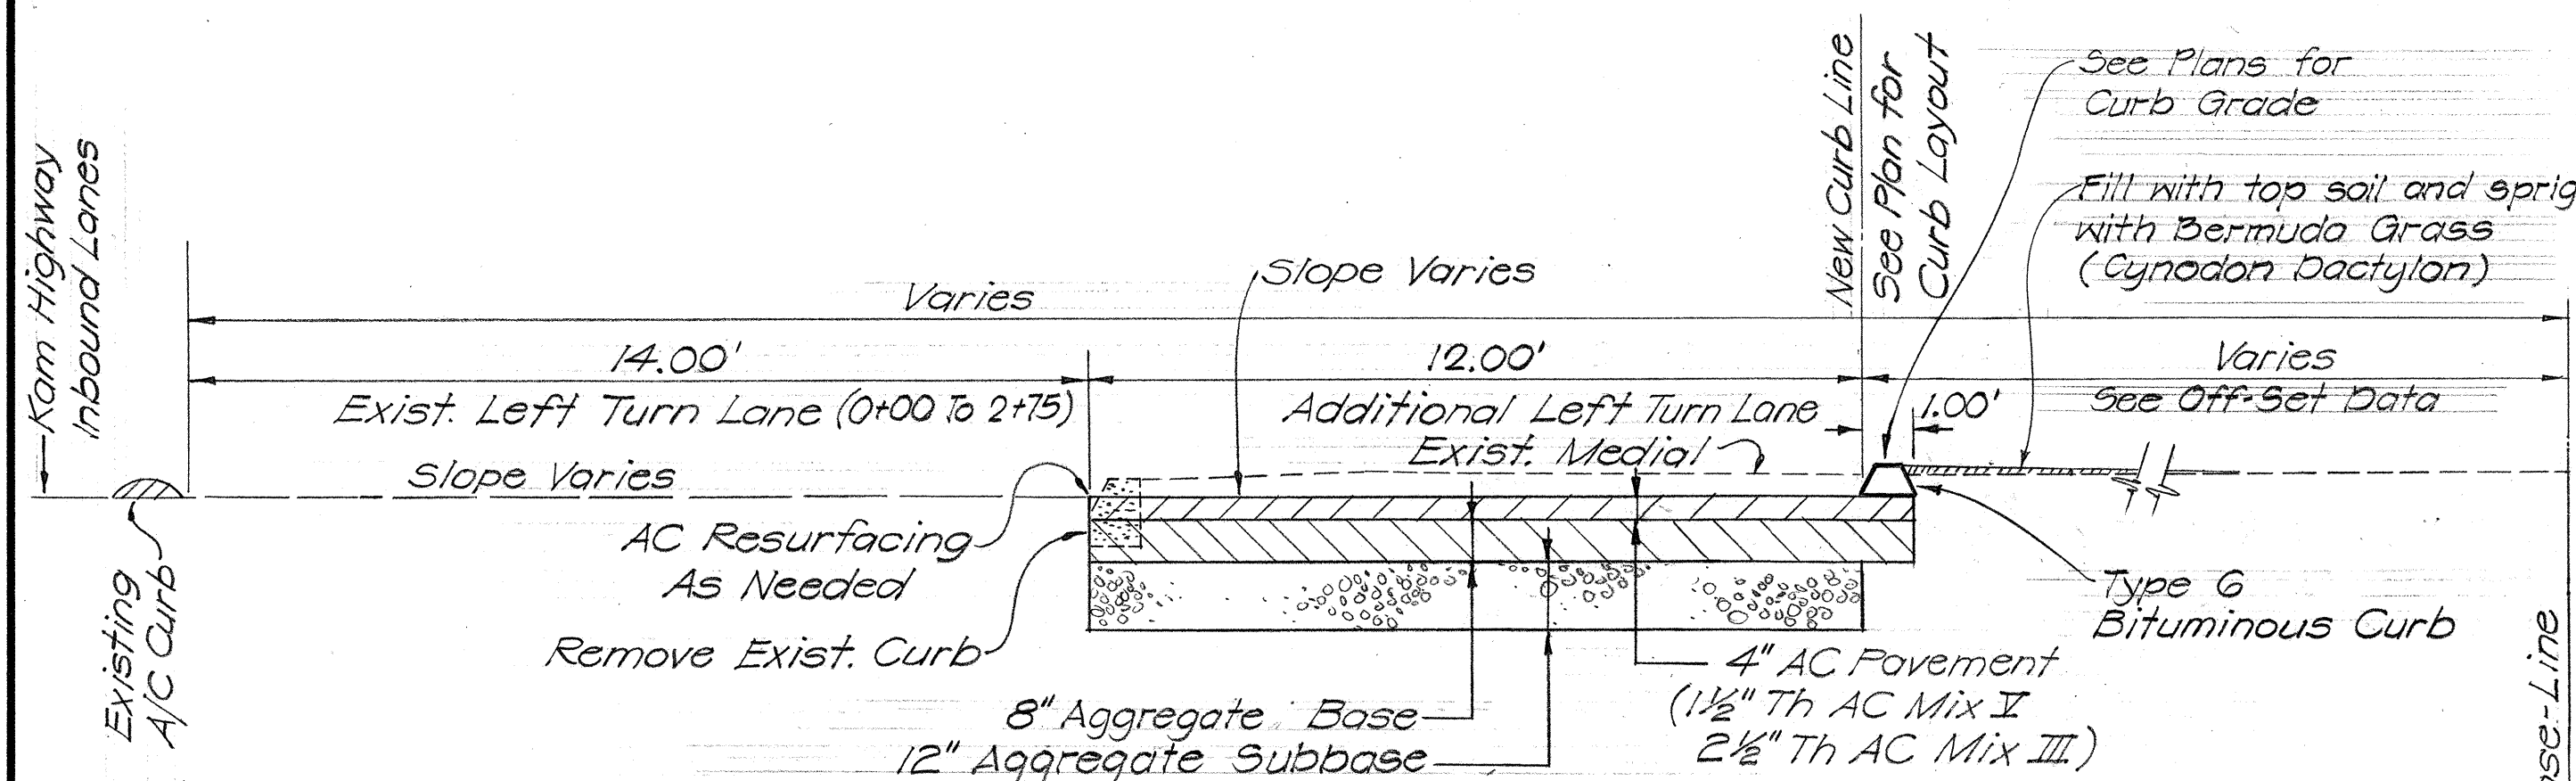

TYPICAL ROAD SECTION
KAMEHAMEHA HIGHWAY INBOUND AT MIDDLE STREET
TWO LEFT TURN LANES
(0+00 TO 2+75)
Scale: 3/8" = 1'-0"


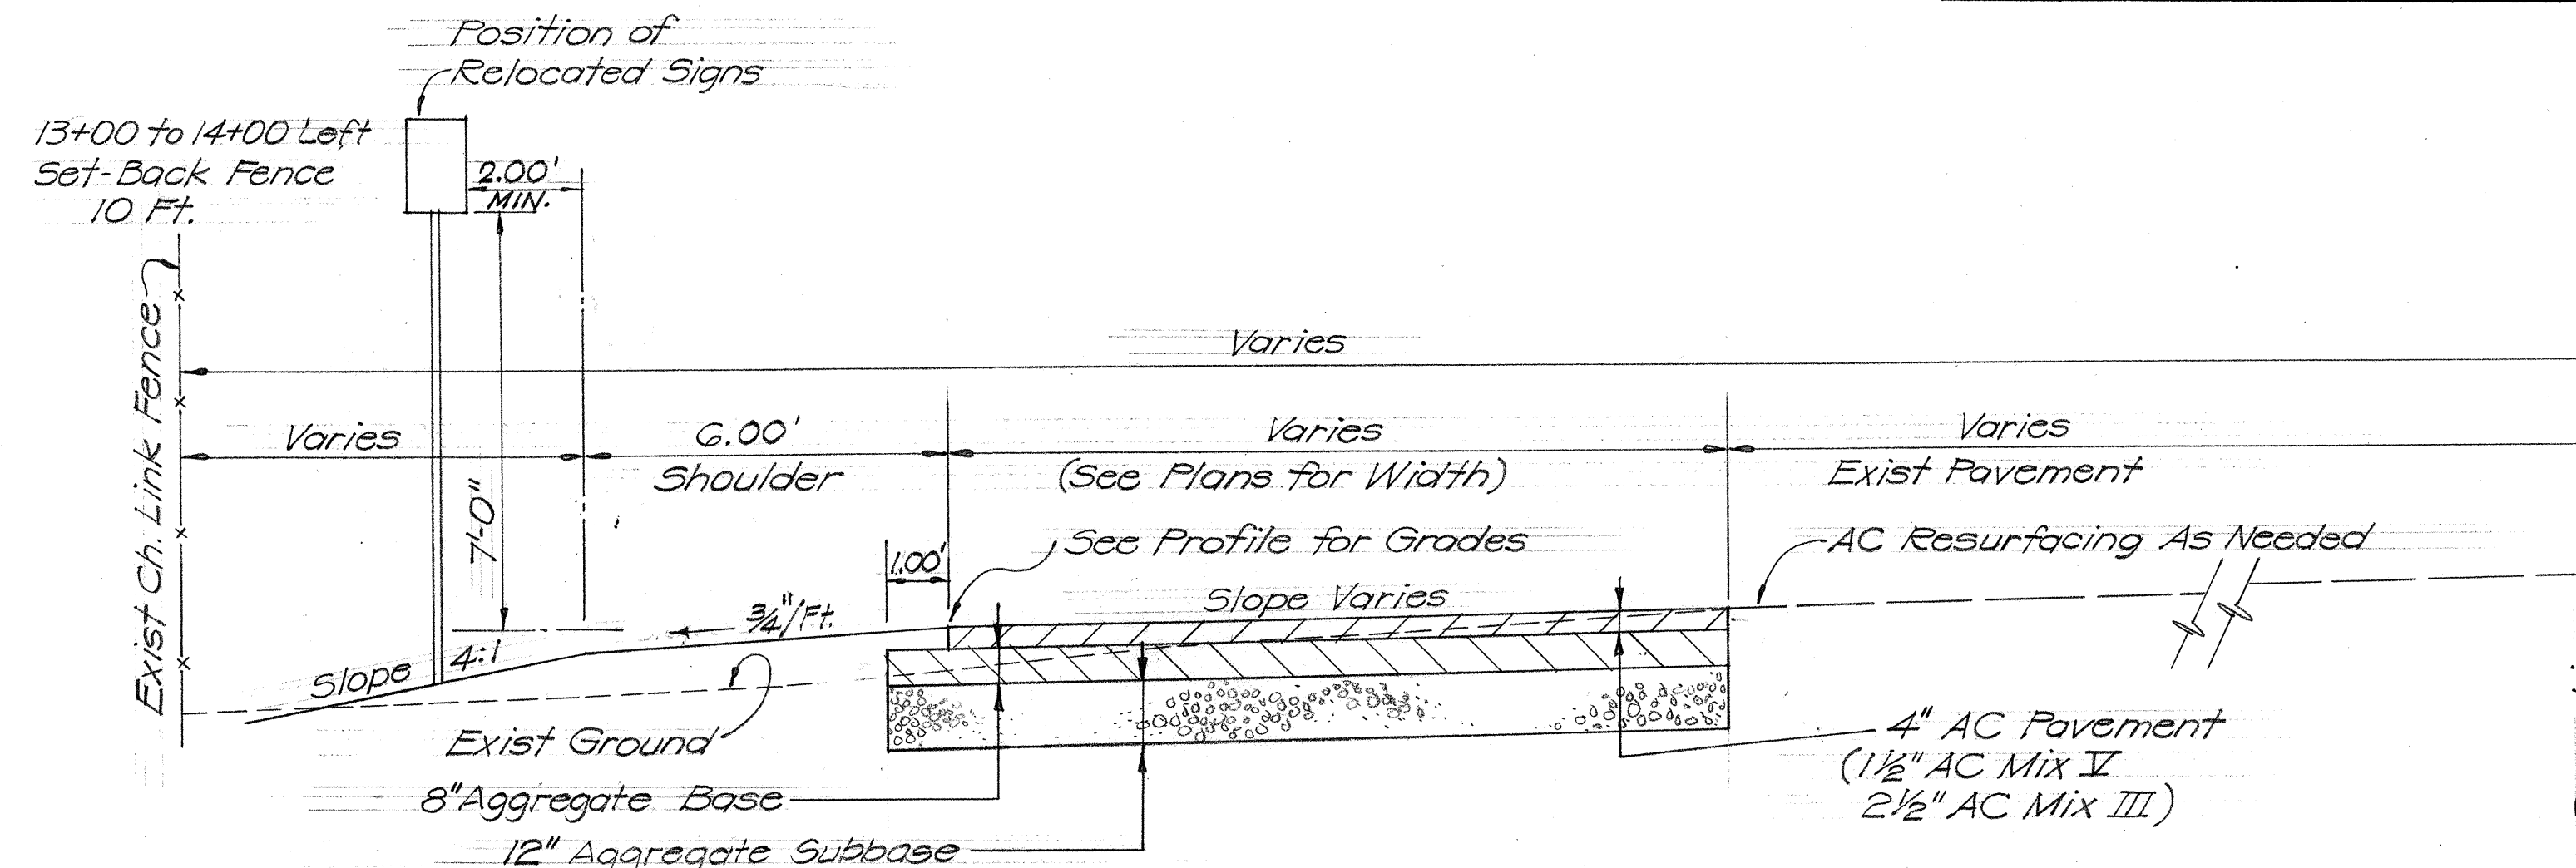


TYPICAL ROAD SECTION
MIDDLE STREET - FILL SIDE SLOPE
9+00 TO 21+48.84
Scale: 3/8" = 1'-0"

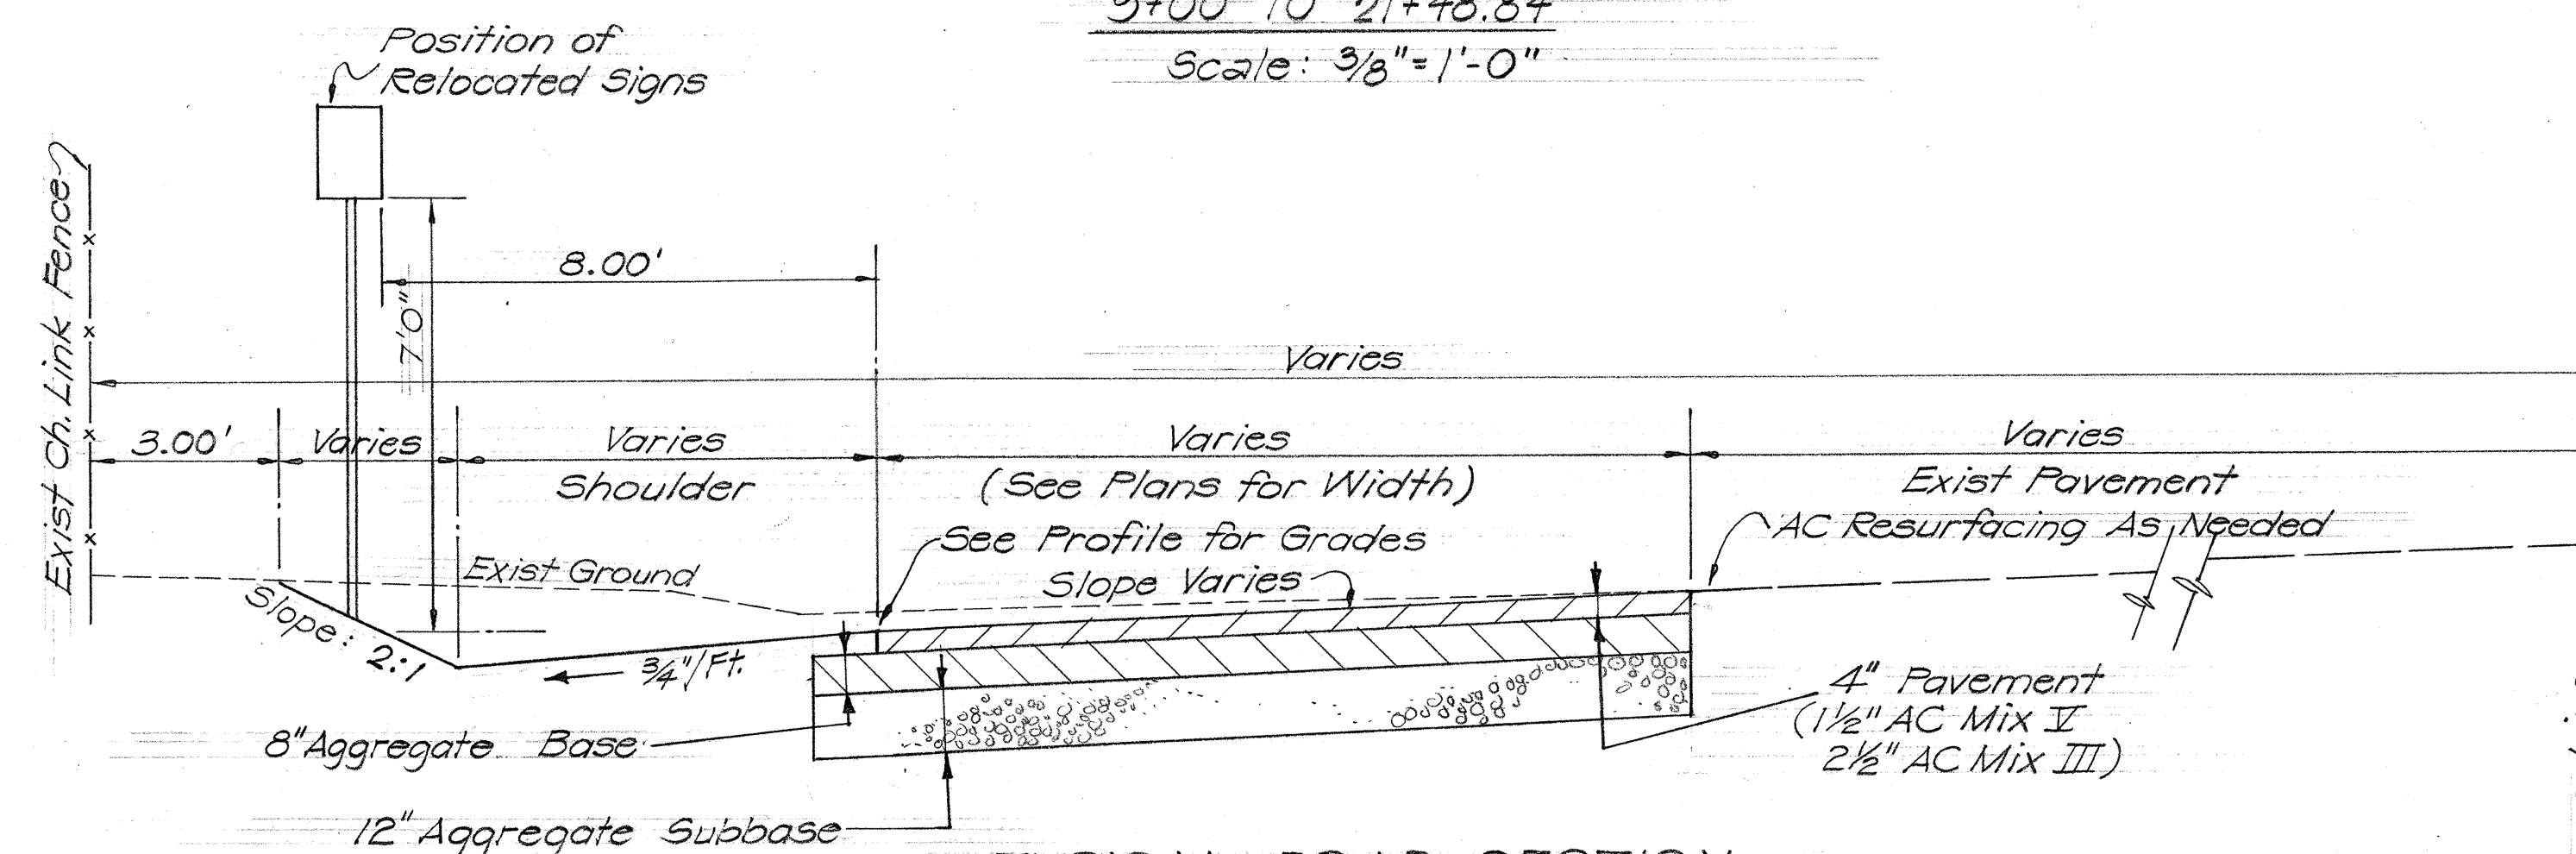

TYPICAL ROAD SECTION
MIDDLE STREET - CUT SIDE SLOPE
9+00 TO 21+48.84
Scale: 3/8" = 1'-0"




LEGEND

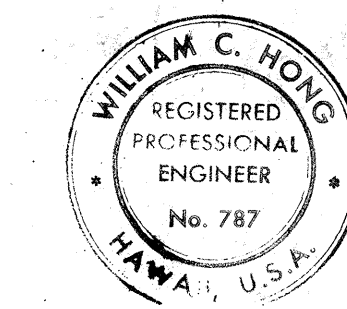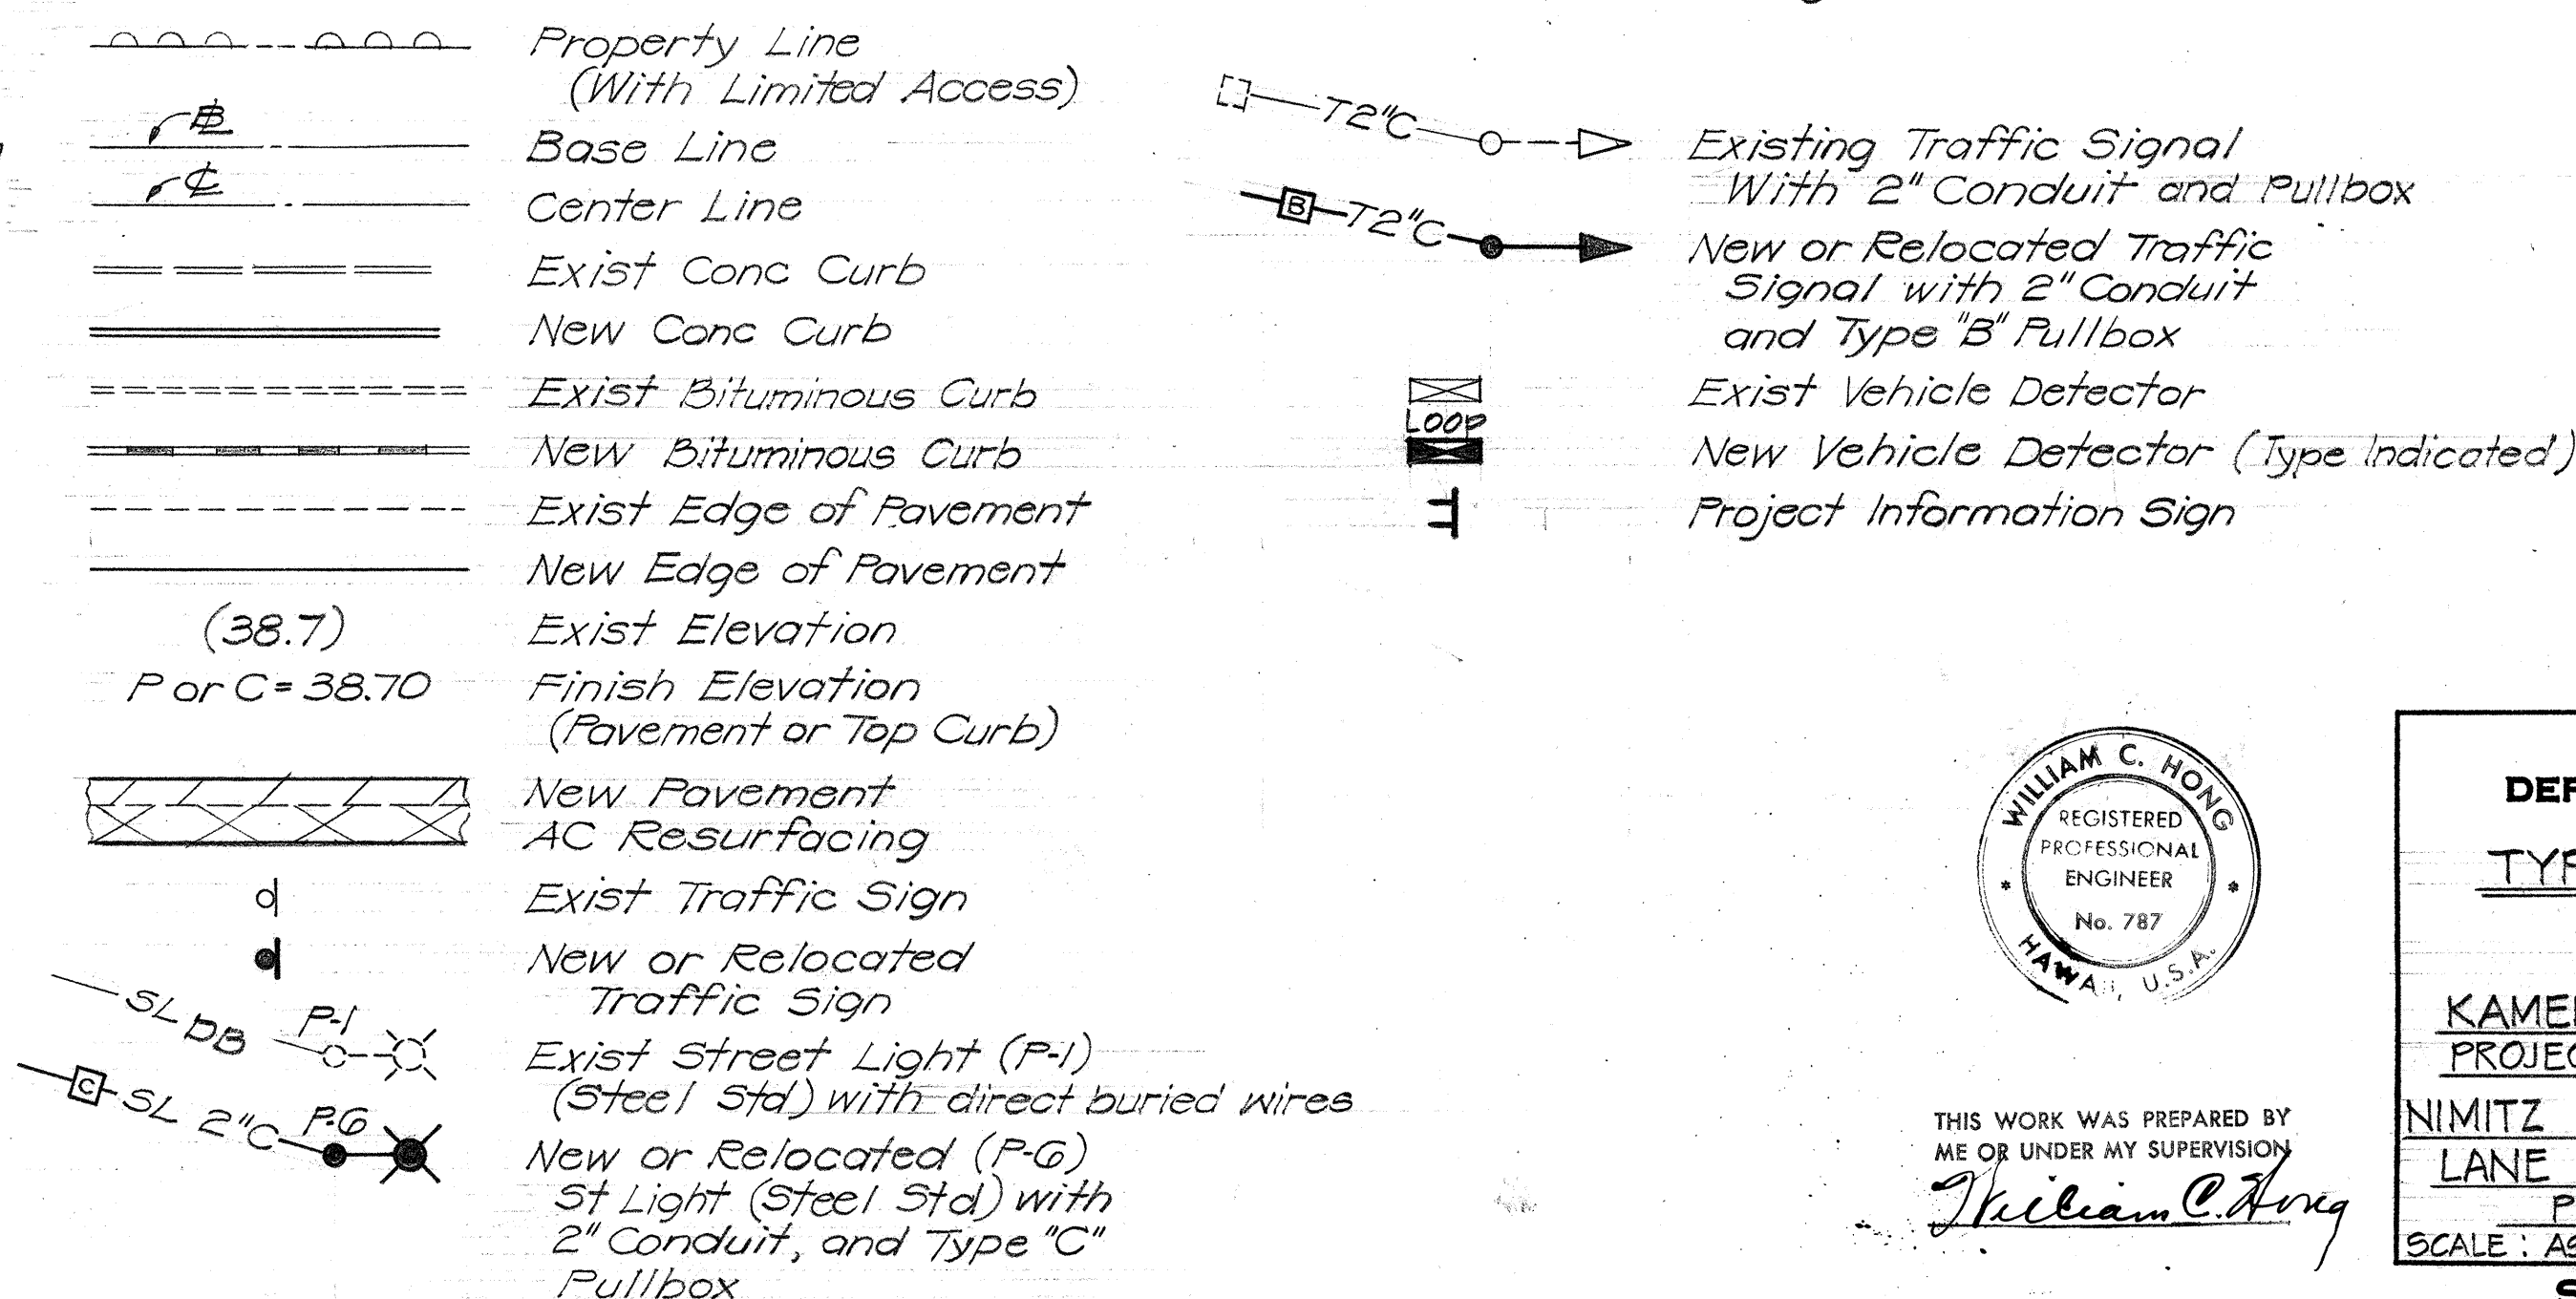

THIS WORK WAS PREPARED BY
ME OR UNDER MY SUPERVISION
William C. Hong

STATE OF HAWAII
DEPARTMENT OF TRANSPORTATION
HIGHWAYS DIVISION
TYPICAL ROAD SECTIONS
AND
LEGEND
KAMEHAMEHA HIGHWAY IMPROVEMENTS
PROJECT NO. 90BD-03-70 PHASE II
NIMITZ HIGHWAY LEFT TURN INBOUND
LANE EXTENSION AT MIDDLE STREET
PROJECT NO. 92A-01-71
SCALE: AS NOTED DATE: OCT. 31, 1970
SHEET No. 1 OF 2 SHEET

FED. ROAD DIST. NO.	STATE	PROJ. NOS.	FISCAL YEAR	SHEET NO.	TOTAL SHEETS
HAWAII	HAW.	20 BD-03-70 PHASE II & 22A-01-71	1970	3	26

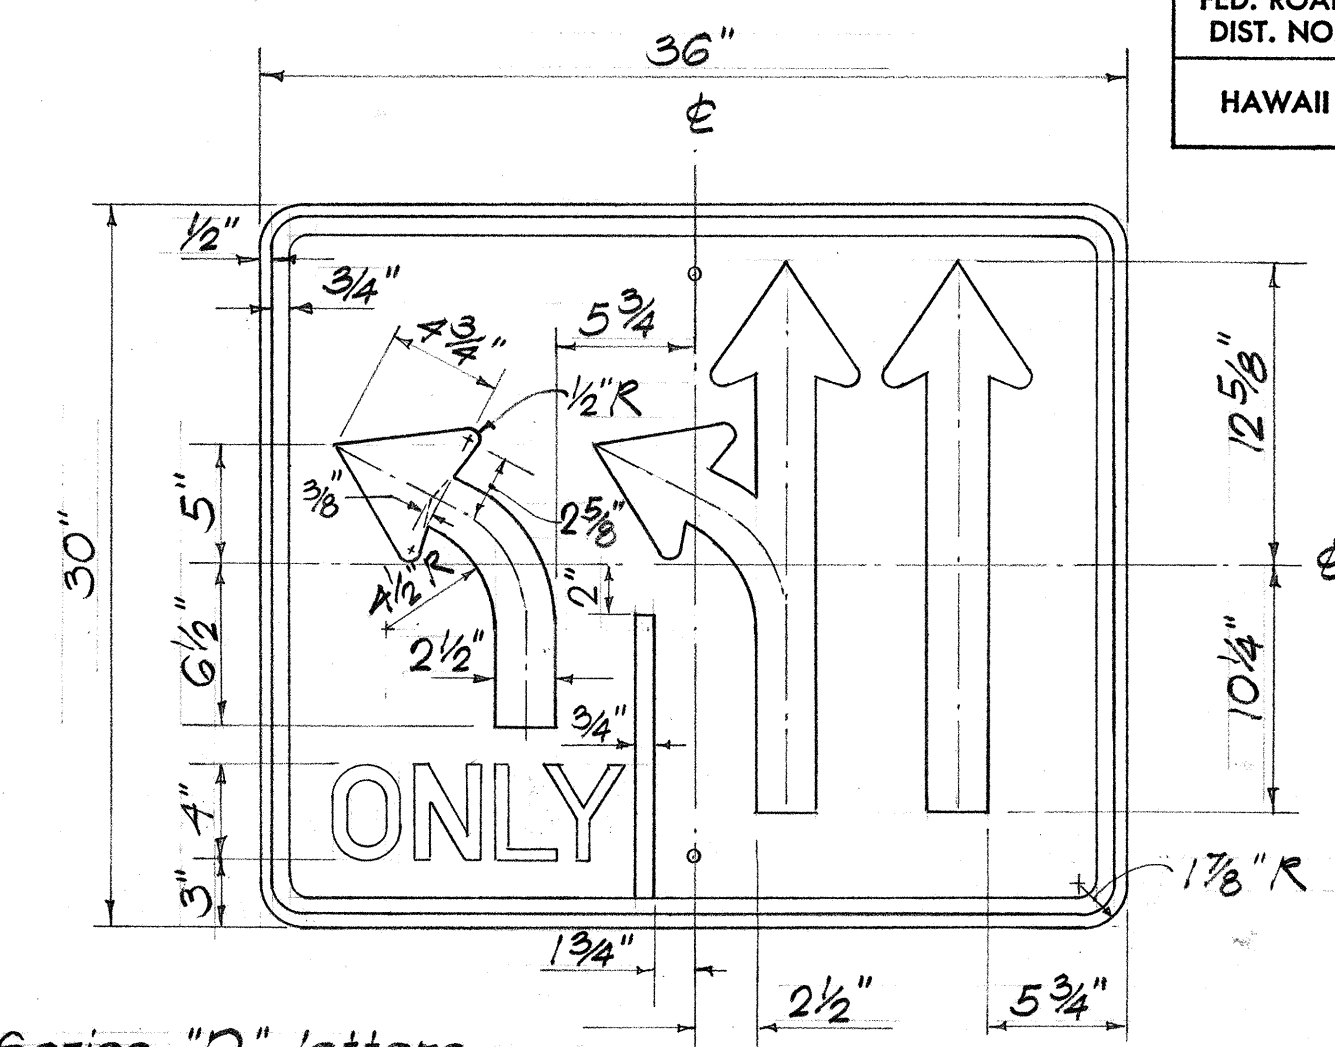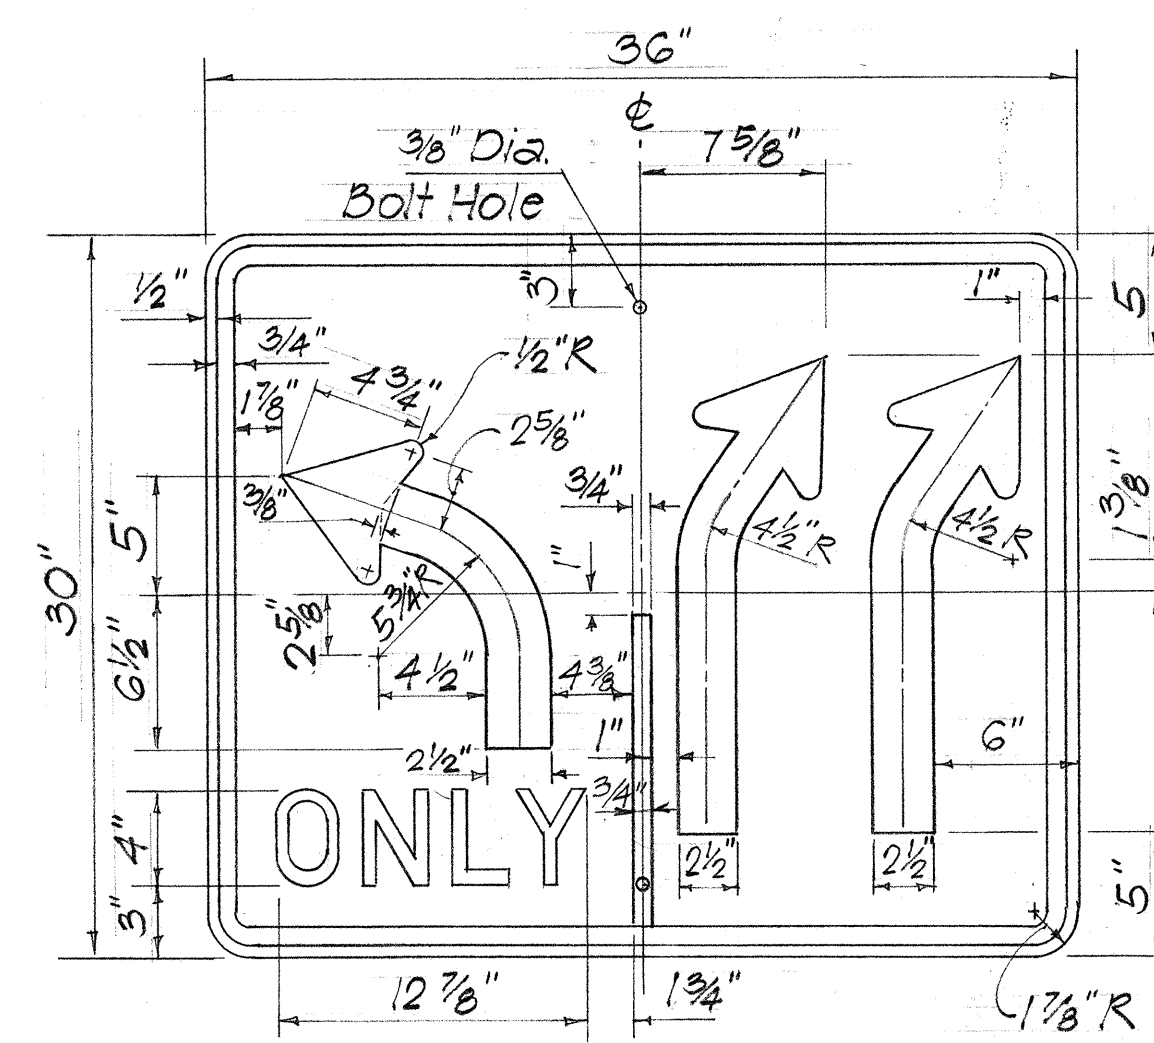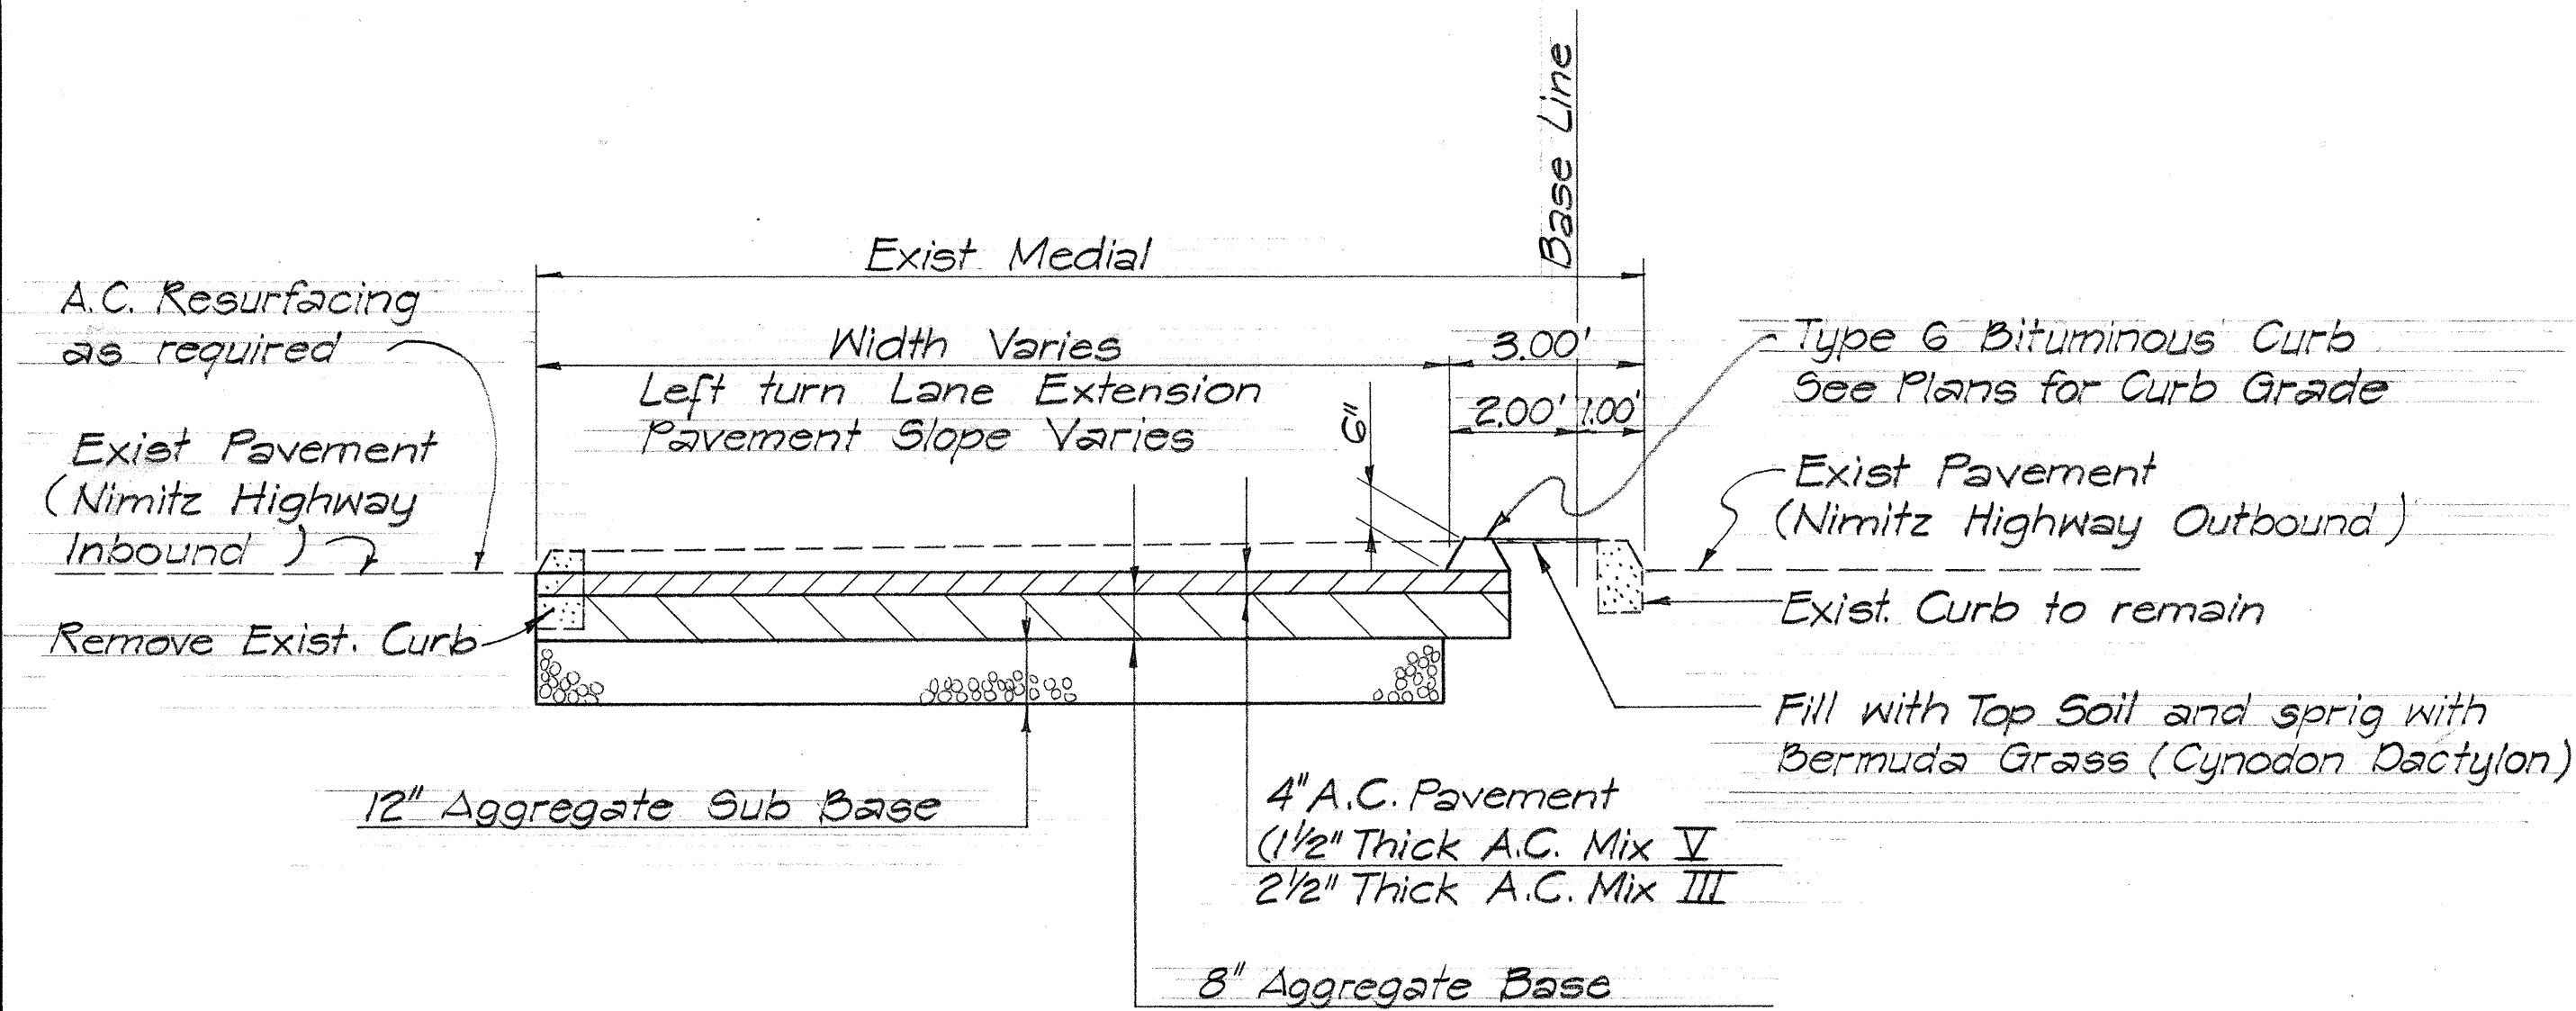


NOTE: Use Series "D" letters.
Black legend on reflectorized
white background.



TYPICAL ROAD SECTION
NIMITZ HIGHWAY INBOUND AT MIDDLE STREET
LEFT TURN LANE EXTENSION
Scale: 3/8" = 1'-0"

R3-12 36" x 30"
Scale: 1 1/2" = 1'-0"


R3-19 36" x 30"
Scale: 1 1/2" = 1'-0"

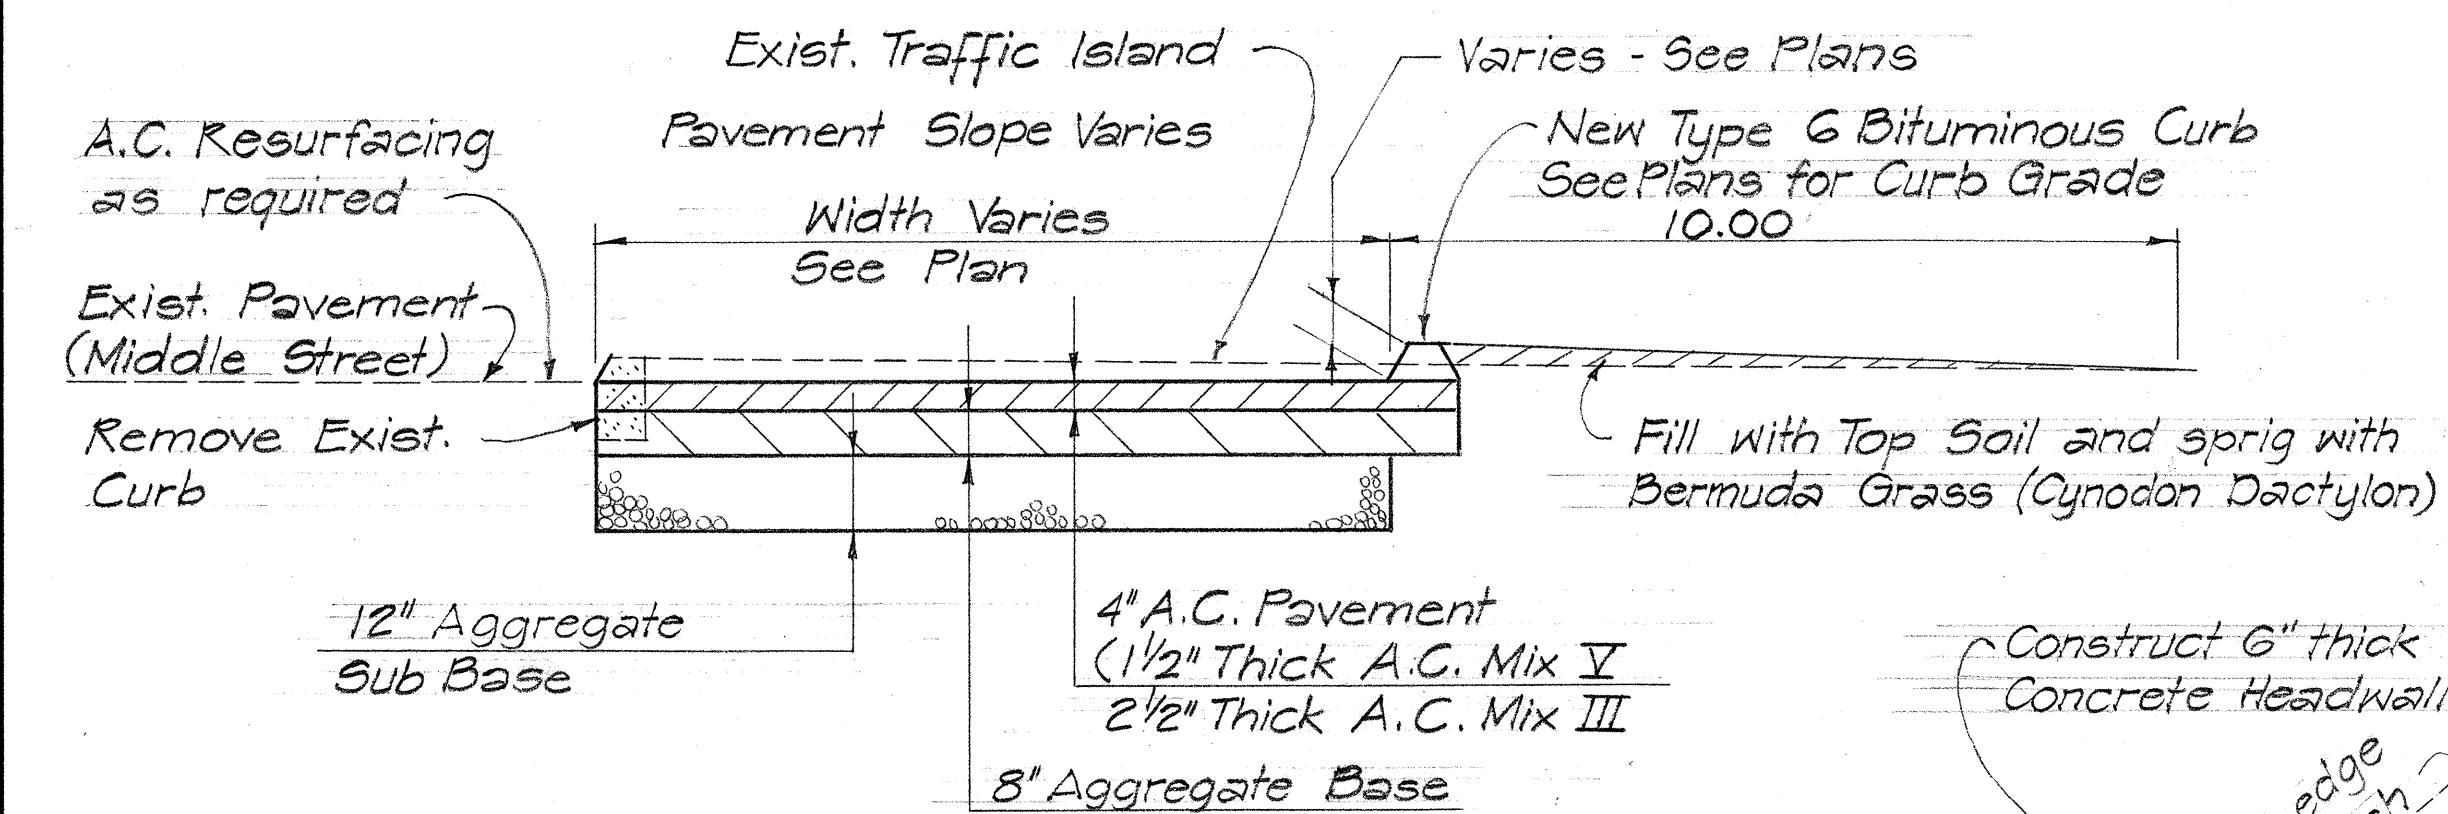

TYPICAL ROAD SECTION
PAVEMENT WIDENING AT TRAFFIC ISLAND
ON MIDDLE STREET
Scale: 3/8" = 1'-0"

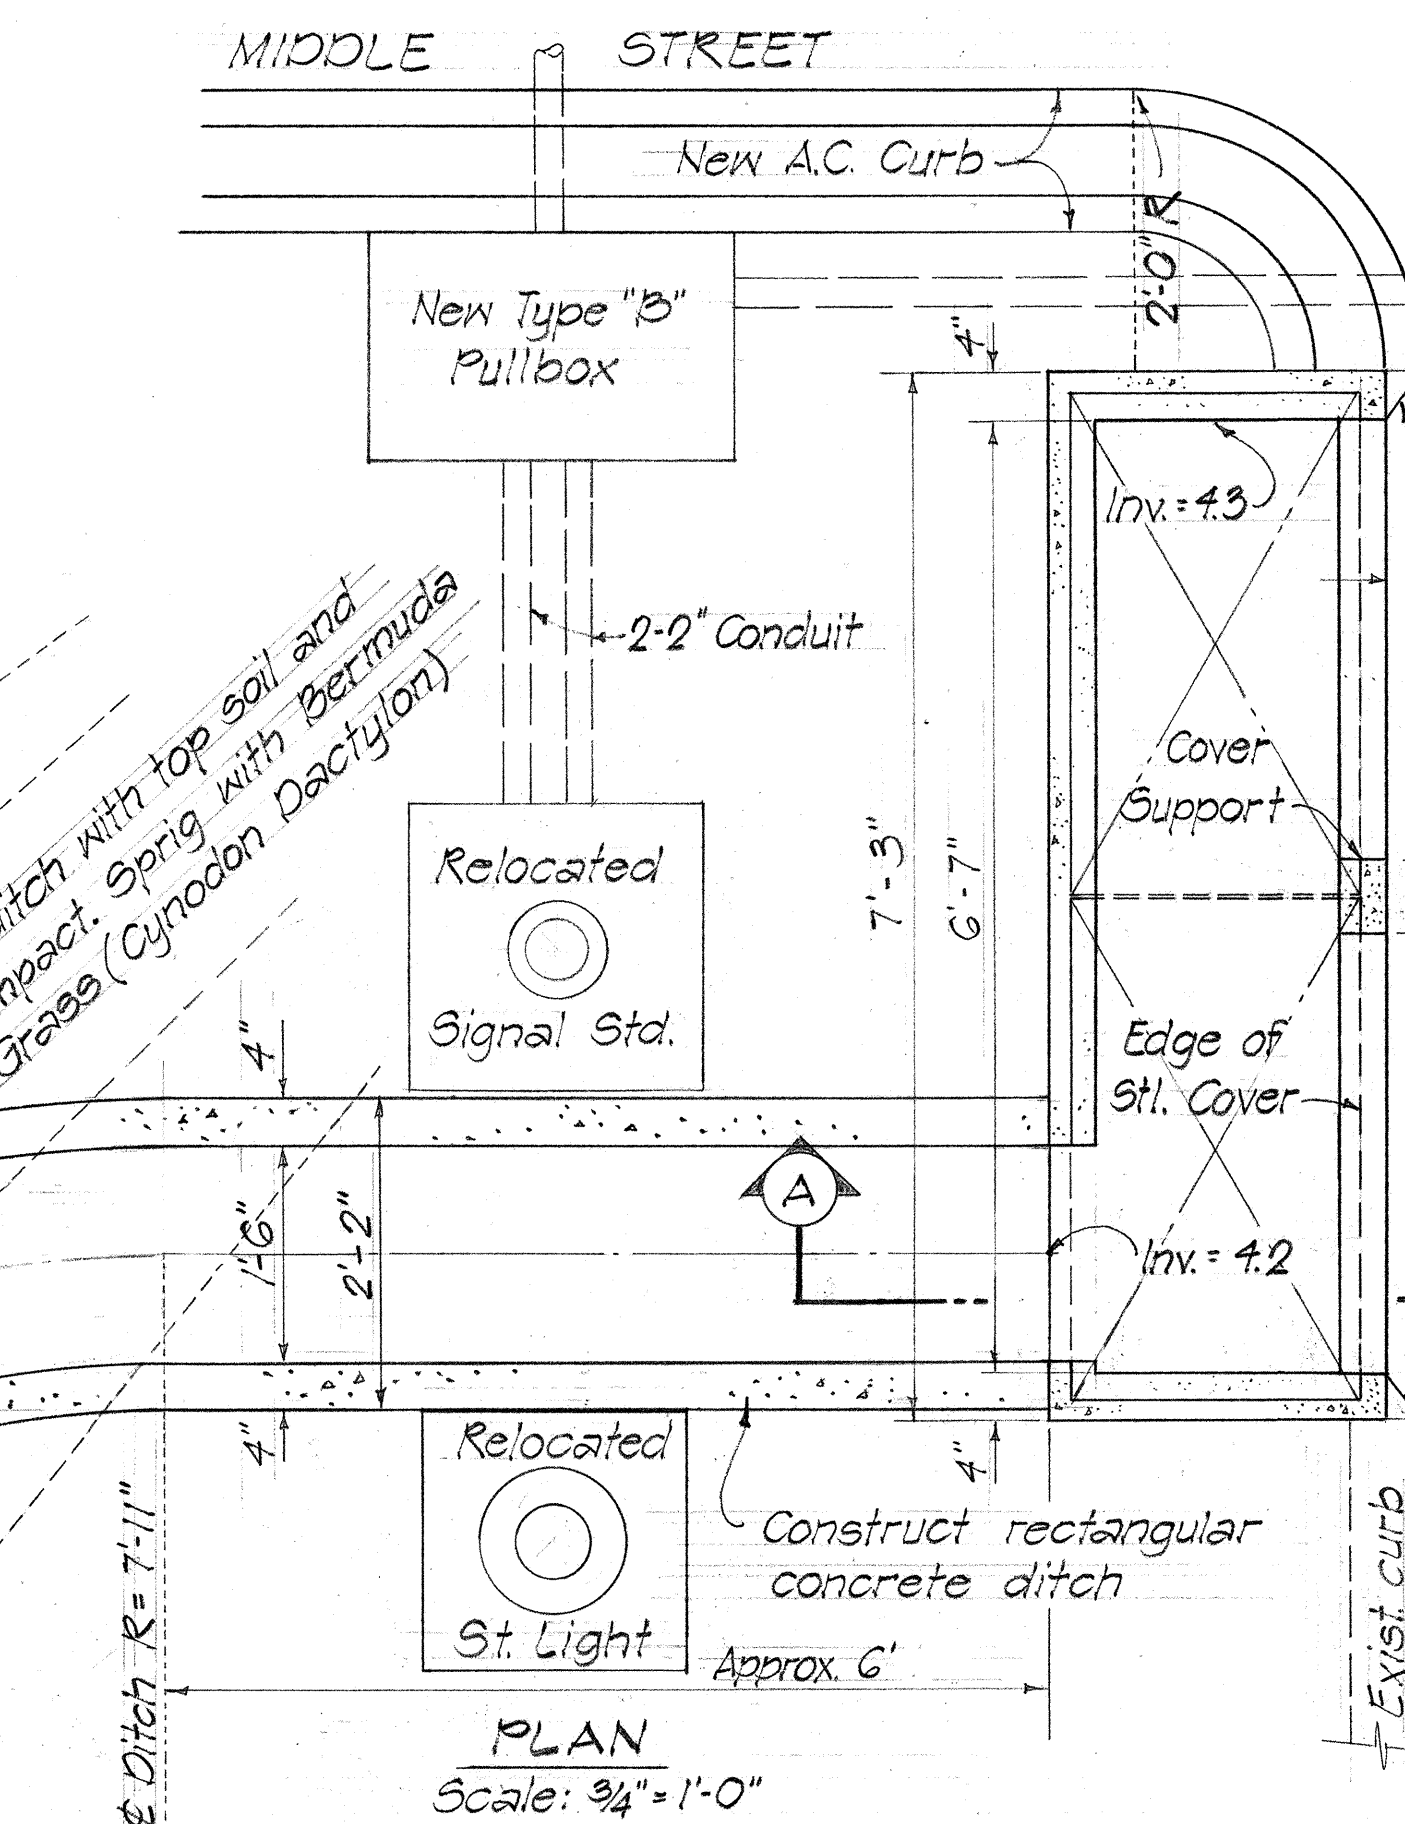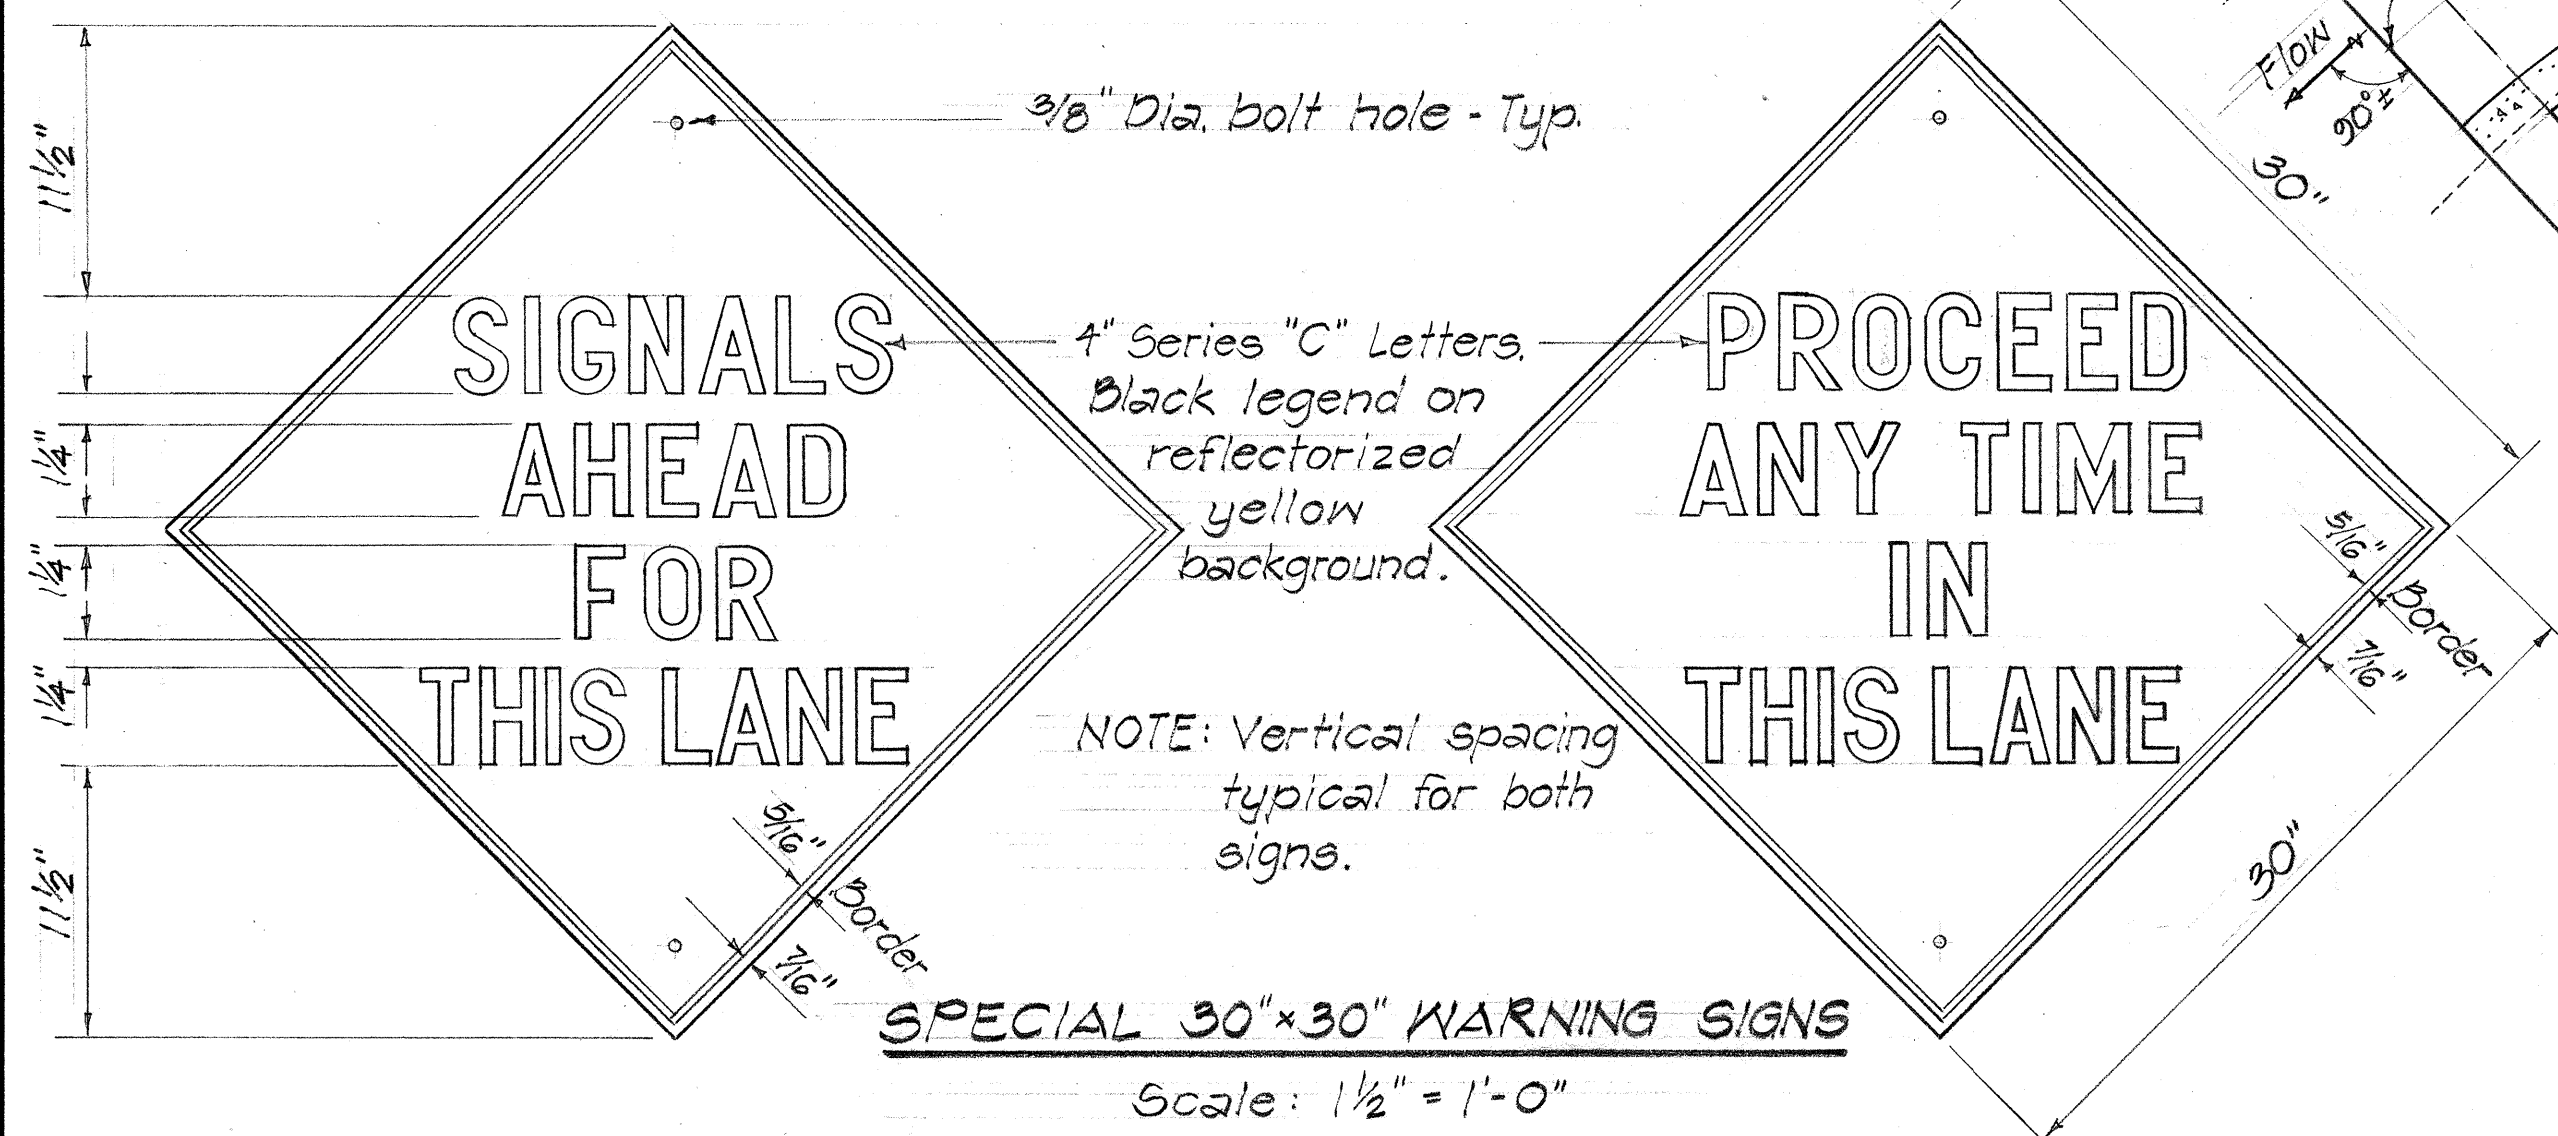


SPECIAL CATCH BASIN & HEADWALL
(-) 0+47 RIGHT MIDDLE STREET
Scale as shown

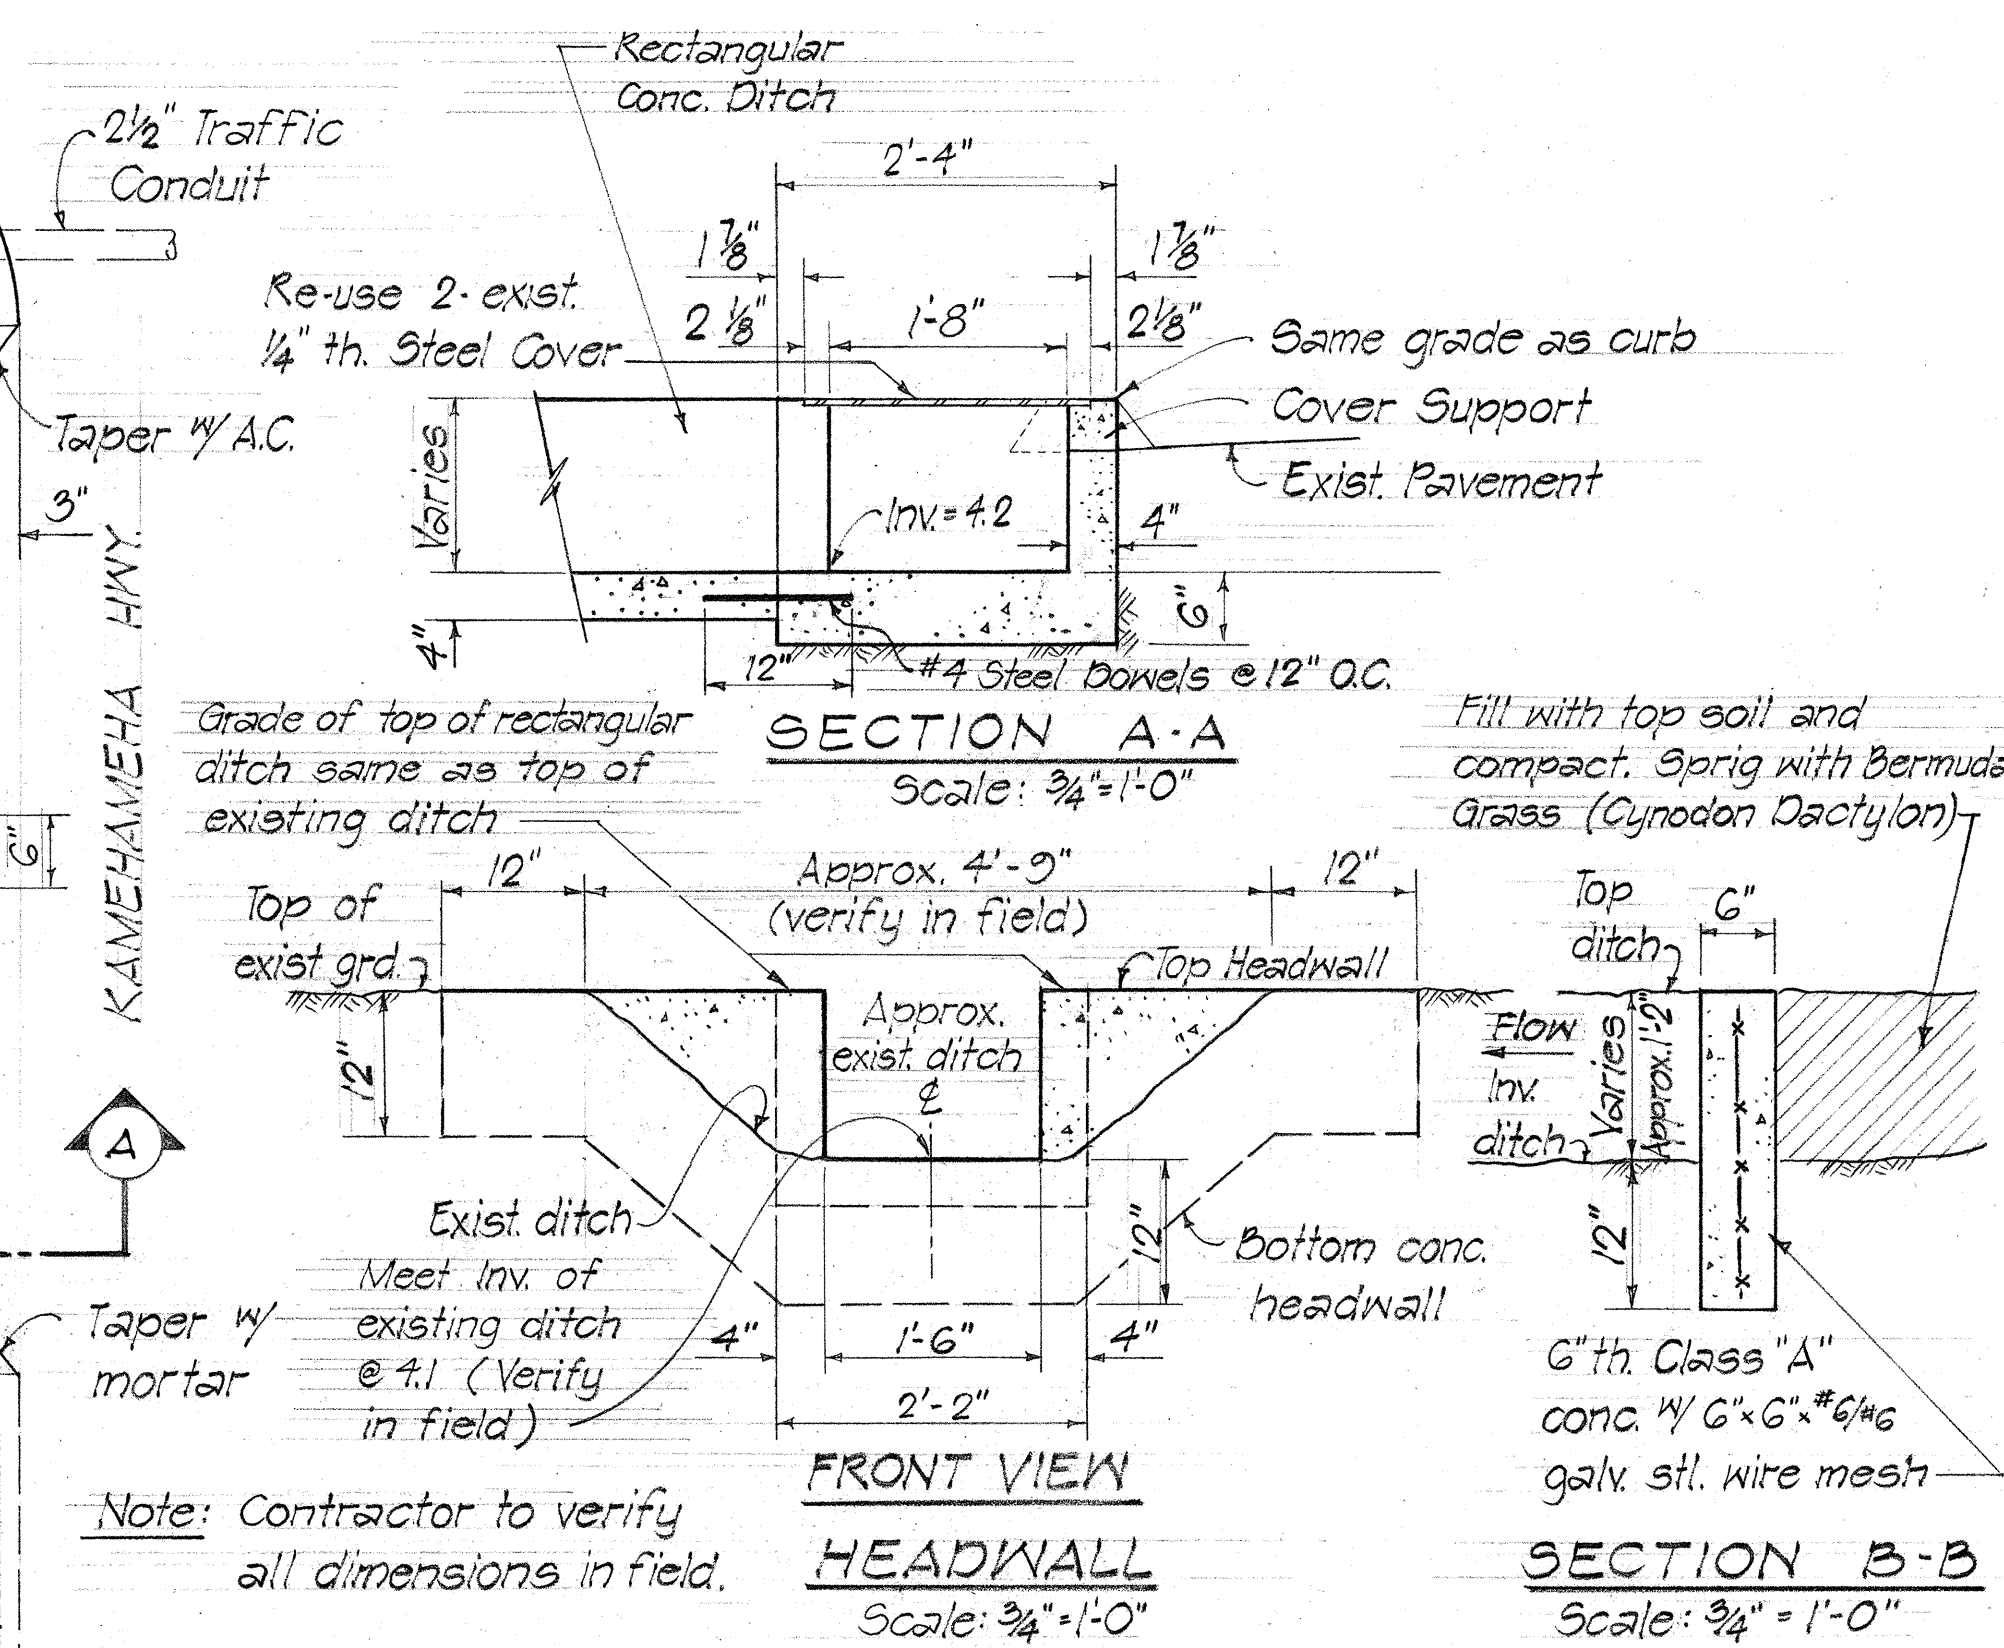

SECTION A-A
Scale: 3/4" = 1'-0"

SECTION B-B
Scale: 3/4" = 1'-0"

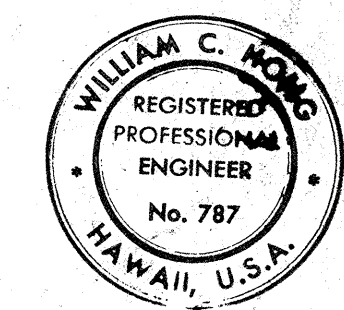

THIS WORK WAS PREPARED BY
ME OR UNDER MY SUPERVISION
William C. Kono

STATE OF HAWAII
DEPARTMENT OF TRANSPORTATION
HIGHWAYS DIVISION

TYPICAL ROAD SECTIONS
NIMITZ HIGHWAY: (-) 0+50 TO 6+00
MIDDLE STREET: (-) 2+75 TO 1+80
AND
MISCELLANEOUS DETAILS

Scale as shown Date: Oct. 31, 1970

SHEET No. 2 OF 2 SHEETS

3