


| FED. ROAD DIST. NO. | STATE | FED. AID PROJ. NO. | FISCAL YEAR | SHEET NO. | TOTAL SHEETS |
|---------------------|-------|--------------------|-------------|-----------|--------------|
| HAWAII              | HAW.  | I-H-1(10):15       | 1973        | 93        | 220          |

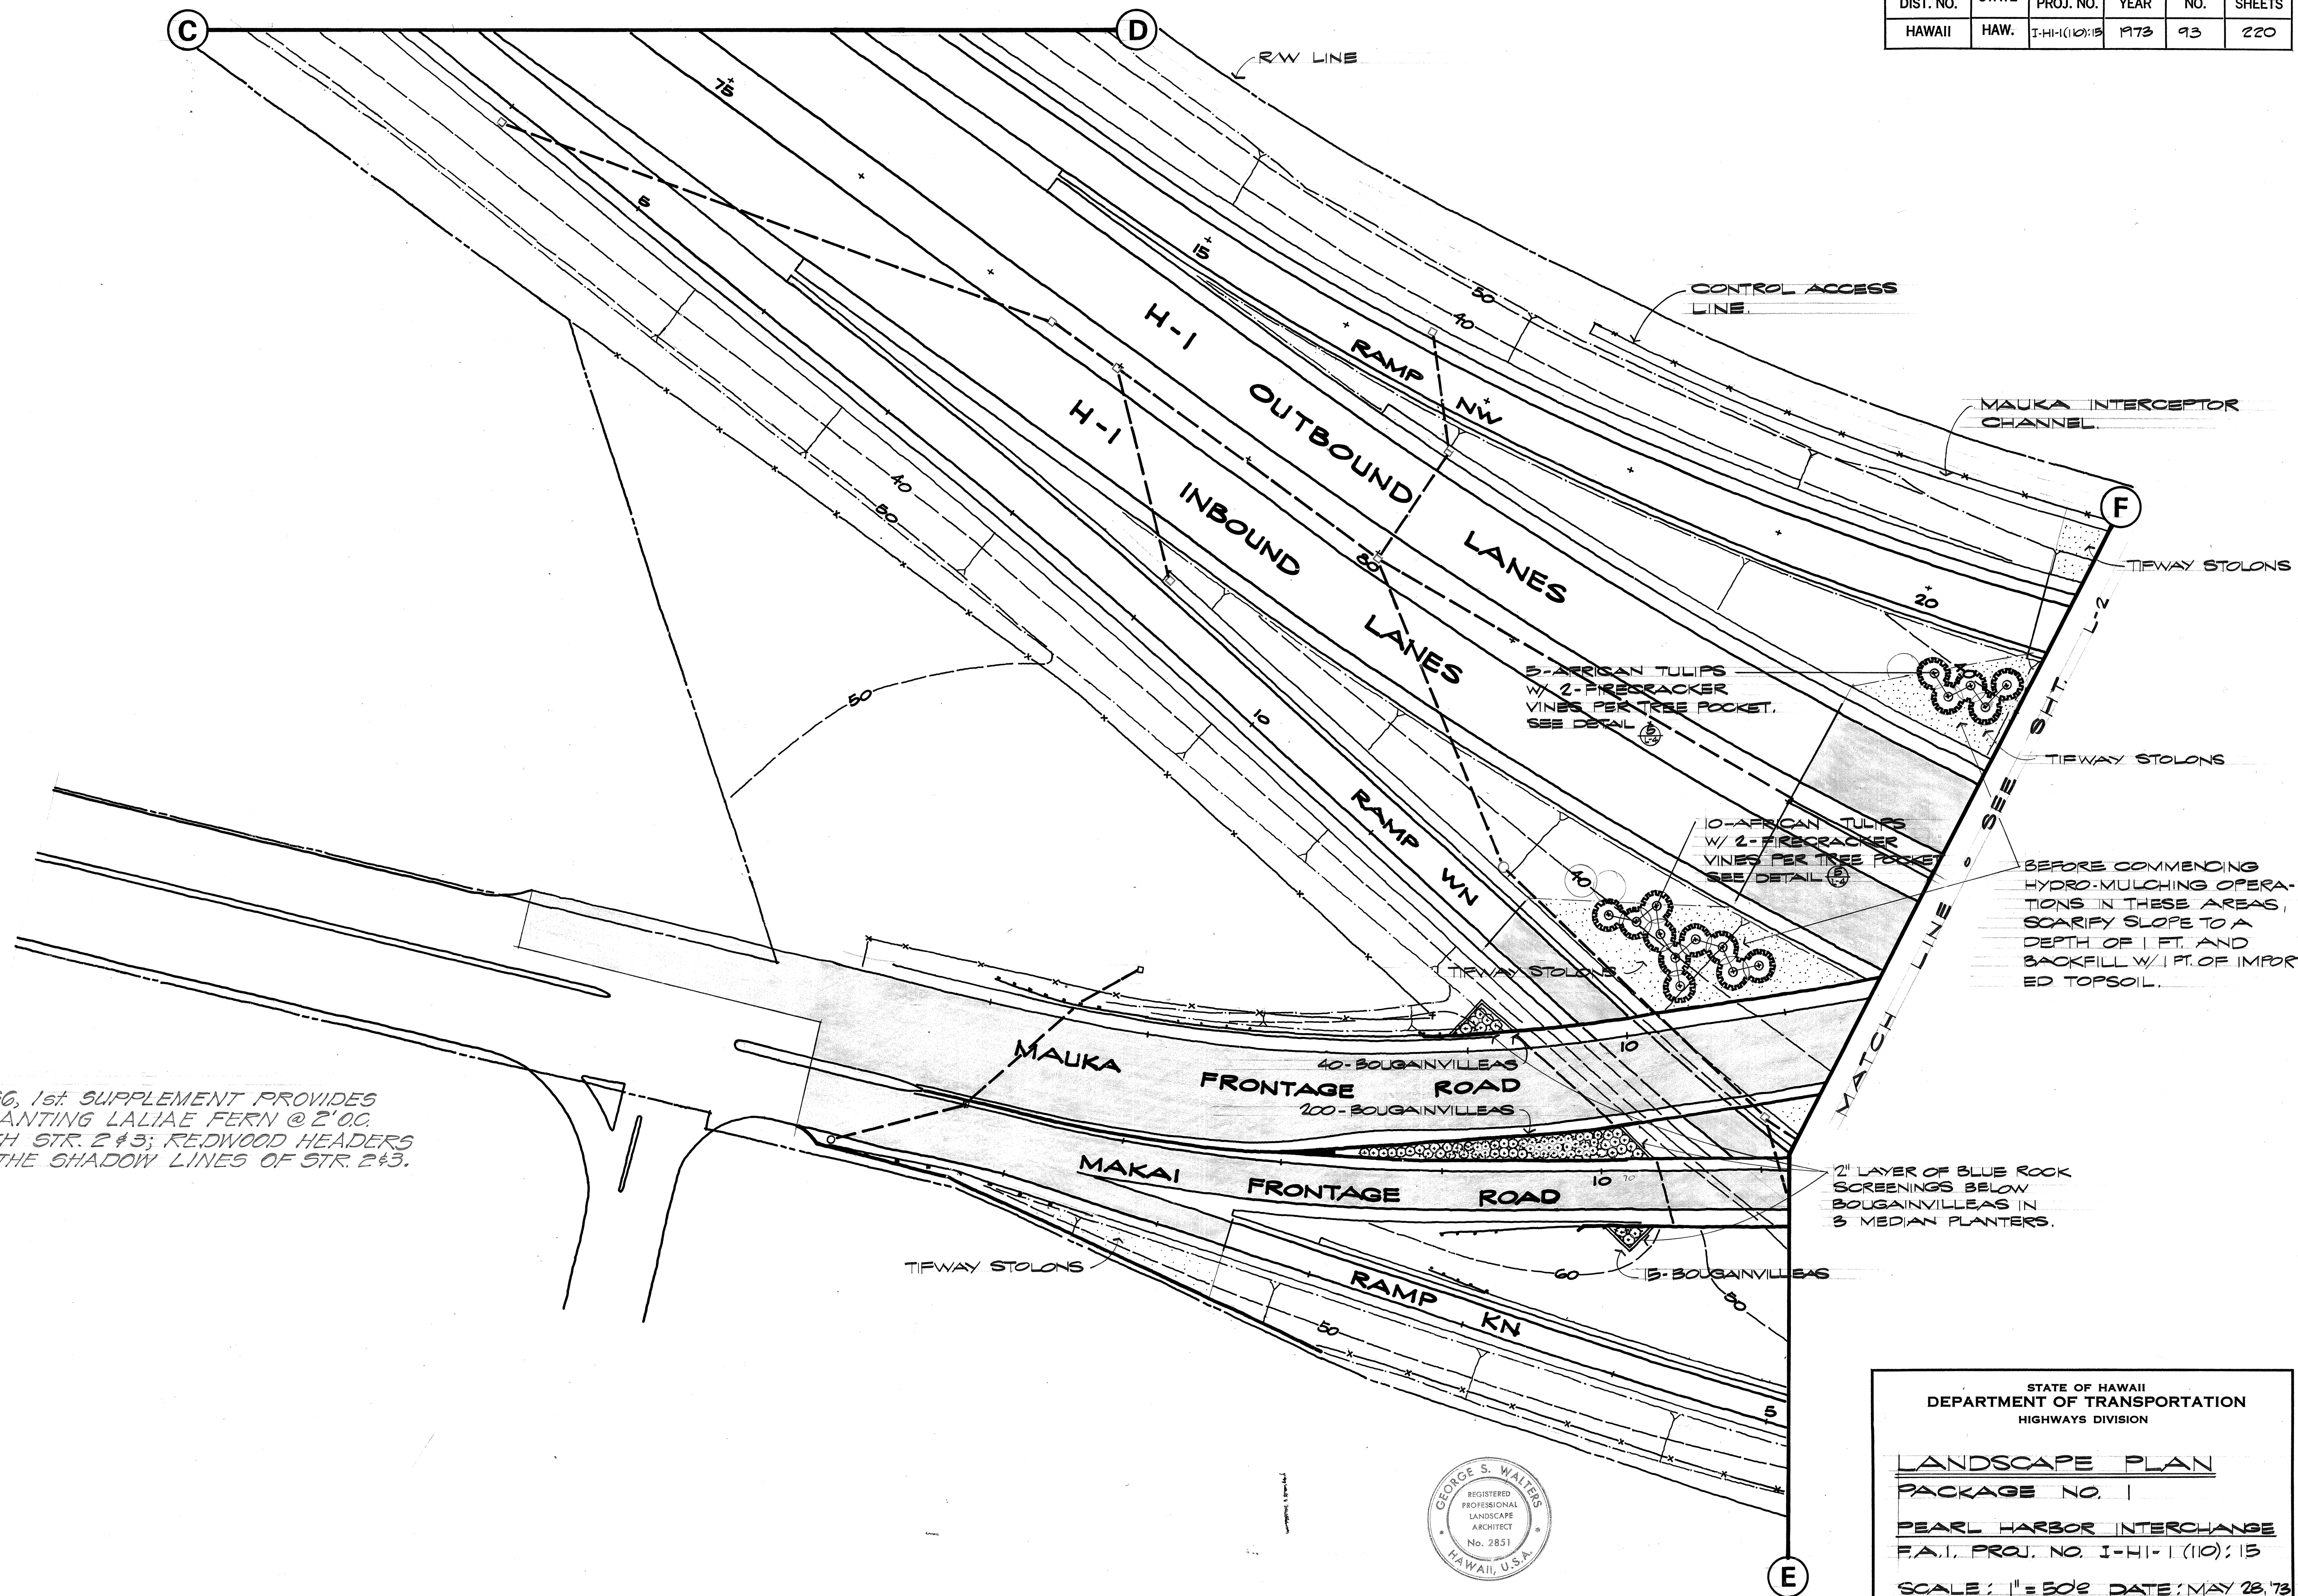

NOTE:  
 CO. #00, 1st SUPPLEMENT PROVIDES  
 FOR PLANTING LALIAE FERN @ 2'00.  
 BENEATH STR. 2#3; REDWOOD HEADERS  
 ALONG THE SHADOW LINES OF STR. 2#3.

BEFORE COMMENCING  
 HYDRO-MULCHING OPERA-  
 TIONS IN THESE AREAS,  
 SCARIFY SLOPE TO A  
 DEPTH OF 1 FT. AND  
 BACKFILL W/ 1 FT. OF IMPOR-  
 ED TOPSOIL.

12" LAYER OF BLUE ROCK  
 SCREENINGS BELOW  
 BOUGAINVILLEAS IN  
 3 MEDIAN PLANTERS.

|           |                   |      |
|-----------|-------------------|------|
| ORIGINAL  | SURVEY PLOTTED BY | DATE |
| PLAN      | DRAWN BY          |      |
| NOTE BOOK | TRACED BY         |      |
|           | DESIGNED BY       |      |
|           | CHECKED BY        |      |



THIS WORK WAS PREPARED BY ME  
 OR UNDER MY SUPERVISION

STATE OF HAWAII  
 DEPARTMENT OF TRANSPORTATION  
 HIGHWAYS DIVISION

**LANDSCAPE PLAN**  
 PACKAGE NO. 1


**PEARL HARBOR INTERCHANGE**  
 F.A.I. PROJ. NO. I-H-1 (10):15

SCALE: 1" = 50' DATE: MAY 28, '73

SHEET NO. 93 OF 13 SHEETS



| FED. ROAD DIST. NO. | STATE | FED. AID PROJ. NO. | FISCAL YEAR | SHEET NO. | TOTAL SHEETS |
|---------------------|-------|--------------------|-------------|-----------|--------------|
| HAWAII              | HAW.  | I-H-100-15         | 1973        | 94        | 220          |

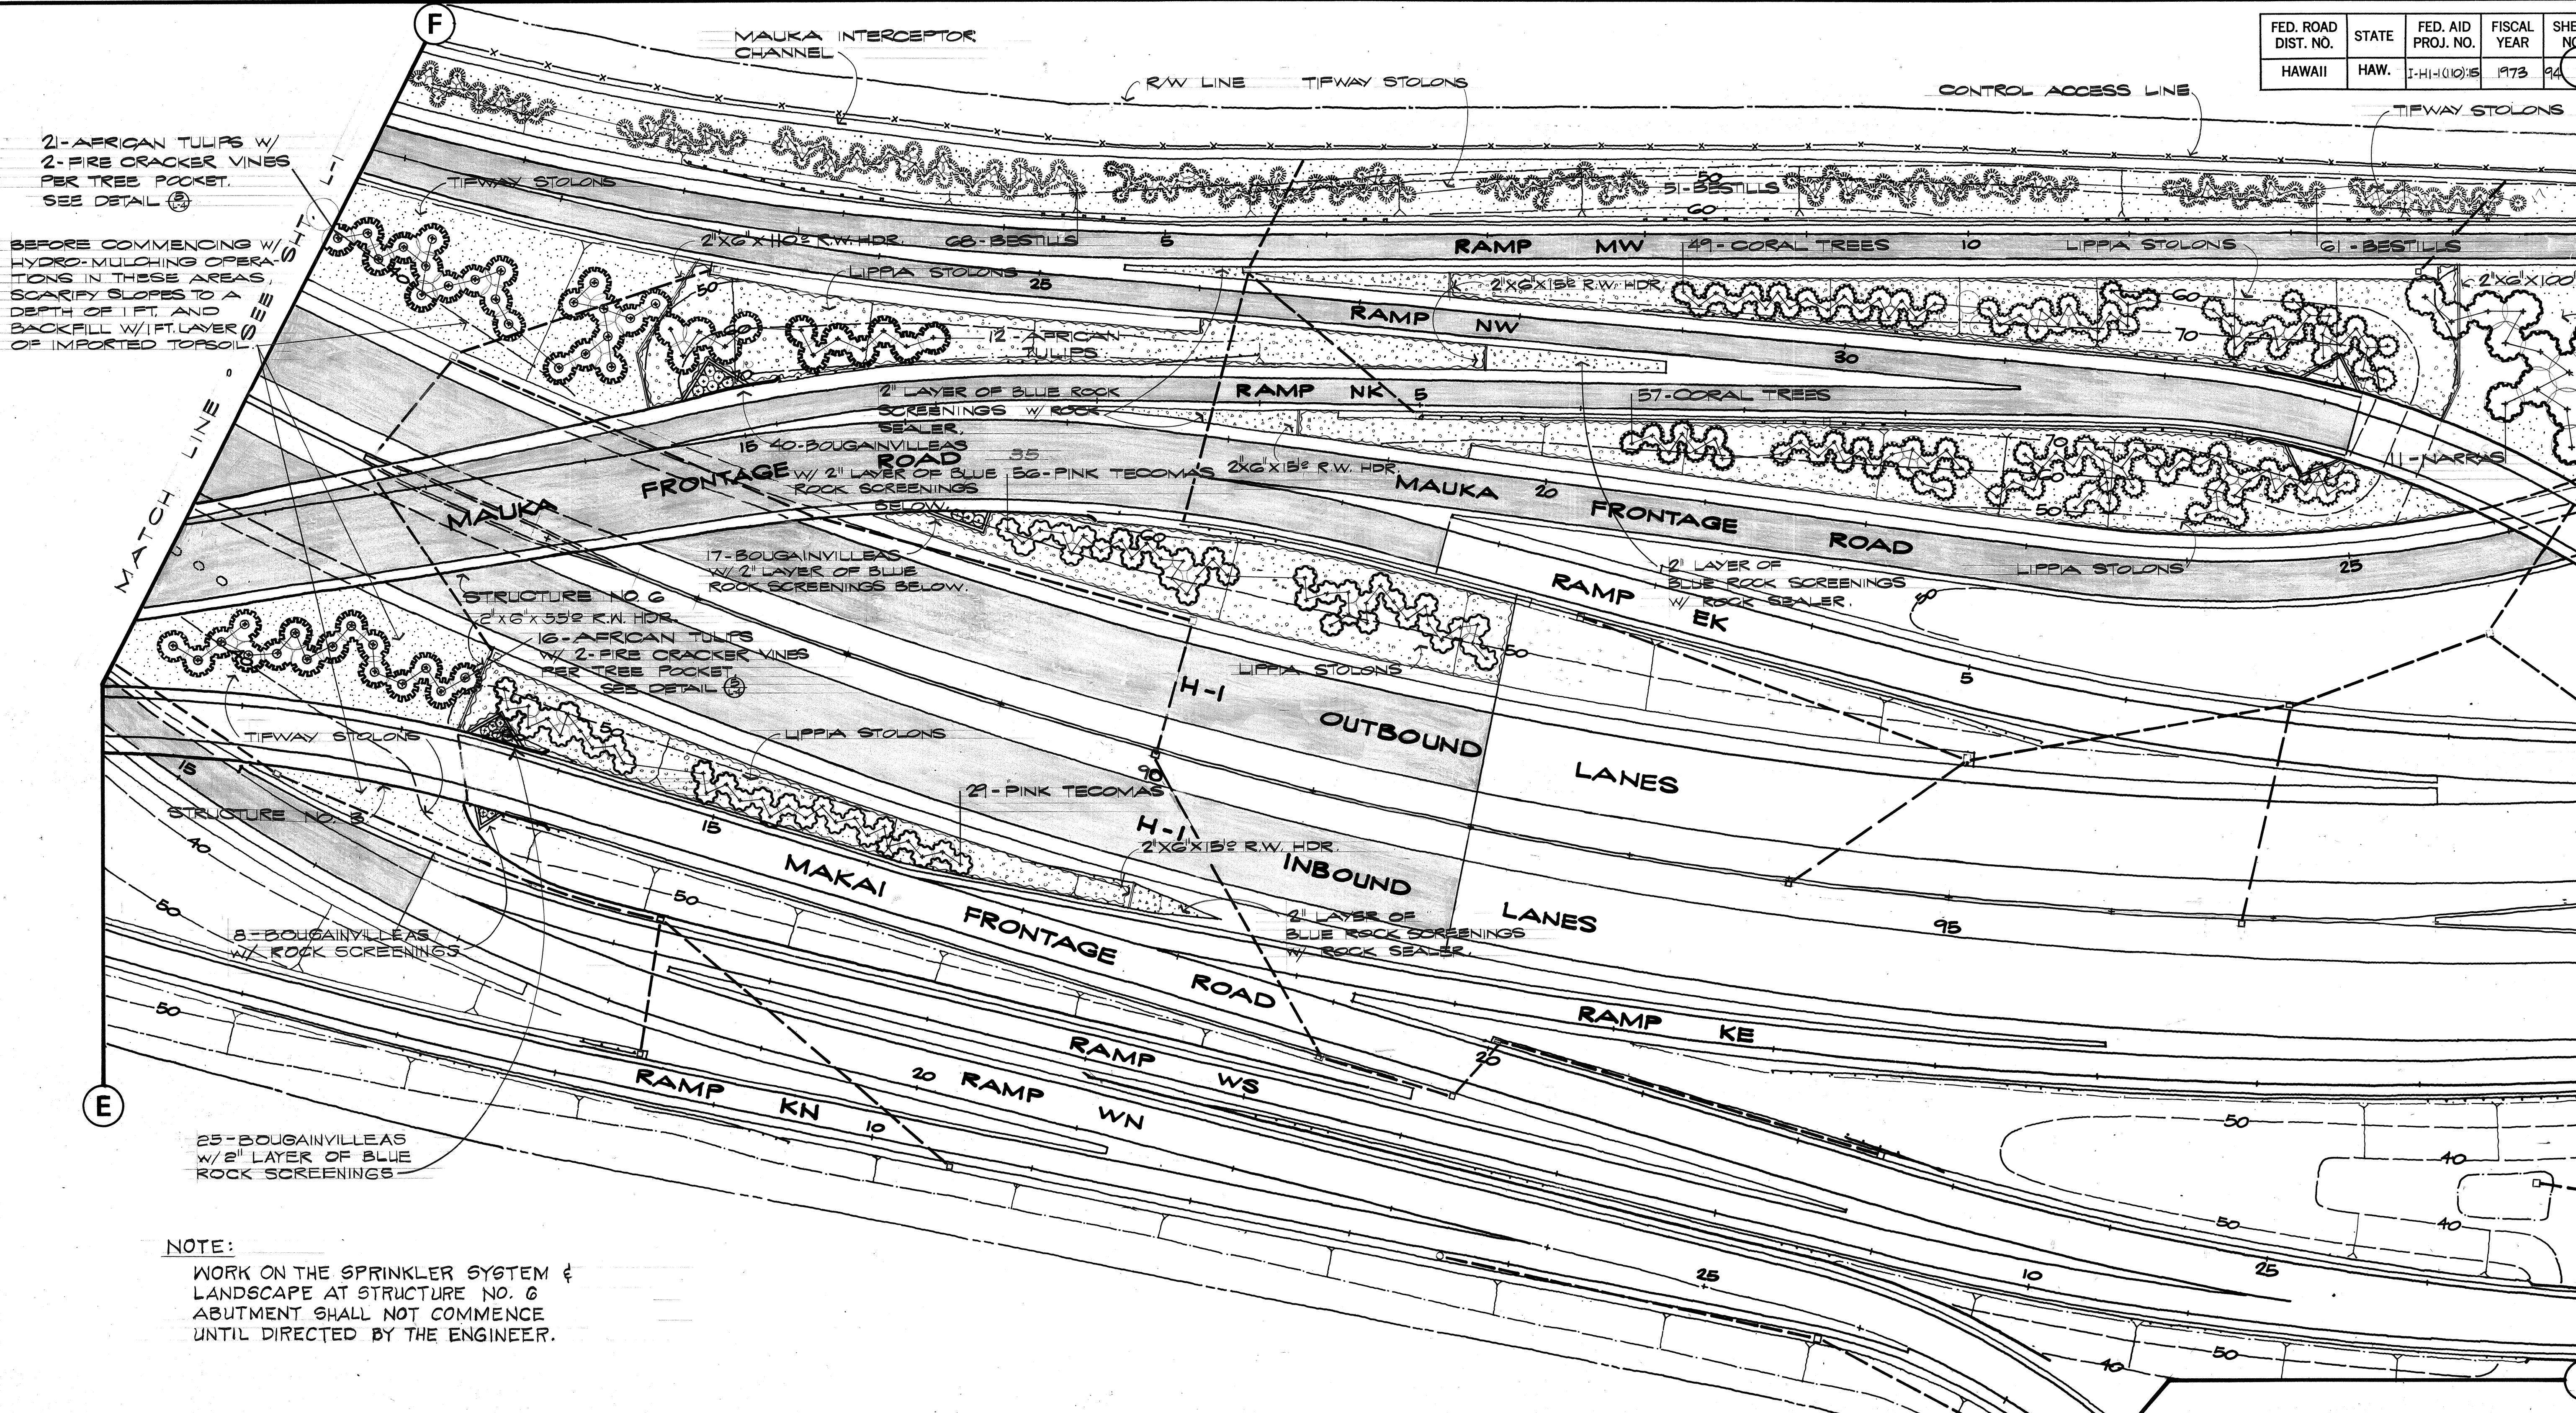

NOTE:  
 WORK ON THE SPRINKLER SYSTEM &  
 LANDSCAPE AT STRUCTURE NO. 6  
 ABUTMENT SHALL NOT COMMENCE  
 UNTIL DIRECTED BY THE ENGINEER.

|                   |      |
|-------------------|------|
| ORIGINAL PLAN     | DATE |
| SURVEY PLOTTED BY |      |
| DRAWN BY          |      |
| DESIGNED BY       |      |
| QUANTITIES BY     |      |
| CHECKED BY        |      |


|       |          |                                                                                                |
|-------|----------|------------------------------------------------------------------------------------------------|
| CO#12 | 11/8/73  | DELETED PLANTING IN H-1<br>MEDIAN AREA. ADDED PLANTING<br>IN STRUCTURE NO. 3 PLANTER<br>BOXES. |
| DATE  | REVISION |                                                                                                |

THIS WORK WAS PREPARED BY ME  
 OR UNDER MY SUPERVISION

STATE OF HAWAII  
 DEPARTMENT OF TRANSPORTATION  
 HIGHWAYS DIVISION  
  
**LANDSCAPE PLAN**  
 PACKAGE NO. 1  
 PEARL HARBOR INTERCHANGE  
 F.A.I. PROJ. NO. I-H-100-15  
 SCALE: 1"=50' DATE: MAY 28, 73  
 SHEET NO. L-2 OF 13 SHEETS



| FED. ROAD DIST. NO. | STATE | FED. AID PROJ. NO. | FISCAL YEAR | SHEET NO. | TOTAL SHEETS |
|---------------------|-------|--------------------|-------------|-----------|--------------|
| HAWAII              | HAW.  | 1-H-1(110)15       | 1973        | 95        | 220          |

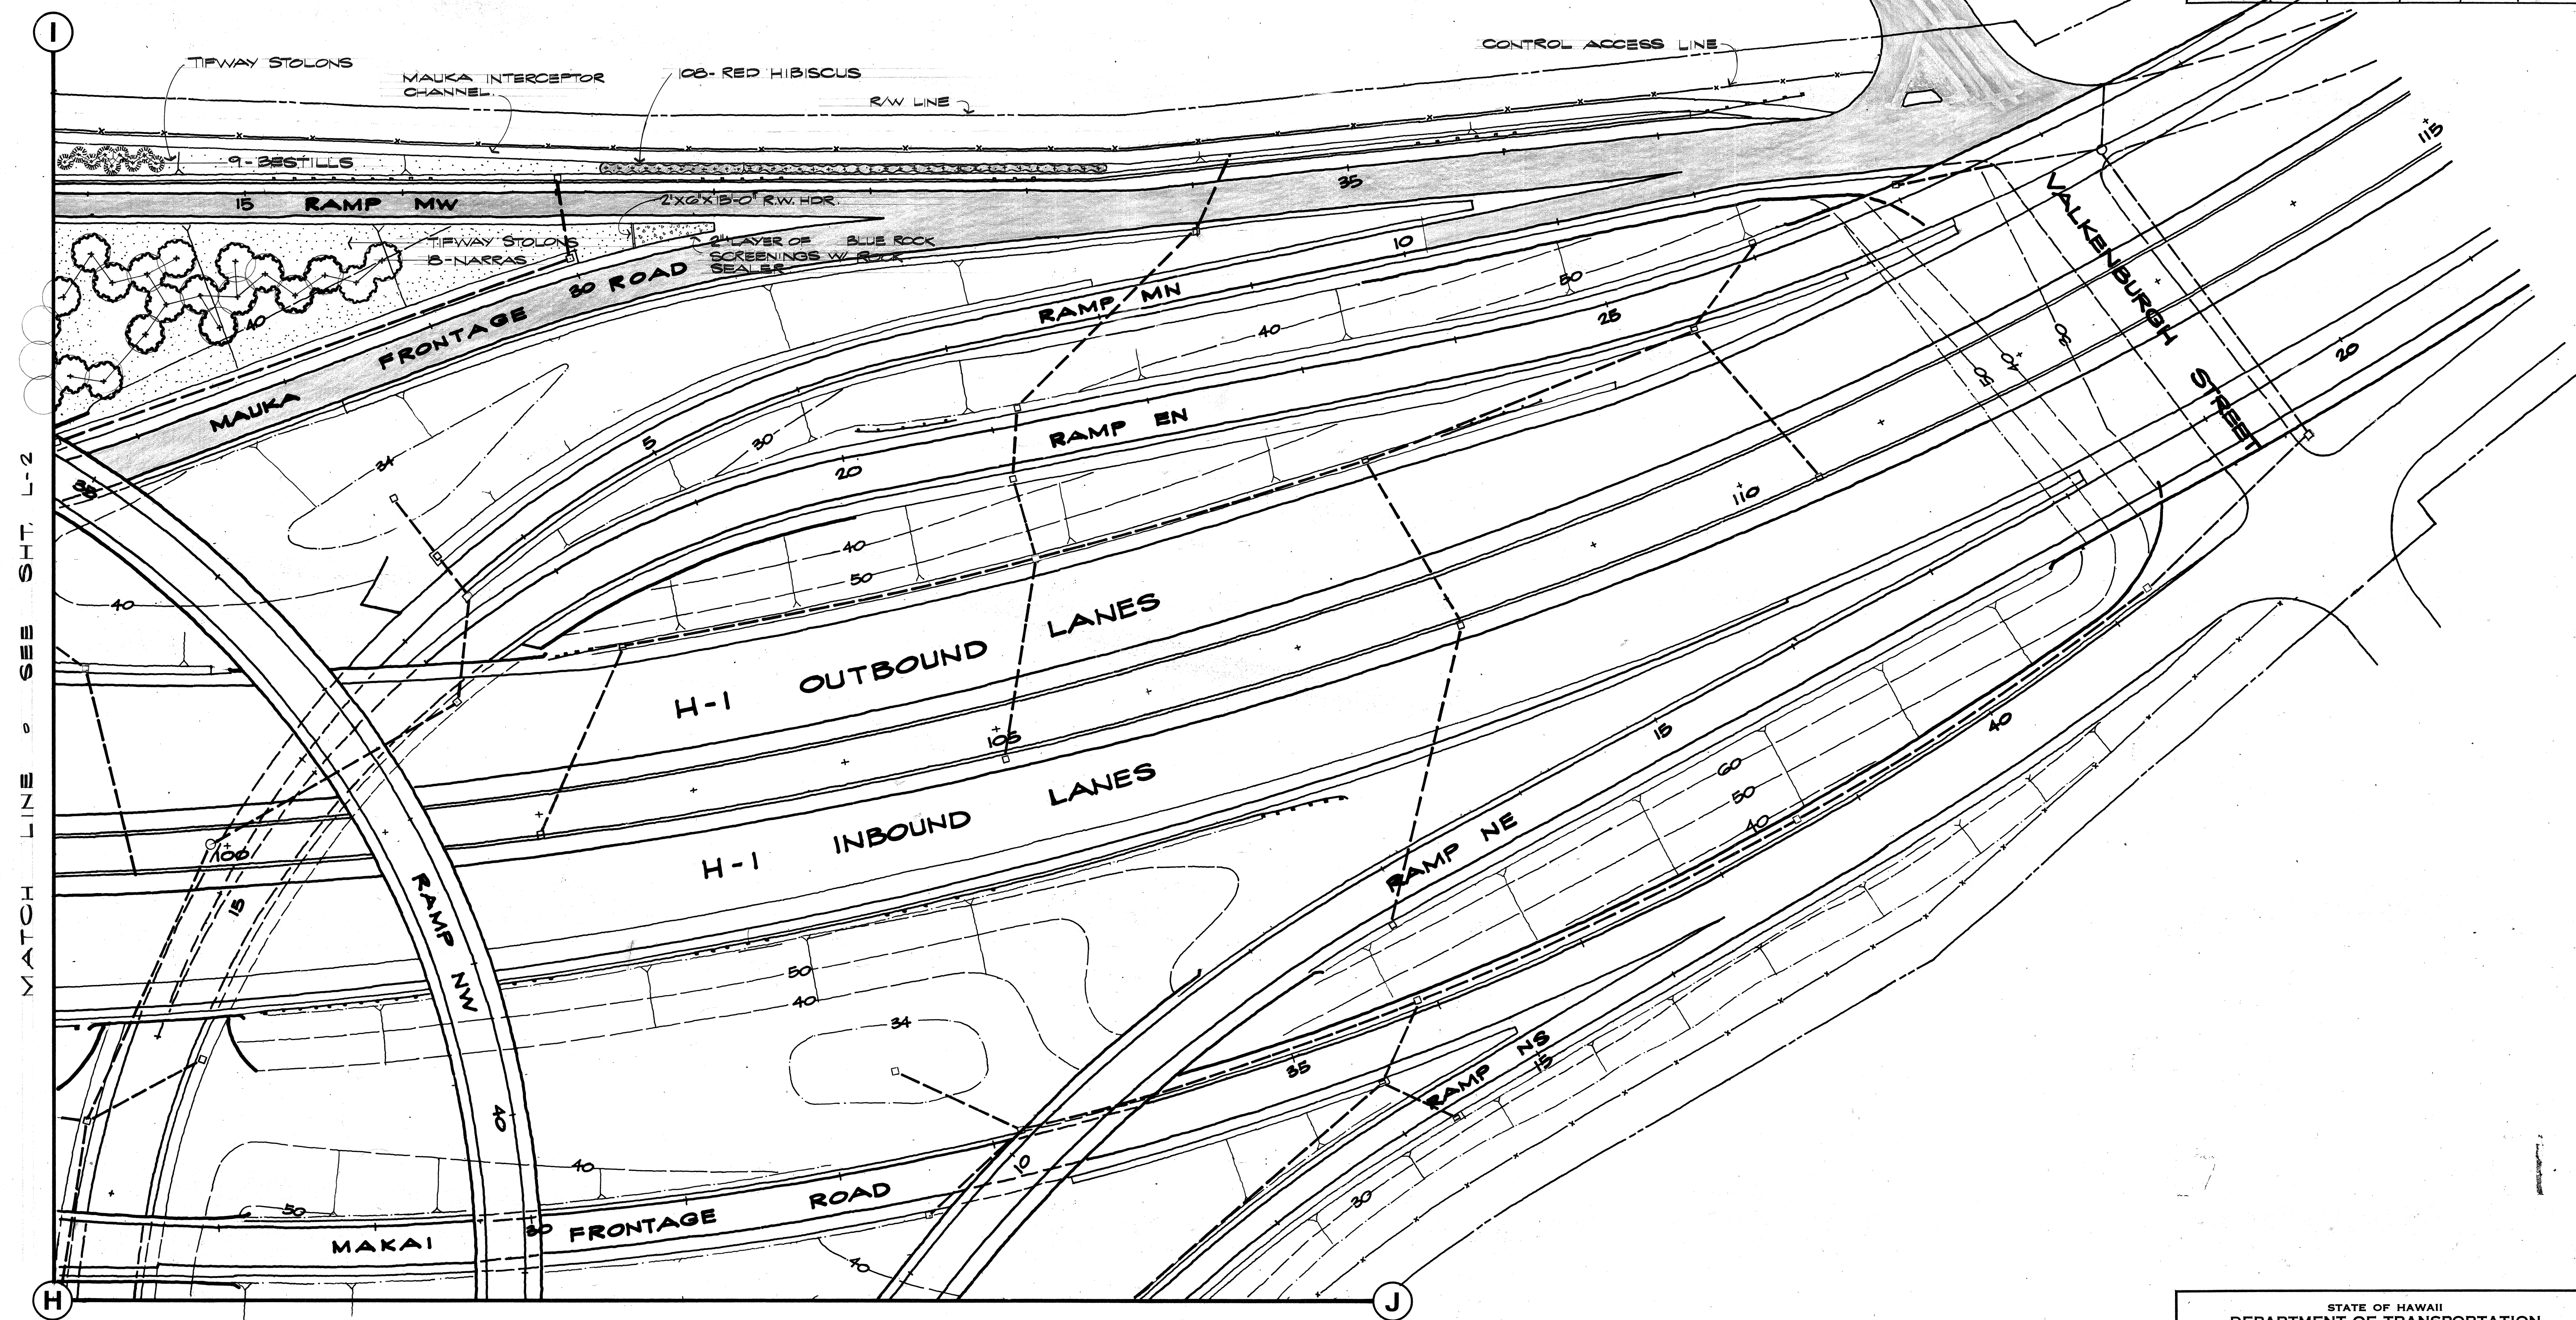

|               |                   |      |
|---------------|-------------------|------|
| ORIGINAL PLAN | SURVEY PLOTTED BY | DATE |
| NOTE BOOK     | DRAWN BY          |      |
|               | DESIGNED BY       |      |
|               | QUANTITIES BY     |      |
|               | CHECKED BY        |      |



THIS WORK WAS PREPARED BY ME  
OR UNDER MY SUPERVISION

STATE OF HAWAII  
DEPARTMENT OF TRANSPORTATION  
HIGHWAYS DIVISION

**LANDSCAPE PLAN**  
PACKAGE NO. 1

**PEARL HARBOR INTERCHANGE**  
F.A.I. PROJ. NO. 1-H-1(110)15

SCALE: 1"=50' DATE: MAY 28, 73

SHEET NO. 95 OF 13 SHEETS



