




FED. ROAD DIST. NO.	STATE	FED. AID PROJ. NO.	FISCAL YEAR	SHEET NO.	TOTAL SHEETS
HAWAII	HAW.	1-H1-110-15	1973	22	220

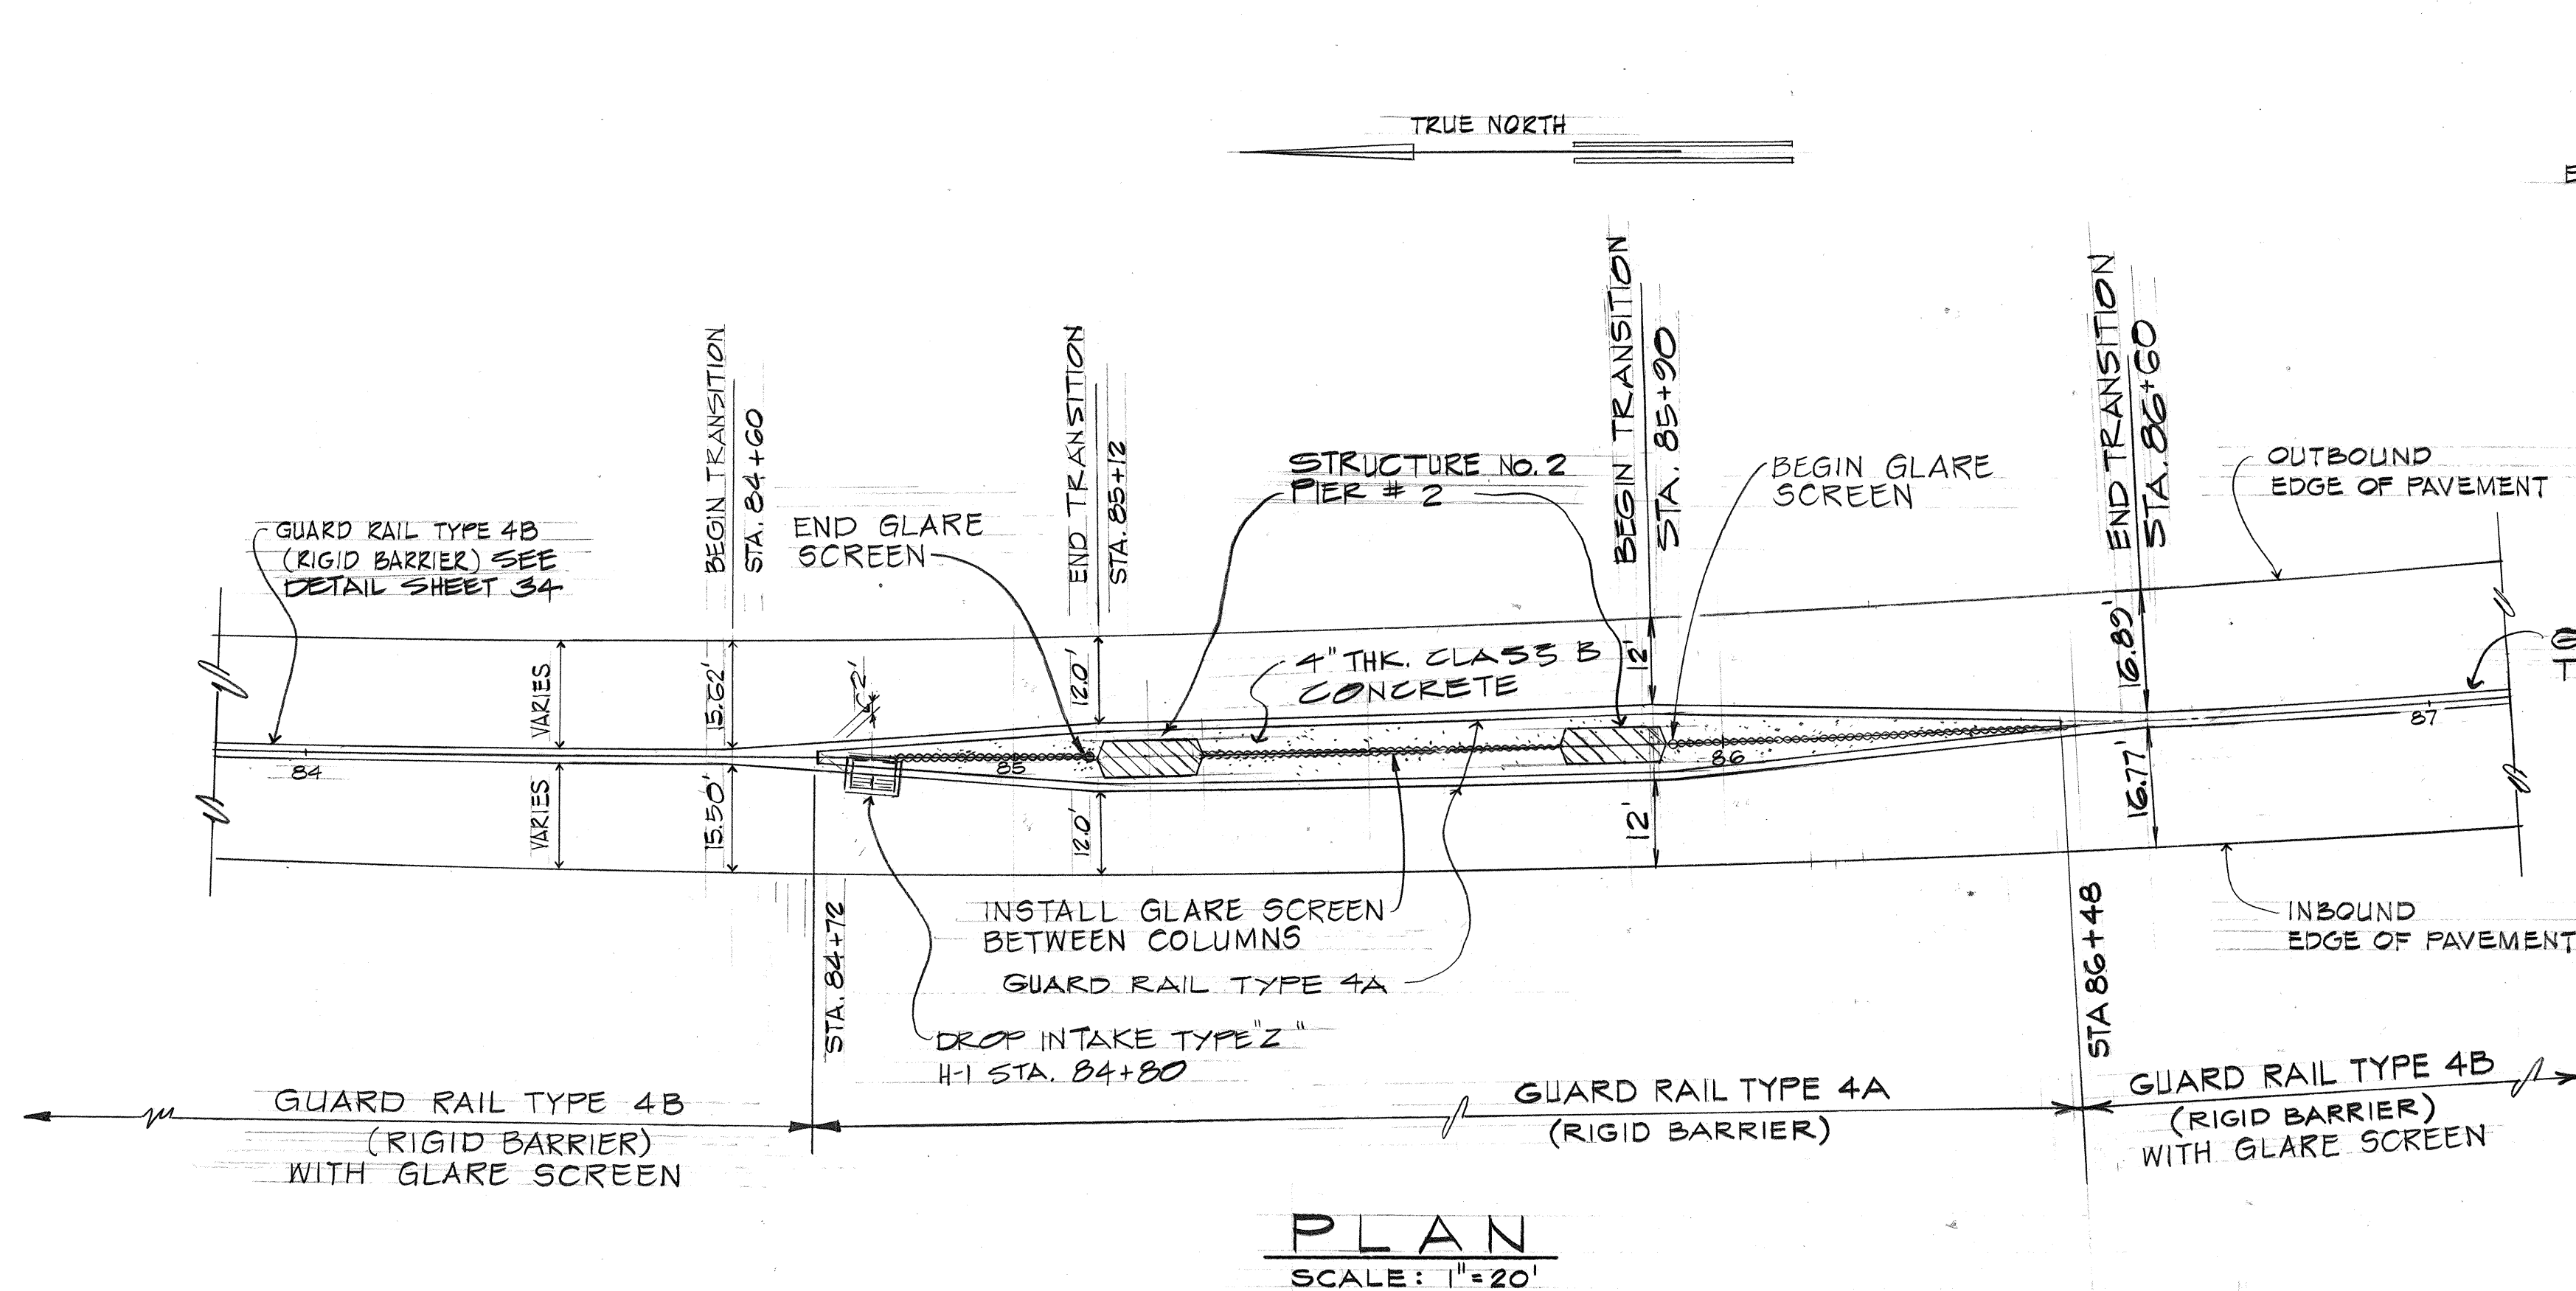

PLAN
SCALE: 1"=20'

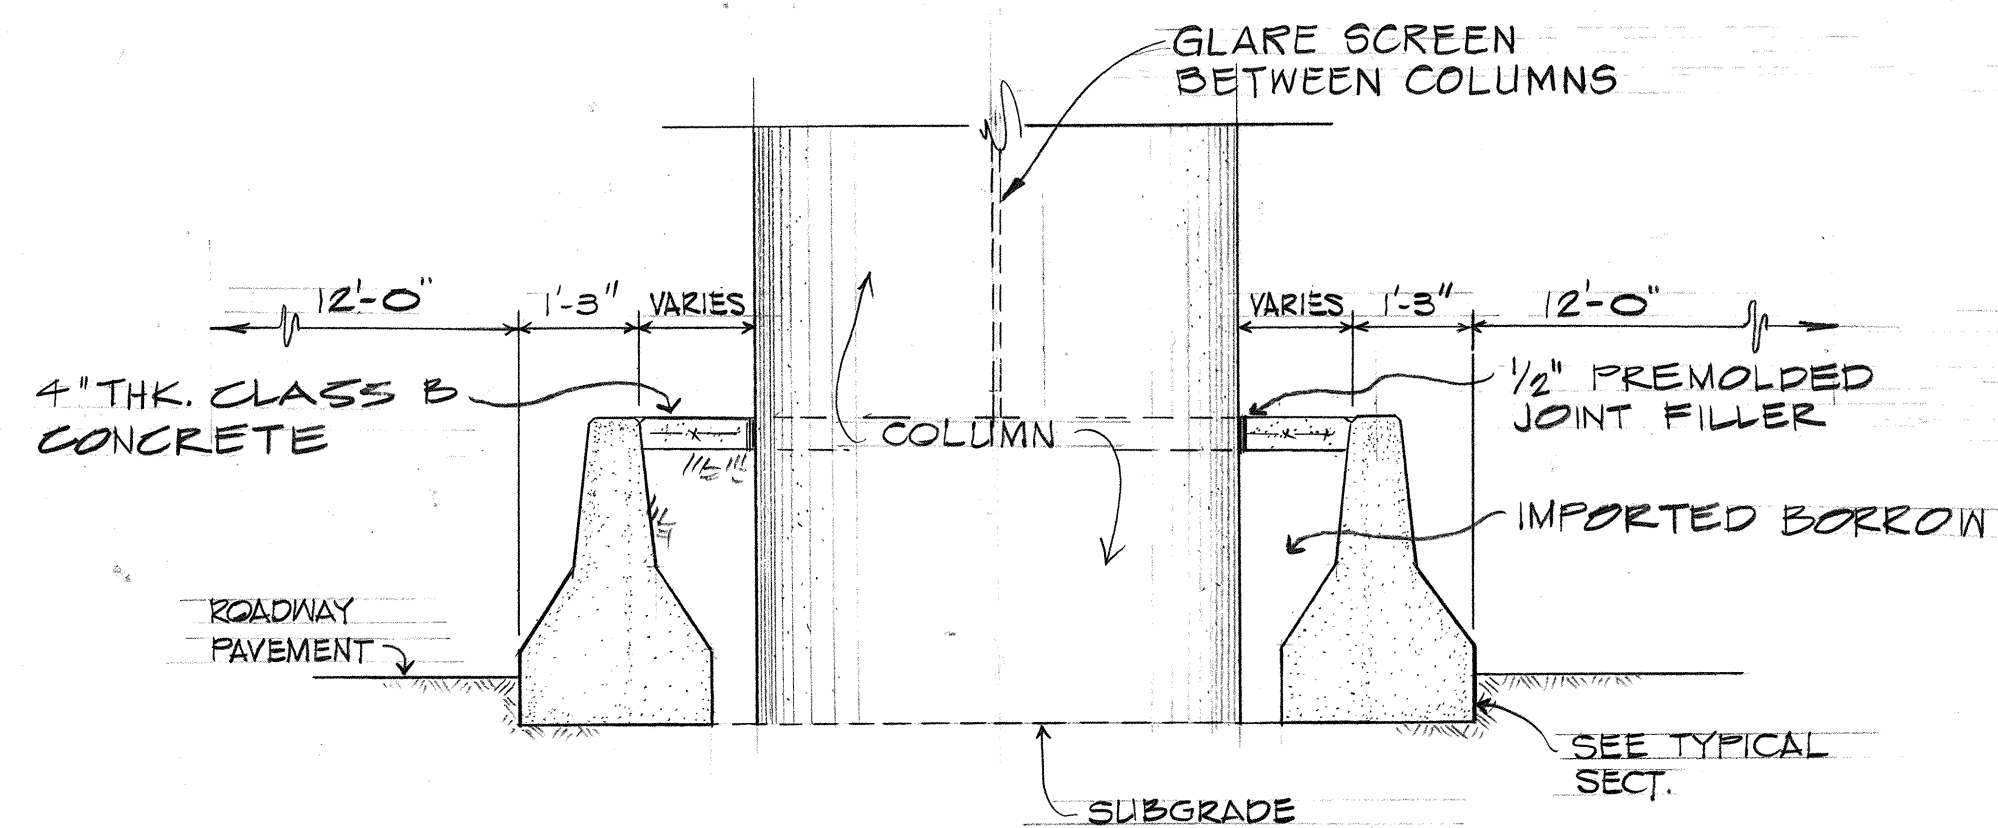


SECTION AT COLUMN
SCALE: 1/2"=1'-0"

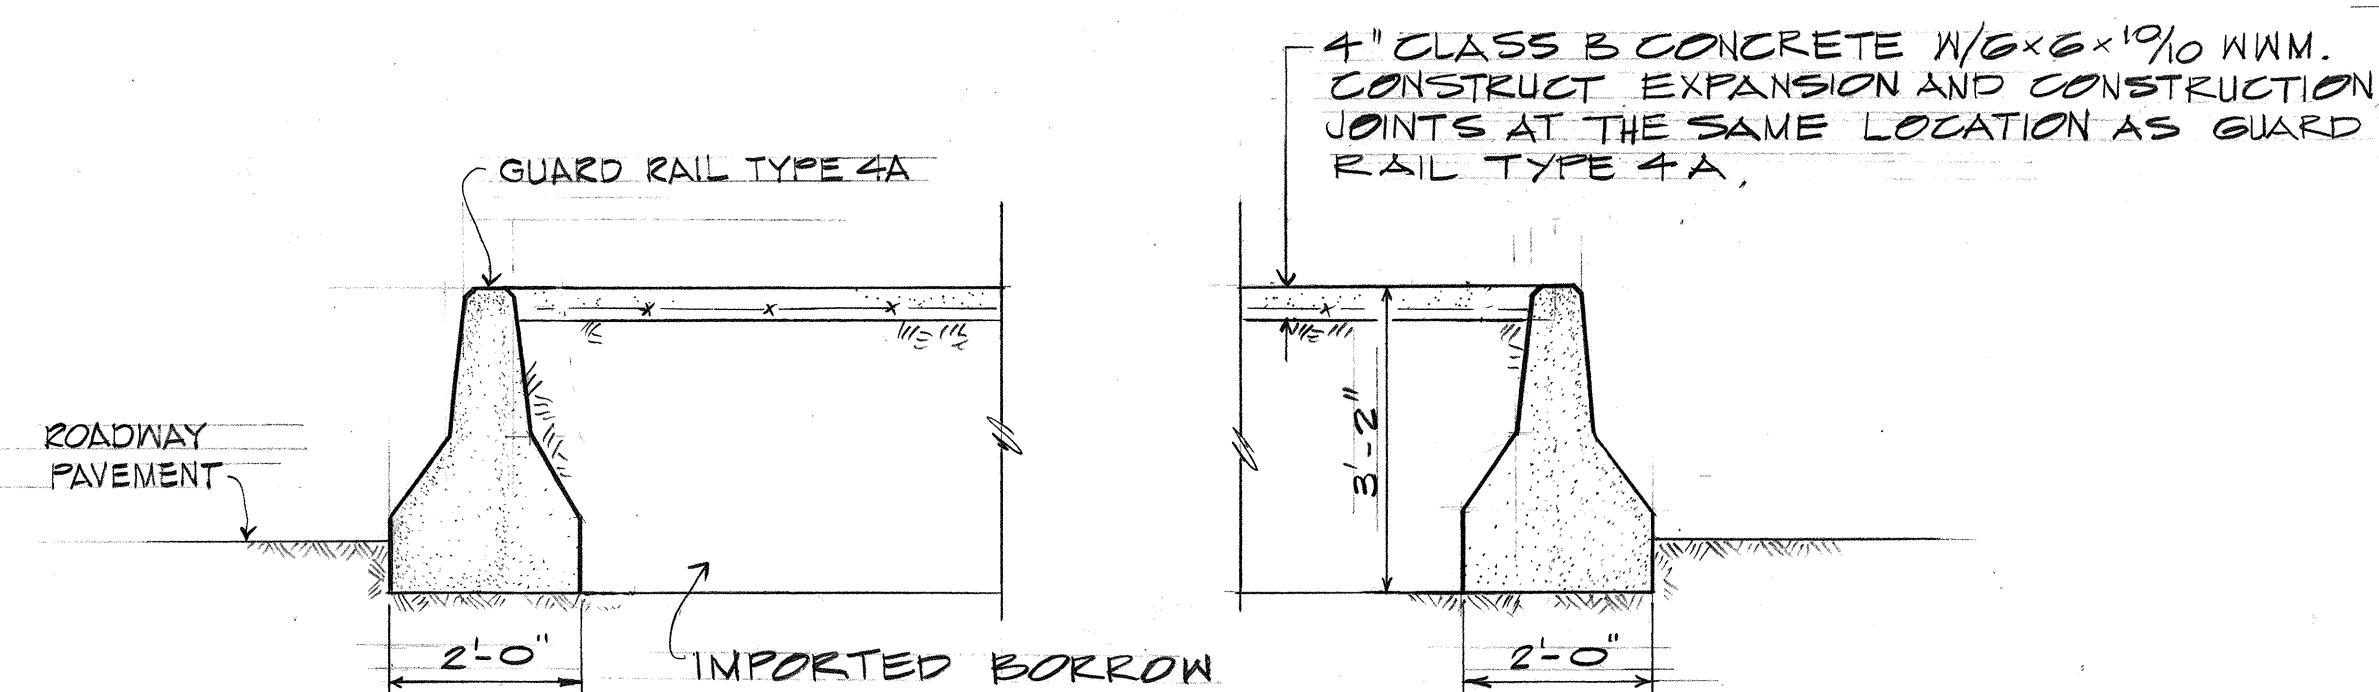


SECTION (TYPICAL)
SCALE: 1/2"=1'-0"


CONCRETE MEDIAN BARRIER TRANSITION AT STRUCTURE NO. 2

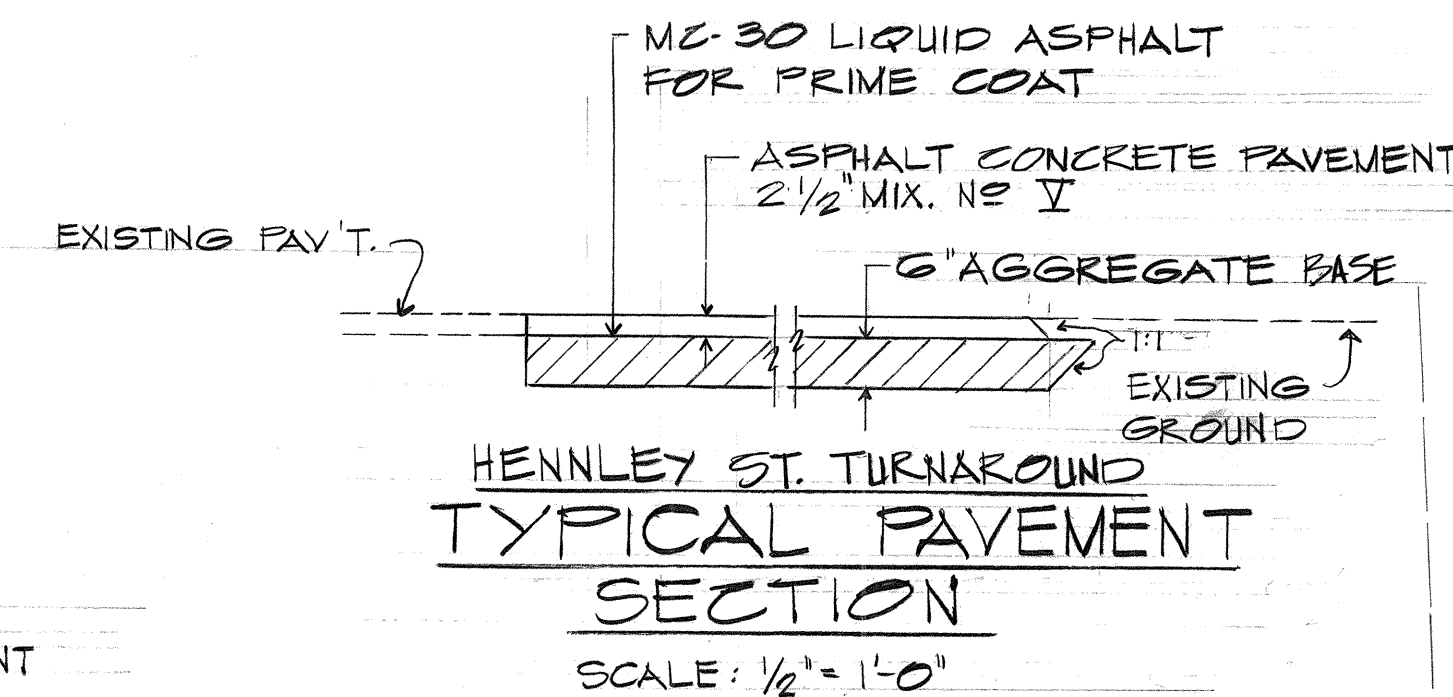

TYPICAL PAVEMENT SECTION
SCALE: 1/2"=1'-0"

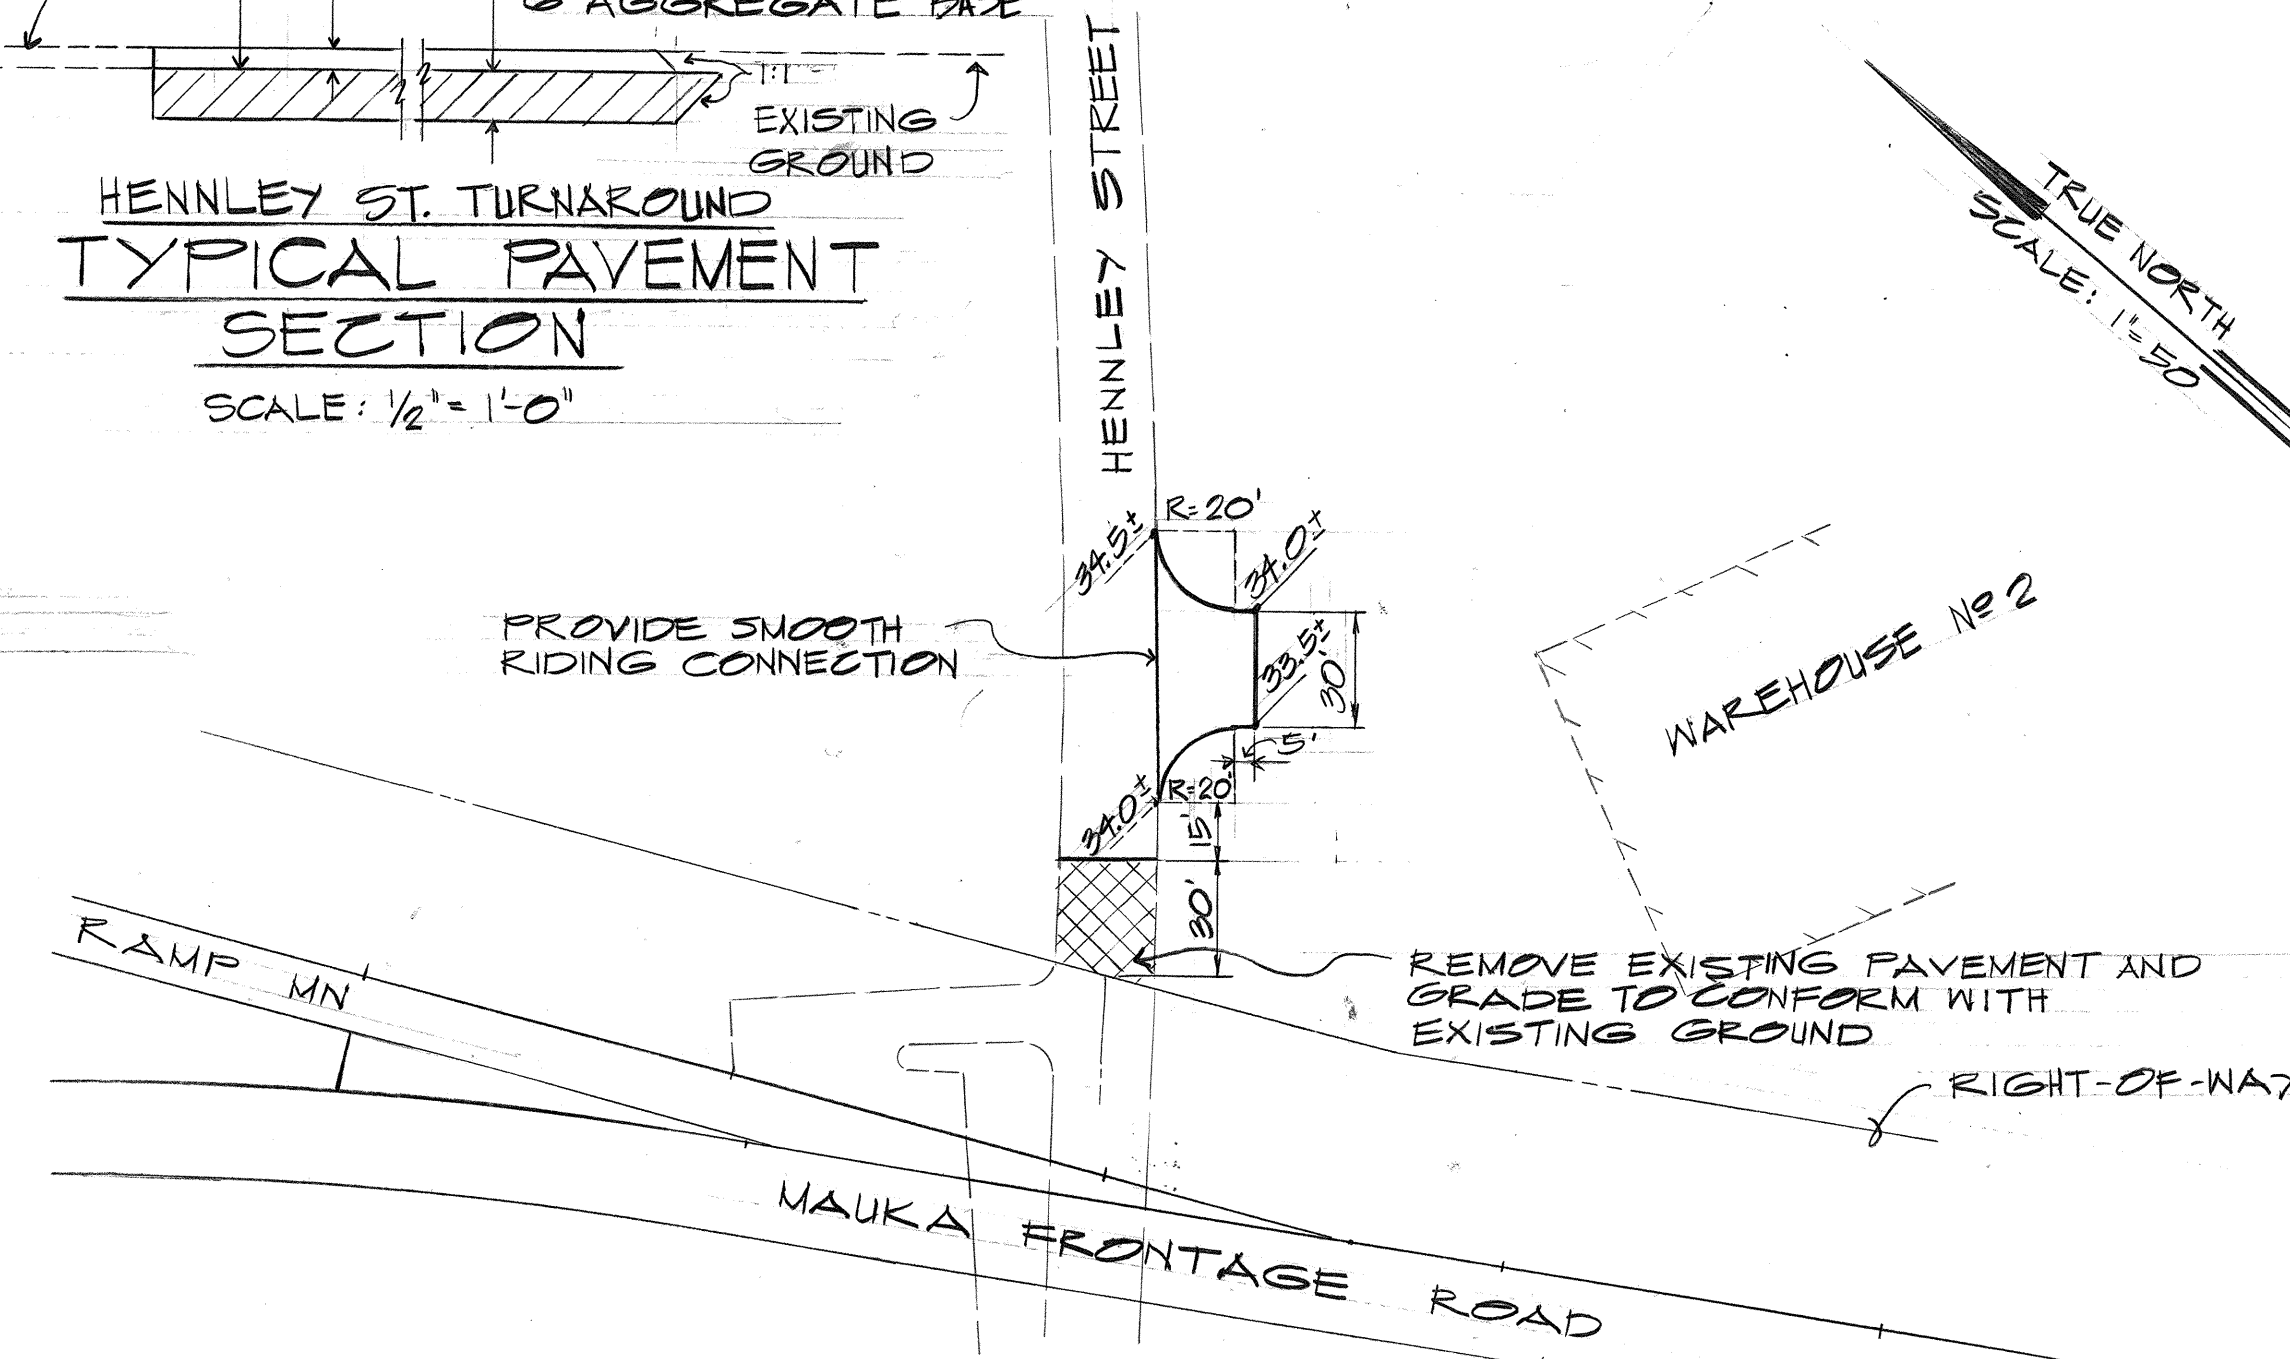

PLAN
HENNLEY STREET TURNAROUND
SCALE: 1"=50'

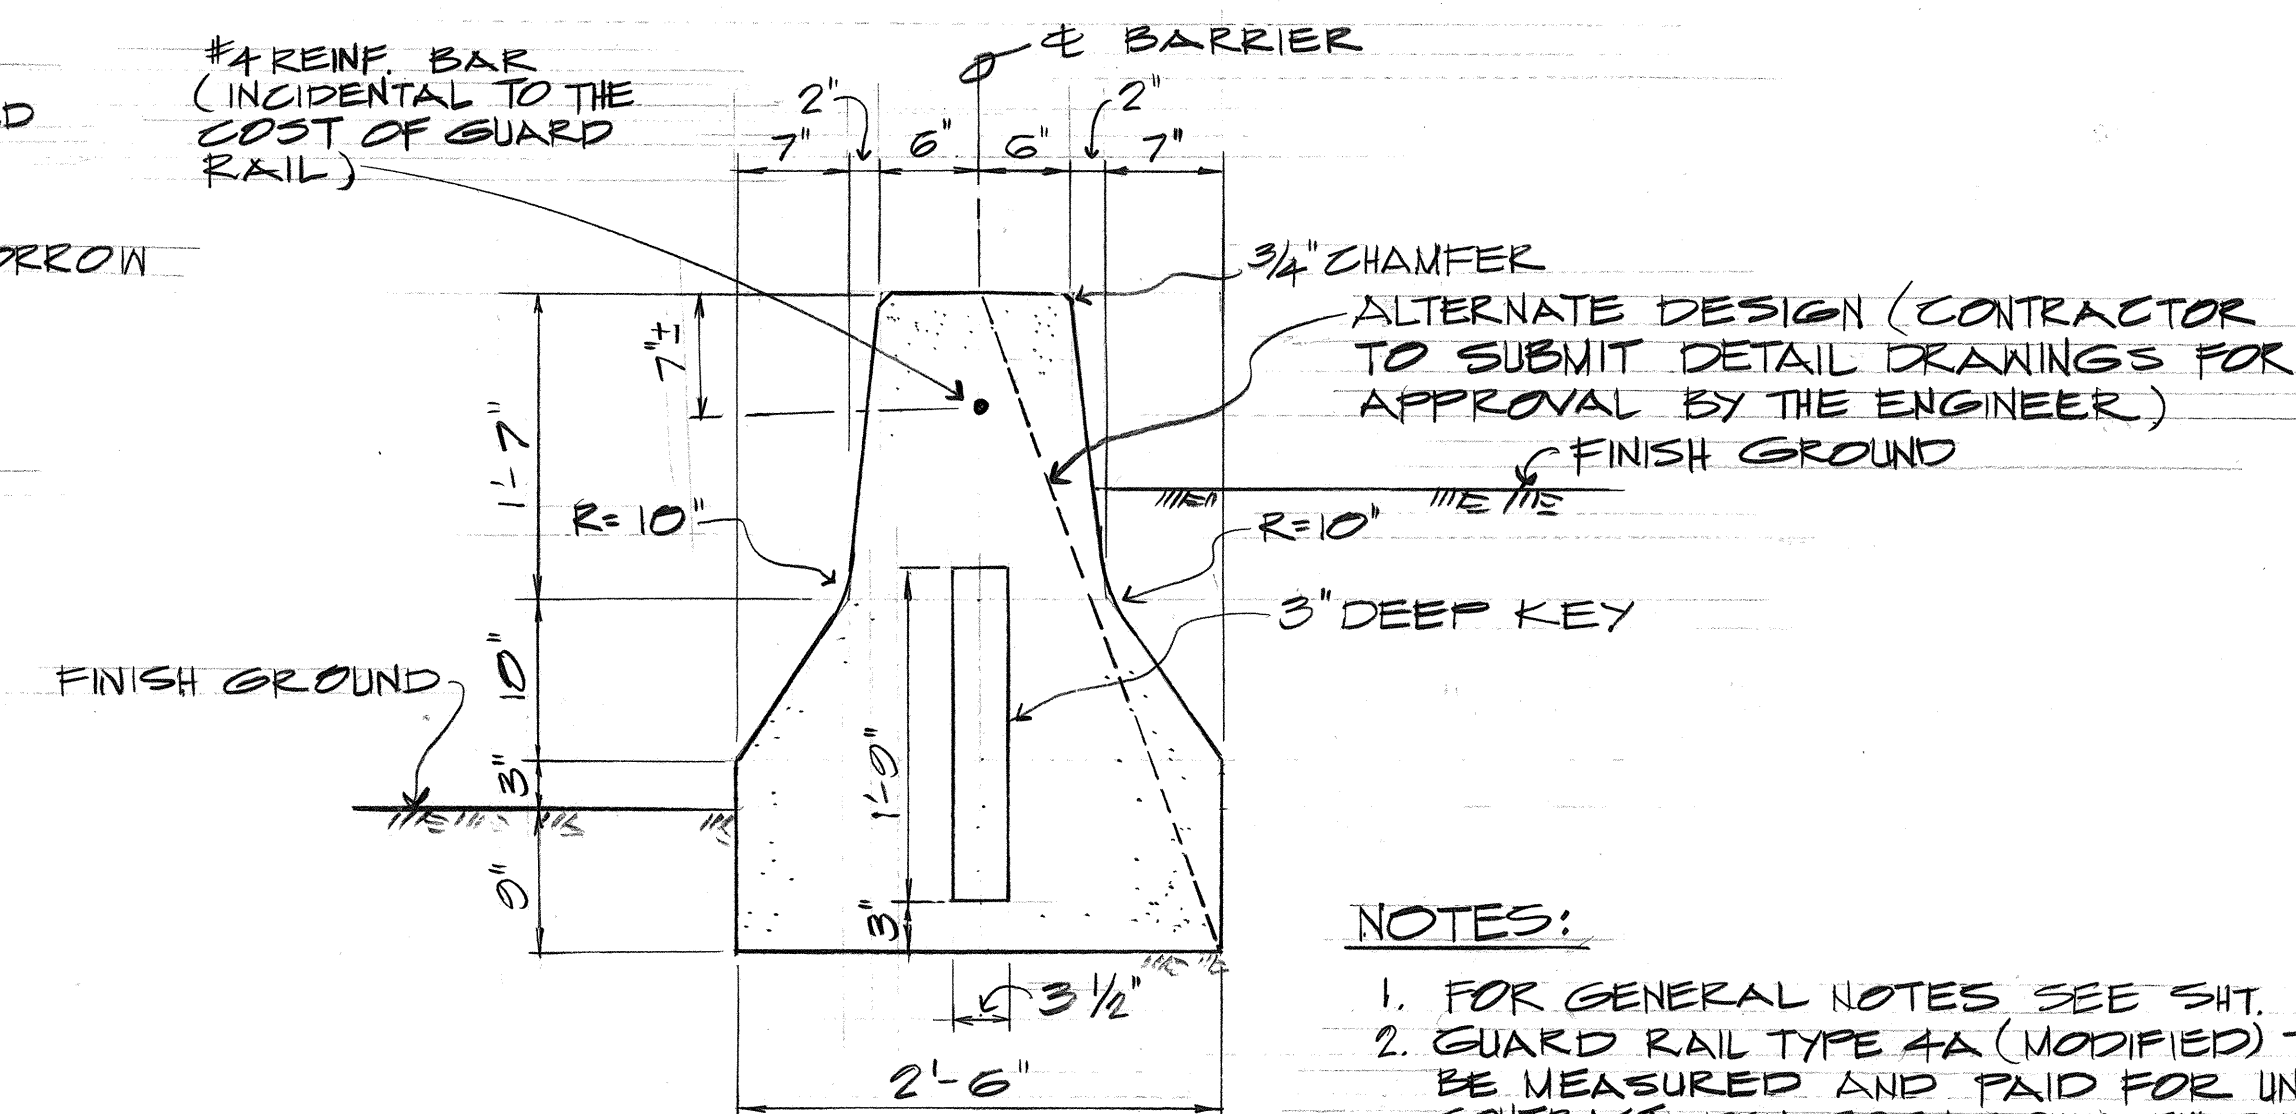


GUARD RAIL TYPE 4A (MODIFIED)
FOR PLANTING MEDIAN MAUKA/MAKAI FRONTAGE ROAD
SCALE: 1"=1'-0"

- NOTES:**
- FOR GENERAL NOTES SEE SHEET 34
 - GUARD RAIL TYPE 4A (MODIFIED) TO BE MEASURED AND PAID FOR UNDER CONTRACT ITEM 606410 GUARD RAIL TYPE 4A.

3/5/74 CO#15	REVISED GUARD RAIL TO TYPE 4B. INCLUDED GLARE SCREEN BETWEEN COLUMNS AND TRANSITIONS.
11/8/73	REVISED PLAN TO SINGLE GUARD RAIL W/ GLARE SCREEN. DELETED STRUT DETAIL. REVISED TYPICAL SECTION.

DATE REVISION

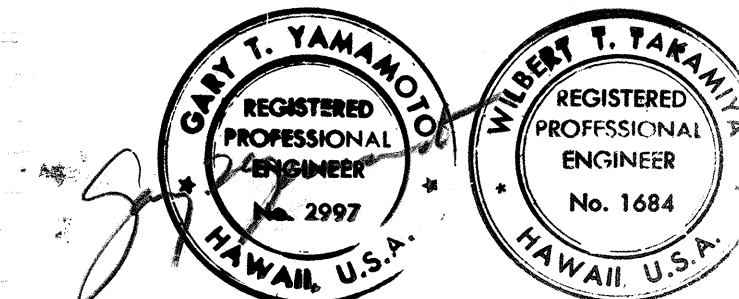

THIS WORK WAS PREPARED BY ME OR UNDER MY SUPERVISION

STATE OF HAWAII
DEPARTMENT OF TRANSPORTATION
HIGHWAYS DIVISION

MISCELLANEOUS DETAILS

PEARL HARBOR INTERCHANGE
F.A.T. Proj. No. I-H1-110-15

Scale: As Shown Date: MAY 28, 1973
SHEET NO. 2 OF 2 SHEETS