
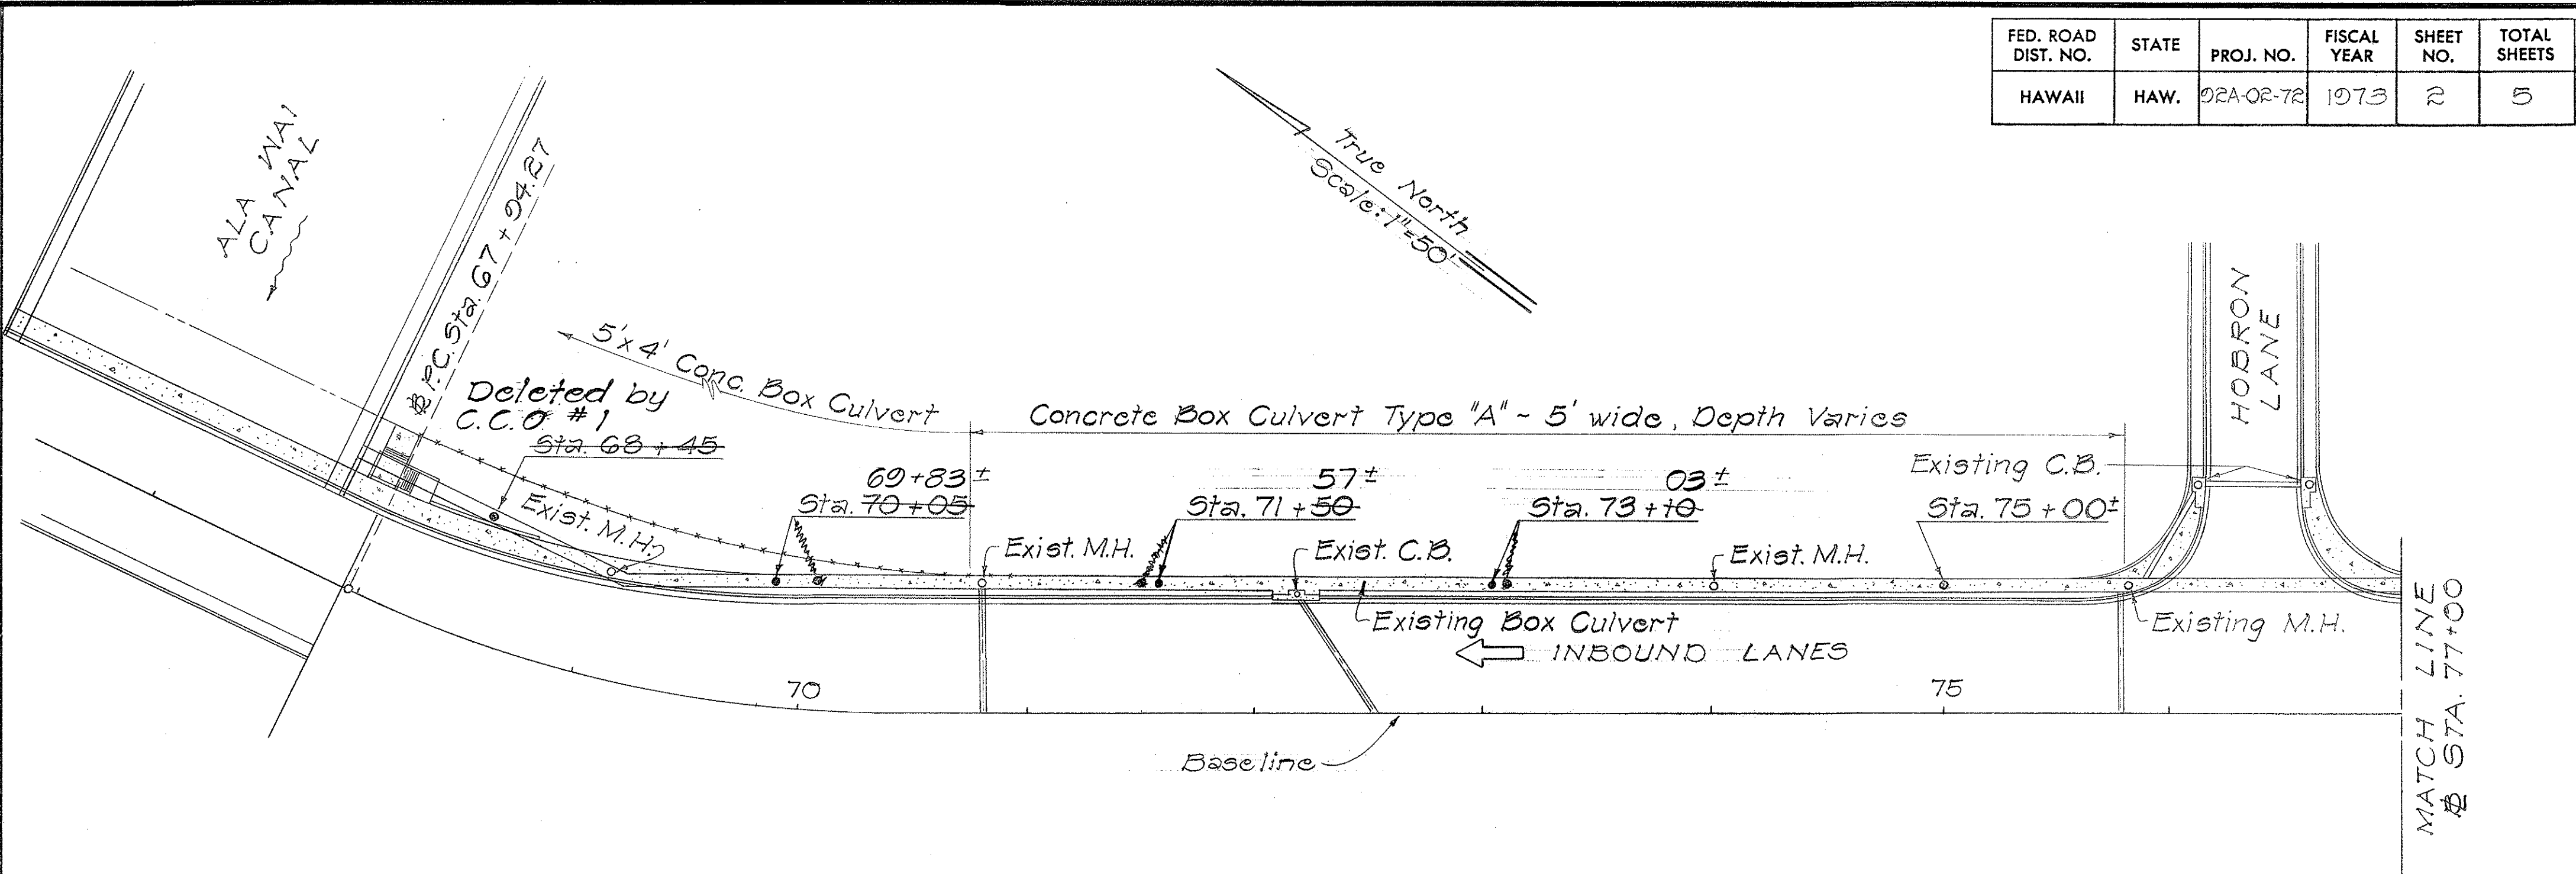


FED. ROAD DIST. NO.	STATE	PROJ. NO.	FISCAL YEAR	SHEET NO.	TOTAL SHEETS
HAWAII	HAW.	02A-02-72	1973	2	5

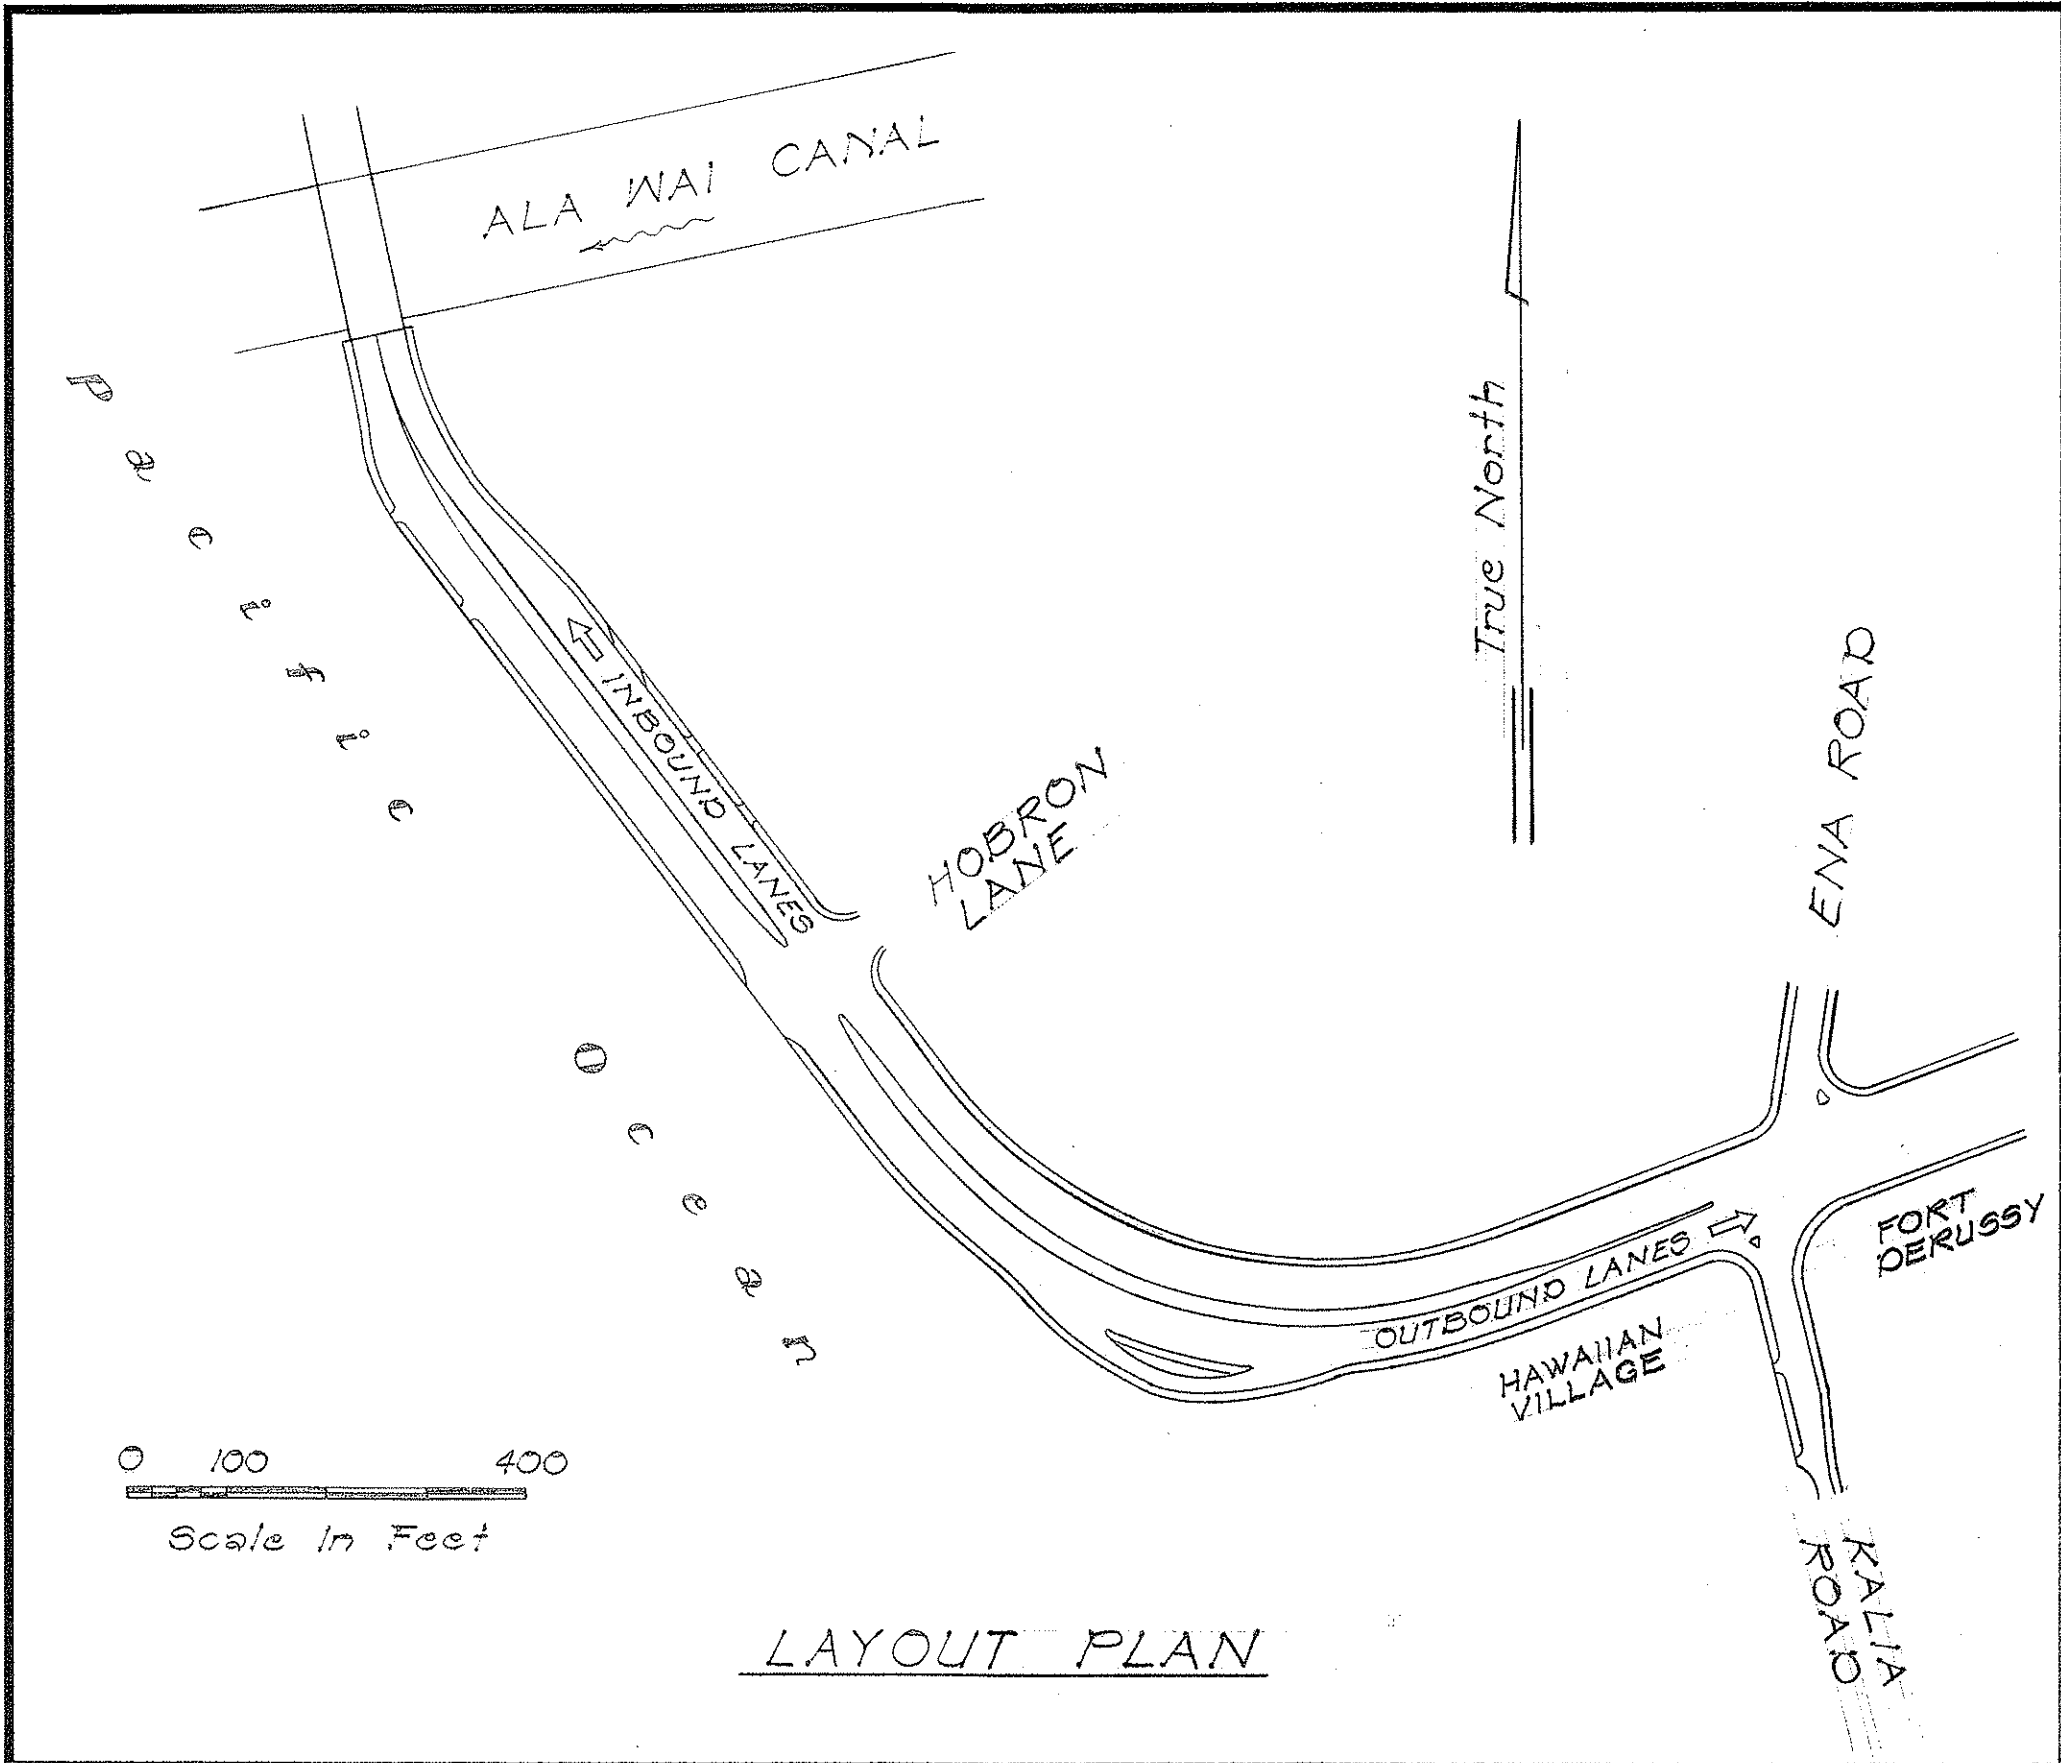



Provide additional manhole openings and install State
Furnished Type "B" Frames and
Covers at following locations.

Stations

- 68+45 Deleted
- 70+05 69+83±
- 71+50 57±
- 73+10 03±
- 75+00±
- 77+05±
- 79+35±
- 81+90 85±
- 83+65 67±
- 85+90±

ESTIMATED QUANTITIES

Reinforcing Steel = 170 lb.
Type "B" C.I. Frame & Cover = 10 Ea.
Demolition & Restoration shall be considered
incidental to the various contract items.

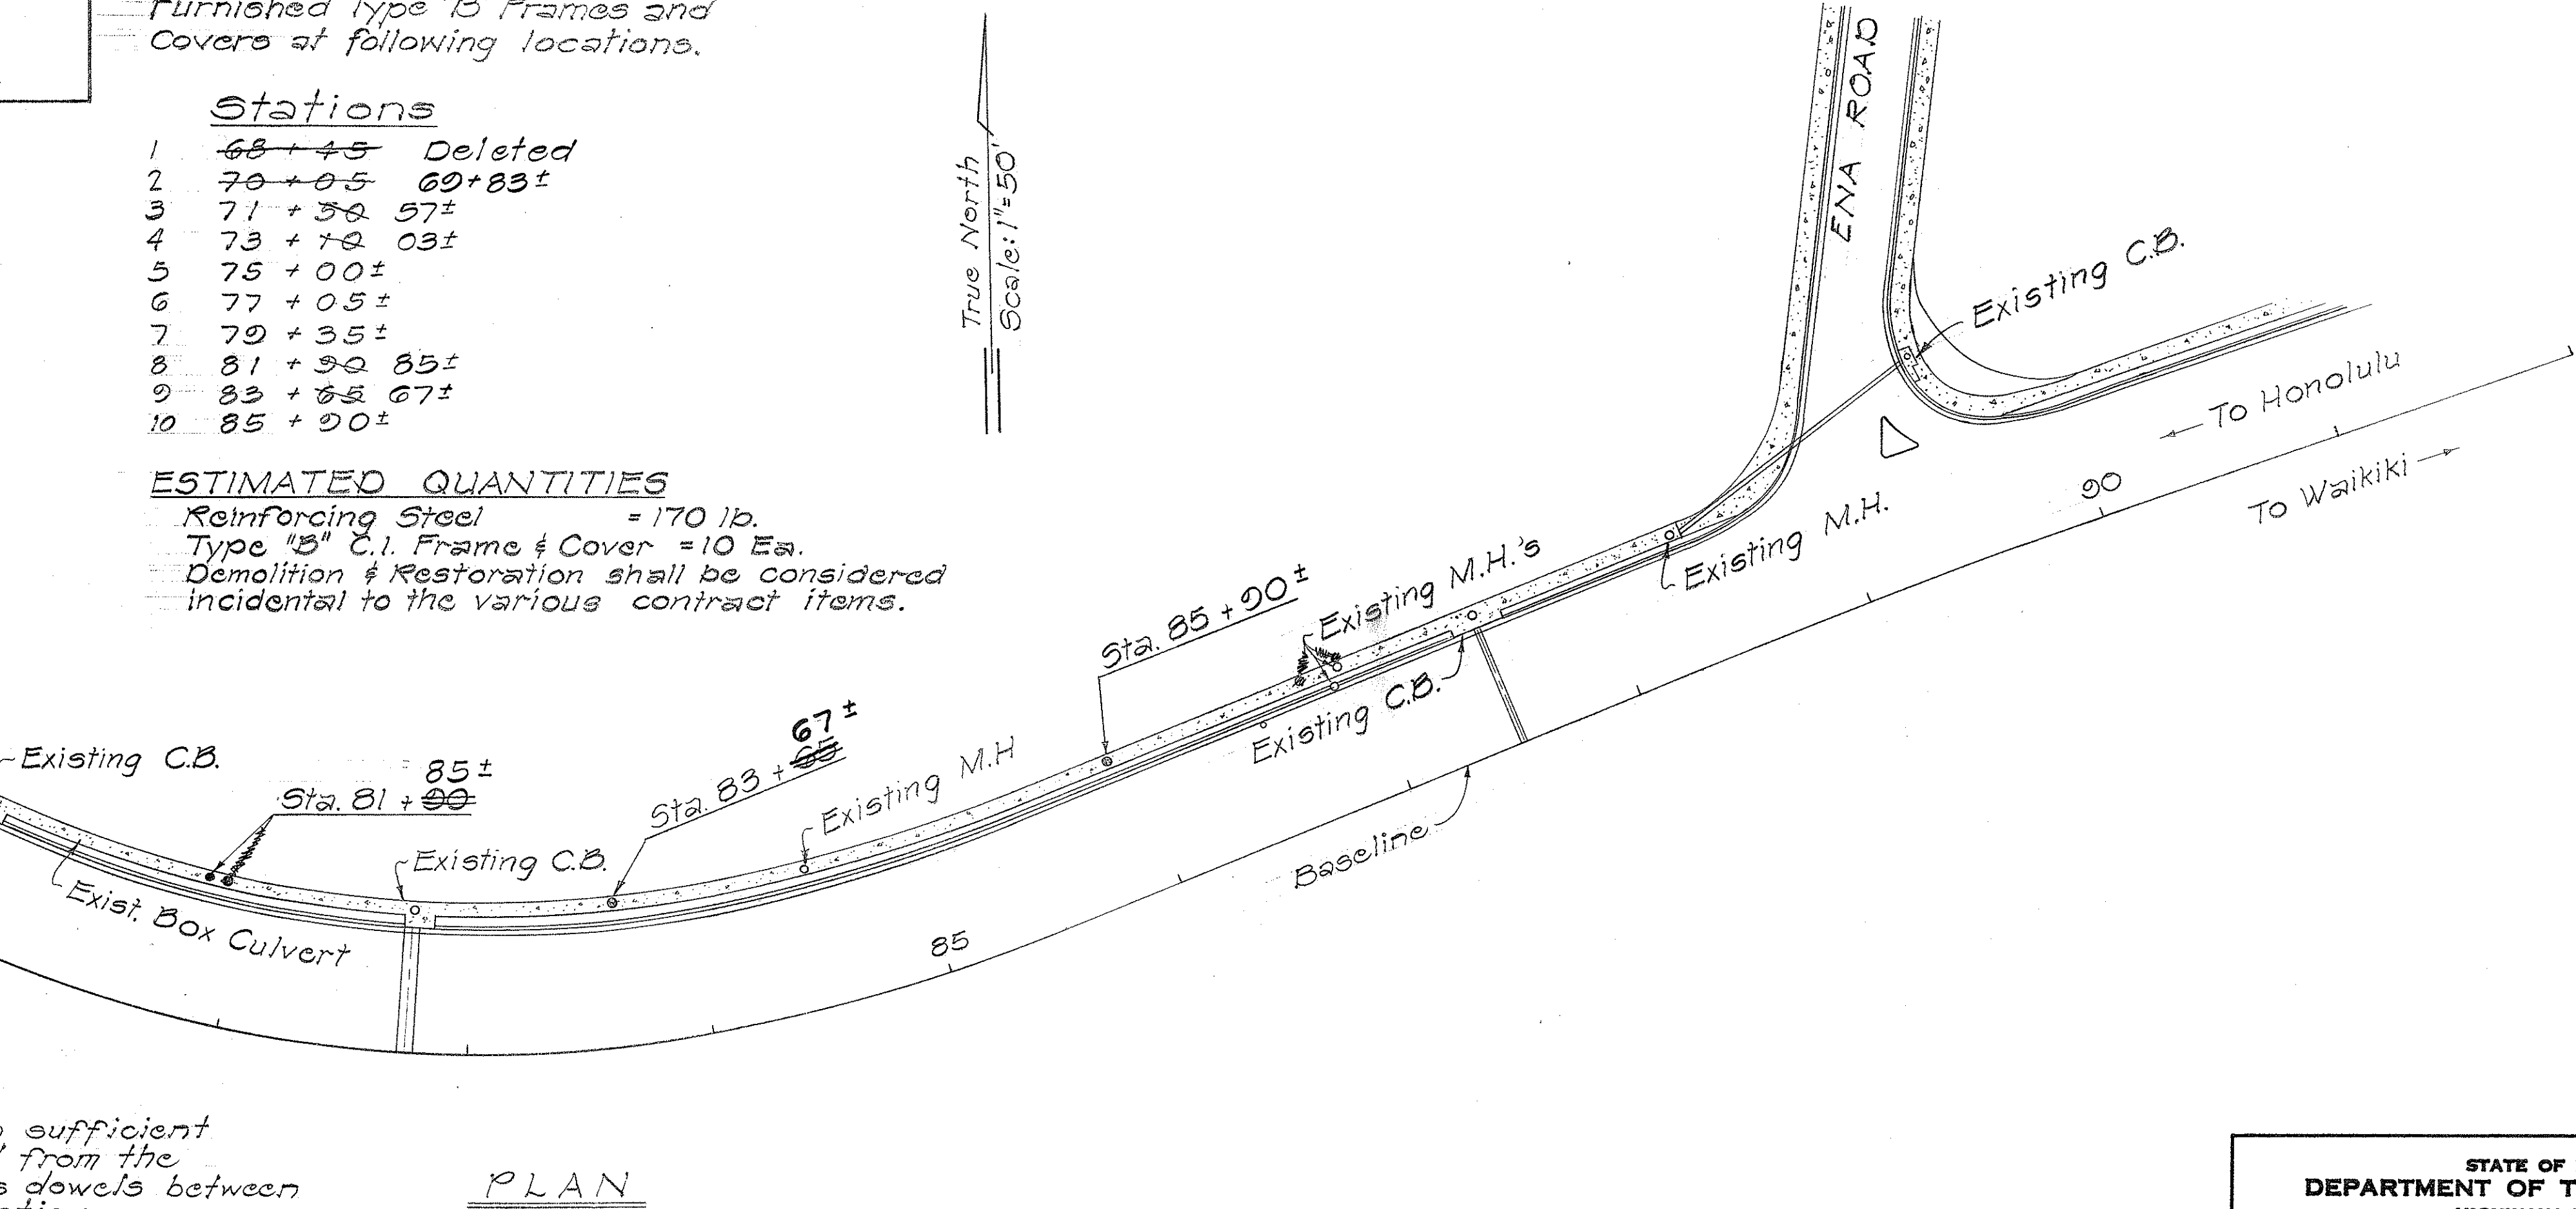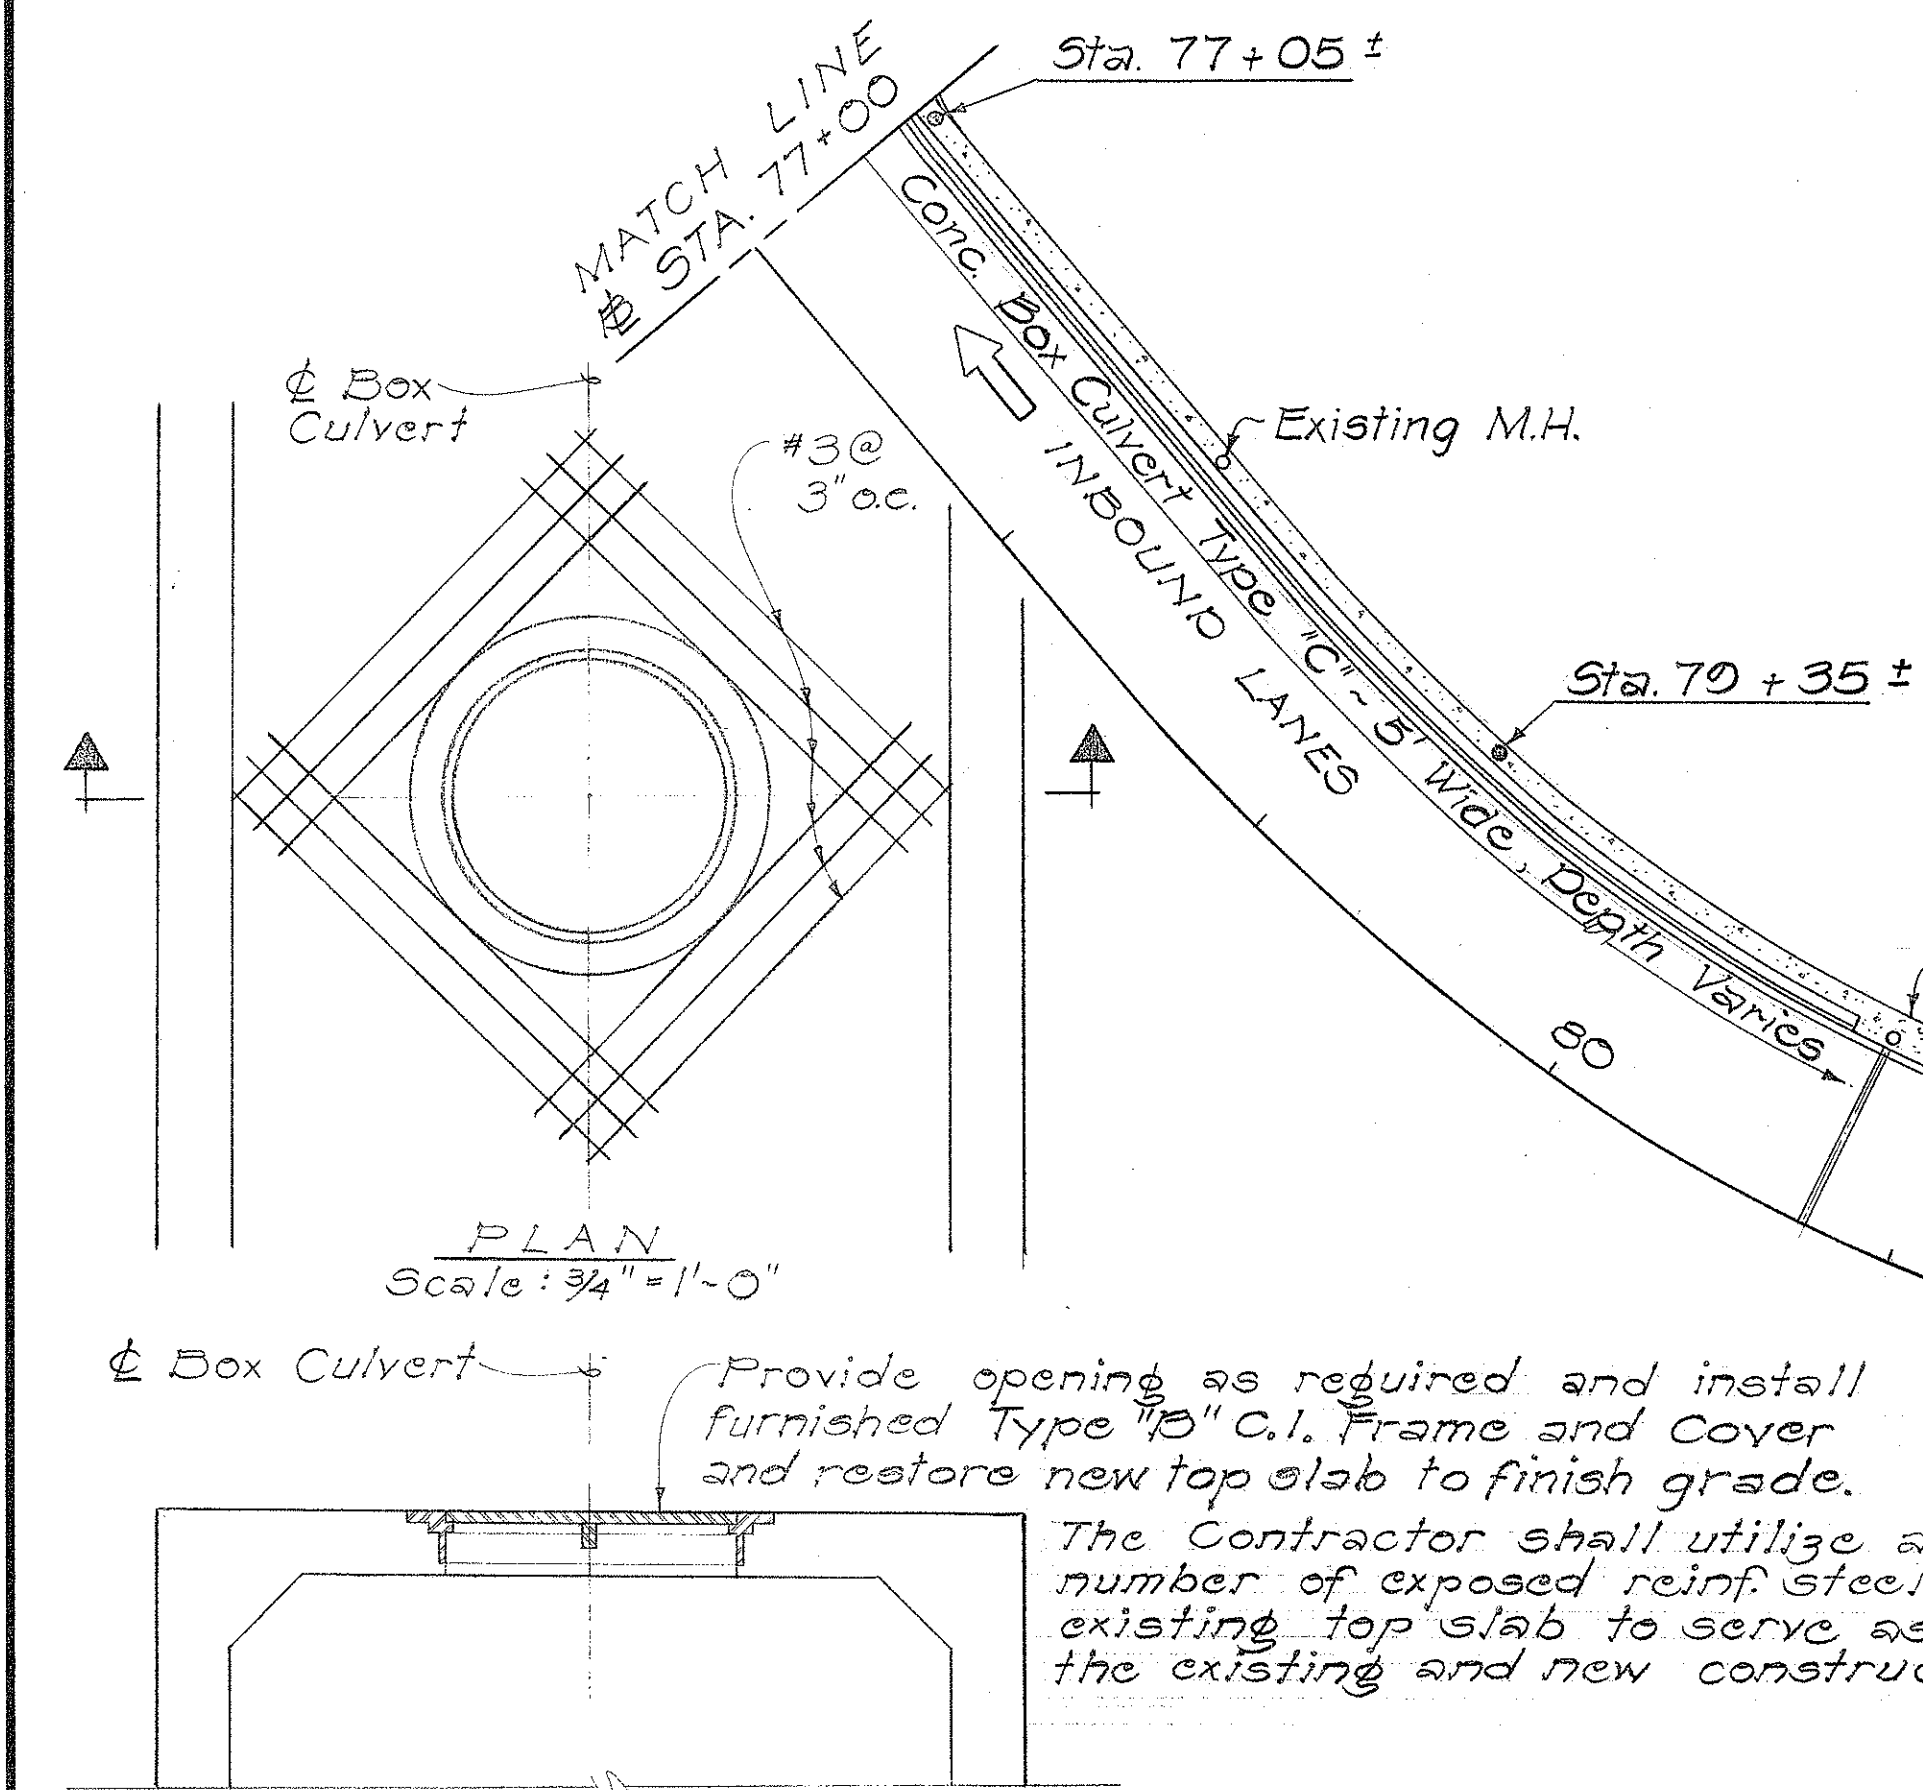



STATE OF HAWAII
DEPARTMENT OF TRANSPORTATION
HIGHWAYS DIVISION

PLAN AND DETAILS

ALA MOANA BOULEVARD
Proj. No. 02A-02-72
Scale: As Noted Date: Sept., 1973
SHEET No. 1 OF 2 SHEETS

DESIGNED BY	DATE
DRAWN BY	
CHECKED BY	
NOTED BY	
ORIGINAL PLAN	
NOTE BOOK	
No.	

FED. ROAD DIST. NO.	STATE	PROJ. NO.	FISCAL YEAR	SHEET NO.	TOTAL SHEETS
HAWAII	HAW.	22A-OR-72	1973	3	5

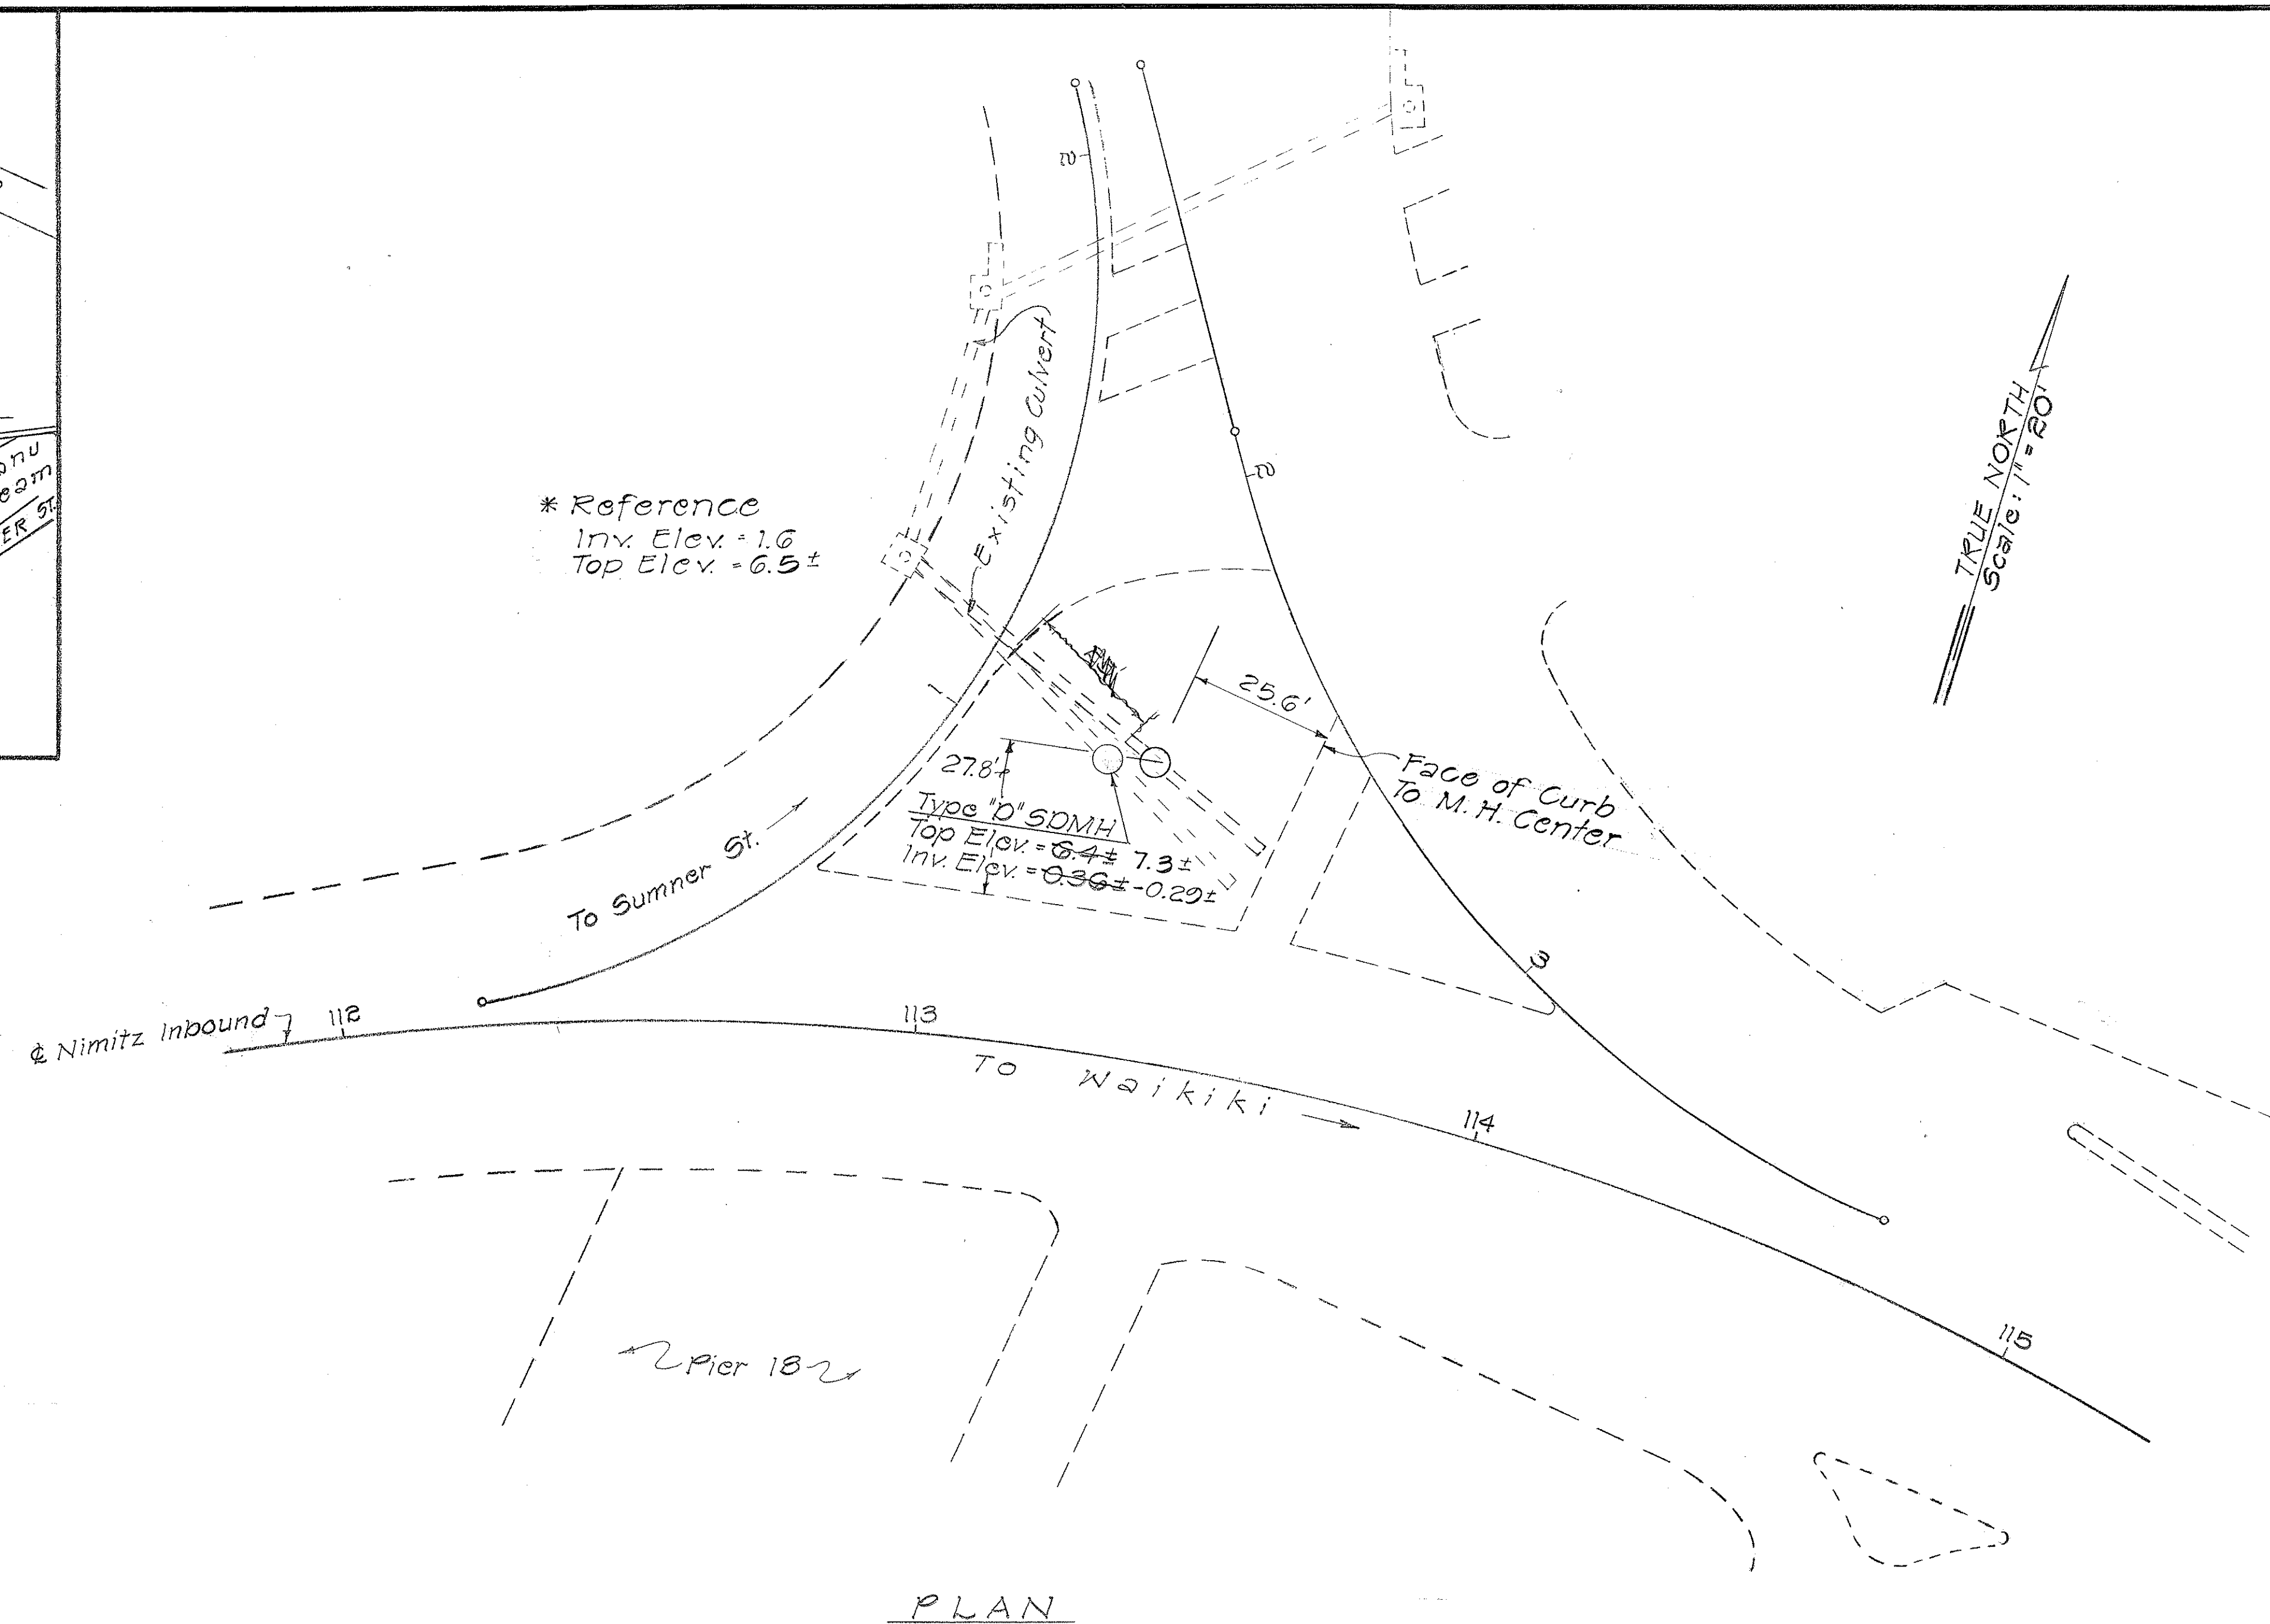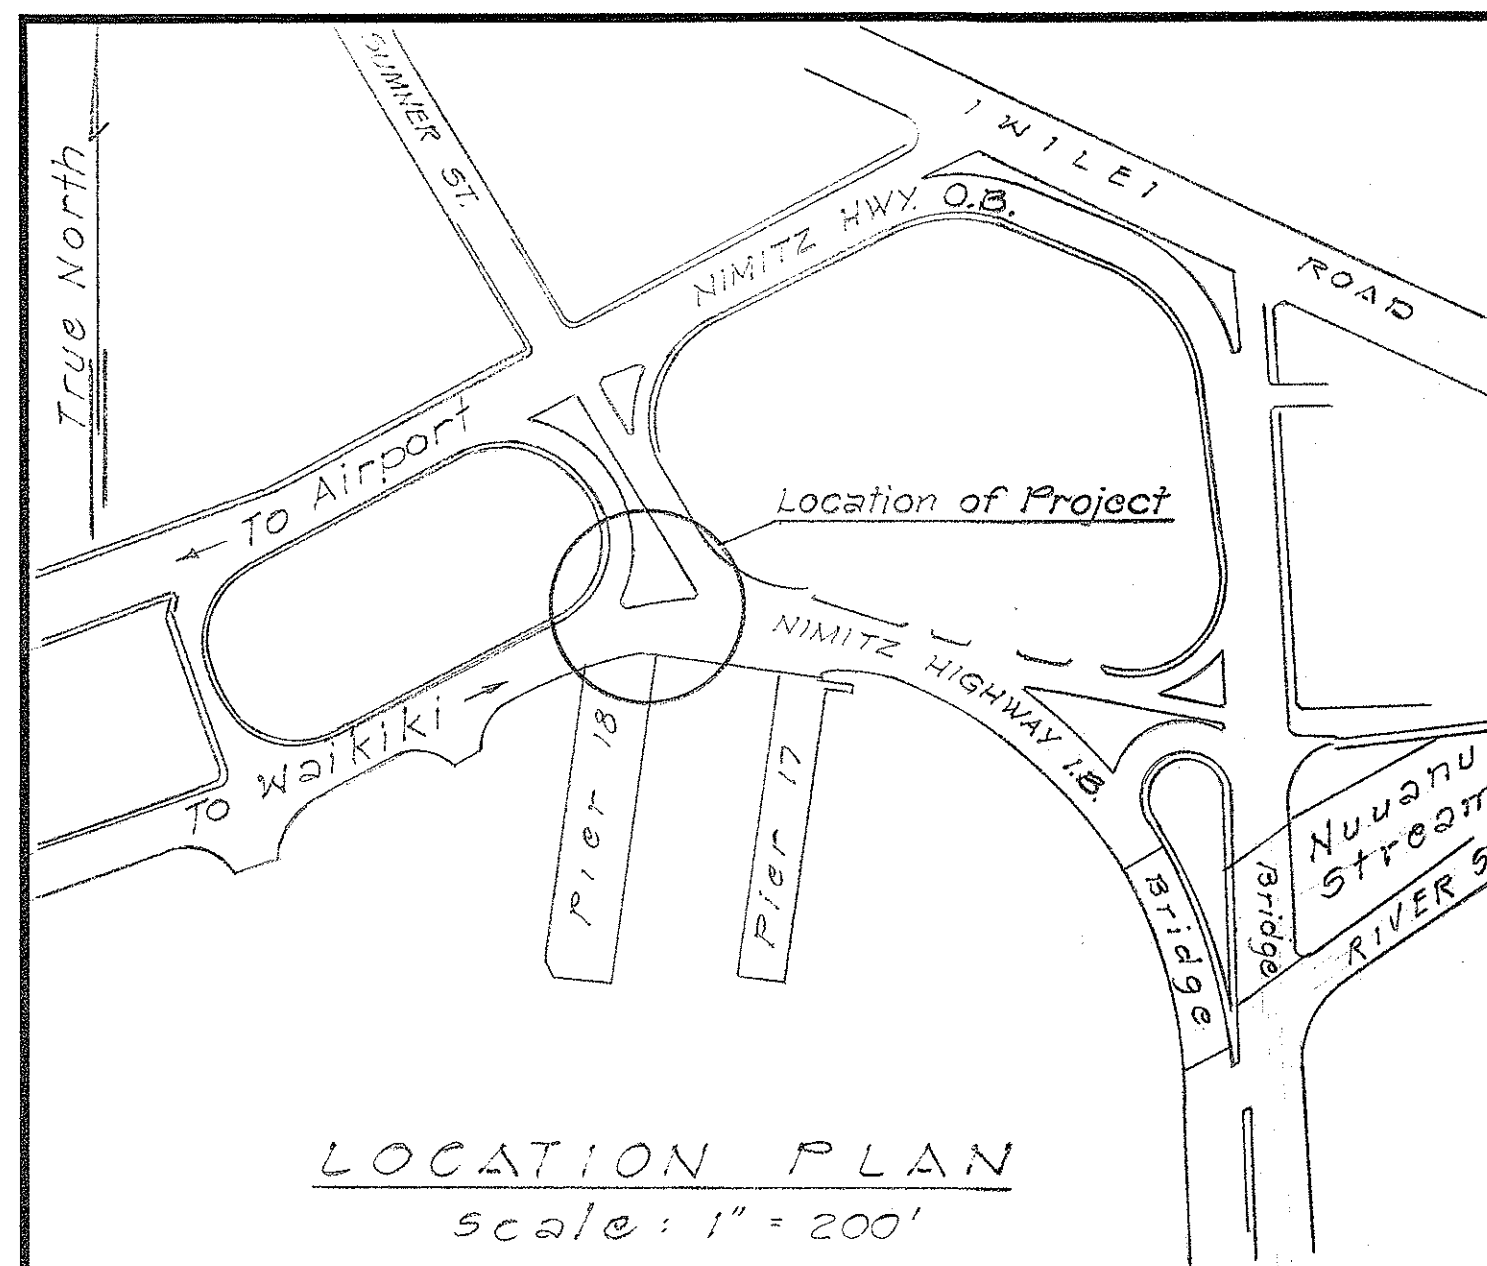

STA. 113+^{32±}_{87±} L₁

Construct: Type "D" SDMH,
Demolish Portion of
Existing Culvert and
Restore Existing Conc.
Island to Finish Grade.

ESTIMATED QUANTITIES

Structure Exc. = 12 c.y.
Class "B" Conc. = 1.0 c.y.
Reinf. Steel = 35 Lbs.
Type "A" C.I. Frame & Cover = 1 Ea.
Demolishing & Restoration
shall be considered incidental
to the various contract items.

DESIGNED BY	DATE
DRAWN BY	
CHECKED BY	
NOTED BY	
NO.	

STATE OF HAWAII
DEPARTMENT OF TRANSPORTATION
HIGHWAYS DIVISION

PLAN

NIMITZ HIGHWAY
Proj. No. 22A-OR-72

Scale: As Noted Date: Sept. 1973

SHEET No. 2 OF 2 SHEETS