						mai) in a milita na manasan ang na dianaka na arawahna kumbang na dianak
IN	DEX	ТО	D	RAWIN	IGS	
SHEET NO.	DESCRIPTION					
1	TIT	LE	SHI	EET		OHOTO
2 - 3	PLA	4NS	8	DETA	ILS	***************************************
4 – 5	STA	NDAI	RD	DETA	ILS	VAT
						······
			dutumm			Transcription of the second of
		THE STREET STREET		<u> </u>		
					**********************	***************************************
			***************************************	**************************************		., , , , , , , , , , , , , , , , , , ,
			<u></u>			

	**************************************		···			

			74 PAPAROVYARRAMANA		***************************************	and the second of the second o
***************************************				**************************************	**************************************	***************************************
						·····

Star annual Control of						······································

Manager - Manager - Walter - W				V		



STATE OF HAWAII

DEPARTMENT OF TRANSPORTATION HIGHWAYS DIVISION

HONOLULU, HAWAII

"AS BUILT"

PLANS FOR CONSTRUCTION OF


DRAINAGE IMPROVEMENTS

ON

ALA MOANA BLV'D. AND NIMITZ HWY.

PROJECT NO. 92A-02-72

DISTRICT OF HONOLULU ISLAND OF OAHU

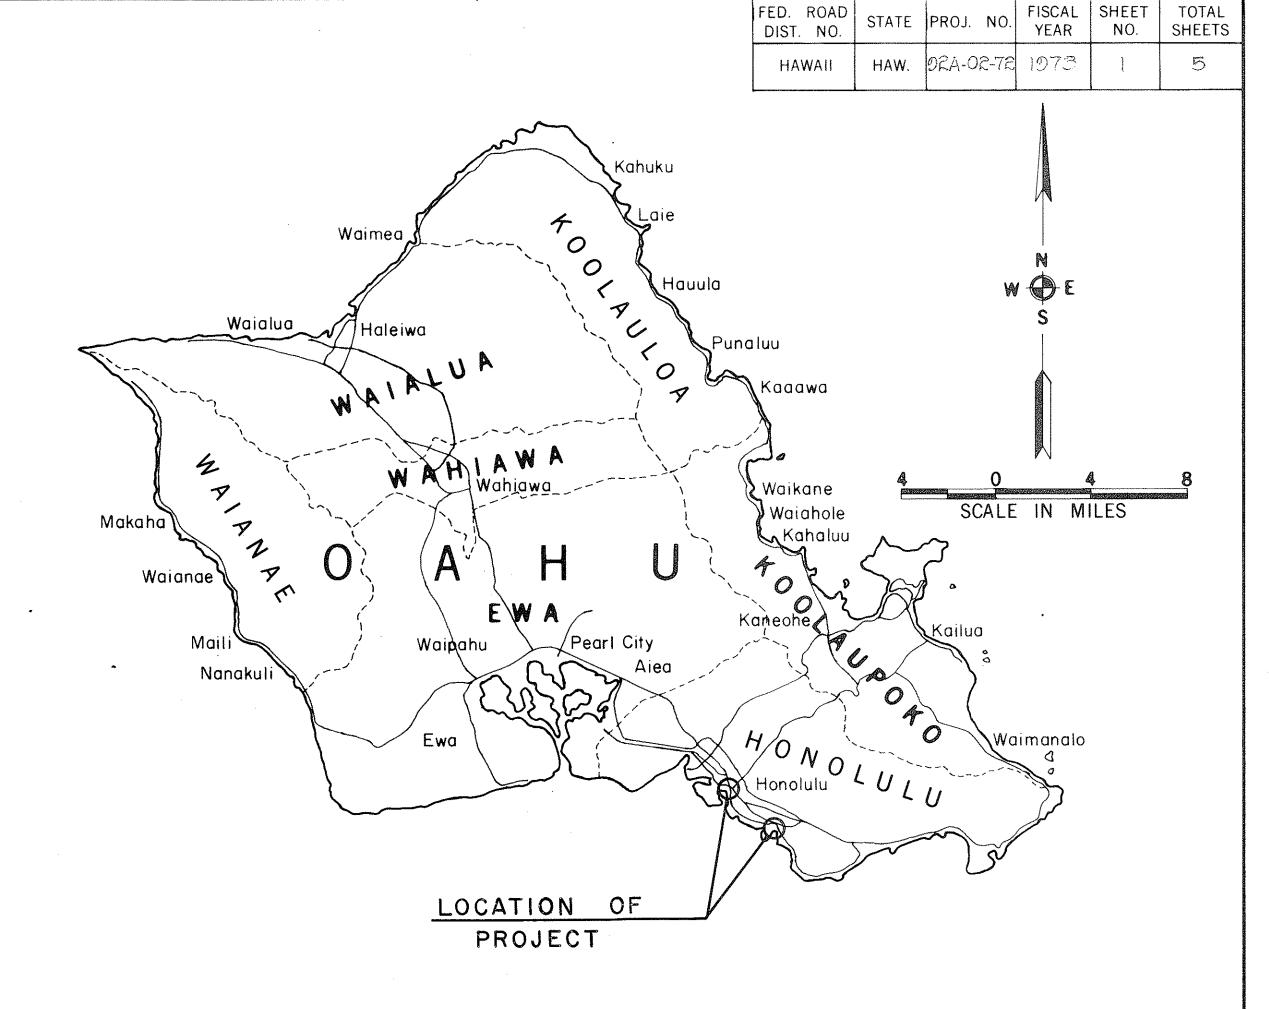

NOTE:

ALL CHANGES MADE DURING CONSTRUCTION HAVE BEEN NOTED IN RED ON THESE TRACINGS AND CHECKED BY:

PROJ. ENG'R.

DATE

DEPARTMENT OF TRANSPORTATION
STATE OF HAWAII

APPROVED:

OF TRANSPORTATION DAT

VE DATE

E. BY PHONE DAT

gn Section A. Nishimura 548. BY P. S. & E. BY PH

aulic Design Section
DESIGNED BY