



STATE OF HAWAII

DEPARTMENT OF TRANSPORTATION HIGHWAYS DIVISION

HONOLULU, HAWAII

"AS - BUILT"


PLANS FOR

## ALA MOANA BOULEVARD RESURFACING

ALA WAI BRIDGE TO KALAKAUA AVENUE

PROJECT NO. 920A-01-74

DISTRICT OF HONOLULU ISLAND OF OAHU

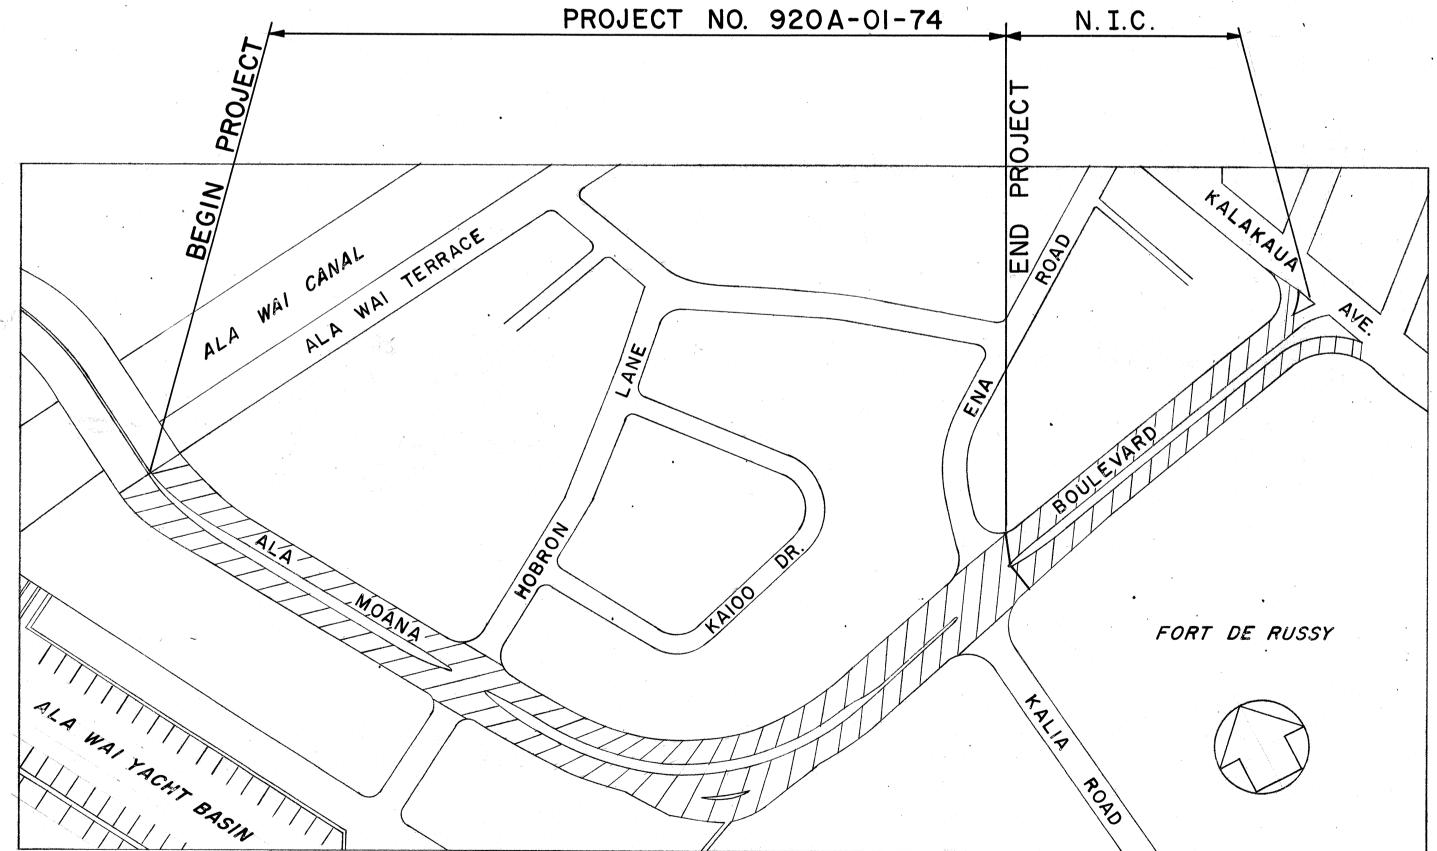

LAYOUT PLAN

2 0 2 4 6

GROSS LENGTH OF PROJECT....0.569 MILE

SCALE IN HUNDRED FEET

NET LENGTH OF PROJECT. . . . 0.569 MILE

Wained

FED. ROAD DIST. NO.

STATE PROJ. NO.

HAW. 920A-01-74 1974 1

FISCAL SHEET YEAR NO.

ALL CHANGES MADE DURING CONSTRUCTION HAVE BEEN INCORPORATED ON THESE PLANS IN RED EXCEPT CHANGES IN THE ORIGINAL THEORETICAL QUANTITIES. FOR ACTUAL QUANTITIES, REFER TO PROJECT LEDGER AND/OR COMPUTATION BOOK.

Programme 3/15/18

PROJECT ENGINEER DATE

DEPARTMENT OF TRANSPORTATION
STATE OF HAWAII

APPROVED:

12/14/73

FOR DIR. OF TRANSPORTATION

DATE

548-2456 PHONE

2-8