




FED. ROAD DIST. NO.	STATE	FED. AID PROJ. NO.	FISCAL YEAR	SHEET NO.	TOTAL SHEETS
HAWAII	HAW.	EH6-D-092-1(1)	1974	40	141

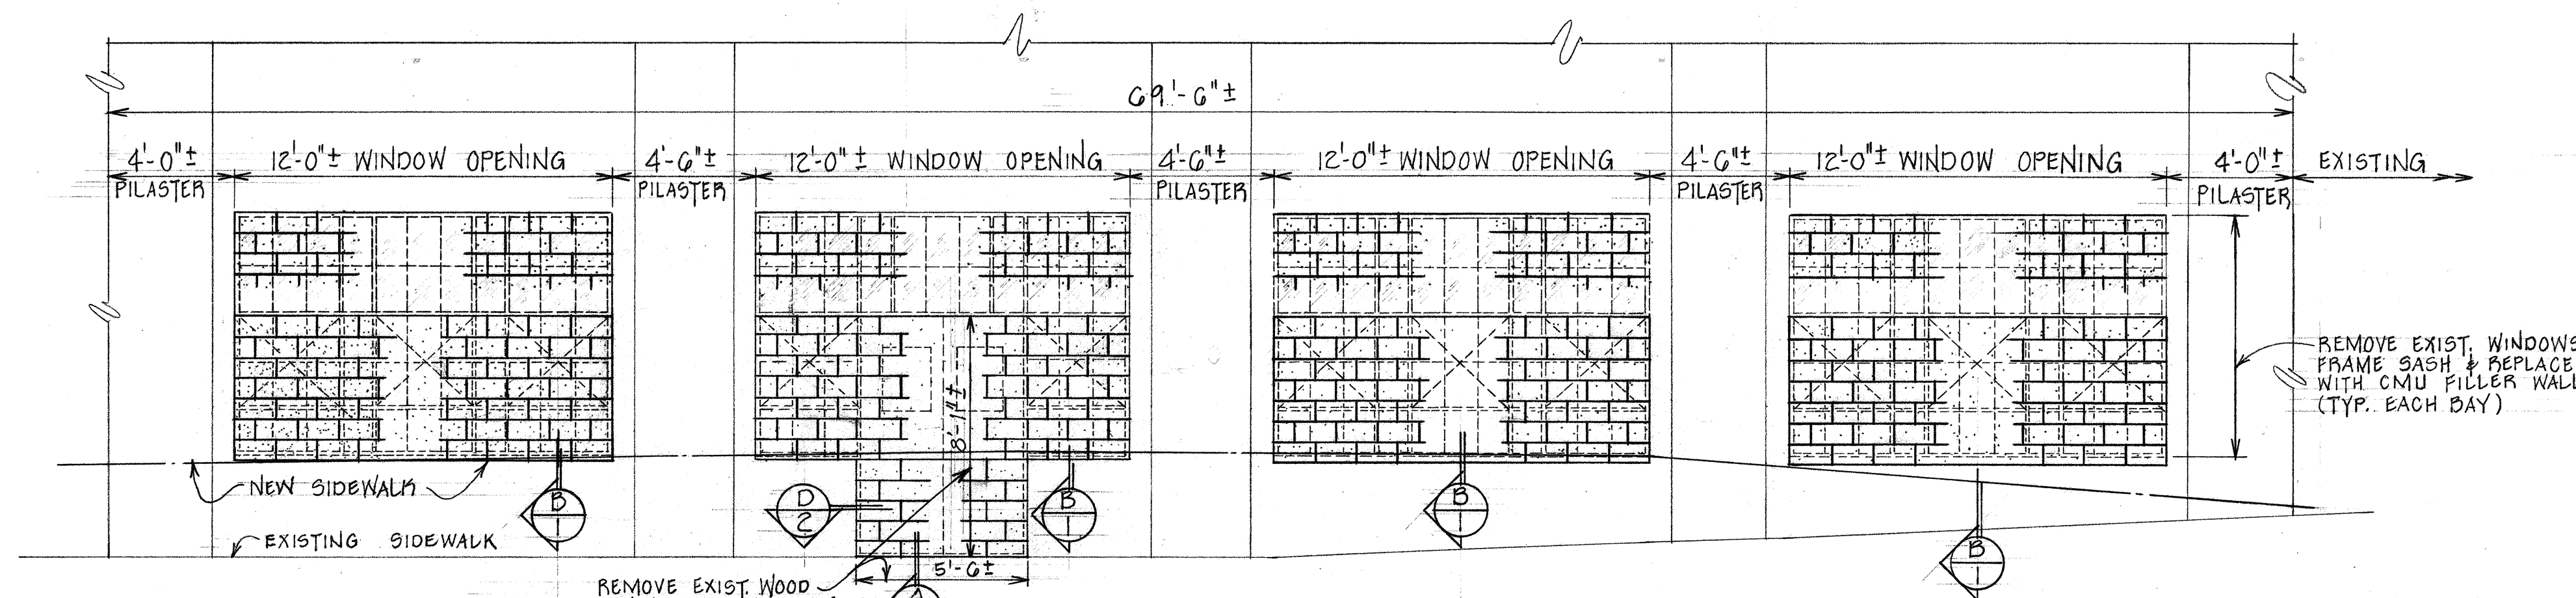


PIER 4 BUILDING
ALA MOANA ELEVATION
SCALE: 1/4" = 1'-0"

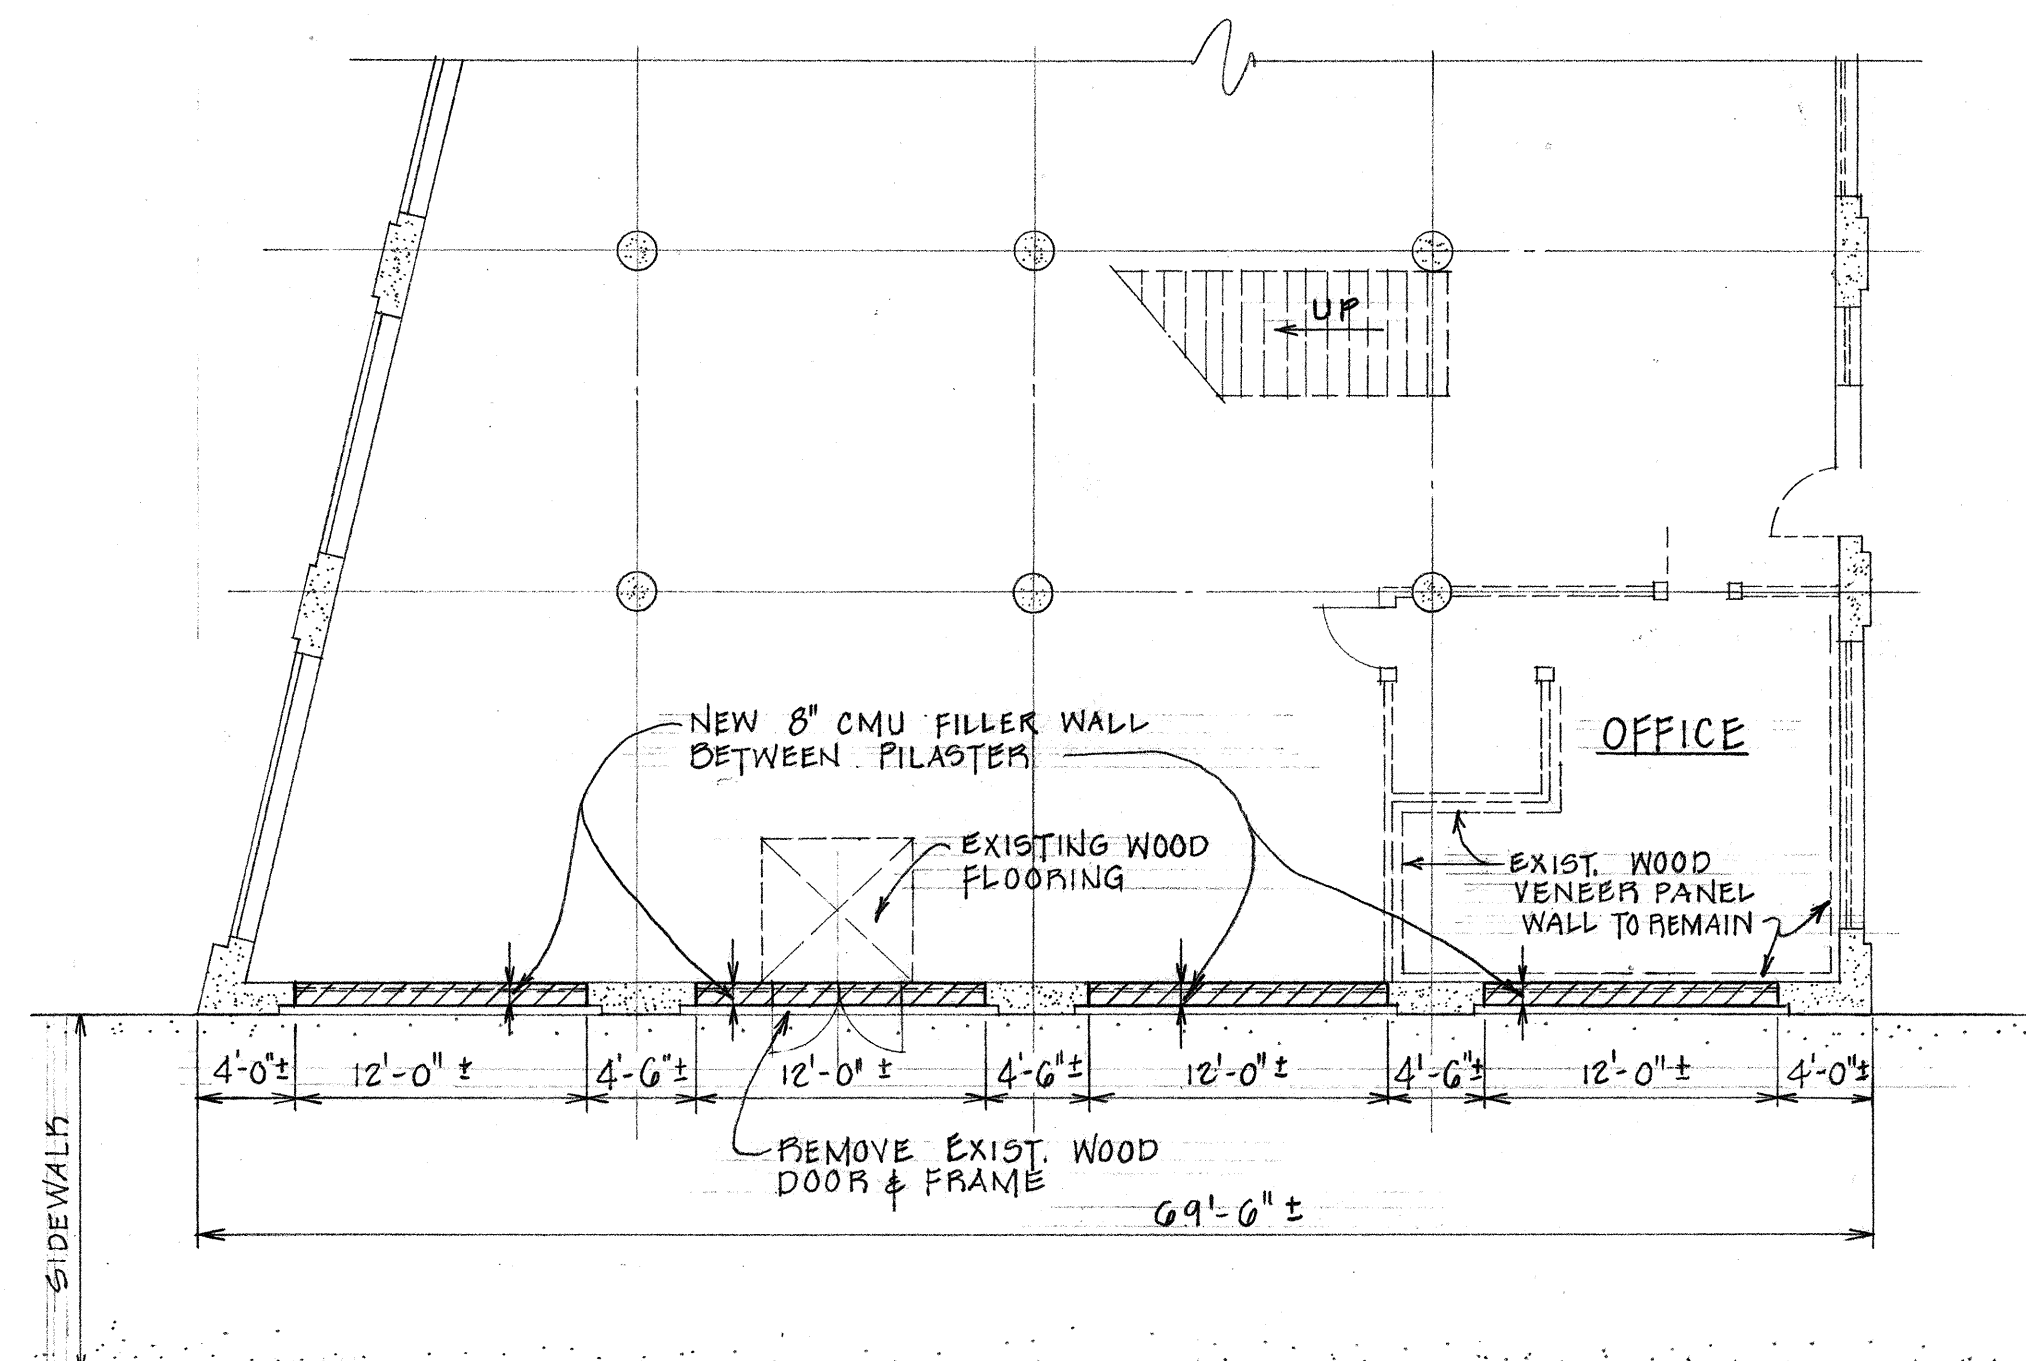

PART. GROUND FLOOR PLAN
SCALE: 1/8" = 1'-0"

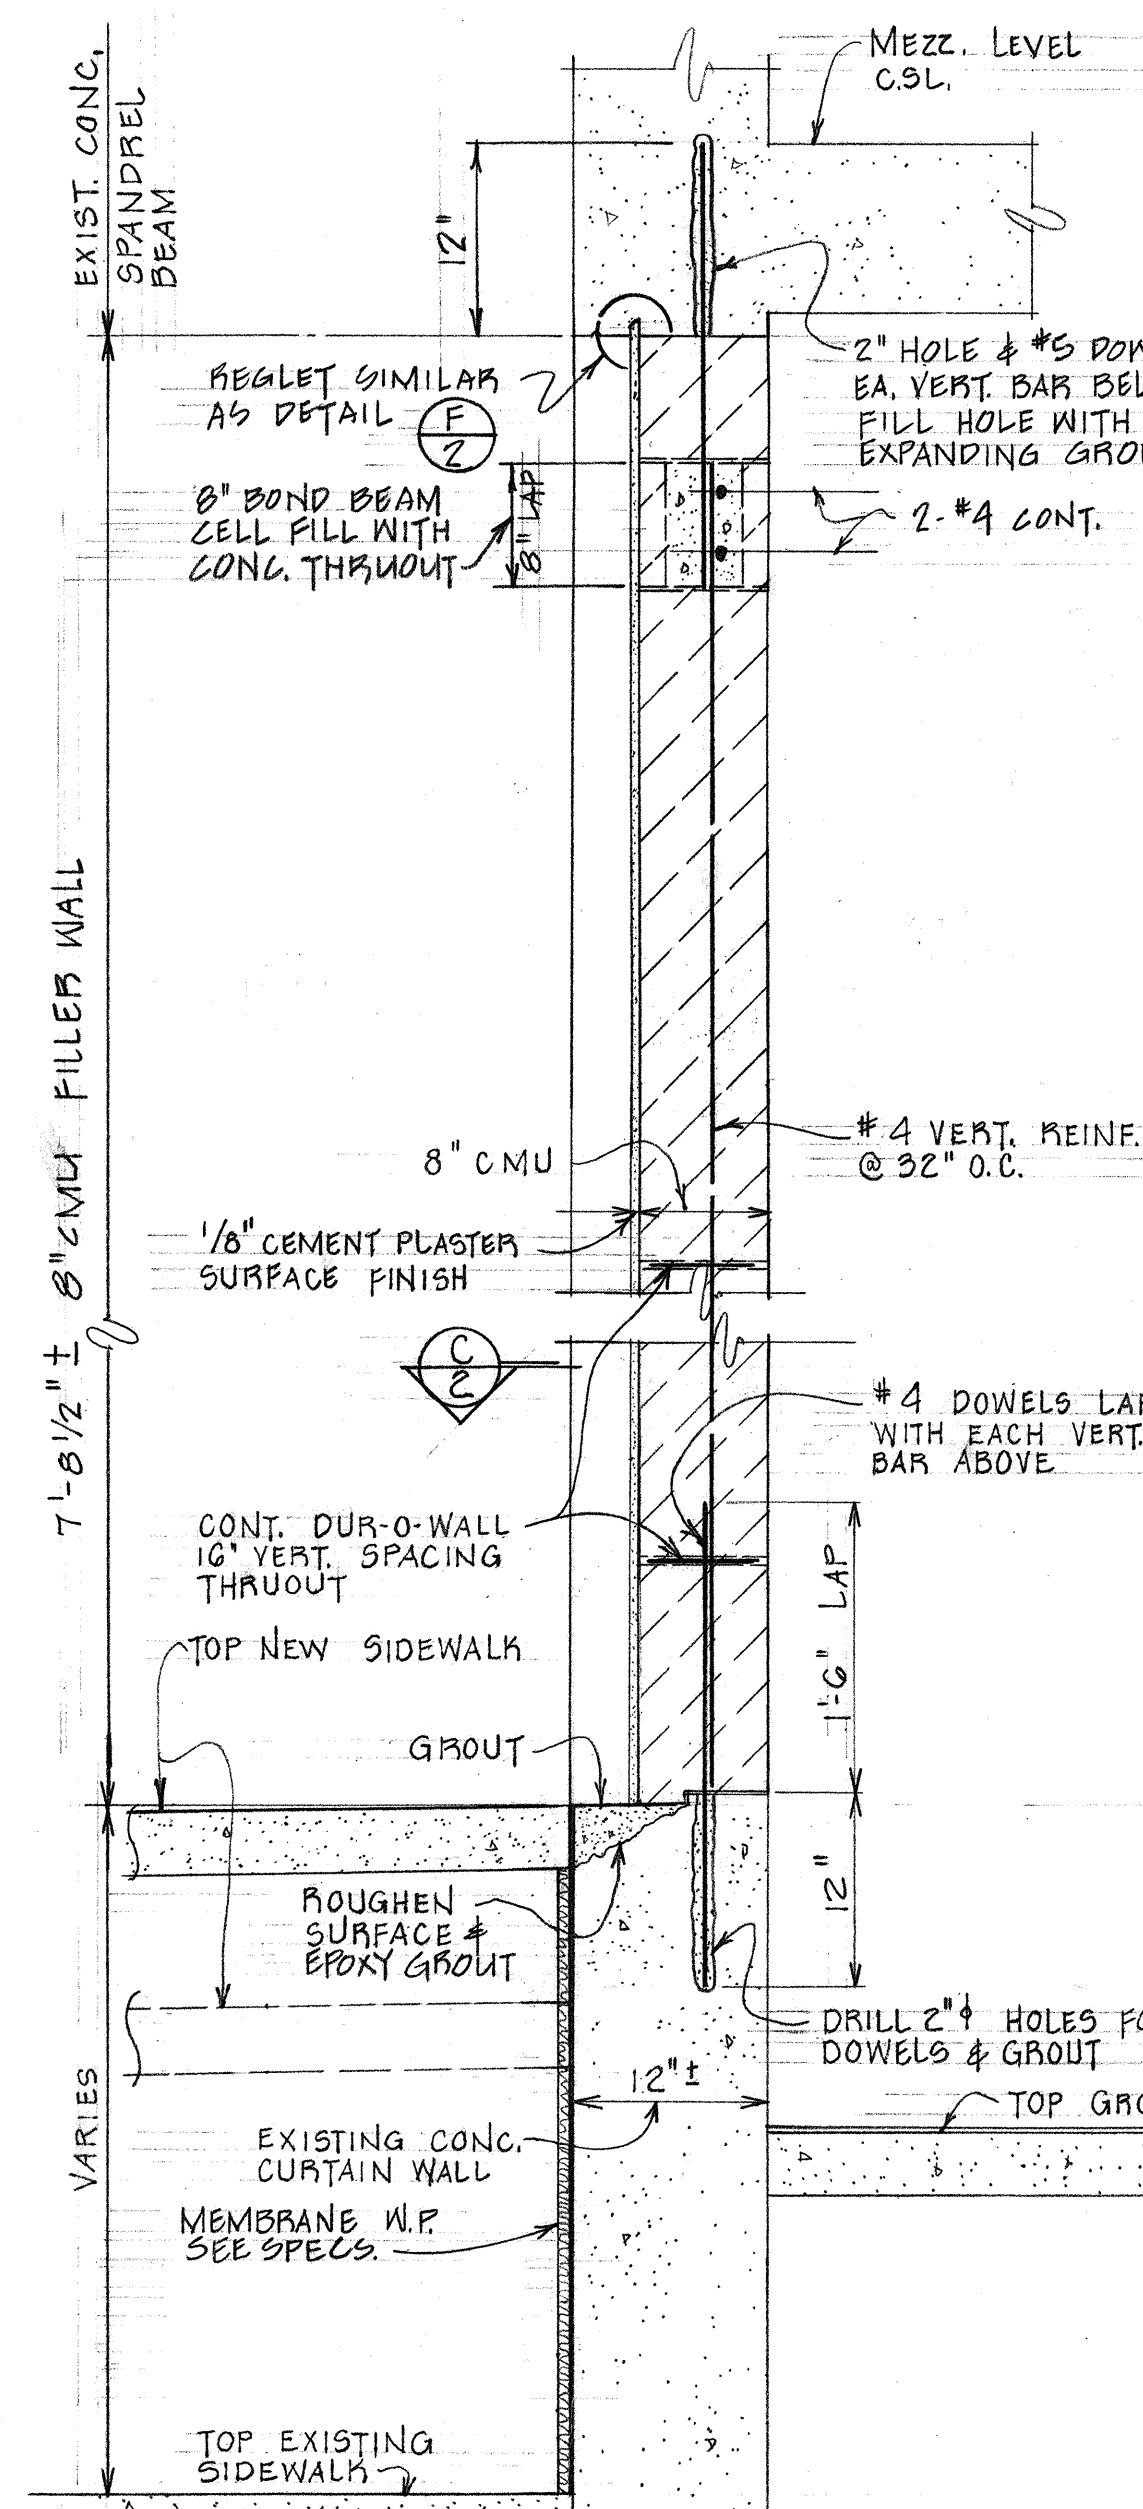

TYPICAL WALL SECTION A-A
SCALE: 1" = 1'-0"

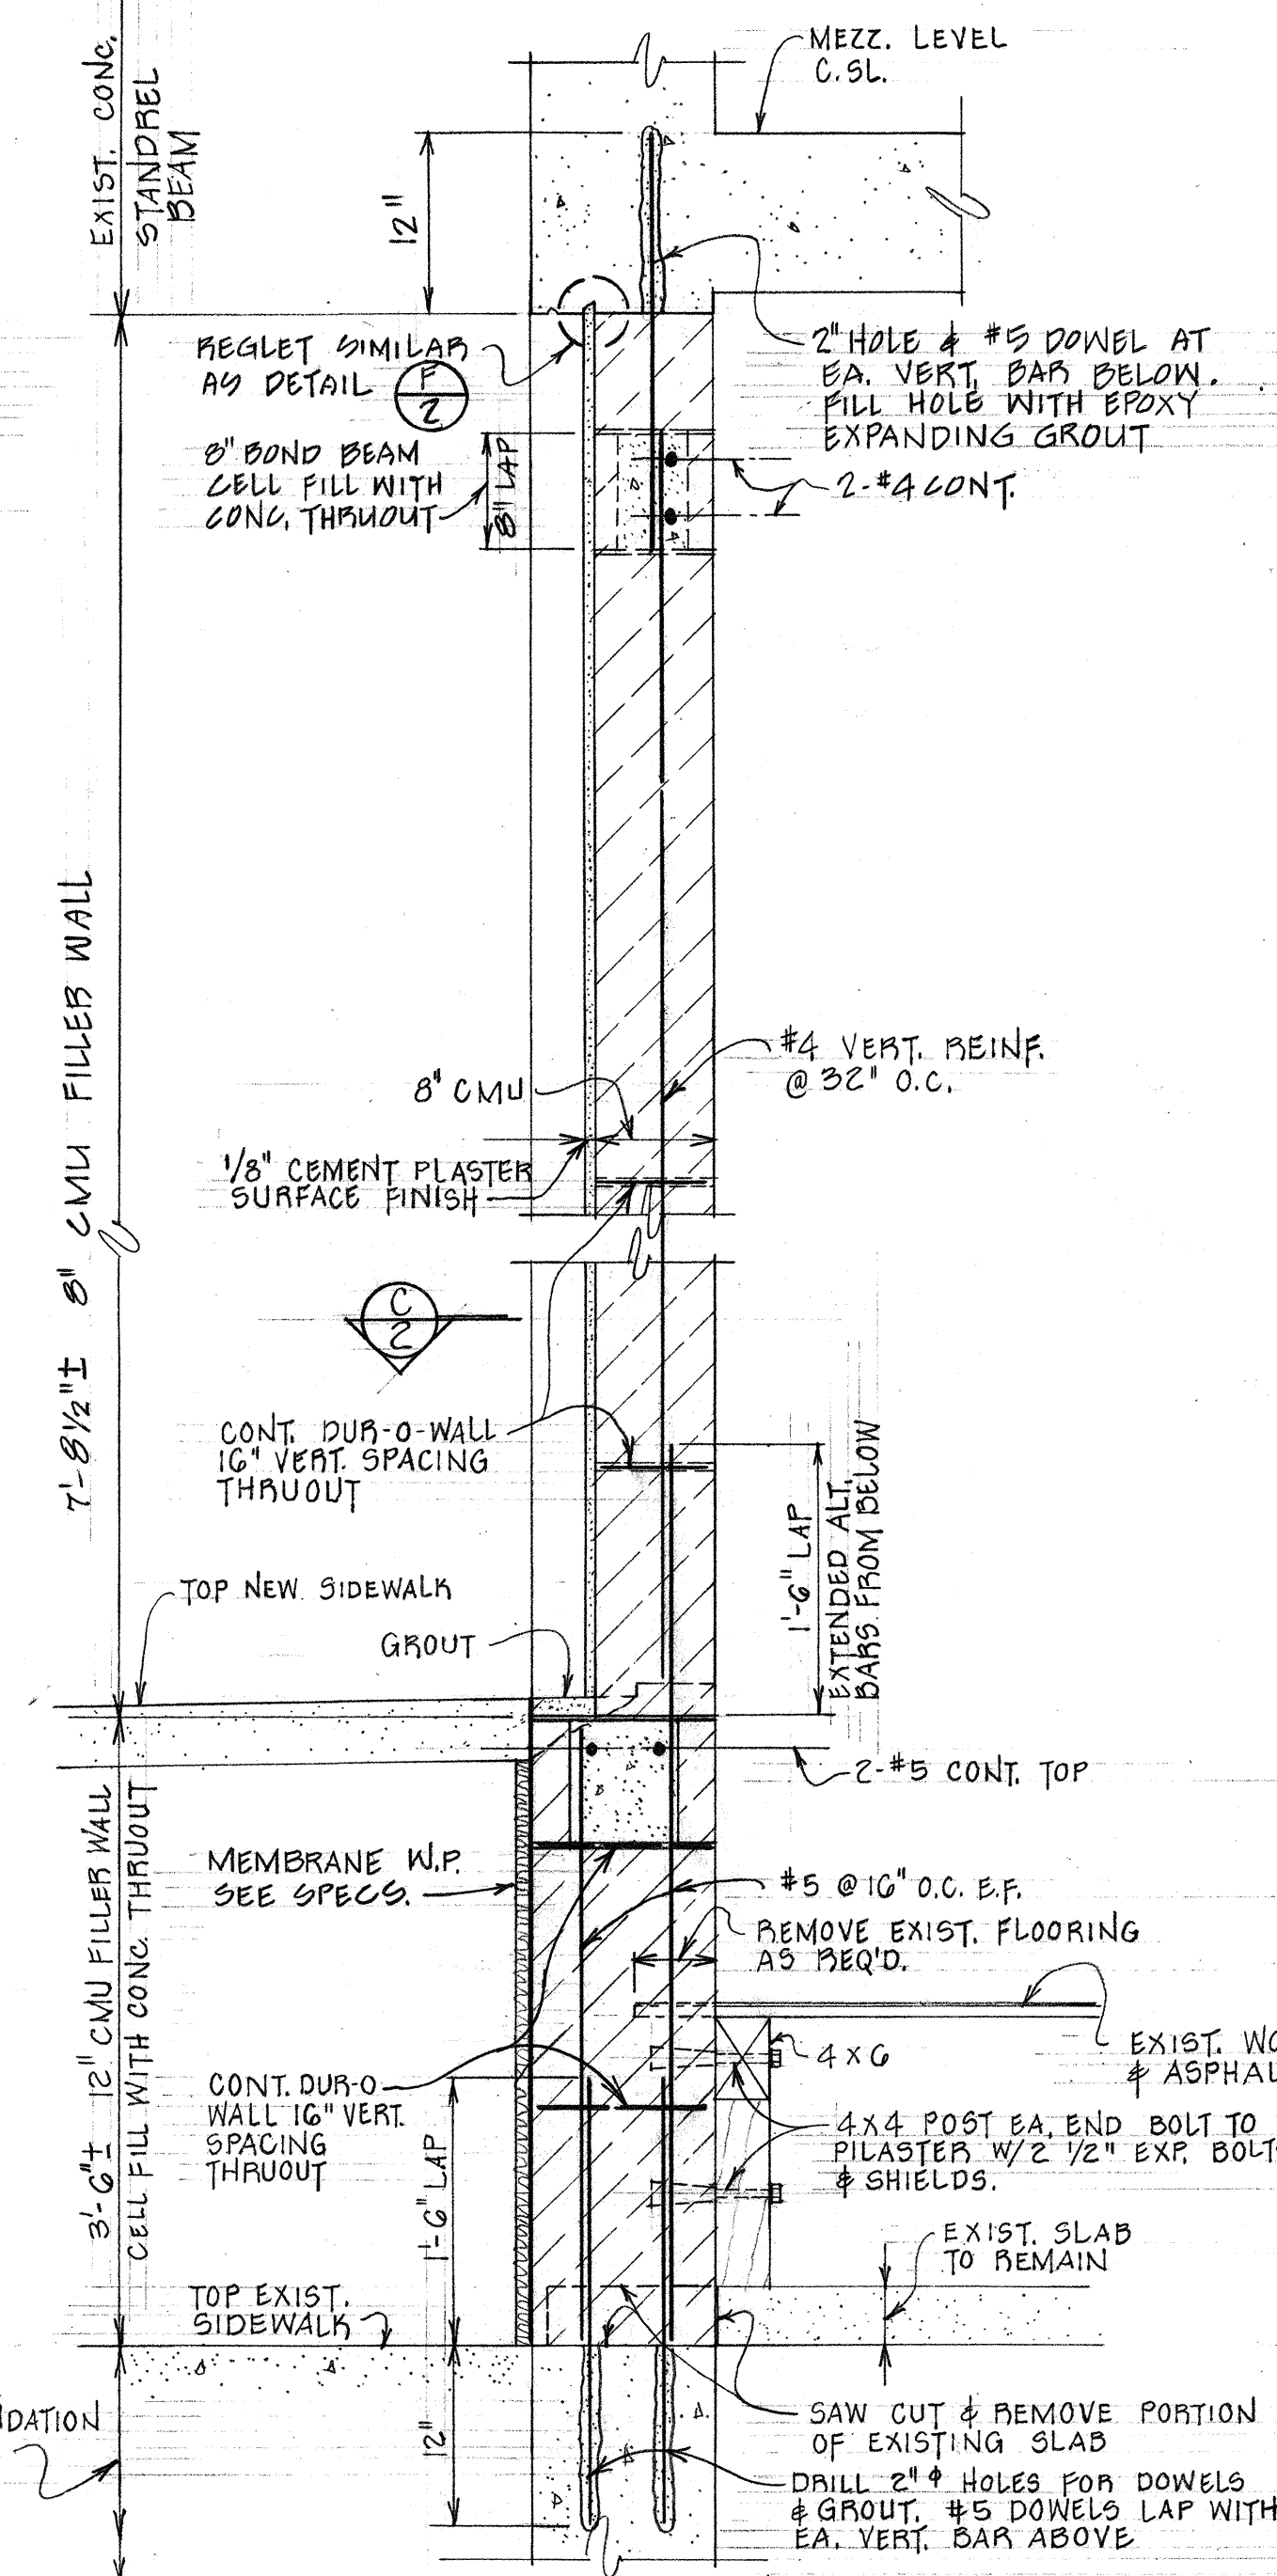

SECTION B-B
SCALE: 1" = 1'-0"

- NOTES: ALL DIMENSIONS SHALL BE VERIFIED IN THE FIELD BY THE CONTRACTOR BEFORE PROCEEDING WITH WORK.
- MATERIALS: ALL CONCRETE TO BE CLASS A CONCRETE FOR BLOCK WALLS - SEE SPECIFICATIONS.
- ALL CONCRETE MASONRY UNITS (CMU) TO BE 8"X8"X16" OR 8"X12"X16", 2 CELL TYPE HOLLOW BLOCKS. SEE SPECIFICATIONS.
- CEMENT PLASTER & PAINTING - SEE SPECIFICATIONS.



R. J. Jacobs, Capt USCG
FOR COMMANDER
14TH COAST GUARD DISTRICT
3-21-74
DATE

STATE OF HAWAII
DEPARTMENT OF TRANSPORTATION
HIGHWAYS DIVISION
REHABILITATION OF EXISTING
PIER 4 BUILDING

SHEET No. 1 OF 2 SHEETS

DATE	11/13
DESIGNED BY	...
CHECKED BY	...
NOTED BY	...
ORIGINAL PLAN	...
NO.	...

FED. ROAD DIST. NO.	STATE	FED. AID PROJ. NO.	FISCAL YEAR	SHEET NO.	TOTAL SHEETS
HAWAII	HAW.	EH6-U-092-1(11)	1974	41	141

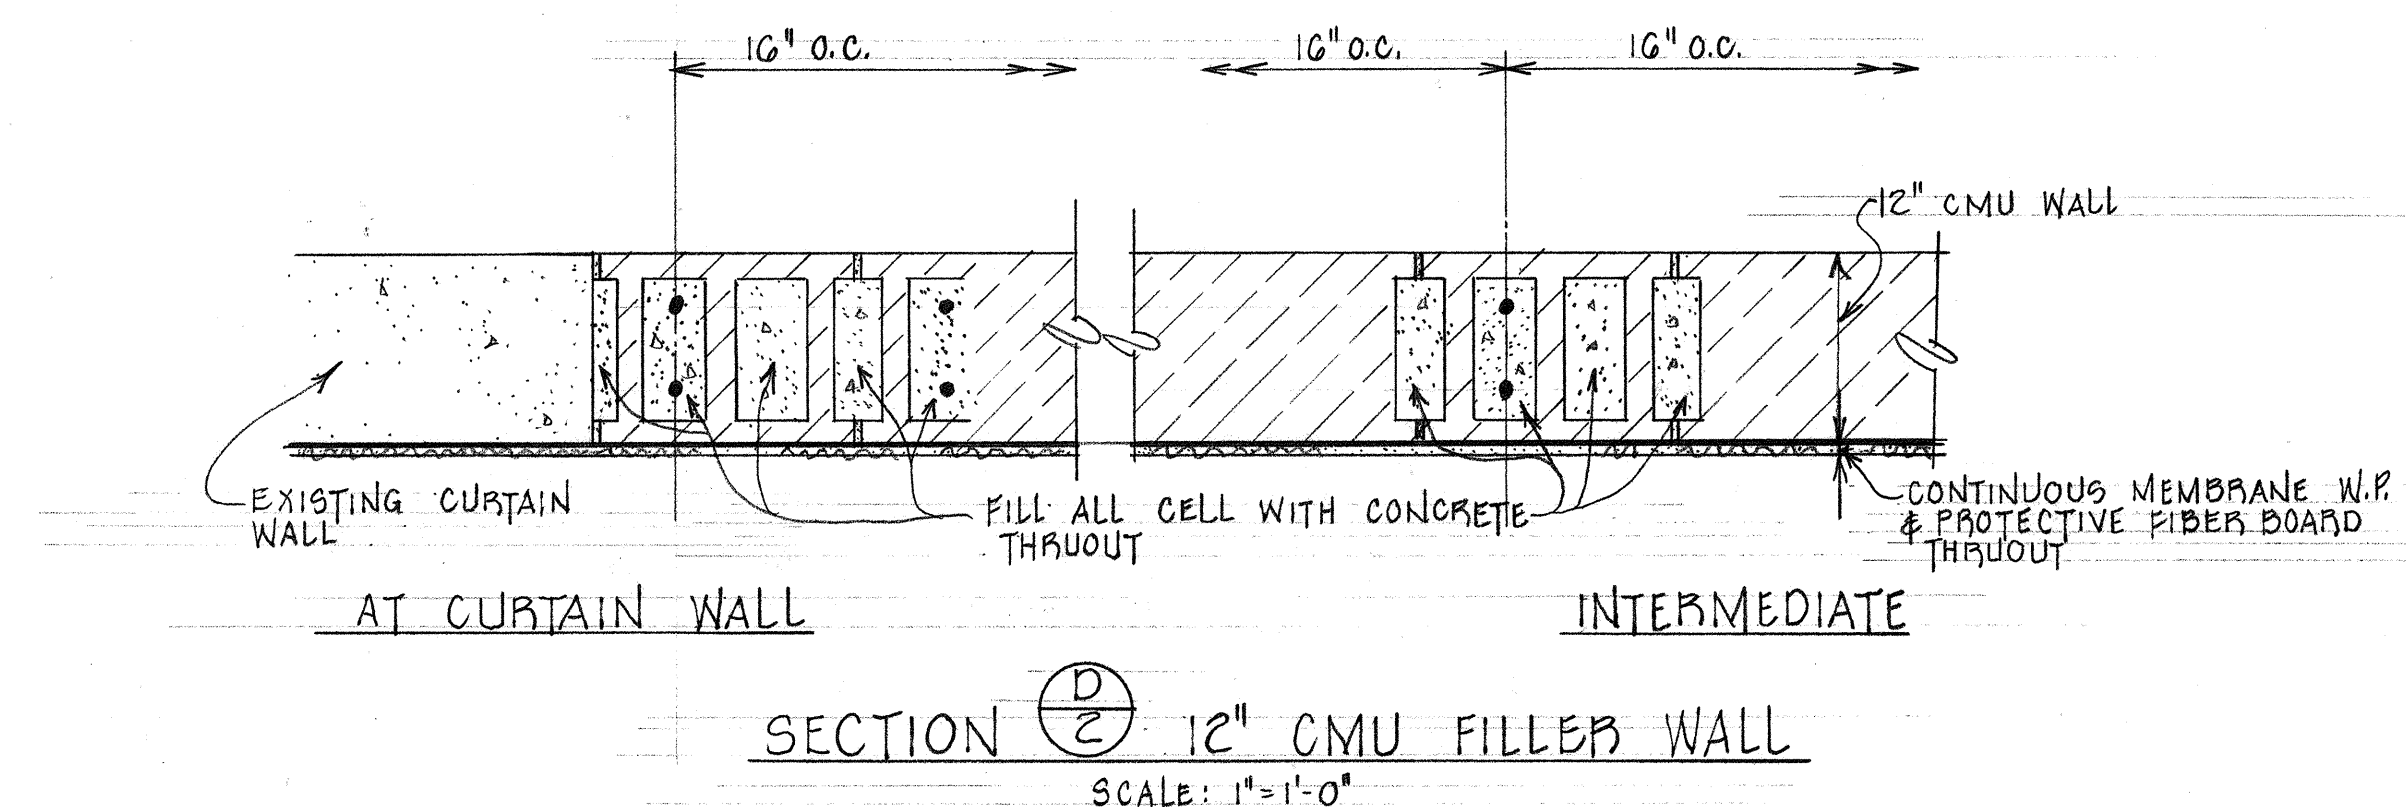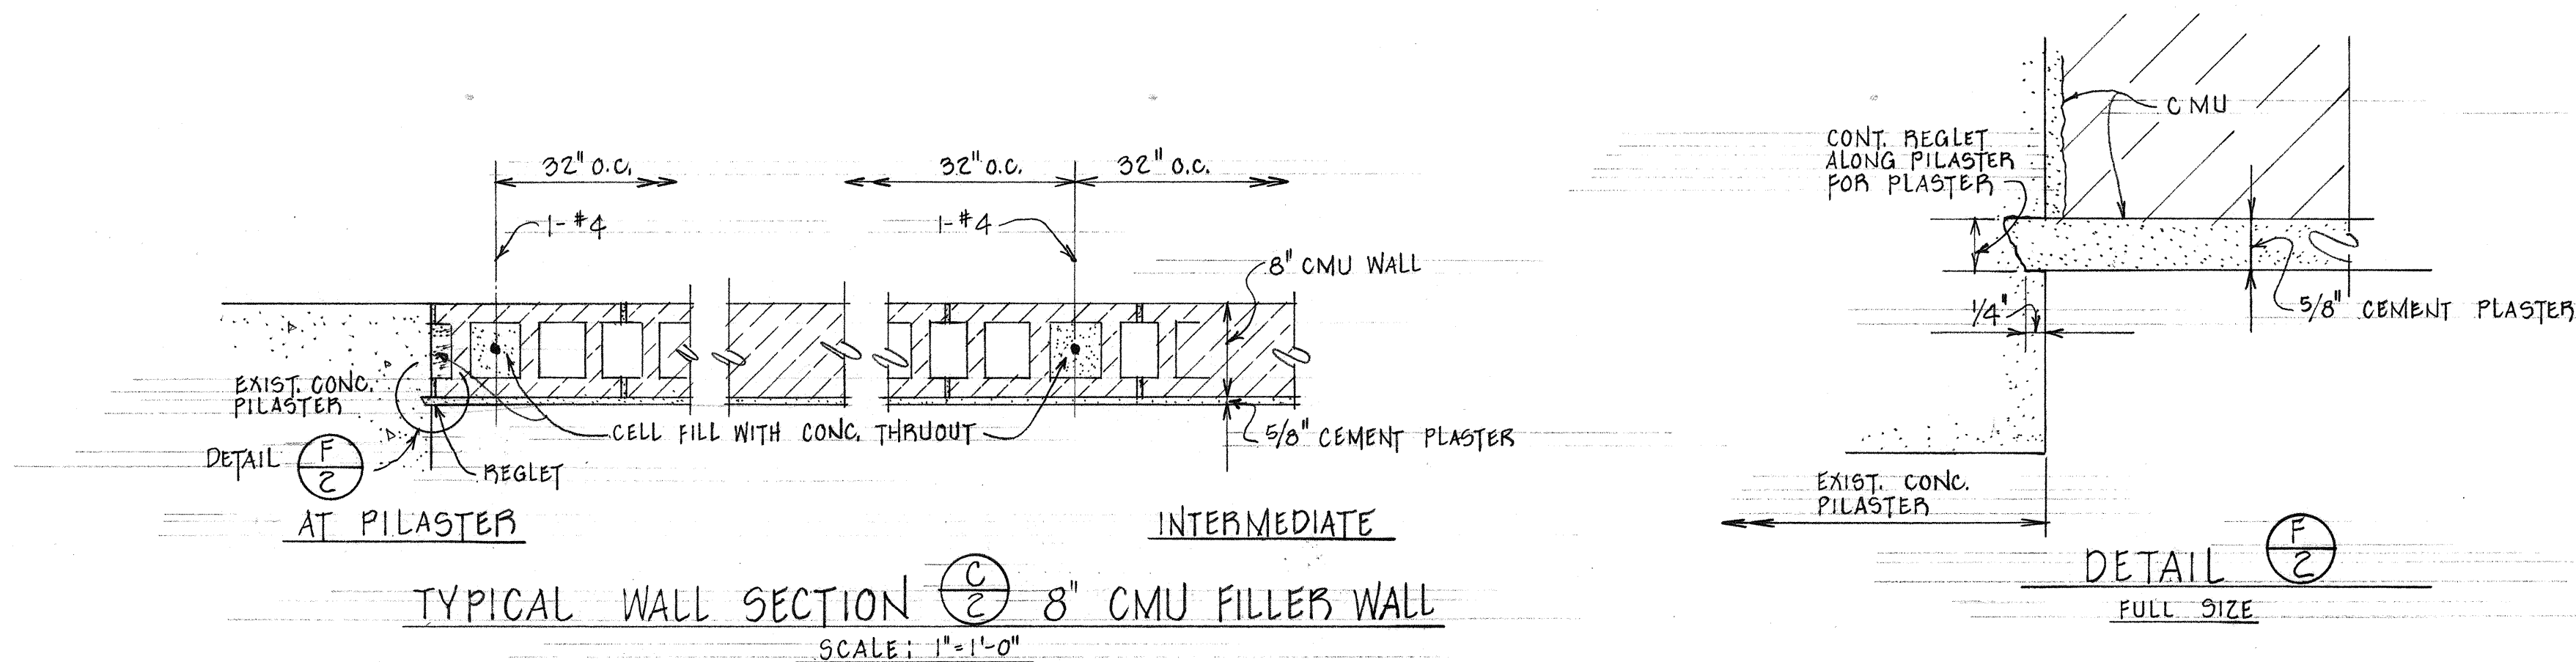

R. J. Hawk, Capt. USCG 3-21-74
 FOR COMMANDER DATE
 14TH COAST GUARD DISTRICT

STATE OF HAWAII
 DEPARTMENT OF TRANSPORTATION
 HIGHWAYS DIVISION
 REHABILITATION OF EXISTING
 PIER 4 BUILDING


SHEET No. 2 OF 3 SHEETS

DESIGNED BY	DATE
DRAWN BY	3/21/74
CHECKED BY	
NOTED BY	
NO.	

GENERAL NOTES


-
- 2" or 2 1/2" Pipe
- Existing Chain Link Fence and Posts to remain
- 14 3/4"
- 4"
- 6"
- 18" ±
- 1" Chamfer
- Class A Concrete
- #3 Longitudinal, 2" Minimum Clearance
- Break Out Hatch Portion of Exst'g Wall
- #3 Dowels, Grout into 3/4" φ holes 6" deep
- 2" Saw Cut
- Roughen Surface for Bond

Scale: $1\frac{1}{2}" = 1' - 0"$

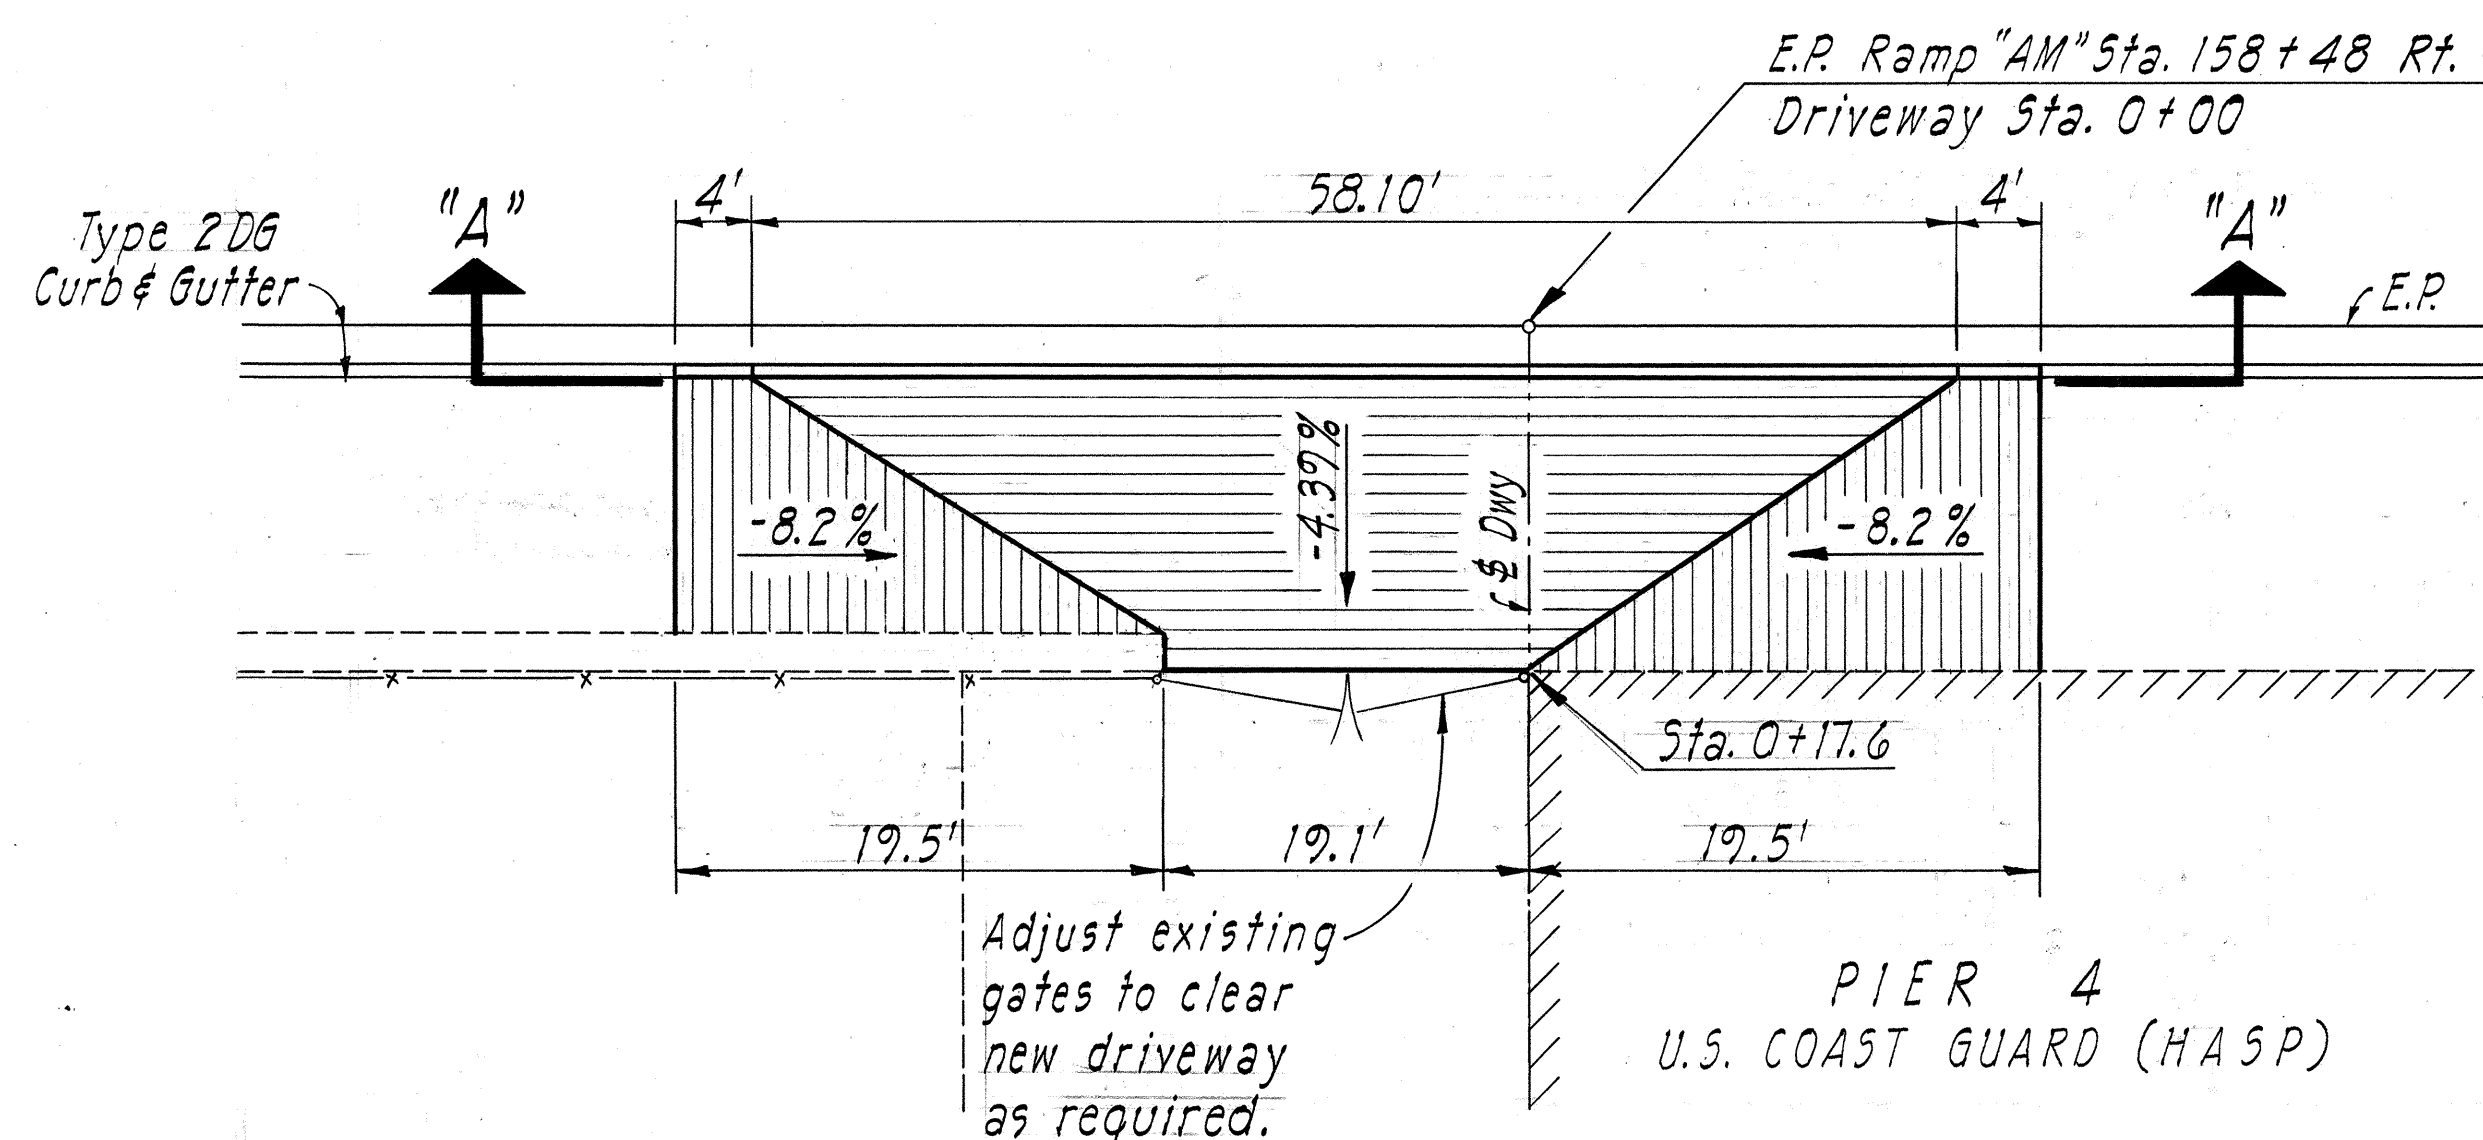



PLAN ~ DRIVEWAY

Not to Scale

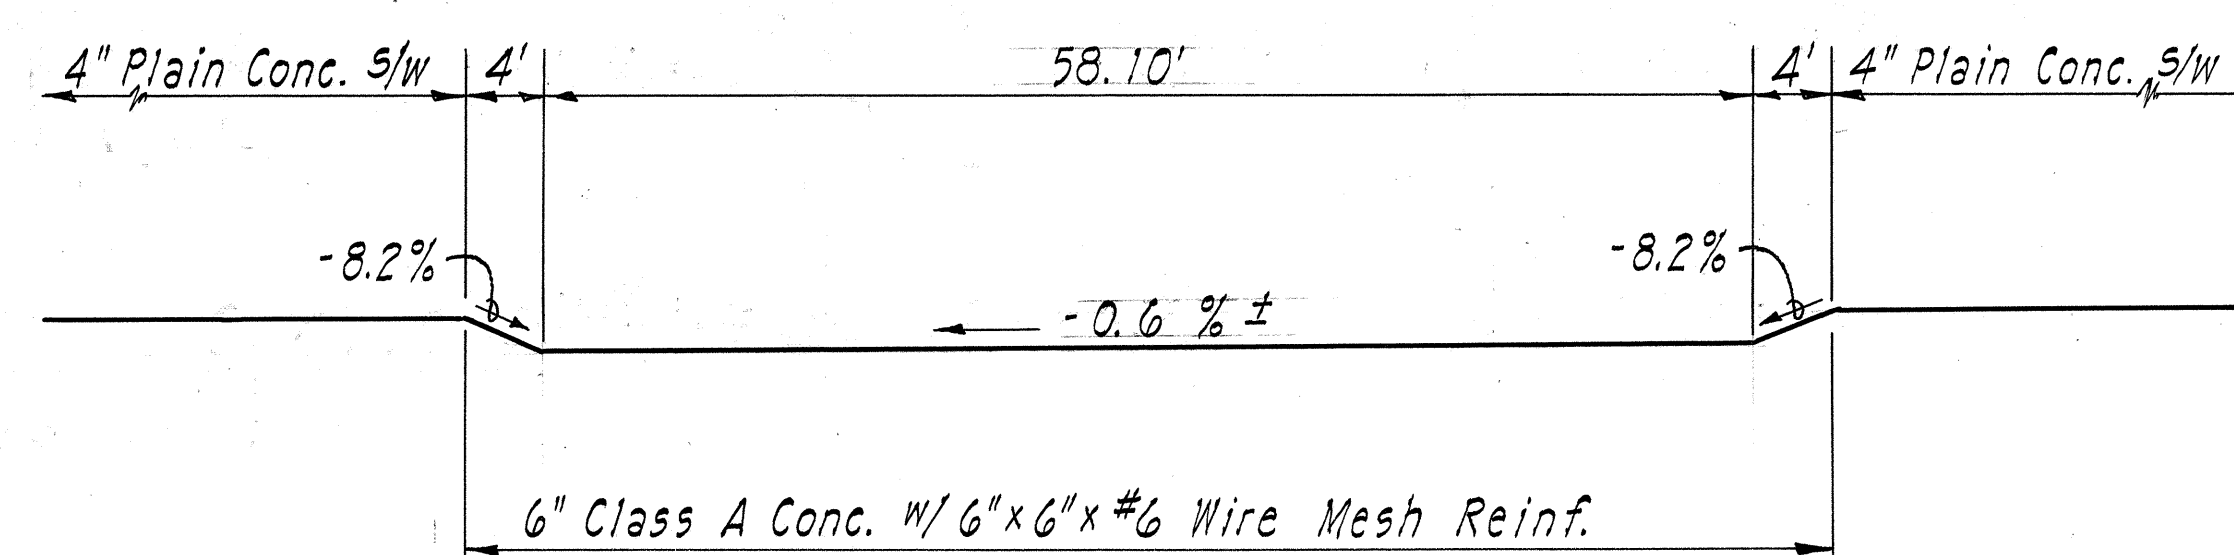

SECTION "A-A"

Not to Scale

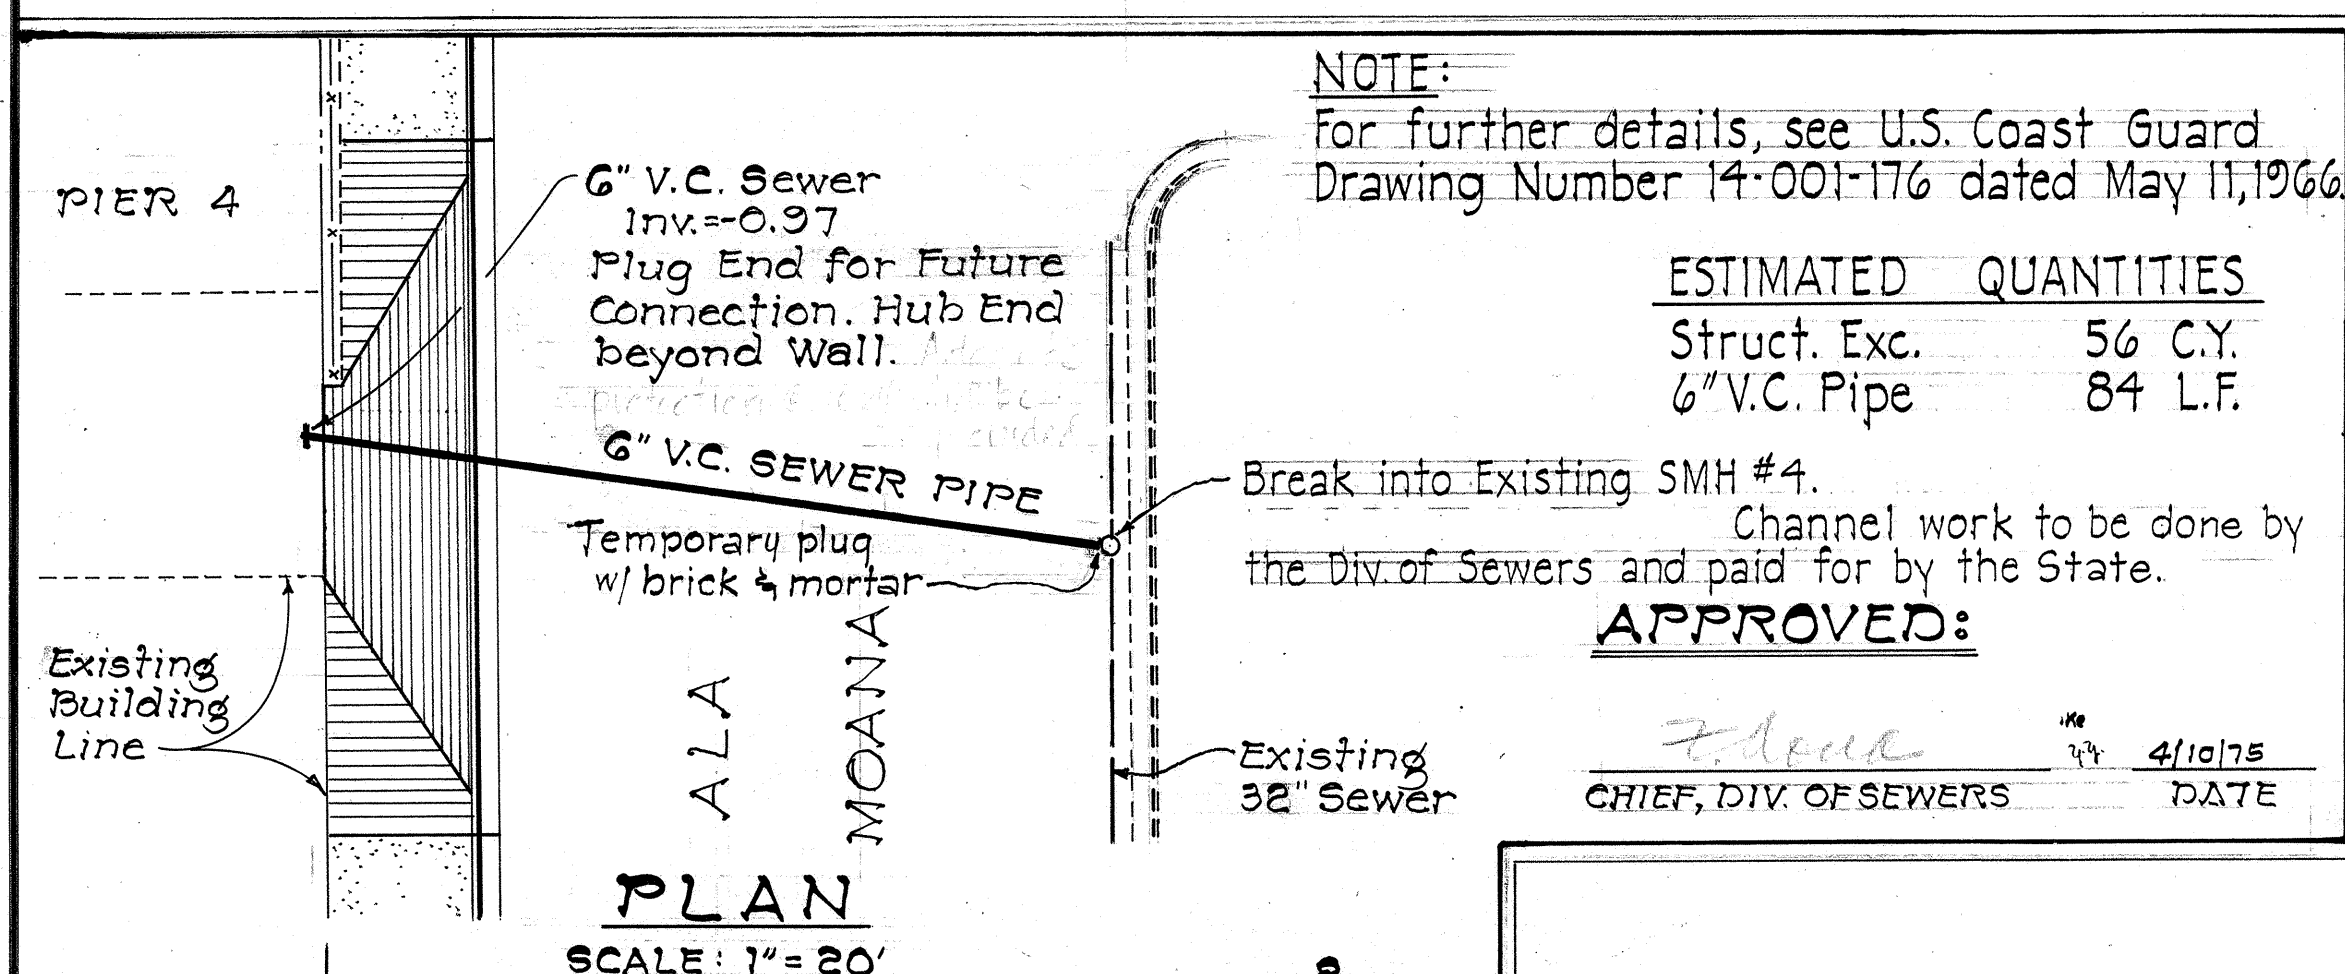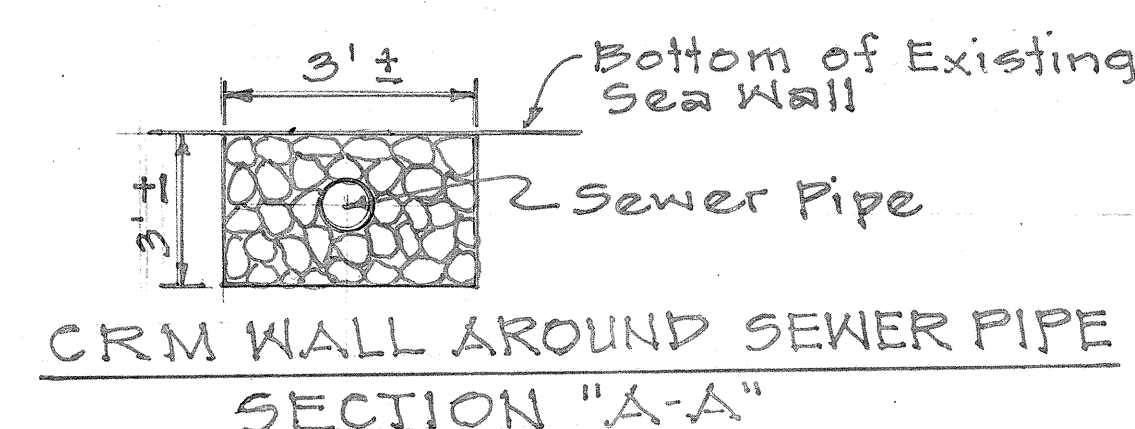


NOTE:
For further details, see U.S. Coast Guard
Drawing Number 14-001-176 dated May 11, 1966.

ESTIMATED QUANTITIES


Struct. Exc.	56 C.Y.
6" V.C. Pipe	84 L.F.

APPROVED:

7. done ¹⁴⁸ 74 4/10/75
CHIEF, DIV. OF SEWERS DATE

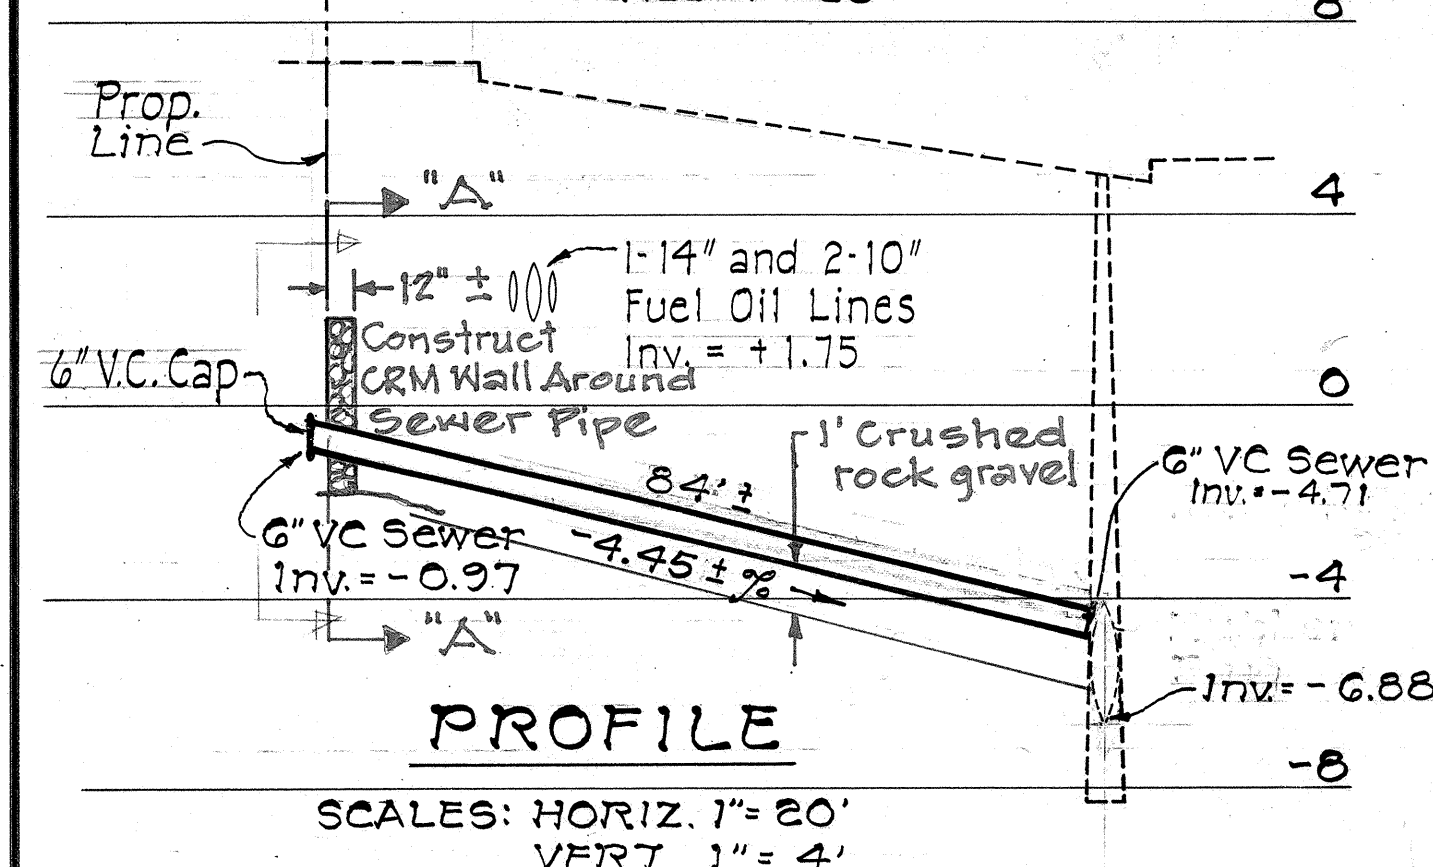

6" SEWER CONNECTION

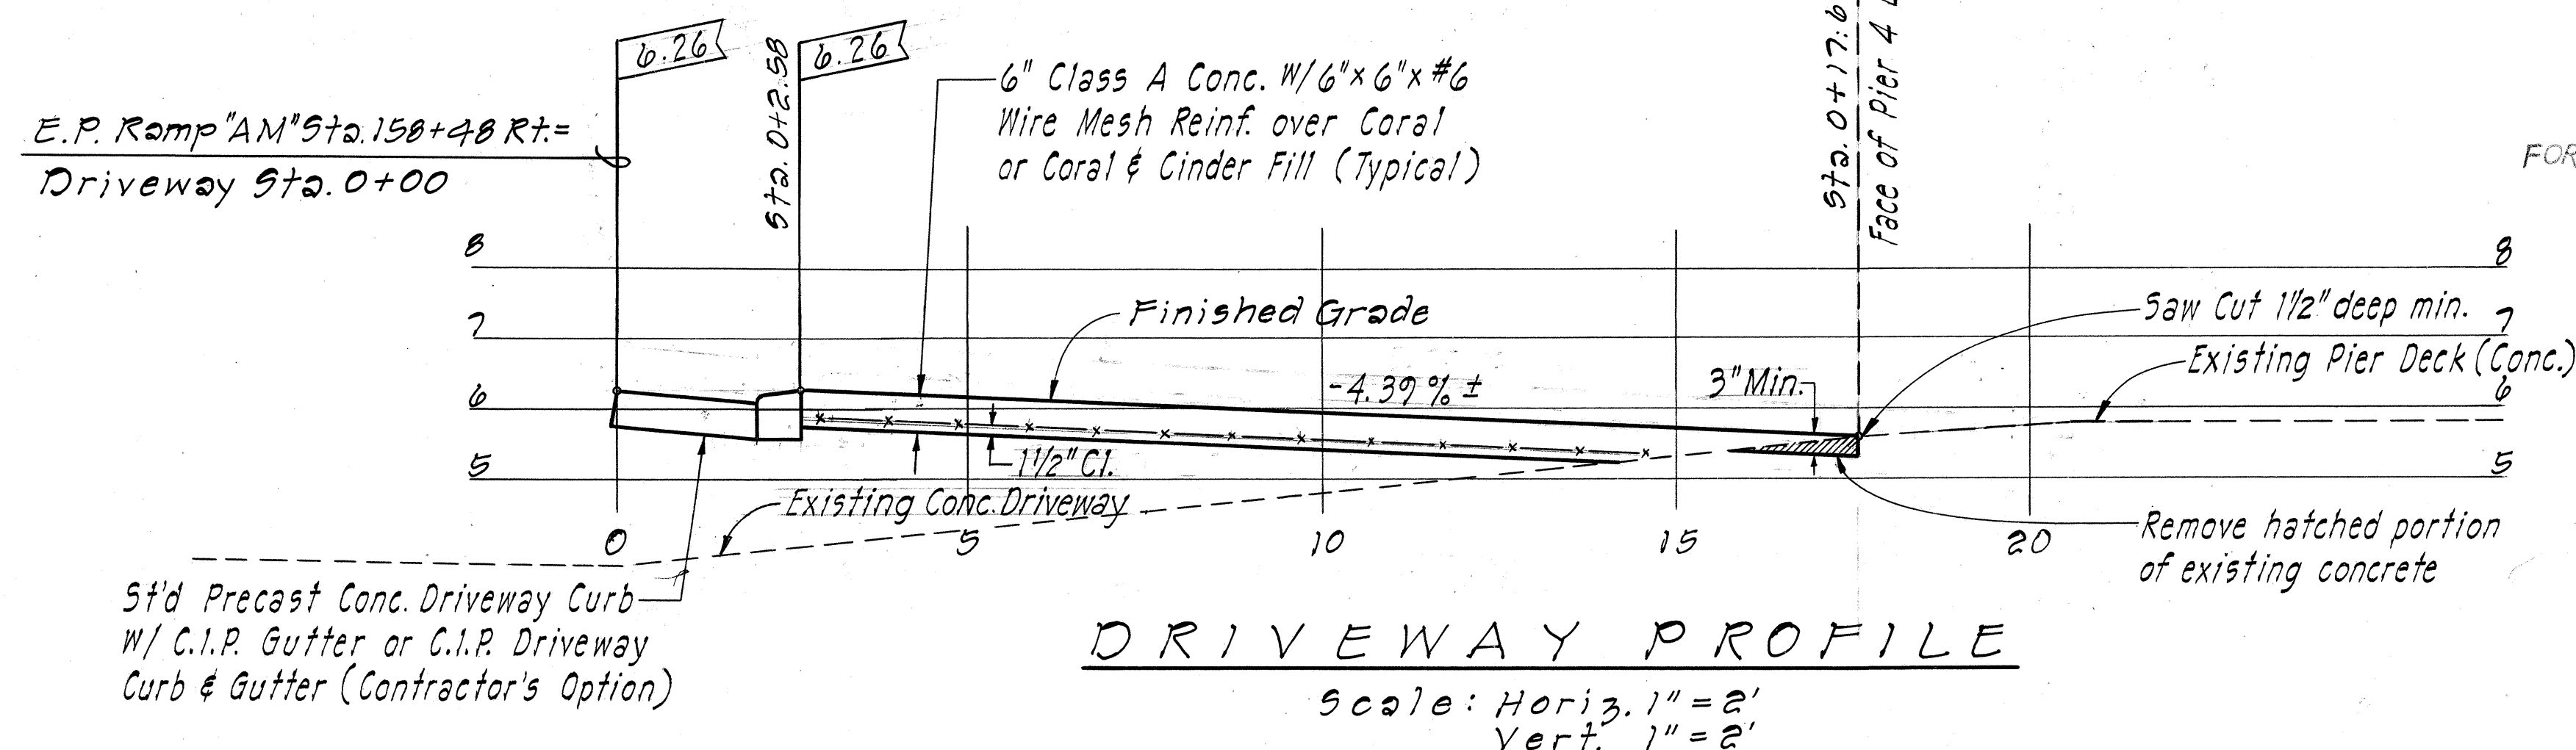

DRIVEWAY PROFILE

Scale: Horiz. $1'' = 2'$
Vert $1'' = 2'$

1	Added notes to Sewer Connection Detail for clarification	<i>[Signature]</i>	4/10/73
NO.	REVISION	APPROVED BY	DATE

K. J. Jacobs, Capt. USCG 3-21-74
FOR COMMANDER, 14TH COAST GUARD DISTRICT DATE

STATE OF HAWAII
DEPARTMENT OF TRANSPORTATION
HIGHWAYS DIVISION

MISCELLANEOUS DETAILS
AT PIER 4

Scale : As Noted Date : Aug. 1973

SHEET No. 3 OF 3 SHEETS