



FINAL SURVEY	SURVEINED	BY	DATE
NOTE BOOK	PLOTTED		
	TEMPLATE		
	AREAS		
	AREAS CHECKED		

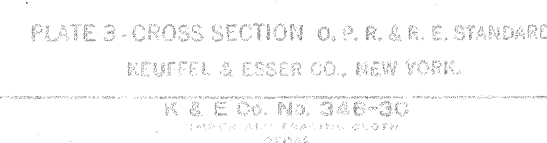

FINAL SURVEY	SURVEYED PLOTTED	BY	DATE
NOTE-BOOK	TEMPLATE		
	AREAS		
	AREAS CHECKED		
NO.			

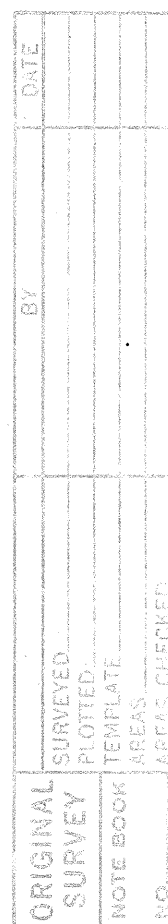