

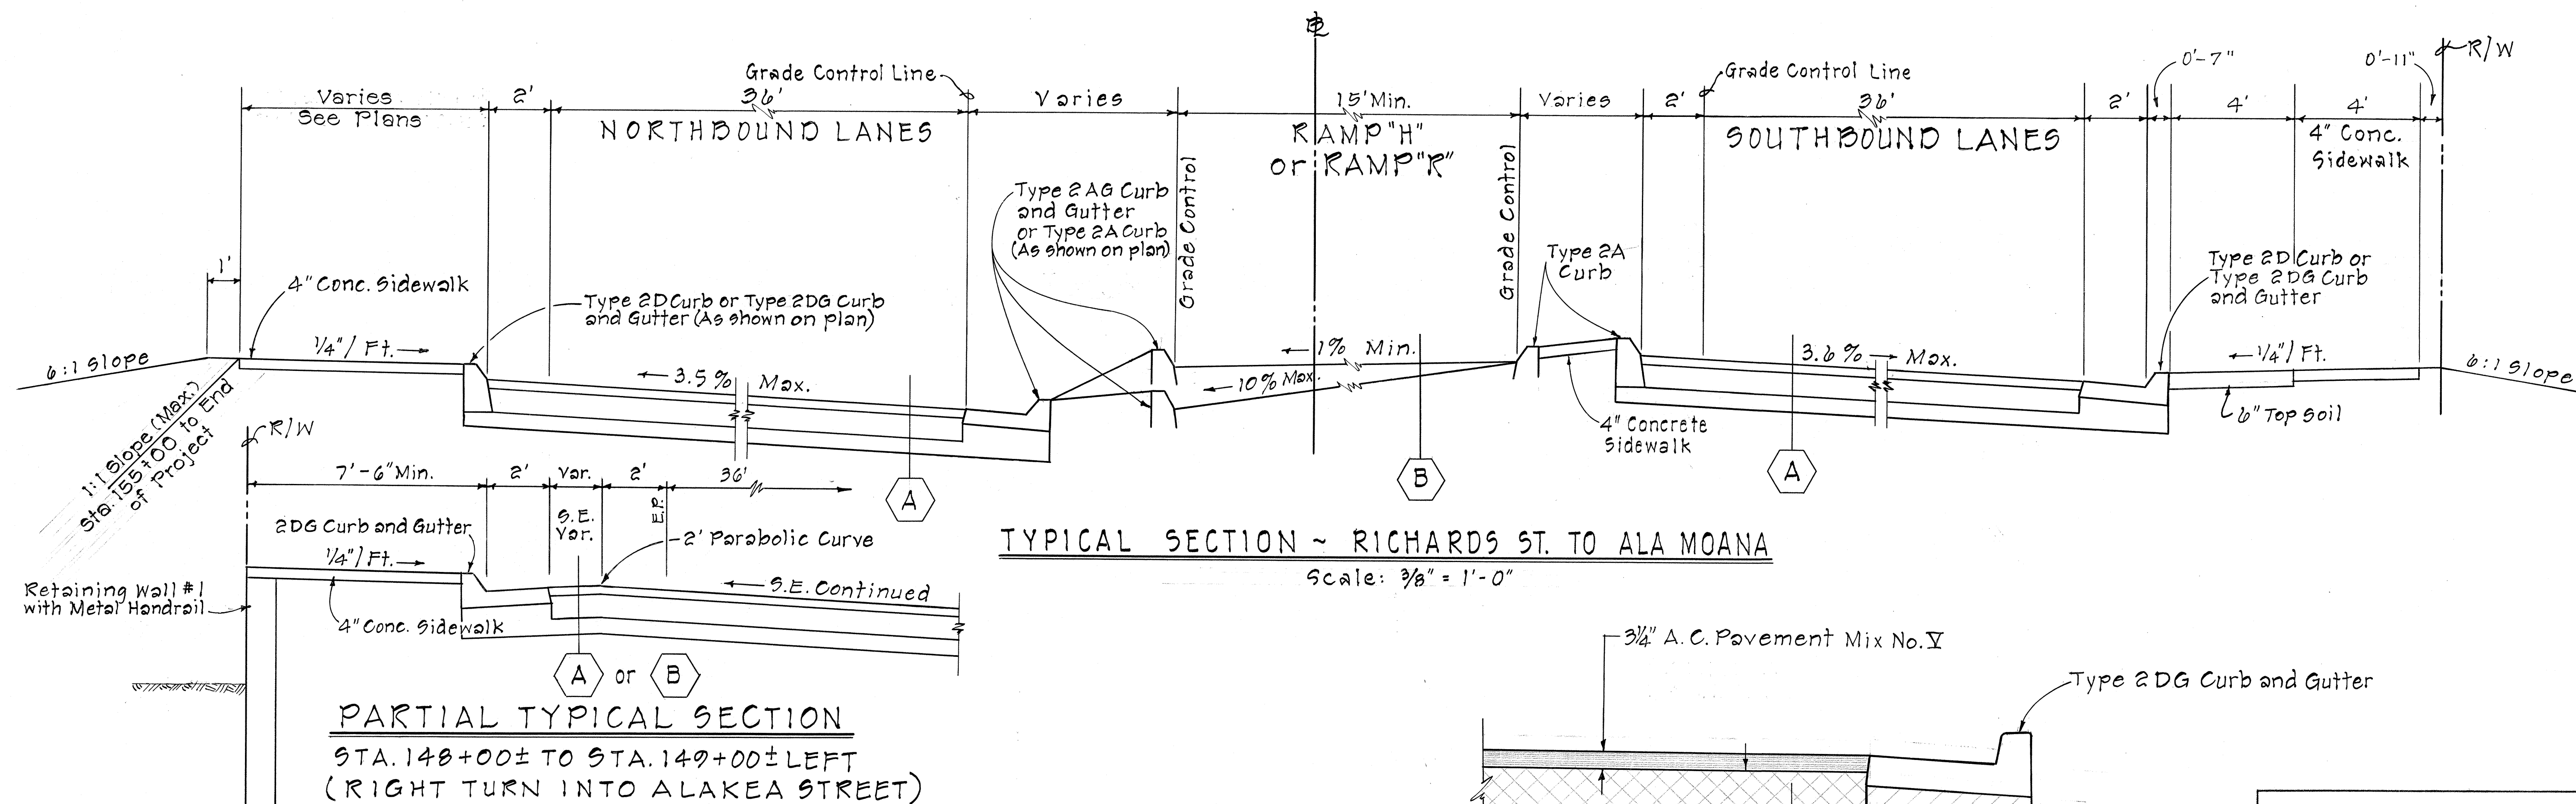


FED. ROAD DIST. NO.	STATE	FED. AID PROJ. NO.	FISCAL YEAR	SHEET NO.	TOTAL SHEETS
HAWAII	HAW.	EHS-U-092-I(II)	1974	2	141

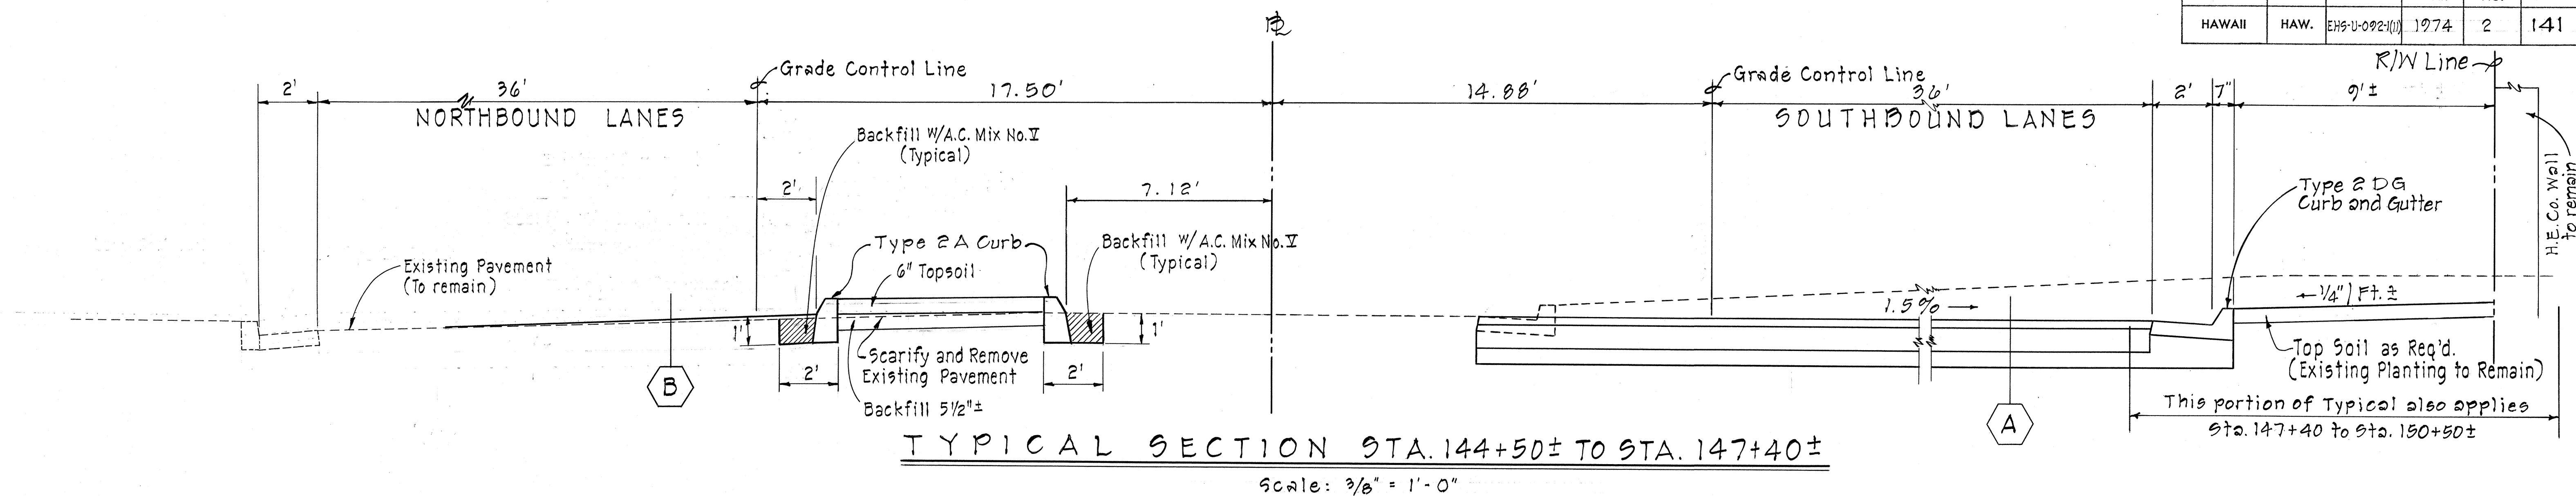

PARTIAL TYPICAL SECTION
STA. 148+00± TO STA. 149+00± LEFT
(RIGHT TURN INTO ALAKEA STREET)

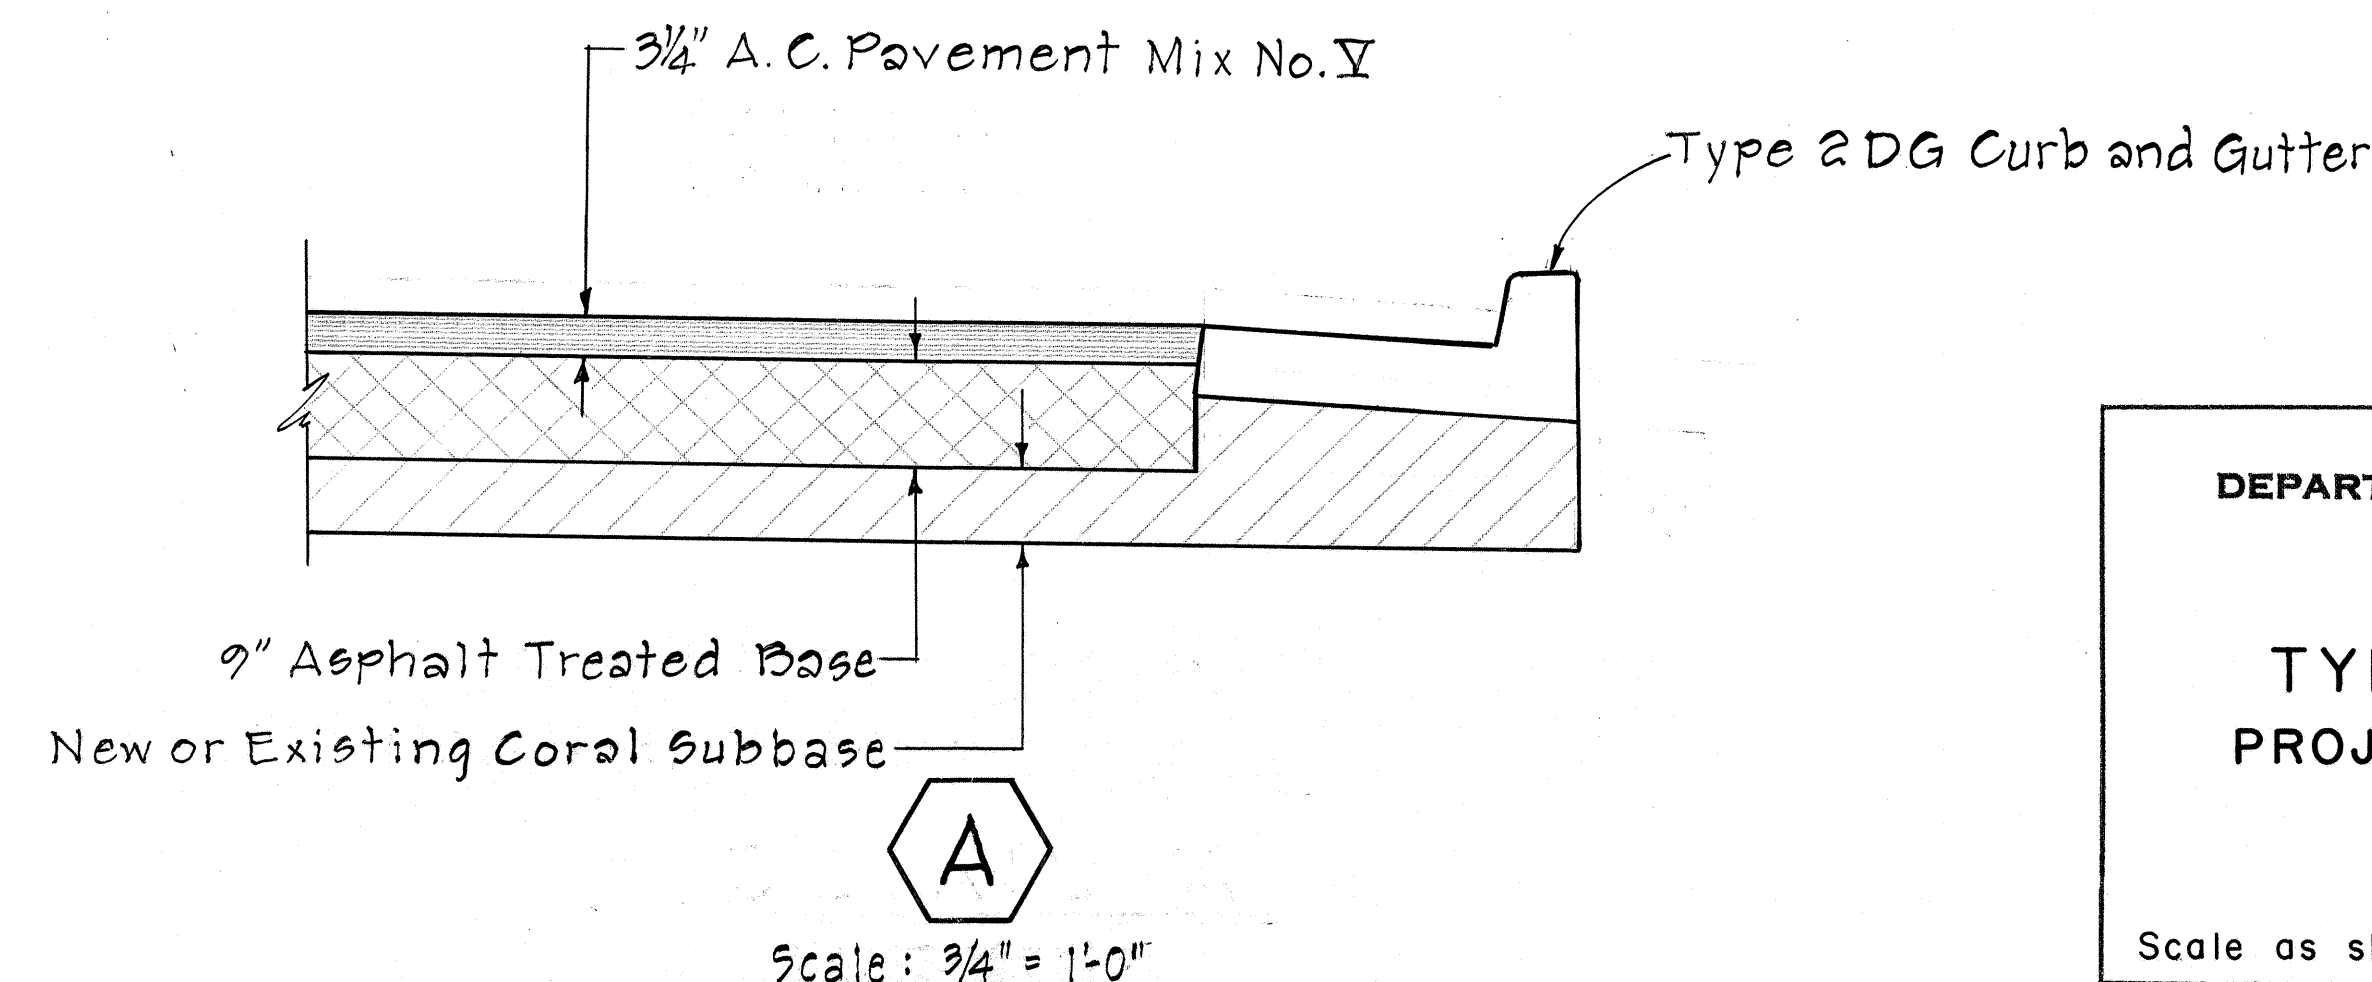

STATE OF HAWAII
DEPARTMENT OF TRANSPORTATION
HIGHWAYS DIVISION




TYPICAL SECTIONS
PROJ. NO. EHS-U-092-I(II)

Scale as shown

SHEET No. 1 OF 3 SHEETS

SURVEY PLOTTED BY	DATE
DRAWN BY	
DESIGNED BY	
NOTED BY	
CHECKED BY	
NO.	


FED. ROAD DIST. NO.	STATE	FED. AID PROJ. NO.	FISCAL YEAR	SHEET NO.	TOTAL SHEETS
HAWAII	HAW.	EHS-U-092-100	1974	3	141

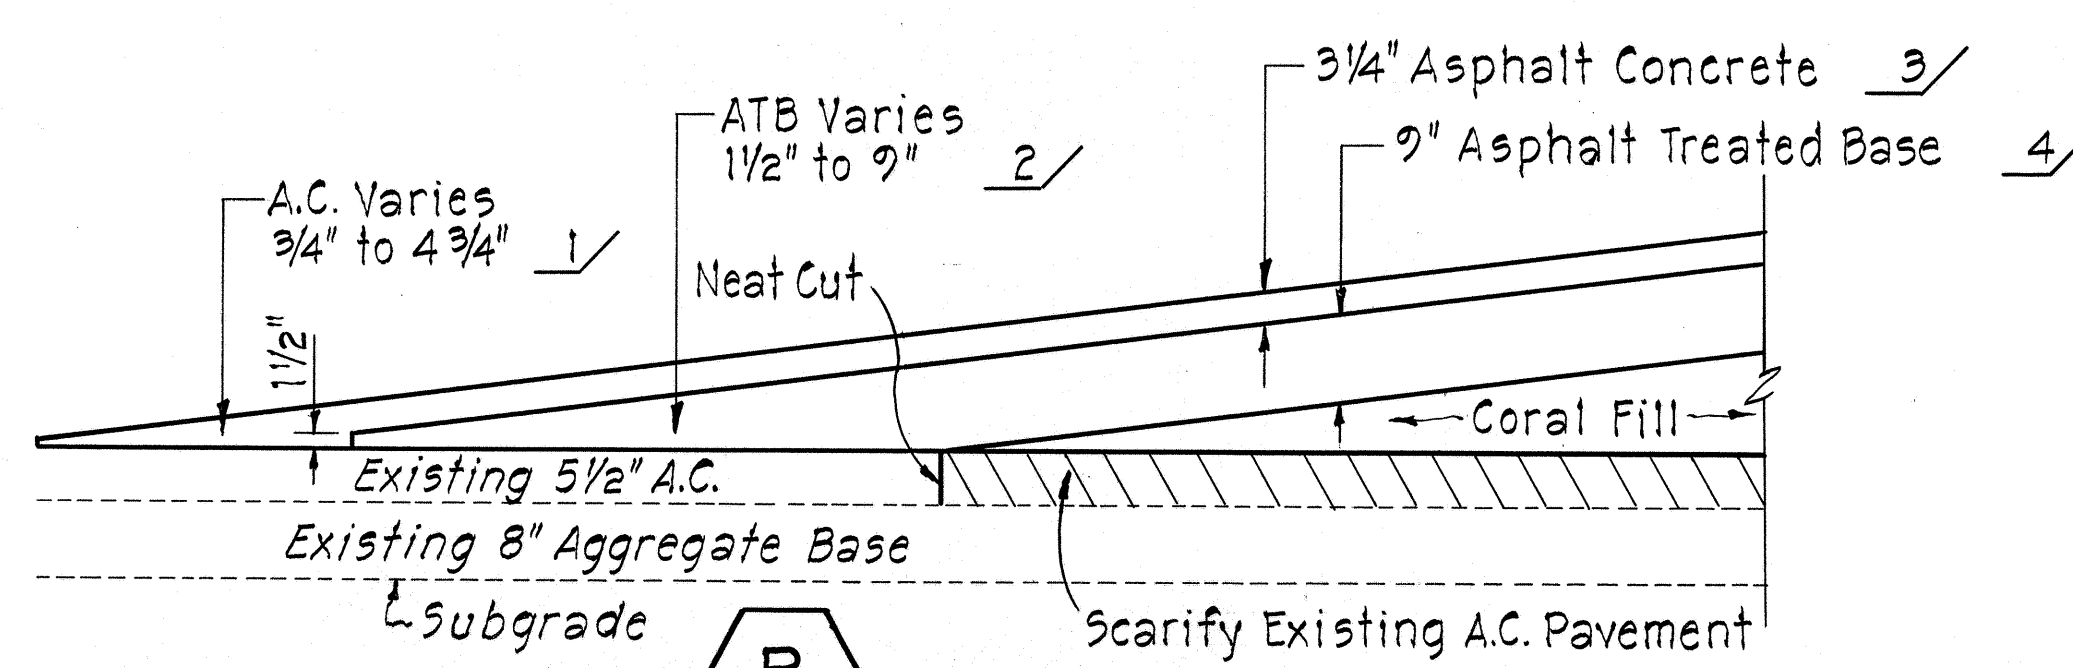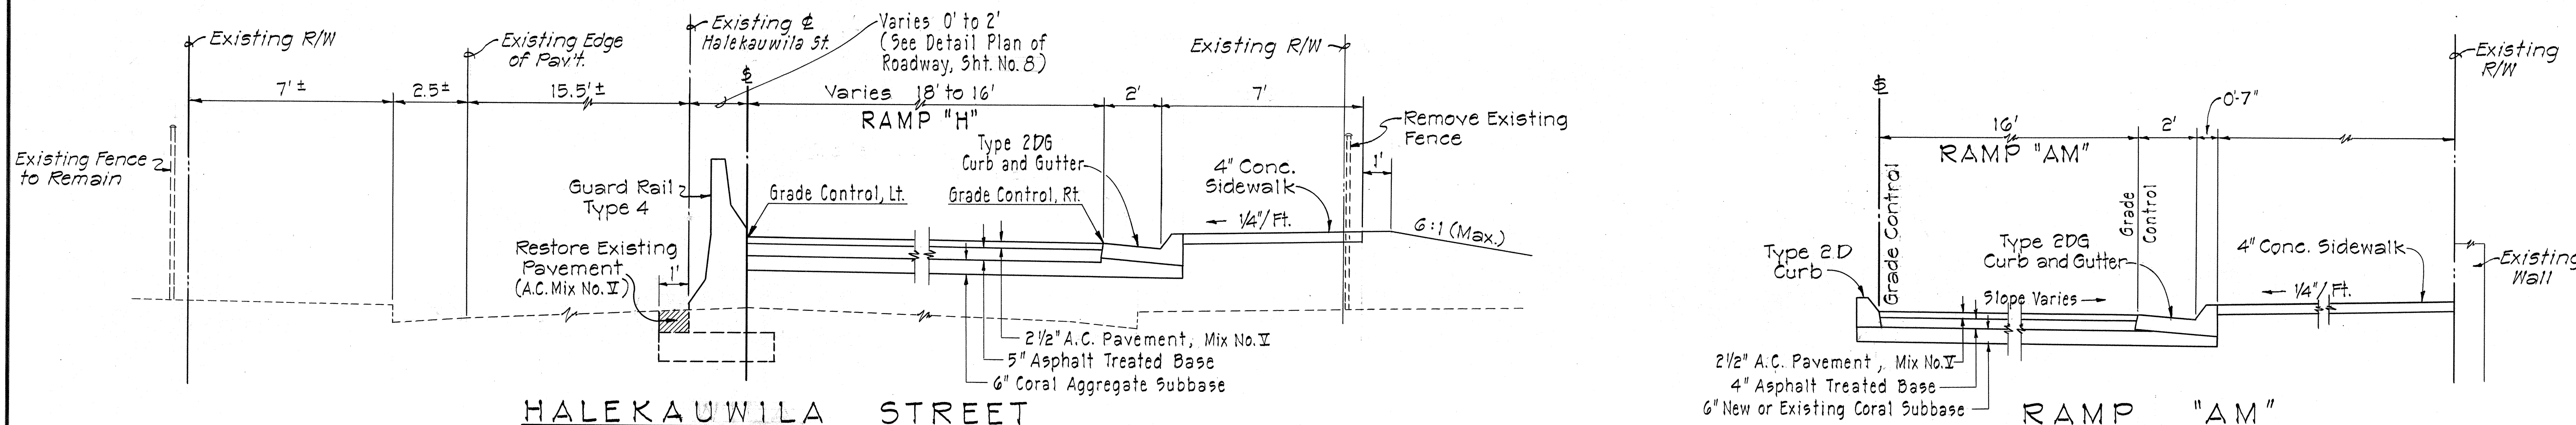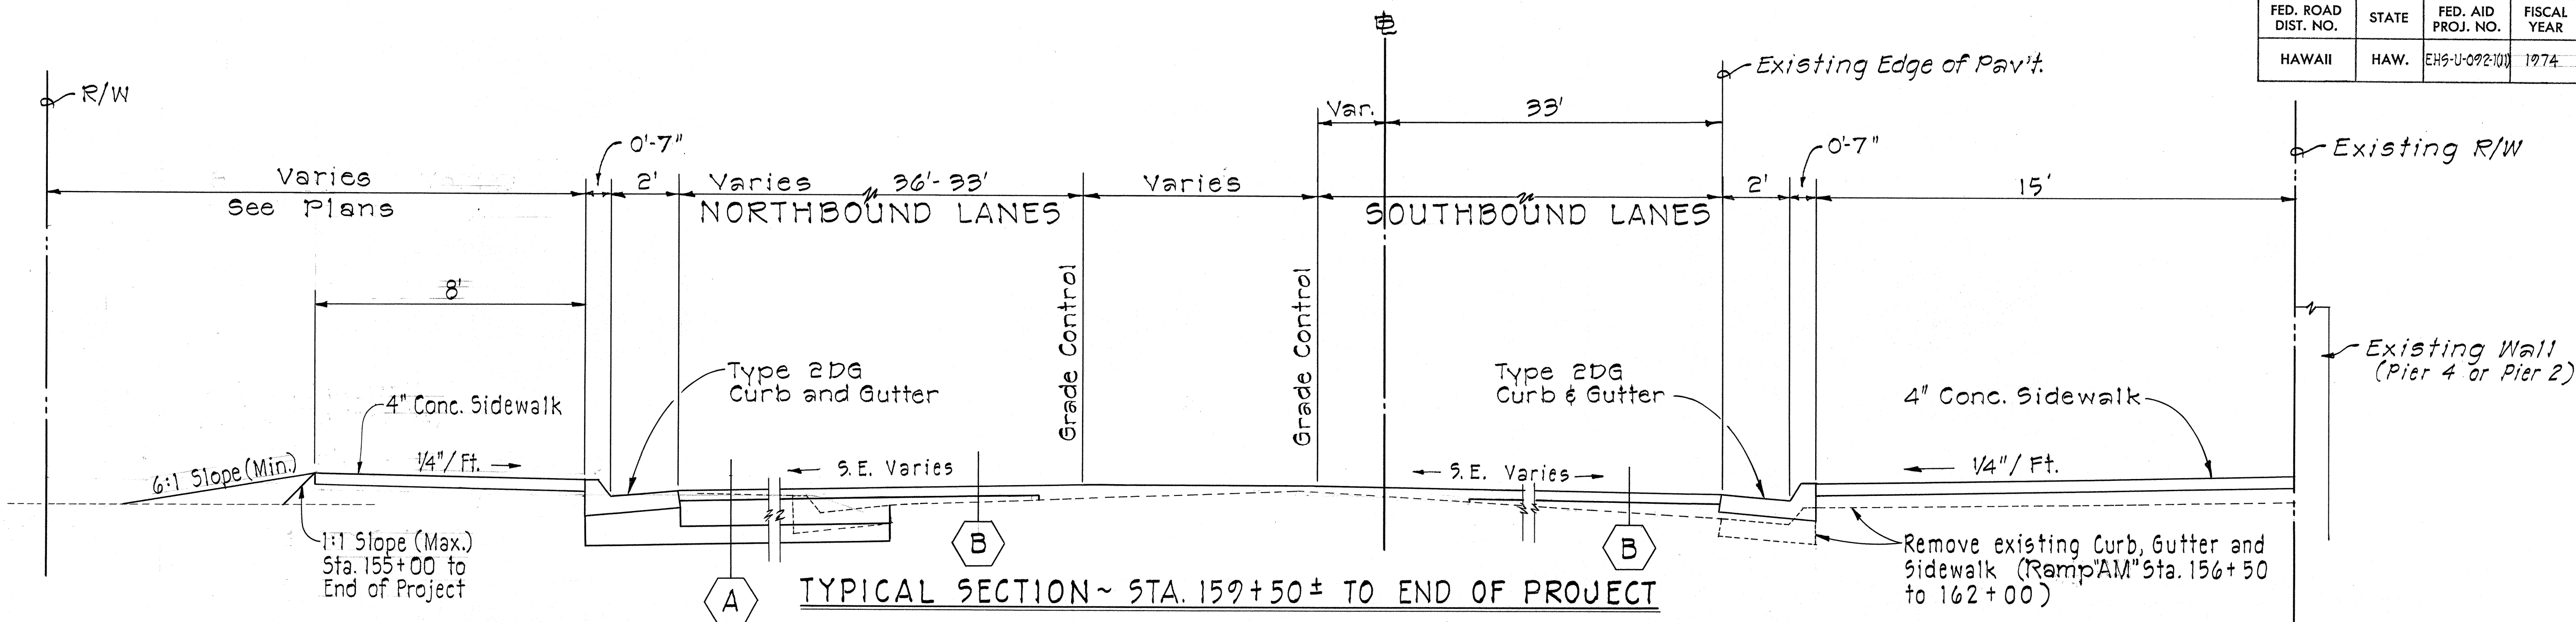


TYPICAL, SUPERELEVATED SECTION OVER EXISTING PAVEMENT
Not to Scale

NOTE: Above Detail, modified as follows, applies to portions of Ramps "H", "R" and "AM":

RAMP	1/	2/	3/	4/
"H" and "R"	3/4" to 4"	1 1/2" to 5"	2 1/2"	5"
"AM"	3/4" to 4"	1 1/2" to 4"	2 1/2"	4"

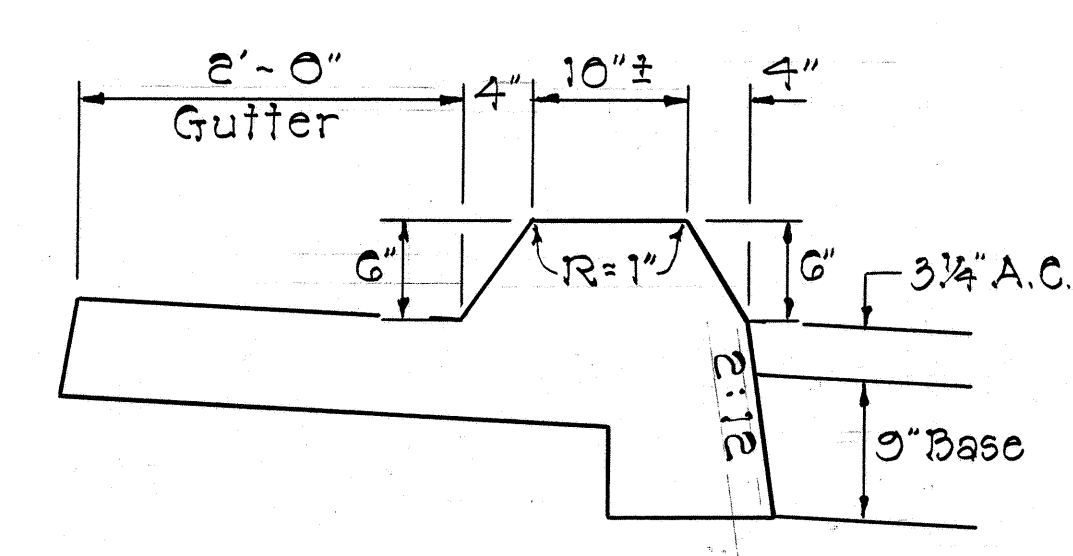


SECTION "A"
Scale: 1" = 1'-0"

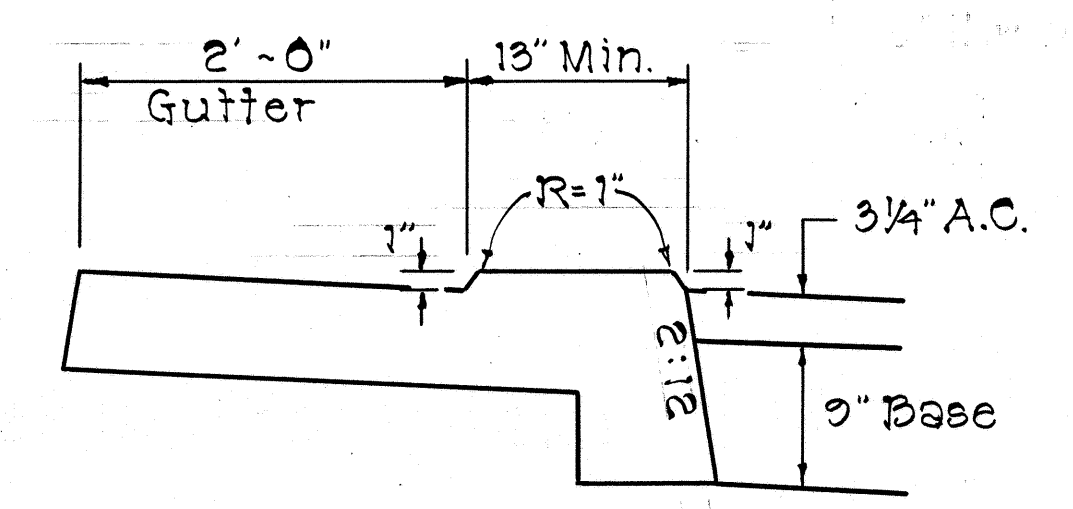

SECTION "B"

Scale: 1" = 1'-0"
RAMP DOWN CURB AT STA. 152+70.28

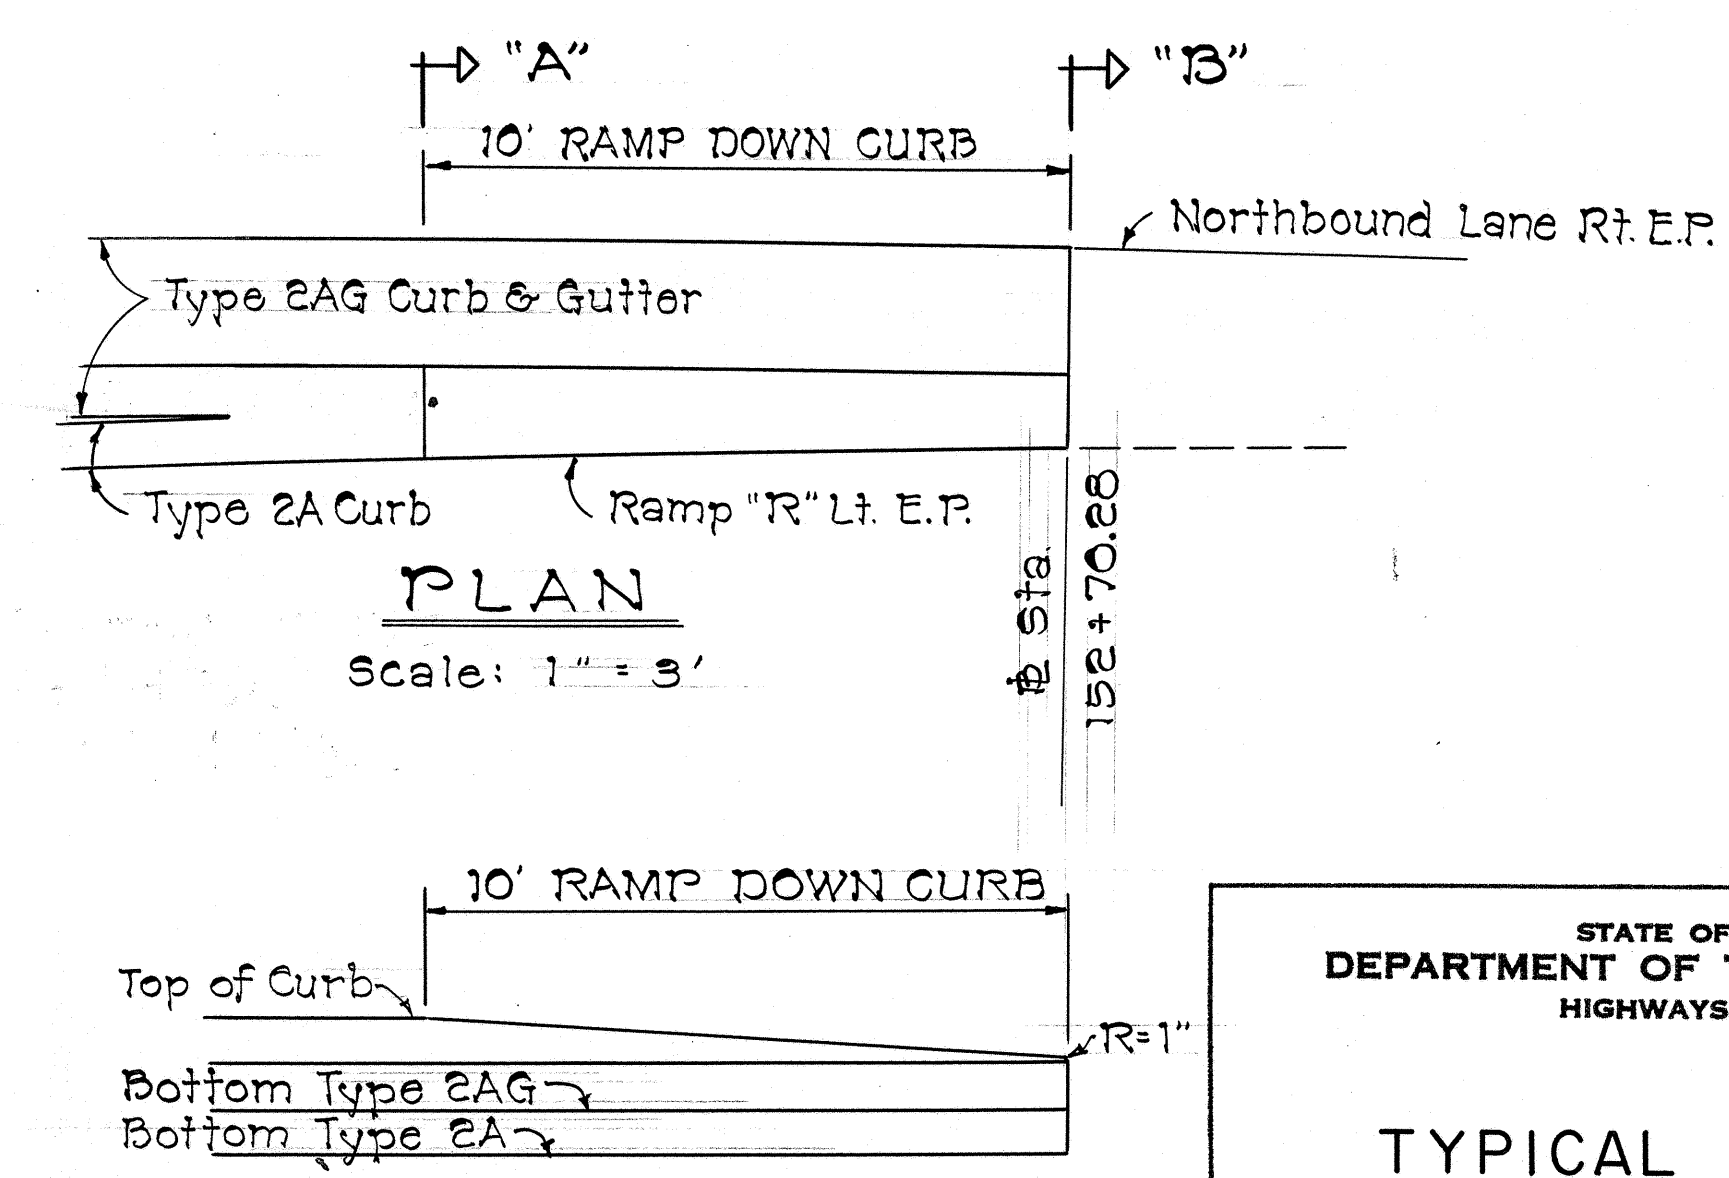

PLAN

Scale: 1" = 3'

ELEVATION

Not to Scale


STATE OF HAWAII
DEPARTMENT OF TRANSPORTATION
HIGHWAYS DIVISION

TYPICAL SECTIONS
PROJ. NO. EHS-U-092-(III)


Scale as shown

SHEET No. 2 OF 3 SHEETS


FED. ROAD DIST. NO.	STATE	FED. AID PROJ. NO.	FISCAL YEAR	SHEET NO.	TOTAL SHEETS
HAWAII	HAW.	EHS-U-092-1(1)	1974	4	141

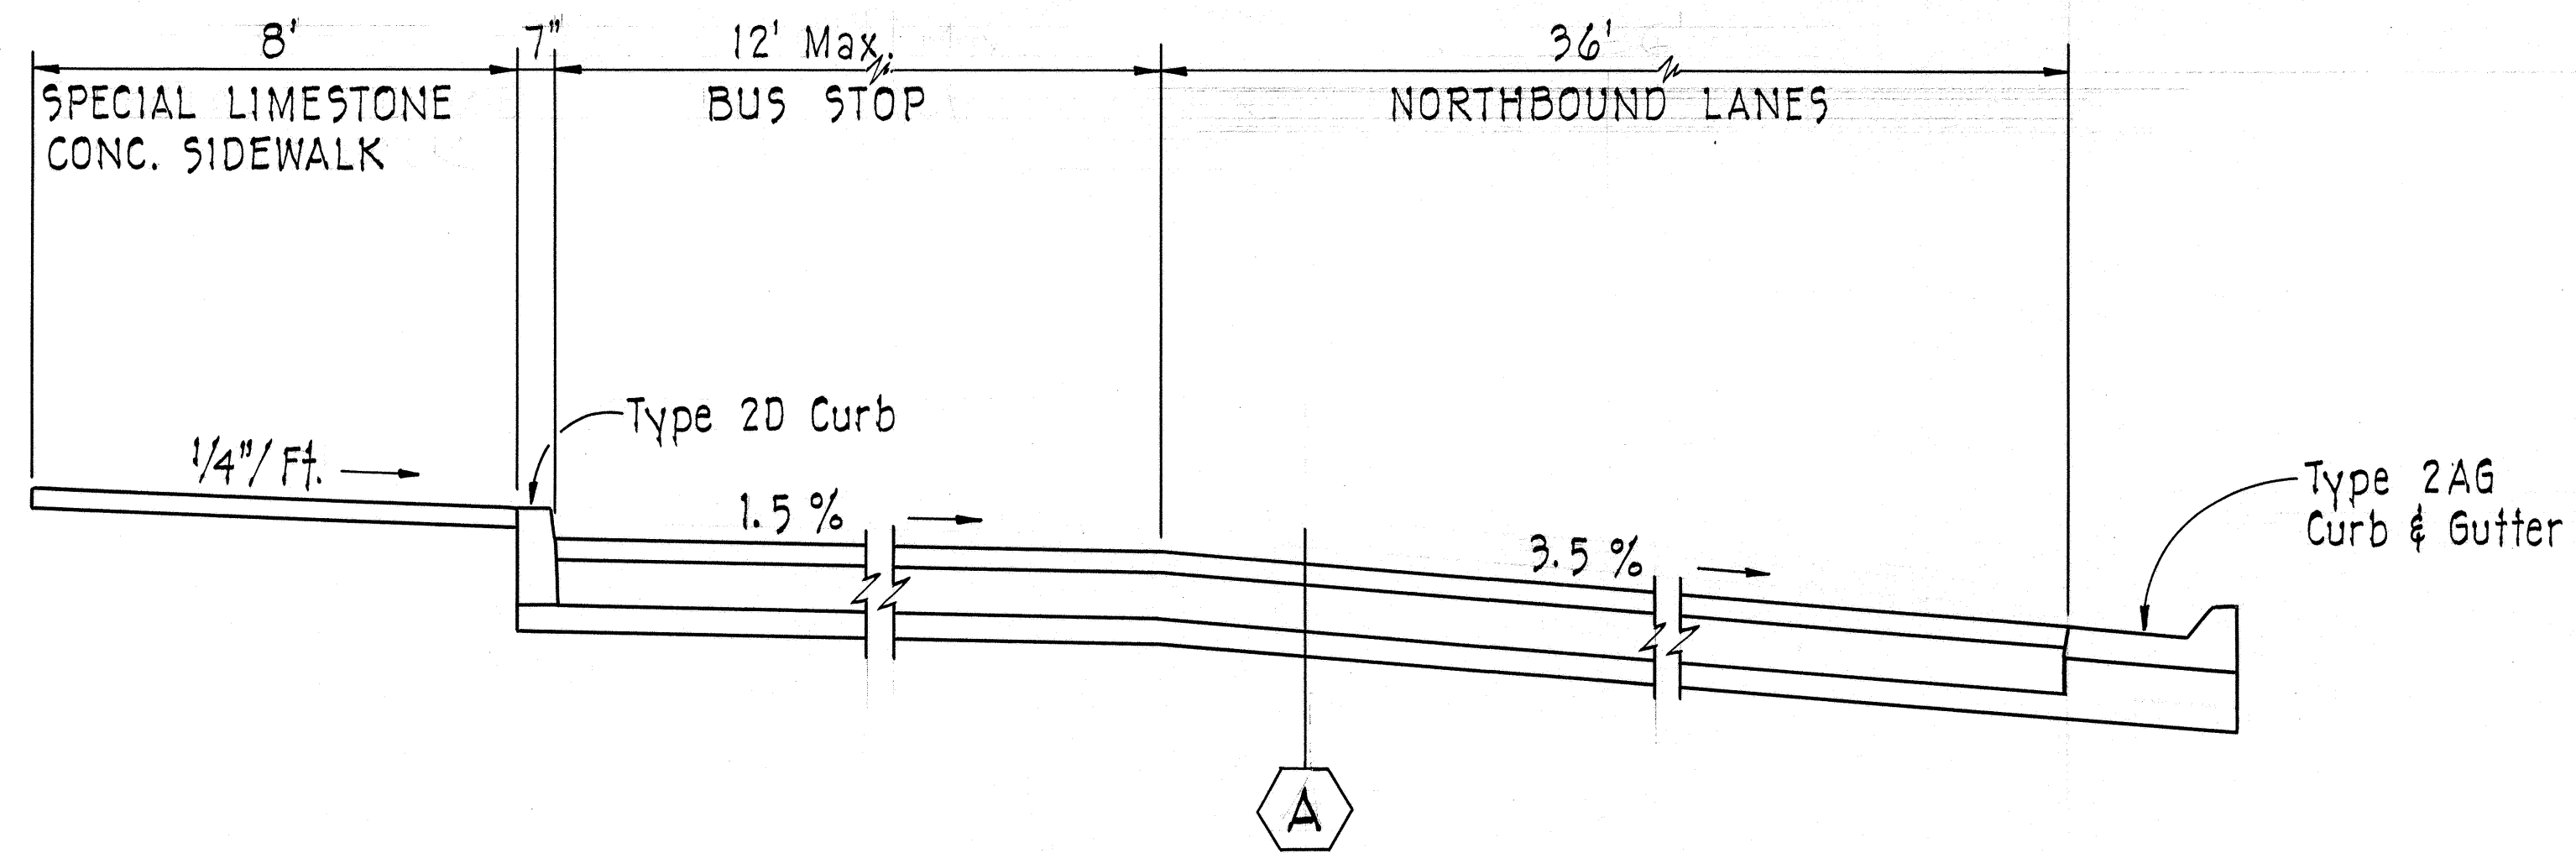

TYPICAL SECTION STA. 151± TO STA. 153+30±
Scale: 3/8"=1'-0"

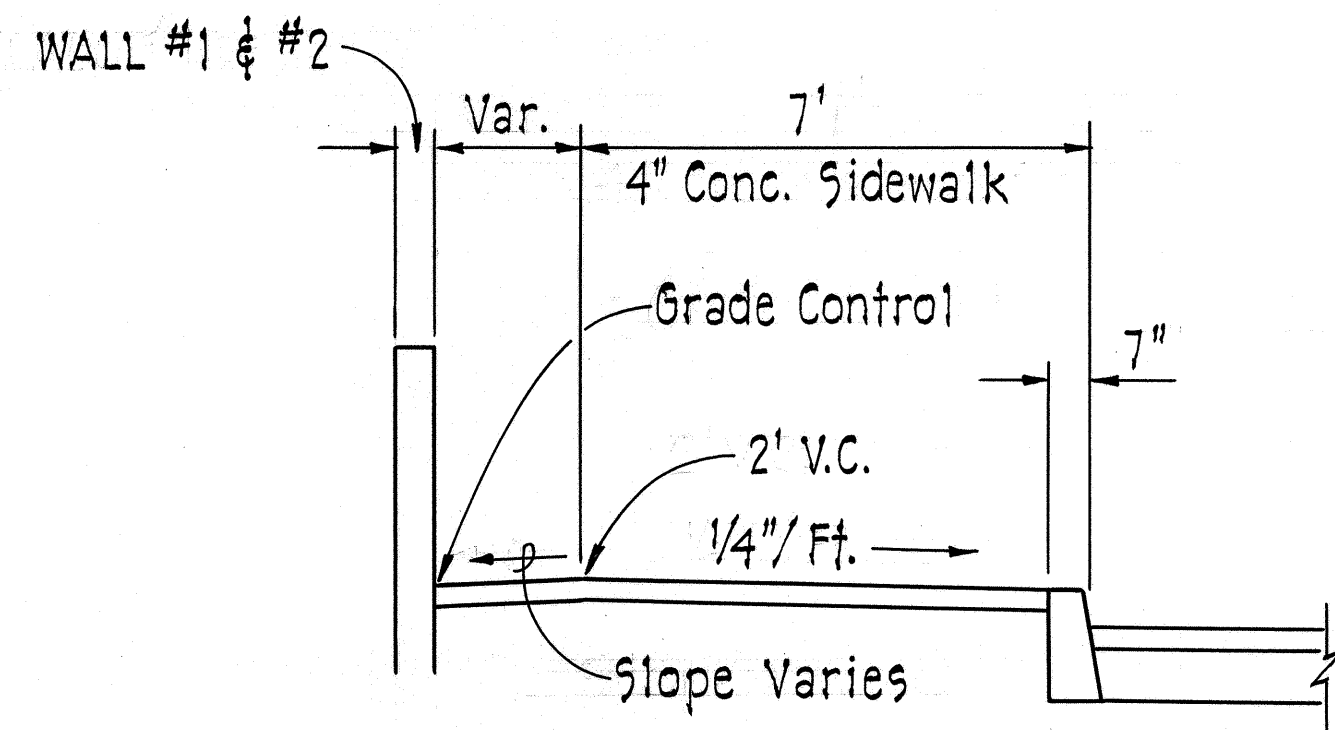

TYPICAL SECTION SIDEWALK
STA. ALAKEA 0+00 TO STA. 150+70± LT.
Scale: 3/8"=1'-0"

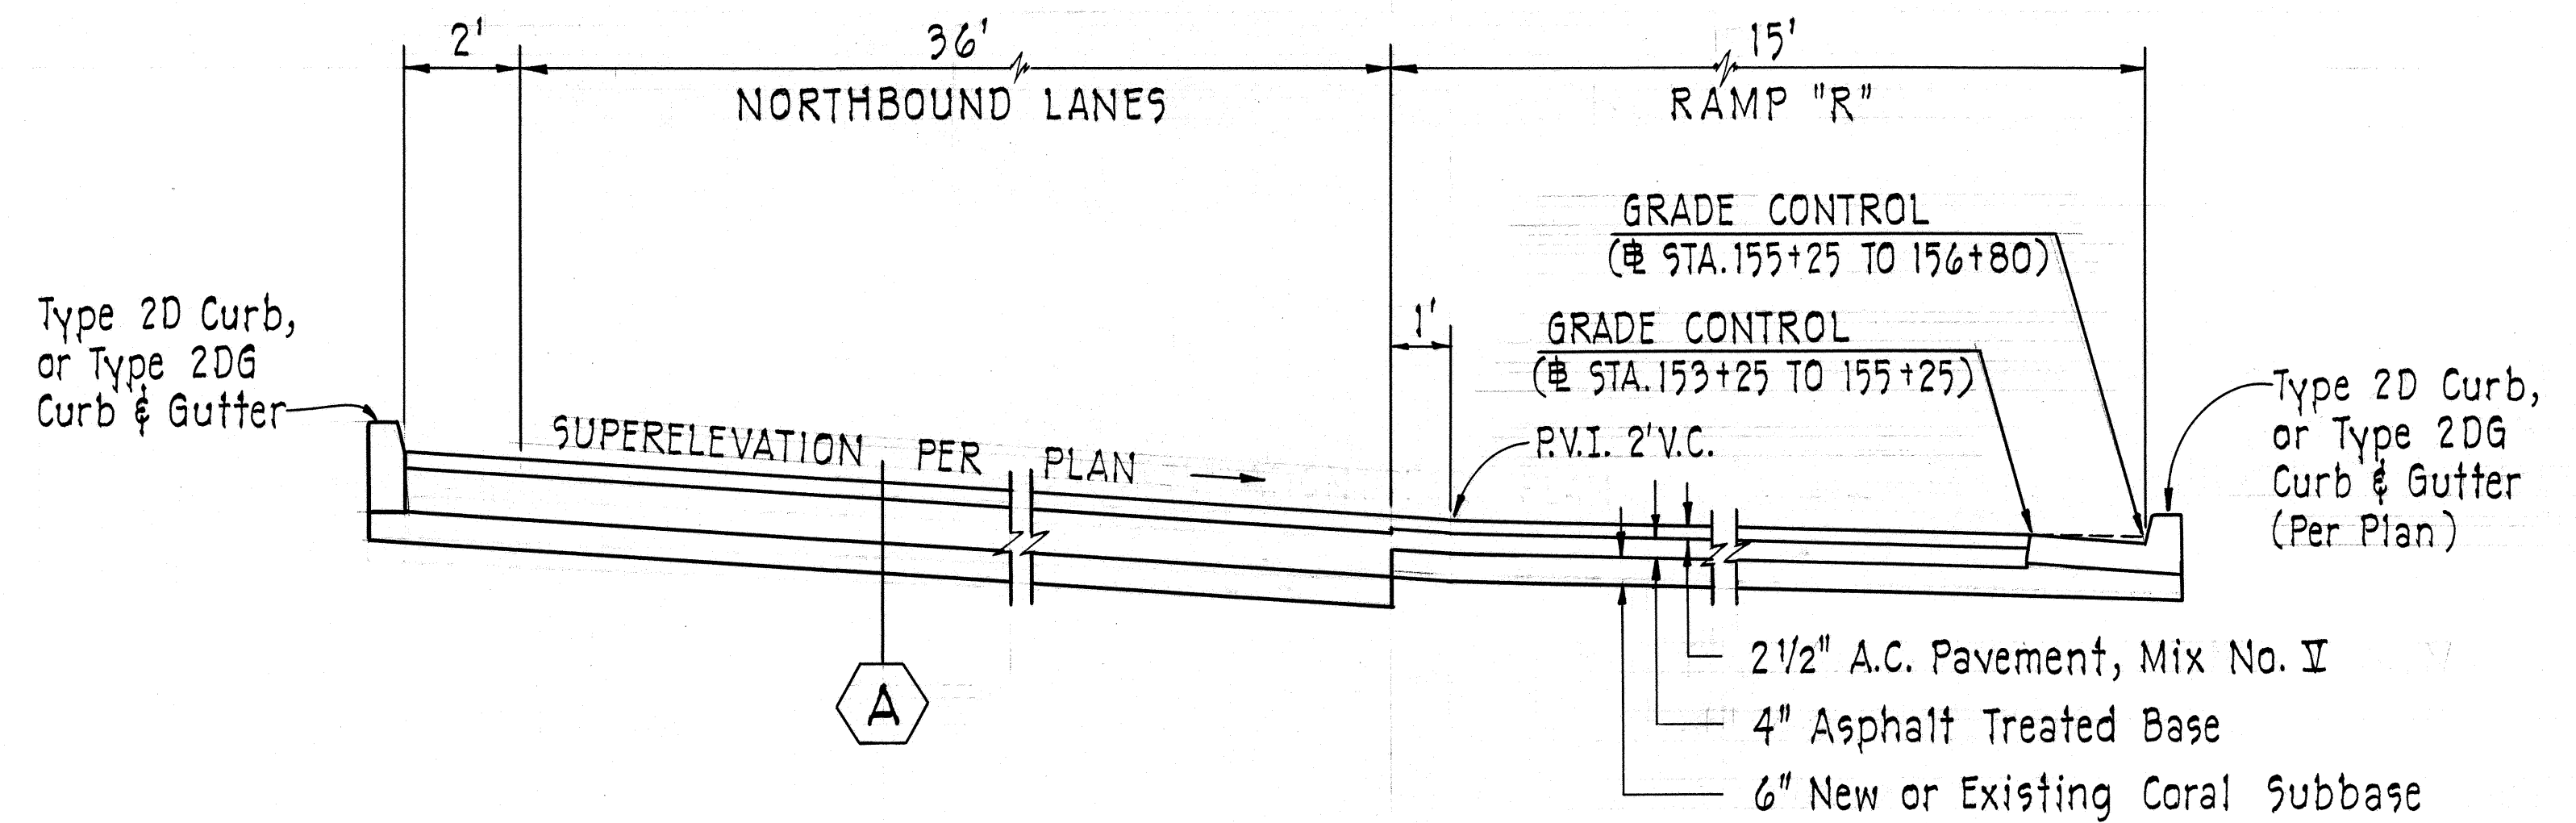

TYPICAL SECTION STA. 153+25± TO STA. 156+80±
Scale: 3/8"=1'-0"

STATE OF HAWAII
DEPARTMENT OF TRANSPORTATION
HIGHWAYS DIVISION

TYPICAL SECTIONS
PROJ. NO. EHS-U-092-1(11)

Scale as shown

SHEET No. 3 OF 3 SHEETS

DATE	_____
SURVEY PLOTTED BY	_____
DRAWN BY	_____
DESIGNED BY	_____
CHECKED BY	_____
ORIGINAL PLAN	_____
NOTE BOOK	_____
No.	_____