
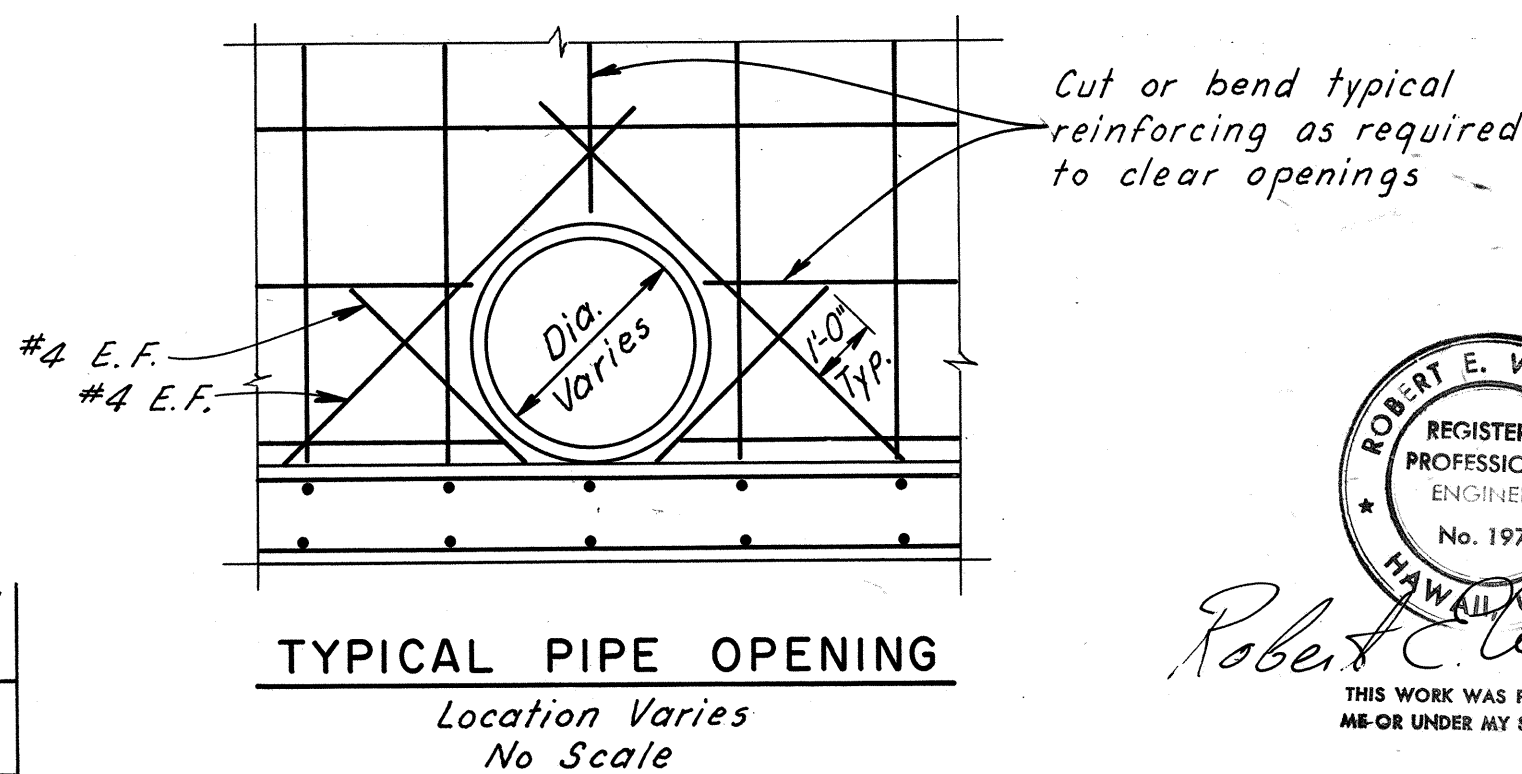
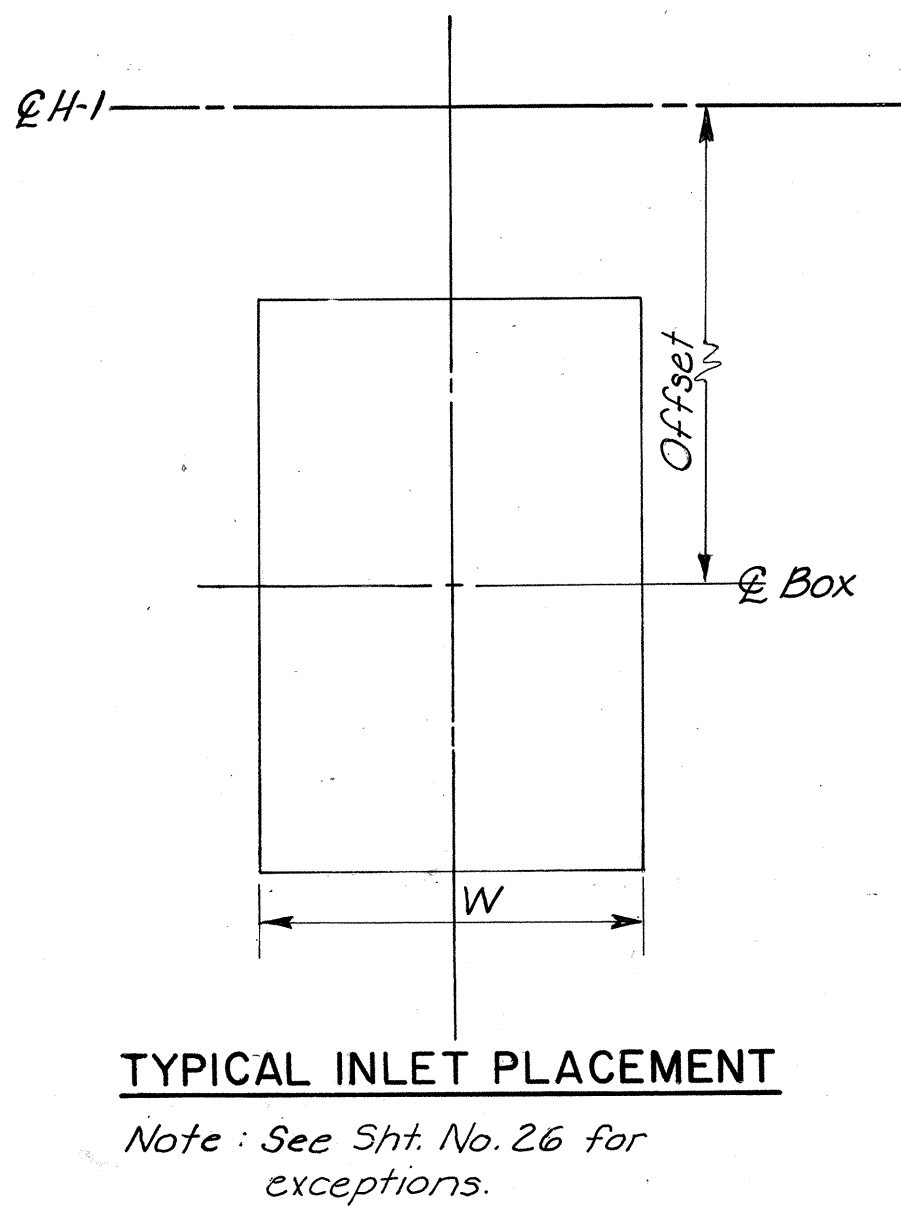
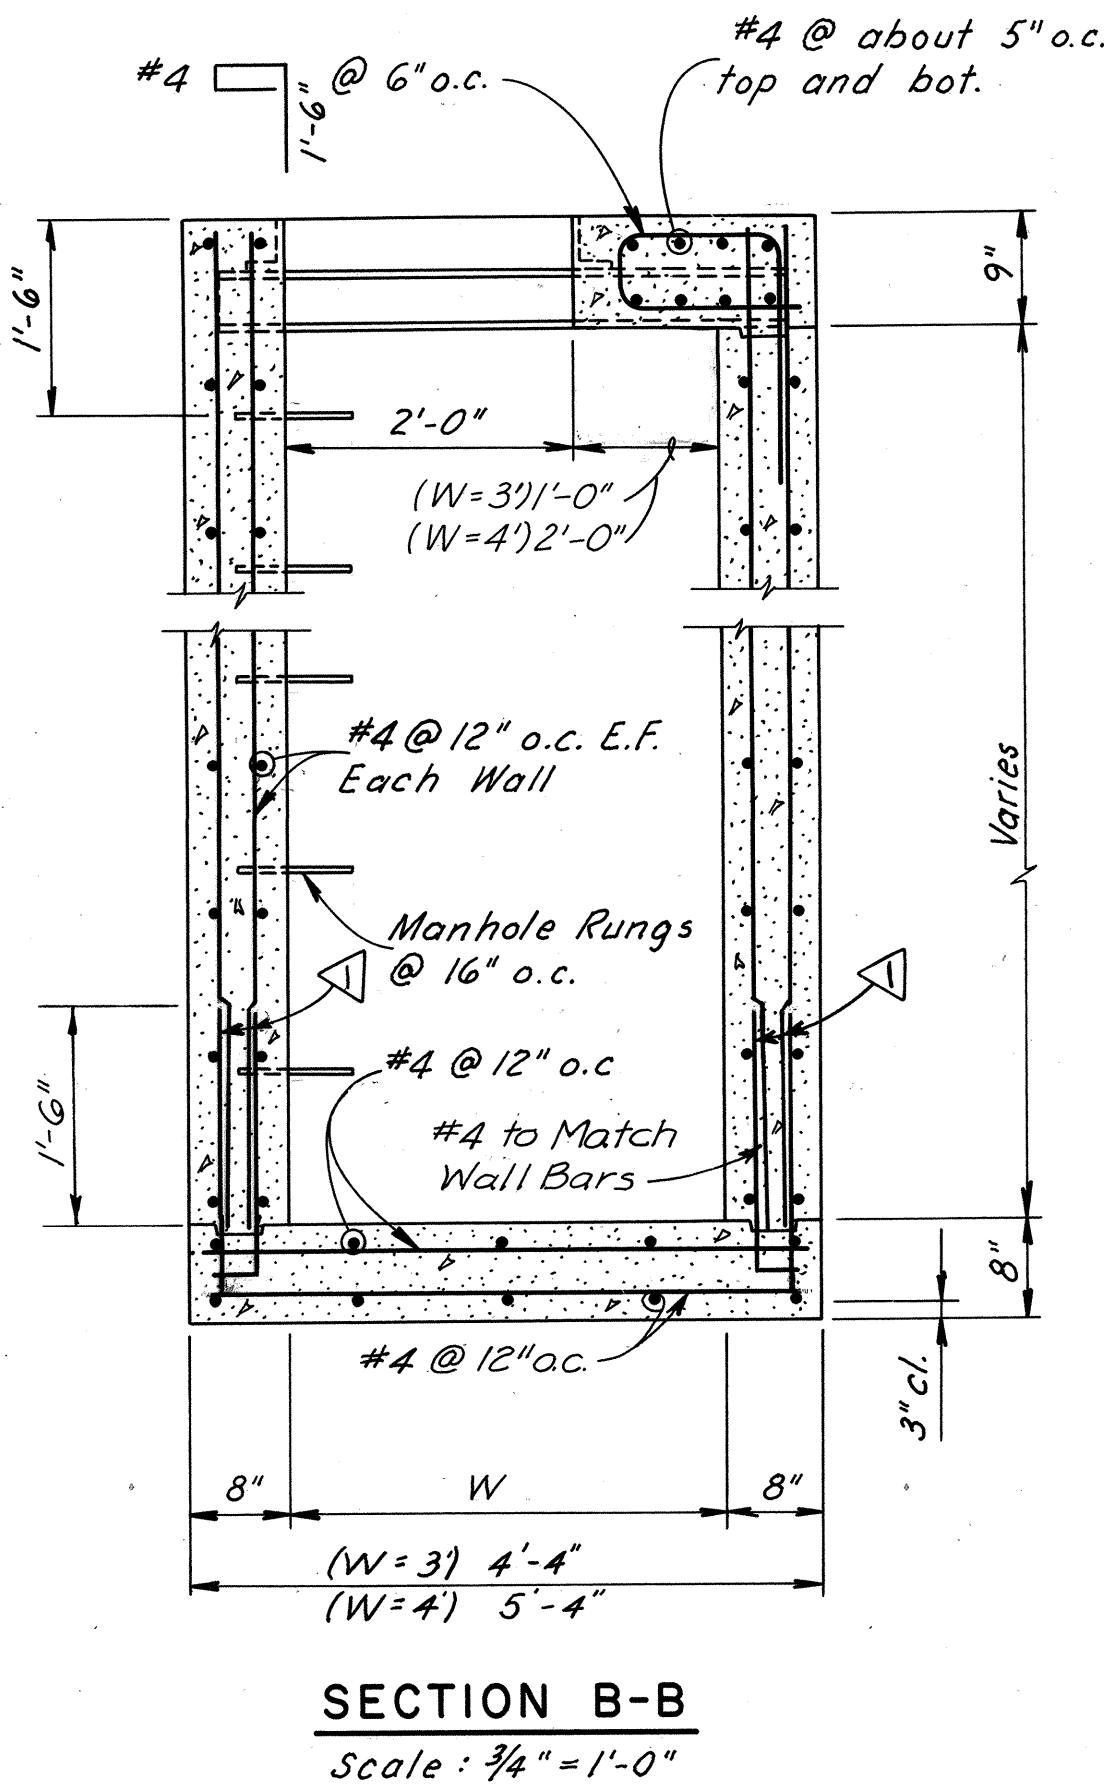
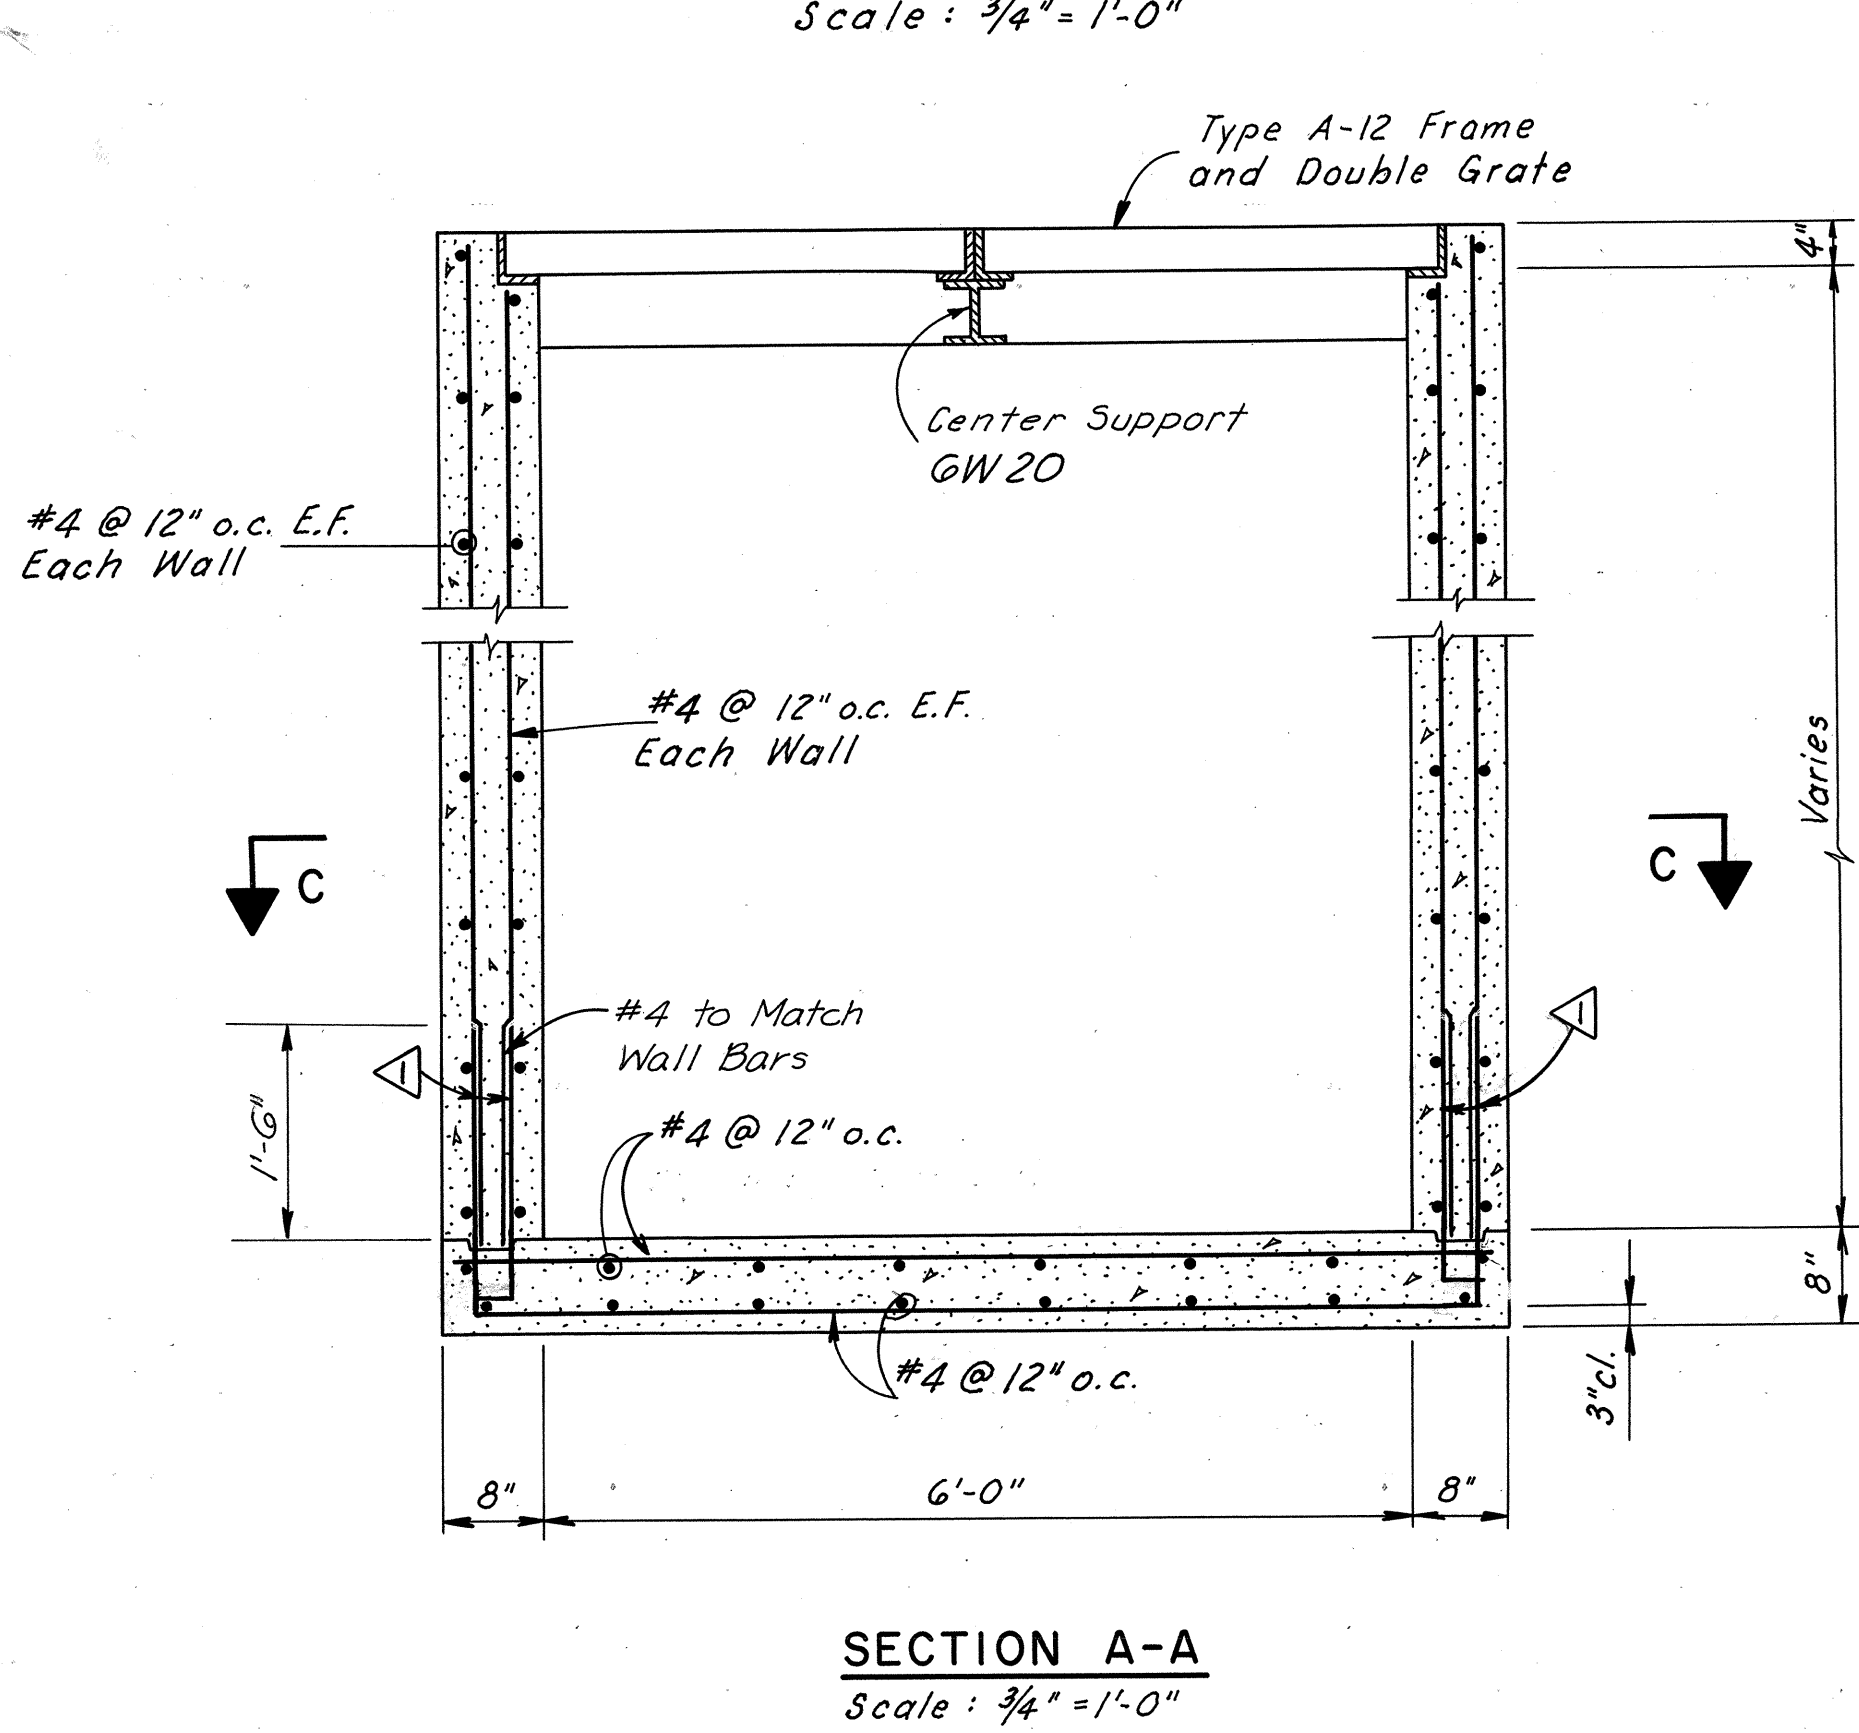


FED. ROAD DIST. NO.	STATE	FED. AID PROJ. NO.	FISCAL YEAR	SHEET NO.	TOTAL SHEETS
HAWAII	HAW.	1-HI-1(118)16	1975	23	209

NOTES

- See also, General Notes, Special Provisions and Specifications.
- All concrete shall be Class A Reinforced Concrete Design Data:
 - fc 3000 psi (28 Days)
 - fs 24,000 psi Deformed Bars

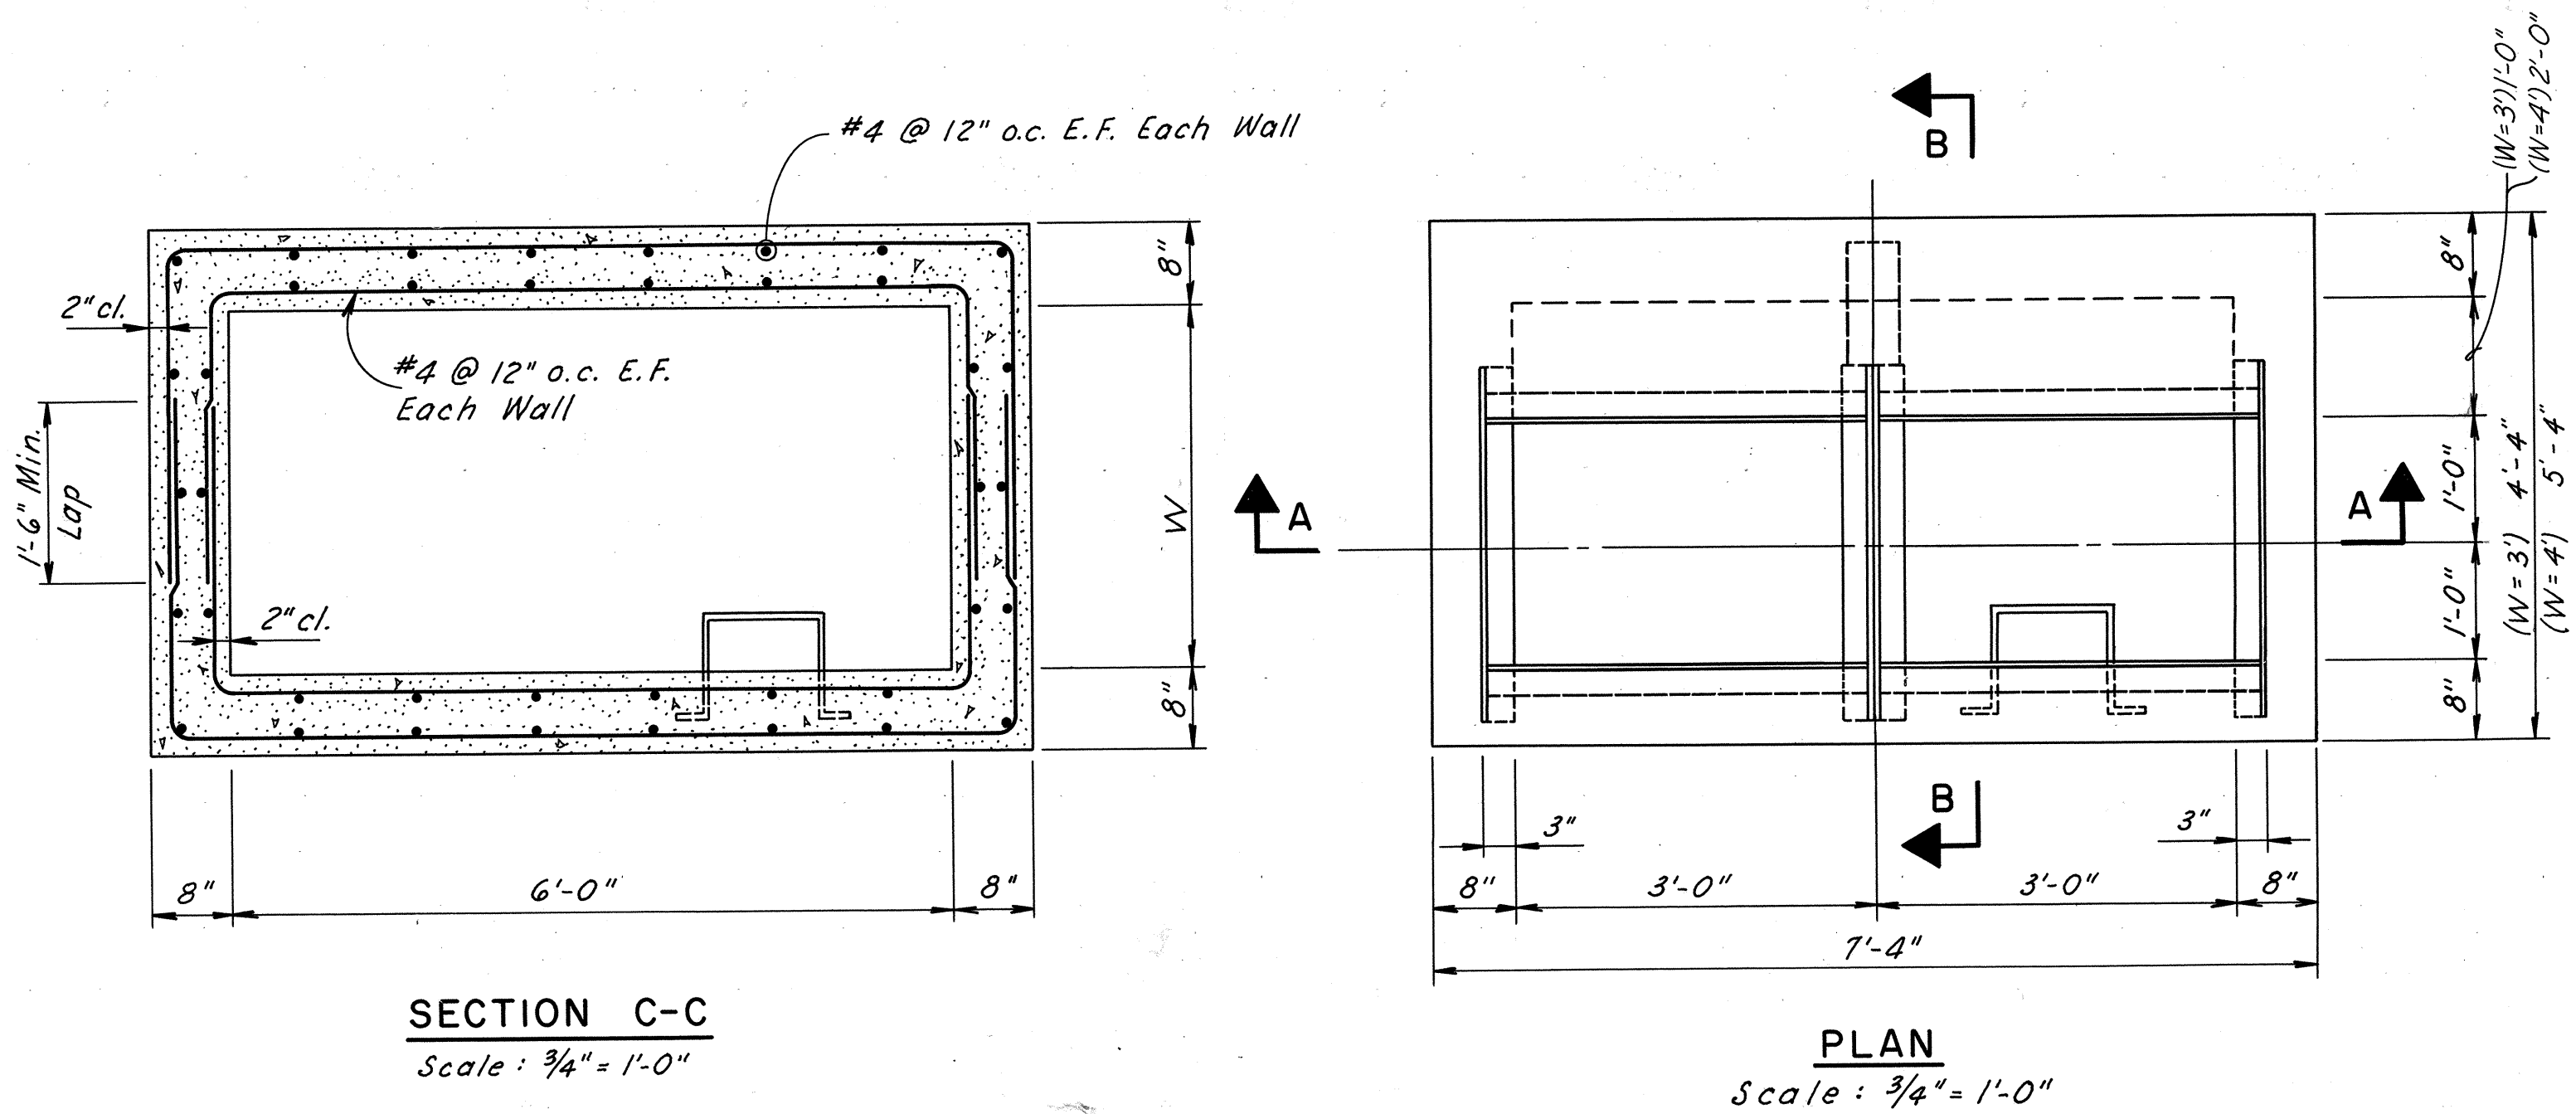

1-30-75	Typical Inlet Placement Added
1-30-75	Reinforcing Bars Added
Date	Revisions

ROBERT E. WHISEN
REGISTERED PROFESSIONAL ENGINEER
No. 1976
HAWAII, U.S.A.
THIS WORK WAS PREPARED BY ME OR UNDER MY SUPERVISION.

STATE OF HAWAII
DEPARTMENT OF TRANSPORTATION
HIGHWAYS DIVISION

DOUBLE GRATE INLET

AIRPORT INTERCHANGE
F.A.I. PROJ NO I-HI-1(118)16
SCALE: 1"=20'
SHEET No. 12 OF 16 SHEETS

DATE: JUNE 15, 1974

ORIGINAL PLAN	DATE
DESIGNED BY	
NOTED BY	
CHECKED BY	