

[illegible]

FED. ROAD DIST. NO.	STATE	FED. AID PROJ. NO.	FISCAL YEAR	SHEET NO.	TOTAL SHEETS
HAWAII	HAW.	I-H-118)16	1975	1	209



STATE OF HAWAII

DEPARTMENT OF TRANSPORTATION

HIGHWAYS DIVISION

HONOLULU, HAWAII


"AS BUILT" PLANS FOR
CONSTRUCTION OF A PORTION OF

INTERSTATE ROUTE H-1

AIRPORT INTERCHANGE

FEDERAL AID INTERSTATE PROJECT I-HI-1(118):16

DISTRICT OF HONOLULU
ISLAND OF OAHU

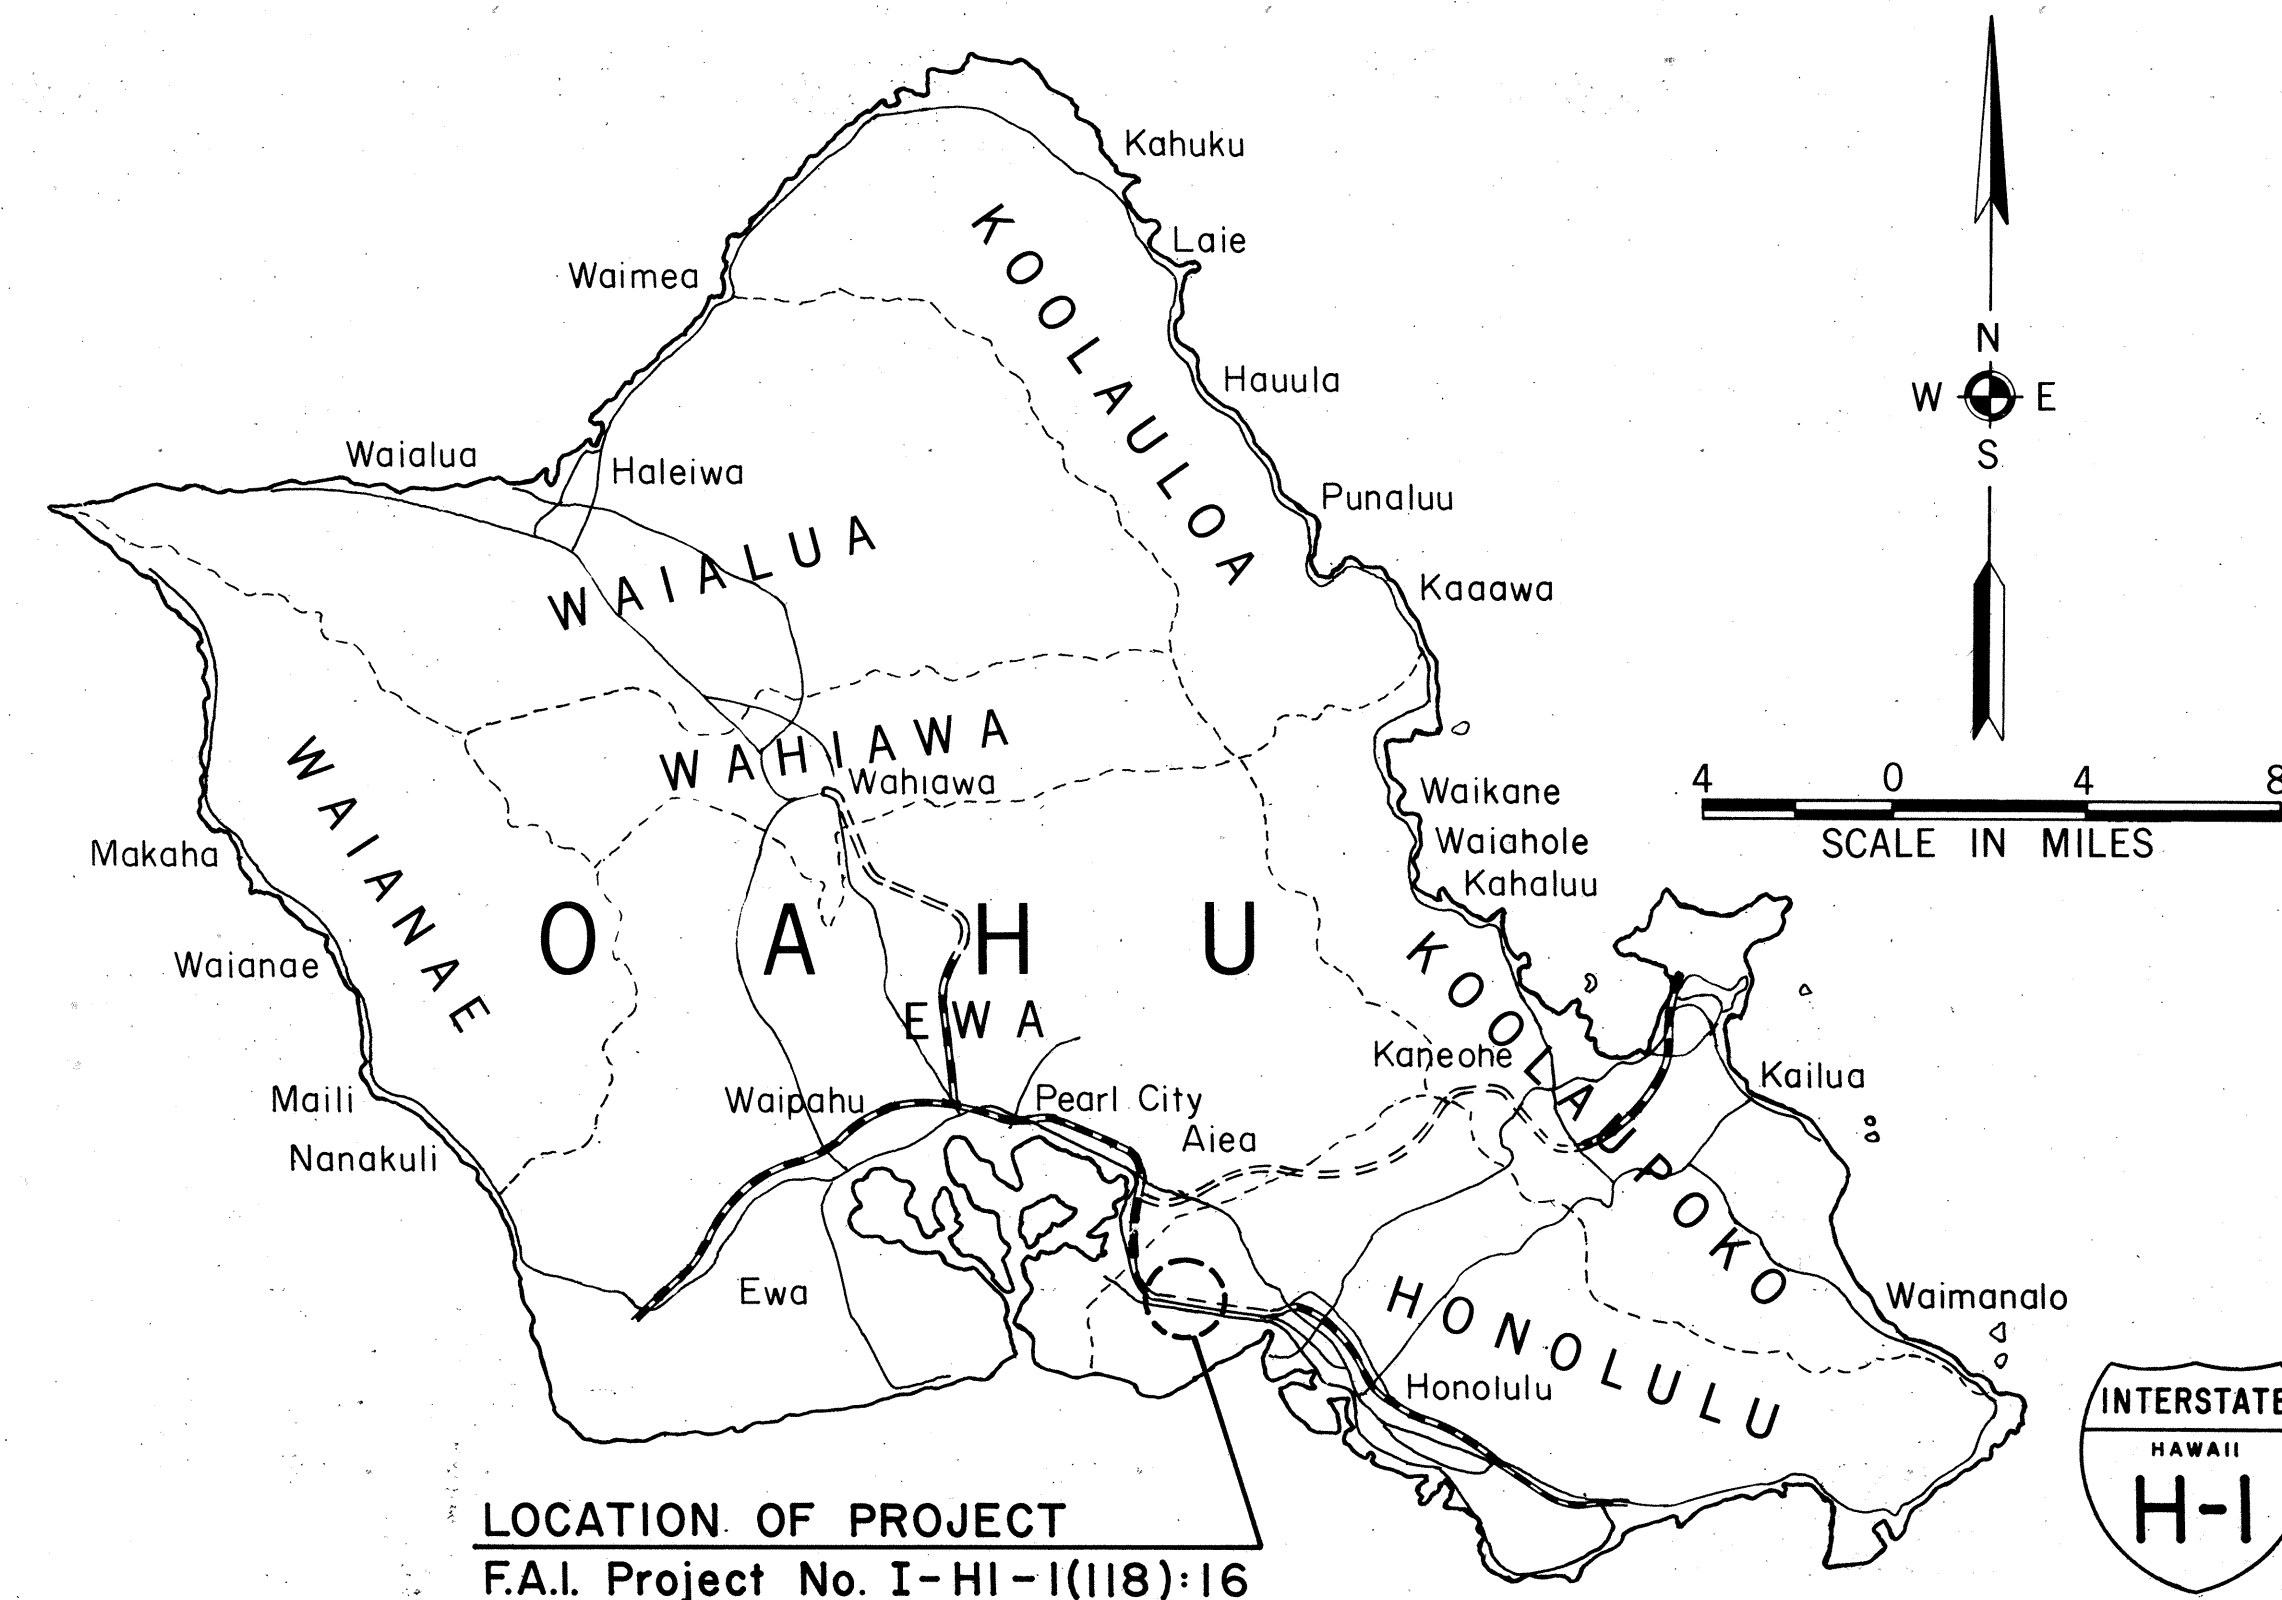

Federal Aid Interstate Projects Previously Constructed or Under Construction

DESIGN CLASSIFICATION

SCALES:


DESIGN ADT (1994).....	102,675
DHV	11 %
D.....	60/40
T.....	5 %
V.....	60 MPH

PLANS	HOR.	1" = 50'
PROFILES	HOR.	1" = 50'
	VER.	1" = 10'
DETAIL ROADWAY PLANS	HOR.	1" = 20'
CROSS SECTIONS	HOR.	1" = 10'
	VER.	1" = 5'

ALL CHANGES MADE DURING CONSTRUCTION
HAVE BEEN INCORPORATED ON THESE PLANS
EXCEPT CHANGES IN THE ORIGINAL THEORETICAL
QUANTITIES.


VICTOR NAKAMURA
RESIDENT ENGINEER


8/29/17
DATE

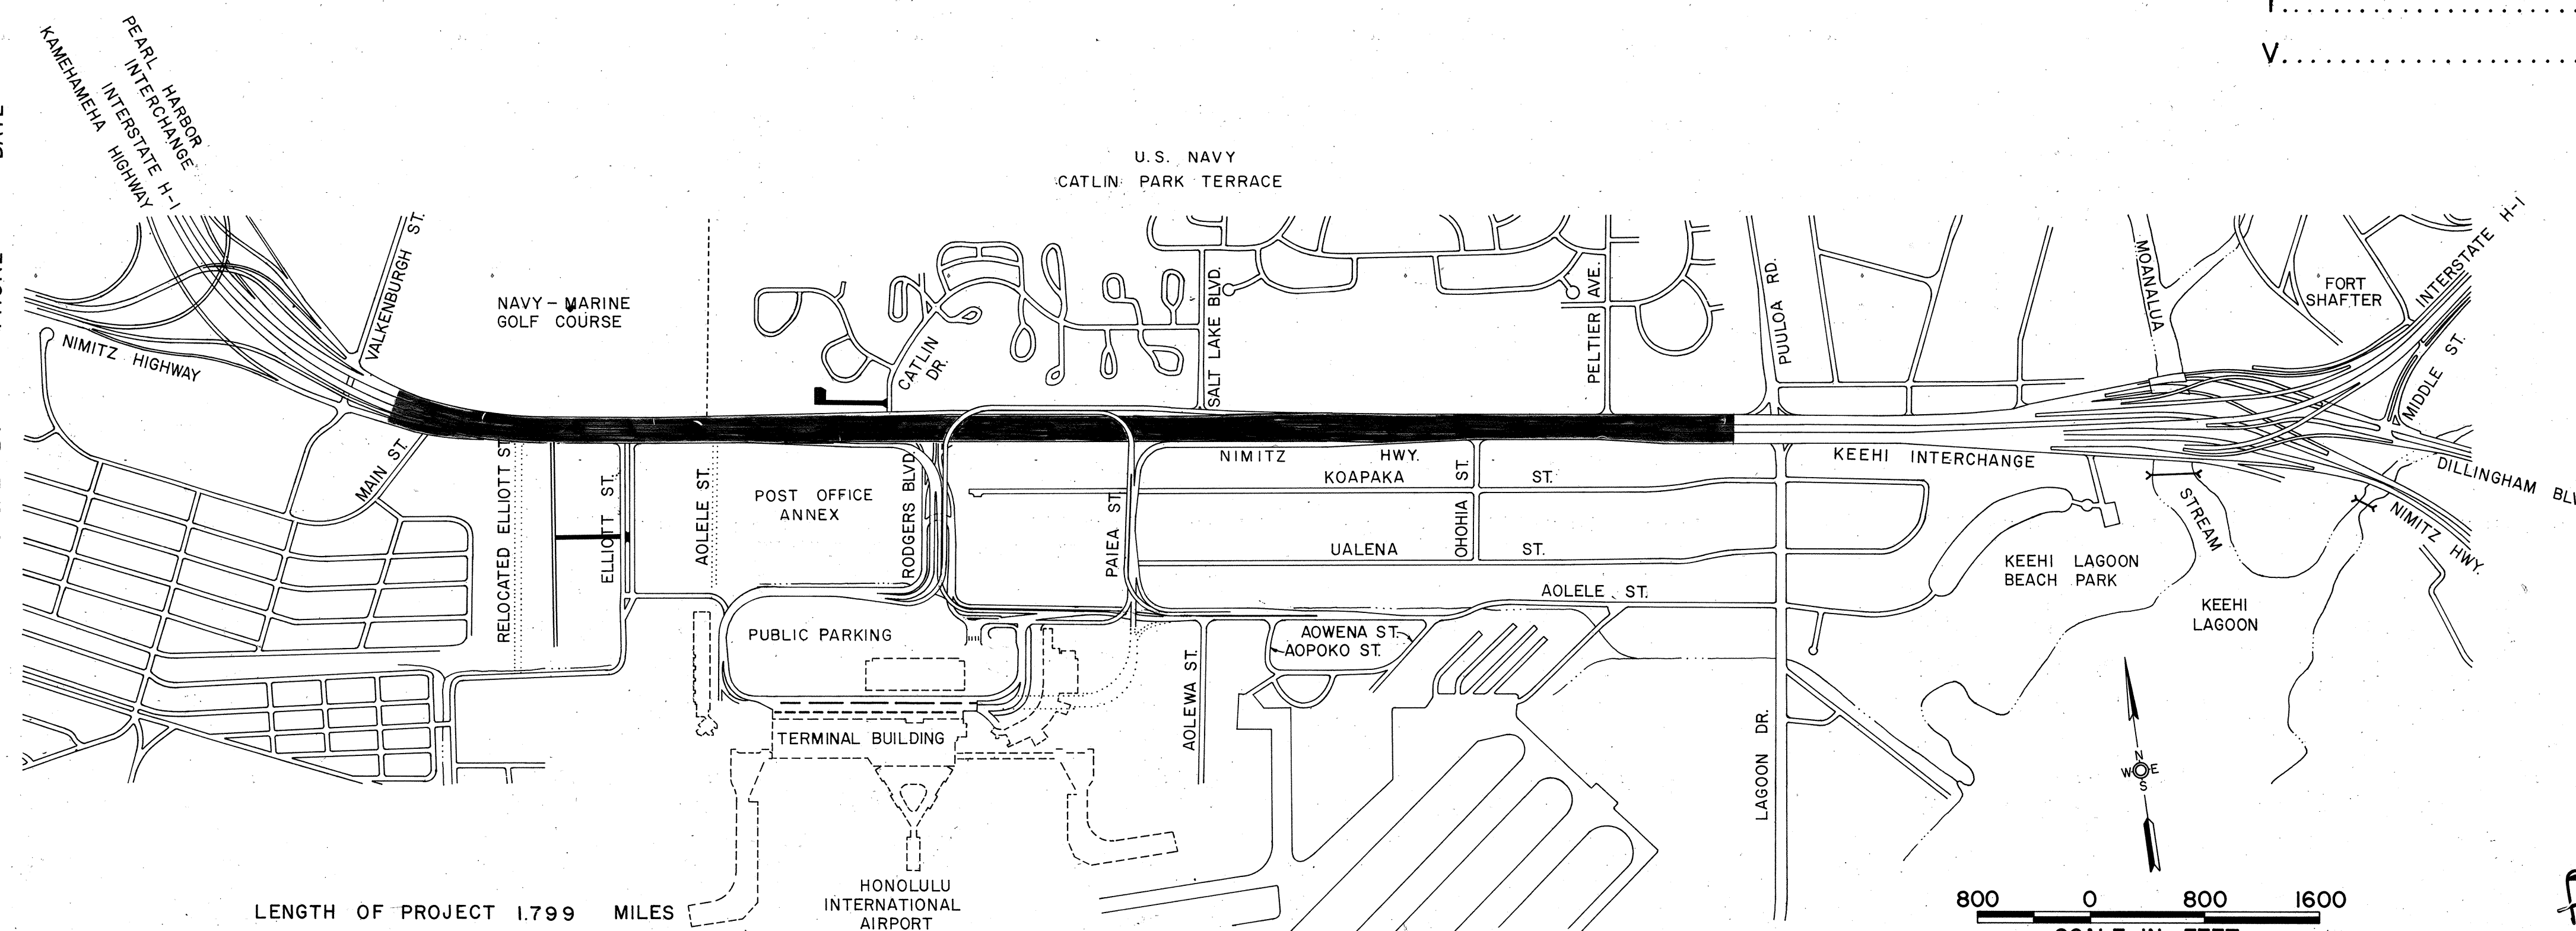

LENGTH OF PROJECT 1799 MILES

800 0 800 1600

SCALE IN FEET

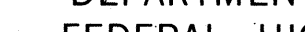DEPARTMENT OF TRANSPORTATION FEDERAL HIGHWAY ADMINISTRATION	
APPROVED:	
	12.20.7
DIVISION ENGINEER	DATE

DEPARTMENT OF TRANSPORTATION STATE OF HAWAII	
APPROVED: E. Alvey Wright DIR. OF TRANSPORTATION	12/13/71 DATE

URS/The Ken R. White Co. Ben Tanaka
DESIGNED BY P. S. & E. BY
521-3051 PHONE 12/11/74 DATE