

[illegible]

STATE OF HAWAII





DEPARTMENT OF TRANSPORTATION
HIGHWAYS DIVISION

HONOLULU, HAWAII

PLANS OF
NIMITZ HIGHWAY BRIDGE REPAIR,
SLIP COVER AT SUMNER STREET

Proj. No. 92A-01-75M
(DISTRICT OF HONOLULU)
ISLAND OF OAHU

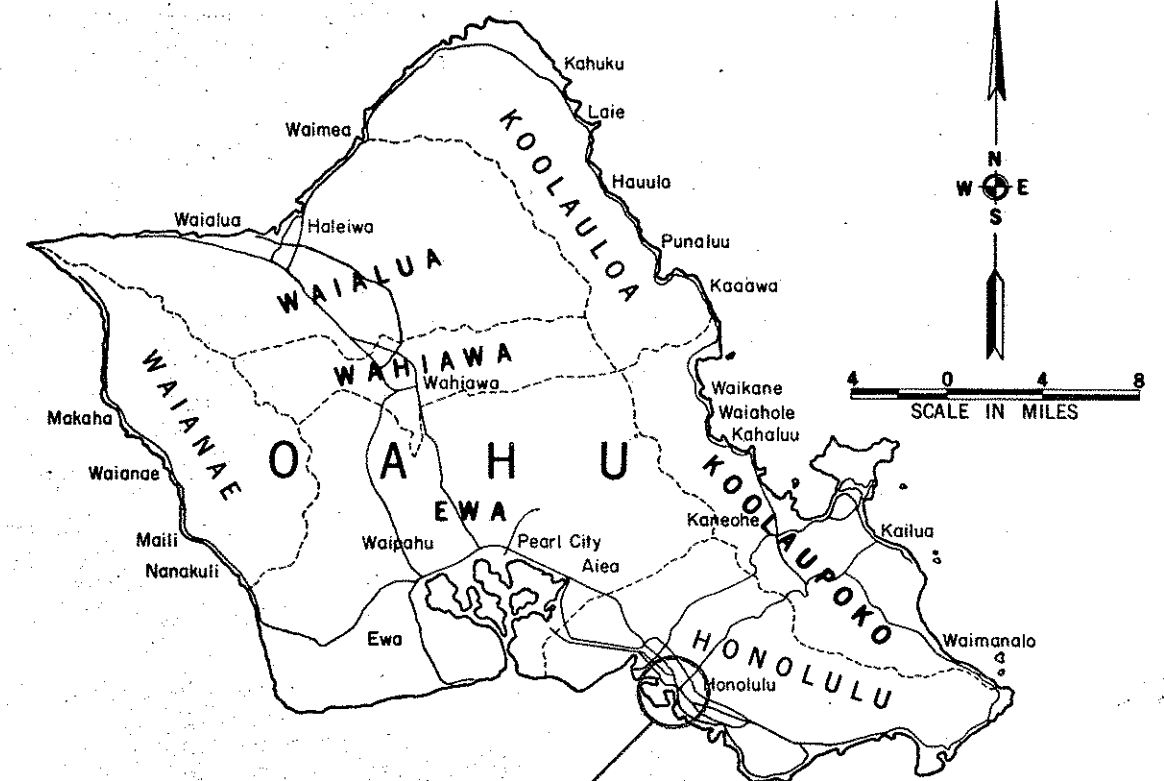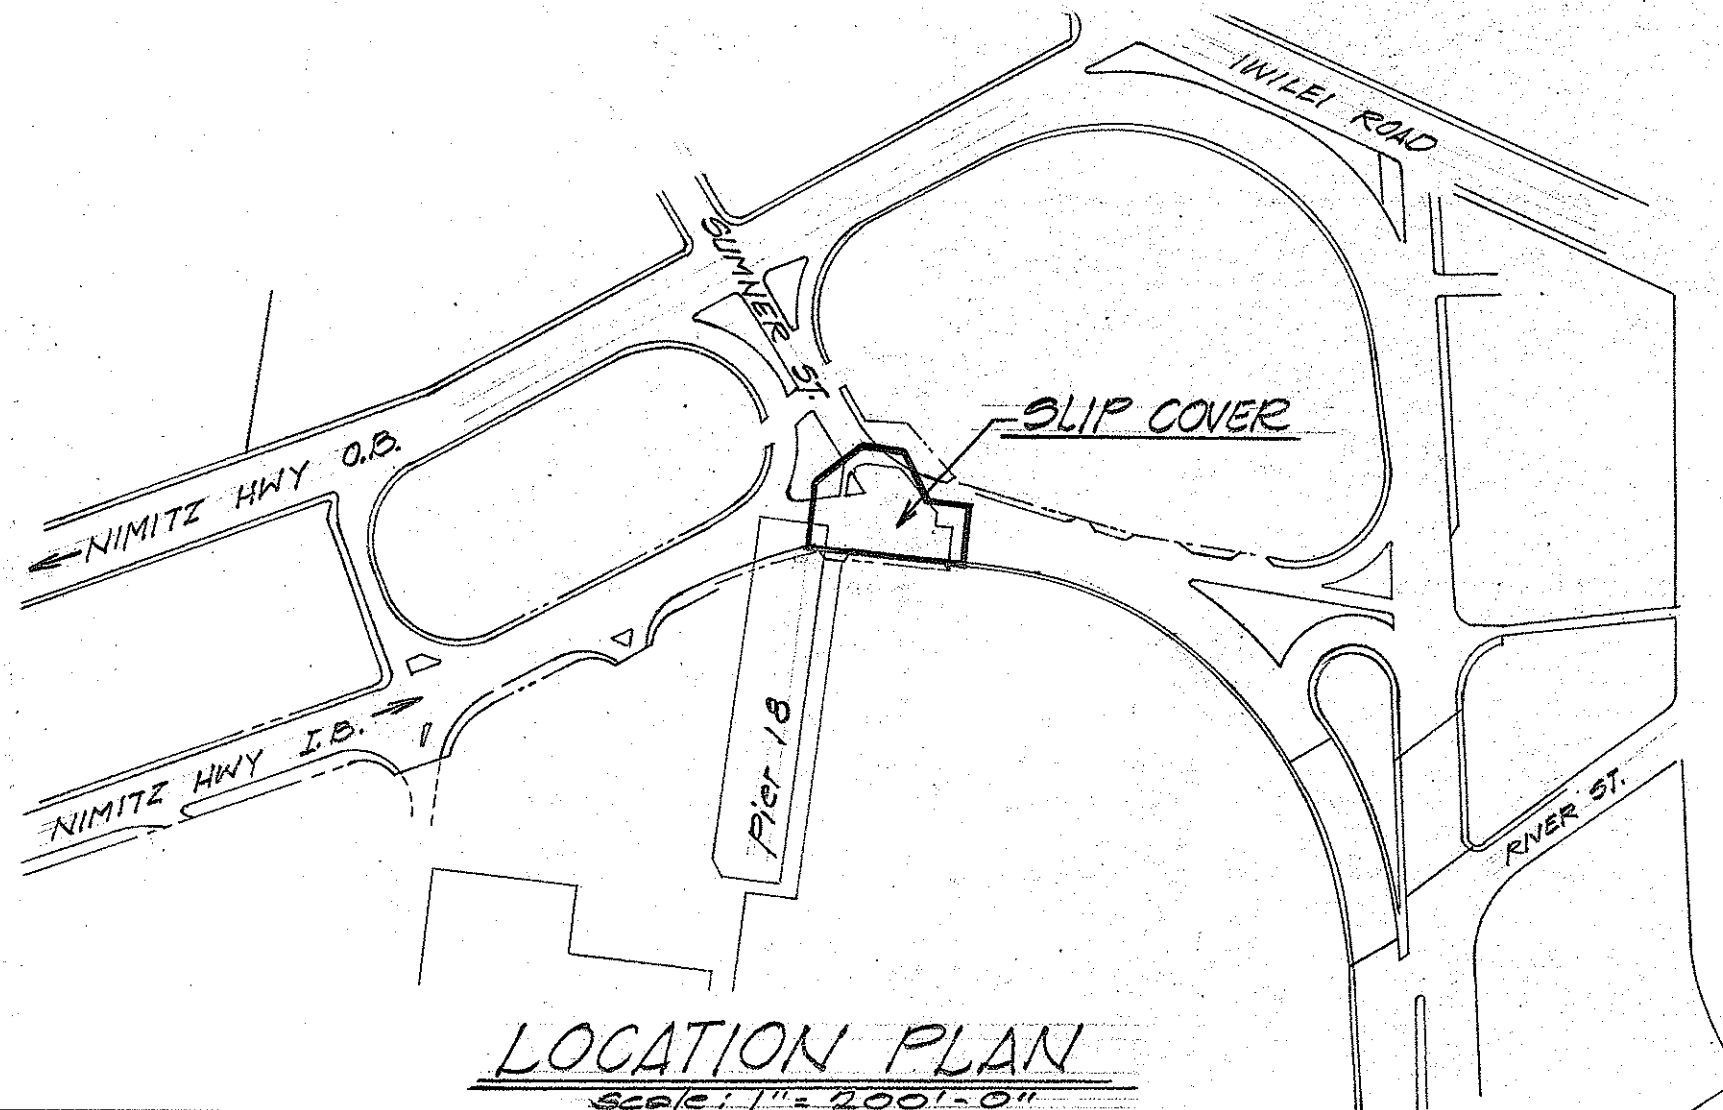

FED. ROAD DIST. NO.	STATE	PROJ. NO.	FISCAL YEAR	SHEET NO.	TOTAL SHEETS
HAWAII	HAW.	92A-01-75M	1975	1	3

PS&E BY D. BEVIER DEC. 1974

DEPARTMENT OF TRANSPORTATION
STATE OF HAWAII

APPROVED:
G. Alway, Director 12/30/74

DIRECTOR OF TRANSPORTATION DATE