
INDEX TO DRAWINGS	
SHEET NO.	DESCRIPTION
	TITLE SHEET
2	GENERAL NOTES AND MISCELLANEOUS DETAILS
3-5	ROADWAY PLANS & DETAILS
6-9	PAVEMENT MARKINGS, STRIP ING, MISC. & ST'D. DETAILS



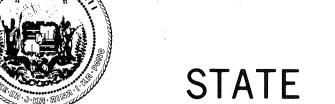

STATE OF HAWAII

DEPARTMENT OF TRANSPORTATION HIGHWAYS DIVISION


> HONOLULU, HAWAII "AS - BUILT" PLANS FOR


RESURFACING OF A PORTION OF NIMITZ HIGHWAY

MOKAUEA STREET TOWARDS PACIFIC STREET (OUTBOUND LANES)

PROJECT NO. 92A-01-76M

DISTRICT OF HONOLULU ISLAND OF OAHU

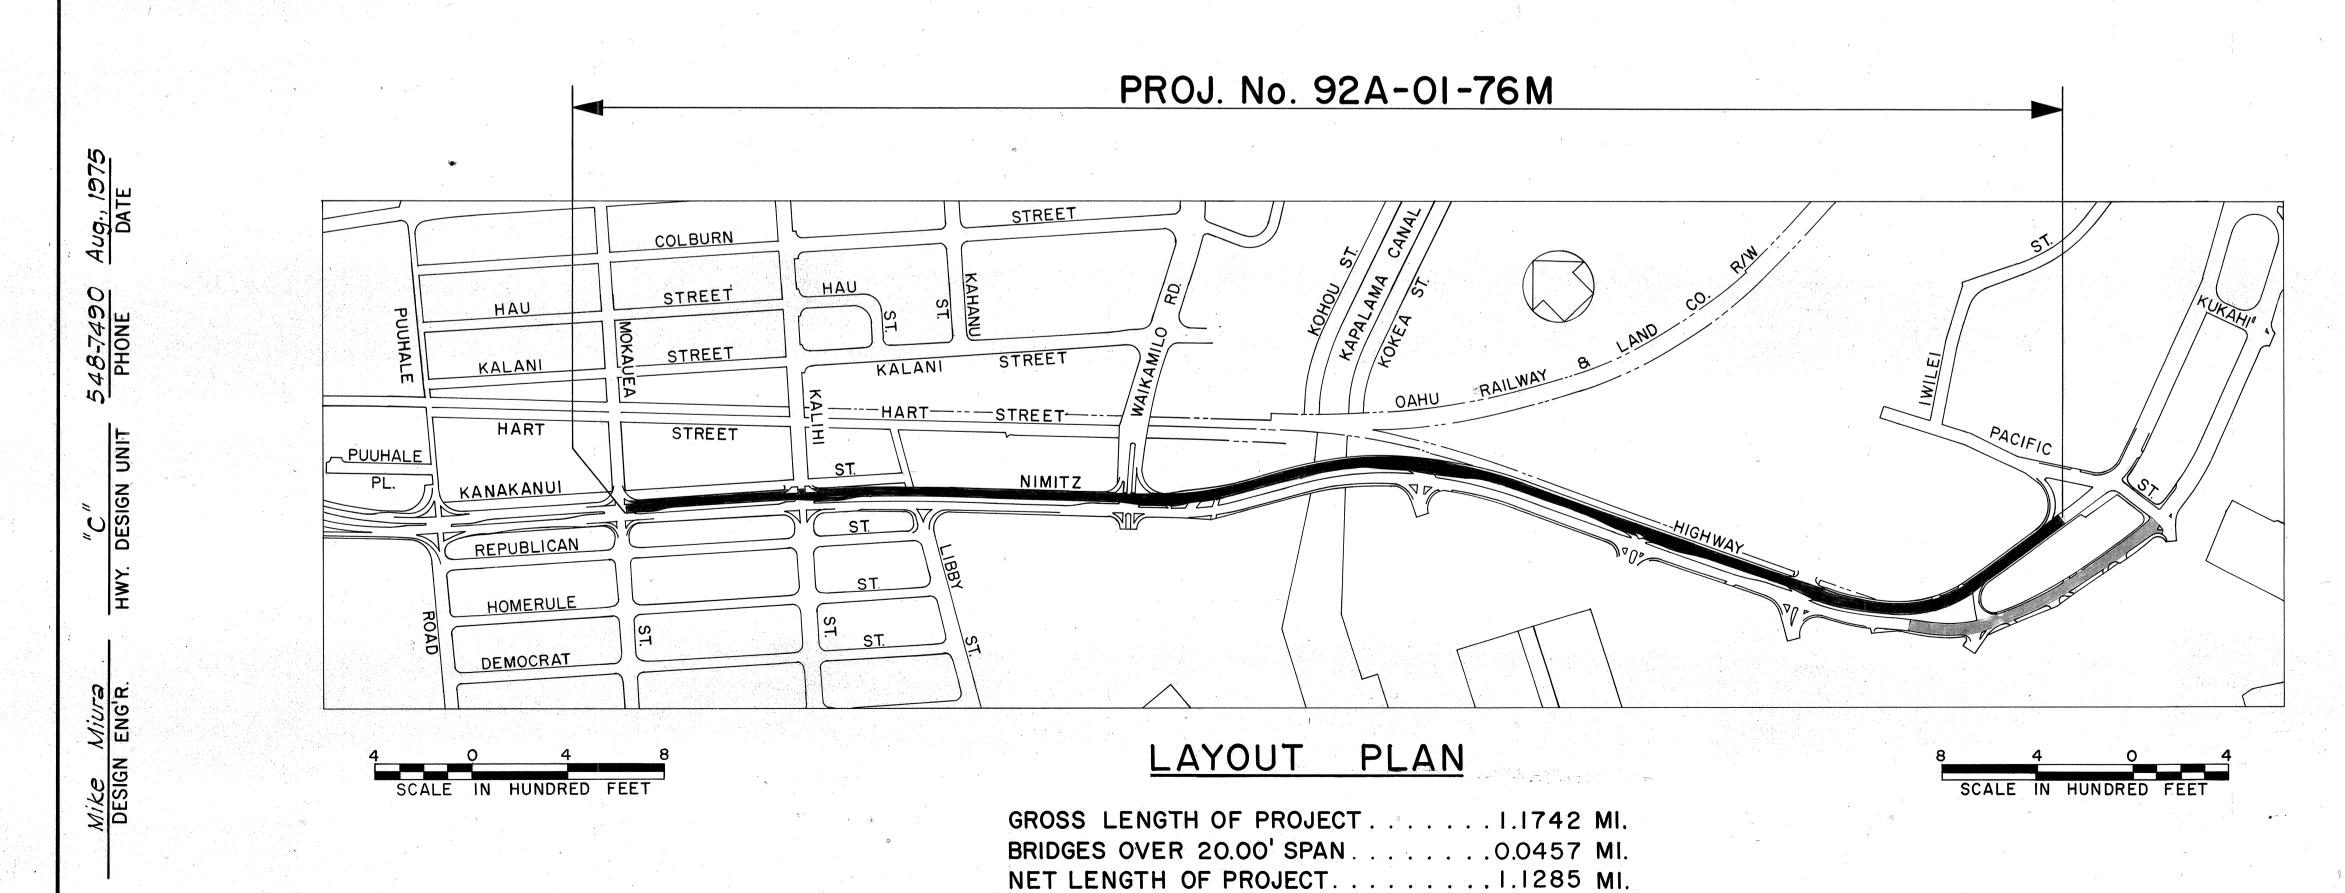

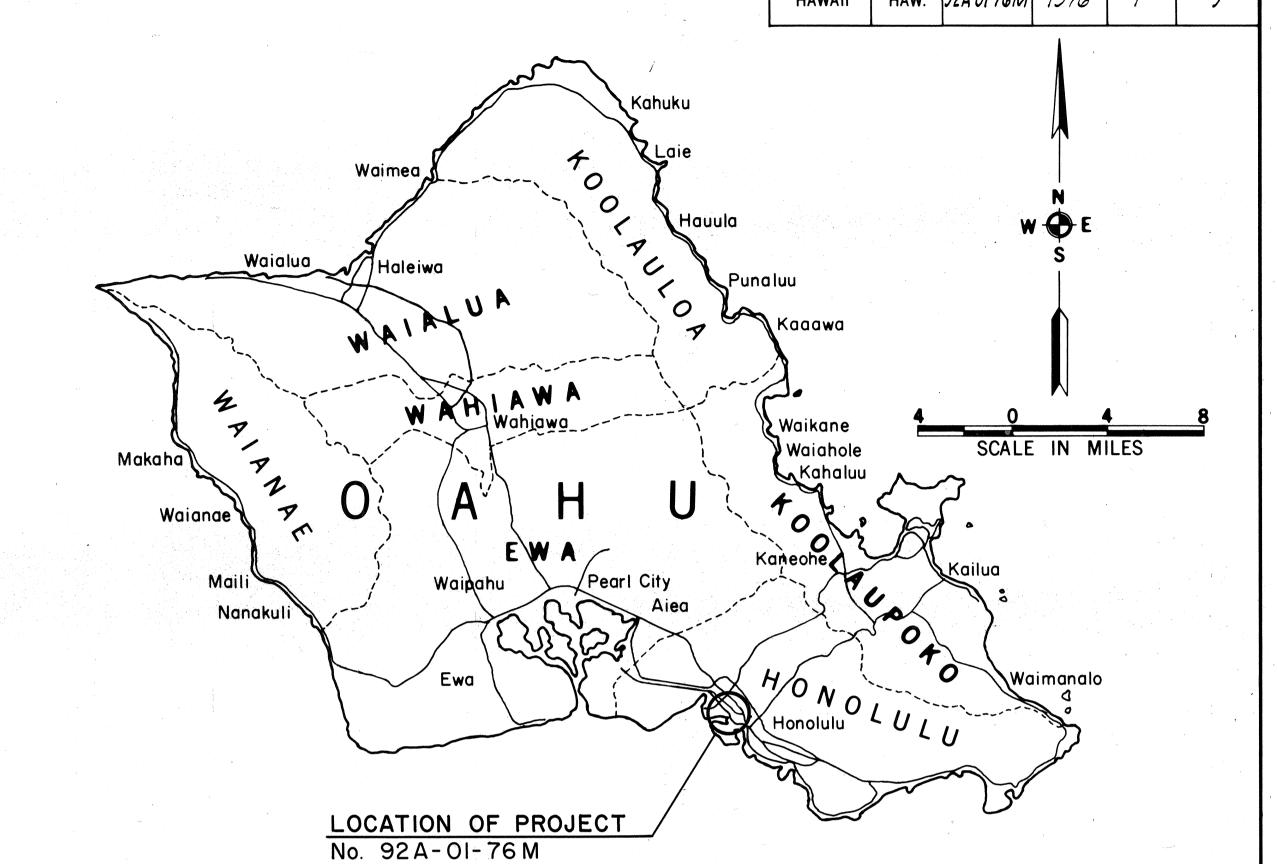

ALL CHANGES MADE DURING CONSTRUCTION HAVE BEEN INCORPORATED ON THESE PLANS IN RED EXCEPT CHANGES IN THE ORIGINAL THEORETICAL QUANTITIES. FOR ACTUAL QUANTITIES, REFER TO PROJECT LEDGER AND/OR COMPUTATION BOOK.

PROJECT ENGINEER

2/22/80 DATE

FISCAL YEAR

DEPARTMENT OF TRANSPORTATION STATE OF HAWAII APPROVED: Ryokecki Higashionna 9-12-75 DIR. OF TRANSPORTATION DATE