


FED. ROAD DIST. NO.	STATE	FED. AID PROJ. NO.	FISCAL YEAR	SHEET NO.	TOTAL SHEETS
HAWAII	HAW.	HWY-0-03-75	1978	34	79

QUANTITY SUMMARY FOR FARRINGTON HWY - KUNIA ROAD		
ITEM NO.	QUANTITY	DESCRIPTION
621.5300	1 Ea.	Install R17-3 Sign with Posts
621.5200	1 Ea.	Install R3-3 Sign
623.3001	1 Ea.	New 12" R.Y. ← Traffic Signal Head with Type I Mounting
623.3003	1 Ea.	New 12" R.Y. ← Programmed Visibility Traffic Signal Head with Type IA Mounting
623.3015	1 Ea.	One new 12" R.Y. ← Traffic Signal Head and one relocated 12" R.Y. ↑ Traffic Signal Head with Type II Mounting
623.6010	3 Ea.	Type B Pullbox
623.8060	2 Ea.	Loop Detector Sensing Unit (6 Ft. x 8 Ft.) 2 Loops
623.8050	3 Ea.	Loop Detector Sensing Unit (6 Ft. x 6 Ft.) 6 Loops
623.5000	100 L.F.	2 inch Conduit
623.7020	925 L.F.	No. 14 2 Conductor Loop Detector Cable
623.1010	25 L.F.	Pavement Striping

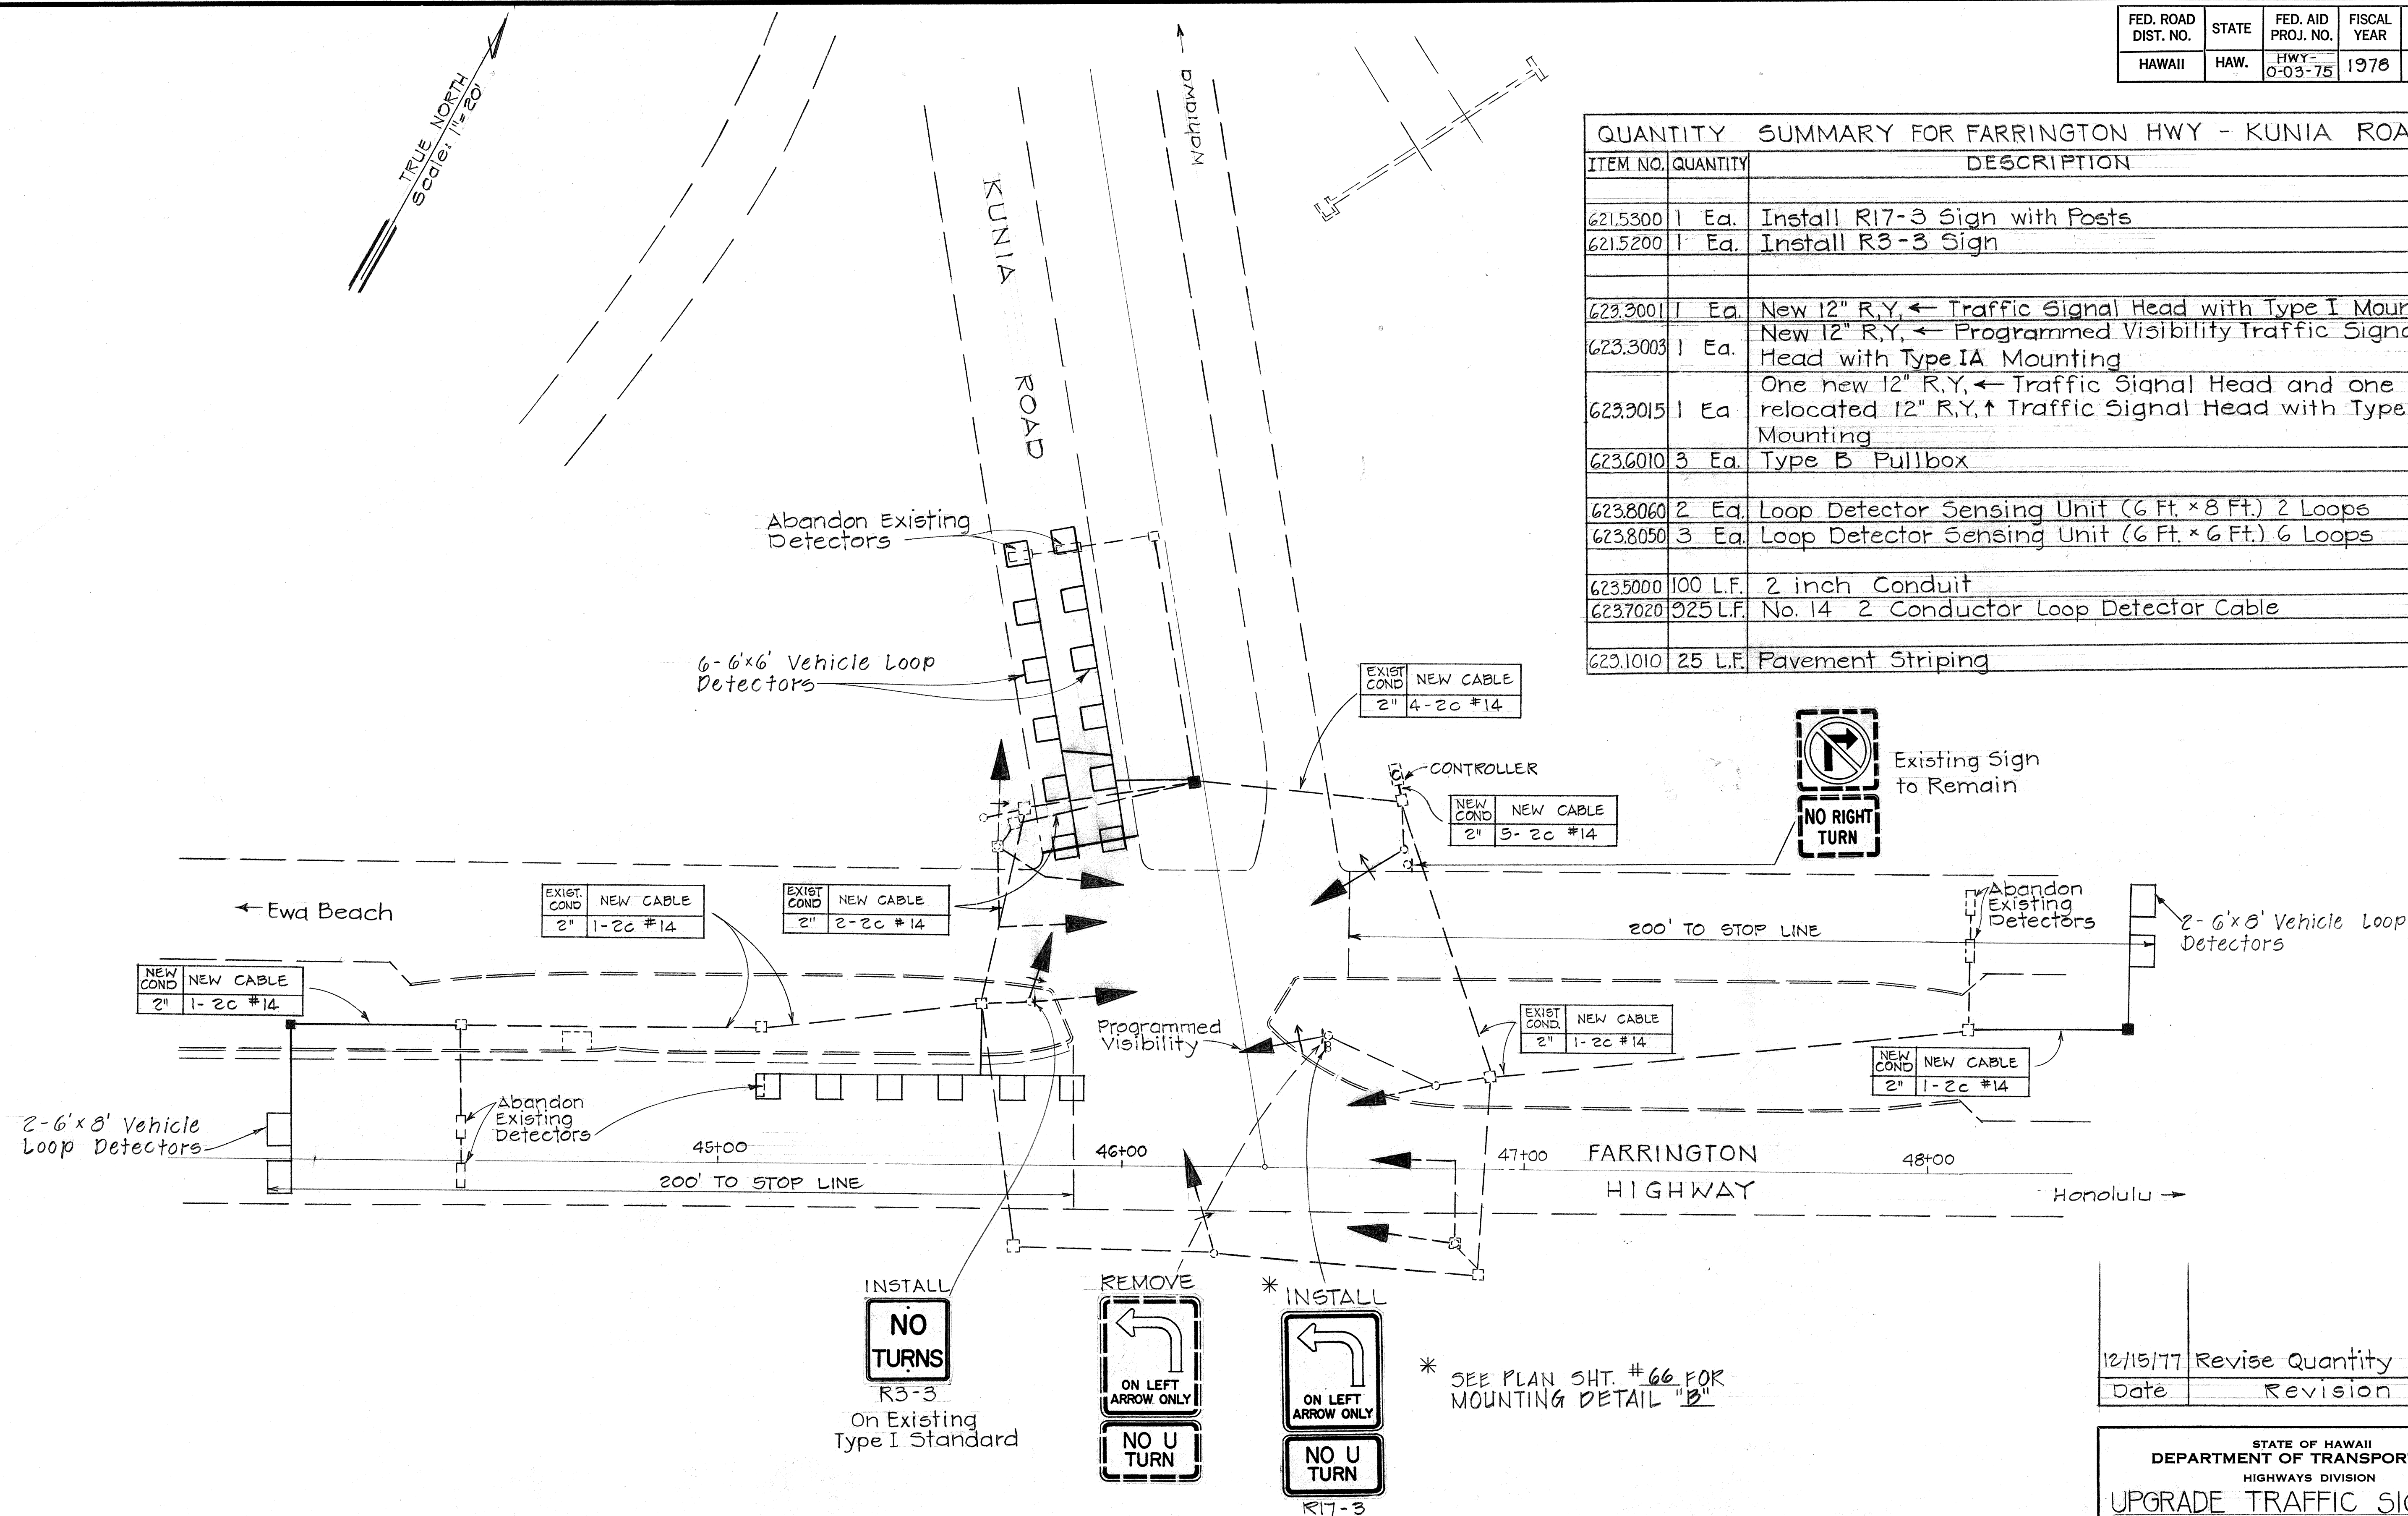

ORIGINAL PLAN	DATE
SURVEY PLOTTED BY	
TRACED BY	
DESIGNED BY	
QUANTITIES BY	
CHECKED BY	
No.	

12/15/77	Revise Quantity Summary
Date	Revision

STATE OF HAWAII
DEPARTMENT OF TRANSPORTATION
HIGHWAYS DIVISION

UPGRADE TRAFFIC SIGNALS
AT VARIOUS INTERSECTIONS
FARRINGTON HWY - KUNIA ROAD
PROJ. NO. HWY-0-03-75

Scale: 1" = 20'
Date: April 1977

SHEET No. 30 OF 47 SHEETS

