


FED. ROAD DIST. NO.	STATE	PROJ. NO.	FISCAL YEAR	SHEET NO.	TOTAL SHEETS
HAWAII	HAW.	02A-01-78M	1978	3	0

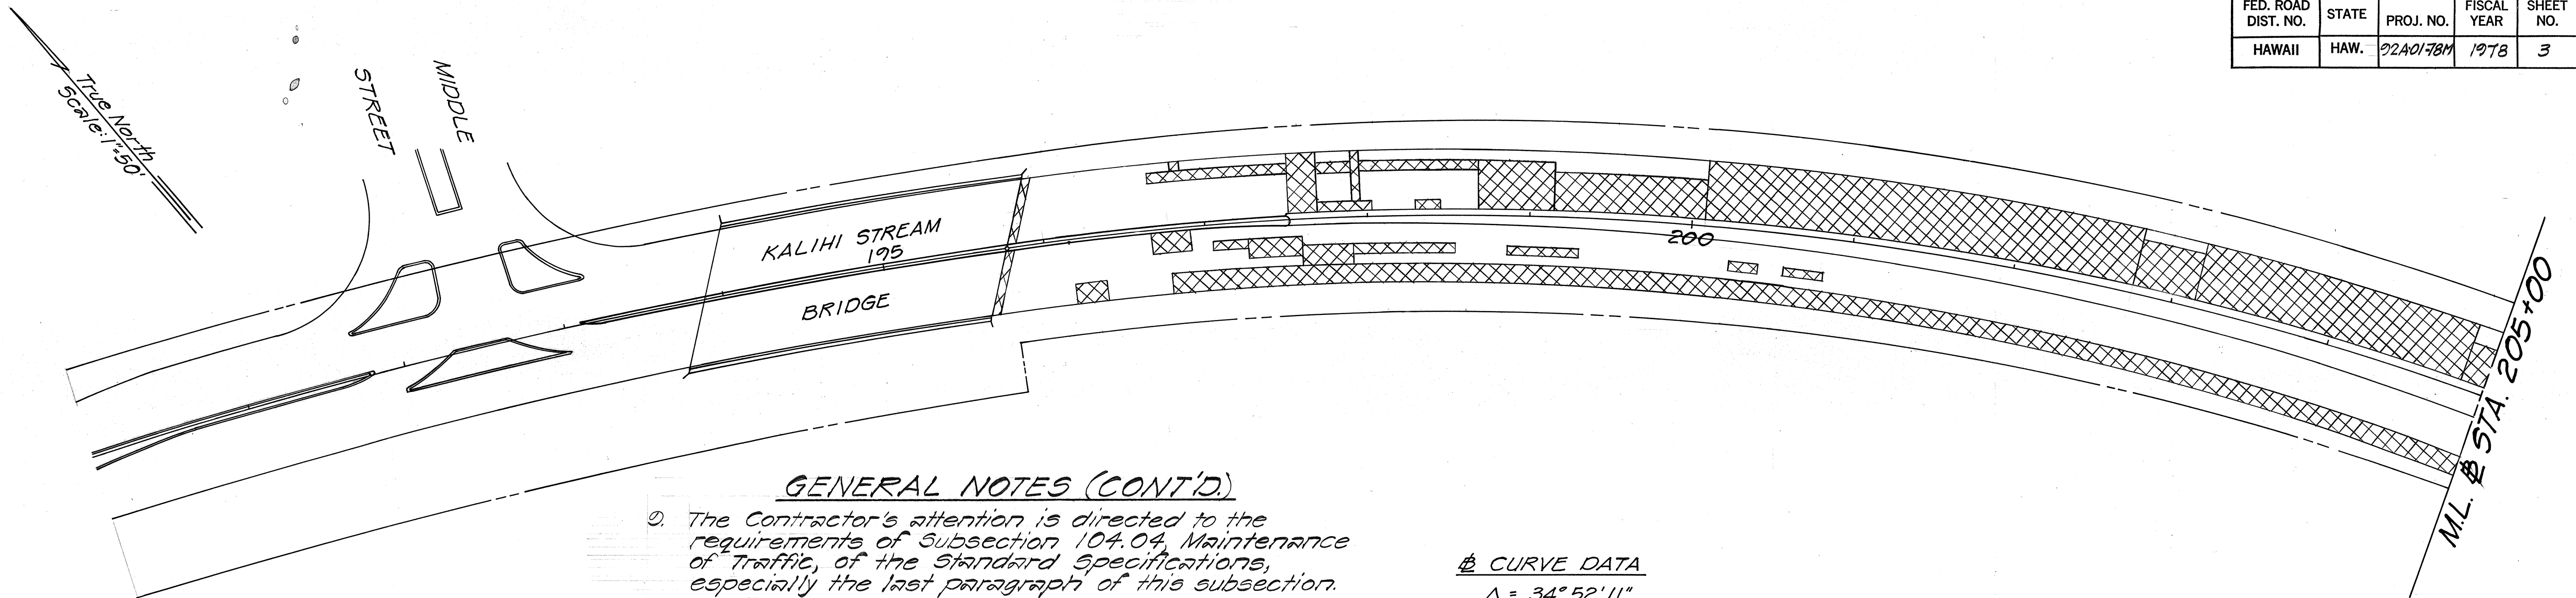


GENERAL NOTES (CONT'D)

9. The Contractor's attention is directed to the requirements of Subsection 104.04, Maintenance of Traffic, of the Standard Specifications, especially the last paragraph of this subsection.
10. The Contractor shall coordinate his work with the C.E.C. of Honolulu, Department of Transportation Services involving the vehicle loop detectors for traffic signal system.
11. The Vehicle Loop Detectors shown on the plans are being installed under Federal Aid Project No. TQF-0300(0), Upgrading Existing Traffic Signals at Various Locations, Oahu.

CURVE DATA

$\Delta = 34^{\circ}52'11''$
 $R = 1,879.90'$
 $T = 590.38'$
 $L = 1,144.09'$

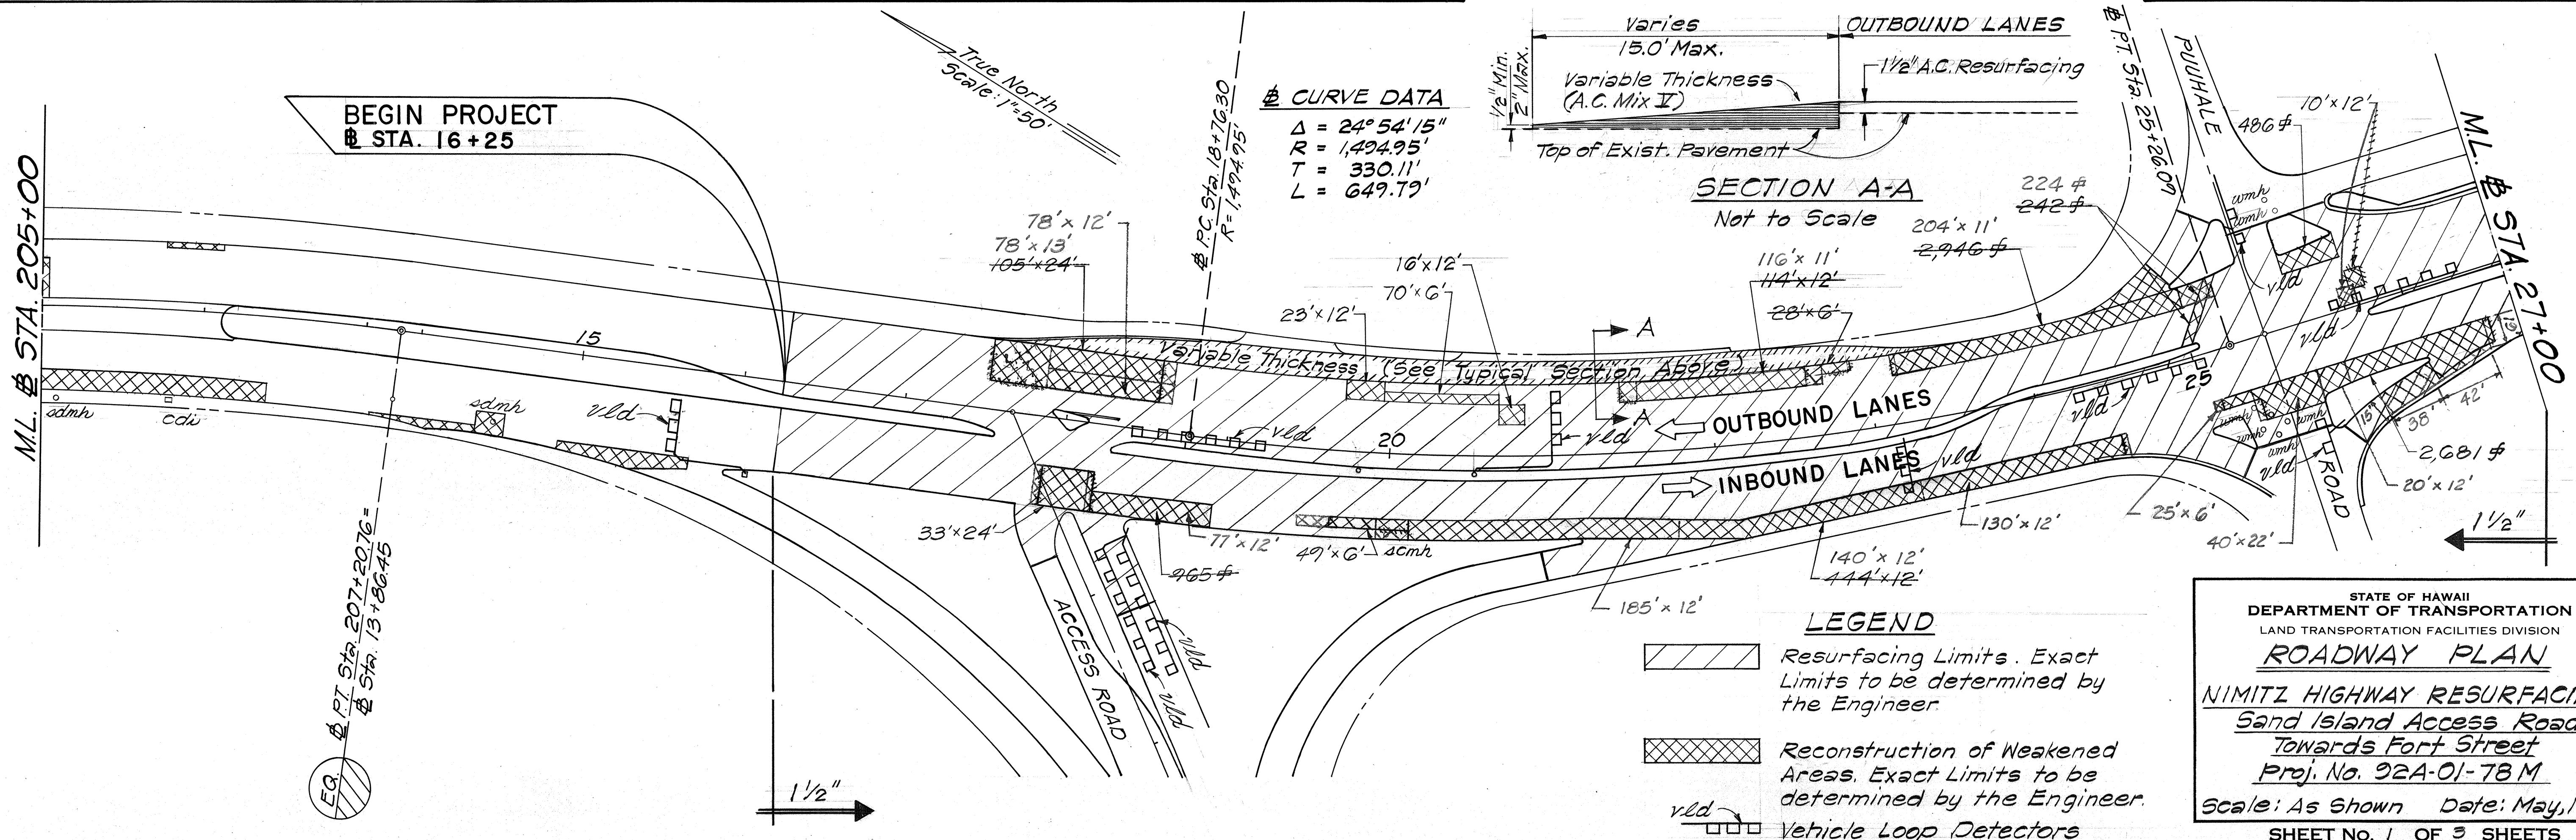

CURVE DATA

$\Delta = 24^{\circ}54'15''$
 $R = 1,494.95'$
 $T = 330.11'$
 $L = 649.72'$

SECTION A-A

Not to Scale

LEGEND

- Resurfacing Limits. Exact Limits to be determined by the Engineer.
- Reconstruction of Weakened Areas. Exact Limits to be determined by the Engineer.
- Vehicle Loop Detectors

STATE OF HAWAII
DEPARTMENT OF TRANSPORTATION
LAND TRANSPORTATION FACILITIES DIVISION

ROADWAY PLAN



NIMITZ HIGHWAY RESURFACING
 Sand Island Access Road
 Towards Fort Street
 Proj. No. 02A-01-78M

Scale: As Shown Date: May, 1978

SHEET No. 1 OF 3 SHEETS

ORIGINAL PLAN	DATE
DRAWN BY	
TRACED BY	
CHECKED BY	
NO. BOOK	
CHECKED BY	

FED. ROAD DIST. NO.	STATE	PROJ. NO.	FISCAL YEAR	SHEET NO.	TOTAL SHEETS
HAWAII	HAW.	92A-0178M	1978	4	9

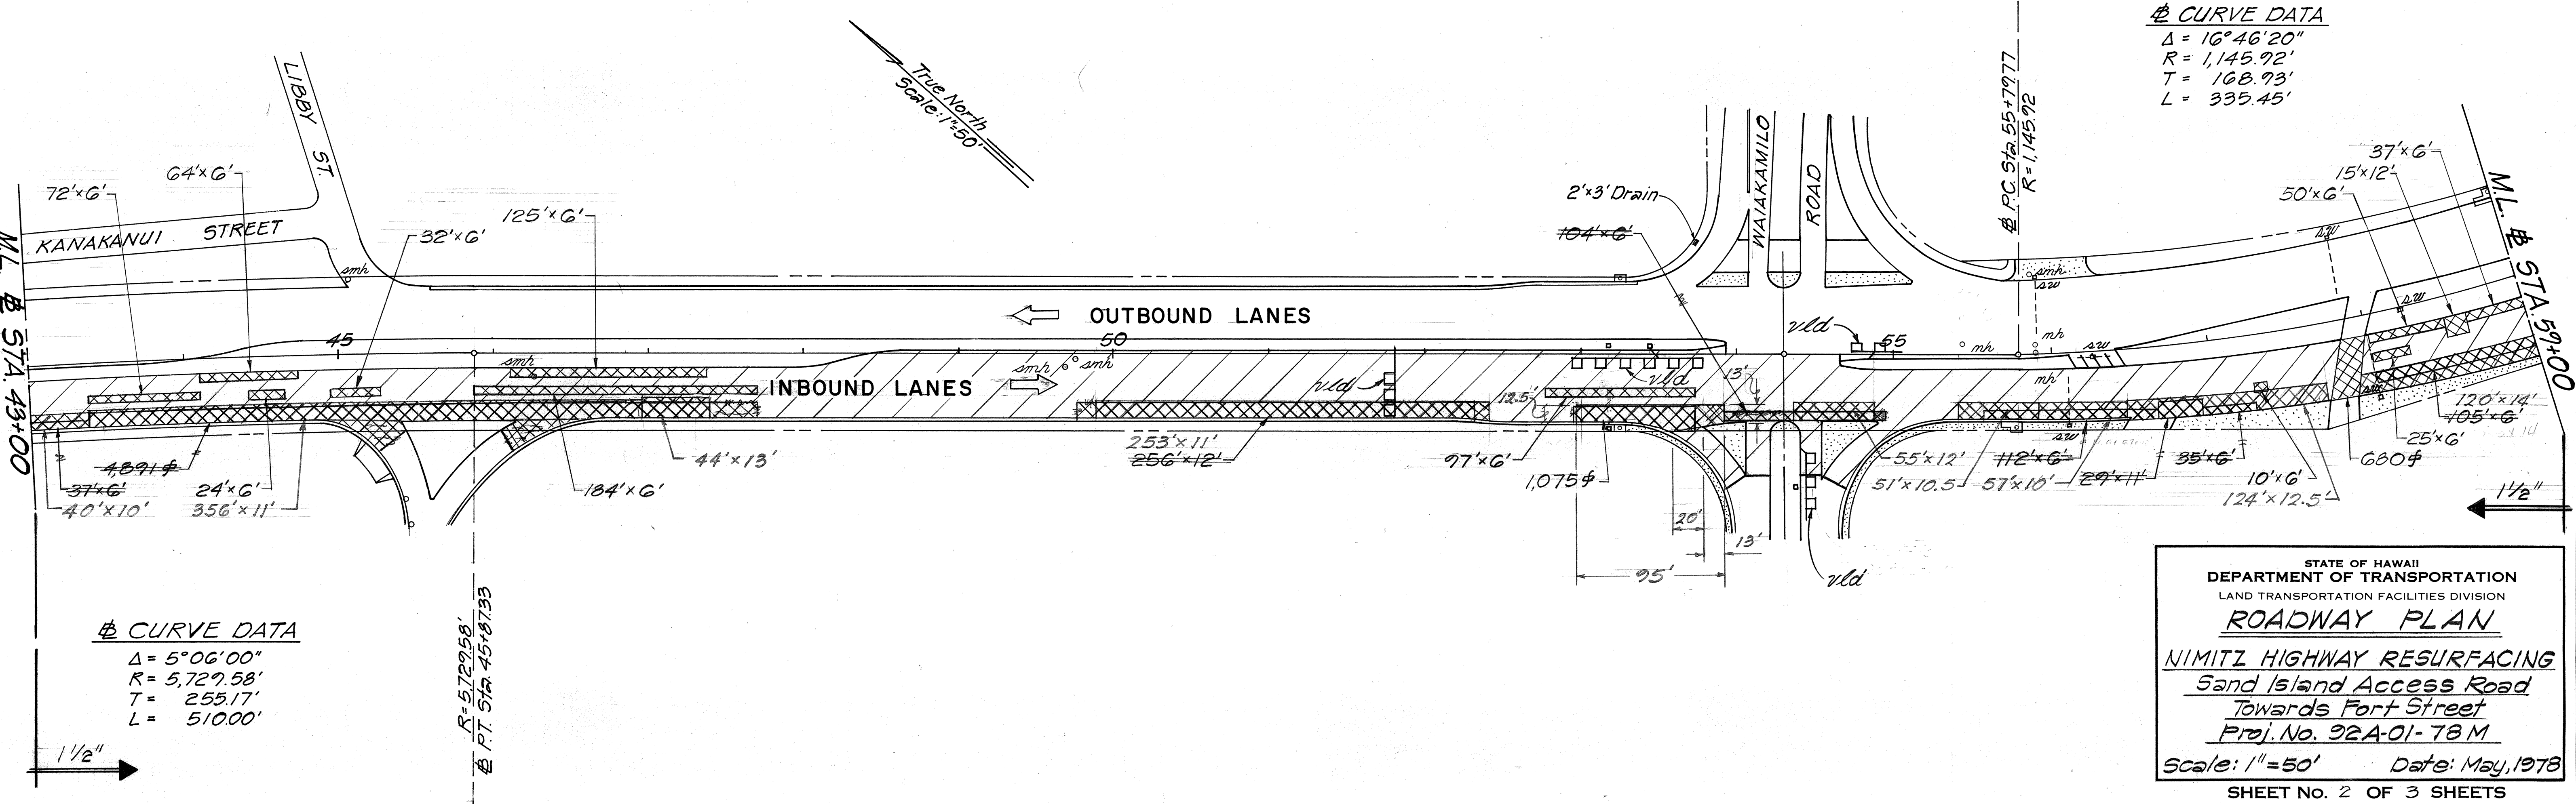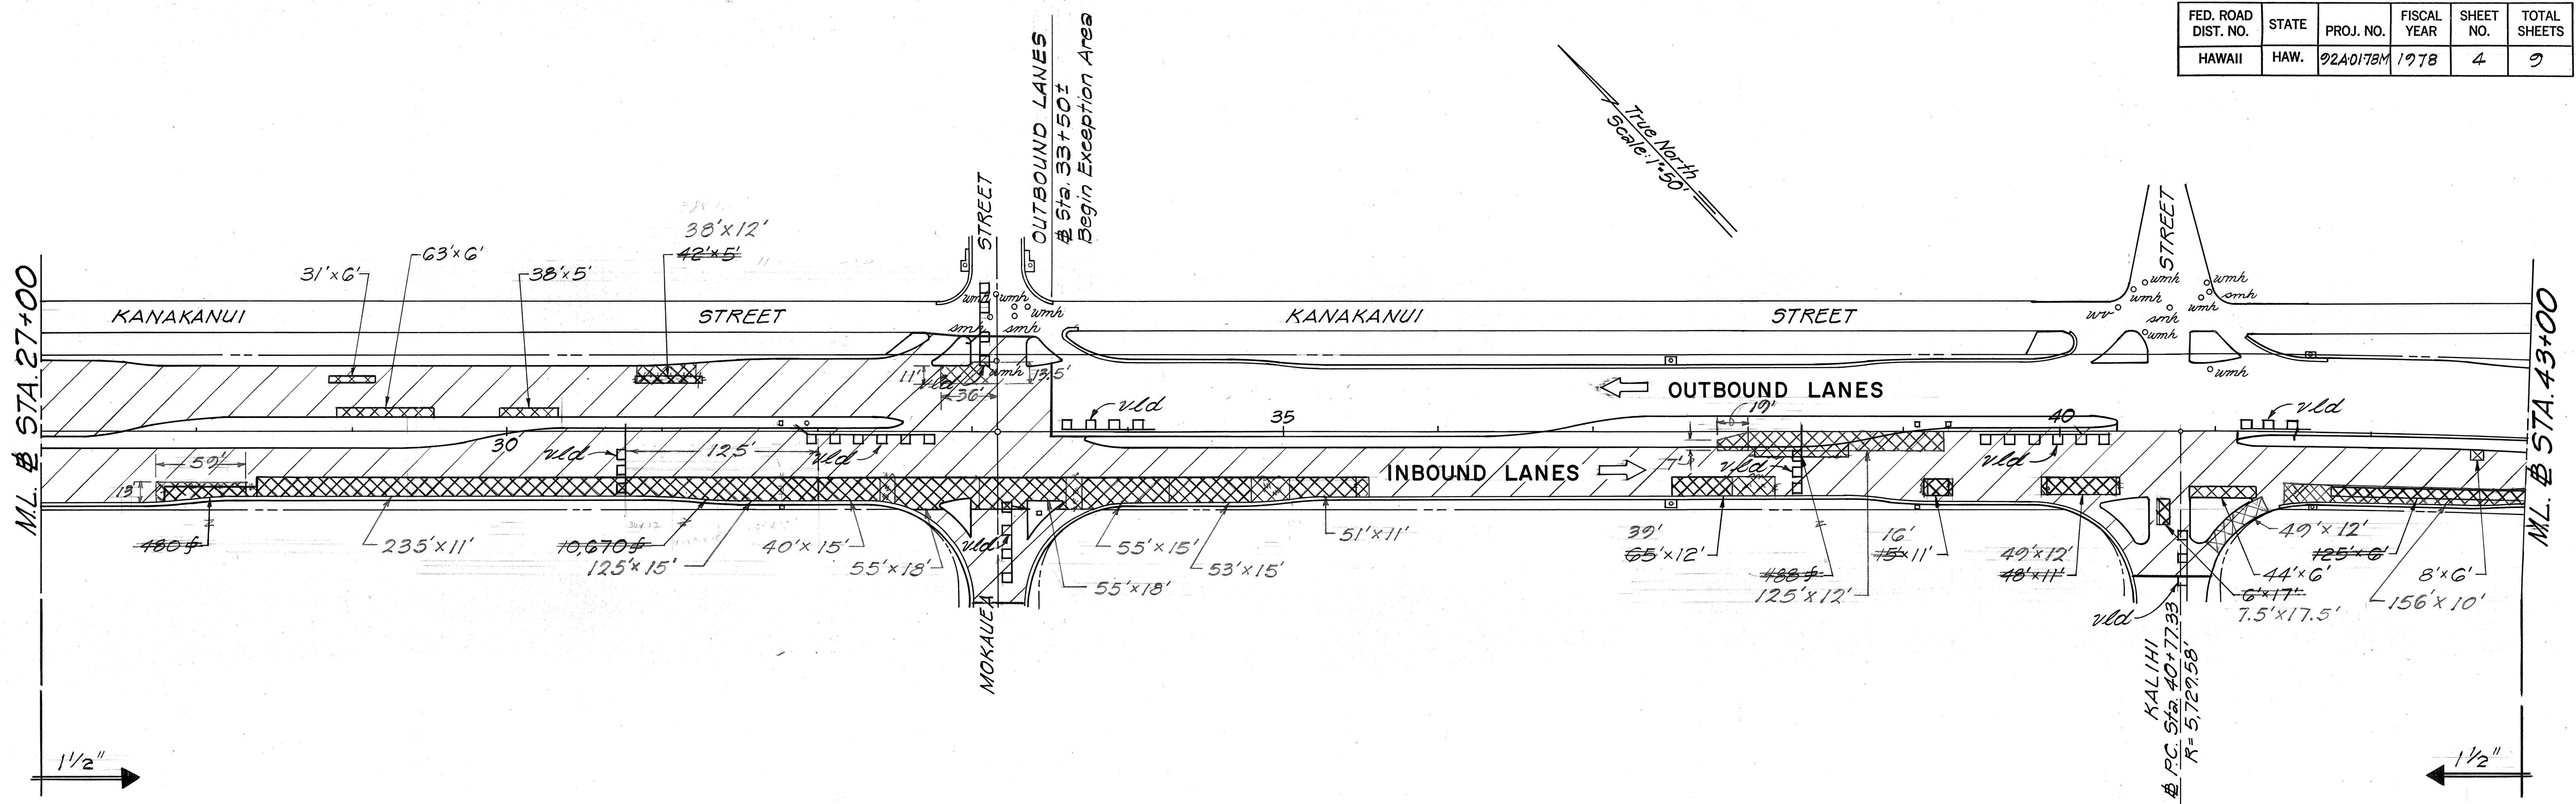

CURVE DATA

Δ	$16^{\circ}46'20''$
R	1,145.92'
T	168.93'
L	335.45'

CURVE DATA

Δ	$5^{\circ}06'00''$
R	5,729.58'
T	255.17'
L	510.00'

STATE OF HAWAII

DEPARTMENT OF TRANSPORTATION

LAND TRANSPORTATION FACILITIES DIVISION

ROADWAY PLAN

NIMITZ HIGHWAY RESURFACING

Sand Island Access Road

Towards Fort Street

Proj. No. 92A-01-78 M

Scale: 1"=50'



Date: May, 1978

SHEET NO. 2 OF 3 SHEETS

DATE	
SURVEY PLOTTED BY	
DRAWN BY	
TRACED BY	
CHECKED BY	
NOTE BOOK	
NO.	

DD-B-78

FED. ROAD DIST. NO.	STATE	PROJ. NO.	FISCAL YEAR	SHEET NO.	TOTAL SHEETS
HAWAII	HAW.	22A-01-TBM	1978	5	9

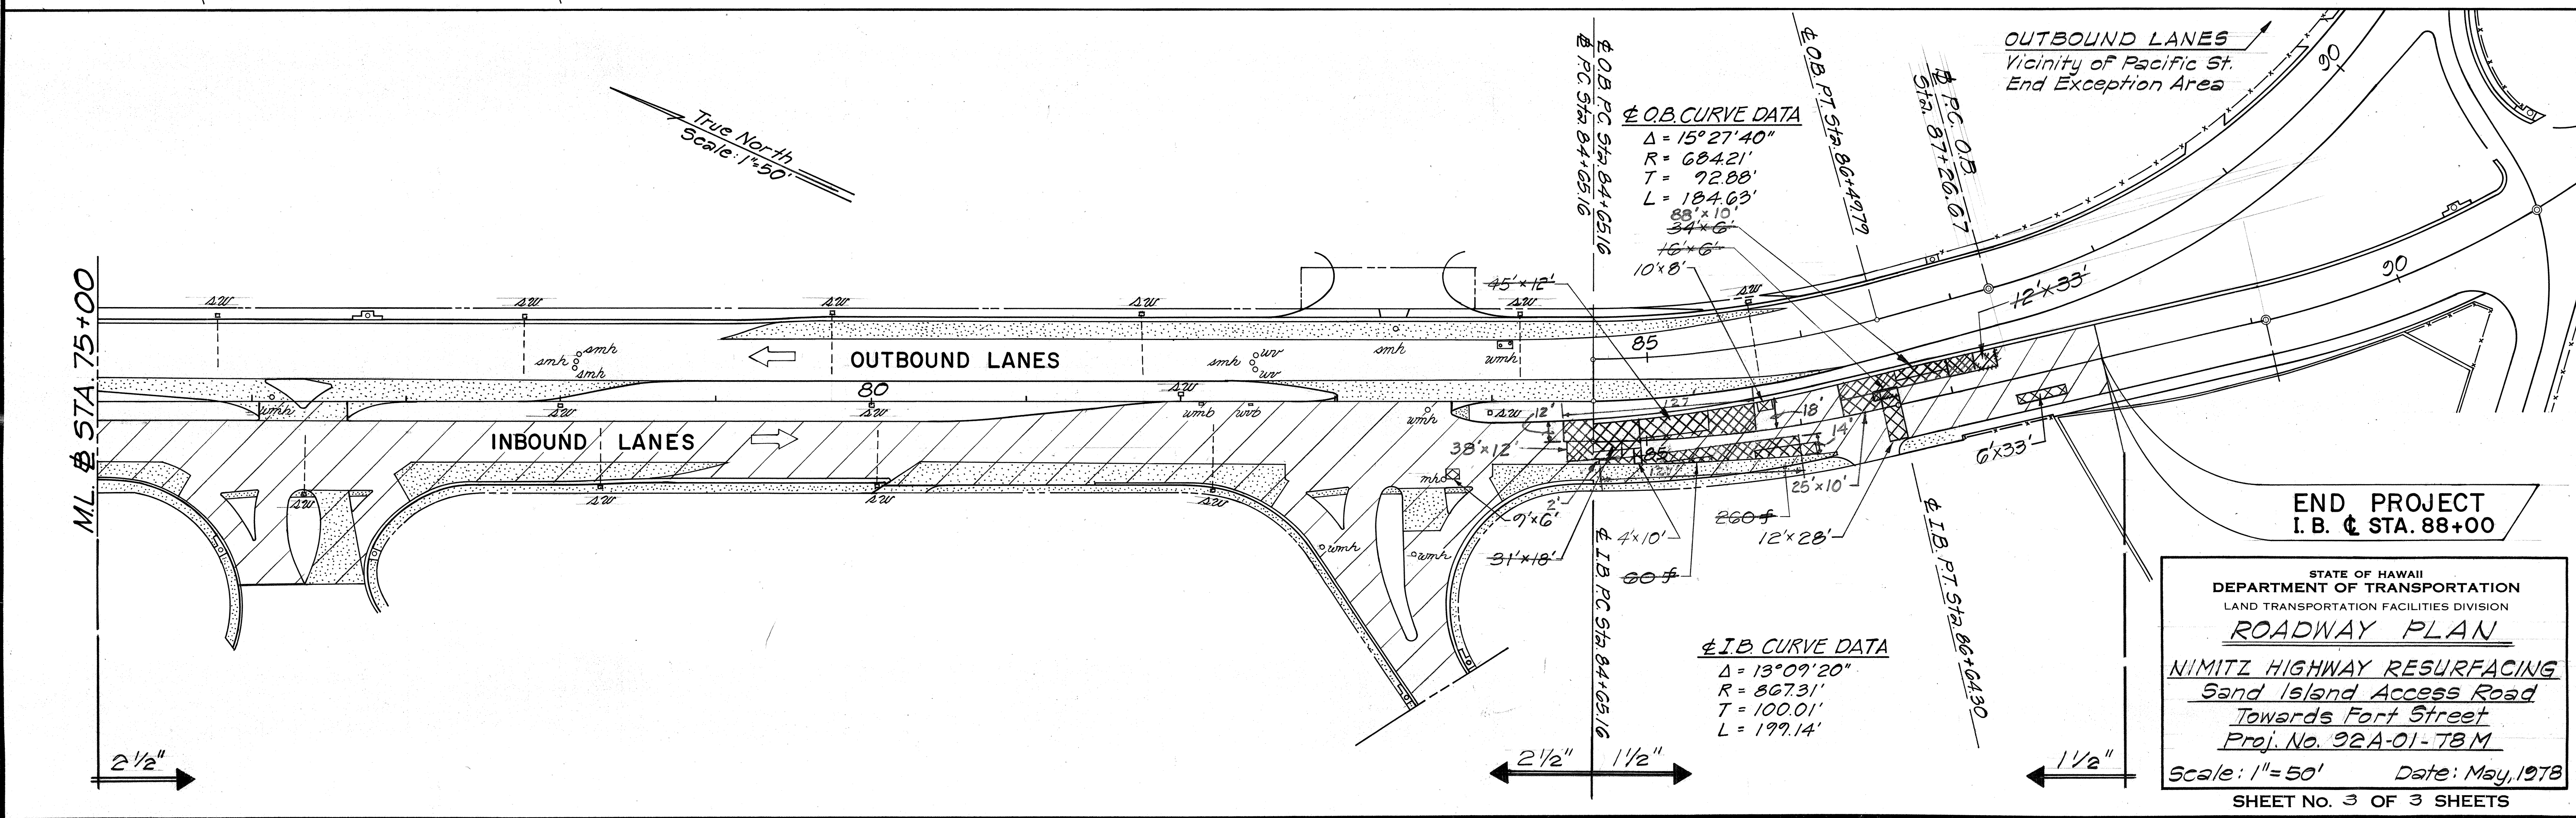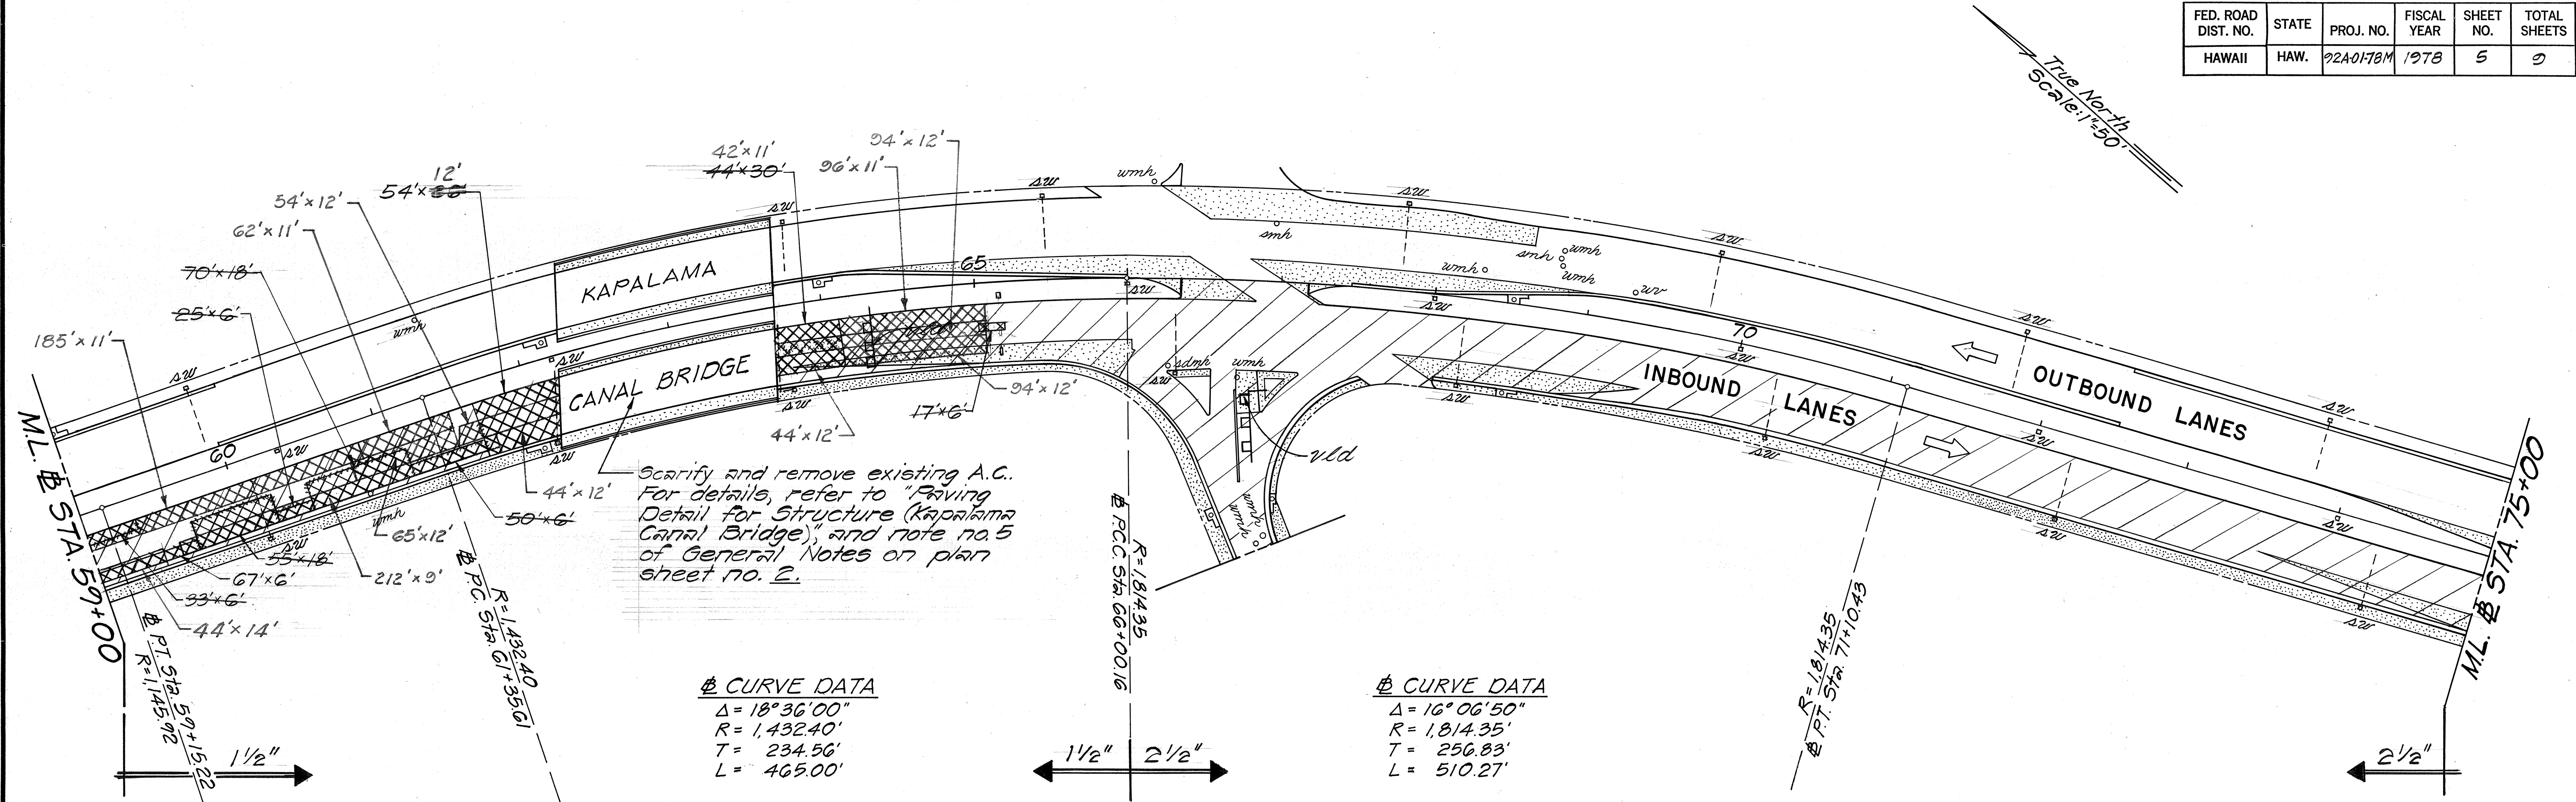

ORIGINAL PLAN	DATE
DRAWN BY	
TRACED BY	
CHECKED BY	
NOTED BY	
NO.	

STATE OF HAWAII
DEPARTMENT OF TRANSPORTATION
LAND TRANSPORTATION FACILITIES DIVISION


ROADWAY PLAN

NIMITZ HIGHWAY RESURFACING
Sand Island Access Road
Towards Fort Street
Proj. No. 22A-01-TBM

Scale: 1" = 50' Date: May, 1978

SHEET NO. 3 OF 3 SHEETS

FED. ROAD DIST. NO.	STATE	PROJ. NO.	FISCAL YEAR	SHEET NO.	TOTAL SHEETS
HAWAII	HAW.	22A-0178M	1978	C055-1	2

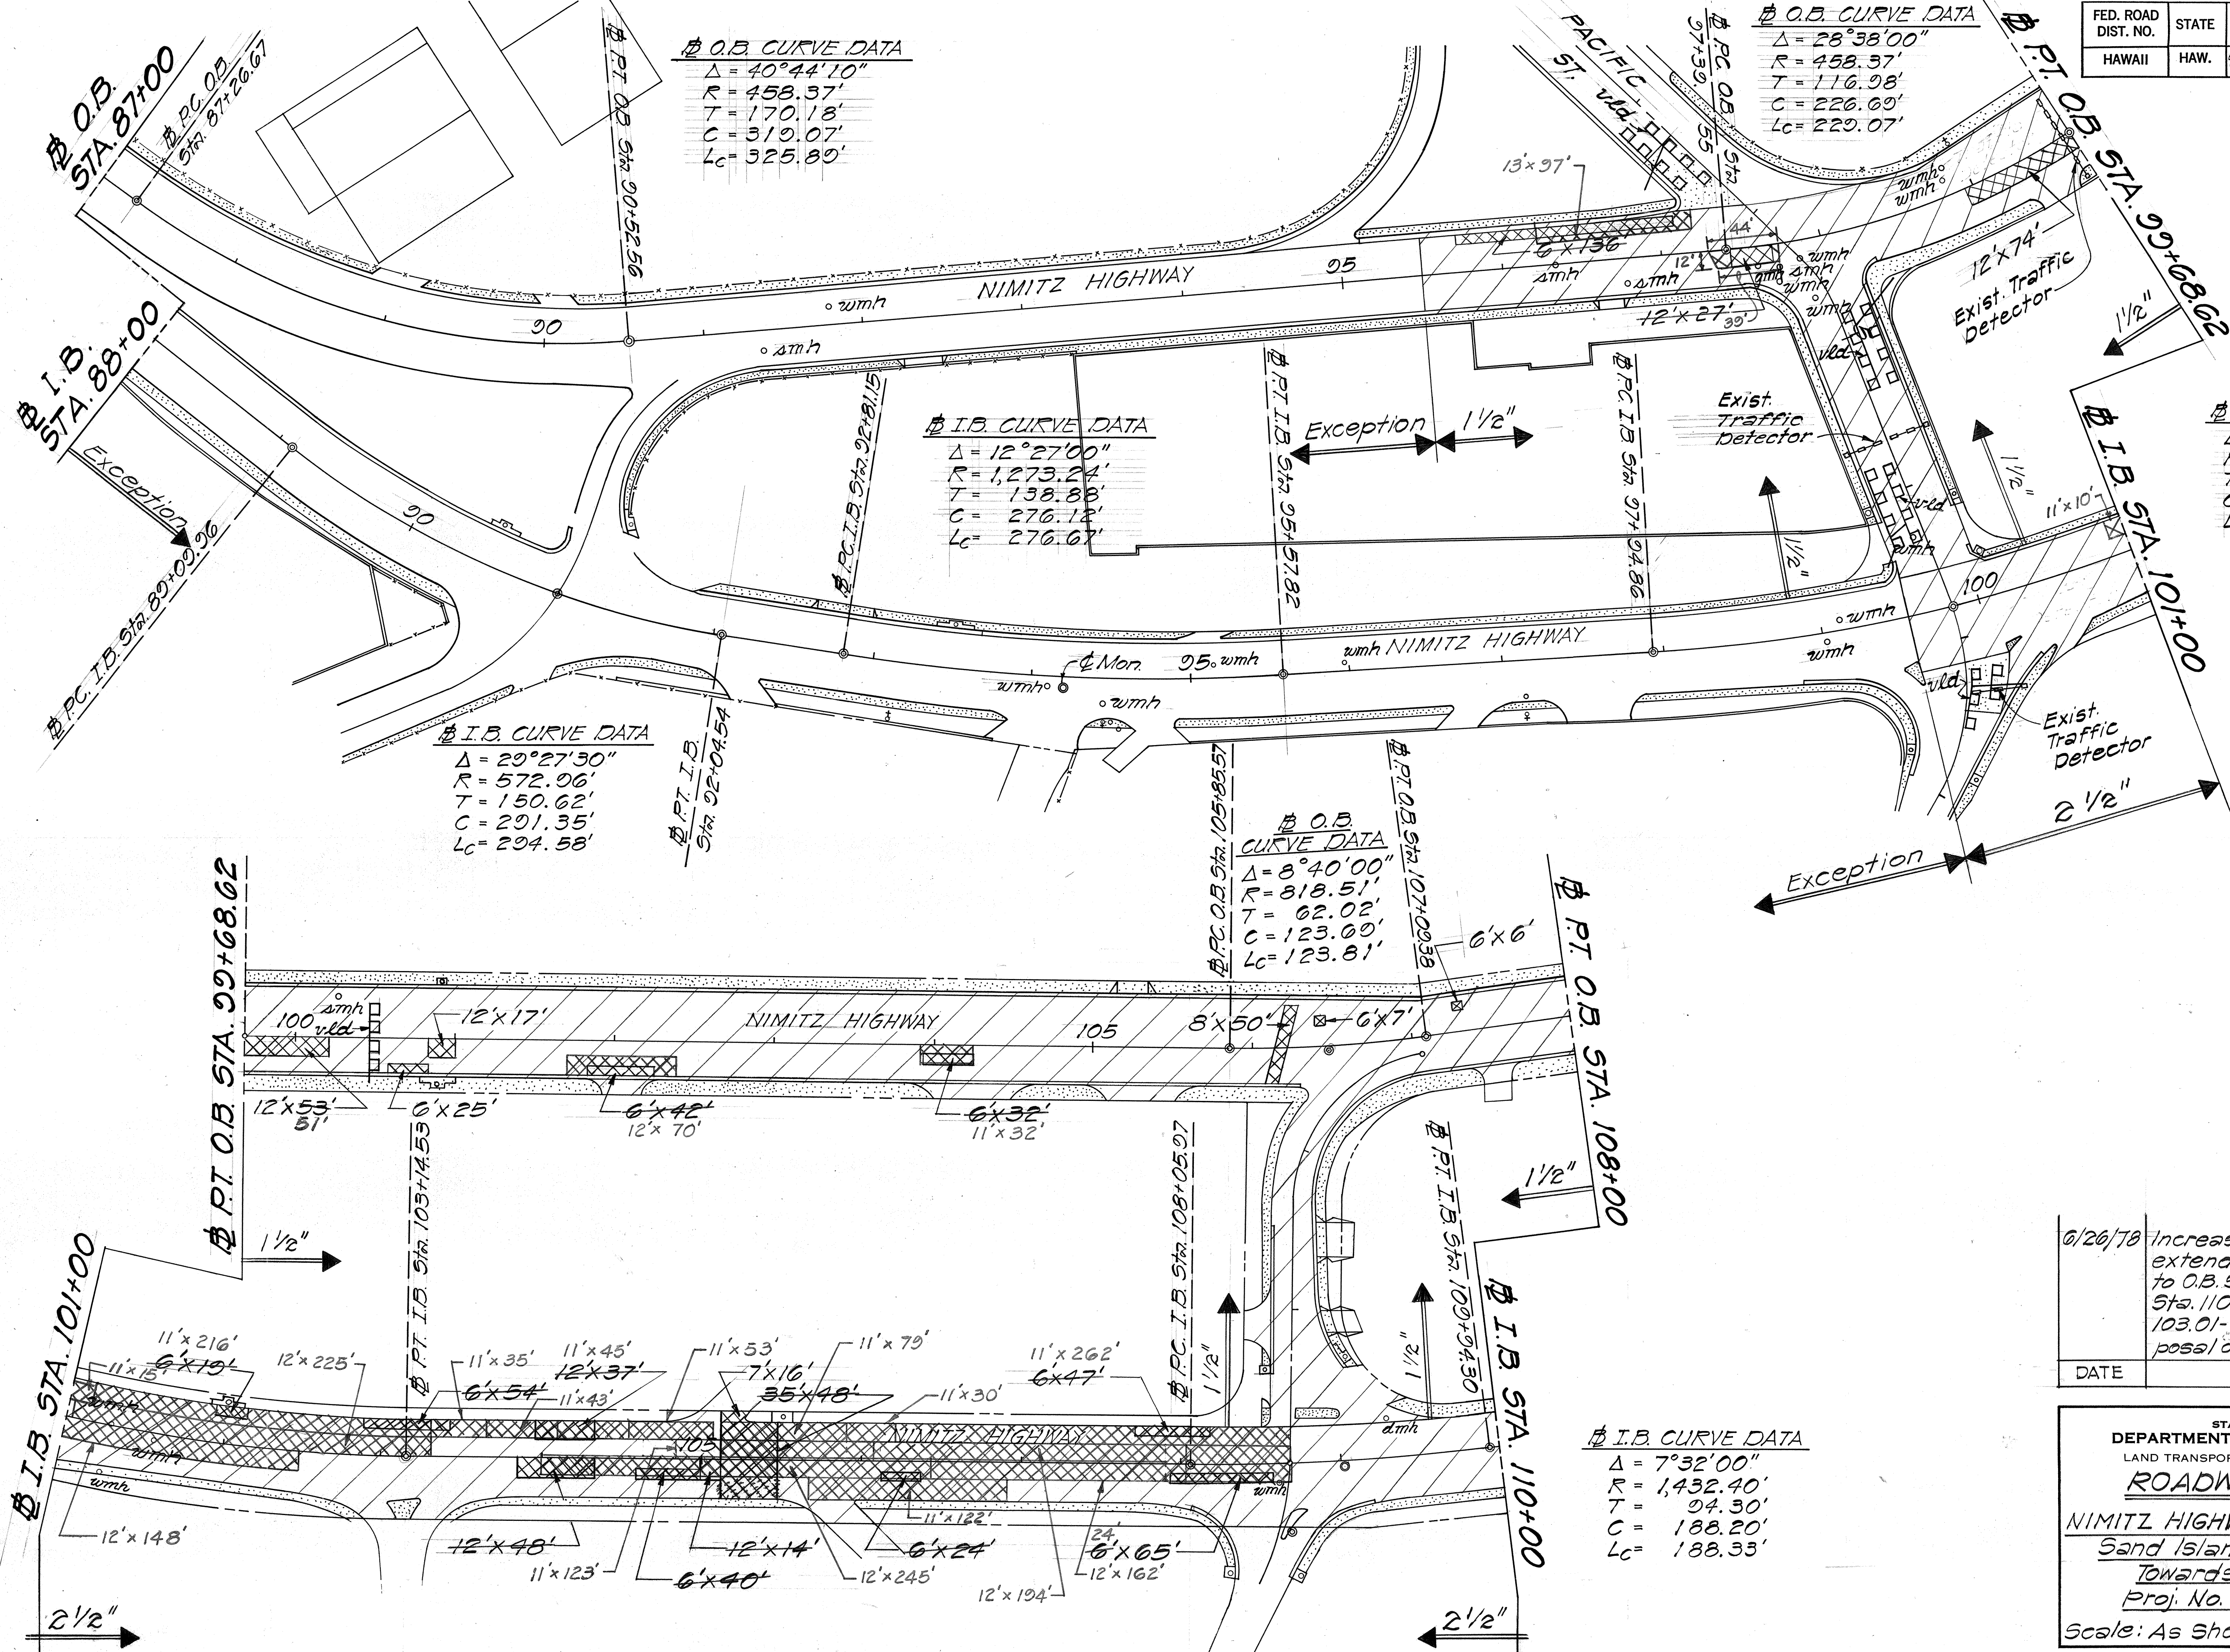

6/26/78	Increased scope of work by extending project length to O.B. Sta. 108+00 and I.B. Sta. 110+00 per Subsection 103.01- Consideration of Proposal of the Special Provisions
DATE	REVISION

STATE OF HAWAII
DEPARTMENT OF TRANSPORTATION
LAND TRANSPORTATION FACILITIES DIVISION

ROADWAY PLAN

NIMITZ HIGHWAY RESURFACING
Sand Island Access Road
Towards Fort Street
Proj. No. 22A-01-78M

Scale: As Shown Date: June, 1978

SHEET No. 34 OF 3 SHEETS

ORIGINAL PLAN	DATE
DRAWN BY	
DESIGNED BY	
NOTED BY	
CHECKED BY	
NO.	

True North
Scale: 1"=50'

Proj. No. U-092 (3)
Sta. 108+00 to 111+00
Proj. No. FU-44(3), U-2
Sta. 111+00 to 111+62.51

ML # O.B. STA. 108+00

ML # I.B. STA. 110+00

SUNNYSIDE HIGHWAY

NIMITZ HIGHWAY

AWA STREET

RIVER

ST.

Proj. No. U-092
Sta. 115+10.1
Proj. No. FU-44(5), U-2
P.T. Sta. 121+59.54

Proj. No. FU-44(3), U-2
P.T. I.B. Sta. 121+59.54
Proj. No. FU-44(5), U-2
P.T. Sta. 121+59.54

ML # P.T. STA. 121+59.54

CURVE DATA
 $\Delta = 115^{\circ}07'00''$
 $R = 329.50'$
 $T = 518.30'$
 $C = 556.16'$
 $LC = 662.02'$
 $R = 329.50'$
 $PC Sta. 108+55.71$

I.B. CURVE DATA
 $\Delta = 114^{\circ}13'00''$
 $R = 500.00'$
 $T = 773.13'$
 $C = 839.70'$
 $LC = 996.73'$
 $R = 500.00'$
 $PC I.B. Sta. 111+62.51$



Scarify and remove existing A.C. on structure before resurfacing with 1 1/2" A.C. Mix II. This work shall be considered incidental to Asphalt Concrete Pavement, Mix No. II and no separate payment shall be made therefor.

STATE OF HAWAII
DEPARTMENT OF TRANSPORTATION
LAND TRANSPORTATION FACILITIES DIVISION
ROADWAY PLAN
NIMITZ HIGHWAY RESURFACING
Sand Island Access Road
Towards Fort Street
Proj. No. 92A-01-78 M
Scale: As Shown Date: June, 1978
SHEET No. 3B OF 3 SHEETS

C05S-2

ORIGINAL PLAN	SURVEY PLOTTED BY _____	DATE _____
NOTE BOOK	DRAWN BY _____	" "
	TRACED BY _____	" "
	DESIGNED BY _____	" "
	QUANTITIES BY _____	" "
No. _____	CHECKED BY _____	" "

FED. ROAD DIST. NO.	STATE	PROJ. NO.	FISCAL YEAR	SHEET NO.	TOTAL SHEETS
HAWAII	HAW.	92A-01-78M	1978	C0553	3

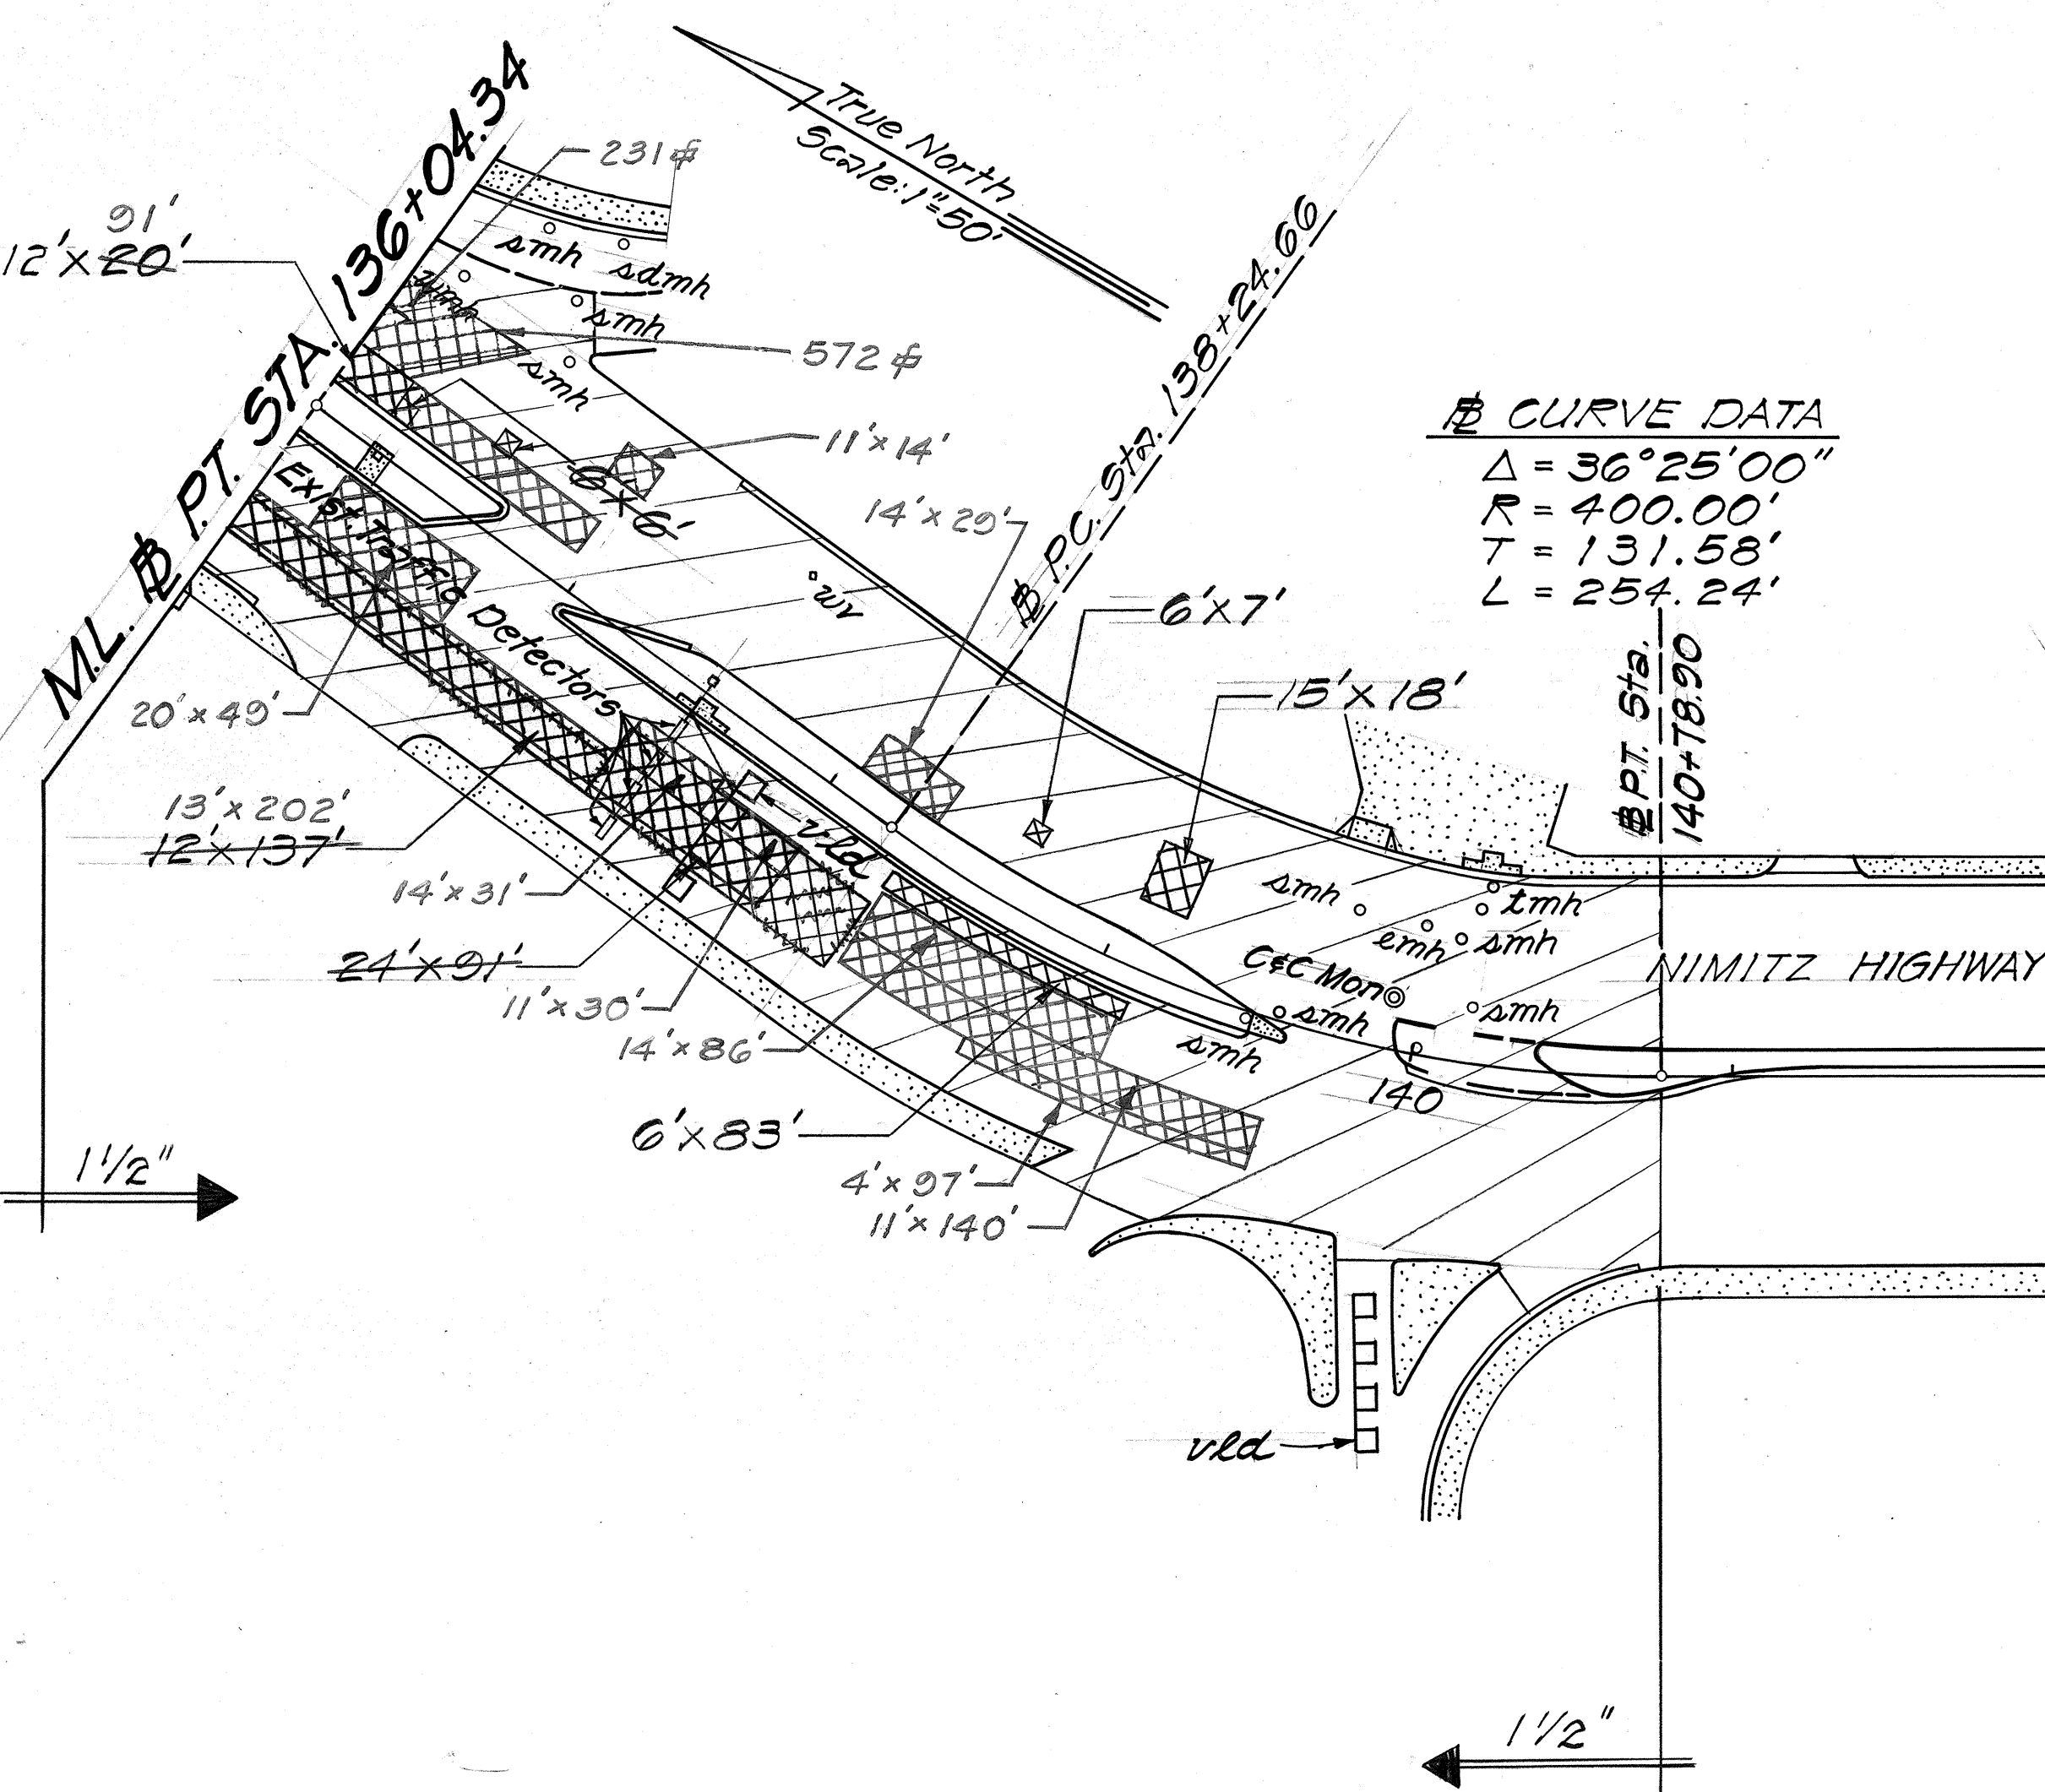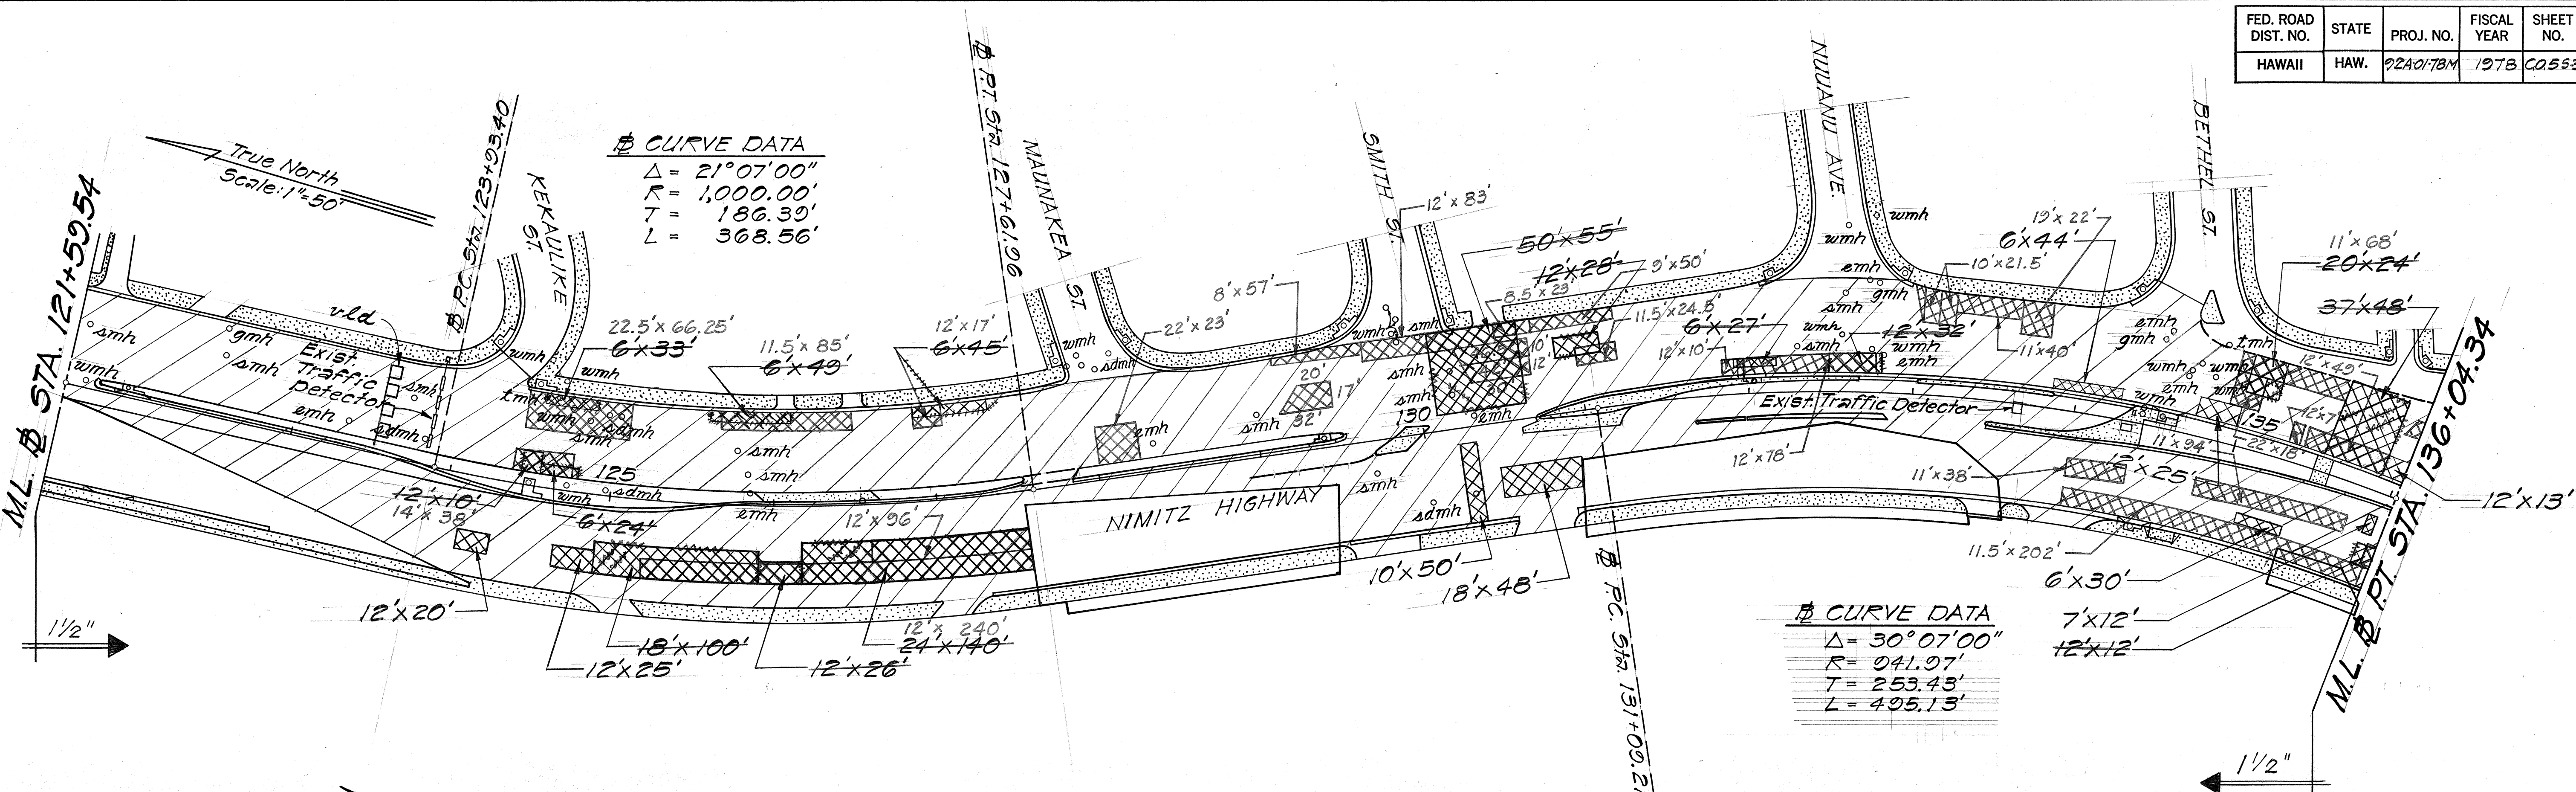


DATE	_____
SURVEY PLOTTED BY	_____
DRAWN BY	_____
TRACED BY	_____
CHECKED BY	_____
ORIGINAL PLAN	_____
NOTE BOOK	_____
No.	_____

7/12/78	Increase scope of work by increasing project length from O.B. Sta. 108+00 and I.B. Sta. 110+00 towards Fort St.
DATE	REVISION

STATE OF HAWAII
DEPARTMENT OF TRANSPORTATION
LAND TRANSPORTATION FACILITIES DIVISION
ROADWAY PLAN


NIMITZ HIGHWAY RESURFACING
Sand Island Access Road
Towards Fort Street
Proj. No. 92A-01-78M
Scale: As Shown Date: June, 1978
SHEET No. 3 OF 3 SHEETS

FED. ROAD DIST. NO.	STATE	FED. AID PROJ. NO.	FISCAL YEAR	SHEET NO.	TOTAL SHEETS
HAWAII	HAW.	22A-01-78M	1978	C05 S-4	9

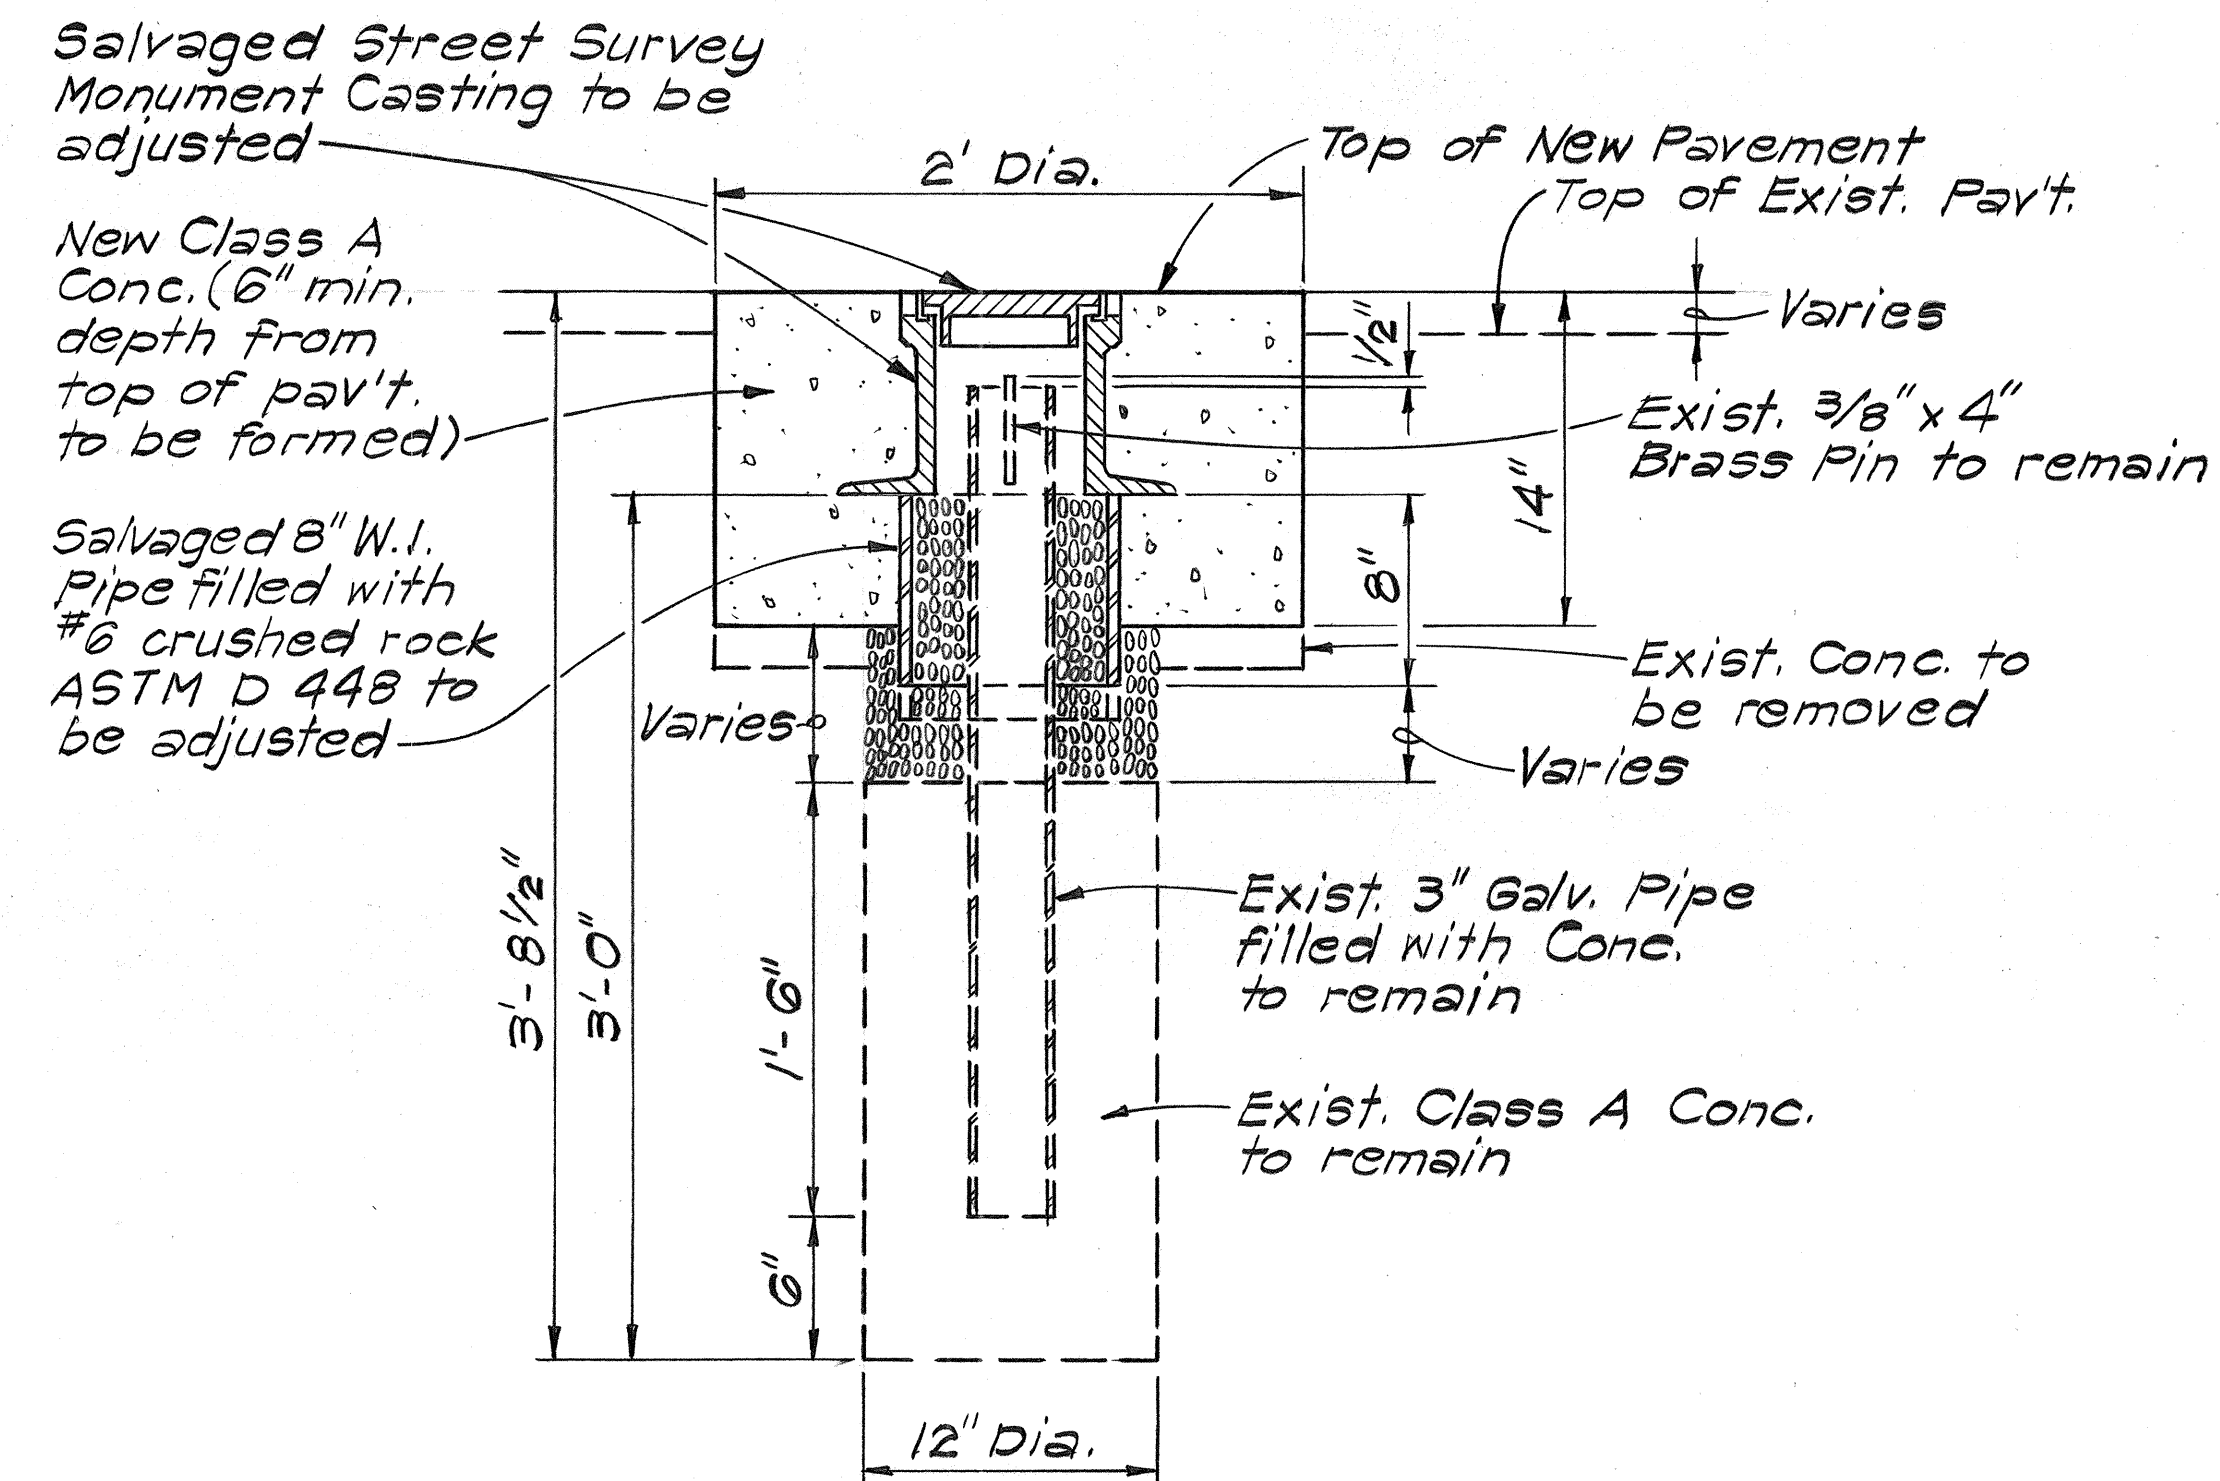

TYPICAL STREET SURVEY MONUMENT ADJUSTMENT

Not to Scale

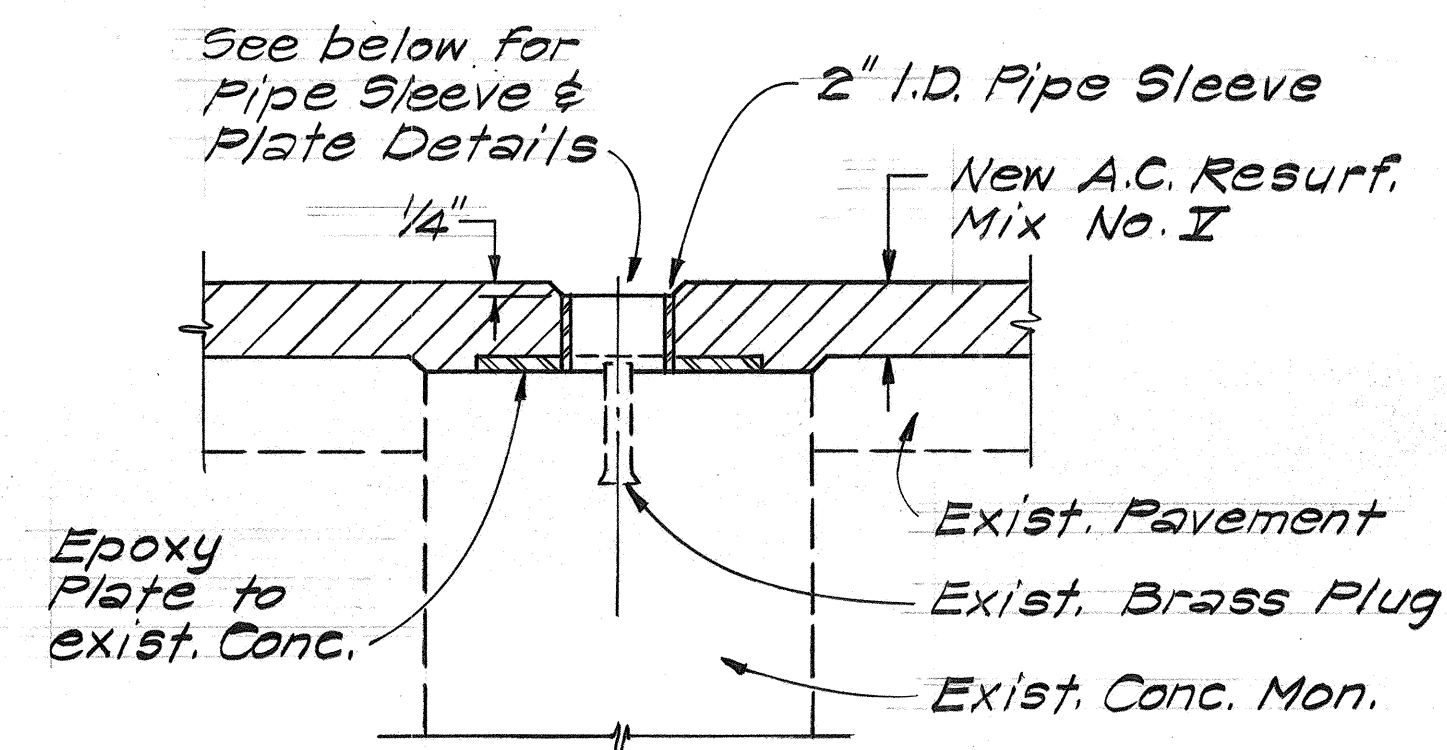

SECTION THRU MONUMENT

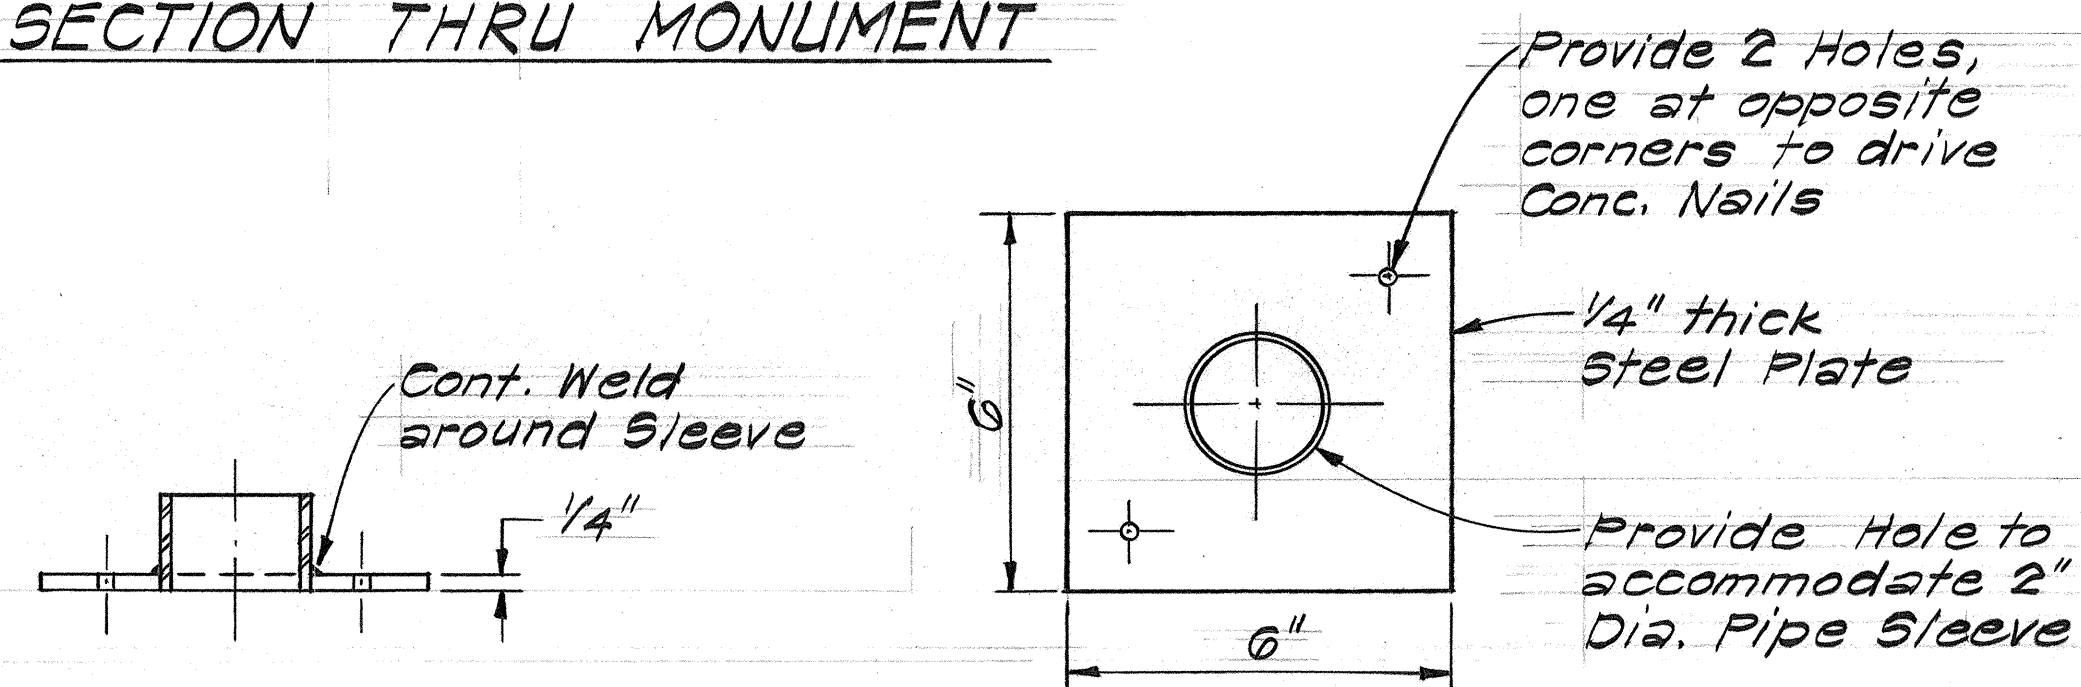


PLATE ELEVATION

PLATE PLAN

DETAIL FOR ADJUSTMENT OF ϕ MONUMENT

Not to Scale

DATE	_____
SURVEY PLOTTED BY	_____
DRAWN BY	_____
TRACED BY	_____
DESIGNED BY	_____
CHECKED BY	_____
ORIGINAL PLAN	_____
NOTE BOOK	_____
No.	_____

STATE OF HAWAII
DEPARTMENT OF TRANSPORTATION
LAND TRANSPORTATION FACILITIES DIVISION

MISCELLANEOUS DETAILS

NIMITZ HIGHWAY RESURFACING
Sand Island Access Road
Towards Fort Street
Proj. No. 22A-01-78M

Scale: As Shown Date: July, 1978

SHEET NO. 3 D OF 3 SHEETS