

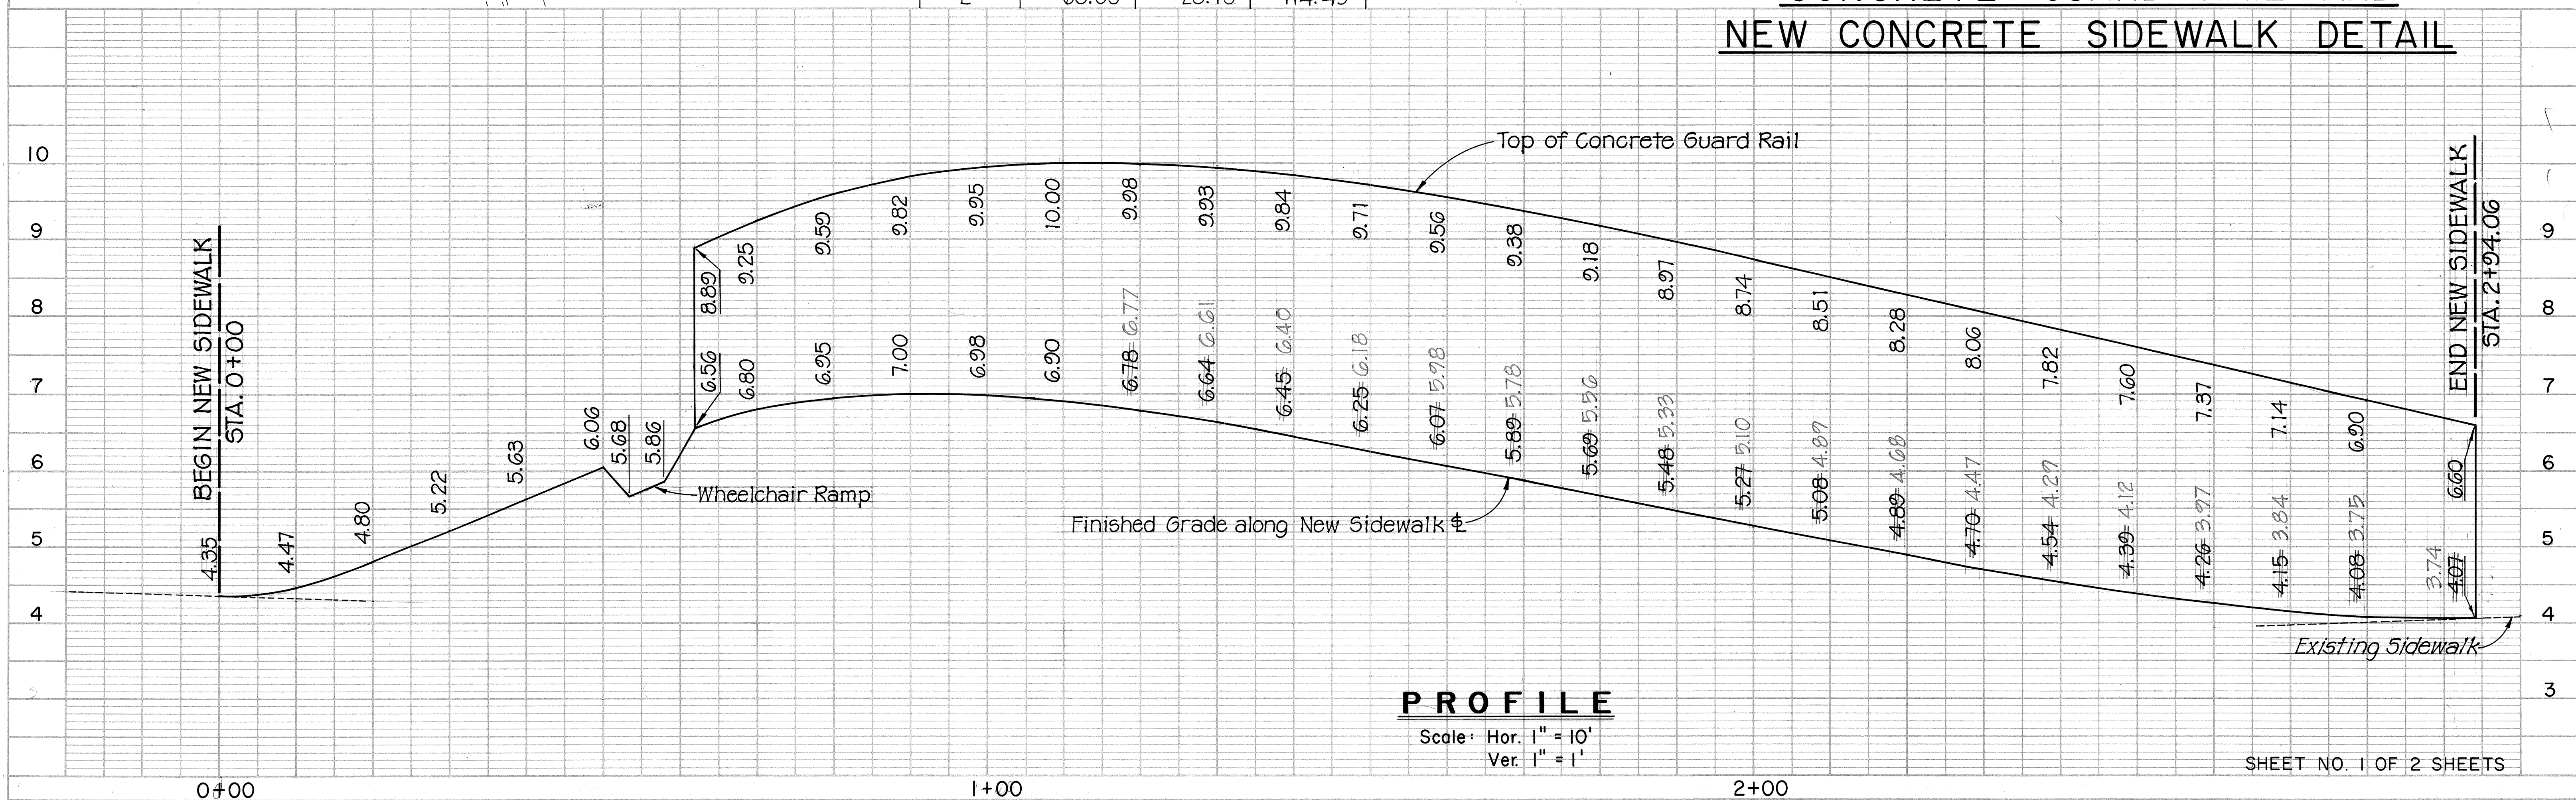
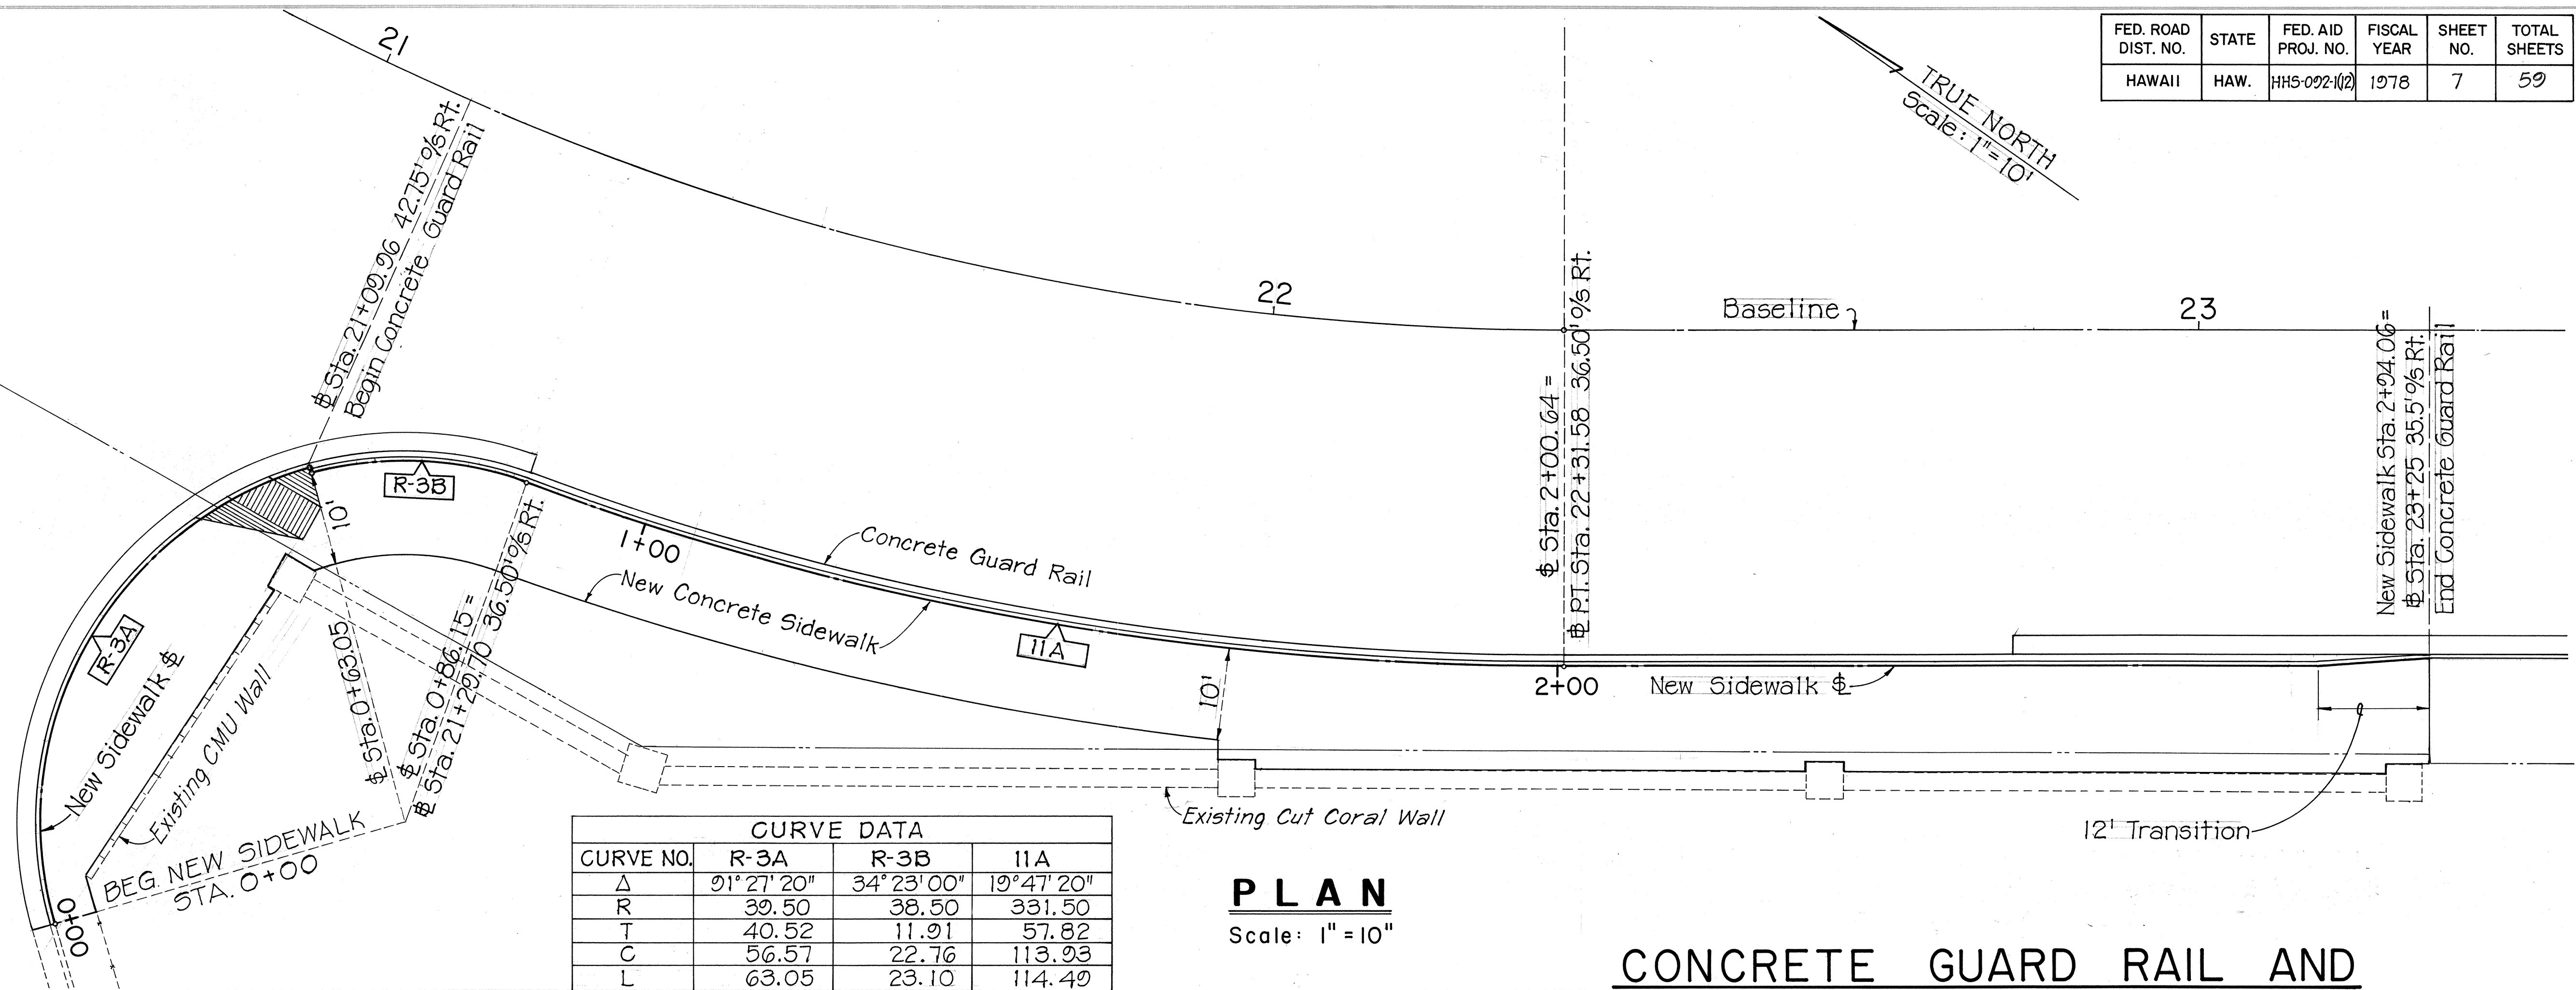
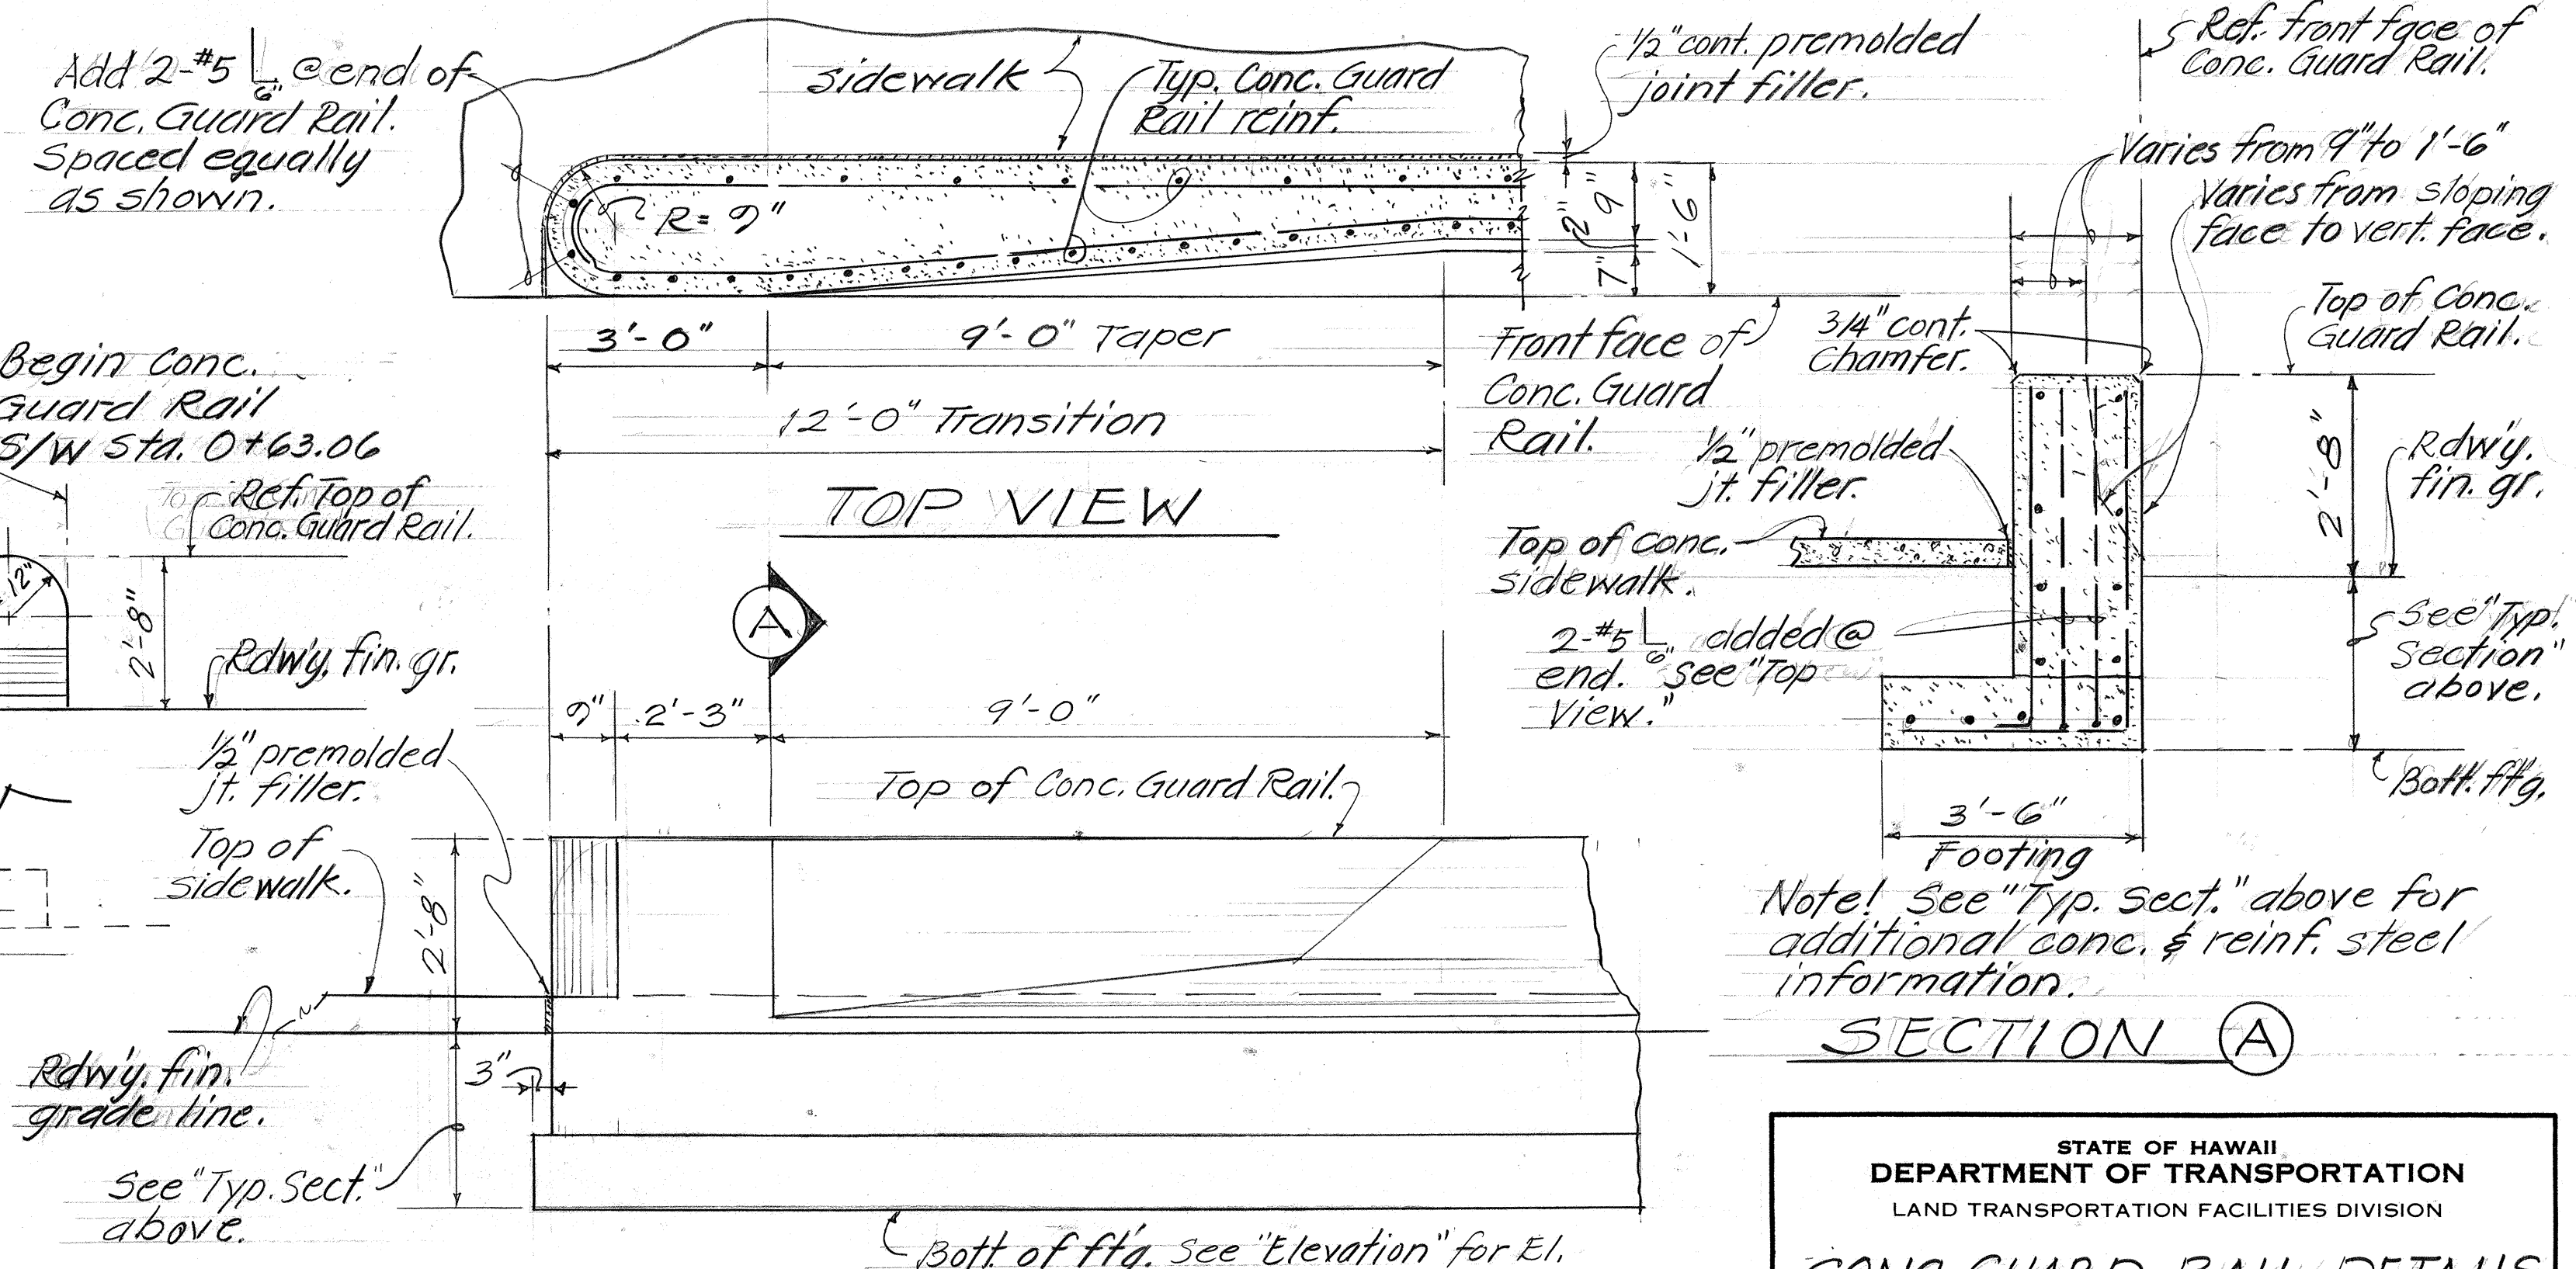
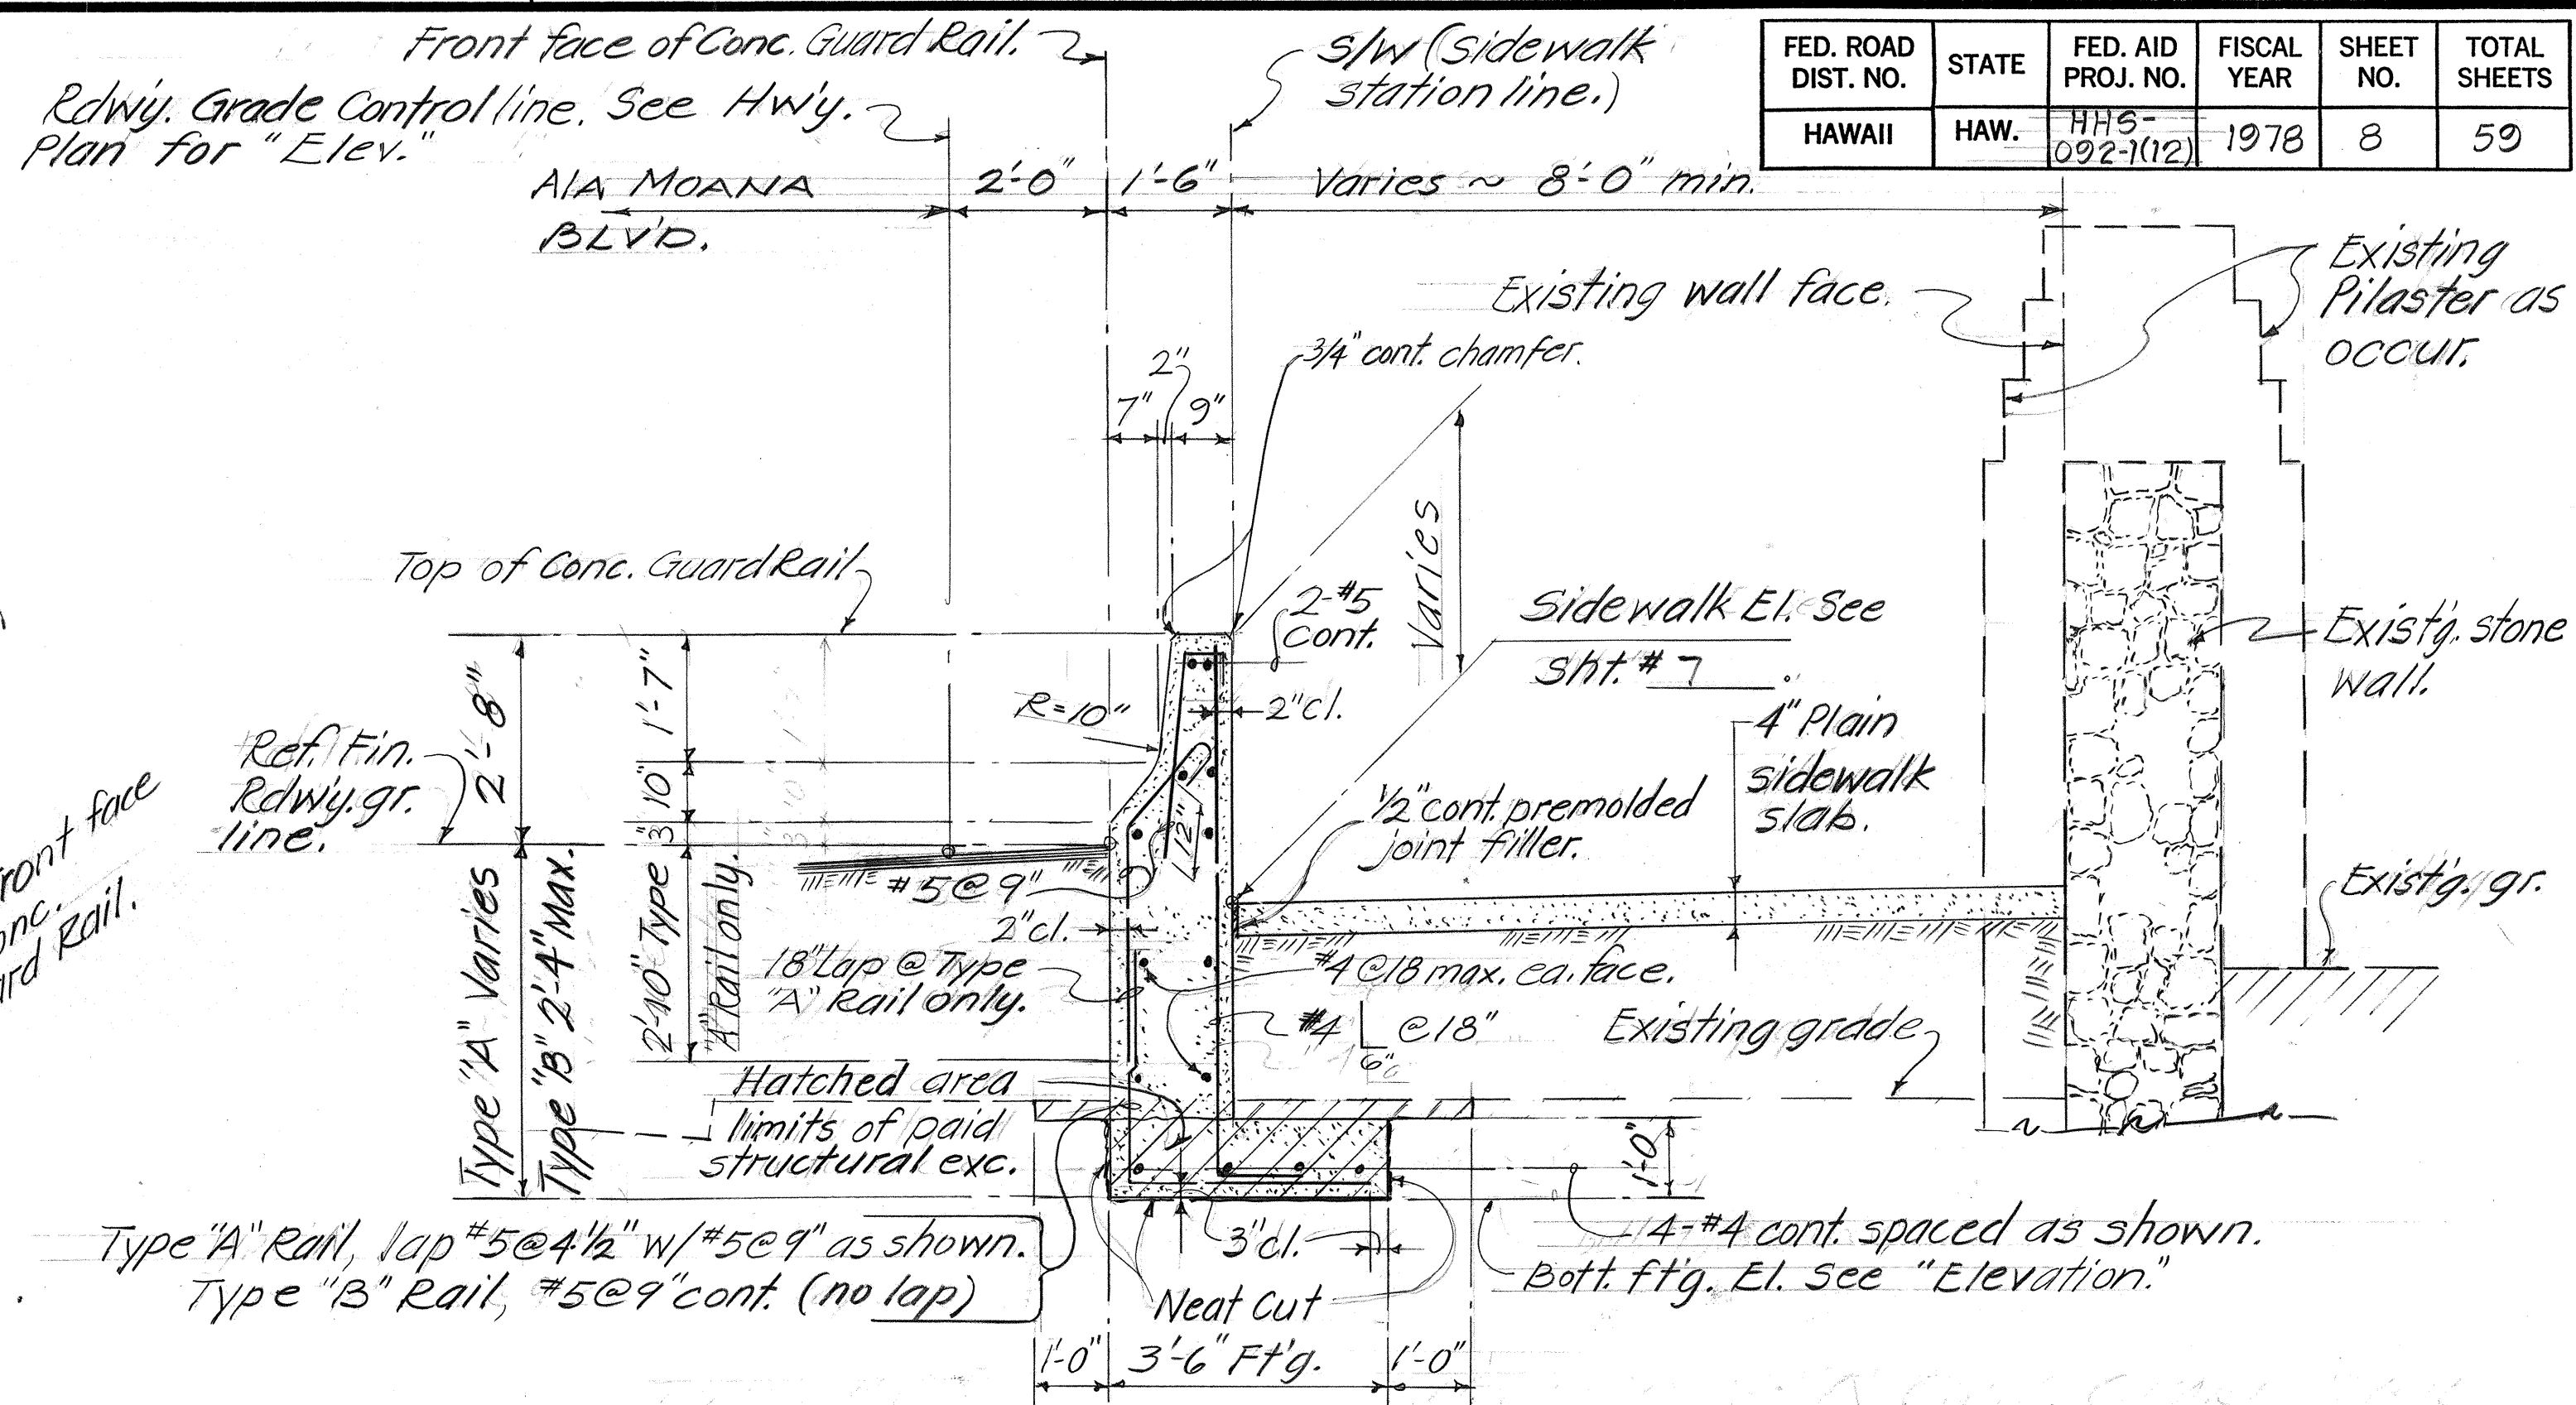


FED. ROAD DIST. NO.	STATE	FED. AID PROJ. NO.	FISCAL YEAR	SHEET NO.	TOTAL SHEETS
HAWAII	HAW.	HHS-092-1(2)	1978	7	59

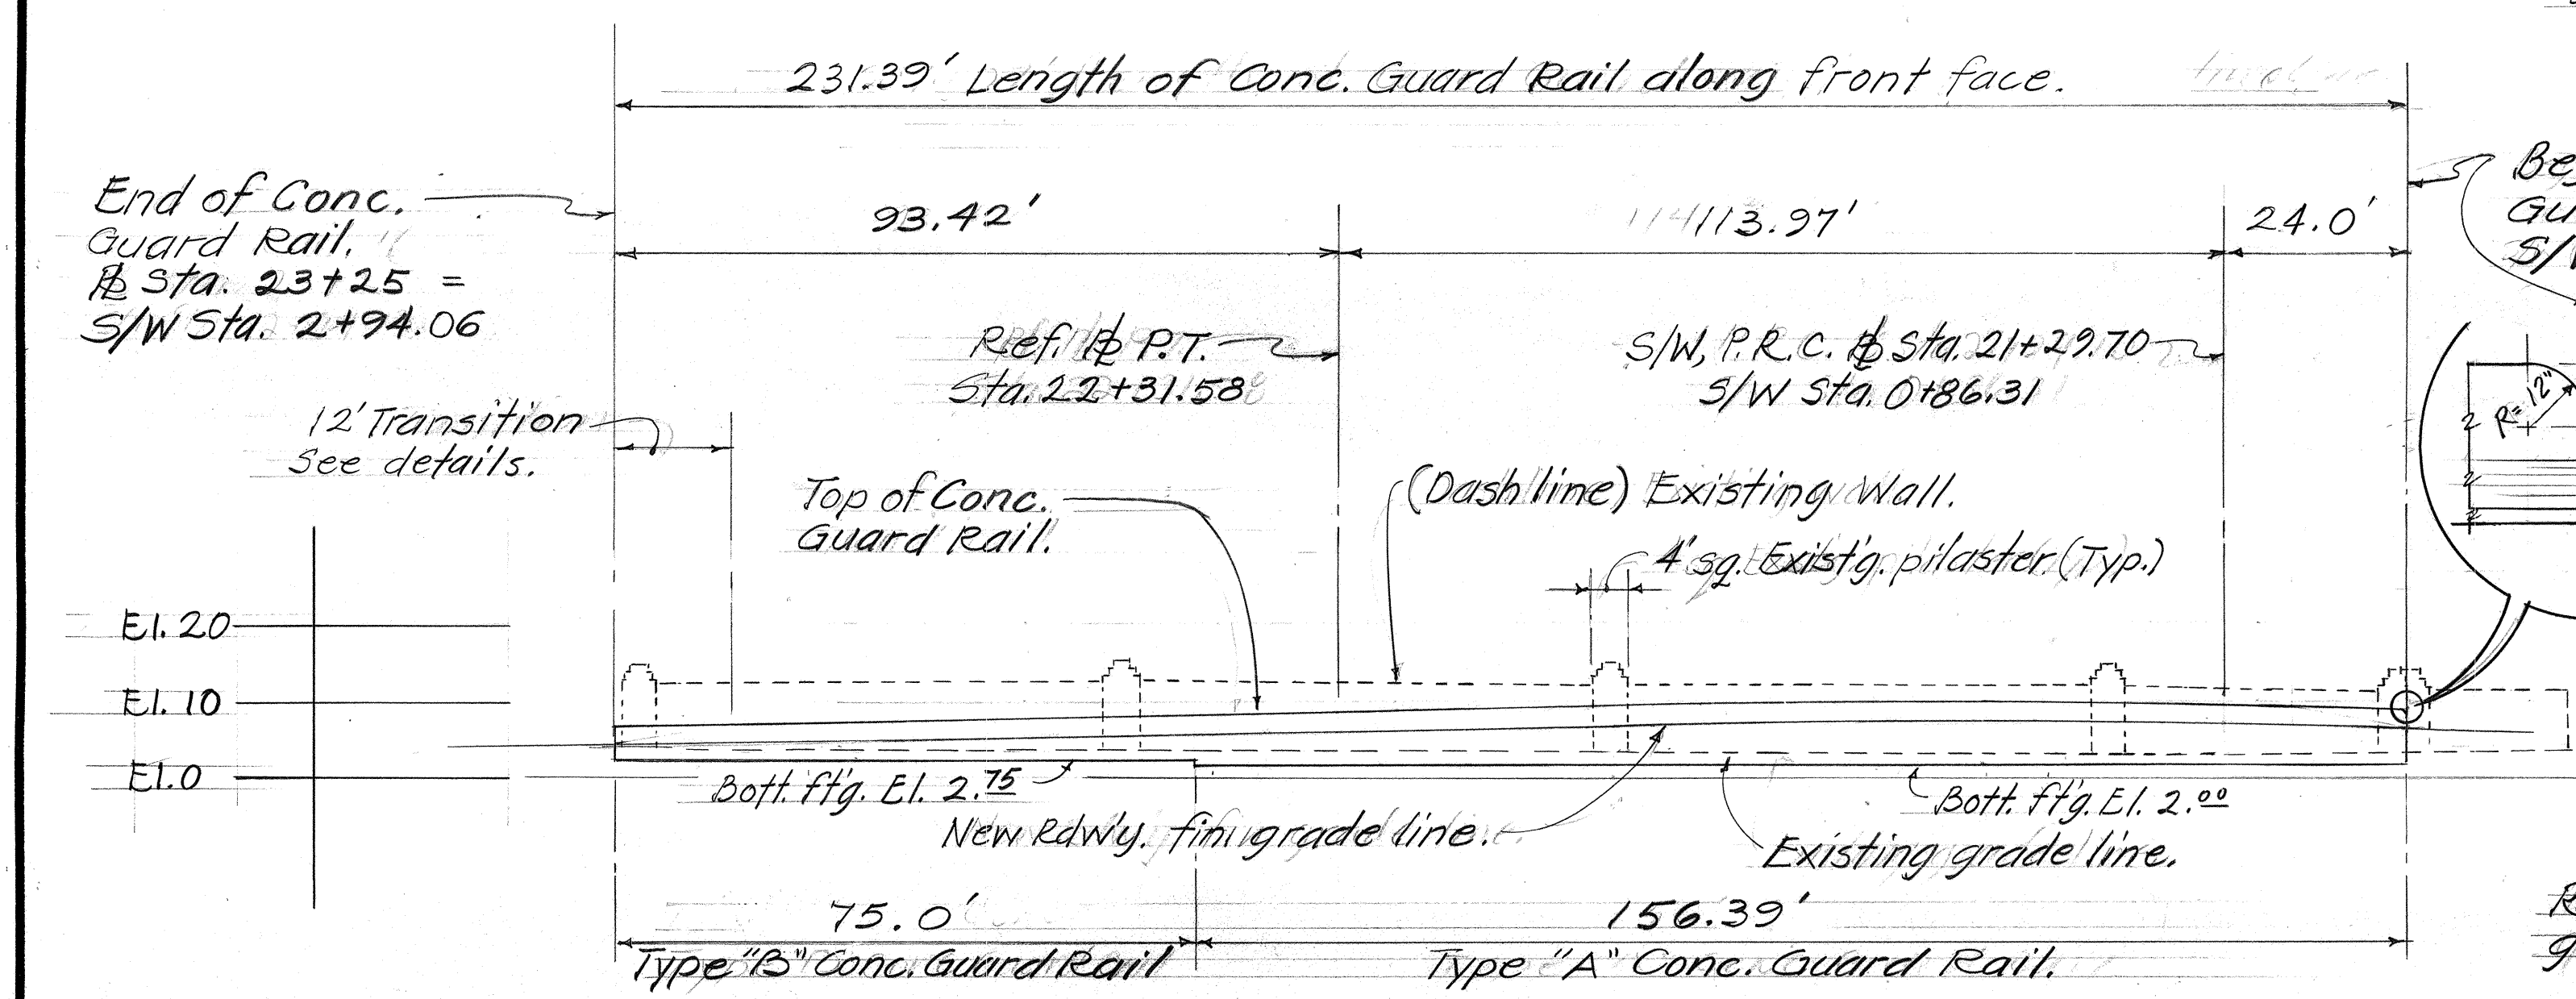

CURVE DATA (ALONG FRONT FACE)		
CURVE NO.	11	R-3C
Δ	19° 47' 15"	34° 23' 00"
R	330.00'	40.00'
L	113.97'	24.00'

FED. ROAD DIST. NO.	STATE	FED. AID PROJ. NO.	FISCAL YEAR	SHEET NO.	TOTAL SHEETS
HAWAII	HAW.	HHS-092-1(12)	1978	8	59

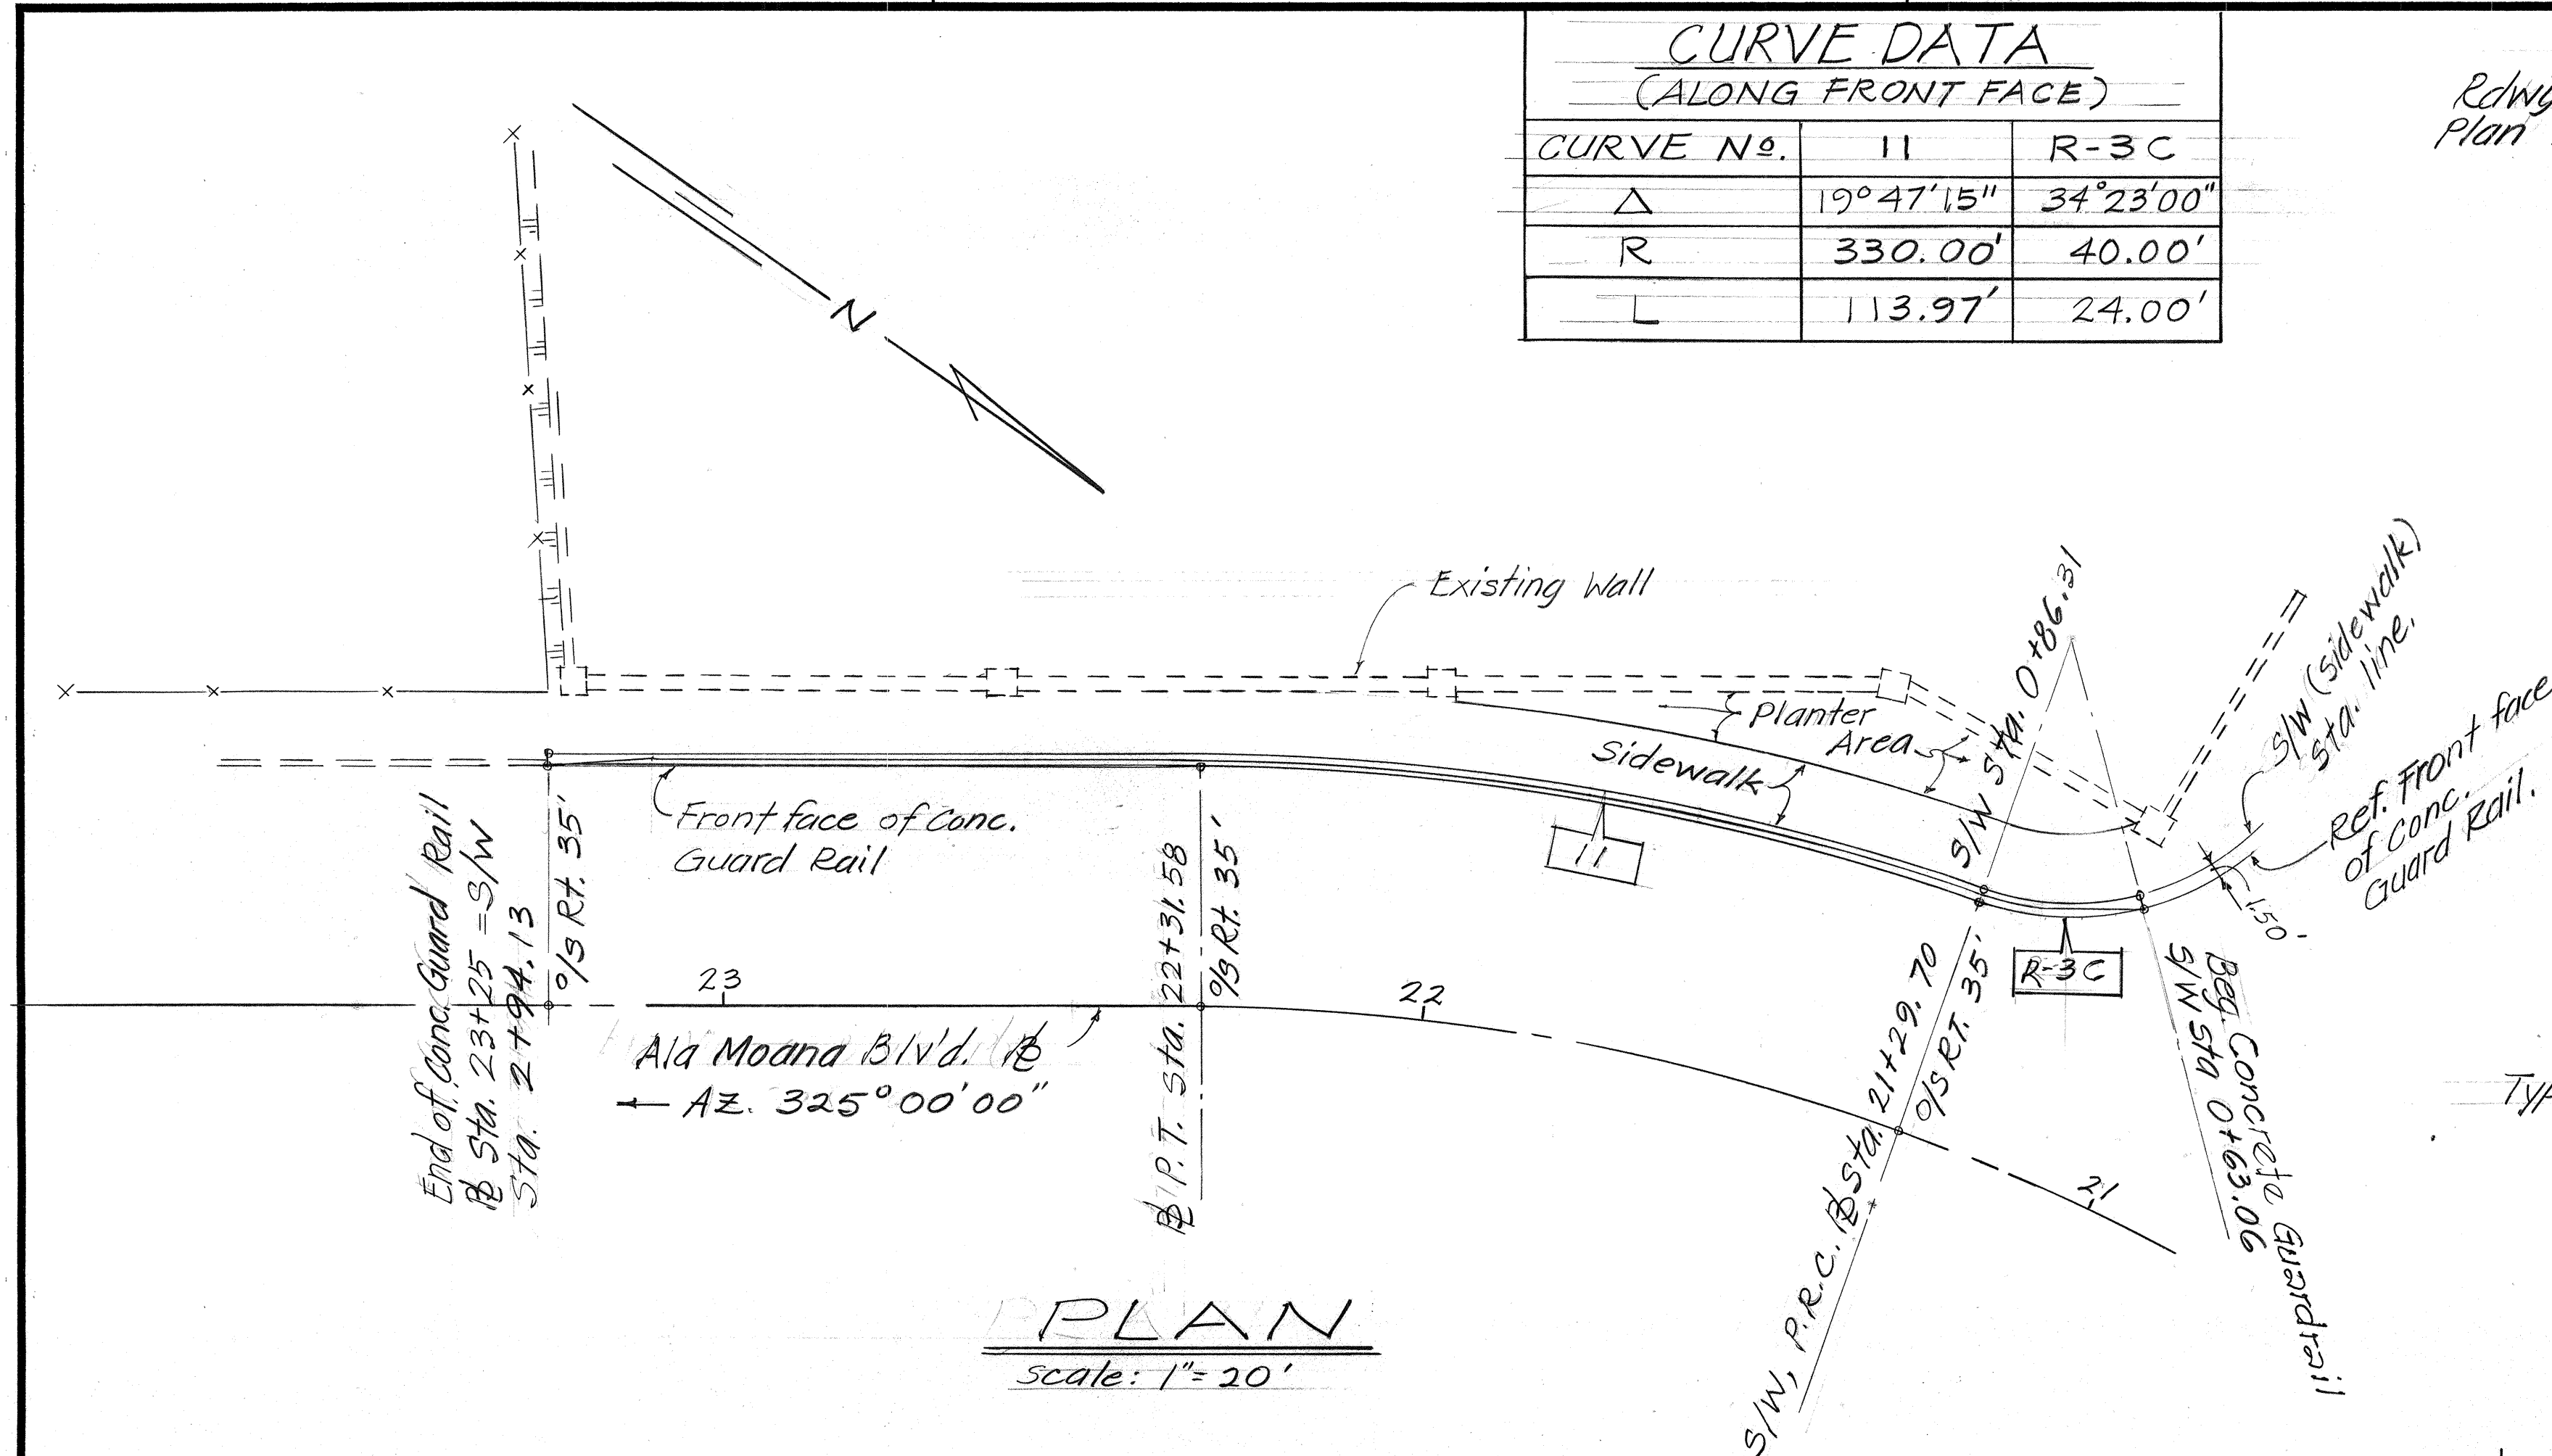

STATE OF HAWAII
DEPARTMENT OF TRANSPORTATION
LAND TRANSPORTATION FACILITIES DIVISION

CONC. GUARD RAIL DETAILS
ALA MOANA BLVD.
SAFETY IMPROVEMENTS
SOUTH ST. TO KEAWE ST.
PROJ. No. HHS-092-1(12)
Scale As Shown Date: April, 1978

SHEET No. 2 OF 2 SHEETS

DATE: _____
SURVEY PLOTTED BY: _____
DRAWN BY: _____
DESIGNED BY: _____
CHECKED BY: _____
ORIGINAL PLAN No. _____
NOTE BOOK No. _____

C-4-7