



FINAL	SURVEYED	DATE
SURVEY	PLOTTED	BY
NOTE BOOK	TEMPLATE	
NO.	AREAS CHECKED	

ORIGINAL	SURVEYED	DATE
SURVEY	PLOTTED	BY
NOTE BOOK	TEMPLATE	
NO.	AREAS CHECKED	

FED. ROAD DIST. NO.	STATE	FED. AID PROJ. NO.	FISCAL YEAR	SHEET NO.	TOTAL SHEETS
HAWAII	HAW.	HHG-092-1(12)	1978	56	59

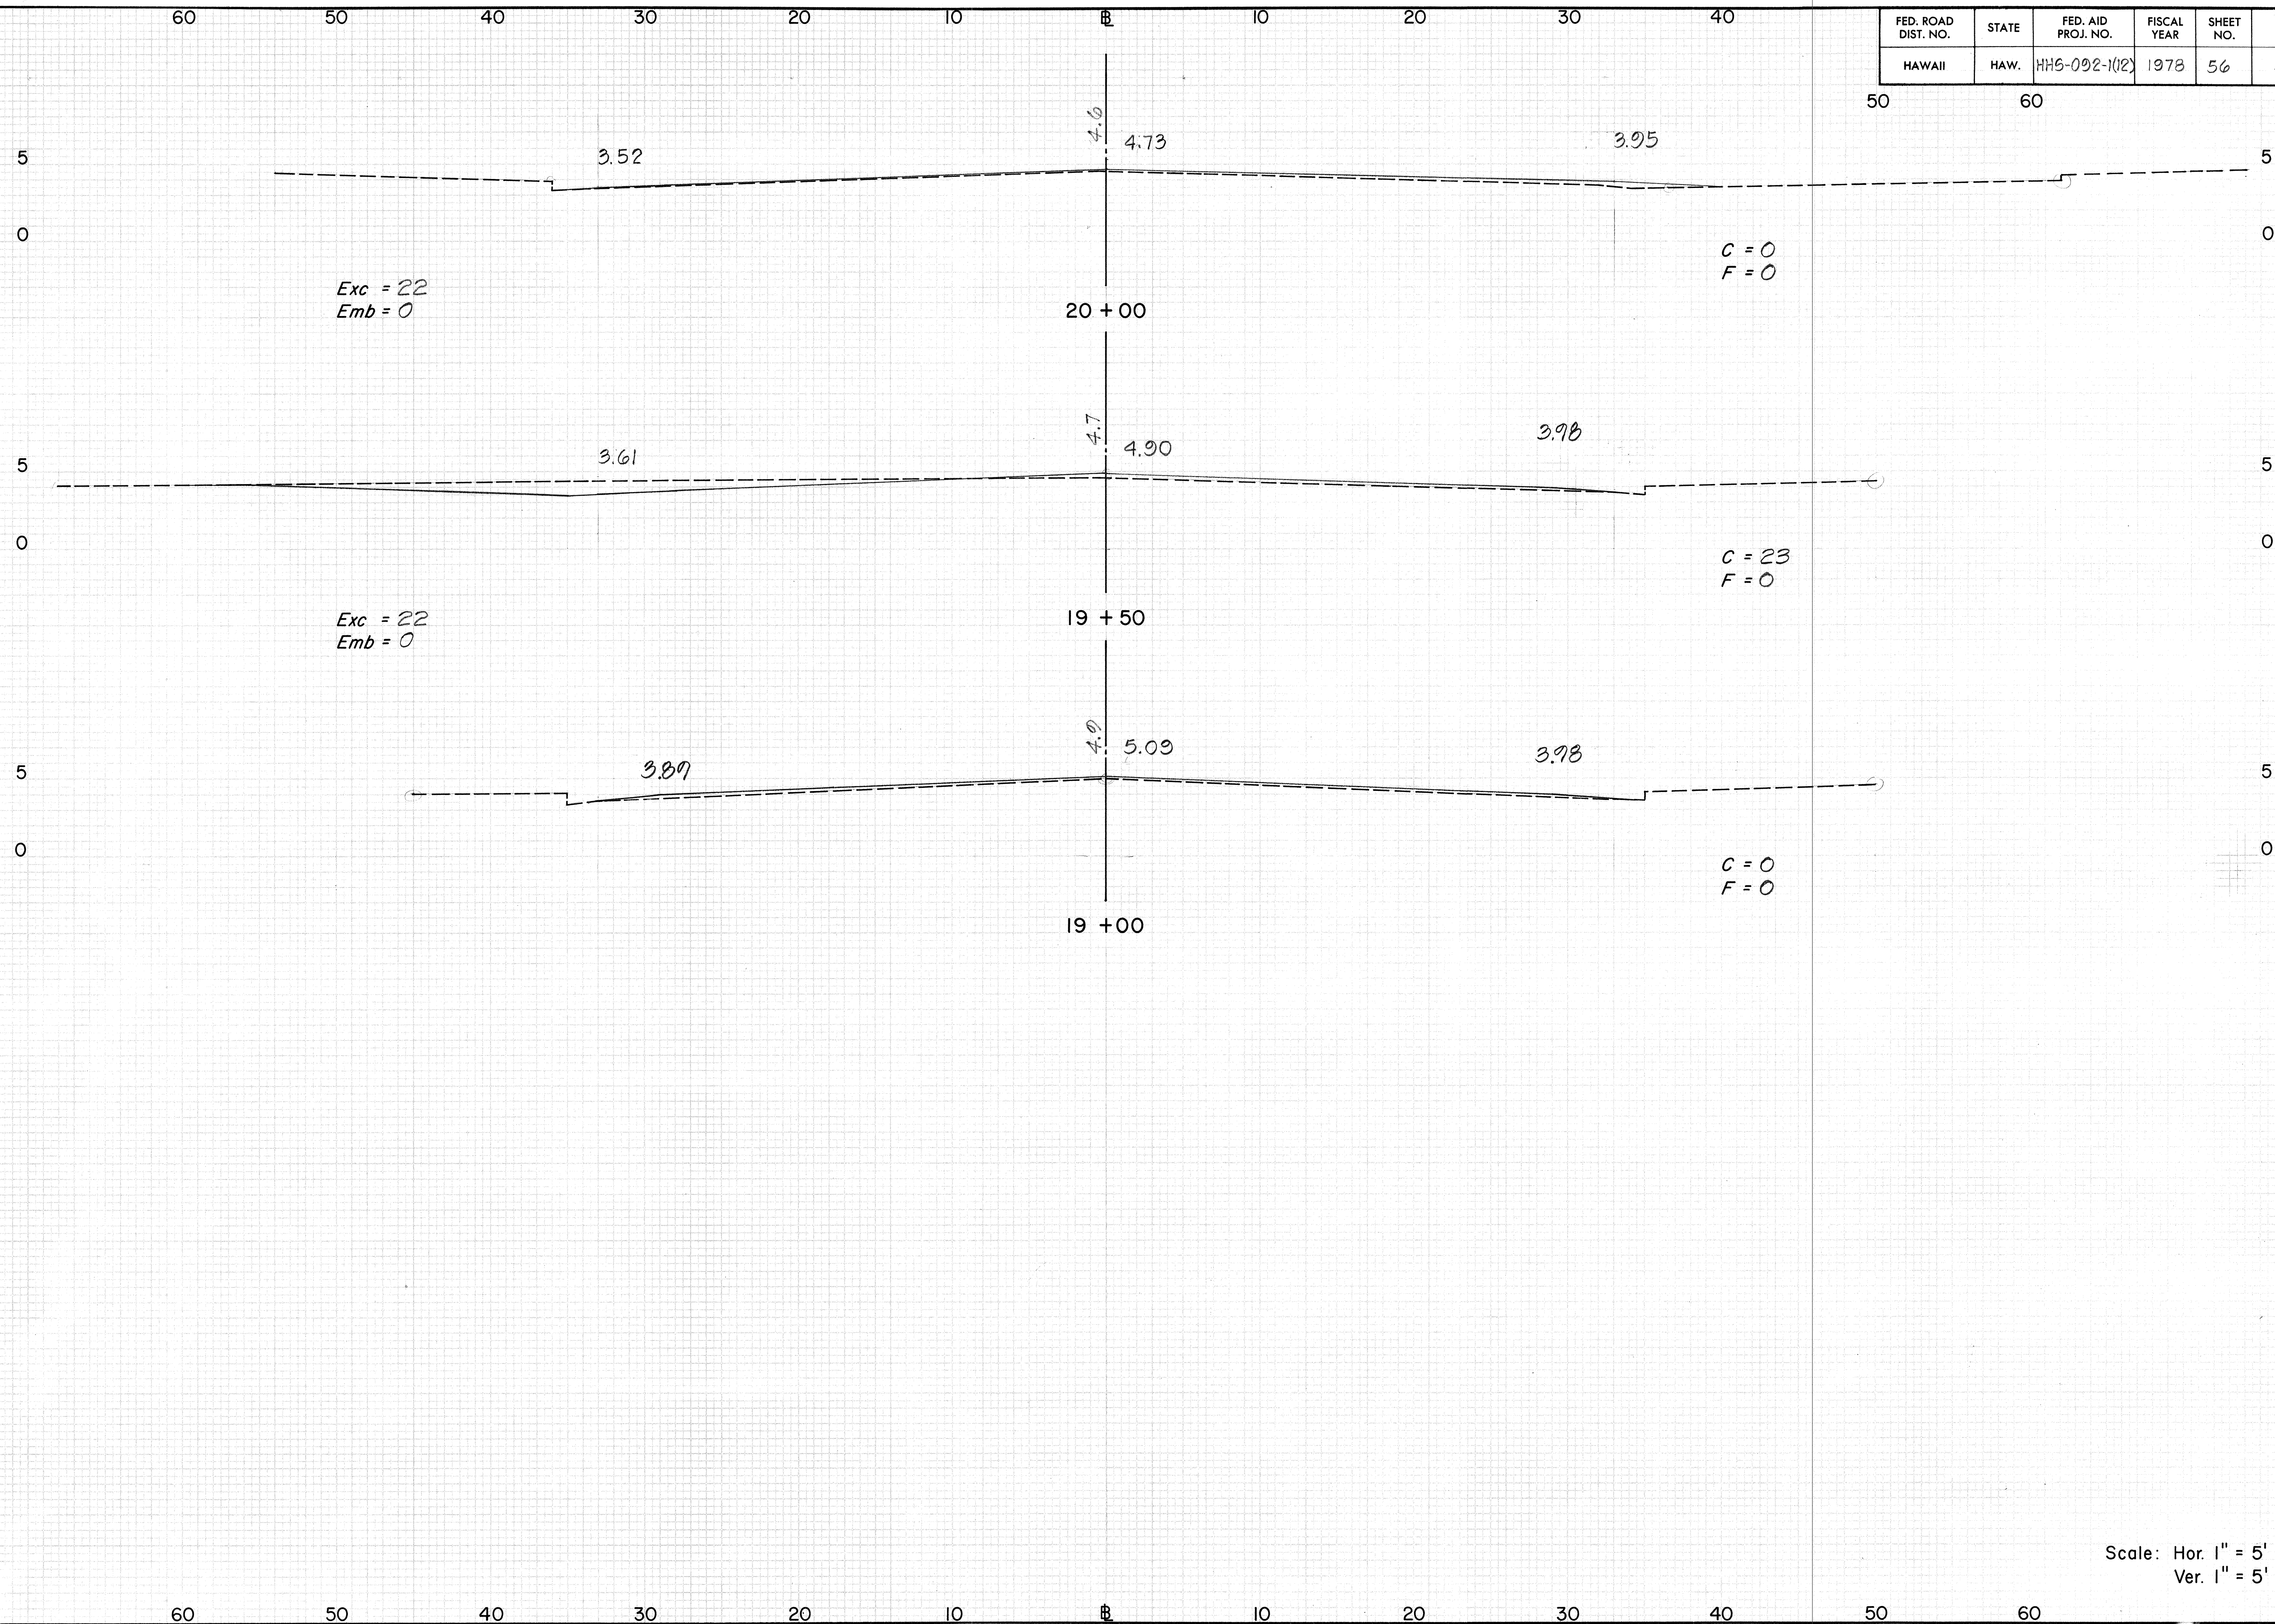

FED. ROAD DIST. NO.	STATE	FED. AID PROJ. NO.	FISCAL YEAR	SHEET NO.	TOTAL SHEETS
HAWAII	HAW.	HH5-002-1(12)	1978	57	59

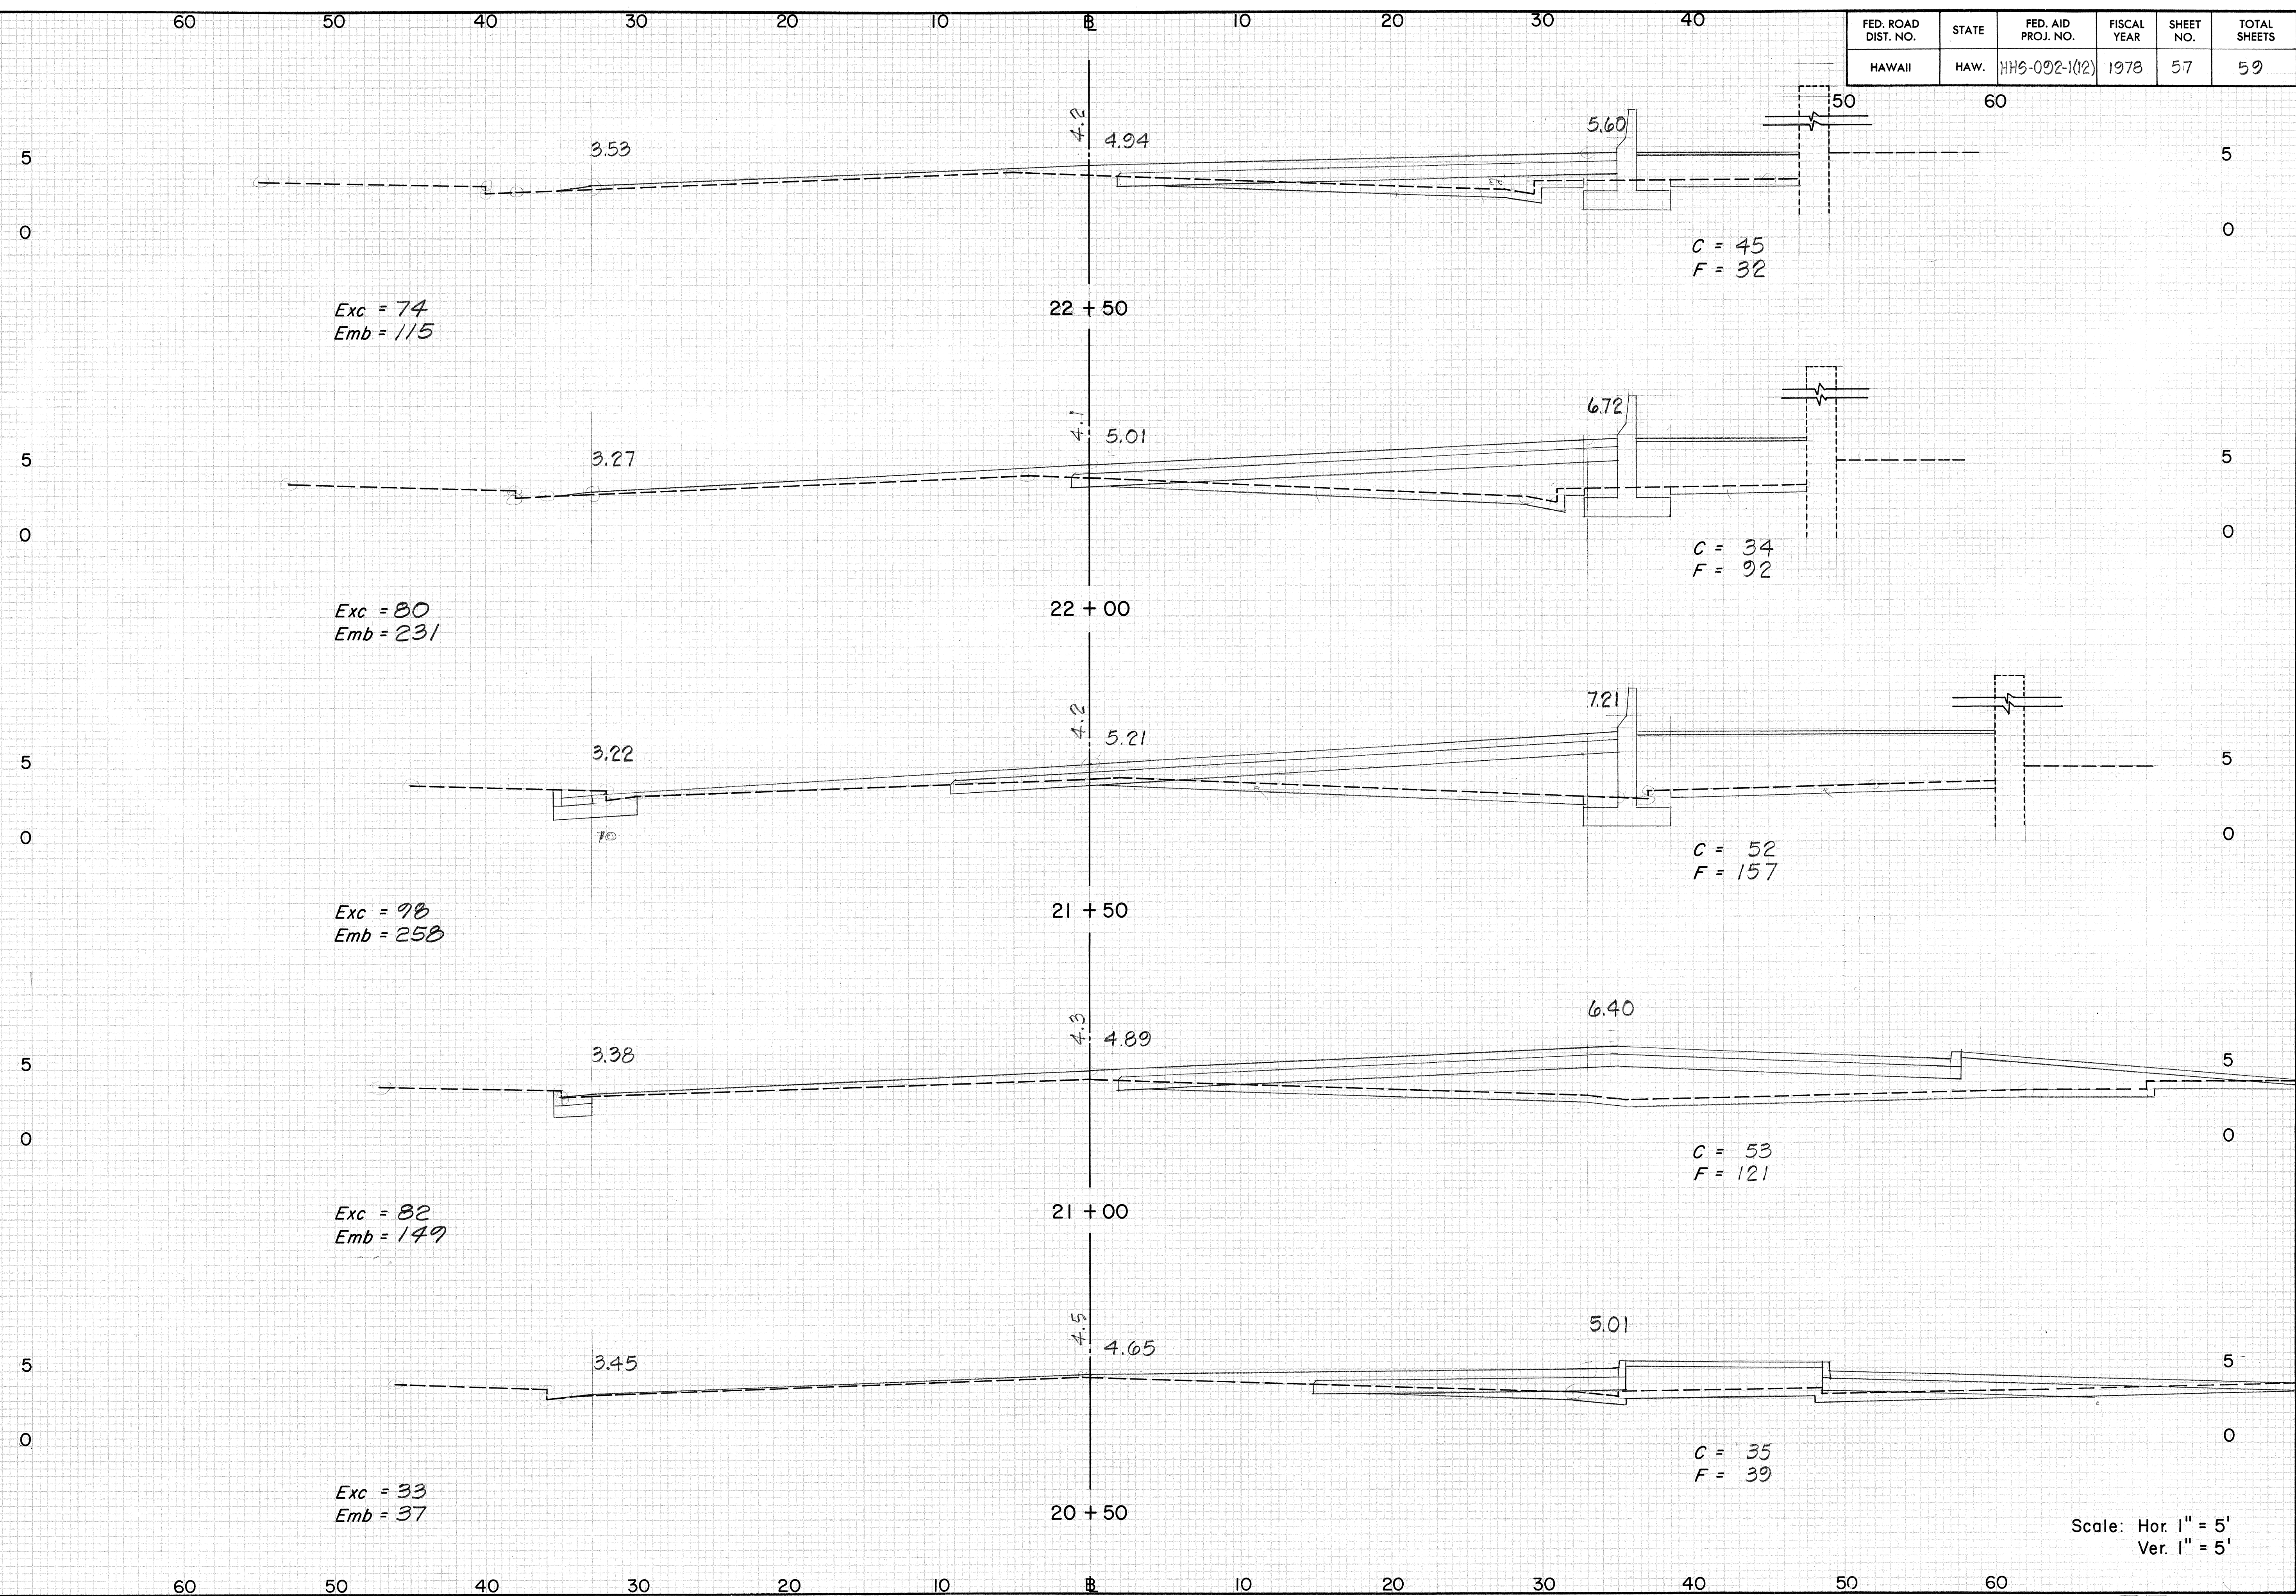

Scale: Hor. 1" = 5'
Ver. 1" = 5'

DATE	BY	DATE	BY
ORIGINAL SURVEY	FINAL SURVEY	ORIGINAL SURVEY	FINAL SURVEY
NOTE BOOK	NOTE BOOK	NOTE BOOK	NOTE BOOK
AREAS CHECKED	AREAS CHECKED	AREAS CHECKED	AREAS CHECKED

DATE	BY	DATE	BY
ORIGINAL SURVEY	FINAL SURVEY	ORIGINAL SURVEY	FINAL SURVEY
NOTE BOOK	NOTE BOOK	NOTE BOOK	NOTE BOOK
AREAS CHECKED	AREAS CHECKED	AREAS CHECKED	AREAS CHECKED

FED. ROAD DIST. NO.	STATE	FED. AID PROJ. NO.	FISCAL YEAR	SHEET NO.	TOTAL SHEETS
HAWAII	HAW.	HH6-092-1(12)	1978	58	59

