

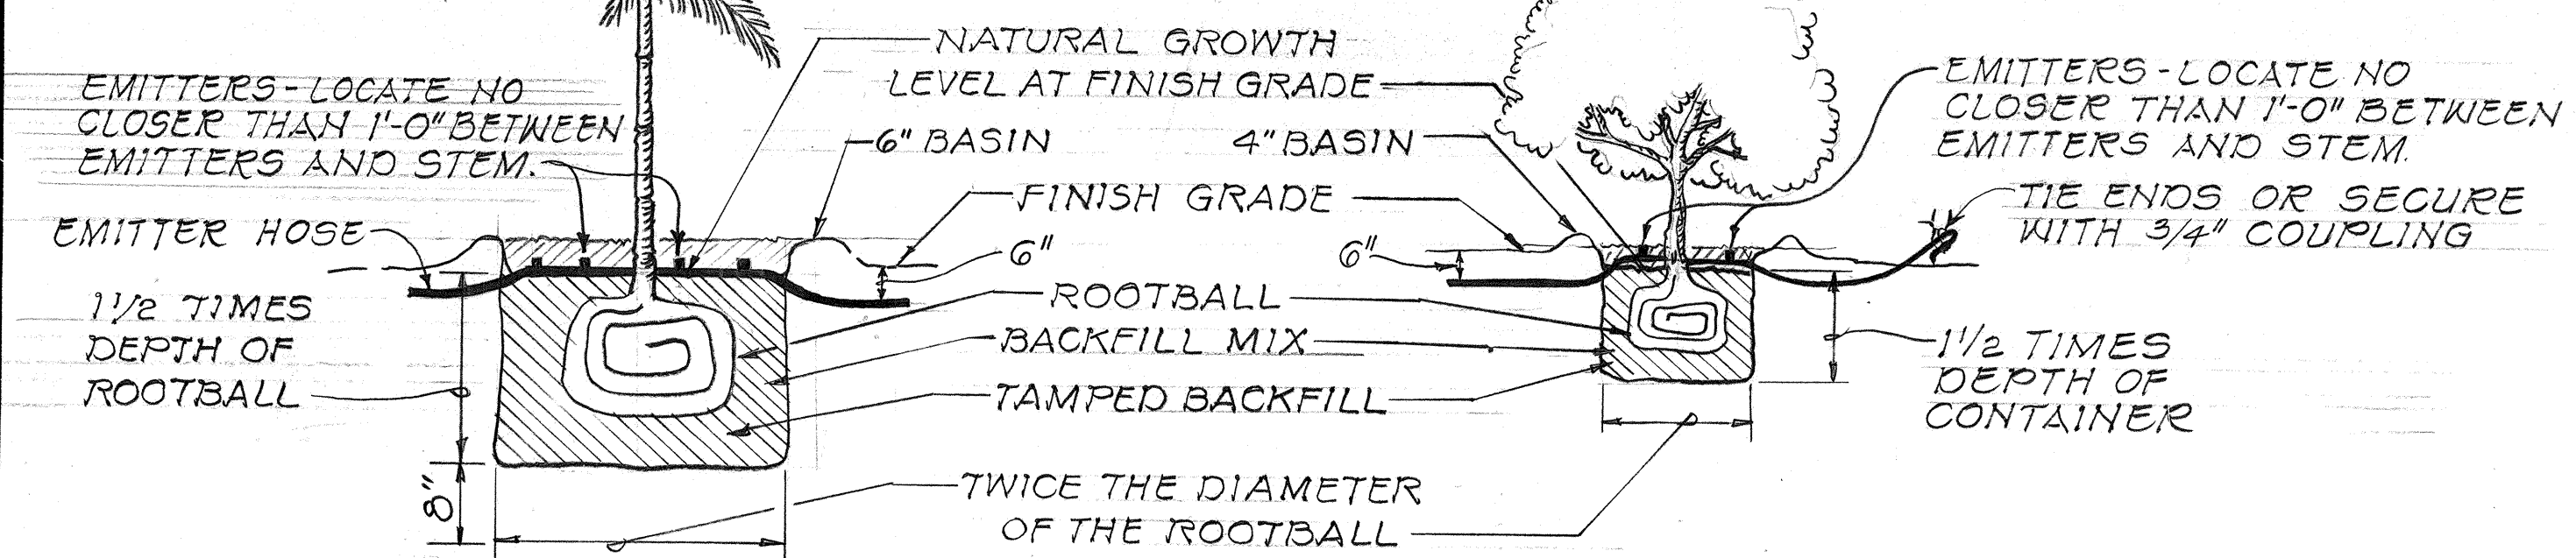


FED. ROAD DIST. NO.	STATE	FED. AID PROJ. NO.	FISCAL YEAR	SHEET NO.	TOTAL SHEETS
HAWAII	HAW.	HHS-092-1(12)	1978	55	50

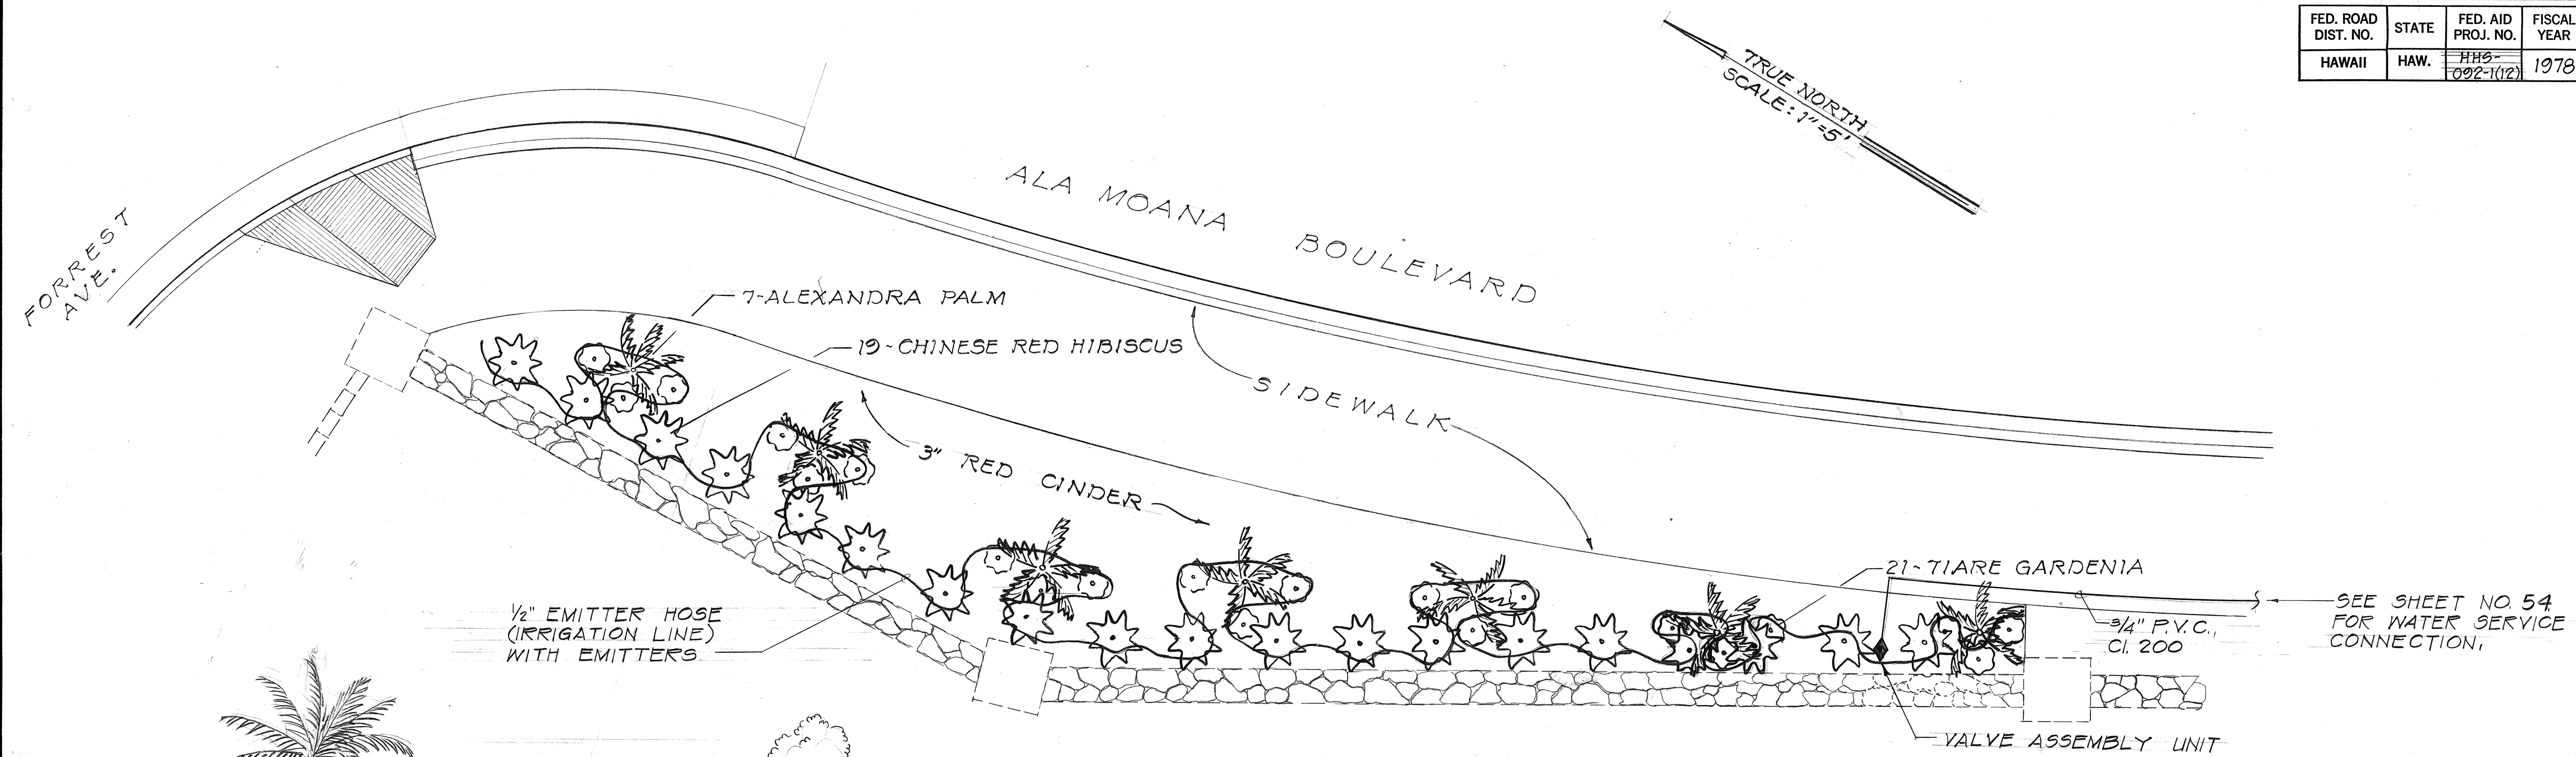

- NOTE: 1. PVC PIPE AND EMITTER HOSE SHALL CONFORM TO SECTION 712.16 POLY-VINYL CHLORIDE (PVC) PIPE AND FITTINGS OF THE SPECIAL PROVISIONS. INSTALL PER MANUFACTURER'S RECOMMENDATION. MINIMUM COVER FOR PVC PIPE SHALL BE 12 INCHES.
2. VALVES SHALL CONFORM TO SECTION 712.13 VALVES OF THE SPECIAL PROVISIONS.
3. EMITTERS SHALL CONFORM TO SECTION 712.12 SPRINKLER HEADS (P).

TYPICAL TREE & SHRUB PLANTING DETAILS
NOT TO SCALE

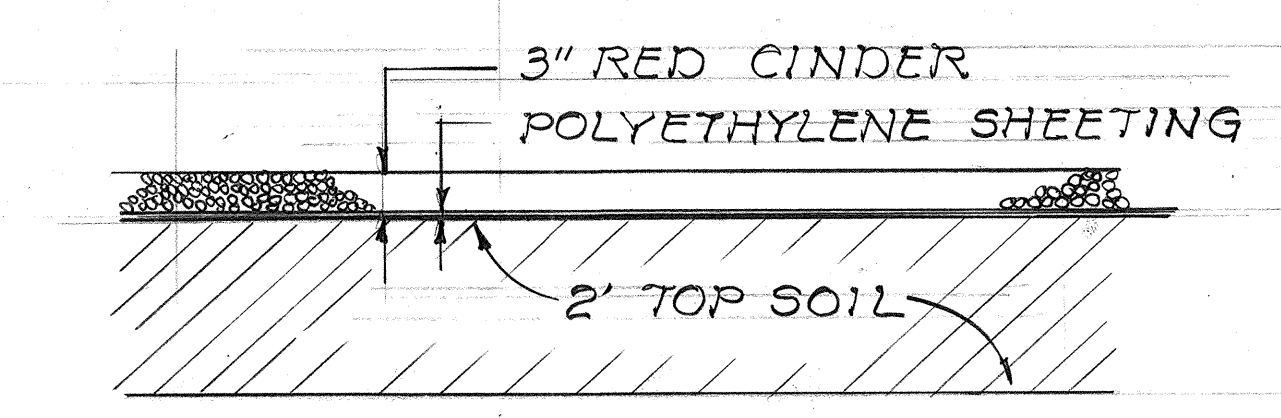

TYPICAL PLANTER SECTION

ESTIMATED QUANTITIES
 3/4" P.V.C. CI. 200 = 180 LF
 1/2" EMITTER HOSE W/EMITTERS = 240 LF
 VALVE ASSEMBLY UNIT = 1 Ea.

LANDSCAPE PLANTING SCHEDULE					
	QUANTITY	SCIENTIFIC NAME	COMMON NAME	CONDITIONS AND REMARKS	NO. OF EMITTERS PER PLANT
	7	ARCHONTOPHOENIX ALEXANDRAE VEITCHIA MERRILLI	ALEXANDRA PALM MANILA PALM	DRUM SIZE 6' TO 7' TRUNK PLANTED AT RANDOM SPACING NO STAKING	6
	19	HIBISCUS ROSA-SINENSIS	CHINESE RED HIBISCUS	2 1/2 GALLON SIZE-3'TALL PLANTED AT 5'-0" O.C. SPACING AS SHOWN	3
	21	GARDENIA TAITENSIS	TIARE GARDENIA	1 GALLON SIZE-1 1/2'TALL PLANTED AT RANDOM SPACING AS SHOWN	3

DATE: _____
 DESIGNED BY: _____
 CHECKED BY: _____
 ORIGINAL PLAN: _____
 NOTE BOOK: _____
 No. _____

STATE OF HAWAII
 DEPARTMENT OF TRANSPORTATION
 LAND TRANSPORTATION FACILITIES DIVISION
LANDSCAPE PLANTING
 ALA MOANA BLVD.
 SAFETY IMPROVEMENTS
 SOUTH ST. TO KEAWE ST.
 PROJECT NO. HHS-092-1(12)
 Scale: As Noted
 SHEET NO. 1 OF 1 SHEETS