
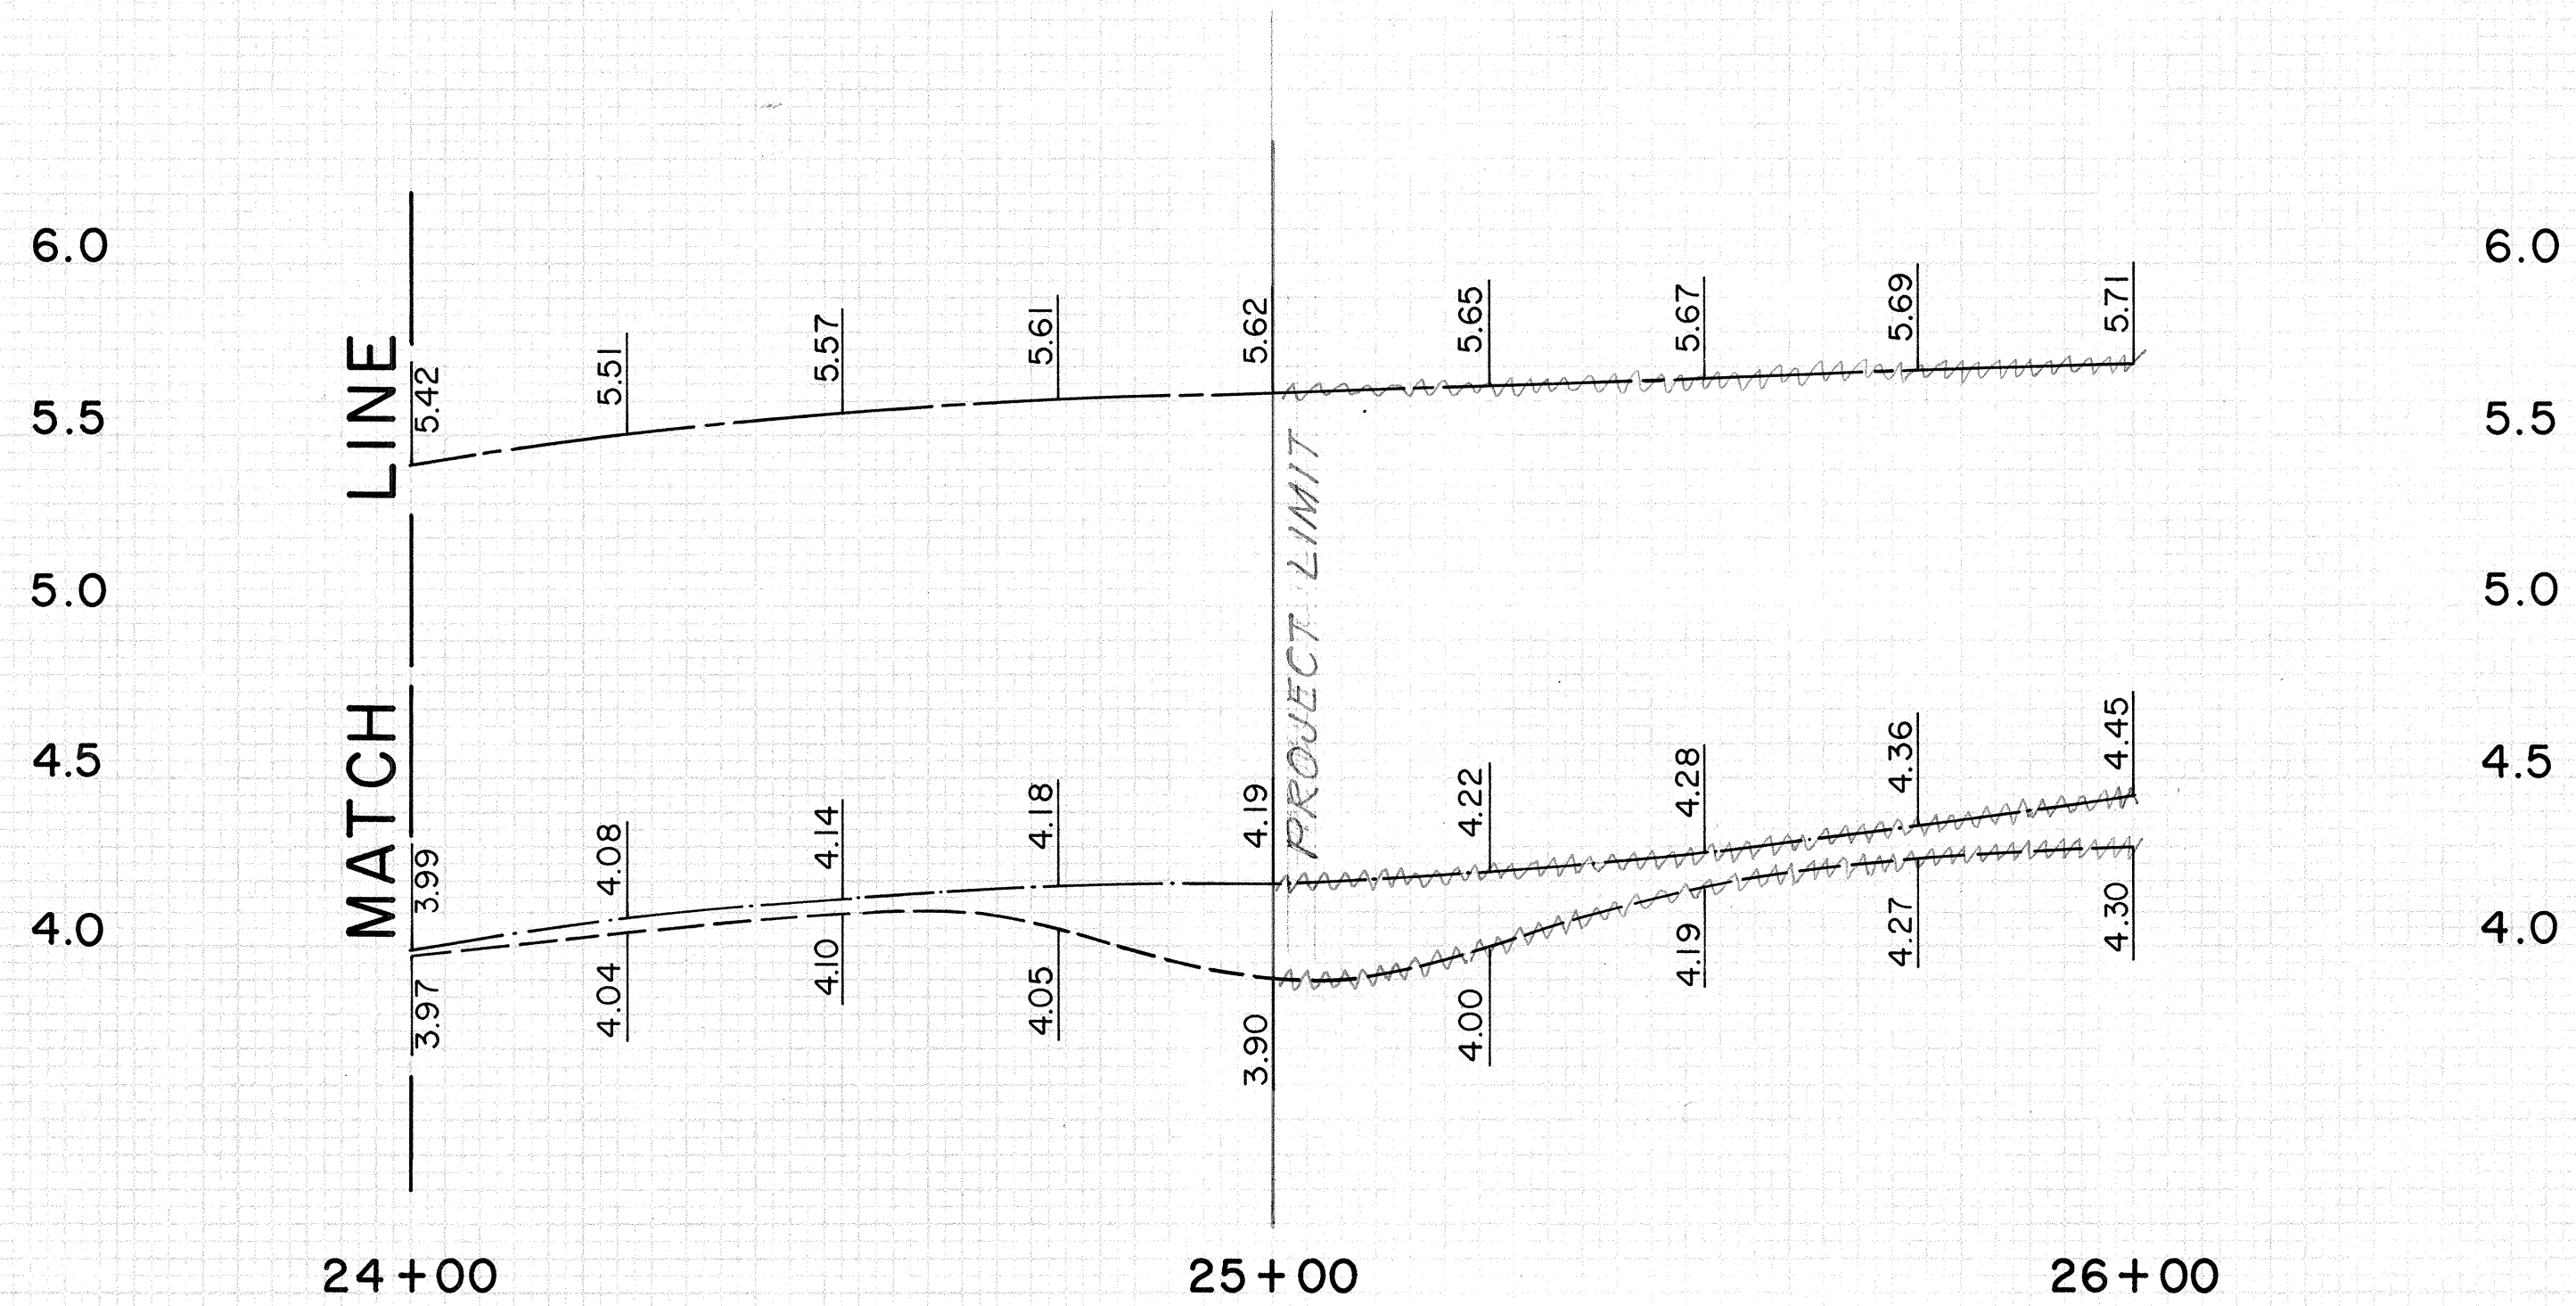


FINAL	SURVEY	DATE
NO.	AREA'S CHECKED	

ORIGINAL	SURVEY	DATE
NO.	AREA'S CHECKED	

FED. ROAD DIST. NO.	STATE	FED. AID PROJ. NO.	FISCAL YEAR	SHEET NO.	TOTAL SHEETS
HAWAII	HAW.	HHS-092-1(12)	1978	6	59

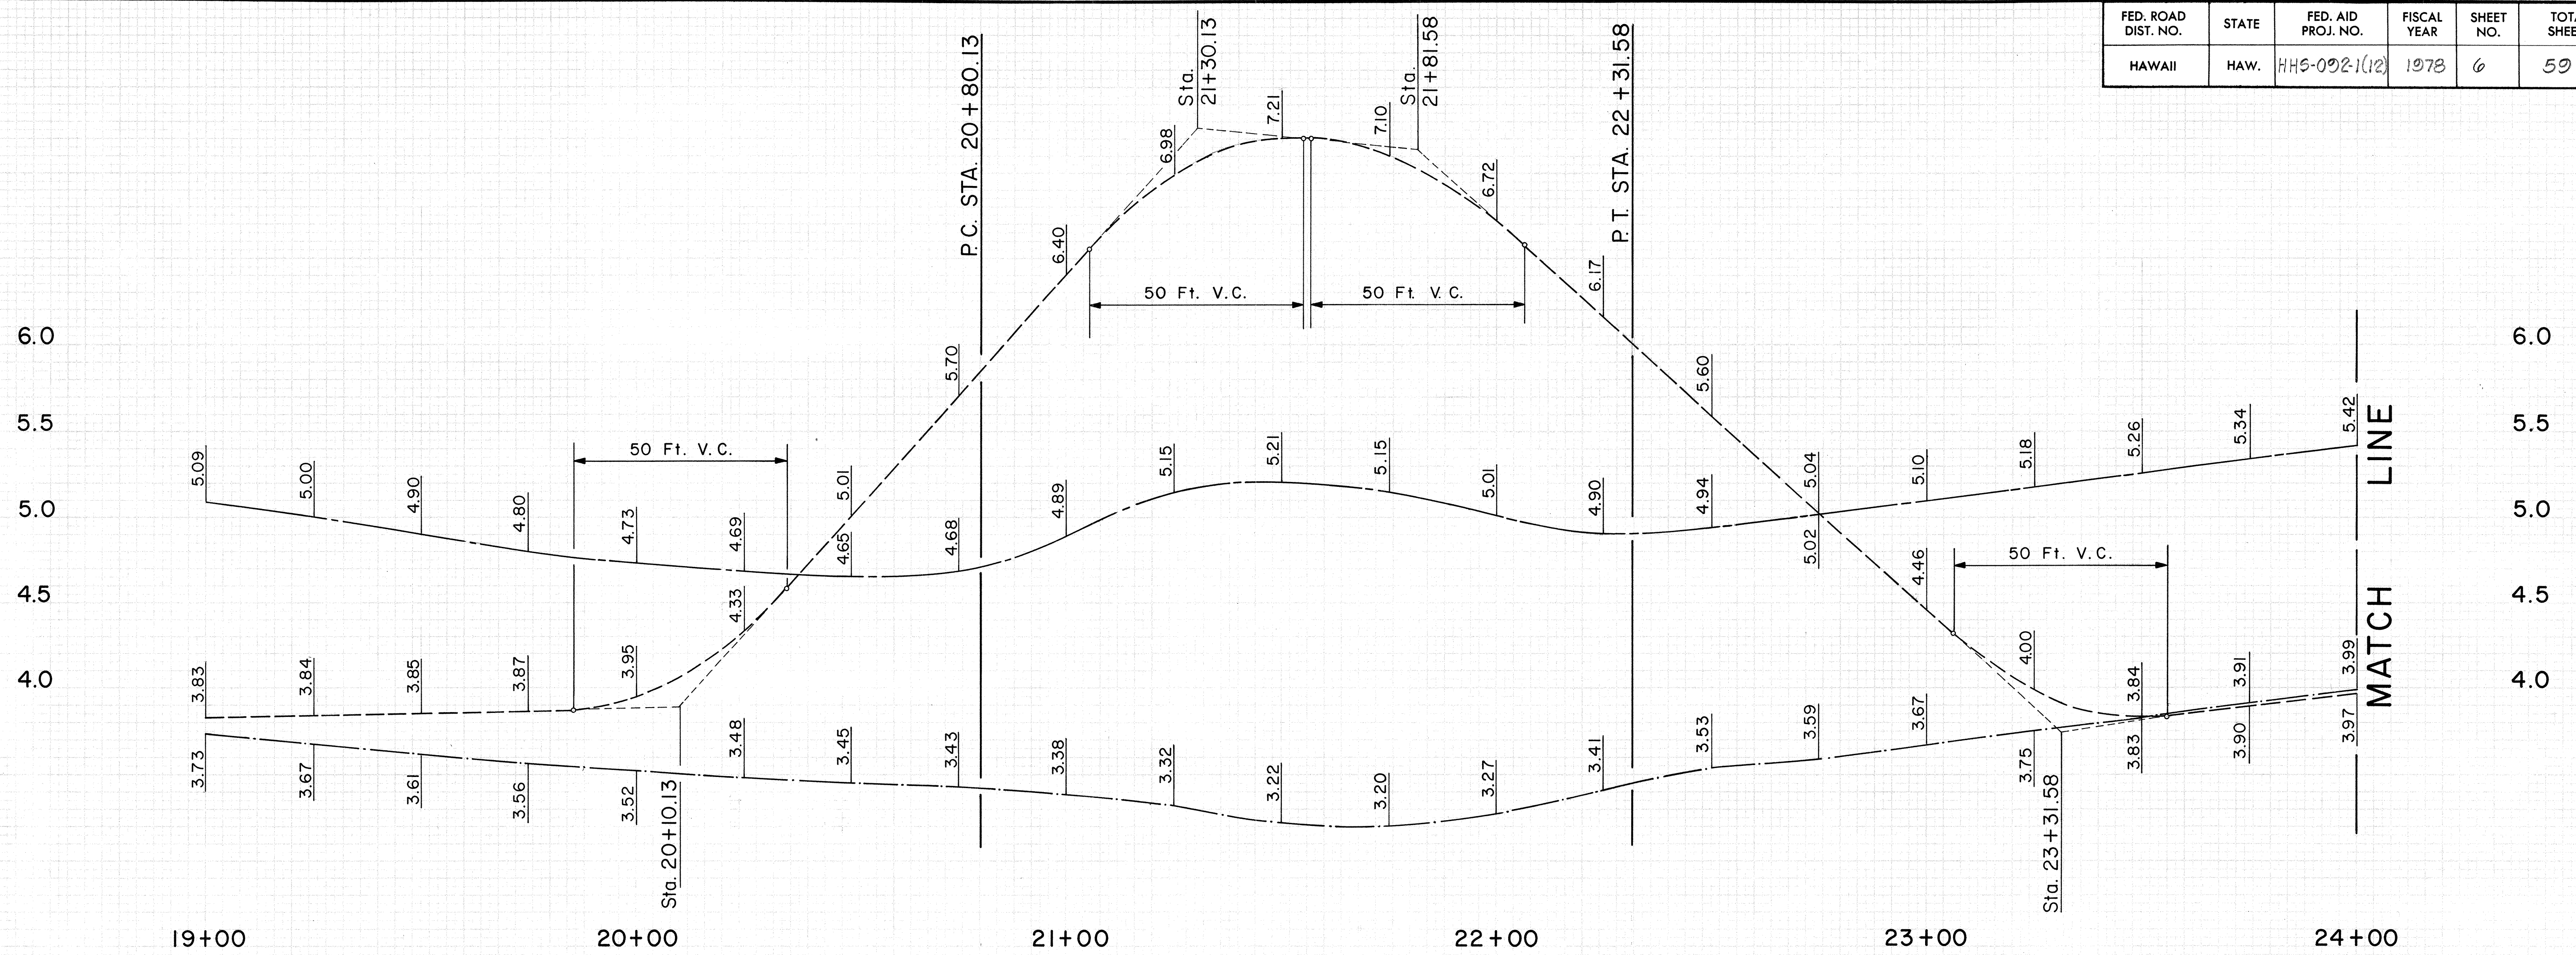

LEGEND:

- — — — — BASELINE
- · — · — · — LEFT GRADE CONTROL LINE (33 FT. FROM CL)
- - - - - RIGHT GRADE CONTROL LINE (33 FT. FROM CL)

SUPERELEVATION DIAGRAM
ALA MOANA BLVD. SAFETY IMPROVEMENTS
Project No. HHS-092-1(12)
Horiz. Scale: 1" = 20'
Vert. Scale: 2" = 1'