INDEX TO DRAWINGS	
SHEET NO.	DESCRIPTION
l	TITLE SHEET
2-3	TYPICAL SECTIONS
4-5	DETAIL PLAN OF ROADWAY
6	SUPERELEVATION DIAGRAM
7-8	CONCRETE GUARD RAIL AND NEW
	CONCRETE SIDEWALK DETAIL
9-11	ROADWAY STANDARD DETAILS
12-16	DRAINAGE DETAILS
17-20	CONSTRUCTION DETOUR PHASE
	AND DETAILS
21-25	SIGNING, PAVEMENT MARKINGS
	AND MISCELLANEOUS DETAILS
26-27	TYPICAL DETAILS OF WHEEL
	CHAIR RAMPS
28	TRAFFIC SIGNAL REVISION
29-31	HIGHWAY LIGHTING
32-48	STANDARD AND MISC. DETAILS
49-53	TELÉPHONE, ELECTRIC, FIRE
	ALARM AND RADIO SYSTEM CABLE
54	SEWER AND WATER SYSTEM
55	LANDSCAPE PLANTING
56-59	CROSS SECTIONS



STATE OF HAWAII

DEPARTMENT OF TRANSPORTATION LAND TRANSPORTATION FACILITIES DIVISION

HONOLULU, HAWAII

"AS-BUILT"


PLANS FOR

ALA MOANA BOULEVARD SAFETY IMPROVEMENT,

SOUTH STREET TO KEAWE STREET

PROJECT NO. HHS-092-1(12)


DISTRICT OF HONOLULU ISLAND OF OAHU

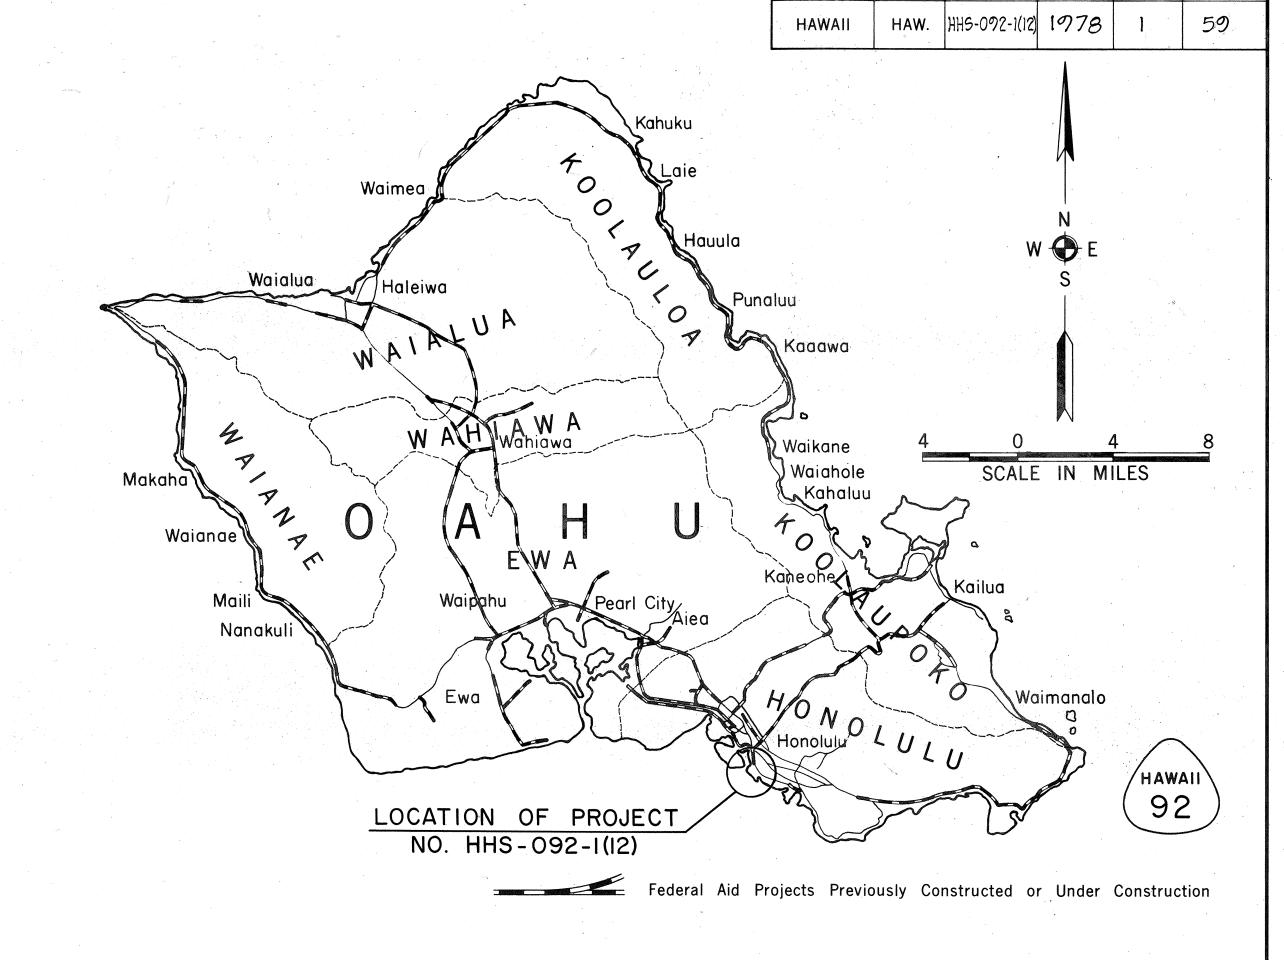

ALL CHANGES MADE DURING CONSTRUCTION HAVE BEEN INCORPORATED ON THESE PLANS EXCEPT CHANGES IN THE ORIGINAL THEORETICAL QUANTITIES.

Phil ALENCASTRE RESIDENT ENGINEER

FED. AID FISCAL SHEET TOTAL PROJ. NO. YEAR NO. SHEETS

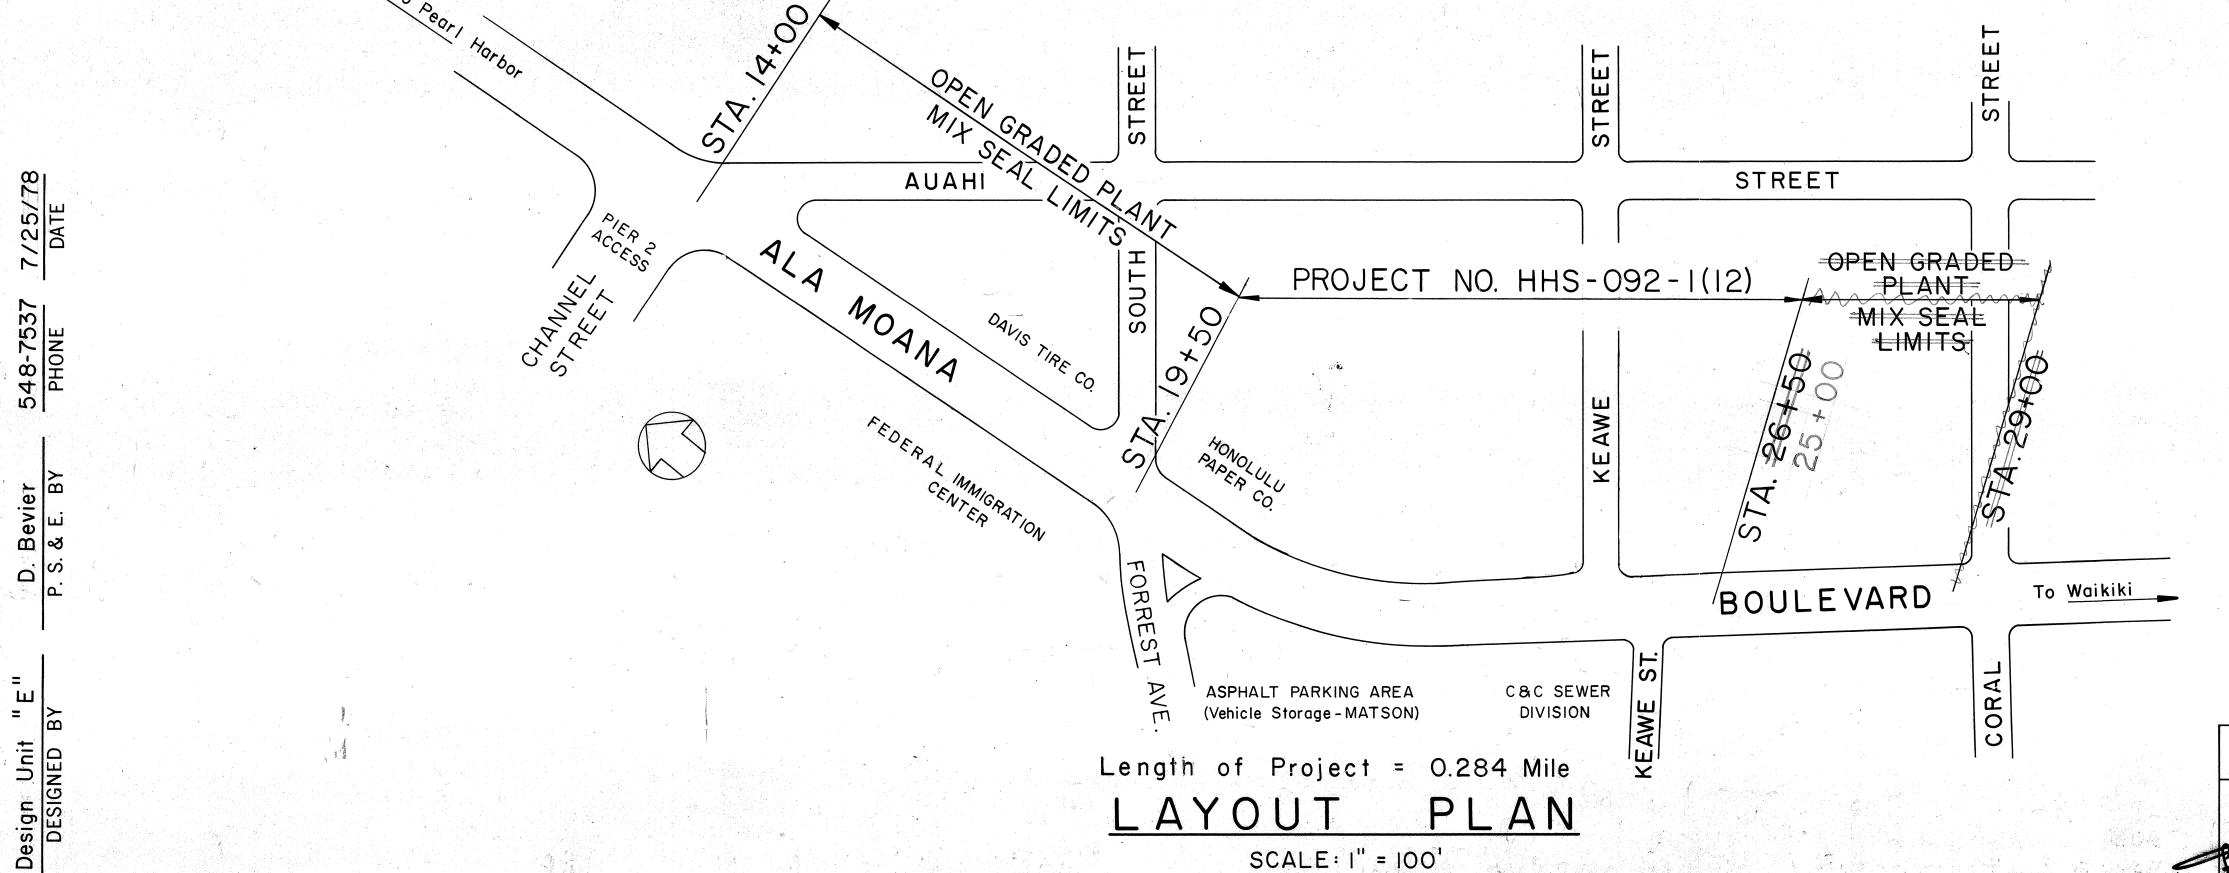

## DESIGN DATA

DEPARTMENT OF TRANSPORTATION
FEDERAL HIGHWAY ADMINISTRATION
APPROVED:

BY SI-18
DIVISION ADMINISTRATOR DATE

DEPARTMENT OF TRANSPORTATION
STATE OF HAWAII

APPROVED:

Probieh: Higashionna 7/25/18

DIR. OF TRANSPORTATION DATE

110-0-0-7

2-4-7