


INDEX TO DRAWINGS	
SHEET NO.	DESCRIPTION
1	TITLE SHEET
2	GENERAL NOTES
3	TYPICAL SECTIONS
4-7	PLAN
8	STANDARD DETAILS- TYPICAL
	DETAILS OF CURB AND/OR GUTTERS
9-19	PAVEMENT MARKINGS AND
	TRAFFIC SIGNAL CONDUIT LAYOUT
20-21	DETAILS-WHEELCHAIR RAMPS

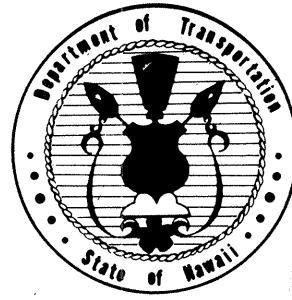

STATE OF HAWAII

DEPARTMENT OF TRANSPORTATION

HIGHWAYS DIVISION

HONOLULU, HAWAII

"AS BUILT"

PLANS FOR

ALA MOANA BOULEVARD

RESURFACING


KEAWE STREET TO ALA WAI CANAL BRIDGE

FEDERAL AID PROJECT NO. F-092-1(15)

DISTRICT OF HONOLULU

ISLAND OF OAHU

FED. ROAD DIST. NO.	STATE	PROJ. NO.	FISCAL YEAR	SHEET NO.	TOTAL SHEETS
HAWAII	HAW.	F-092-1(15)	1980	1	21

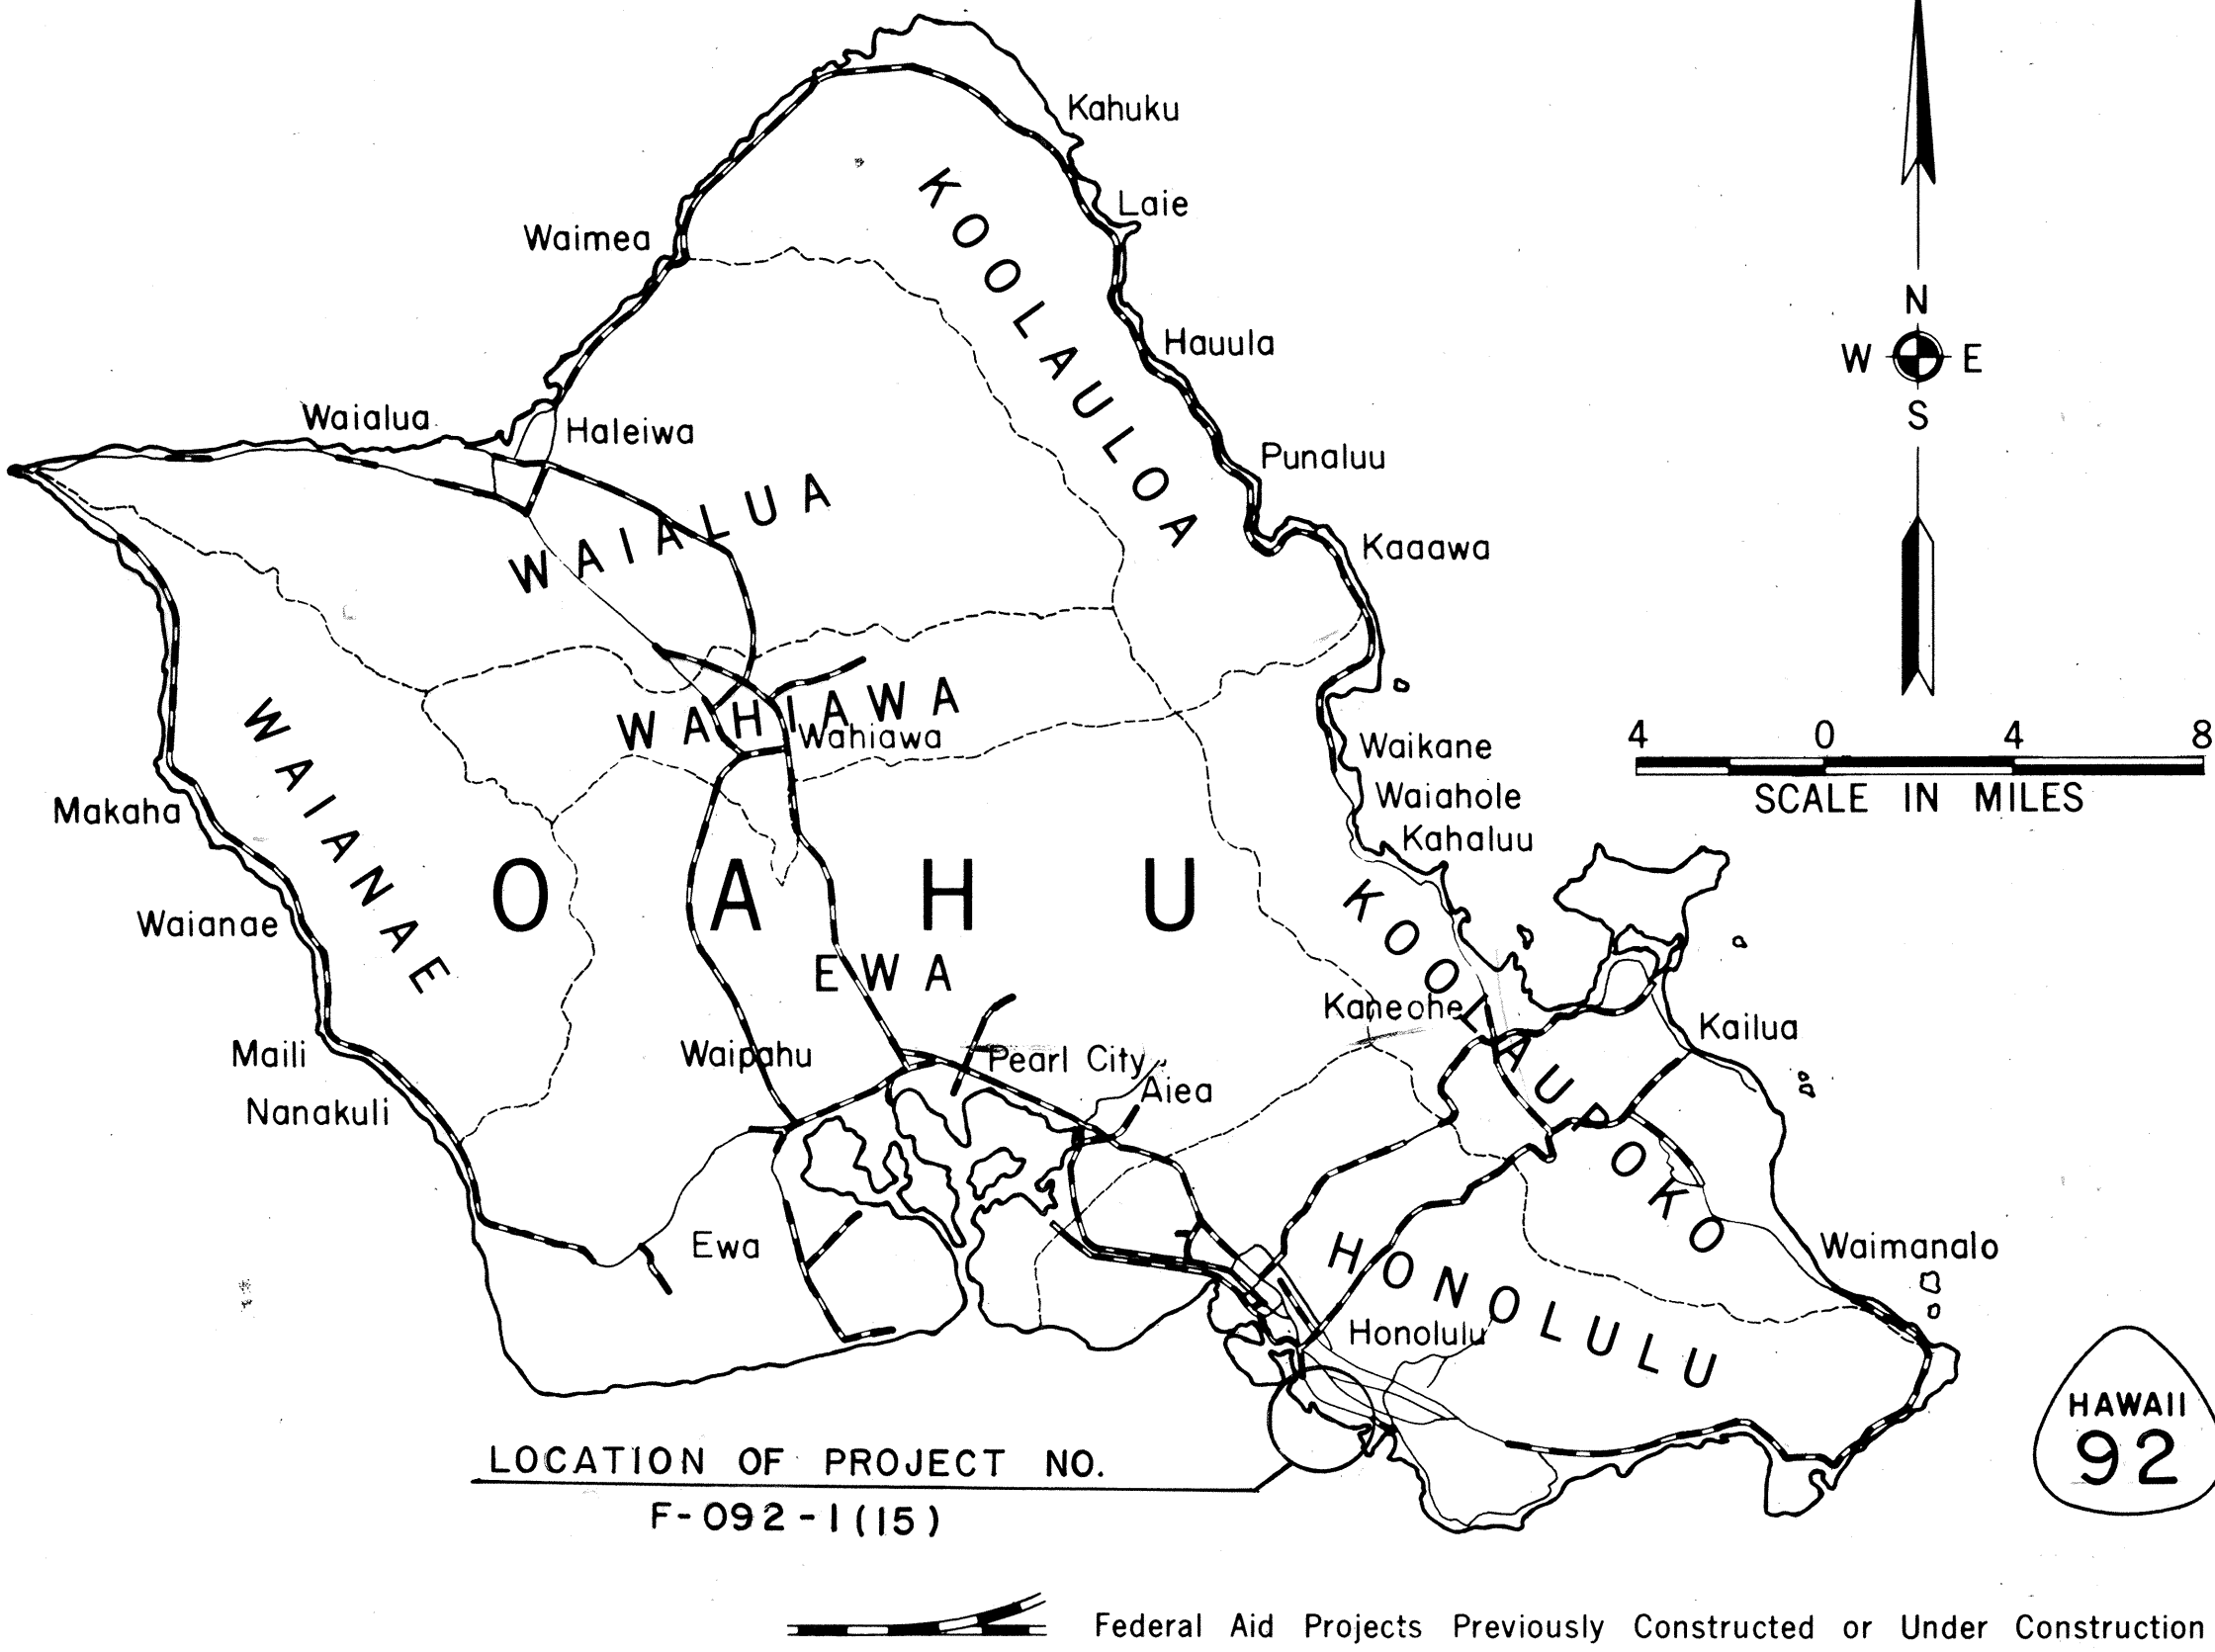

ALL CHANGES MADE DURING CONSTRUCTION
HAVE BEEN NOTED IN RED ON THESE
TRACINGS AND CHECKED BY

Virginia P. Gonzales 2/5/82
PROJECT ENGINEER DATE

DESIGN DATA

ADT (1976)	57,400
ADT (1996) [Ⓔ]	57,400
DHV	5,460 [@ S.L.E]
K	9.5 %
D	55 / 45
T	4.0 %
V	35 MPH

DEPARTMENT OF TRANSPORTATION

FEDERAL HIGHWAY ADMINISTRATION

APPROVED

[Signature] 5-30-80

DIVISION ADMINISTRATOR DATE


DEPARTMENT OF TRANSPORTATION

STATE OF HAWAII

APPROVED:

James R. Carras 5/14/80

DIR. OF TRANSPORTATION DATE

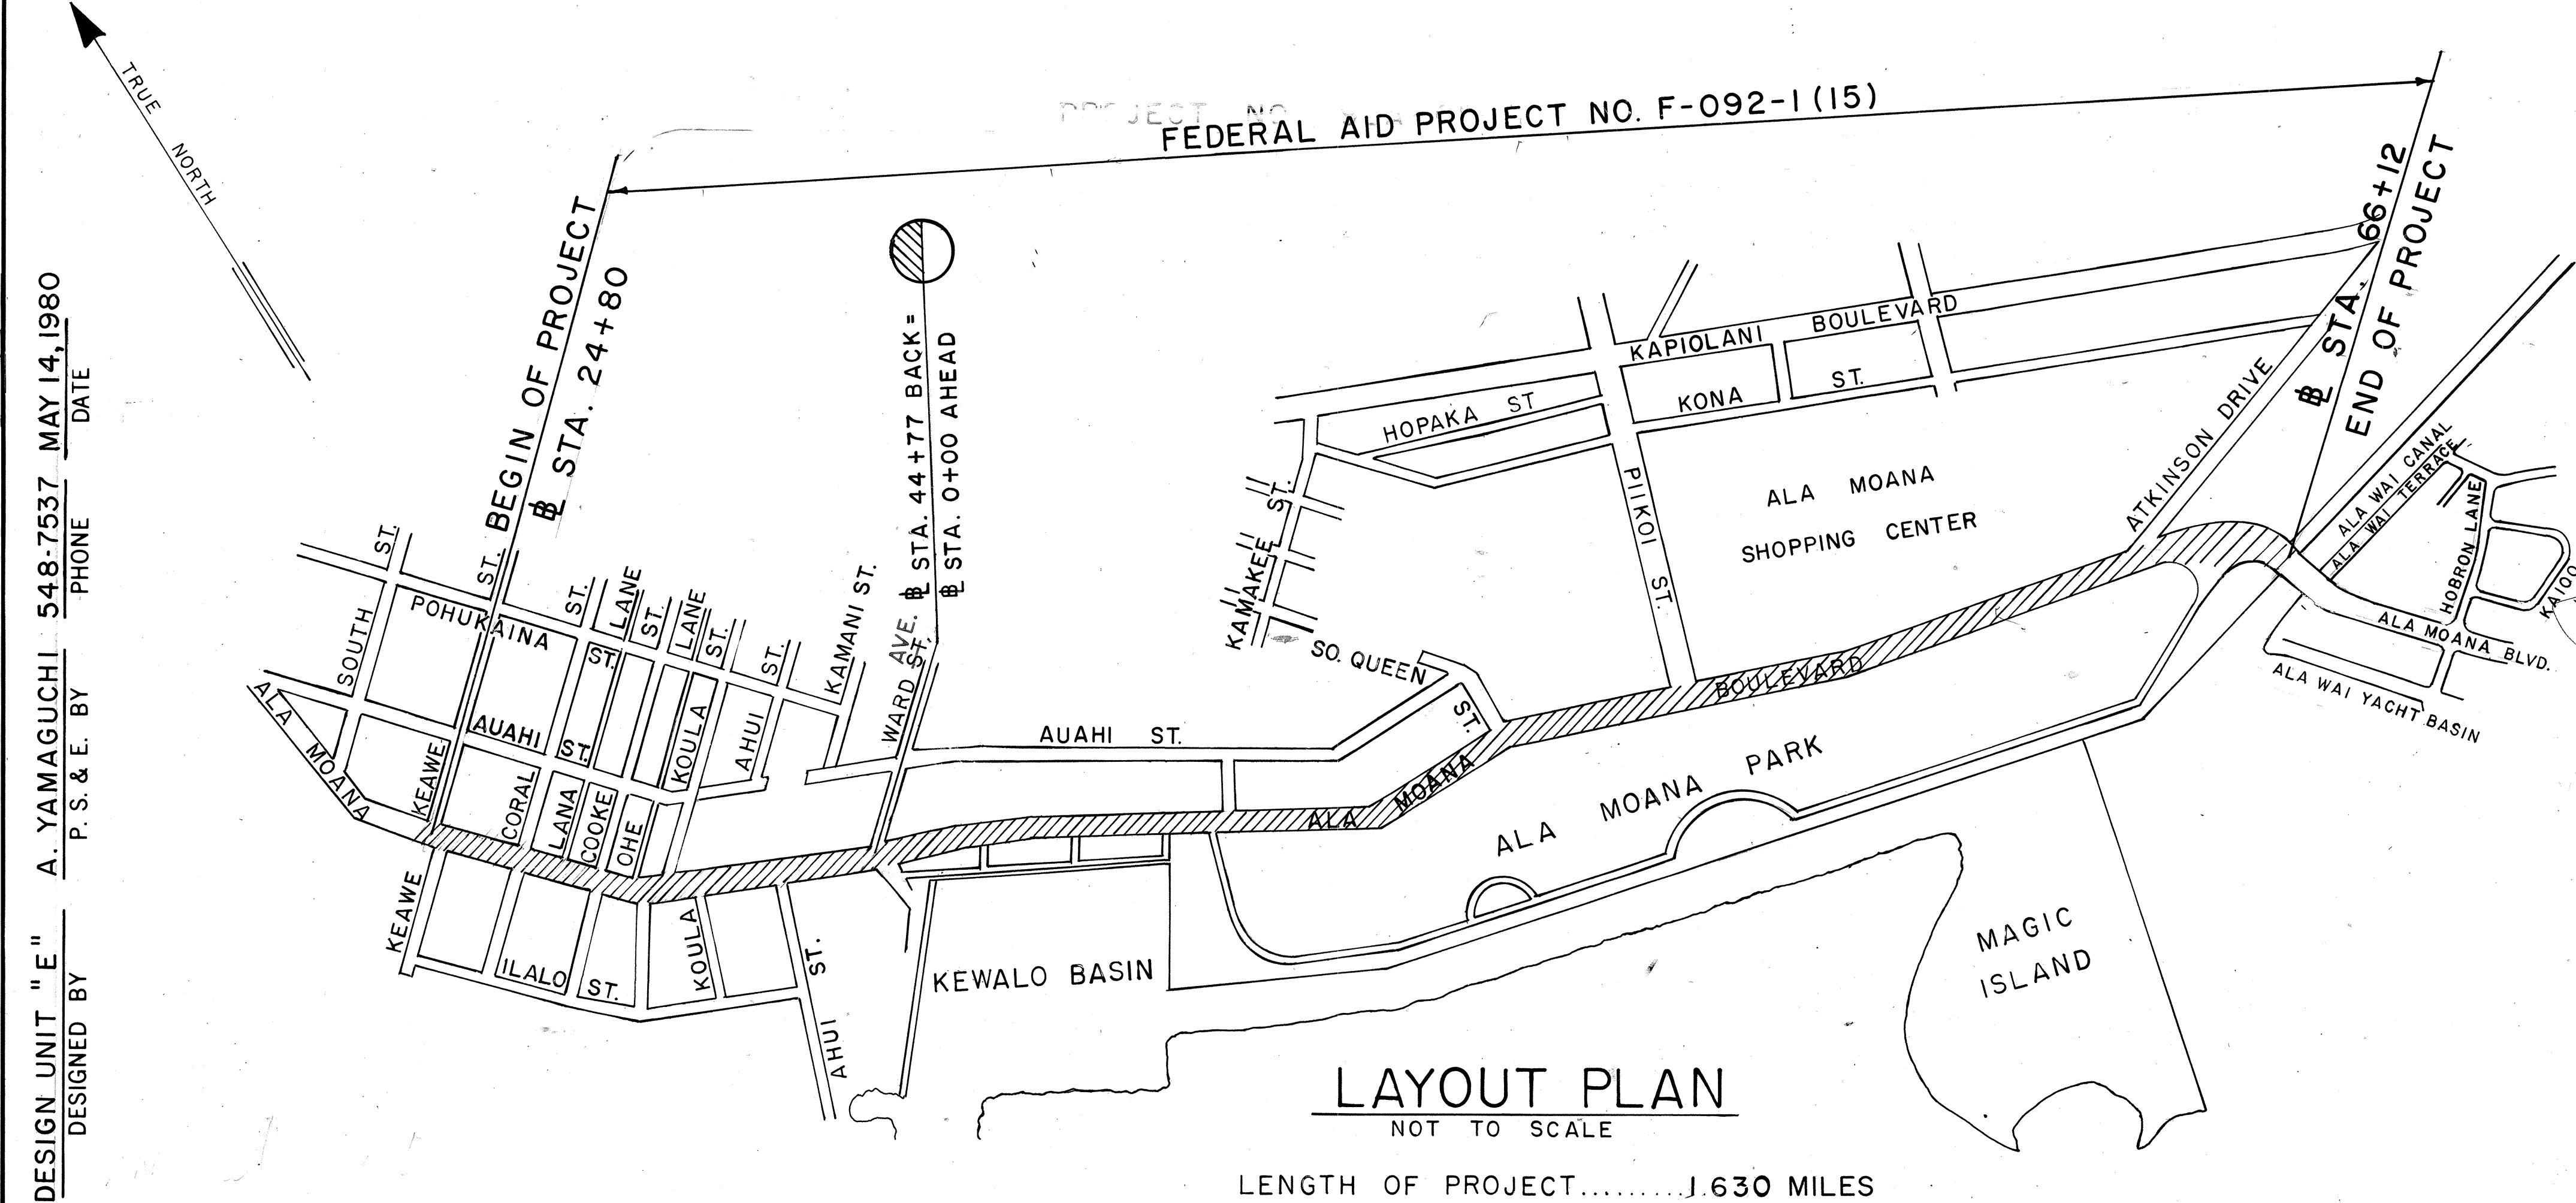

DESIGN UNIT "E" A. YAMAGUCHI 548-7537 MAY 14, 1980
DESIGNED BY P.S. & E. BY PHONE DATE

D-4-7 6/70-2/82