


FED. ROAD DIST. NO.	STATE	PROJ. NO.	FISCAL YEAR	SHEET NO.	TOTAL SHEETS
HAWAII	HAW.	92A-04-B	1980	2	13

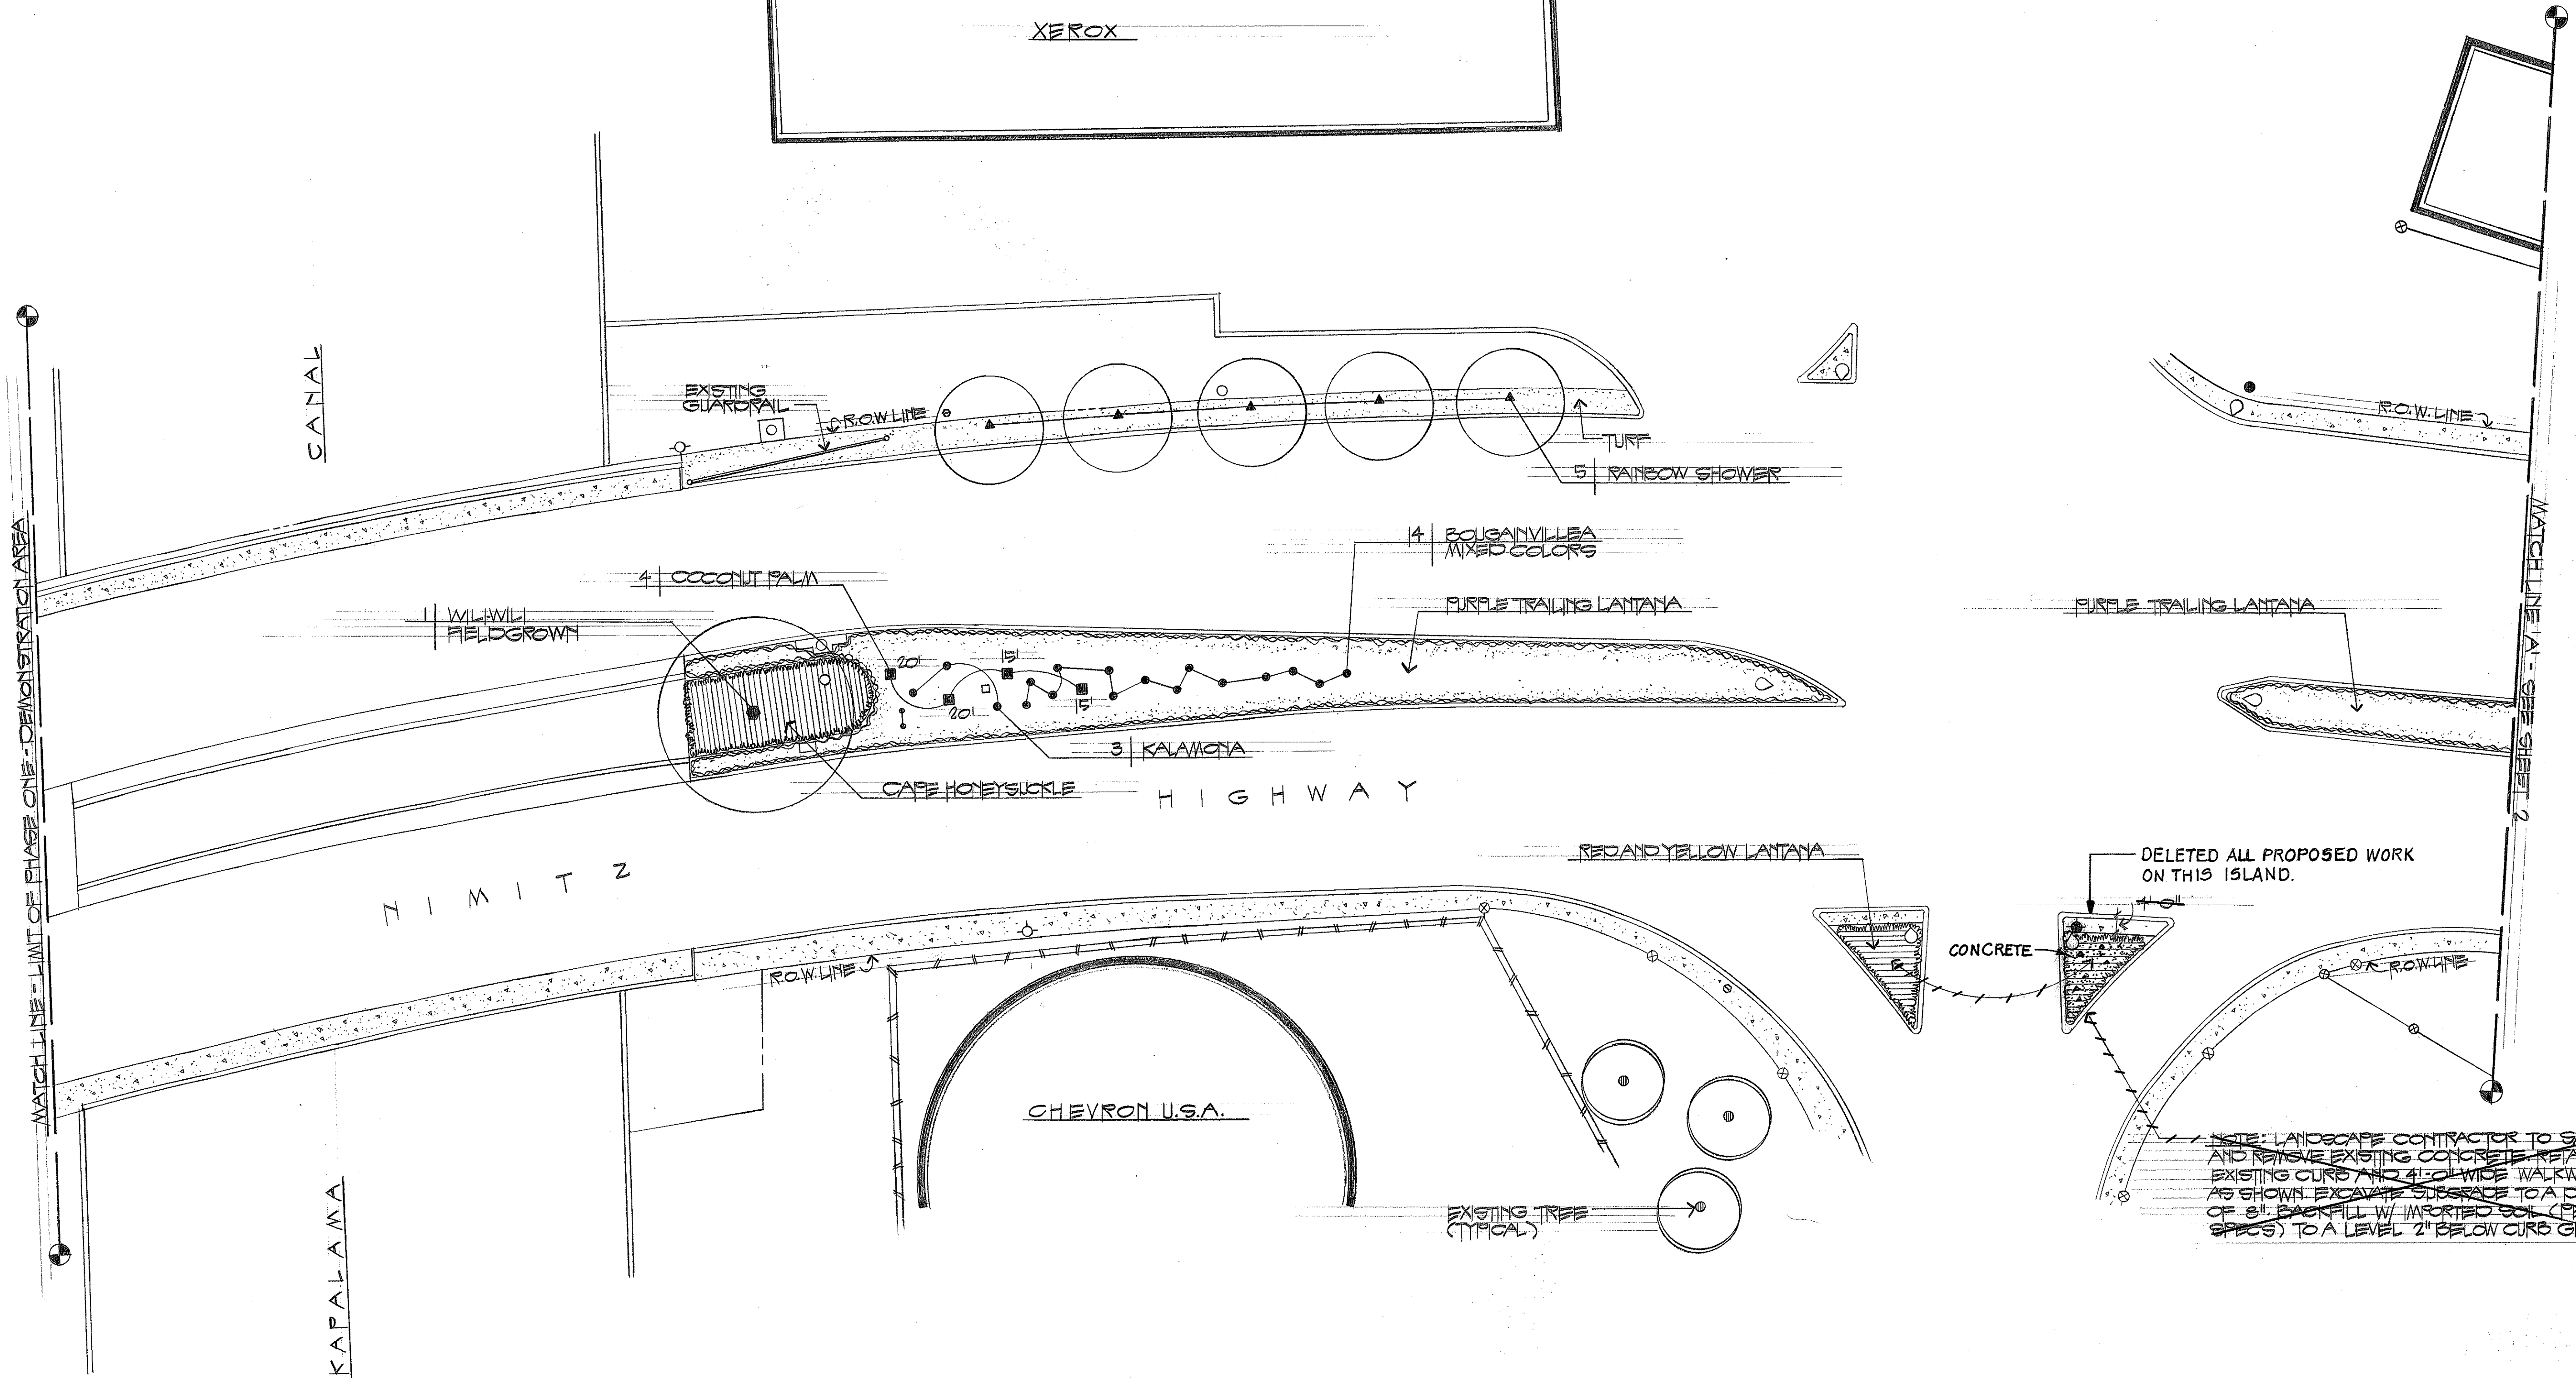


DELETED ALL PROPOSED WORK ON THIS ISLAND.

NOTE: LANDSCAPE CONTRACTOR TO SAW CUT AND RAISE EXISTING CONCRETE RETAIN EXISTING CURB AND 4'-0" WIDE WALKWAY AS SHOWN EXCAVATE SUBGRADE TO A DEPTH OF 8" BACKFILL W/ IMPORTED SOIL (PER SPECS) TO A LEVEL 2" BELOW CURB GRADE.

EXISTING SITE ELEMENTS

○	LIGHT STANDARD	—○—	CHAINLINK FENCE
●	UTILITY POLE	—□—	WOOD FENCE
—	EXISTING SIGN		CONCRETE WALL
■	BUS STOP	▨▨▨	CONCRETE PAVING
⊕	FIRE HYDRANT	○	TRAFFIC SIGNAL
○	UTILITY MANHOLE		
□	UTILITY VALVEBOX		

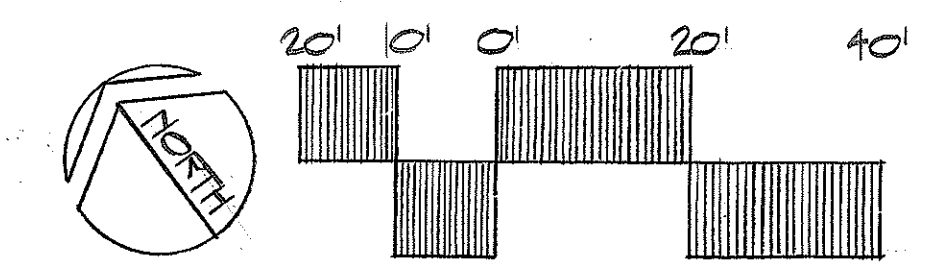


STATE OF HAWAII
DEPARTMENT OF TRANSPORTATION
LAND TRANSPORTATION FACILITIES DIVISION

PLANTING PLAN

HONOLULU GATEWAY
BEAUTIFICATION PROJECT
PHASE ONE - DEMONSTRATION AREA

DATE: DEC. 1980
SHEET NO. 1 OF 5 SHEETS

SURVEY PLOTTED BY	DATE
DRAWN BY	
TRACED BY	
DESIGNED BY	
CHECKED BY	
NOTE BOOK	
No.	

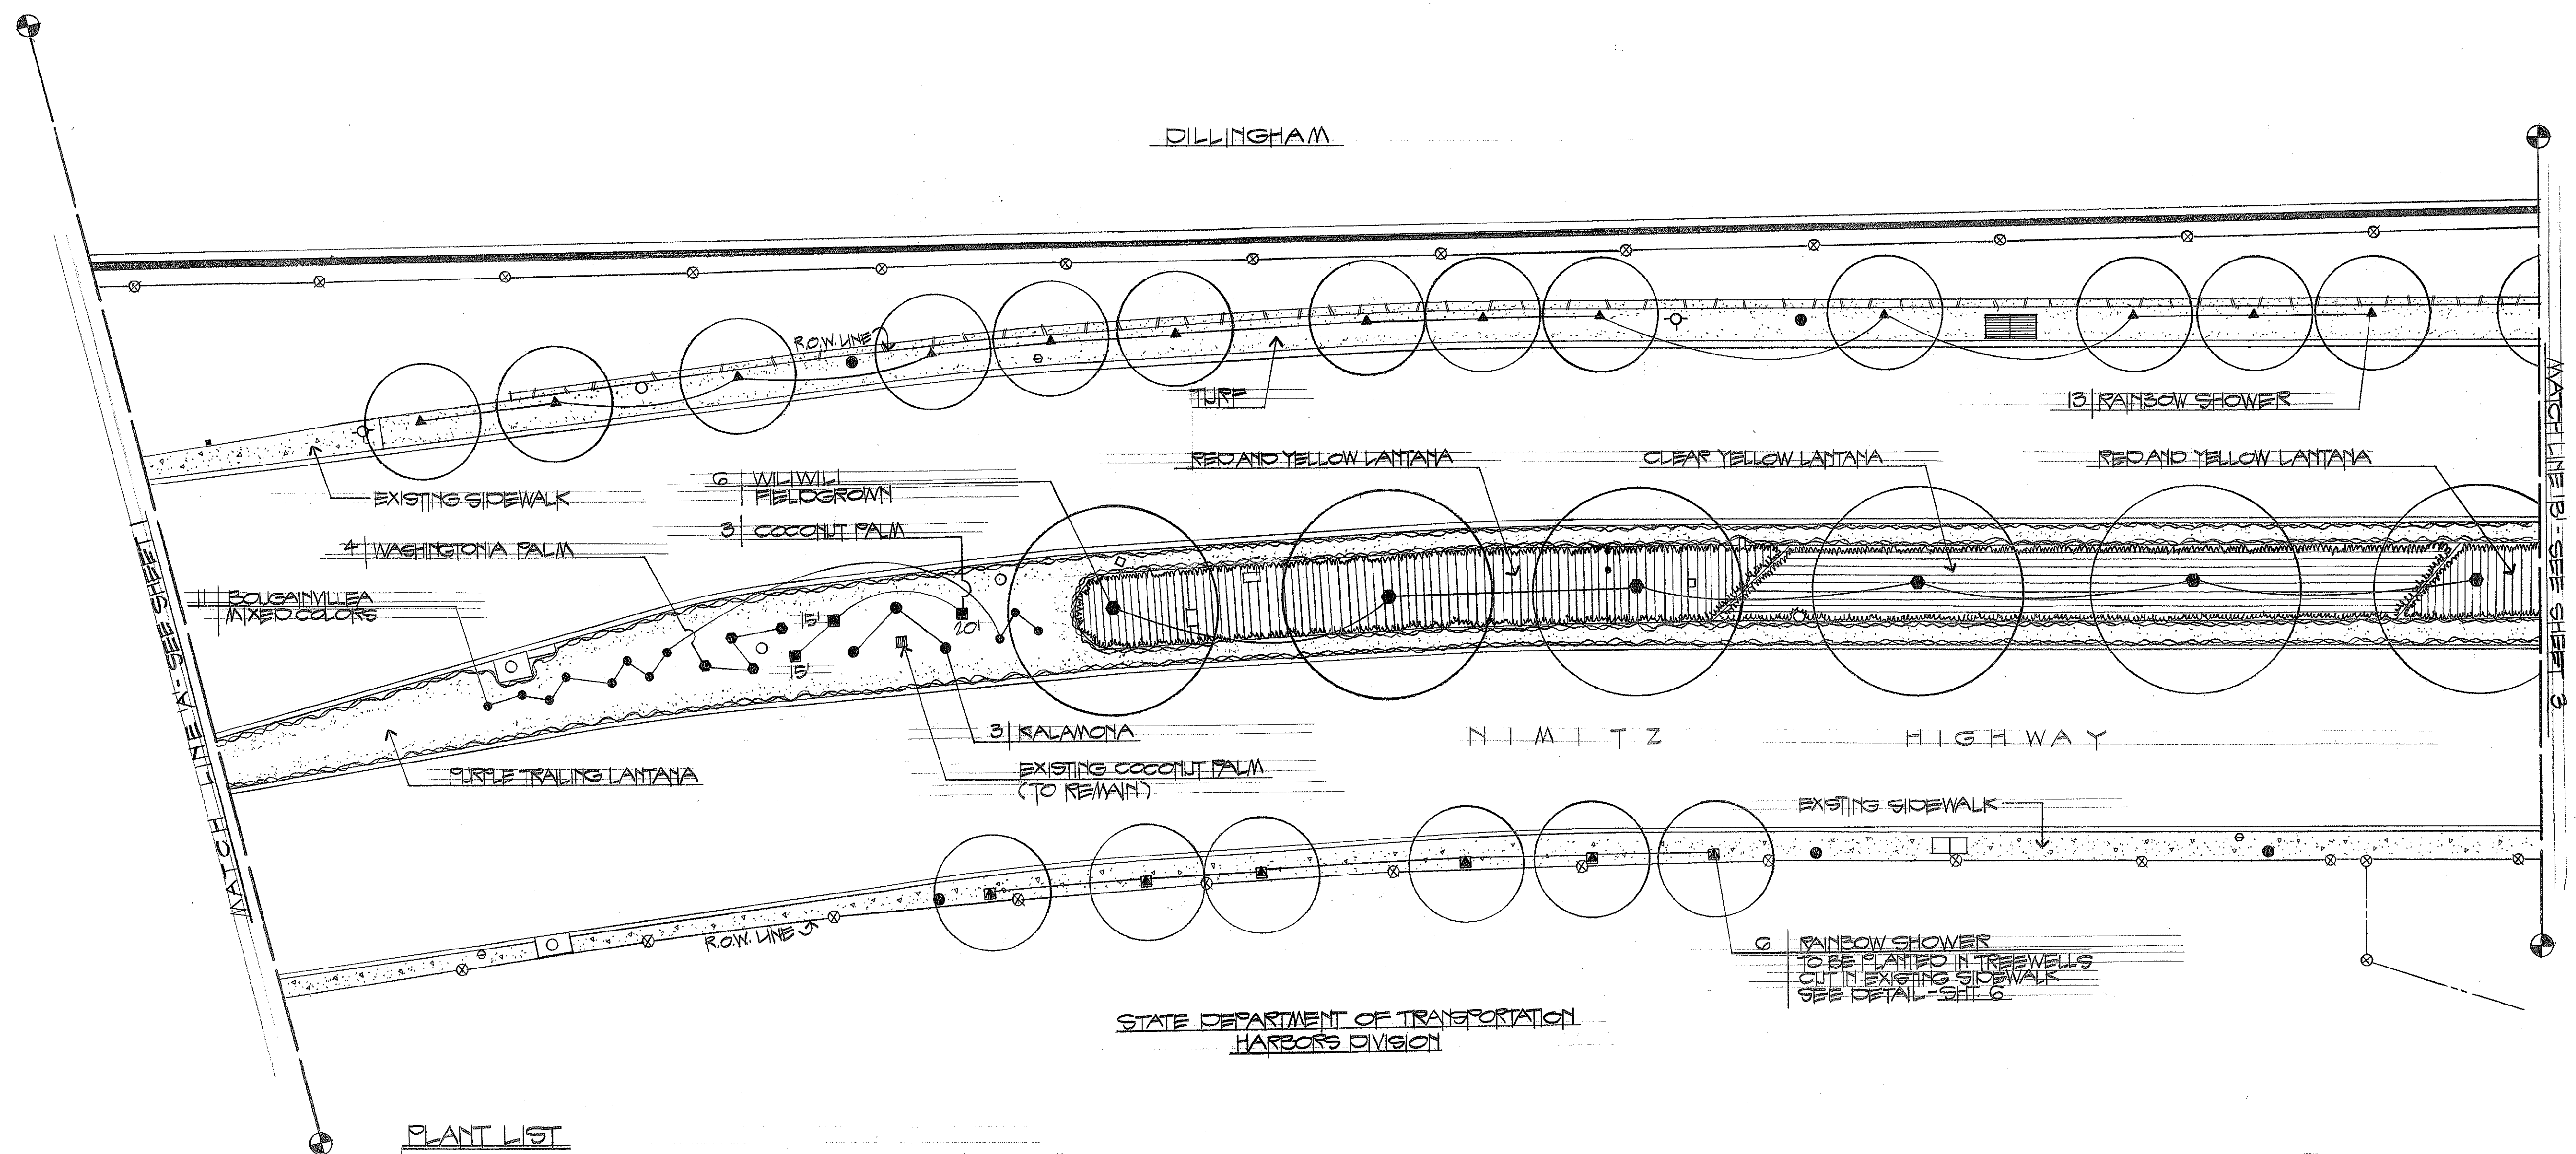


PLANT LIST

QUANTITY	BOTANICAL NAME	COMMON NAME	SIZE	HEIGHT	SPREAD	CALIPER	REMARKS
12	ERITHRINA SANDWICENSIS	WILIWILI	PIELOGROWN	8'-10' PRUNED TRUNK HT.		6"-8"	
11	ERITHRINA VARIEGATA VAR. ORIENTALIS	INDIAN CORAL TREE	25 GAL.	6'-8'	3'-4'	1/2"-2"	
35	CASSIA FISTULA X C. JAVANICA	RAINBOW SHOWER	25 GAL.	6'-8'	3'-4'	1/2"-2"	
15	TABBUJA PENTAPHYLLA	PINK TECOMA	25 GAL.	6'-8'	3'-4'	1/2"-2"	
10	CASSIA GLAUCA	KALAMONA	25 GAL.	6'-8'	3'-4'	1/2"-2"	
18	COCOS NUCIFERA	COCONUT PALM	PIELOGROWN	15'-20' TRUNK HT.			SEE PLANS FOR TREE HT.
9	WASHINGTONIA ROBUSTA	WASHINGTONIA PALM	25 GAL.	2'-3' TRUNK HT.			
7	PHOENIX ROEBELINII	PHOENIX PALM	25 GAL.	3'-4' TRUNK HT.			
12	COCOS NUCIFERA	COCONUT PALM	25 GAL.	15'-20'			
65	BOUGAINVILLEA SP.	BOUGAINVILLEA	2 1/2 GAL.	1'-2'	18"-24"		SEE PLANS FOR LOCATION. EQUAL NO. OF: B. SPECTABILIS, VAR. 'CRIMSON LAKE', VAR. 'MARY PALMER', VAR. 'MISS MANILA'
933	TECOMARIA CAPENSIS	CAPE HONEYSUCKLE	1 GAL.	12"-18"	12"		SPACING: 24" O.C.
455	PLUMBAGO CAPENSIS	CAPE PLUMBAGO	1 GAL.	8"-12"	8"		SPACING: 24" O.C.
2590	LANTANA CAMARA	LANTANA	4" CELL	6"-8"	6"-8"		RED AND YELLOW VARIETY - SPACING: 18" O.C.
1310	LANTANA CAMARA	LANTANA	4" CELL	6"-8"	6"-8"		CLEAR YELLOW BUSH VARIETY - SPACING: 18" O.C.
10032	LANTANA SELLOMANA	TRAILING LANTANA	4" CELL	6"-8"	6"		PURPLE FLOWER - SPACING: 18" O.C.
9320	CARPENTERIA BOULIS WEDELIA	WEDELIA	R.C.				SPACING: 12" O.C. - ROOTED CUTTINGS
19455	CYNODON DACTYLON	PERMUICA GRASS	SEED				TO BE HYDROMULCHED

GENERAL NOTES:

- THE LANDSCAPE CONTRACTOR SHALL EXERCISE CAUTION WHEN DIGGING TREE-PLANTING HOLES TO AVOID ANY UNDERGROUND UTILITIES NOT ANTICIPATED BY THE PLANTING PLAN.
- WHERE BOUGAINVILLEAS ARE SHOWN IN GROUP PLANTINGS, THE VARIETIES SHALL BE MIXED SO THAT NO MORE THAN TWO PLANTS OF THE SAME VARIETY ARE ADJACENT TO EACH OTHER.
- TOPSOIL - IMPORTED TOPSOIL (PER SPECS) SHALL BE PLACED OVER ALL PLANTING AREAS TO THE FOLLOWING DEPTHS: TURF AREAS - 3 INCHES, SHRUB/GROUND COVER AREAS - 3 INCHES
- BACKFILL MIX (PER PLANTING DETAILS) MIX 6 CU. FT. OF MULCH WITH 6 CU. FT. MANURE, THEN WITH EACH 15 CU. FT. OF TOPSOIL.

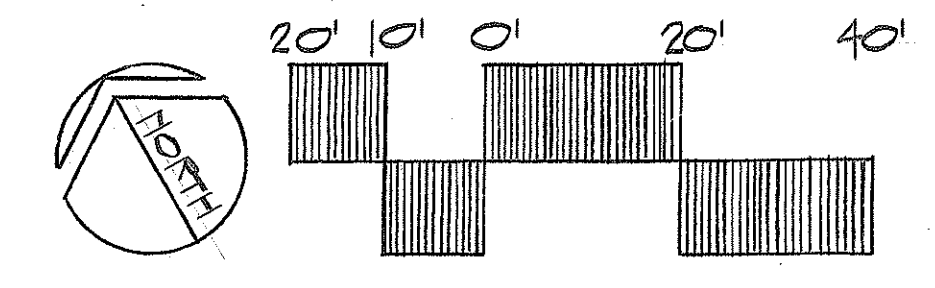

STATE OF HAWAII
DEPARTMENT OF TRANSPORTATION
LAND TRANSPORTATION FACILITIES DIVISION

PLANTING PLAN

HONOLULU GATEWAY
BEAUTIFICATION PROJECT
PHASE ONE - DEMONSTRATION AREA

DATE: DEC. 1980

SHEET NO. 2 OF 5 SHEETS

SURVEY PLOTTED BY	DATE
DRAWN BY	
DESIGNED BY	
QUANTITIES BY	
CHECKED BY	
ORIGINAL PLAN	
NOTE BOOK	
No.	

WEYERHAUSER



MATCHLINE C - SEE SHEET 4


Abstract

ORIGINAL PLAN	SURVEY PLOTTED BY _____
NOTE BOOK	DRAWN BY _____
No. _____	TRACED BY _____
	DESIGNED BY _____
	QUANTITIES BY _____
	CHECKED BY _____


PLANTING PLAN

DATE: DEC. 1980

SHEET No. 3 OF 5 SHEETS

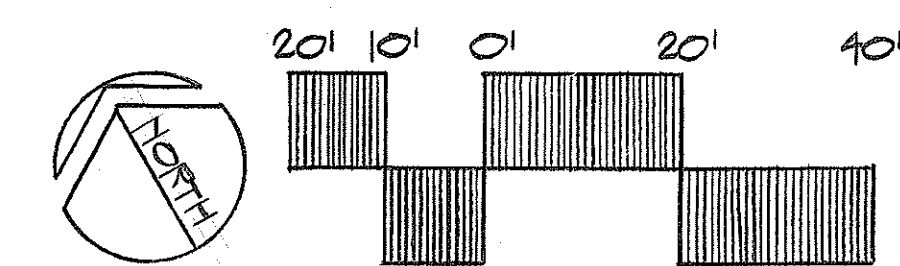

FED. ROAD DIST. NO.	STATE	FED. AID PROJ. NO.	FISCAL YEAR	SHEET NO.	TOTAL SHEETS
HAWAII	HAW.	92A-04-B	1980	5	13

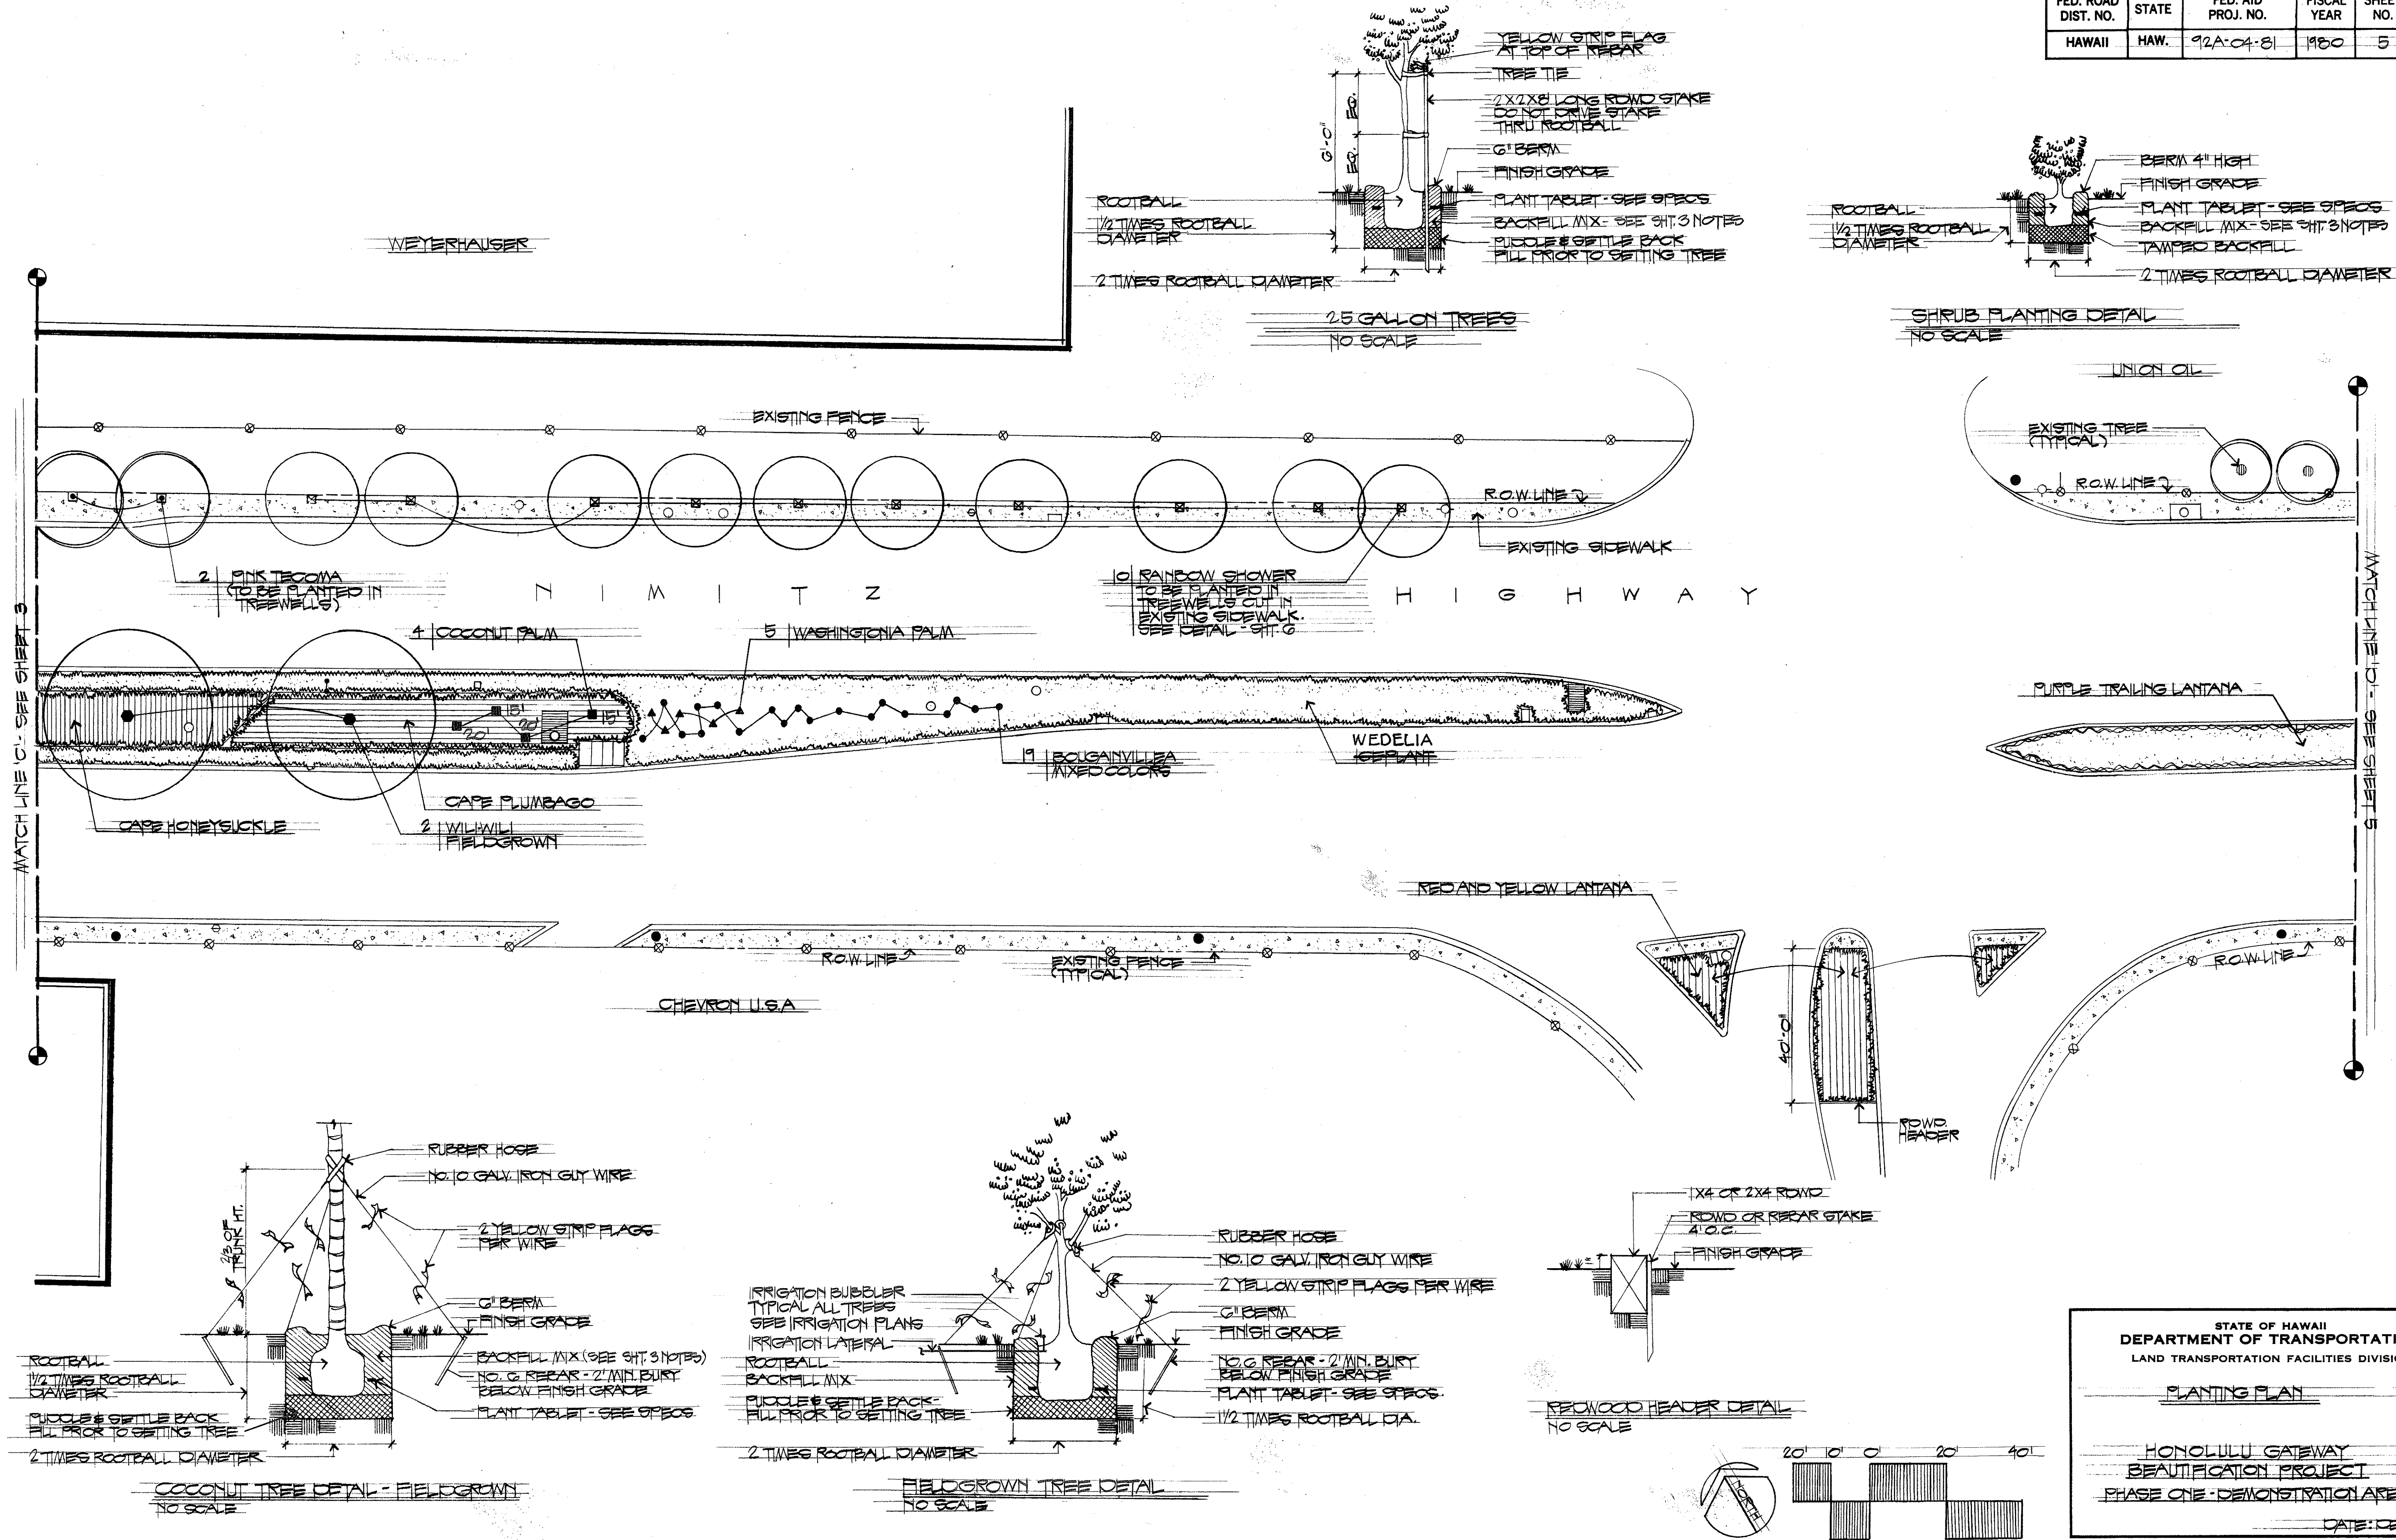

ORIGINAL PLAN	SURVEY PLOTTED BY	DATE
DESIGNED BY	DRAWN BY	
CHECKED BY	NOTED BY	
NO.		


STATE OF HAWAII
DEPARTMENT OF TRANSPORTATION
LAND TRANSPORTATION FACILITIES DIVISION

PLANTING PLAN

HONOLULU GATEWAY
BEAUTIFICATION PROJECT
PHASE ONE - DEMONSTRATION AREA

DATE: DEC. 1980
SHEET NO. 4 OF 5 SHEETS

FED. ROAD DIST. NO.	STATE	PROJ. NO.	FISCAL YEAR	SHEET NO.	TOTAL SHEETS
HAWAII	HAW.	92A-04-8	1980	6	13

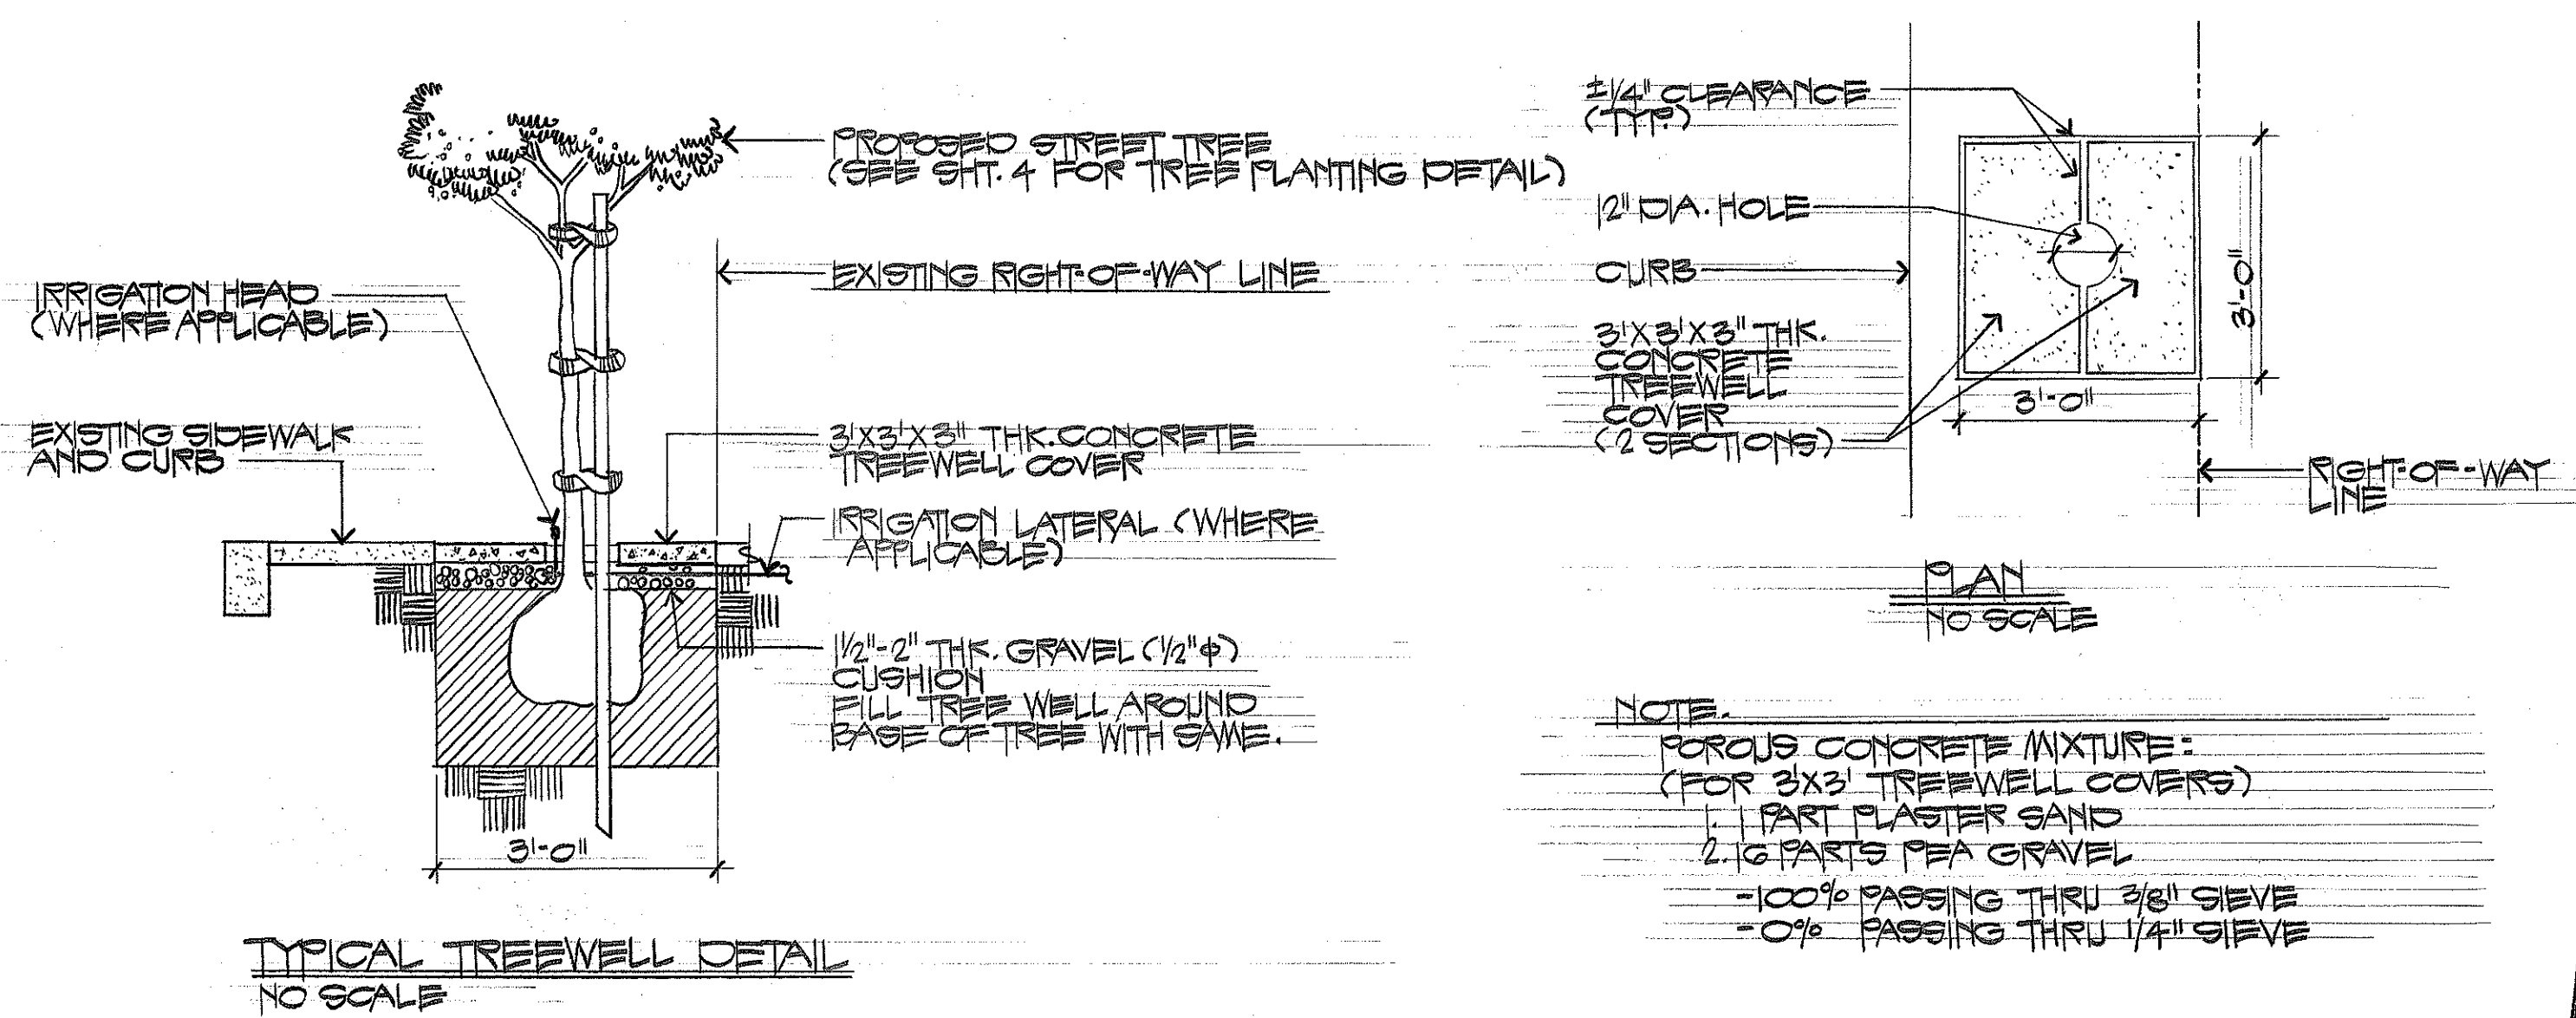

NOTE: TREEWELLS SHALL BE SAWCUT IN THE EXISTING AT THE LOCATIONS SHOWN ON THE PLANS. (PER STANDARD SPECS - SEC. 202.06)

BREWER CHEMICAL

EXISTING BANYAN (TO REMAIN)

CLEAR YELLOW LANTANA
SAFE HONEYBUCKLE

CLEAR YELLOW LANTANA

3 COCONUT PALM
ALL TO BE 25 GAL.

EXISTING COCONUT PALM
(TYPICAL) ALL TO REMAIN

HIGHWAY

HAWAIIAN ELECTRIC

CASTLE & COOK


STATE OF HAWAII
DEPARTMENT OF TRANSPORTATION
LAND TRANSPORTATION FACILITIES DIVISION

PLANTING PLAN

HONOLULU GATEWAY
BEAUTIFICATION PROJECT
PHASE ONE-DEMONSTRATION AREA

DATE: DEC. 1980

SHEET NO. 5 OF 5 SHEETS

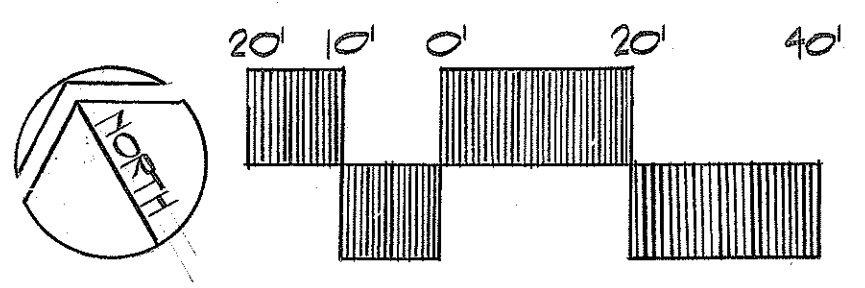

ORIGINAL PLAN	SURVEY PLOTTED BY	DATE
NO.	DRAWN BY	
	DESIGNED BY	
	QUANTITIES BY	
	CHECKED BY	