| | INDEX TO DRA | WINGS |
|-----------|----------------------------|--------------------------------------------------------------------------------------------------------------------------------------------------------------------------------------------------------------------------------------------------------------------------------------------------------------------------------------------------------------------------------------------------------------------------------------------------------------------------------------------------------------------------------------------------------------------------------------------------------------------------------------------------------------------------------------------------------------------------------------------------------------------------------------------------------------------------------------------------------------------------------------------------------------------------------------------------------------------------------------------------------------------------------------------------------------------------------------------------------------------------------------------------------------------------------------------------------------------------------------------------------------------------------------------------------------------------------------------------------------------------------------------------------------------------------------------------------------------------------------------------------------------------------------------------------------------------------------------------------------------------------------------------------------------------------------------------------------------------------------------------------------------------------------------------------------------------------------------------------------------------------------------------------------------------------------------------------------------------------------------------------------------------------------------------------------------------------------------------------------------------------|
| SHEET NO. | DESCI | RIPTION |
| <u> </u> | TITLE SHEET | |
| 2 - 6 | PLANTING PLANS | S, PLANT LIST & LS |
| 7-13 | IRRIGATION PLANS & DETAILS | |
| | | ** The state of th |
| | | |
| | | |
| | | , |
| | | |
| - | | |
| - | | |
| | | |
| | | |
| | | |
| | | , |



STATE OF

HAWAII


DEPARTMENT OF TRANSPORTATION


HIGHWAYS DIVISION "AS - BUILT"
PLANS FOR

THE HONOLULU GATEWAY BEAUTIFICATION PROJECT

ON NIMITZ HIGHWAY KAPALAMA CANAL TO VICINITY OF PACIFIC STREET PROJECT NO. 92A-04-81

DISTRICT OF HONOLULU ISLAND OF OAHU

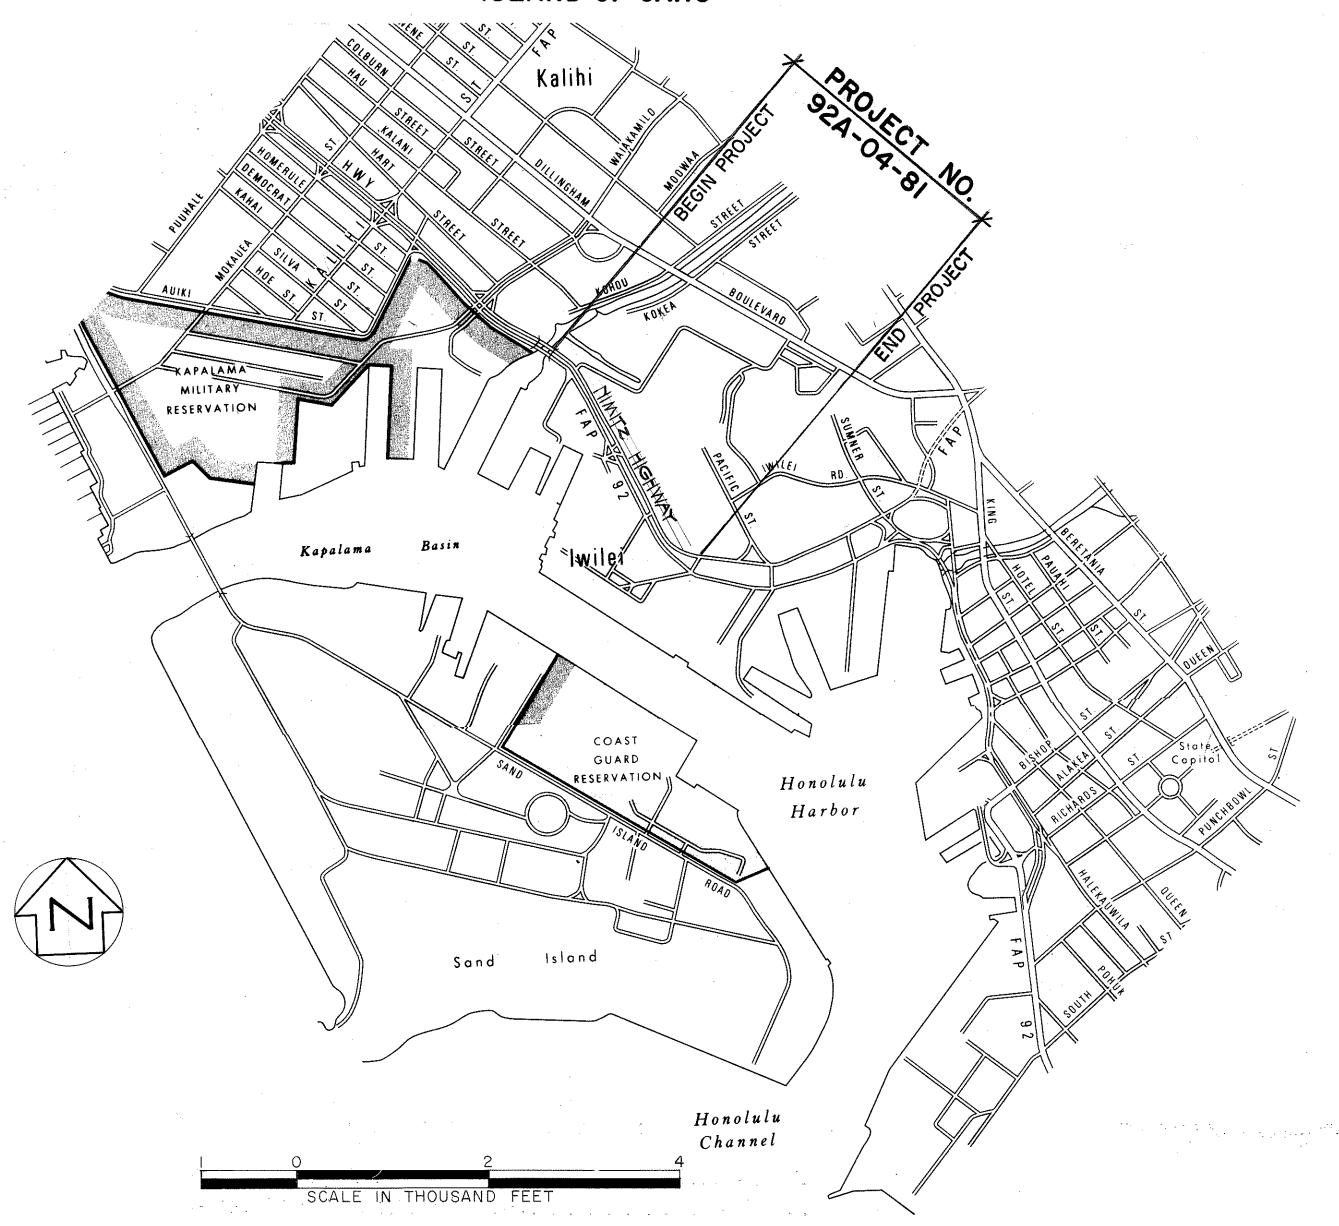

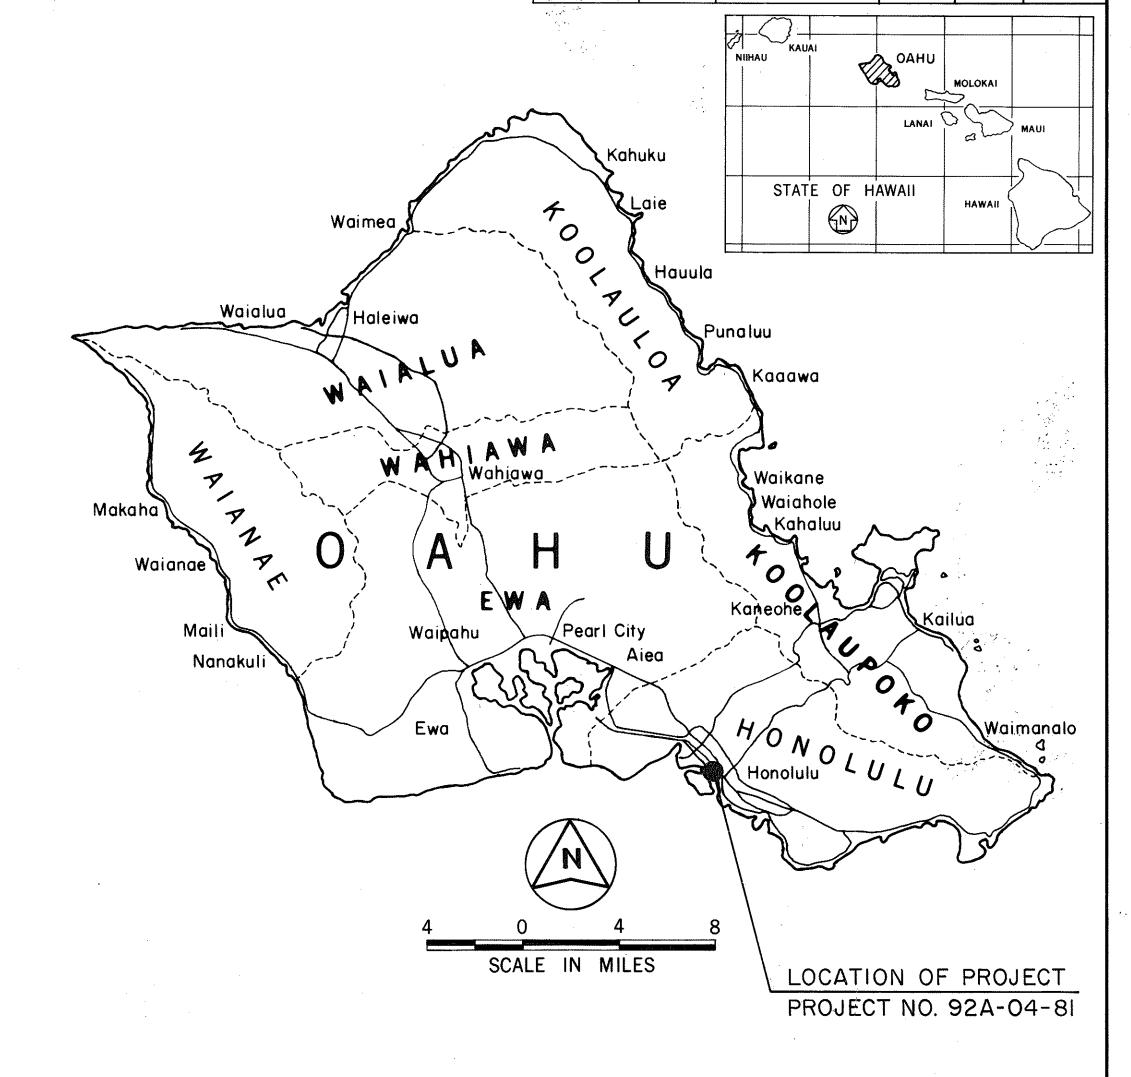

FED. ROAD DIST. NO.

PROJ. NO.

CHANGES MADE DURING CONSTRUCTION HAVE BEEN INCORPORATED ON THESE PLANS EXCEPT CHANGES IN THE ORIGINAL THEORETICAL QUANTITIES. FOR ACTUAL QUANTITIES, REFER TO PROJECT LEDGER AND/OR COMPUTATION BOOK.

10-17-83 RESIDENT ENGINEER

APPROVED FOR CROSS-COMMECTION CONTROL REQUIREMENTS:

DEPARTMENT OF TRANSPORTATION STATE OF HAWAII

DATE

MDIR. OF TRANSPORTATION