

[illegible]

STATE OF HAWAII

DEPARTMENT OF TRANSPORTATION

HIGHWAYS DIVISION

"AS-BUILT"

PLANS FOR



NIMITZ HIGHWAY BIKEWAY

MIDDLE ST. TOWARDS PUNCHBOWL ST.

(WAIAKAMILO RD. TO FORT ST. MALL)

PROJECT NO. 92A-01-81

FED. ROAD DIST. NO.	STATE	PROJ. NO.	FISCAL YEAR	SHEET NO.	TOTAL SHEETS
HAWAII	HAW.	92 A-01-81	1981	1	14

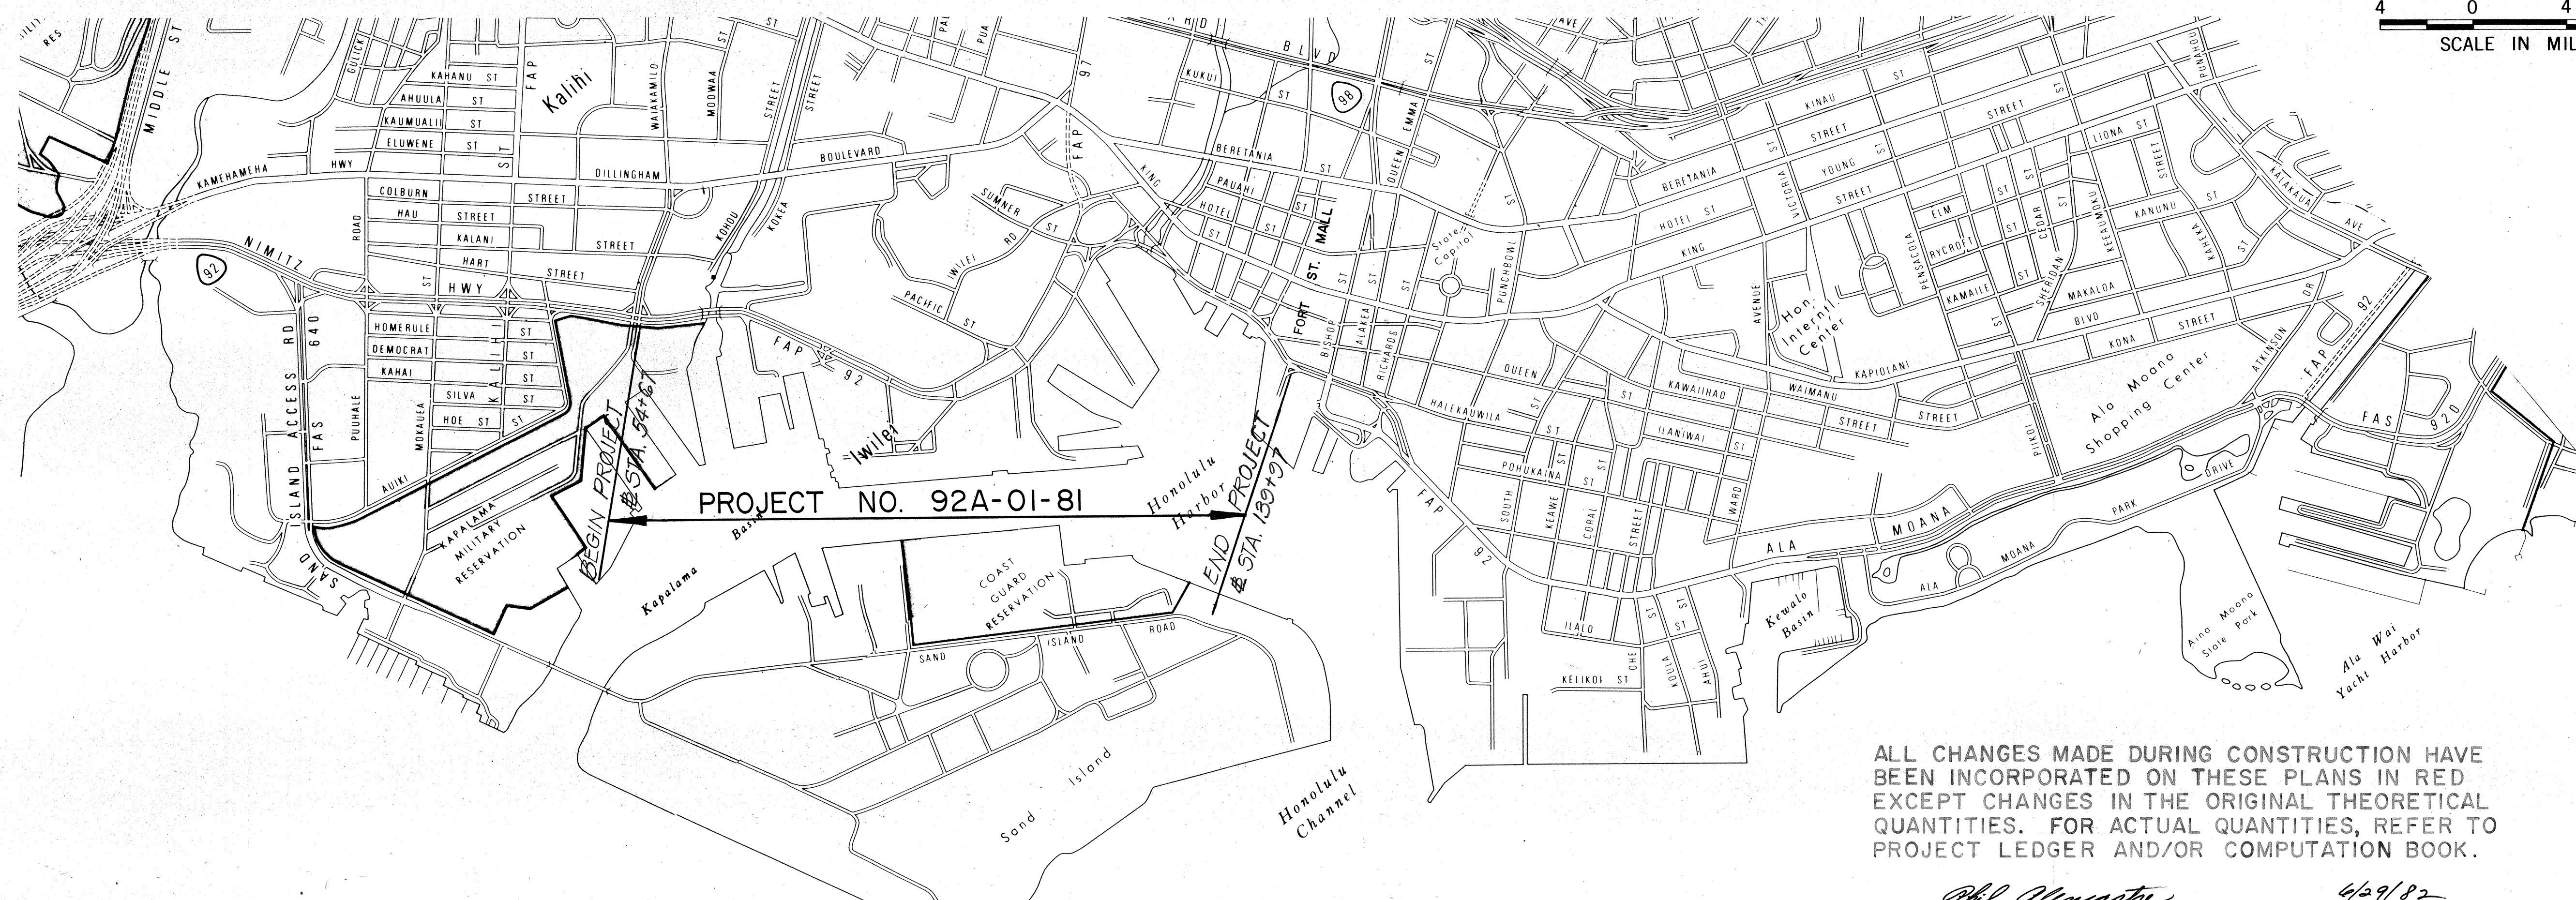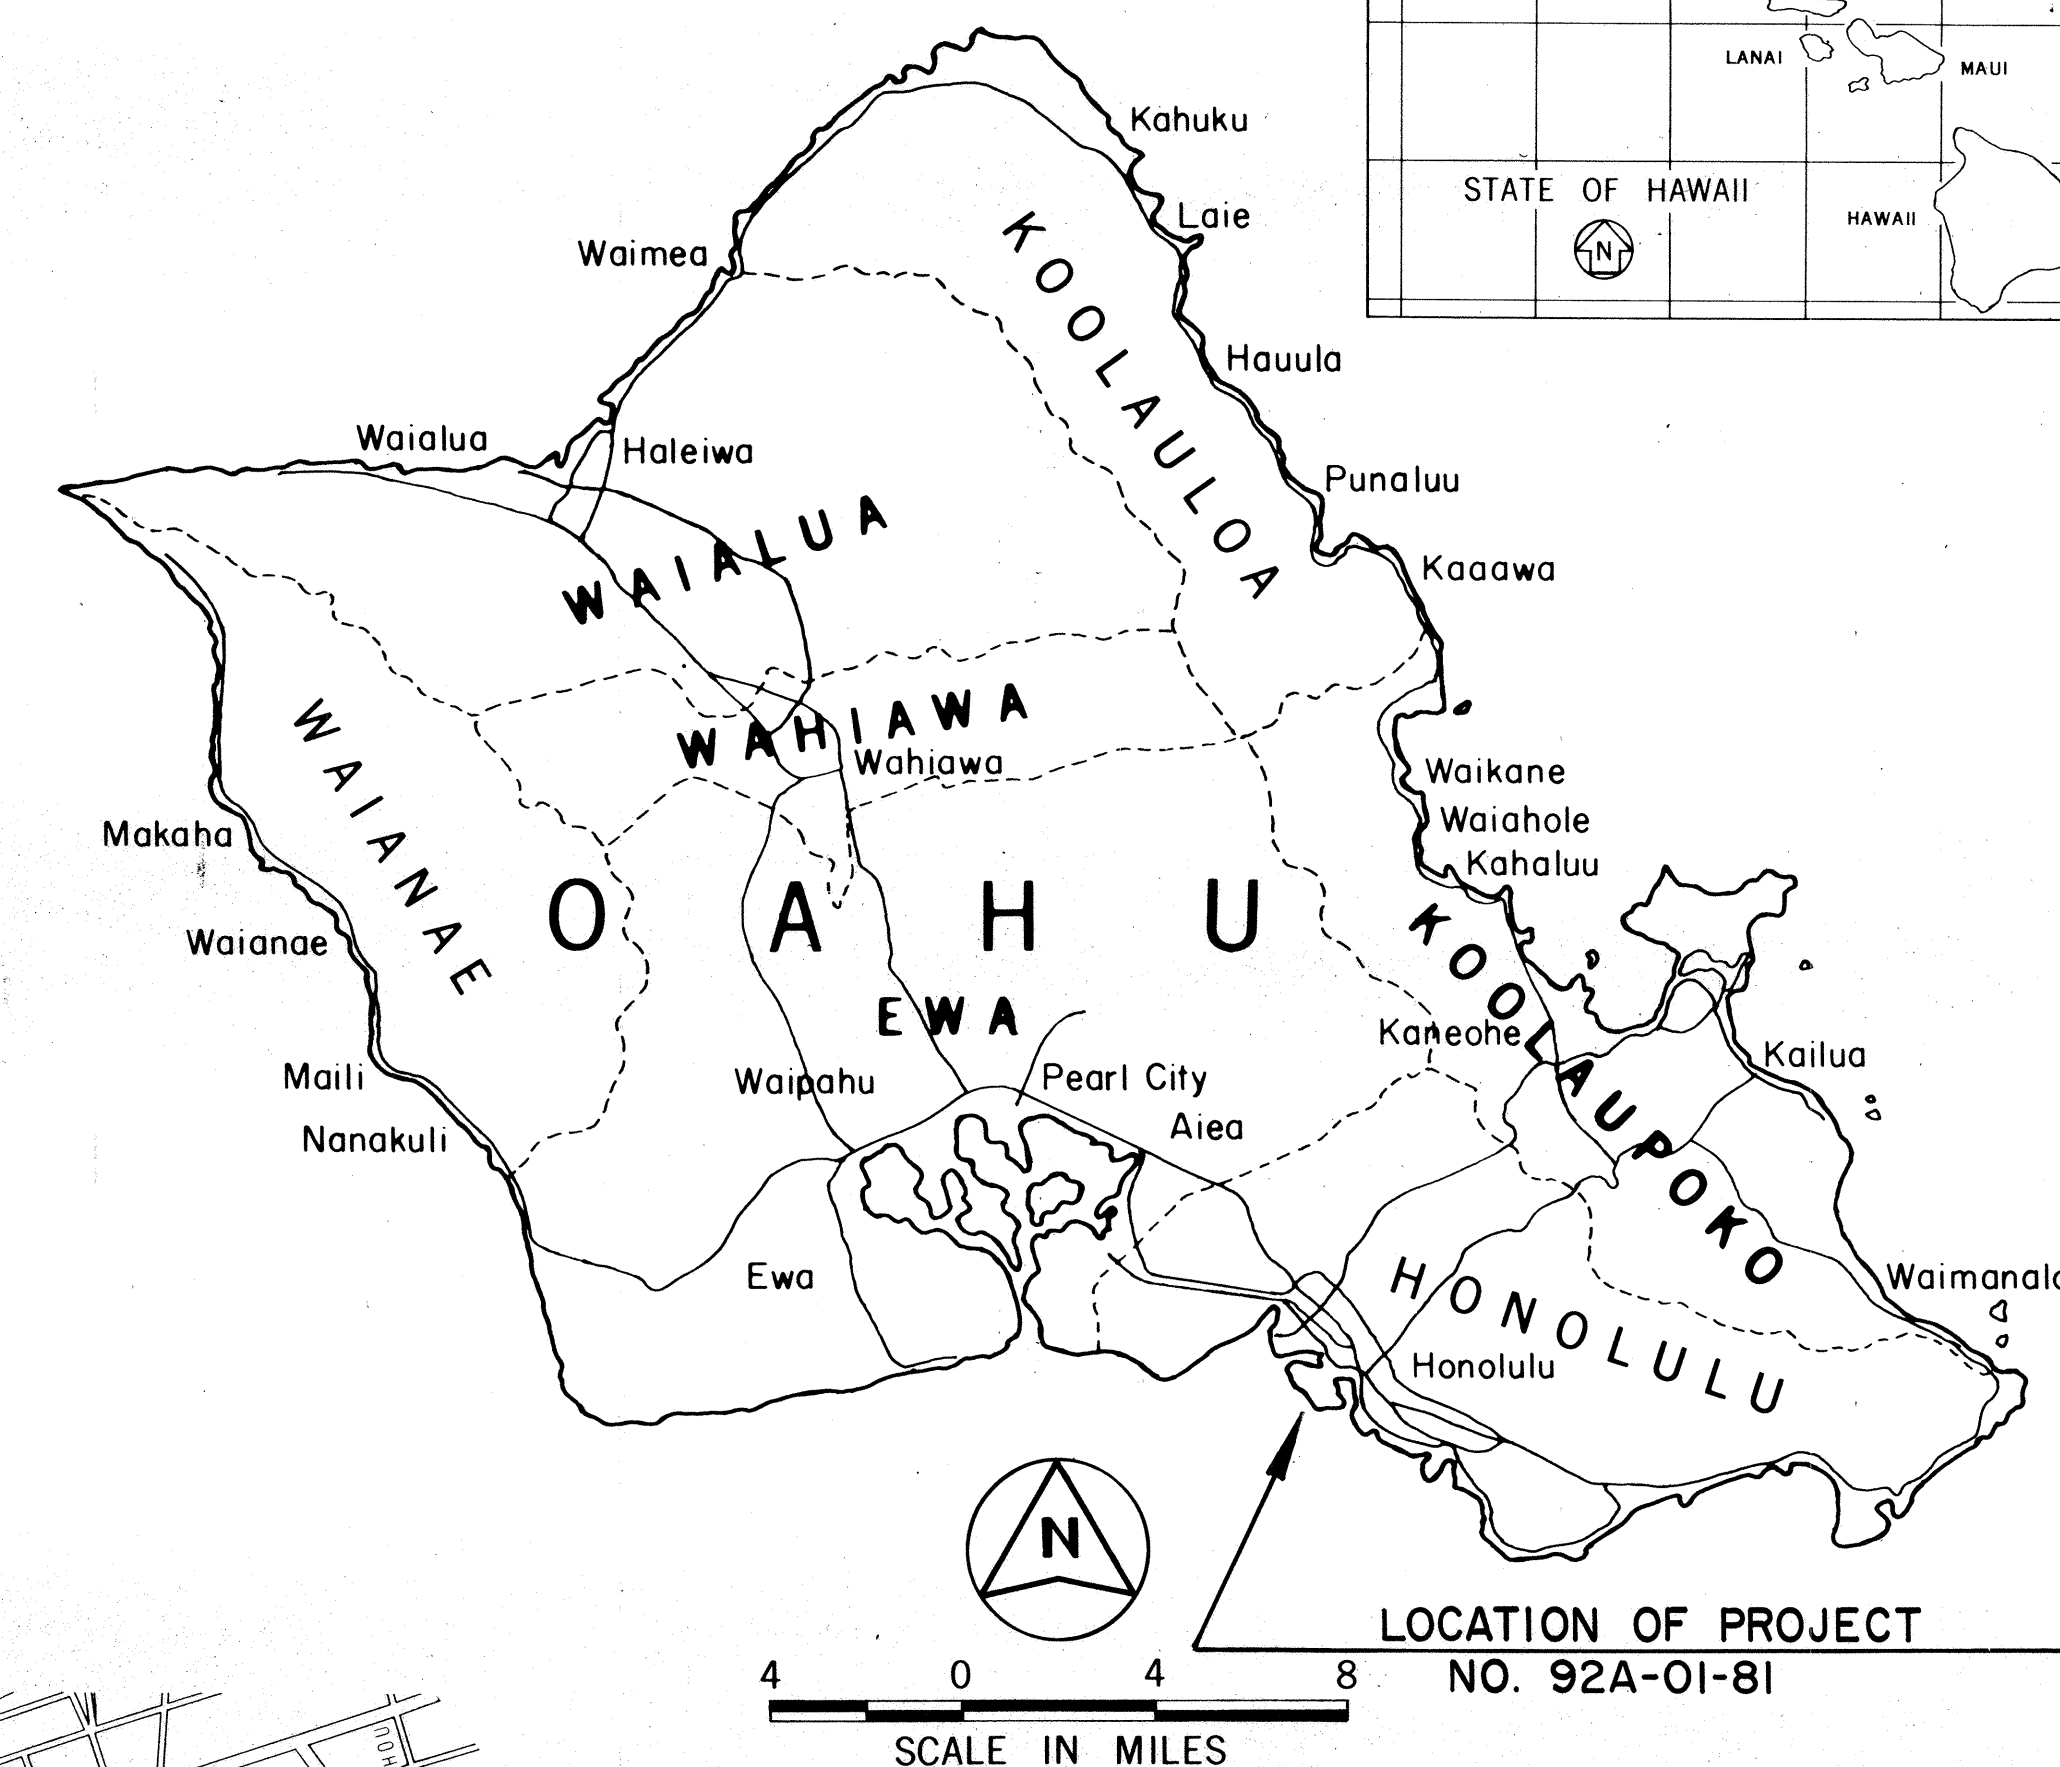

DEPARTMENT OF TRANSPORTATION
STATE OF HAWAII

APPROVED:

James R. Carras 2/25/81

4 DIR. OF TRANSPORTATION DATE

R. Tsuzuki R. Tsuzuki 548-2456 Feb, 1981
DESIGNED BY P. S. & E. BY PHONE DATE

DD-B-7:9