

Remove curb and ac pav't where indicated

grassed surface

curb

a.c. pav't

4" Thick Imported Top Soil and Grassed Surface

12" 12"

Saw Cut and Provide Smooth Connection.

a.c. pav't

exist. pav't structure

Curb, Type 2D

Asphalt Concrete Pavement 1½" Min. Thickness or match exist. thickness, whichever is greater.

6" Thick Recycled Asphalt Treated Base Course


Recompacted Subbase

Diagram illustrating the taper of a curb, labeled "4'-0\" curb taper". The diagram shows a cross-section of a curb and pavement surface. Key dimensions and labels include:

- 4'-0"**: The length of the taper section.
- 6"**: The height of the curb at the start of the taper.
- Varies**: The height of the curb at the end of the taper.
- Labels**: "Begin Curb Taper", "Curb, Type 2D", "Pavement Surface", "Top of Curb", "End Curb Taper", "exist. a.c. curb", "top of pav't", and "Saw Cut and Provide Smooth Connection."

SECTION A
Scale: $\frac{1}{2}'' = 1'-0''$

6, 7, 9 /

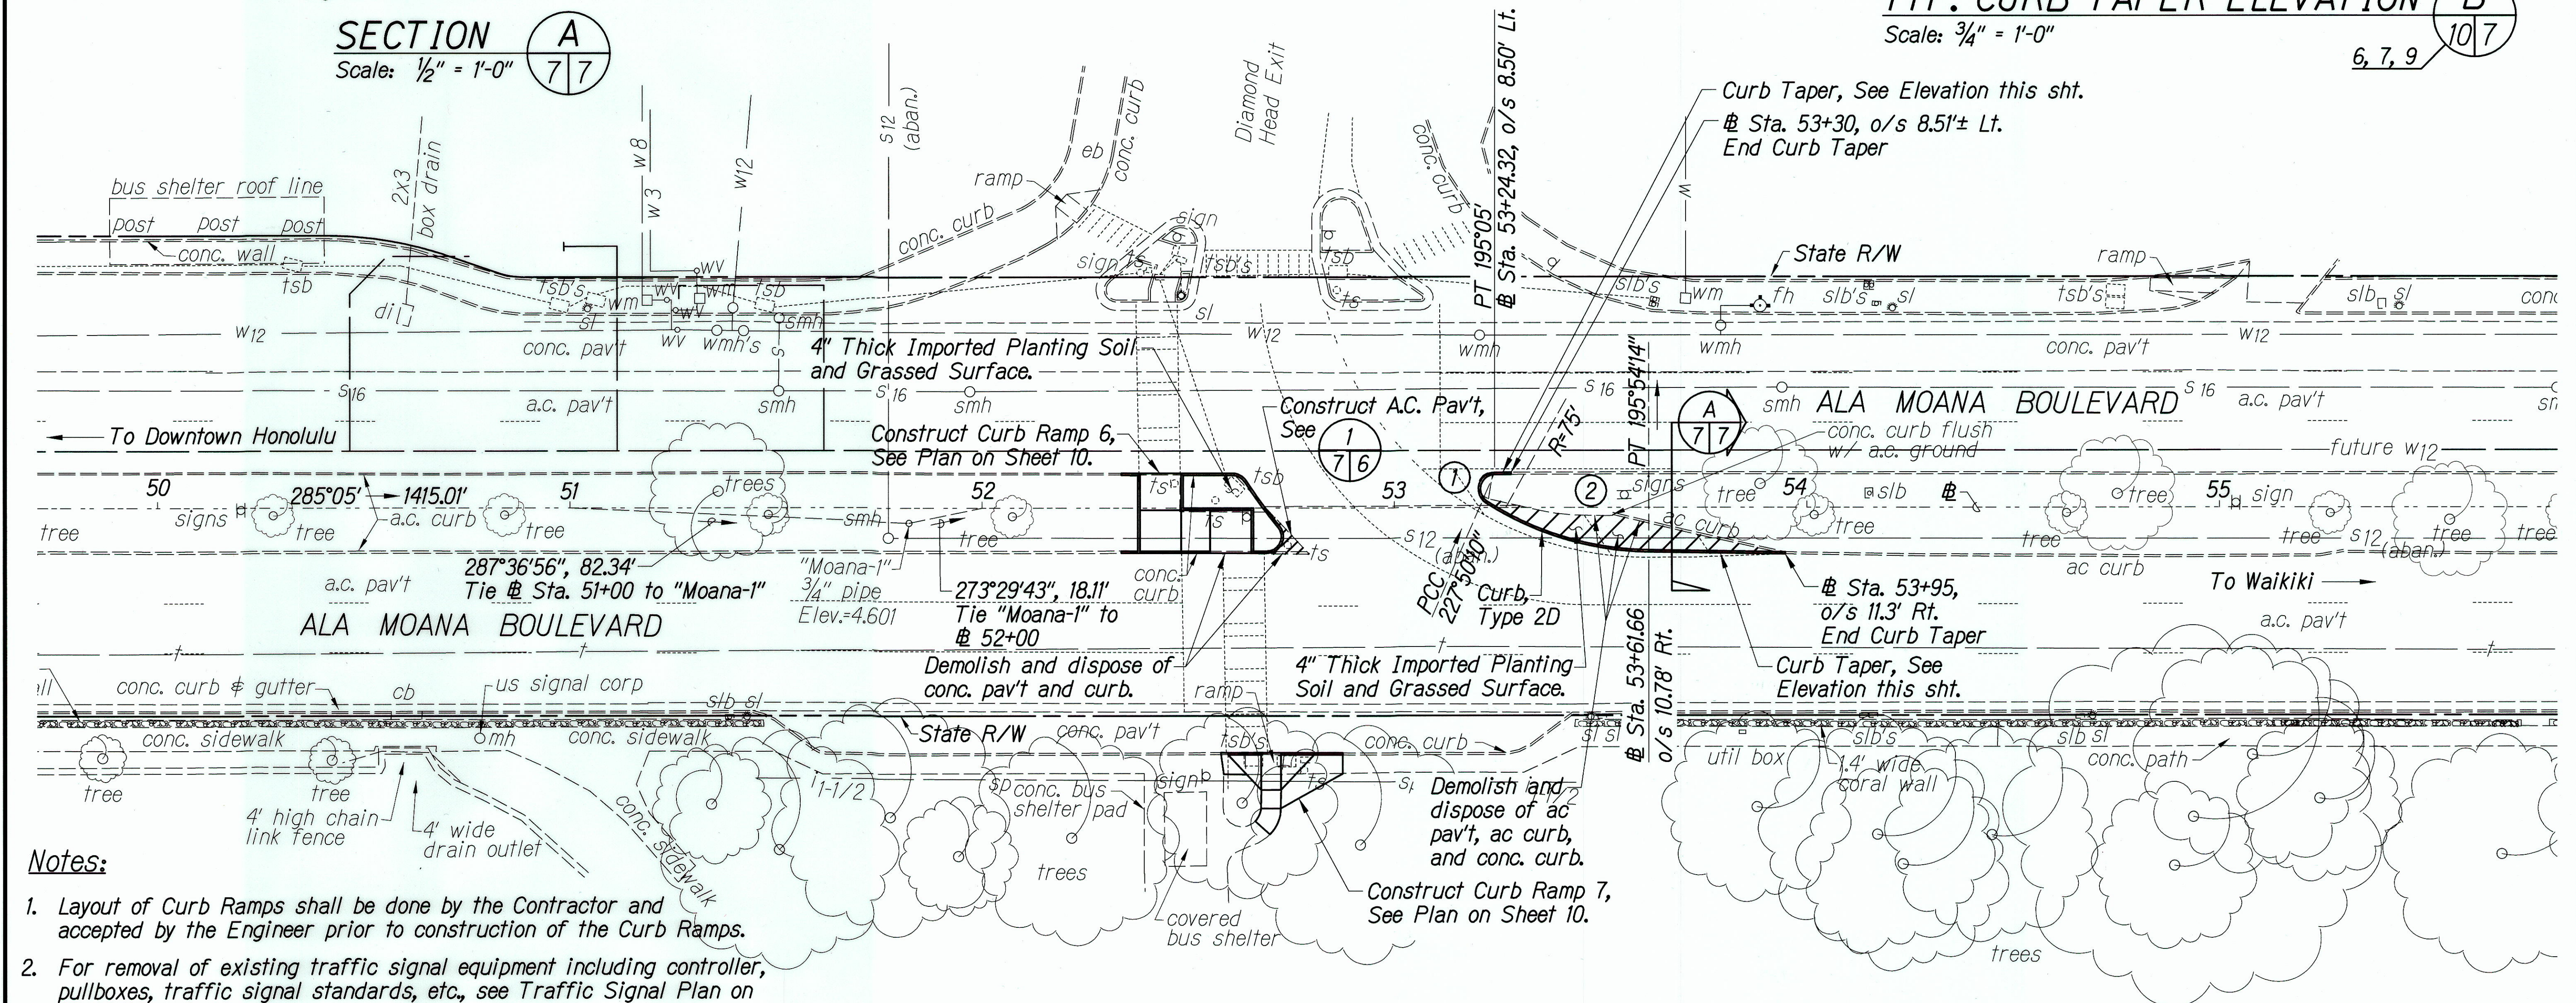

ALA MOANA BEACH PARK
(City and County of Honolulu)
T.M.K.: 2 - 3 - 37 : 001

Scale: 1"=20'

THIS WORK WAS PREPARED BY ME
OR UNDER MY SUPERVISION



SHIMAOBURO ENDO & YOSHIZAKI, INC.
1126 12TH Avenue
Honolulu, Hawaii 96816

C.O. 7