
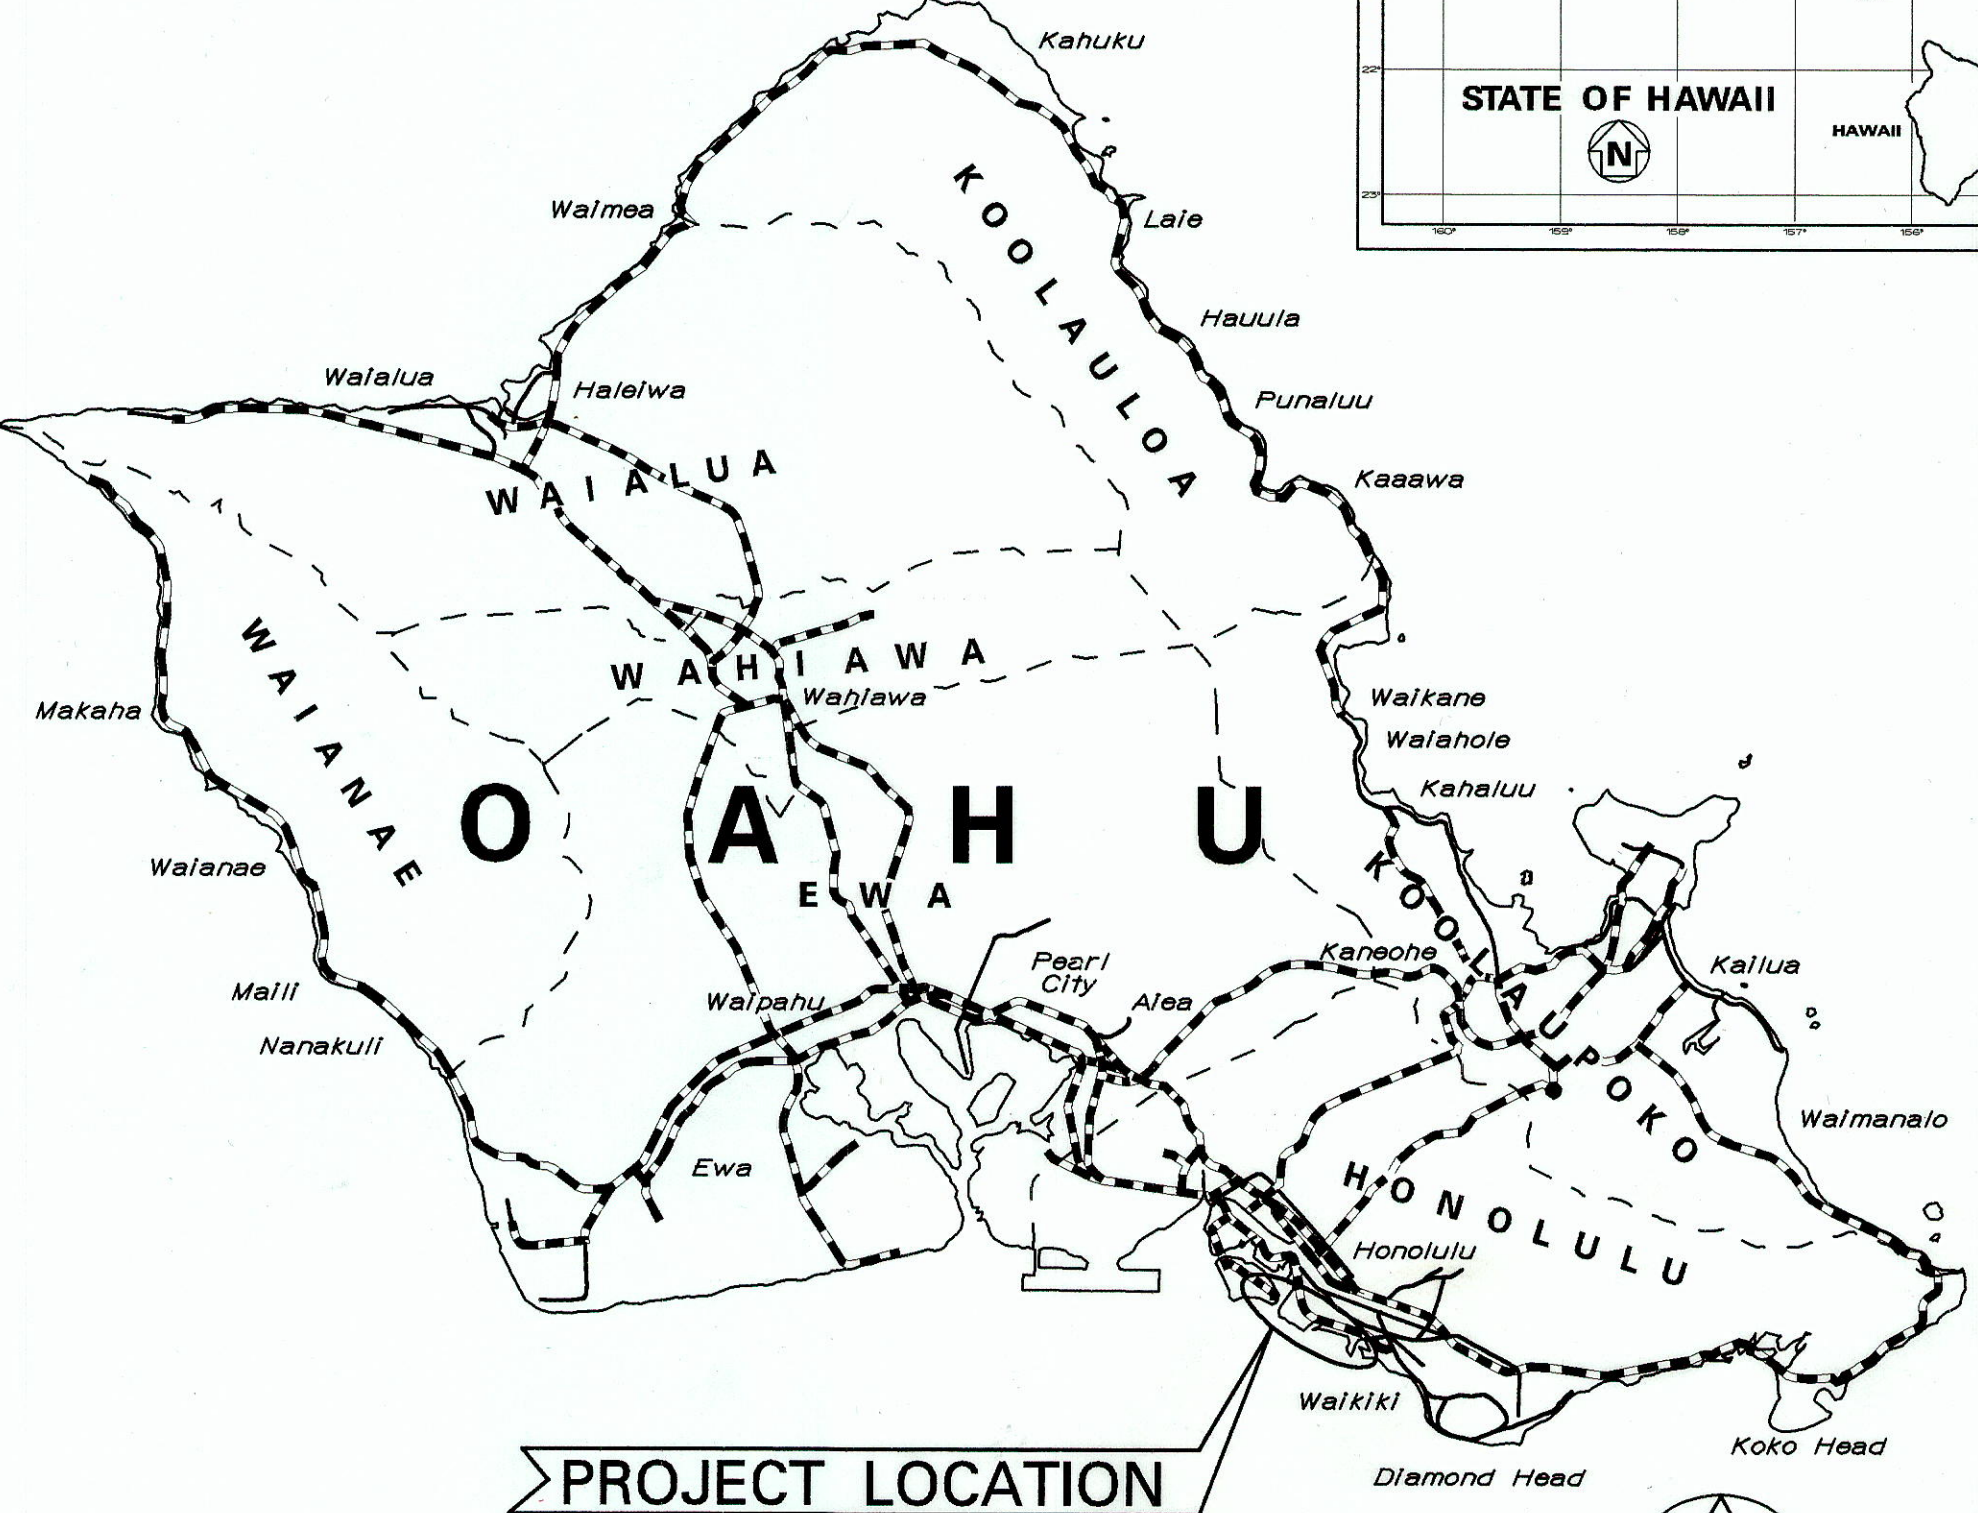


INDEX TO DRAWINGS	
SHEET NO.	DESCRIPTION
1	TITLE SHEET
2	STANDARD PLANS SUMMARY
3-4	GENERAL NOTES
5	NOTES, ABBREVIATIONS AND LEGEND
6	ROADWAY PLAN - ENTRANCE
7	ROADWAY PLAN - EXIT
8-11	MISCELLANEOUS DETAILS
12	PAVEMENT MARKING NOTES AND LEGEND
13	PAVEMENT MARKING PLAN - ENTRANCE
14	PAVEMENT MARKING PLAN - EXIT
15	TRAFFIC SIGNAL NOTES AND LEGEND
16-17	TRAFFIC SIGNAL PLAN - ENTRANCE
18-19	TRAFFIC SIGNAL PLAN - EXIT
20-22	INTERCONNECT CABLE PLANS
23-30	TRAFFIC SIGNAL DETAILS
.	.
.	.
STATE OF HAWAII
DEPARTMENT OF TRANSPORTATION
HIGHWAYS DIVISION
HONOLULU, HAWAII
"AS-BUILT"
PLANS FOR
**ALA MOANA BOULEVARD
TRAFFIC SIGNAL MODERNIZATION
ENTRANCE AND EXIT TO
ALA MOANA SHOPPING CENTER
FEDERAL-AID PROJECT NO. NH-092-1(26)**

DISTRICT OF HONOLULU
ISLAND OF OAHU

FED. ROAD DIST. NO.	STATE	FED. AID PROJ. NO.	FISCAL YEAR	SHEET NO.	TOTAL SHEETS
HAWAII	HAW.	NH-092-1(26)	2002	1	30

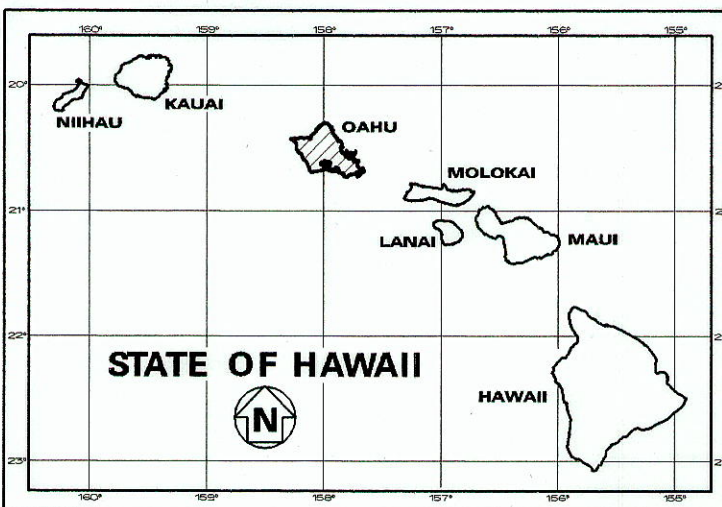

PROJECT LOCATION

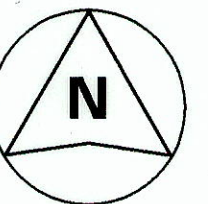

SCALE IN MILES


FEDERAL AID PROJECTS PREVIOUSLY CONSTRUCTED OR UNDER CONSTRUCTION

ALA MOANA BOULEVARD
MILE POST 8.0 TO MILE POST 8.5

CHANGES MADE DURING CONSTRUCTION HAVE BEEN INCORPORATED ON THESE PLANS EXCEPT CHANGES IN THE ORIGINAL THEORETICAL QUANTITIES. FOR ACTUAL QUANTITIES, REFER TO PROJECT LEDGER AND/OR COMPUTATION BOOK.

Maria C. A. Luff 5-29-2014
RESIDENT ENGINEER

DEPARTMENT OF TRANSPORTATION
STATE OF HAWAII
APPROVED: *[Signature]* 2-25-02
for DIR. OF TRANSPORTATION DATE

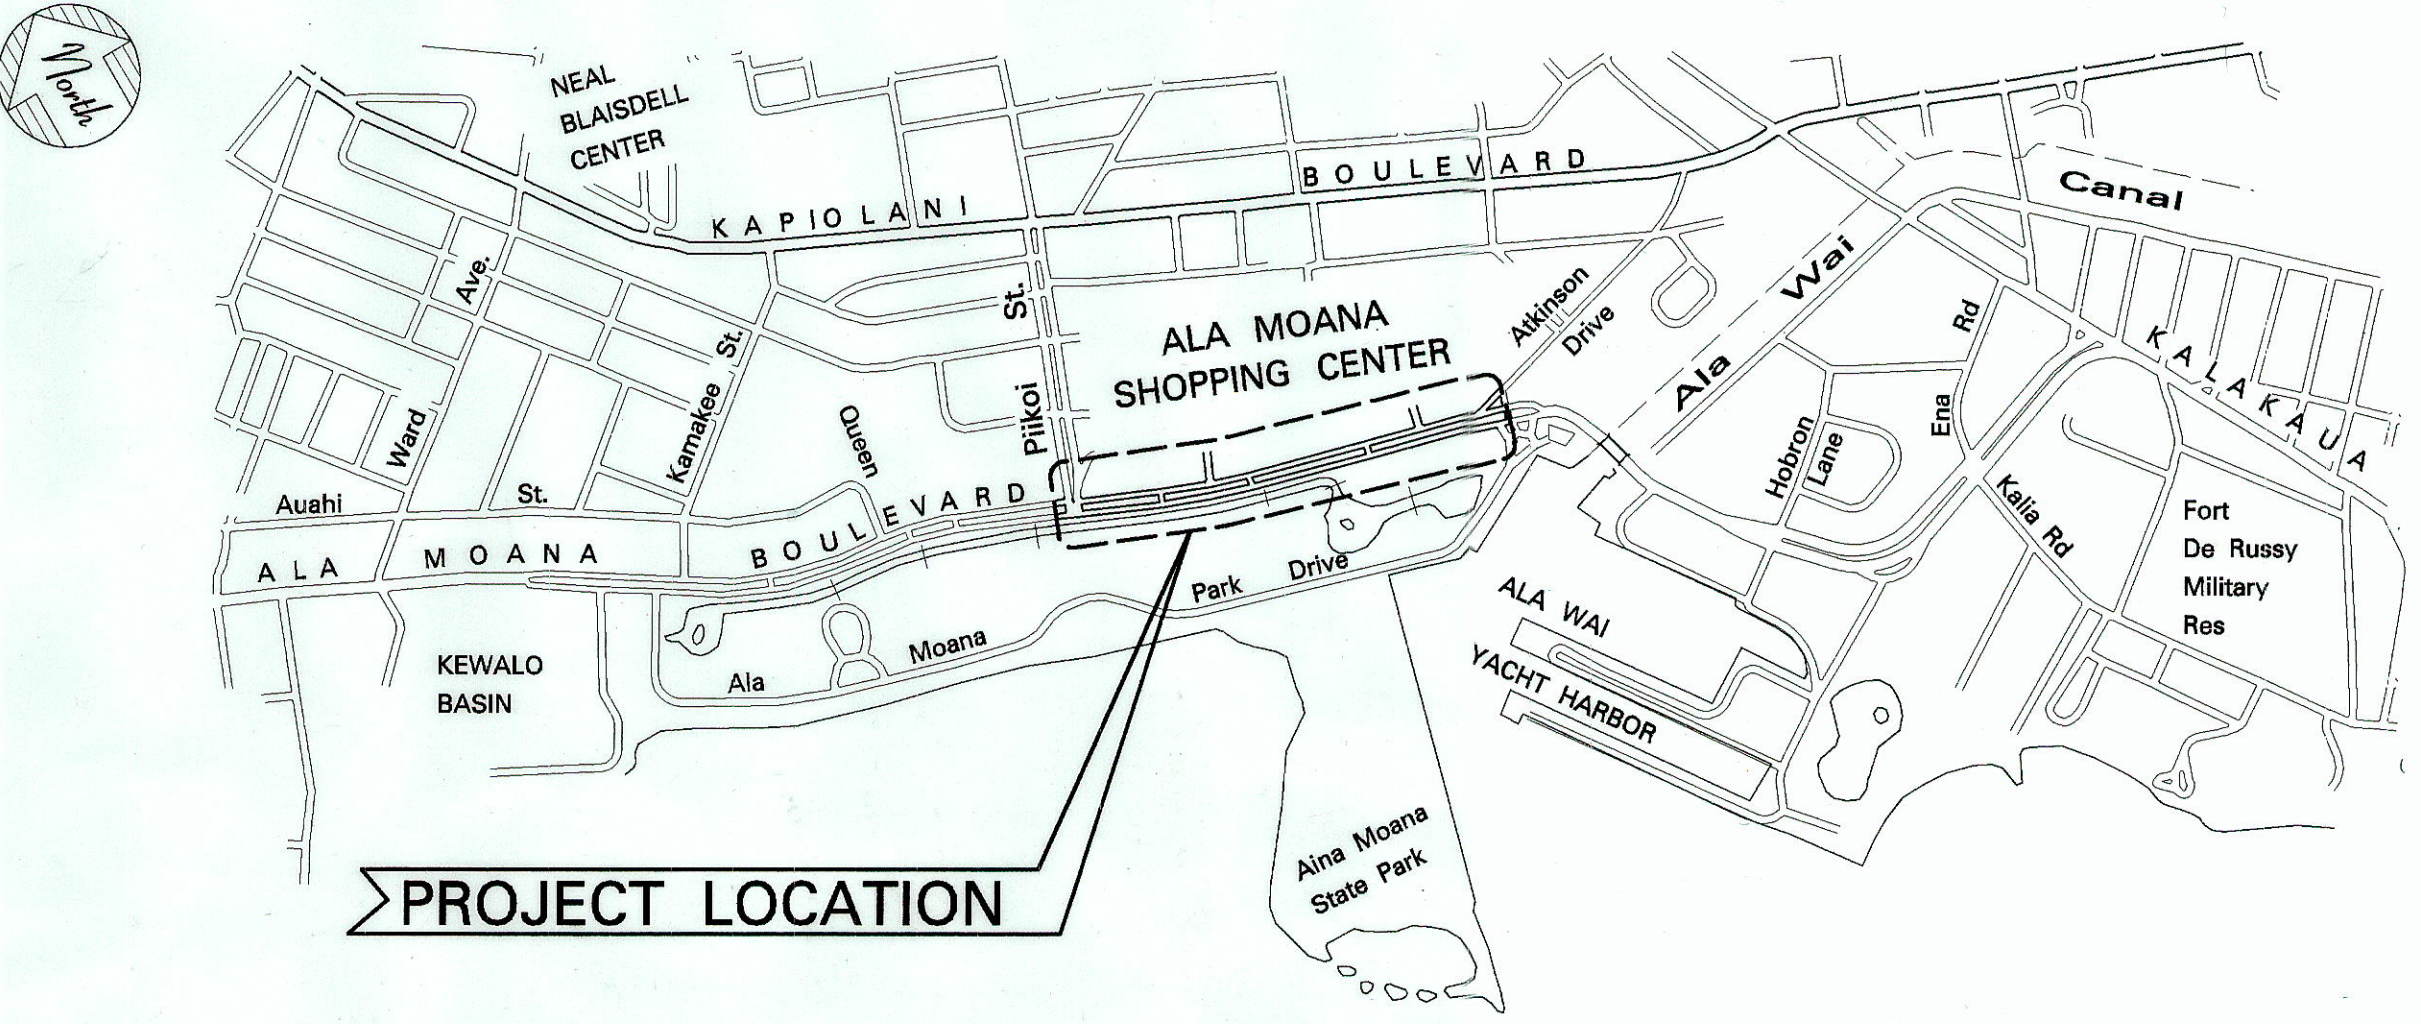

PROJECT LOCATION

LAYOUT PLAN

(ROUTE 76)
SCALE IN FEET

SHIMABUKURO, ENDO & YOSHIZAKI, INC. DESIGNED BY
KARL KUNISHIGE P. S. & E. BY
692-7679 PHONE
FEBRUARY, 2002 DATE