






| FED. ROAD DIST. NO. | STATE | PROJ. NO. | FISCAL YEAR | SHEET NO. | TOTAL SHEETS |
|---------------------|-------|-----------|-------------|-----------|--------------|
| HAWAII              | HAW.  | 92A-01-03 | 2003        | 20        | 69           |

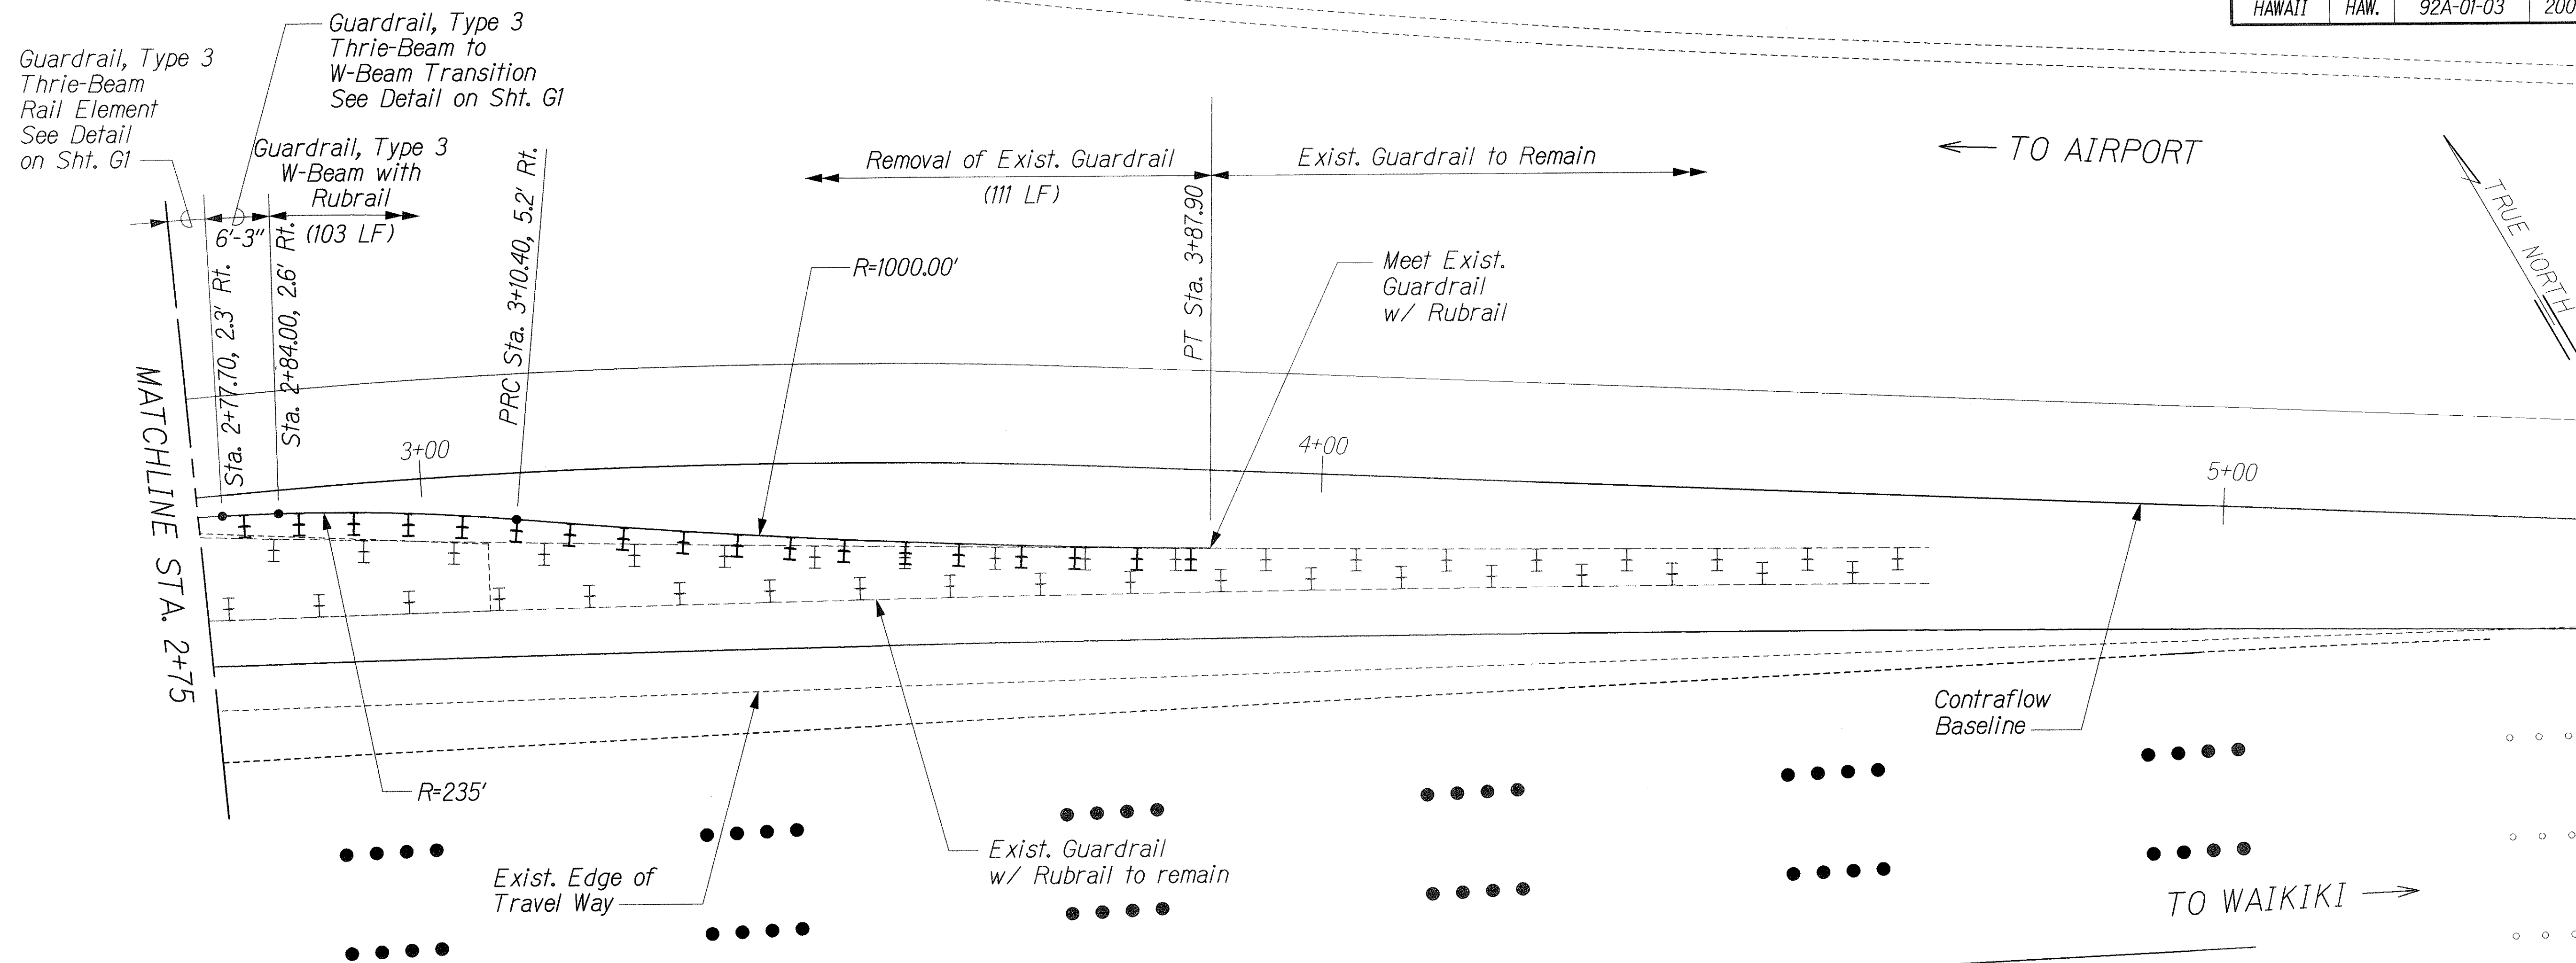

NOTES:

1. Closure of Contraflow lane shall proceed in the direction of Crossover I to Crossover-IV.
2. Place barricades to close crossover during non-operation hours of the Contraflow lane. Remove barricades prior to operation.
3. Barricades shall be in place at every crossover before removal of Contraflow traffic cones.
4. Operating hours for Contraflow Traffic Control shall be from 5:00 a.m. to 9:00 a.m. Opening and closing of crossovers shall be scheduled to maintain these hours.

R/W

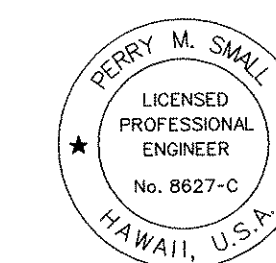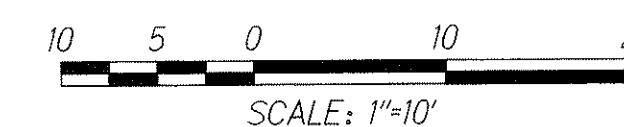

THIS WORK WAS PREPARED BY ME  
OR UNDER MY SUPERVISION.  
*Perry M. Small*

STATE OF HAWAII  
DEPARTMENT OF TRANSPORTATION  
HIGHWAYS DIVISION


**ROADWAY PLAN**  
**CROSSOVER - I**

NIMITZ HIGHWAY IMPROVEMENTS  
KEEHI INTERCHANGE TO PACIFIC STREET  
PROJECT NO. 92A-01-03

Scale: 1"=10' Date: March 2, 2003

SHEET No. C2 OF 10 SHEETS

| FED. ROAD DIST. NO. | STATE | PROJ. NO. | FISCAL YEAR | SHEET NO. | TOTAL SHEETS |
|---------------------|-------|-----------|-------------|-----------|--------------|
| HAWAII              | HAW.  | 92A-01-03 | 2003        | 21        | 69           |

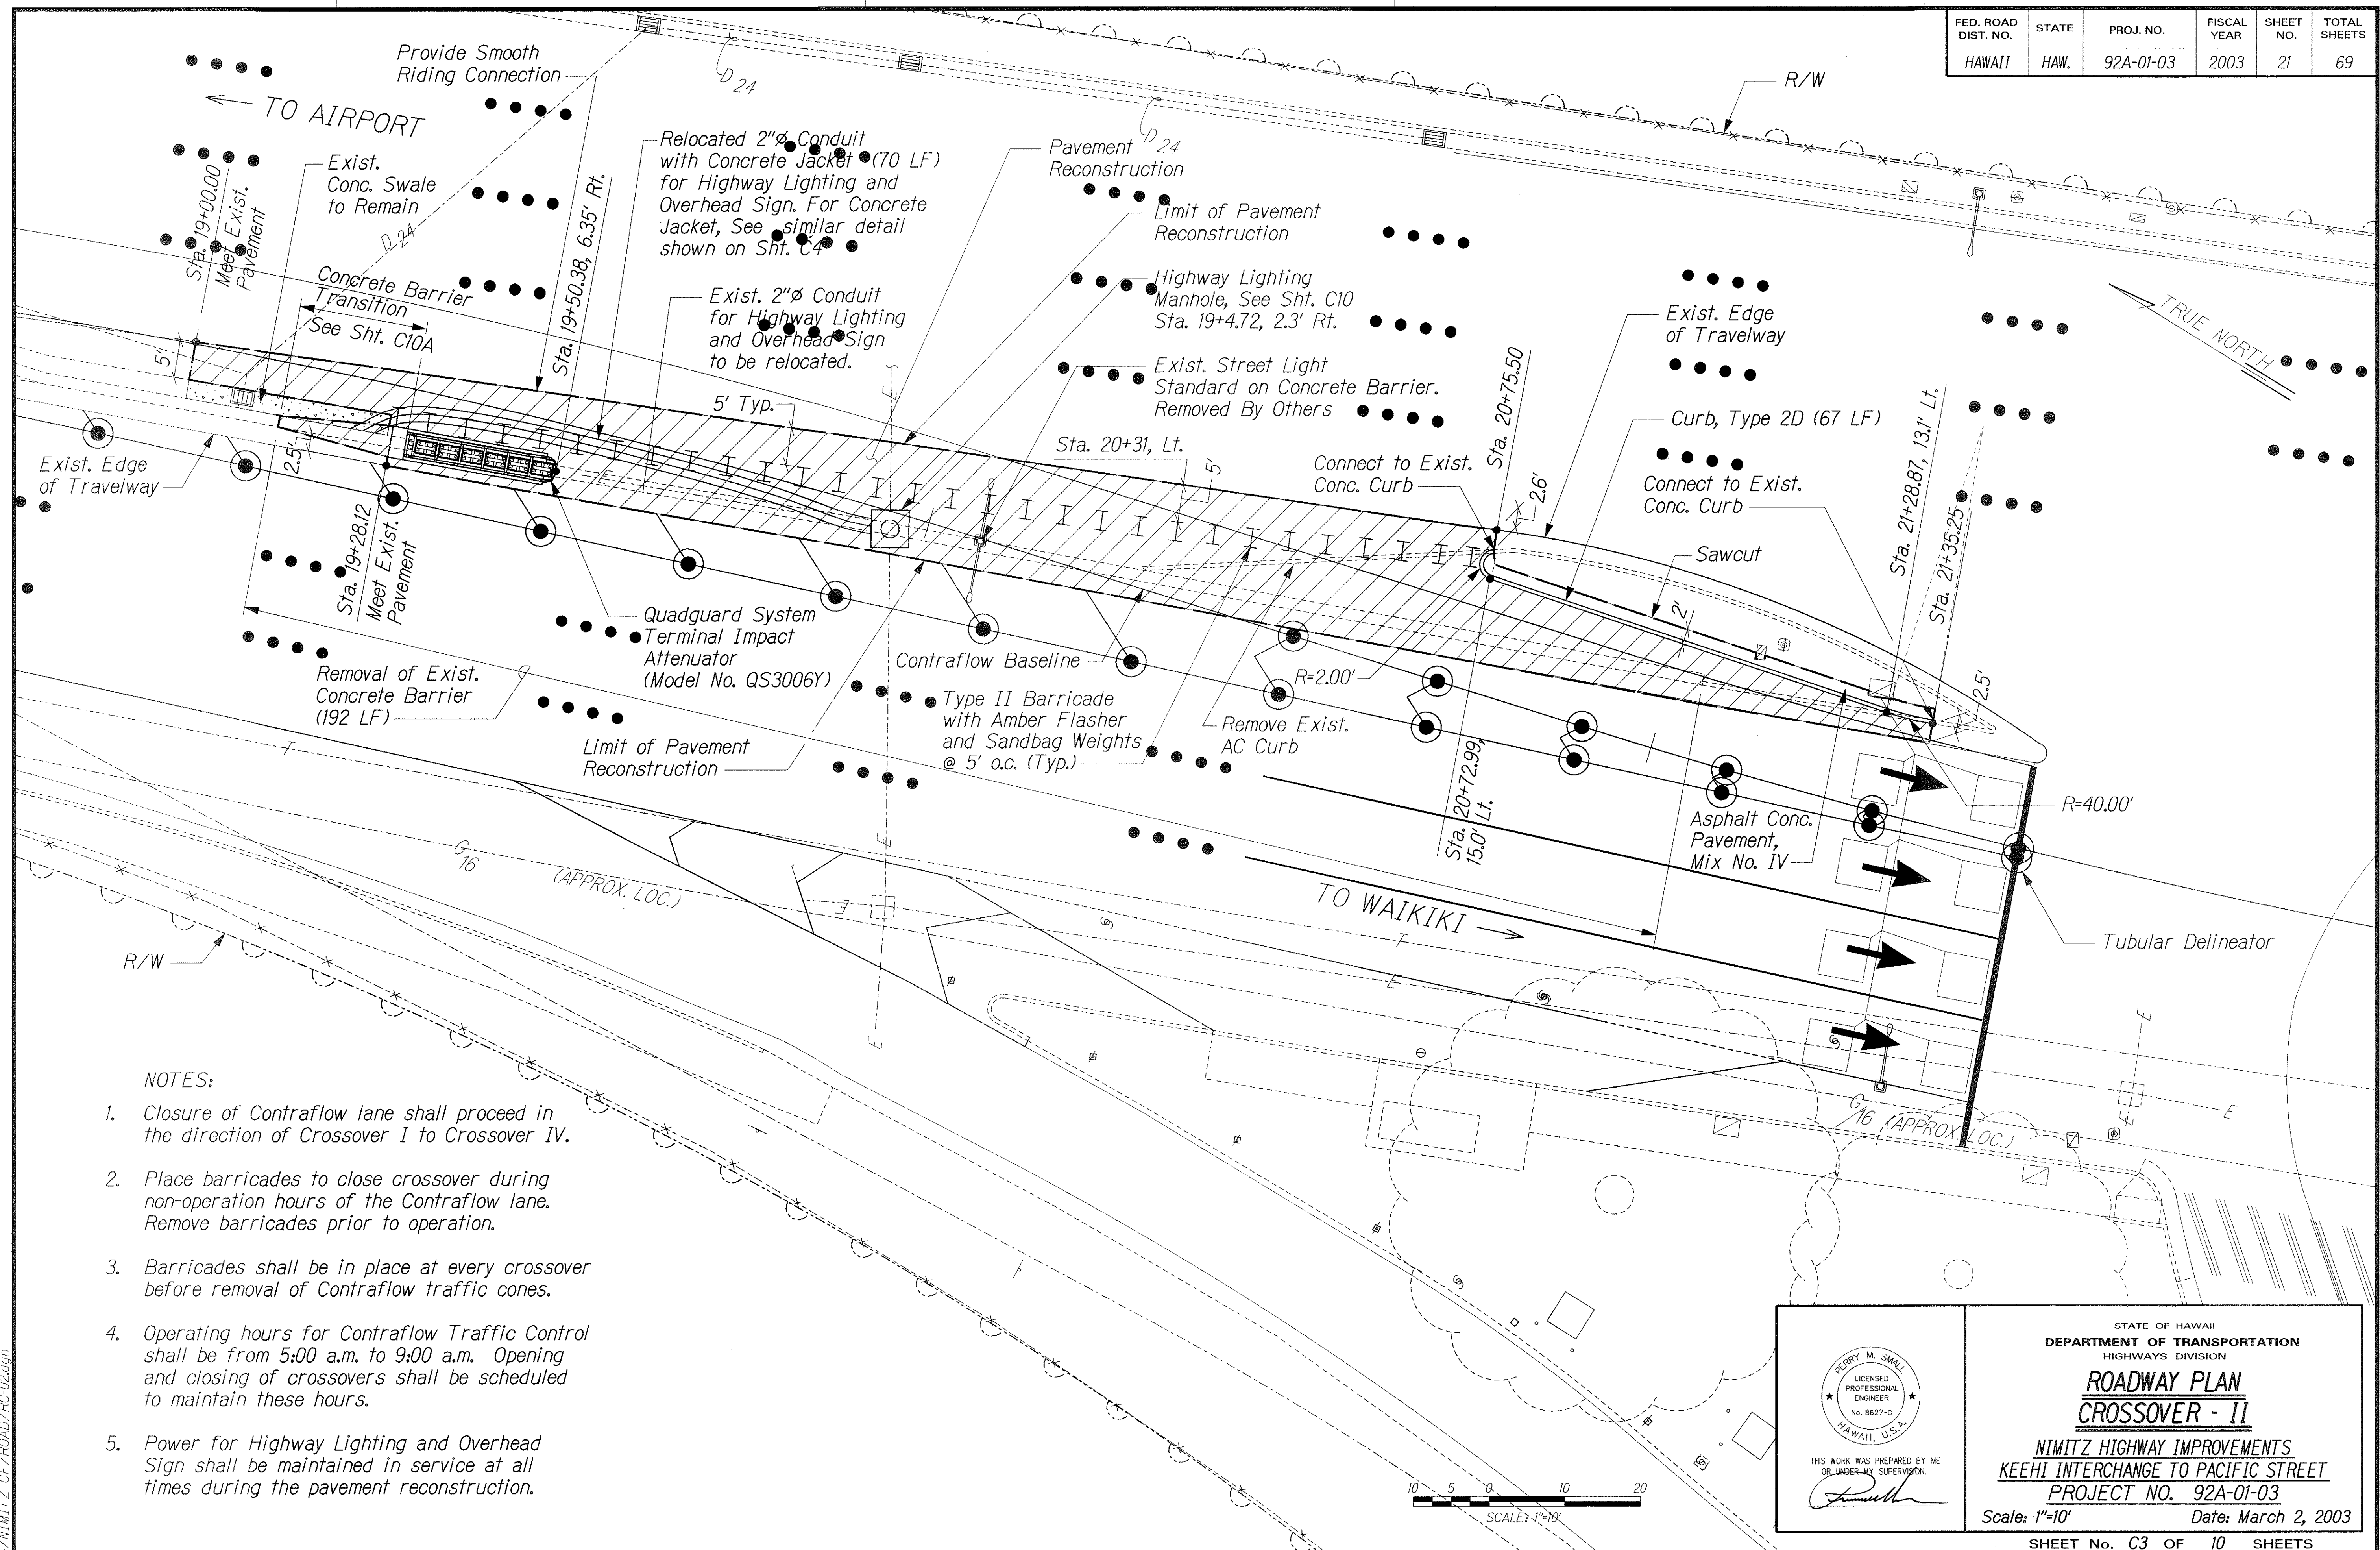

**NOTES:**

1. Closure of Contraflow lane shall proceed in the direction of Crossover I to Crossover IV.
2. Place barricades to close crossover during non-operation hours of the Contraflow lane. Remove barricades prior to operation.
3. Barricades shall be in place at every crossover before removal of Contraflow traffic cones.
4. Operating hours for Contraflow Traffic Control shall be from 5:00 a.m. to 9:00 a.m. Opening and closing of crossovers shall be scheduled to maintain these hours.
5. Power for Highway Lighting and Overhead Sign shall be maintained in service at all times during the pavement reconstruction.

|               |      |
|---------------|------|
| ORIGINAL PLAN | DATE |
| DESIGNED BY   |      |
| NOTED BY      |      |
| CHECKED BY    |      |

U:\NIMITZ CF ROAD\RC-02.dgn





THIS WORK WAS PREPARED BY ME OR UNDER MY SUPERVISION.

STATE OF HAWAII  
DEPARTMENT OF TRANSPORTATION  
HIGHWAYS DIVISION

**ROADWAY PLAN**  
**CROSSOVER - II**


NIMITZ HIGHWAY IMPROVEMENTS  
KEEHI INTERCHANGE TO PACIFIC STREET  
PROJECT NO. 92A-01-03  
Scale: 1"=10' Date: March 2, 2003  
SHEET No. C3 OF 10 SHEETS

| FED. ROAD DIST. NO. | STATE | PROJ. NO. | FISCAL YEAR | SHEET NO. | TOTAL SHEETS |
|---------------------|-------|-----------|-------------|-----------|--------------|
| HAWAII              | HAW.  | 92A-01-03 | 2003        | 22        | 69           |

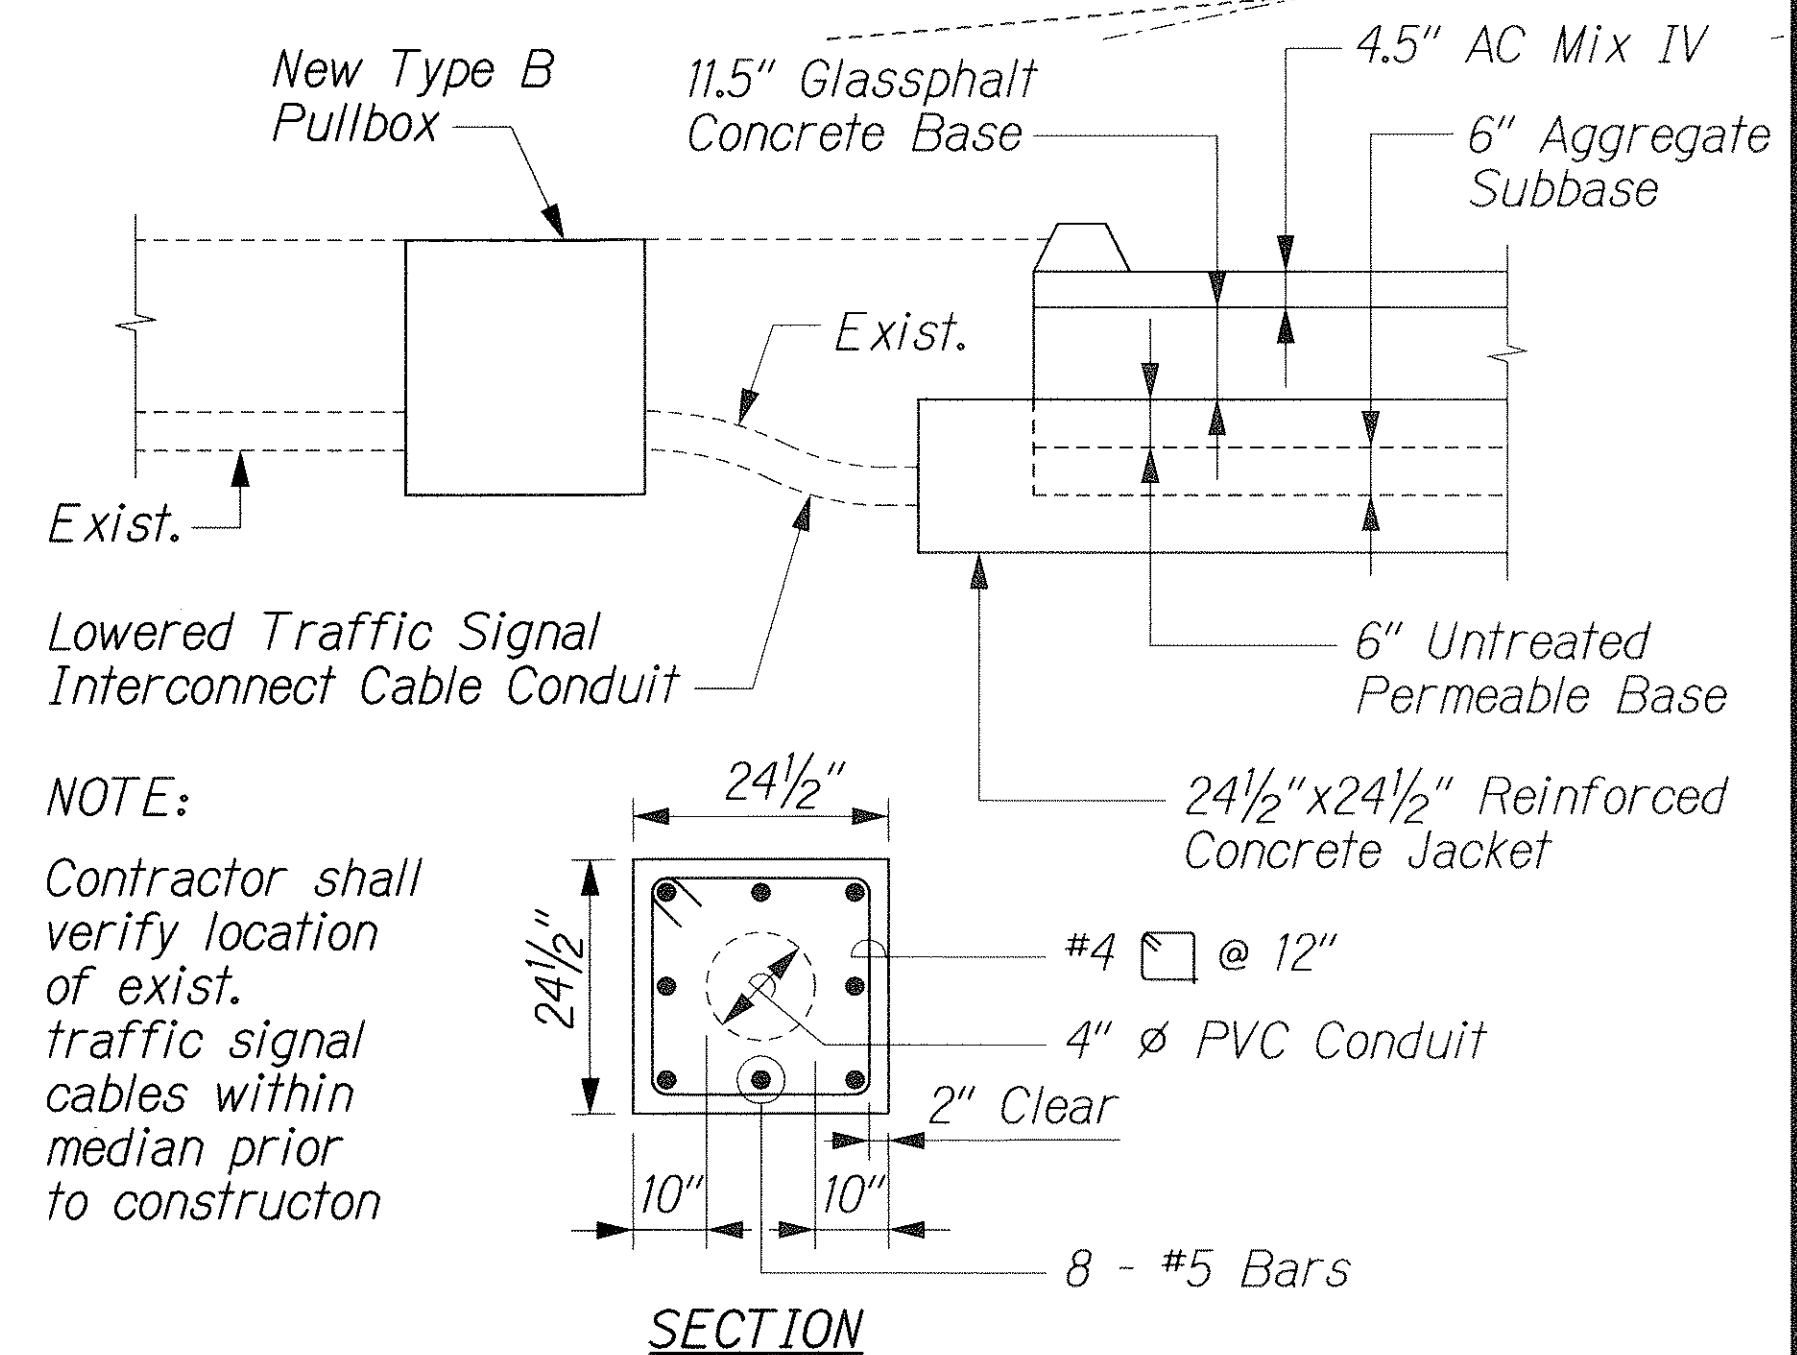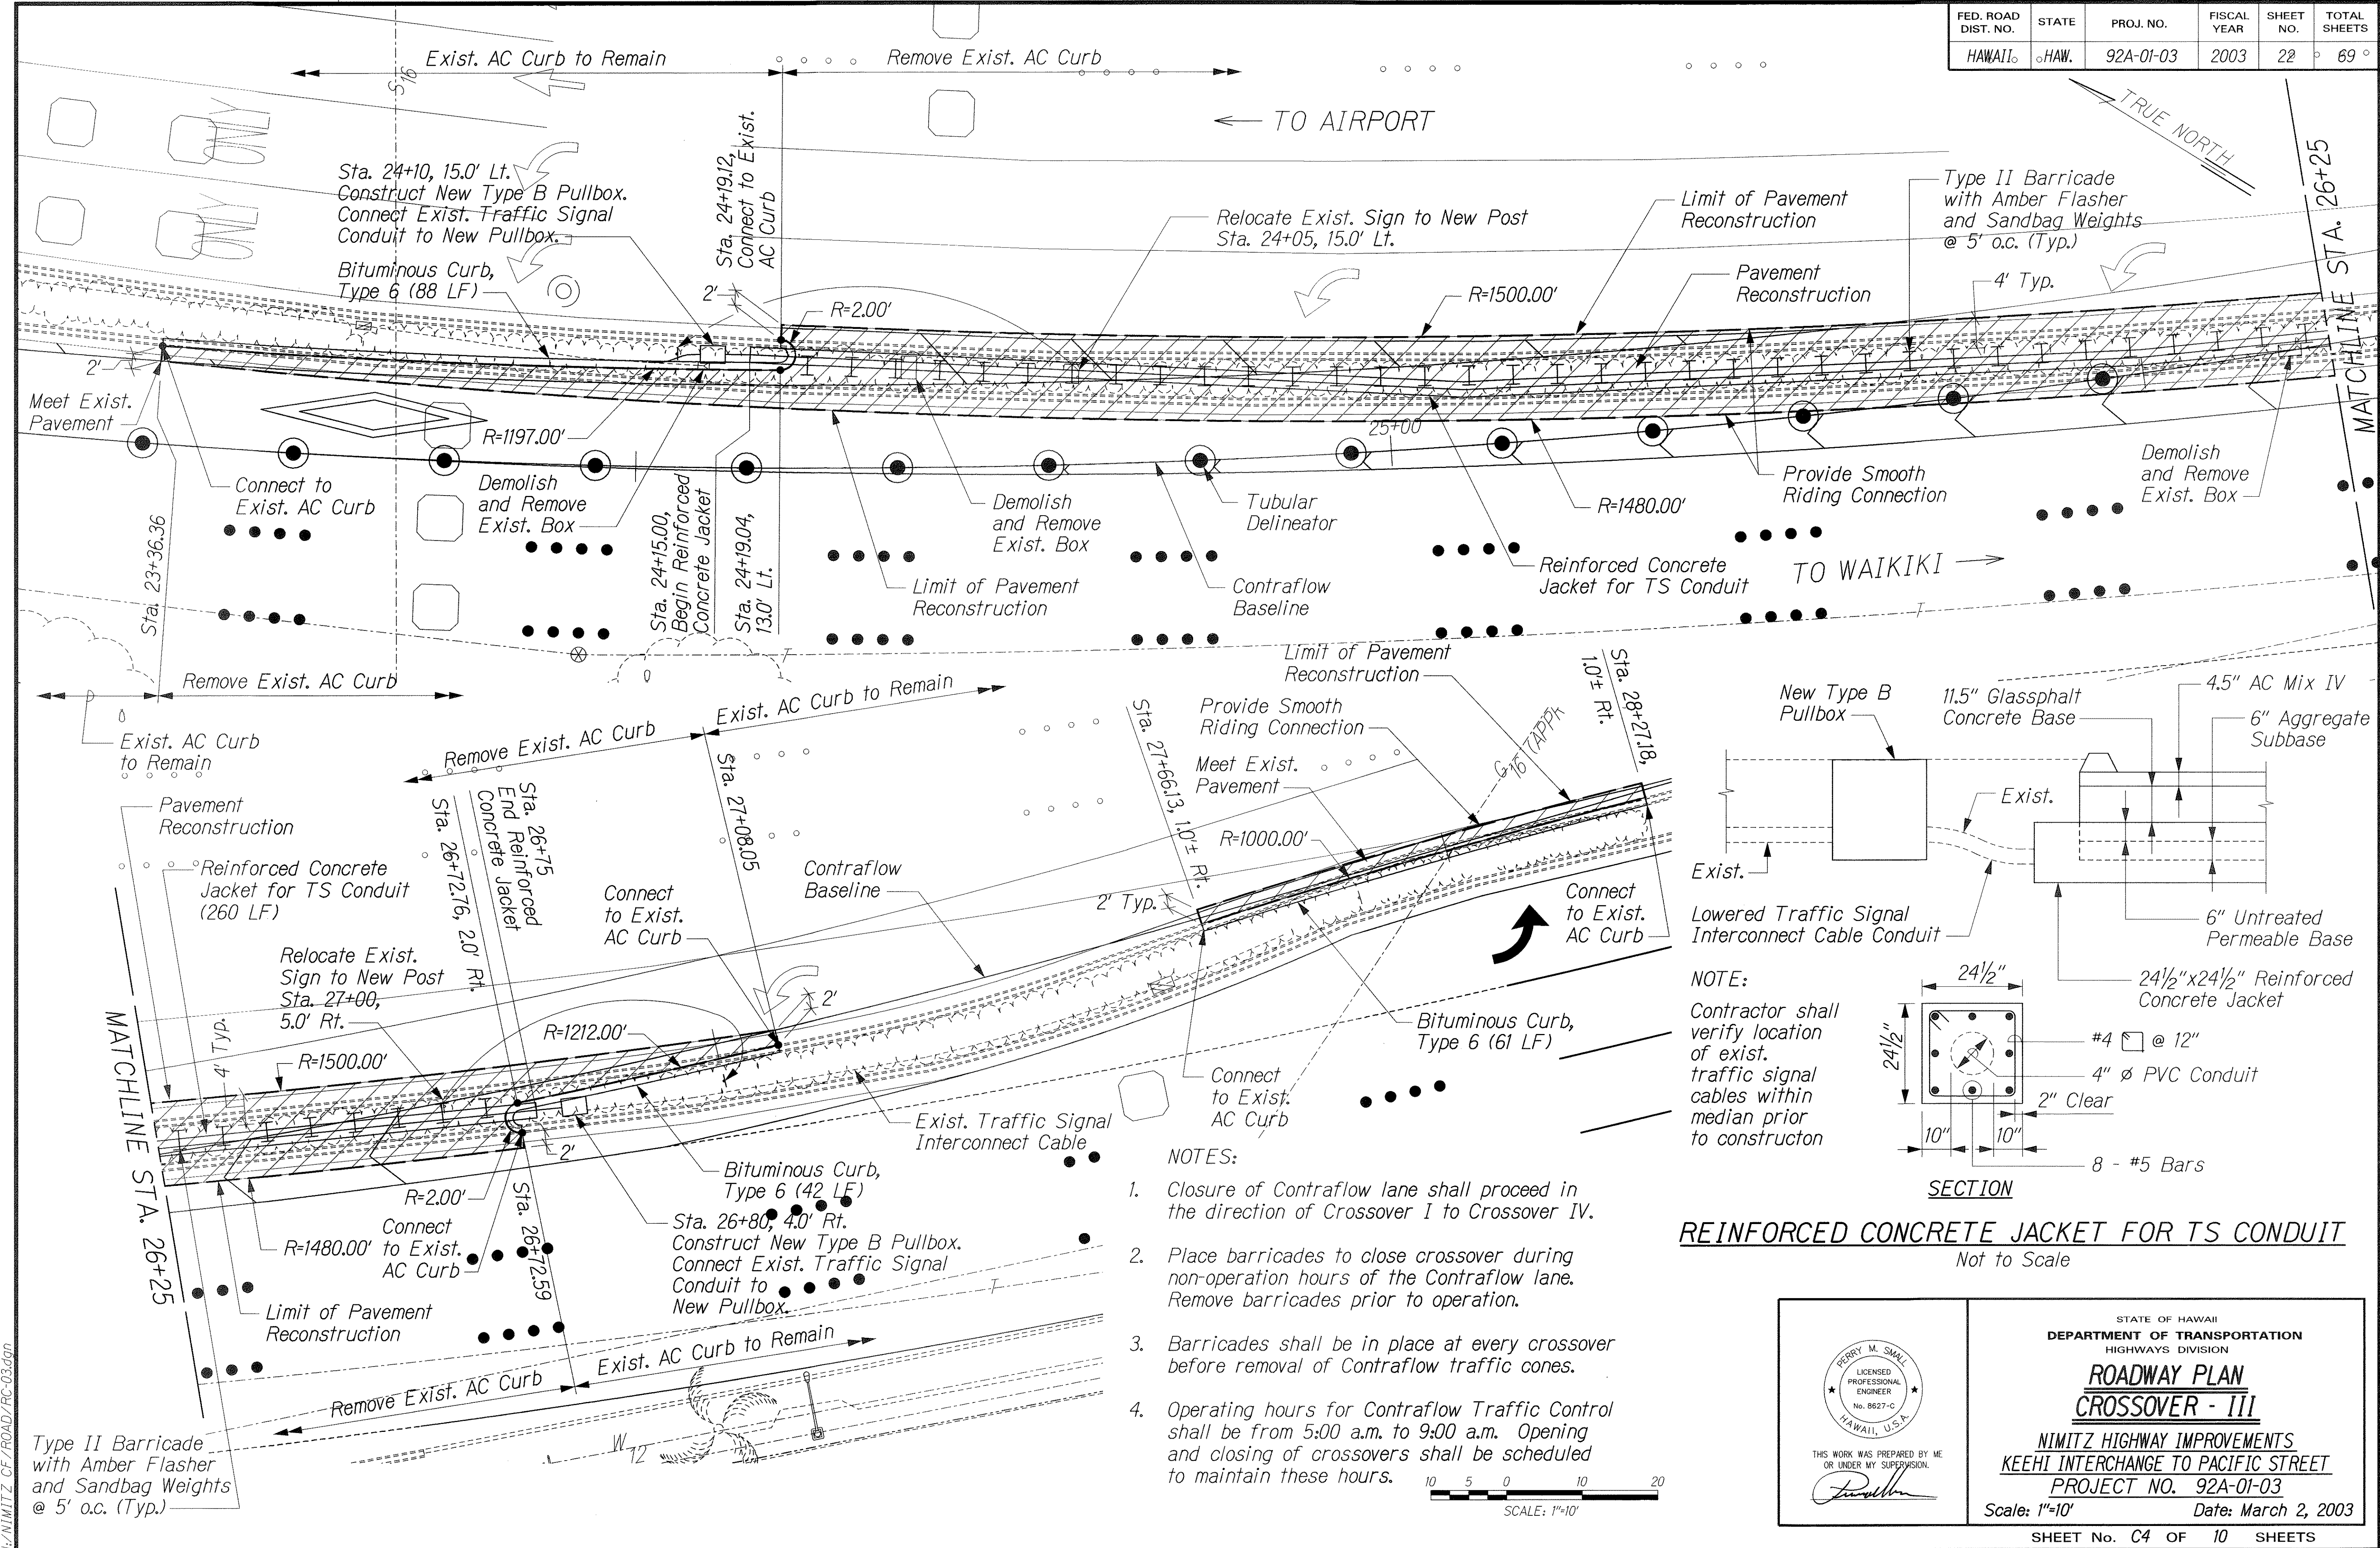

REINFORCED CONCRETE JACKET FOR TS CONDUIT  
Not to Scale

- NOTES:
- Closure of Contraflow lane shall proceed in the direction of Crossover I to Crossover IV.
  - Place barricades to close crossover during non-operation hours of the Contraflow lane. Remove barricades prior to operation.
  - Barricades shall be in place at every crossover before removal of Contraflow traffic cones.
  - Operating hours for Contraflow Traffic Control shall be from 5:00 a.m. to 9:00 a.m. Opening and closing of crossovers shall be scheduled to maintain these hours.

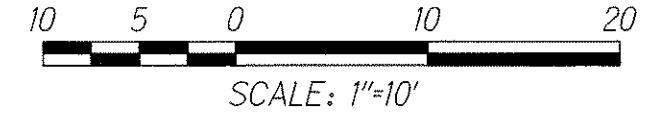

THIS WORK WAS PREPARED BY ME OR UNDER MY SUPERVISION.

*Perry M. Small*

STATE OF HAWAII  
DEPARTMENT OF TRANSPORTATION  
HIGHWAYS DIVISION

**ROADWAY PLAN**  
**CROSSOVER - III**

NIMITZ HIGHWAY IMPROVEMENTS  
KEEHI INTERCHANGE TO PACIFIC STREET  
PROJECT NO. 92A-01-03  
Scale: 1"=10' Date: March 2, 2003

SHEET No. C4 OF 10 SHEETS

|                   |      |
|-------------------|------|
| SURVEY PLOTTED BY | DATE |
| DRAWN BY          |      |
| DESIGNED BY       |      |
| QUANTITIES BY     |      |
| CHECKED BY        |      |

