


FED. ROAD DIST. NO.	STATE	PROJ. NO.	FISCAL YEAR	SHEET NO.	TOTAL SHEETS
HAWAII	HAW.	92A-01-03	2003	24R	69

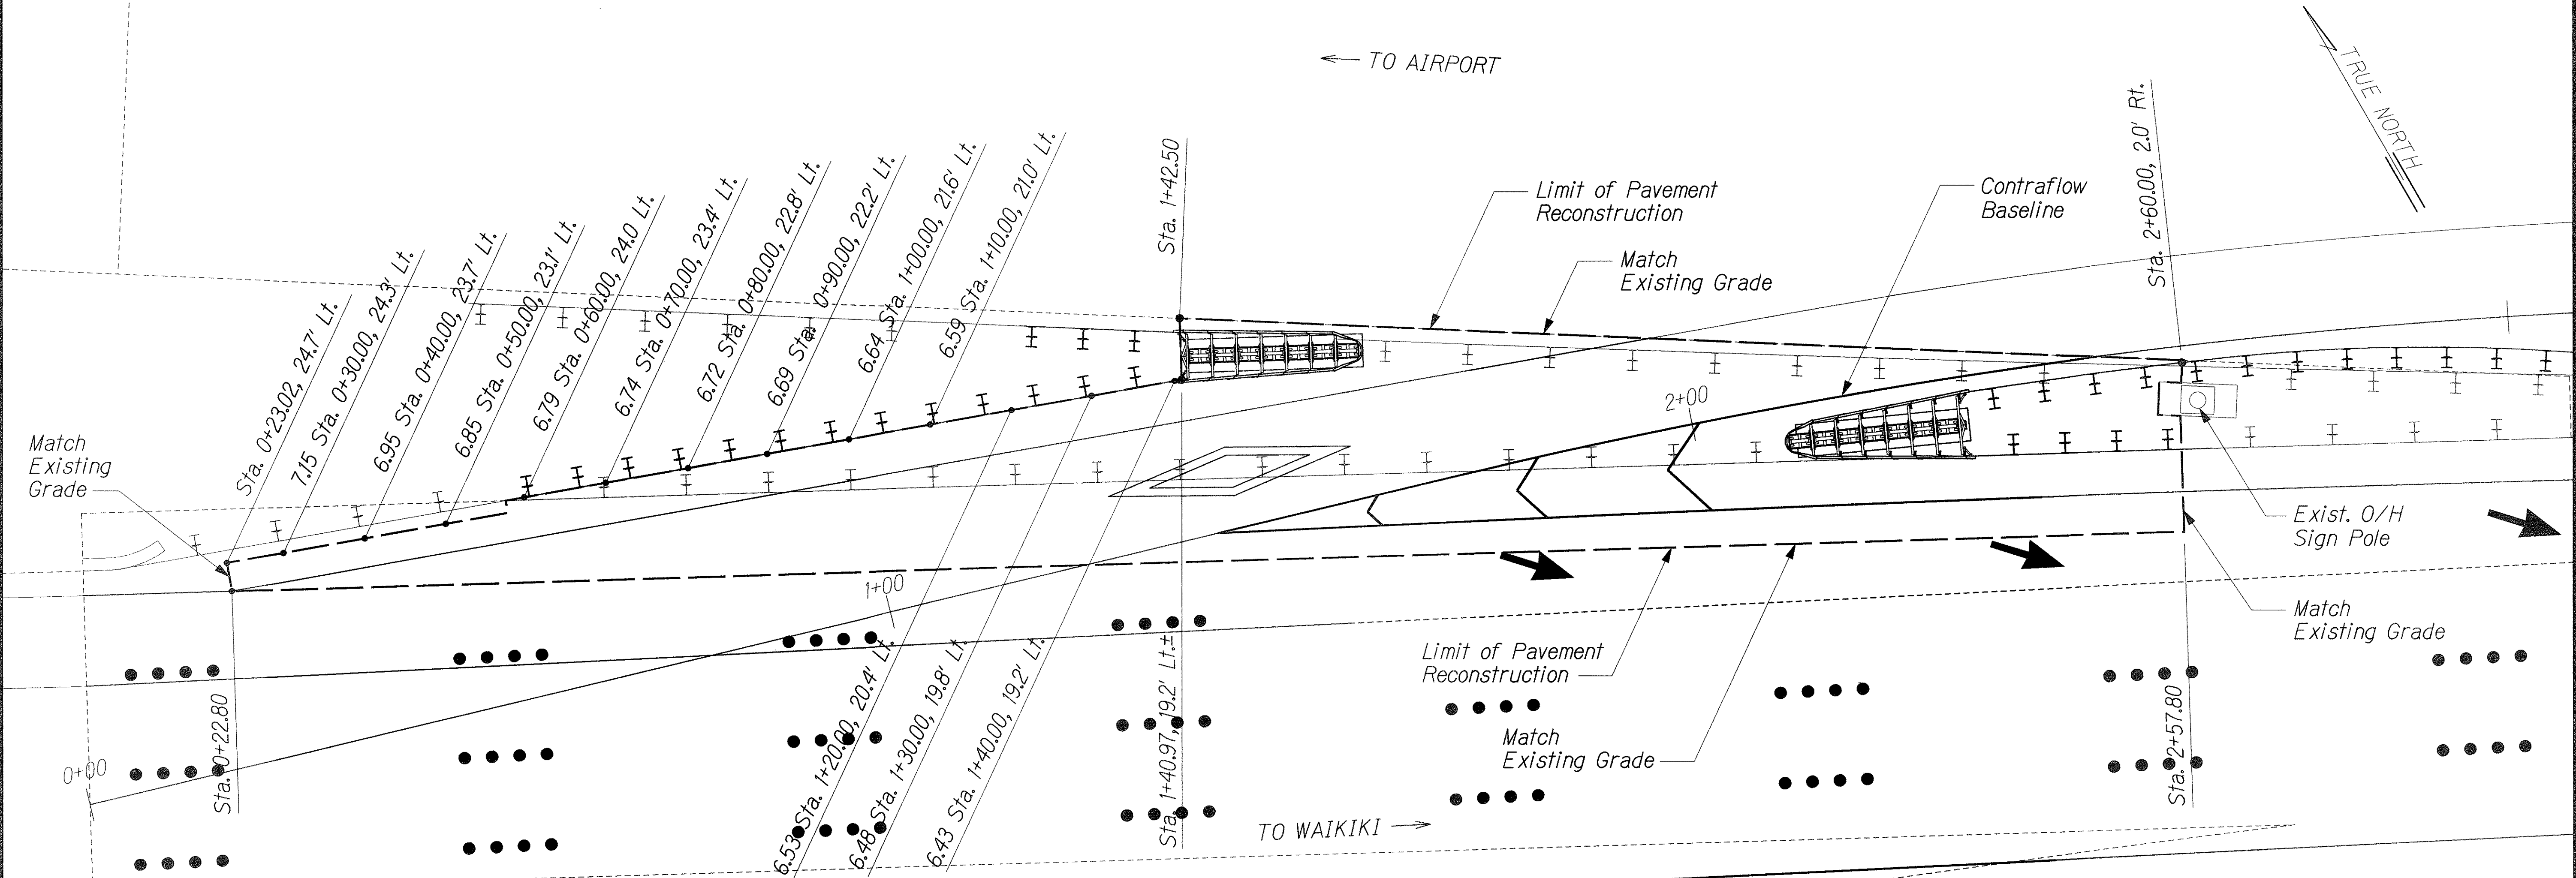


- NOTES:
- Contractor shall verify spot elevations prior to construction.
 - Elevations of attenuator concrete pads will be determined by the Contractor using control from elevations at limit of pavement reconstruction.

7/28/03	Revised spot elevations.
Date	Revision

ORIGINAL PLAN	SURVEY PLOTTED BY	DATE
NOTE BOOK	DESIGNED BY	
N=	QUANTITIES BY	
	CHECKED BY	

PLAN NIMITZ EB REVISIONS/ALIGN/SPOT-01.dgn

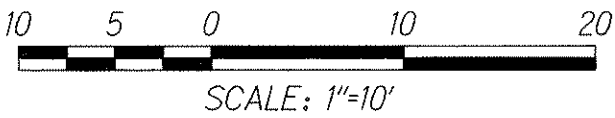

THIS WORK WAS PREPARED BY ME OR UNDER MY SUPERVISION.


STATE OF HAWAII
DEPARTMENT OF TRANSPORTATION
HIGHWAYS DIVISION

SPOT ELEVATION CROSSOVER - I

NIMITZ HIGHWAY IMPROVEMENTS
KEEHI INTERCHANGE TO PACIFIC STREET
PROJECT NO. 92A-01-03
Scale: 1"=10' Date: March 2, 2003

SHEET No. C6 OF 10 SHEETS

FED. ROAD DIST. NO.	STATE	PROJ. NO.	FISCAL YEAR	SHEET NO.	TOTAL SHEETS
HAWAII	HAW.	92A-01-03	2003	25	69

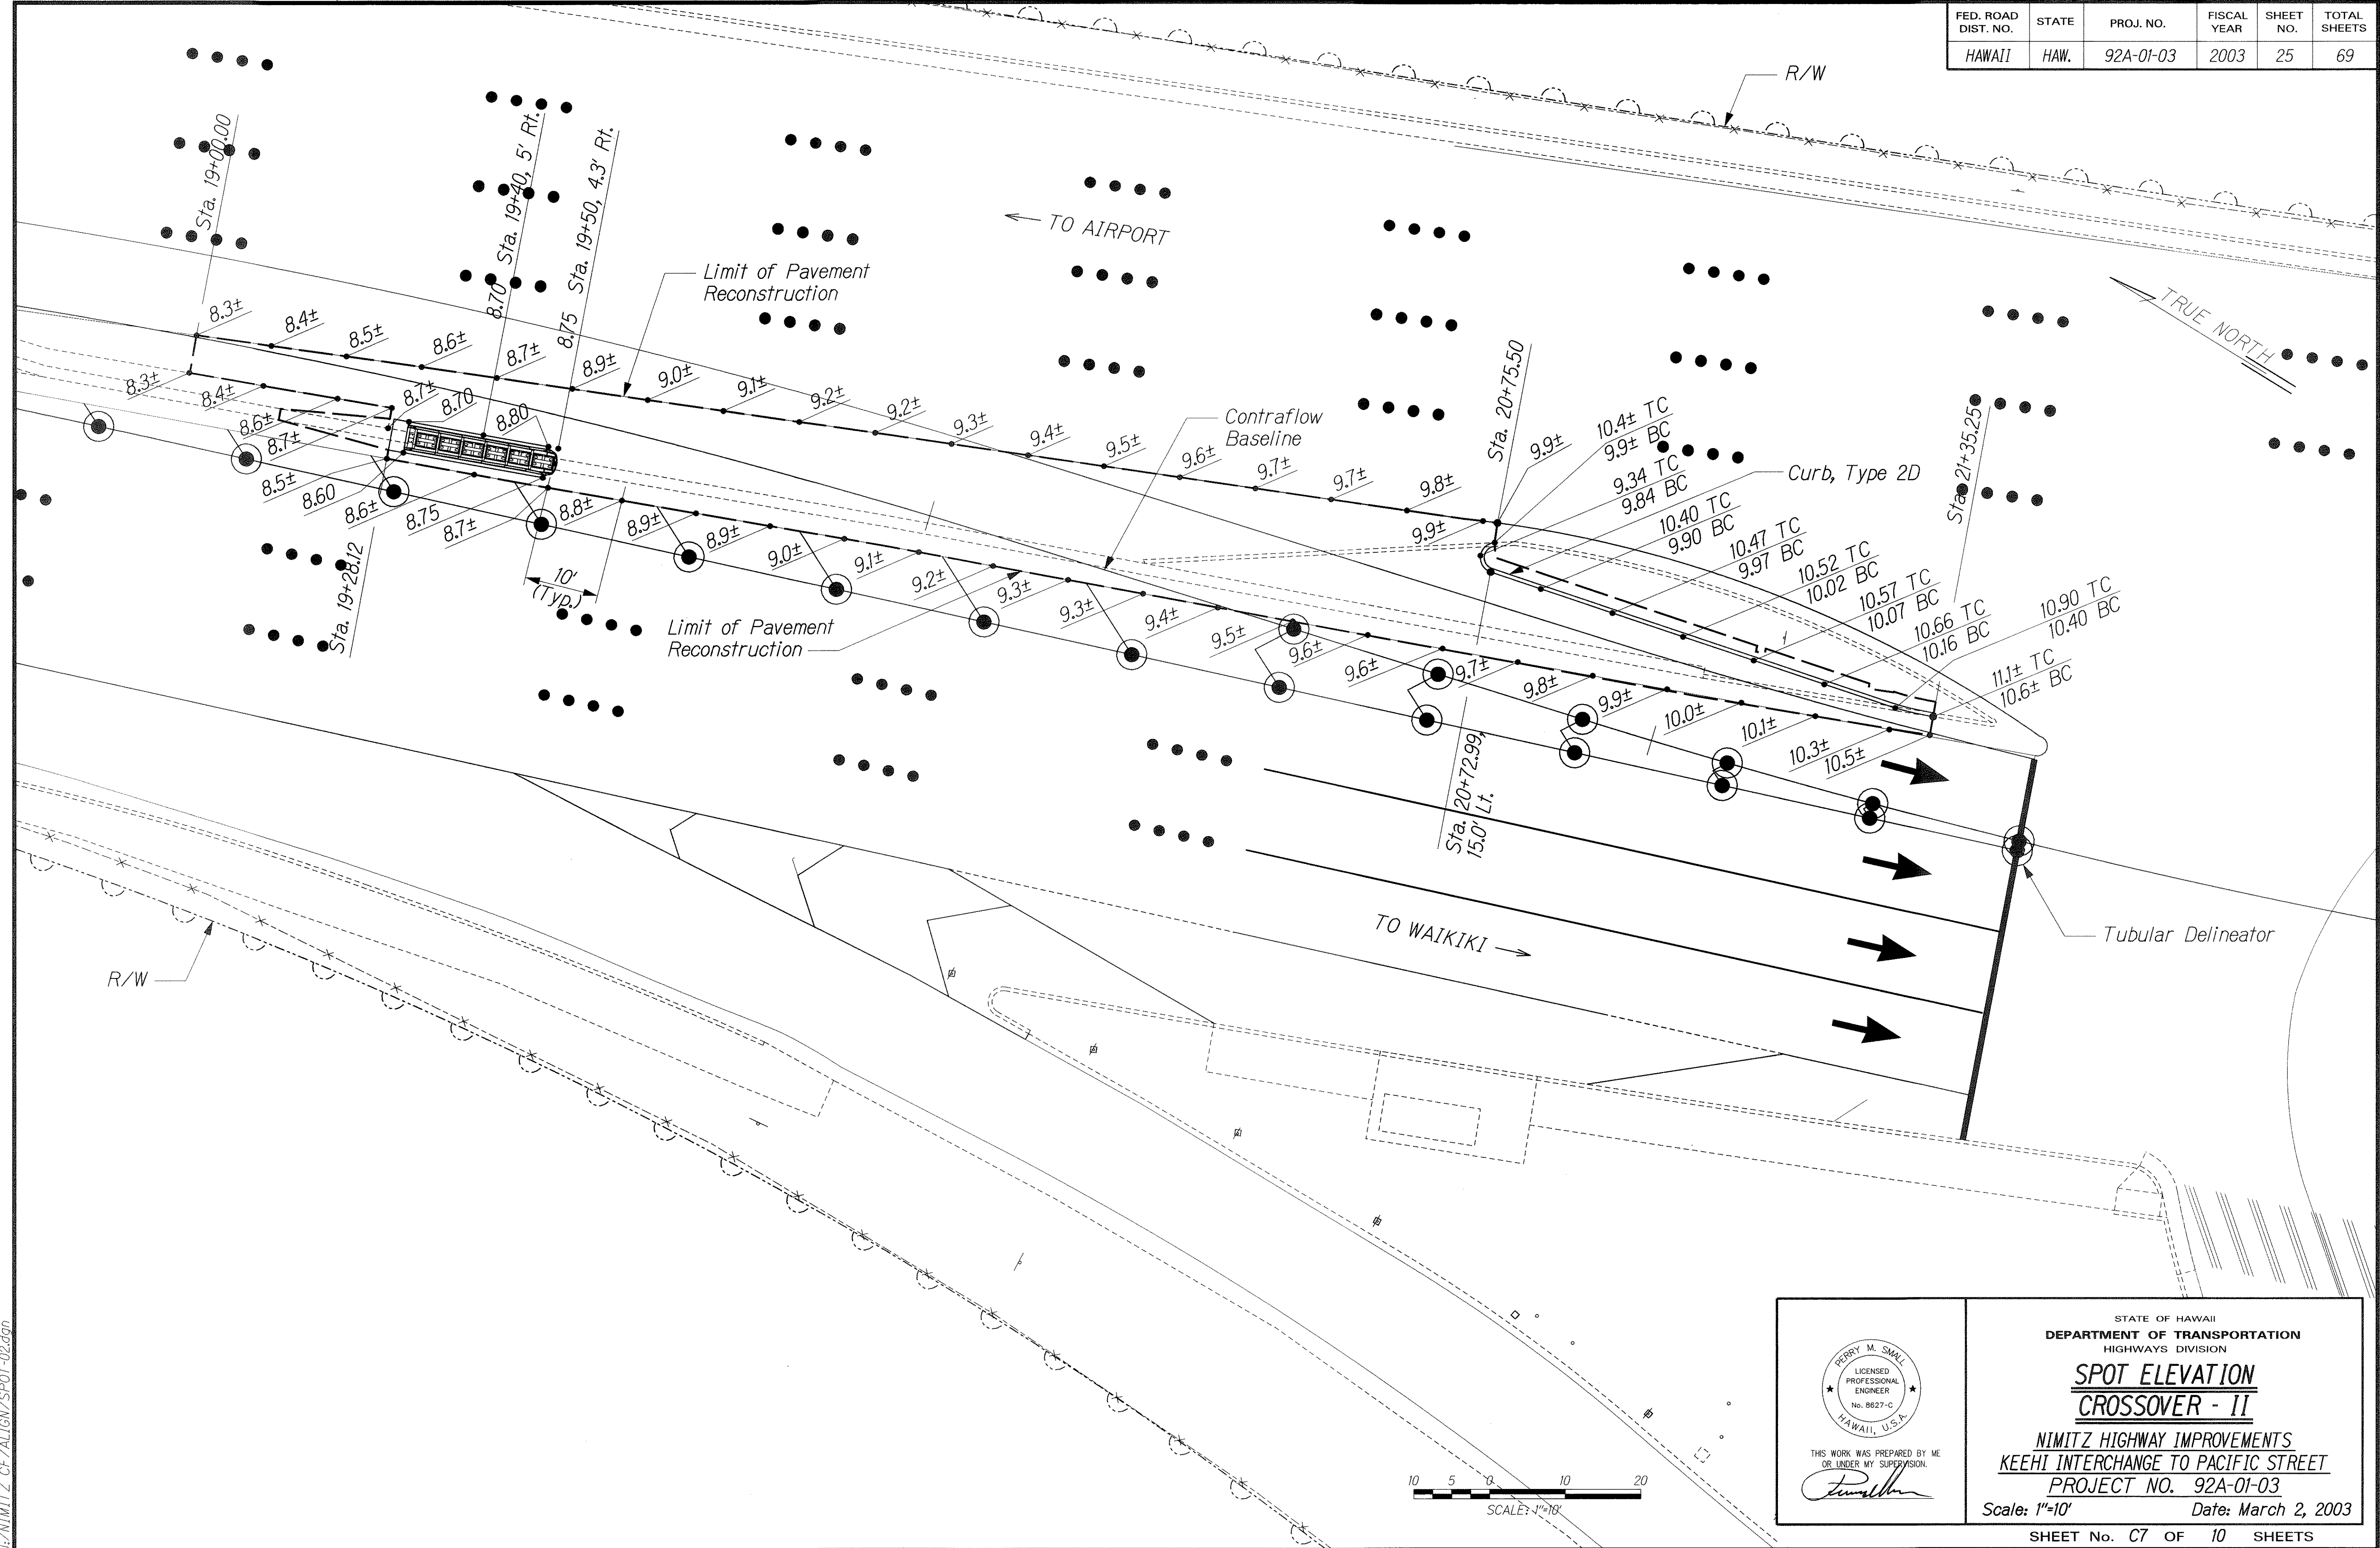

ORIGINAL PLAN	SURVEY PLOTTED BY	DATE
NOTE BOOK	DRAWN BY	
	DESIGNED BY	
	QUANTITIES BY	
	CHECKED BY	

U:\NIMITZ CF\ALIGN\SPOT-02.dgn

THIS WORK WAS PREPARED BY ME
OR UNDER MY SUPERVISION.


 
Perry M. Small

STATE OF HAWAII
DEPARTMENT OF TRANSPORTATION
HIGHWAYS DIVISION

**SPOT ELEVATION
CROSSOVER - II**


NIMITZ HIGHWAY IMPROVEMENTS
KEEHI INTERCHANGE TO PACIFIC STREET
PROJECT NO. 92A-01-03
Scale: 1"=10' Date: March 2, 2003

SHEET No. C7 OF 10 SHEETS

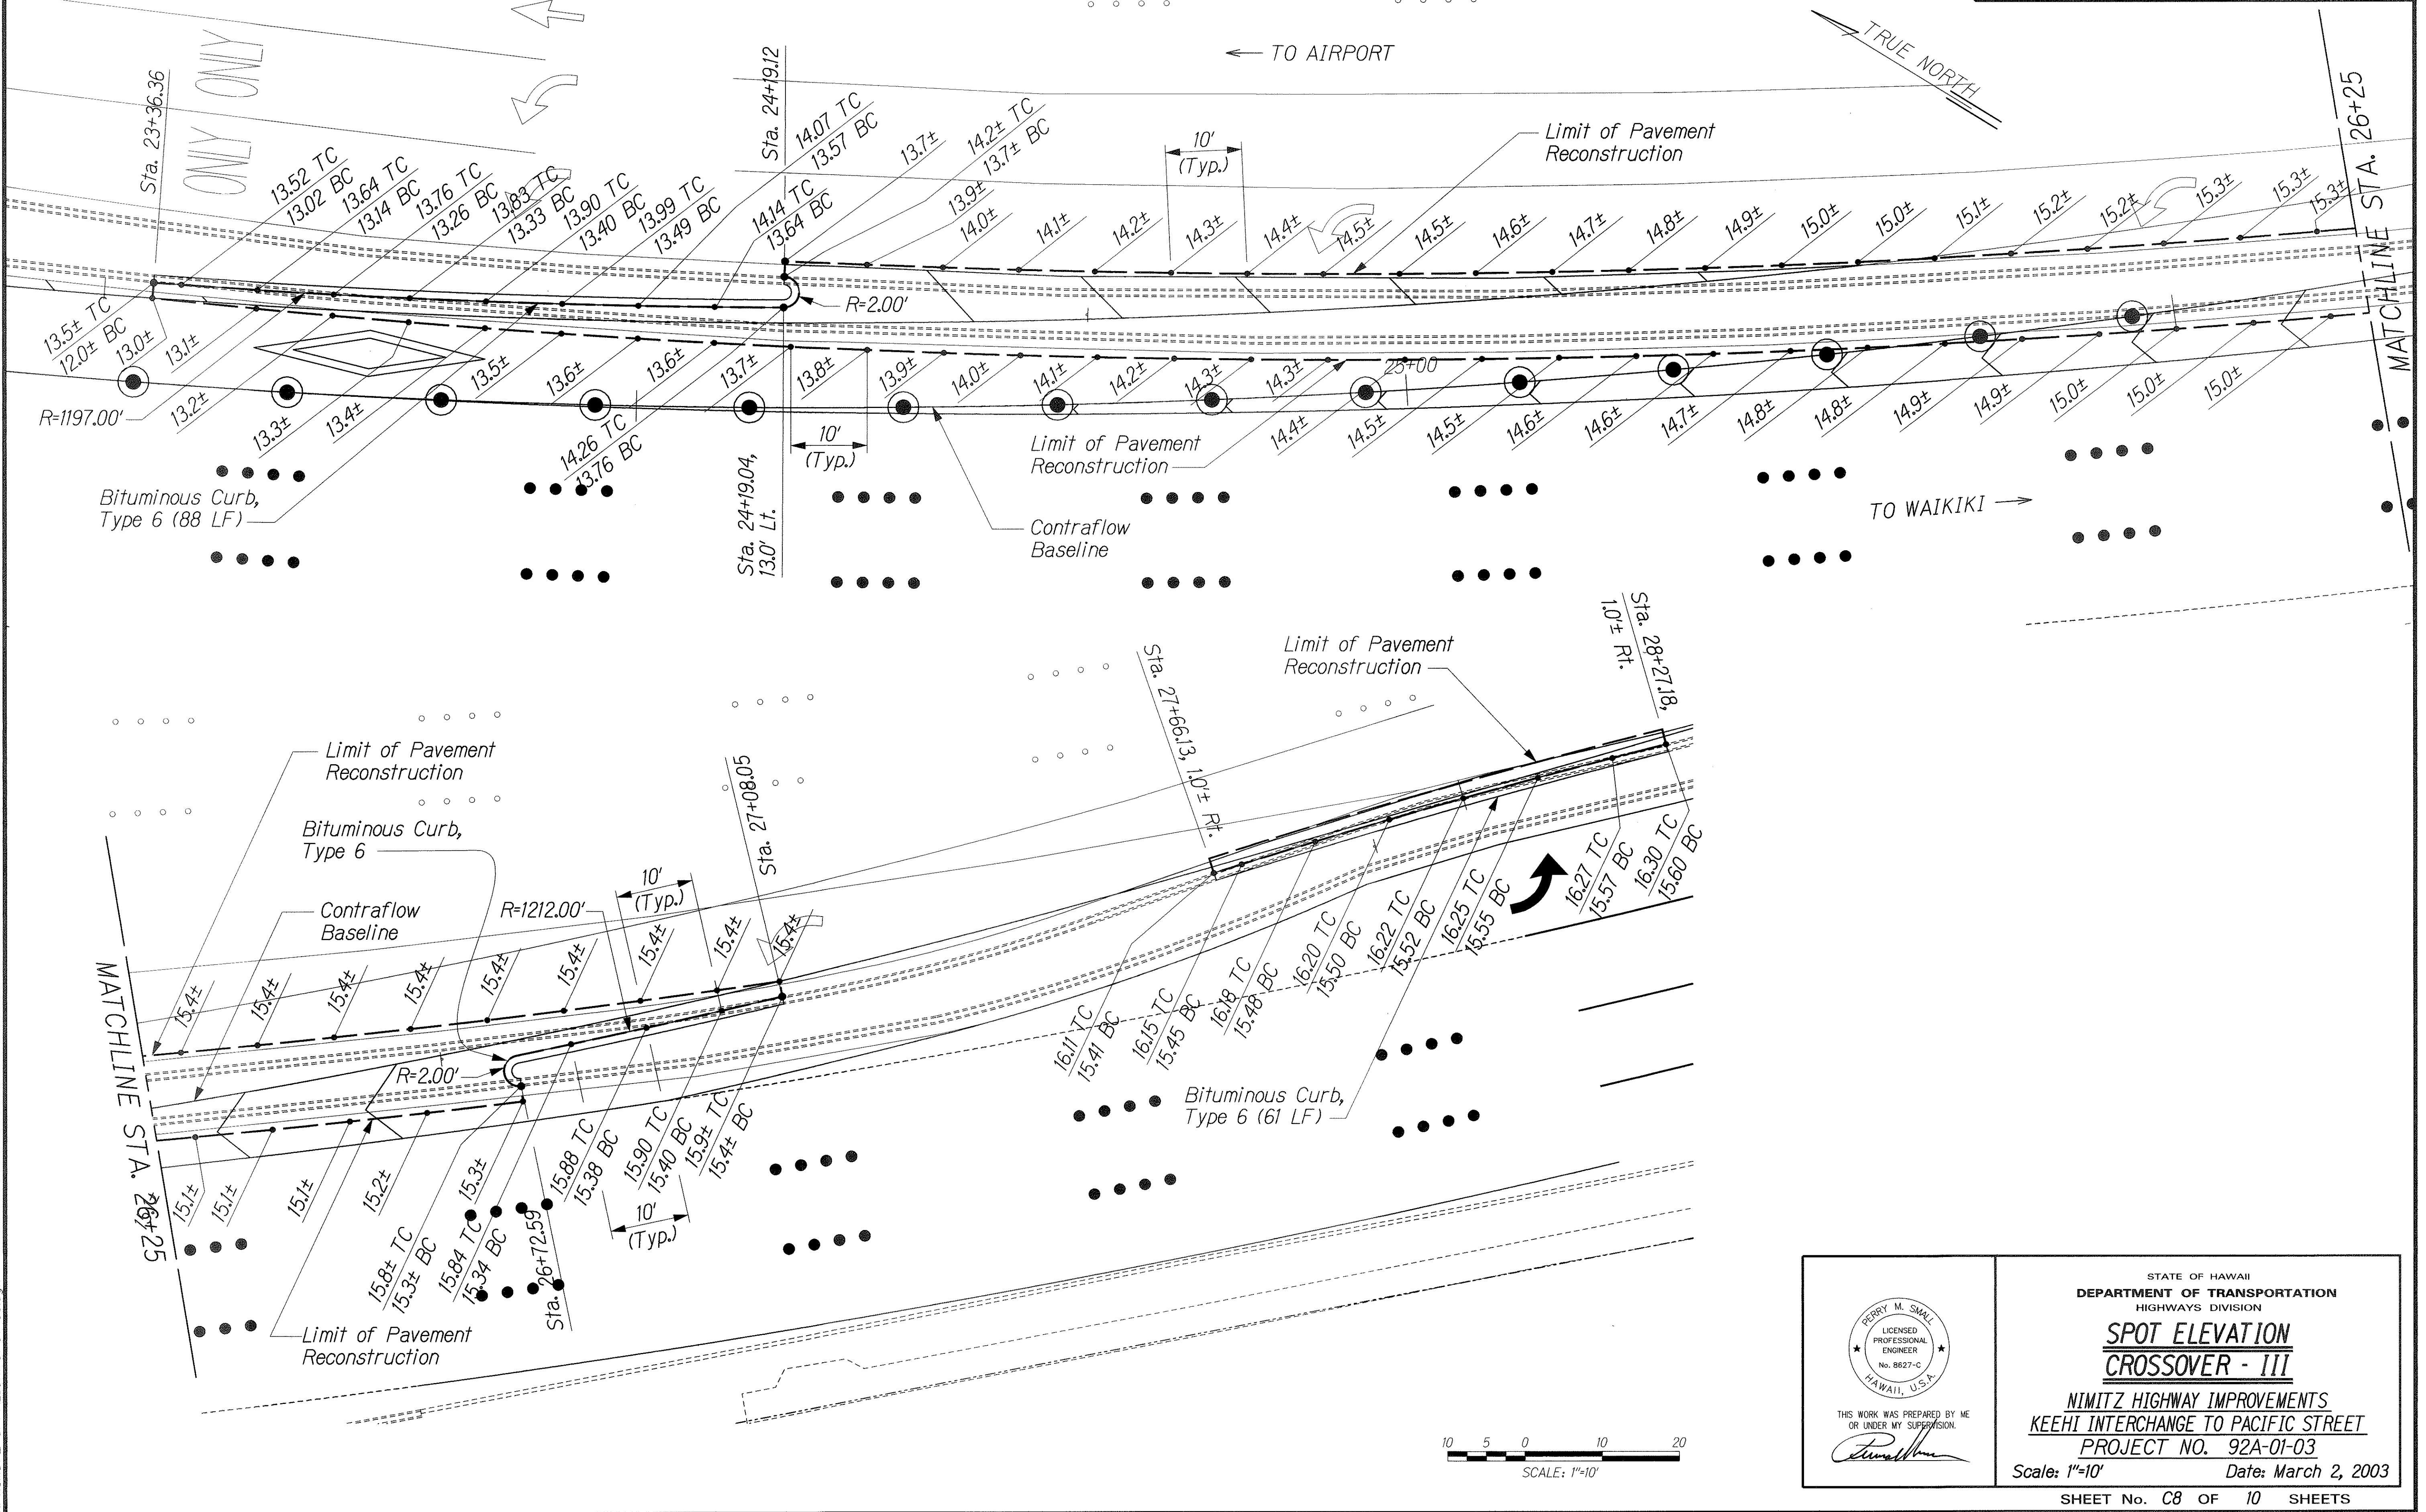


ORIGINAL PLAN	SURVEY PLOTTED BY _____	DATE _____
	DRAWN BY _____	_____
	TRACED BY _____	_____
NOTE BOOK	DESIGNED BY _____	_____
	QUANTITIES BY _____	_____
N _o _____	CHECKED BY _____	_____

J:\NIMITZ CF\ALIGN\SPOT-03.dgn

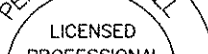
 THIS WORK WAS PREPARED BY ME OR UNDER MY SUPERVISION. 	STATE OF HAWAII DEPARTMENT OF TRANSPORTATION HIGHWAYS DIVISION <u>SPOT ELEVATION</u> <u>CROSSOVER - III</u> <u>NIMITZ HIGHWAY IMPROVEMENTS</u> <u>KEEHI INTERCHANGE TO PACIFIC STREET</u> <u>PROJECT NO. 92A-01-03</u> Scale: 1"=10' Date: March 2, 2003
	SHEET No. C8 OF 10 SHEETS

FED. ROAD DIST. NO.	STATE	PROJ. NO.	FISCAL YEAR	SHEET NO.	TOTAL SHEETS
HAWAII	HAW.	92A-01-03	2003	27	70

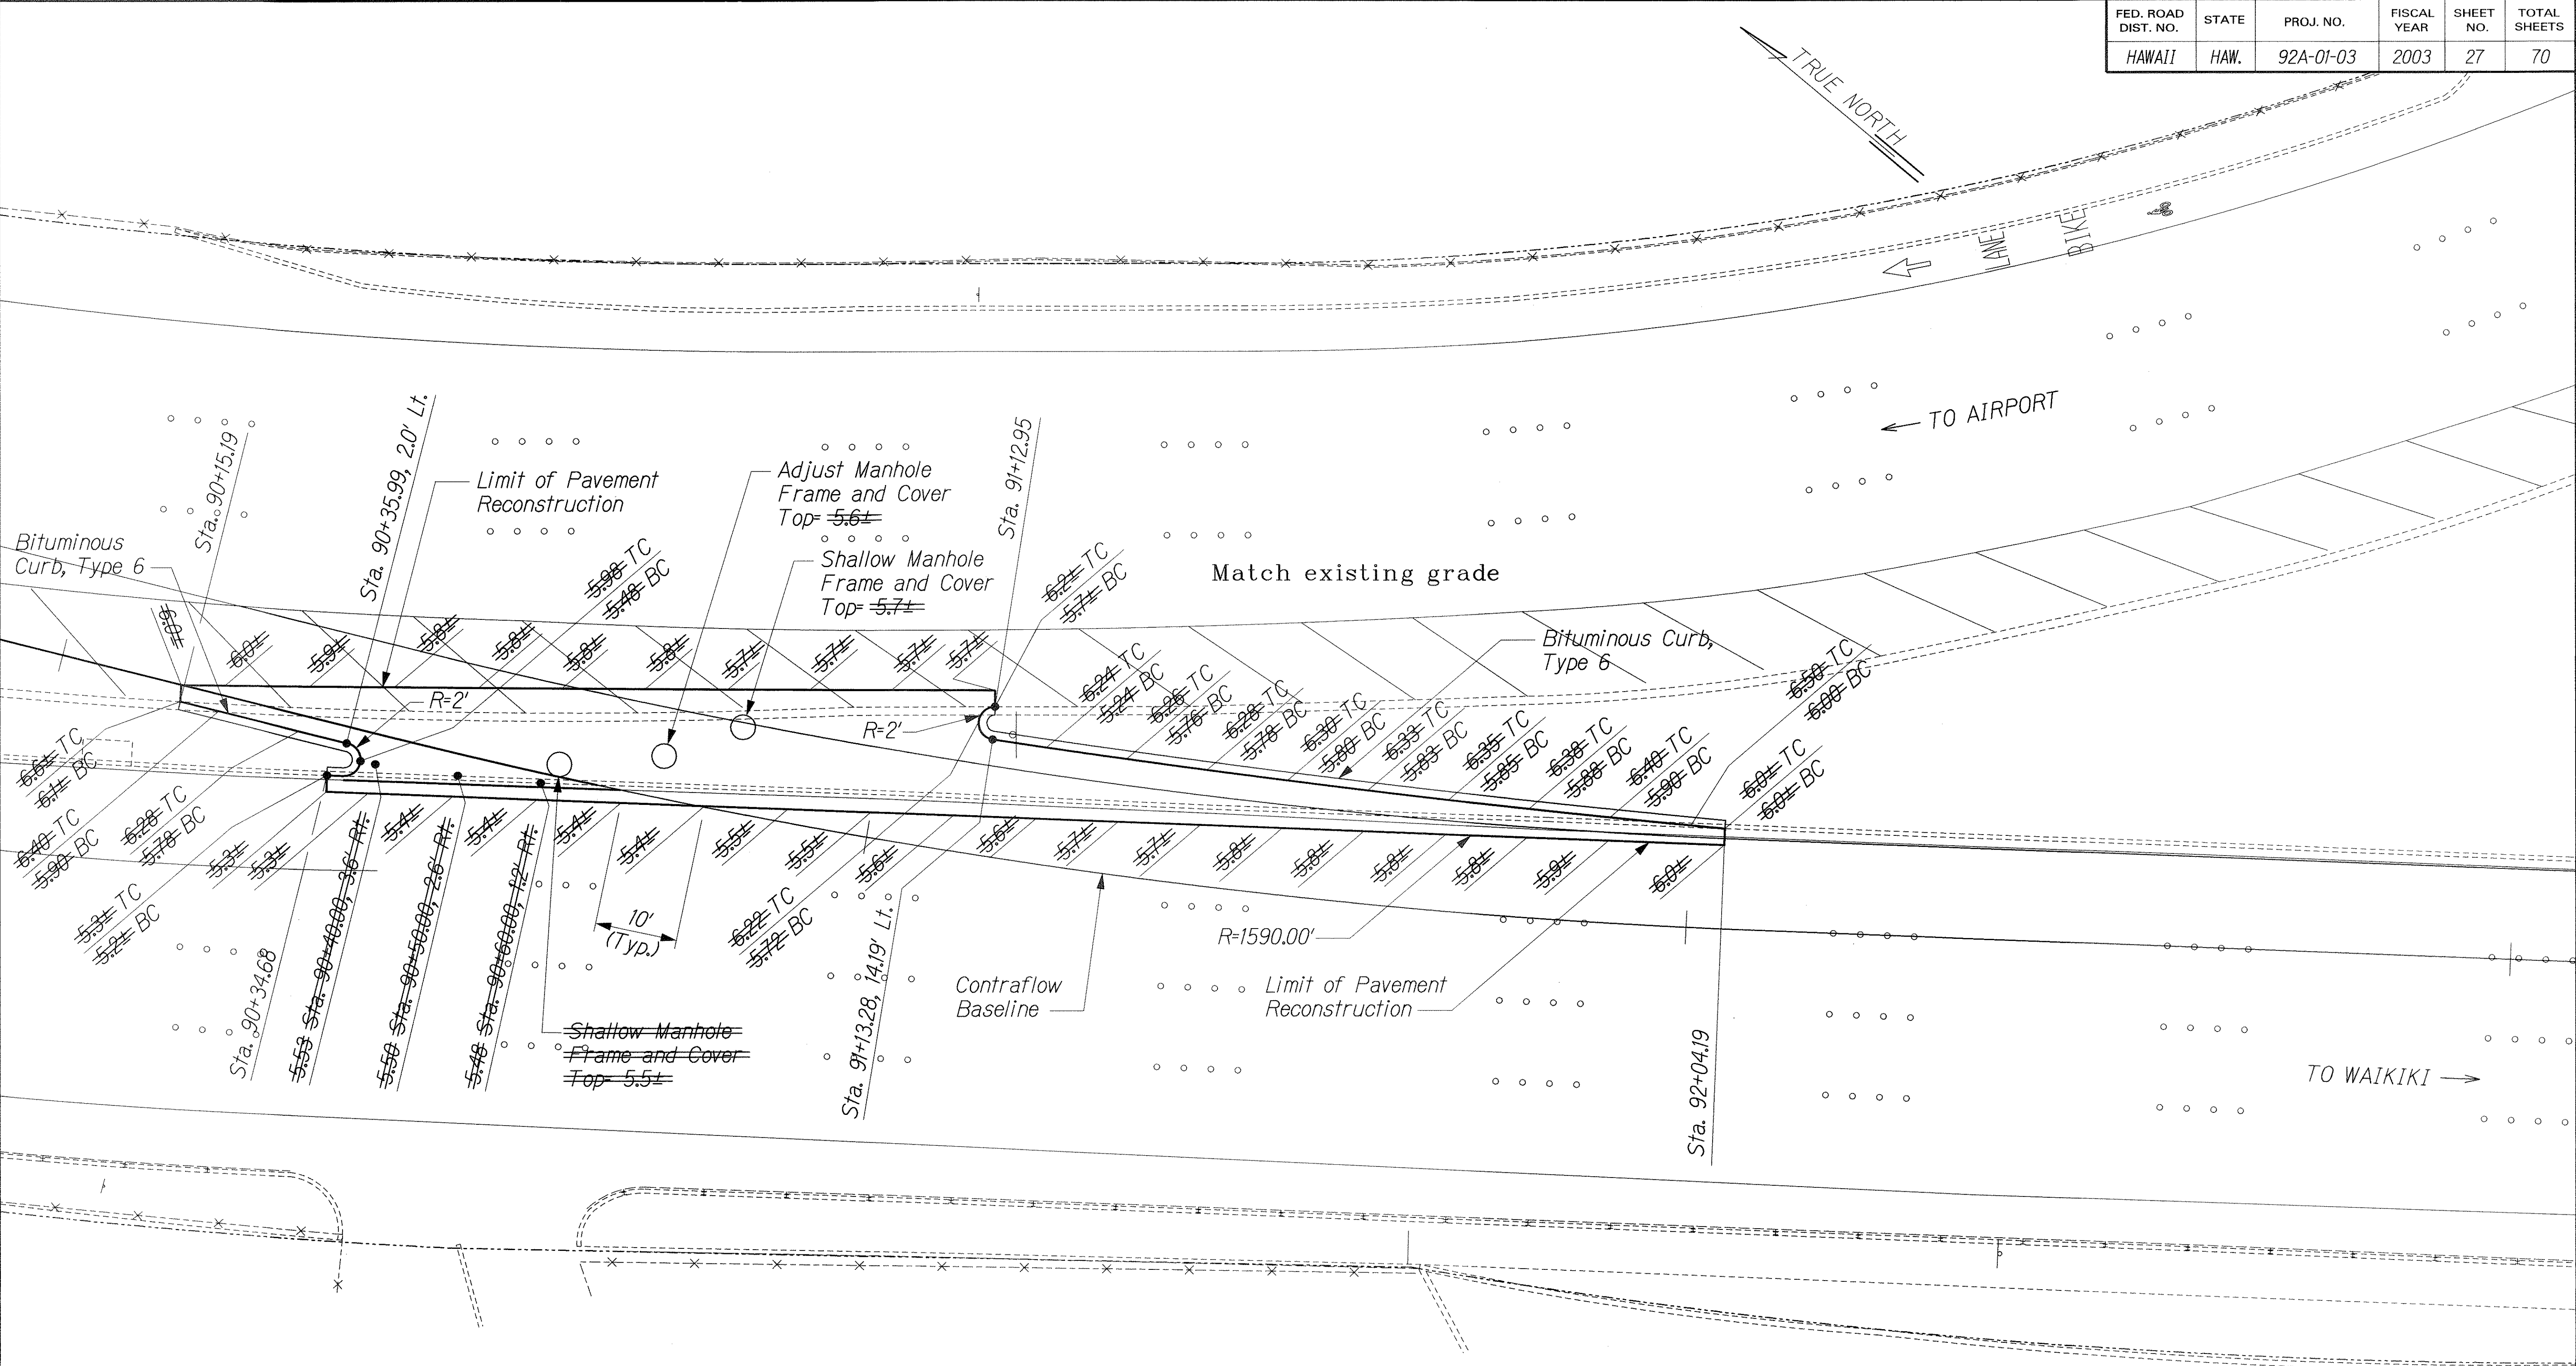

ORIGINAL PLAN	DATE
NOTED BY	
DESIGNED BY	
CHECKED BY	

LEGEND FOR AS-BUILT POSTINGS	
	Squiggly line for as-built deletion
	Double line for as-built deletion
Roadway	Text for as-built posting

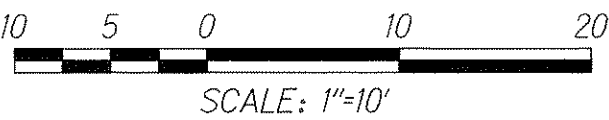

THIS WORK WAS PREPARED BY ME OR UNDER MY SUPERVISION.

STATE OF HAWAII
DEPARTMENT OF TRANSPORTATION
HIGHWAYS DIVISION

SPOT ELEVATION CROSSOVER - IV

NIMITZ HIGHWAY IMPROVEMENTS
KEEHI INTERCHANGE TO PACIFIC STREET
PROJECT NO. 92A-01-03
Scale: 1"=10' Date: March 2, 2003

SHEET No. C9 OF 10 SHEETS