


| FED. ROAD DIST. NO. | STATE | PROJ. NO.    | FISCAL YEAR | SHEET NO. | TOTAL SHEETS |
|---------------------|-------|--------------|-------------|-----------|--------------|
| HAWAII              | HAW.  | NH-092-1(27) | 2009        | 20        | 302          |

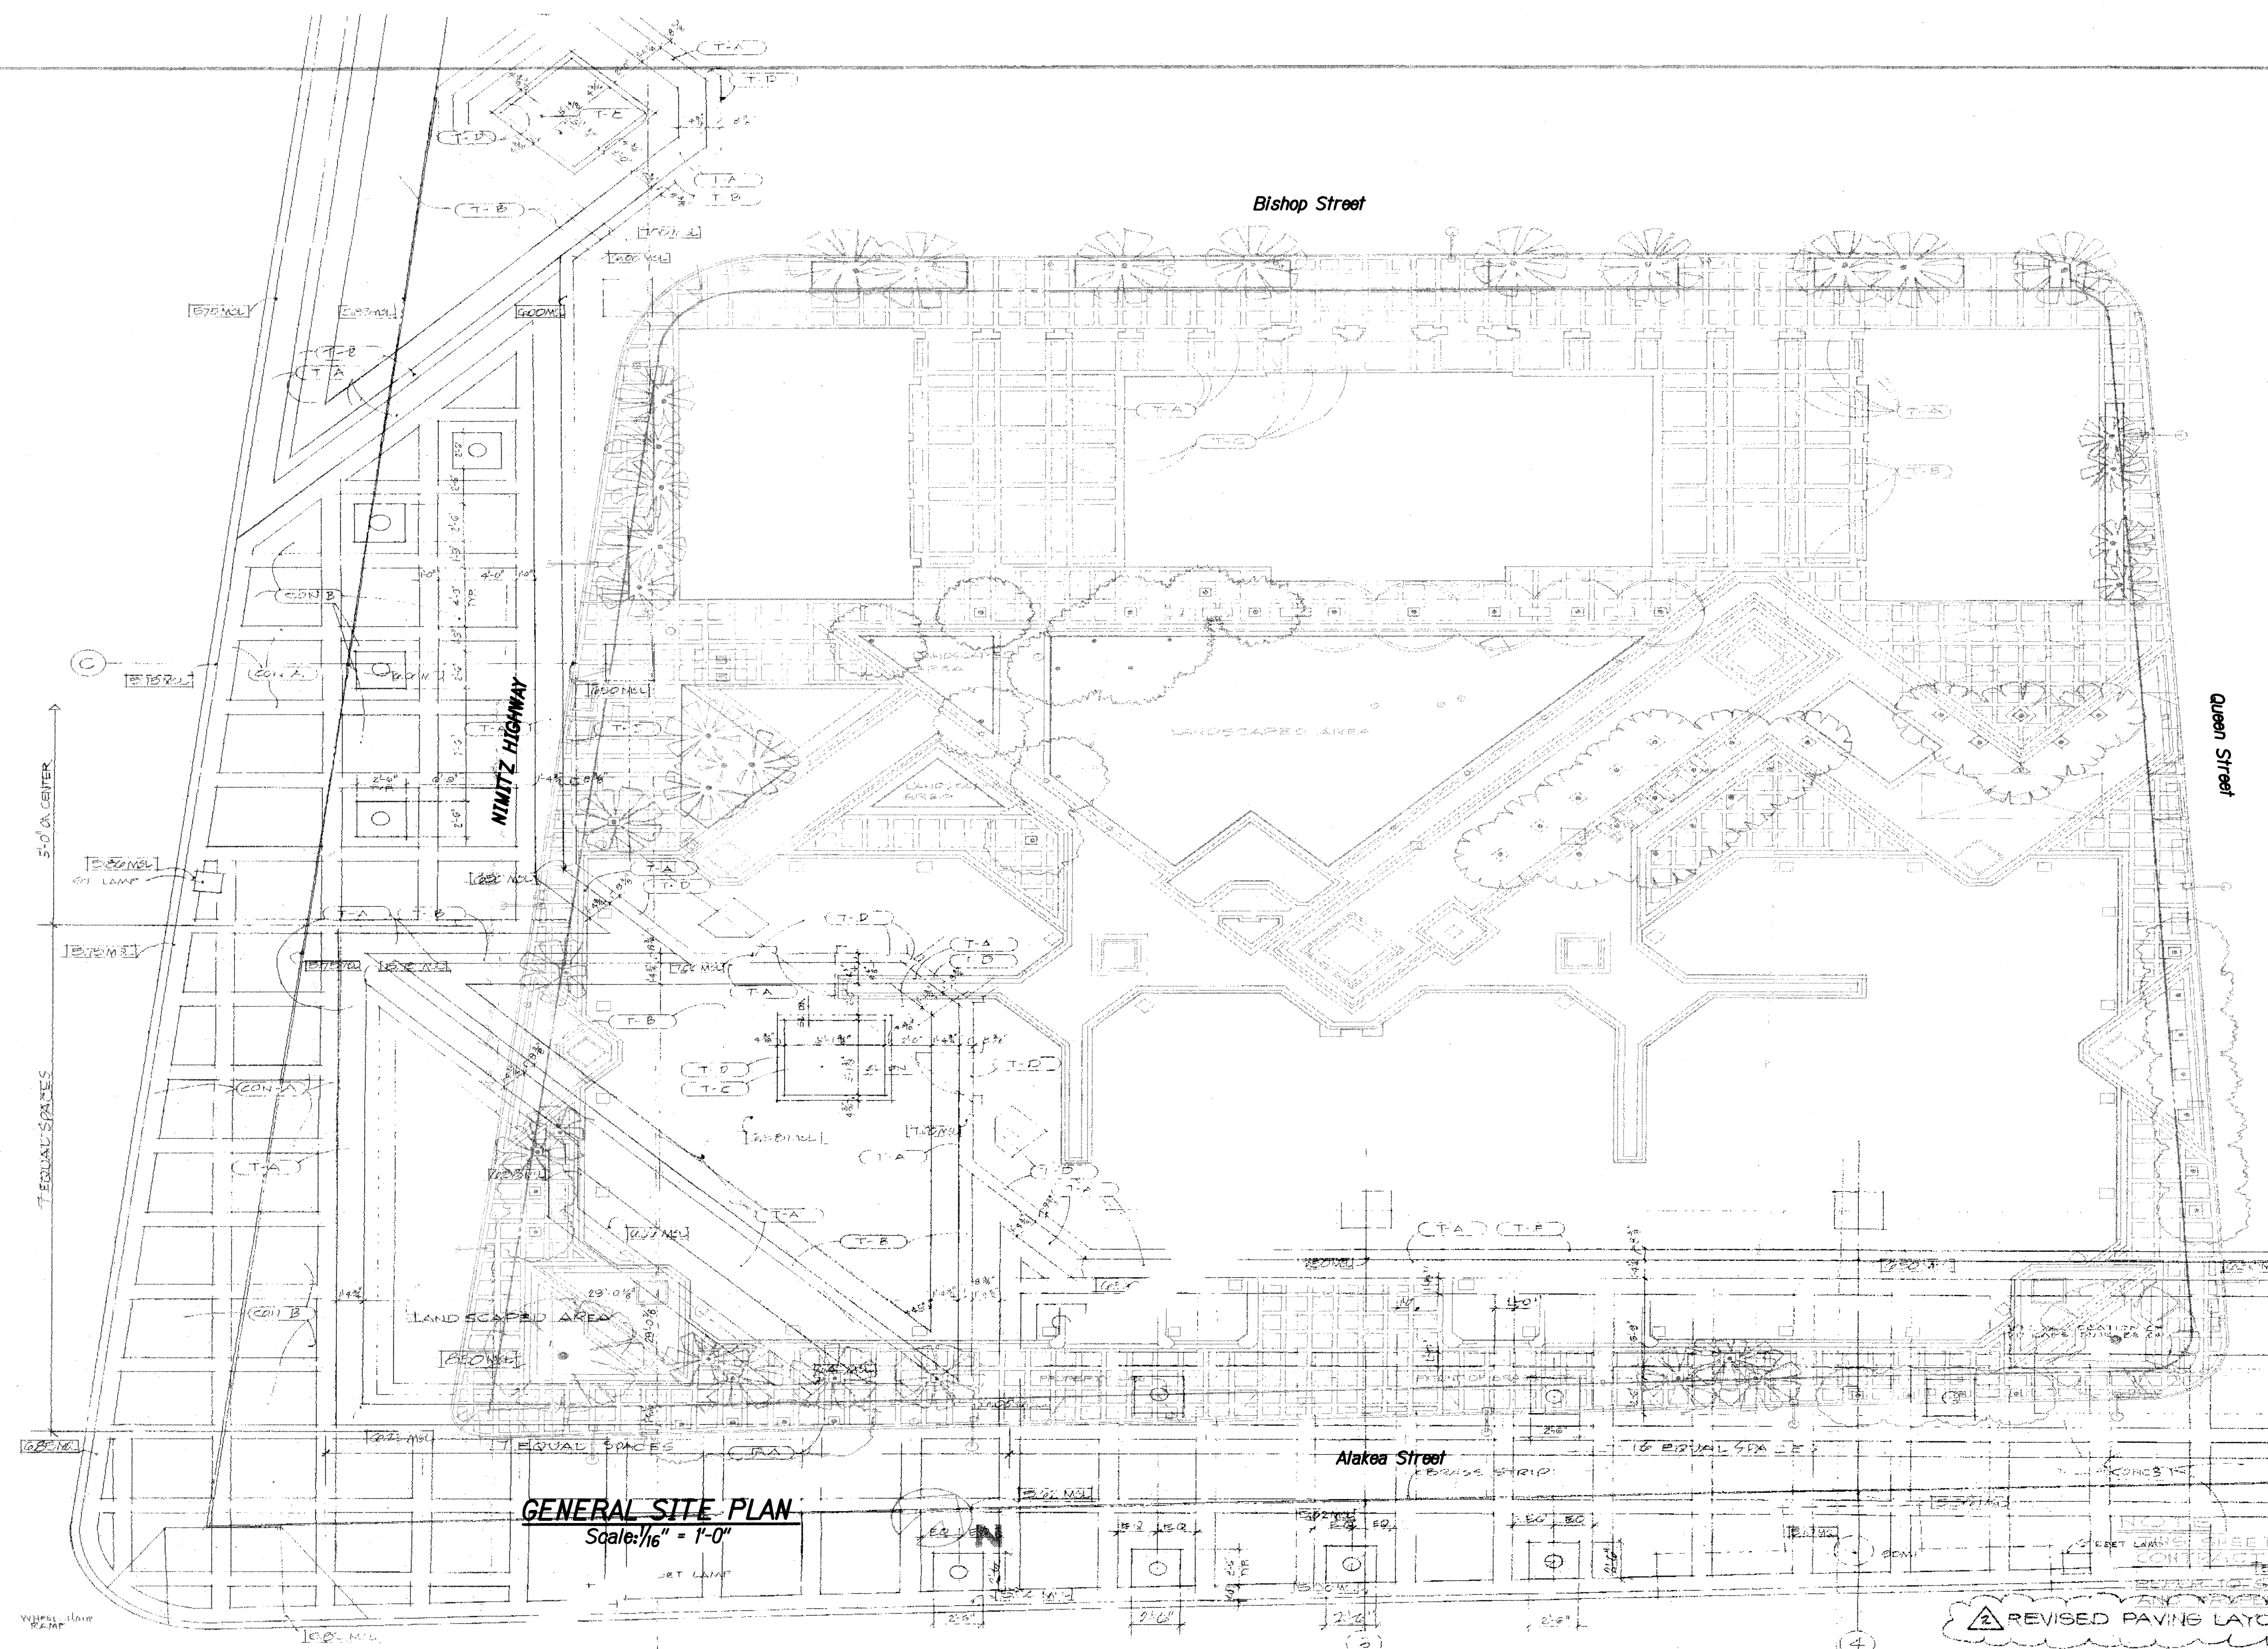

NOTE: ALL DIMENSIONS TO BE VERIFIED ON JOB SITE WITH APPROVAL BY ARCHITECT

ALL INFORMATION OUTSIDE PROPERTY LINE IS NOT TO BE USED FOR ANY OTHER PURPOSES. SEE SHEET 20-301A FOR LANDSCAPE PLAN.

DAY CUTS AS DIRECTED BY ATILE COLORS

(T-2) BLACK - UPTS - 8  
(T-3) YELLOW - UPTS - 3  
(T-6) BLACK - UPTS - 7  
(T-7) PERSIMMONS  
CONCRETE COLORS

(CON A) SPECIAL MIX CONCRETE NON-SAND BLASTED  
(CON B) SPECIAL MIX CONCRETE SAND BLASTED

ARCHITECTS  
**HAWAII LTD.**  
Francis S. Haines AIA  
Paul D. Jones AIA  
Joseph Farrell AIA  
Fred R. White AIA  
Stanley S. Ginn AIA  
Alex Weinstein AIA  
David A. Miller AIA  
Architecture  
Planning  
Interior Design  
Graphic Design  
Offices:  
Honolulu, Oahu, Hawaii  
Waikuku, Maui, Hawaii

**735**  
BISHOP STREET  
DEVELOPMENT  
FOR GROSVENOR CENTER  
GROSVENOR CENTER  
DEVELOPMENT  
SCALE 1/16" = 1'-0"

| Revision | Date             | By | Check |
|----------|------------------|----|-------|
| 1        | OCTOBER 24, 1978 |    |       |
| 2        | MARCH 29, 1979   |    |       |
| 3        | SEPT. 1, 1979    |    |       |
| 4        | SEPT. 9, 1979    |    |       |

Designed by J.P./L.  
Drawn by J.P./L.  
Project No. 20-301  
Date: SEPT. 2, 1979  
Sheet No. 20-301


| ORIGINAL PLAN     | DATE |
|-------------------|------|
| SURVEY PLOTTED BY |      |
| DRAWN BY          |      |
| DESIGNED BY       |      |
| QUANTITIES BY     |      |
| CHECKED BY        |      |

FOR INFORMATION ONLY

NOT TO SCALE  
Grosvenor Center Sidewalk

STATE OF HAWAII  
DEPARTMENT OF TRANSPORTATION  
HIGHWAYS DIVISION  
**CONCRETE SIDEWALK PLANS**  
**NIMITZ HIGHWAY AND  
ALA MOANA BOULEVARD RESURFACING  
AND HIGHWAY LIGHTING REPLACEMENT  
Fort Street to Kalakaua Avenue  
Federal Aid Project No. NH-092-1(27)**  
Not to Scale Date: January 2009  
SHEET No. 1 OF 2 SHEETS

| FED. ROAD DIST. NO. | STATE | PROJ. NO.    | FISCAL YEAR | SHEET NO. | TOTAL SHEETS |
|---------------------|-------|--------------|-------------|-----------|--------------|
| HAWAII              | HAW.  | NH-092-1(27) | 2009        | 21        | 302          |

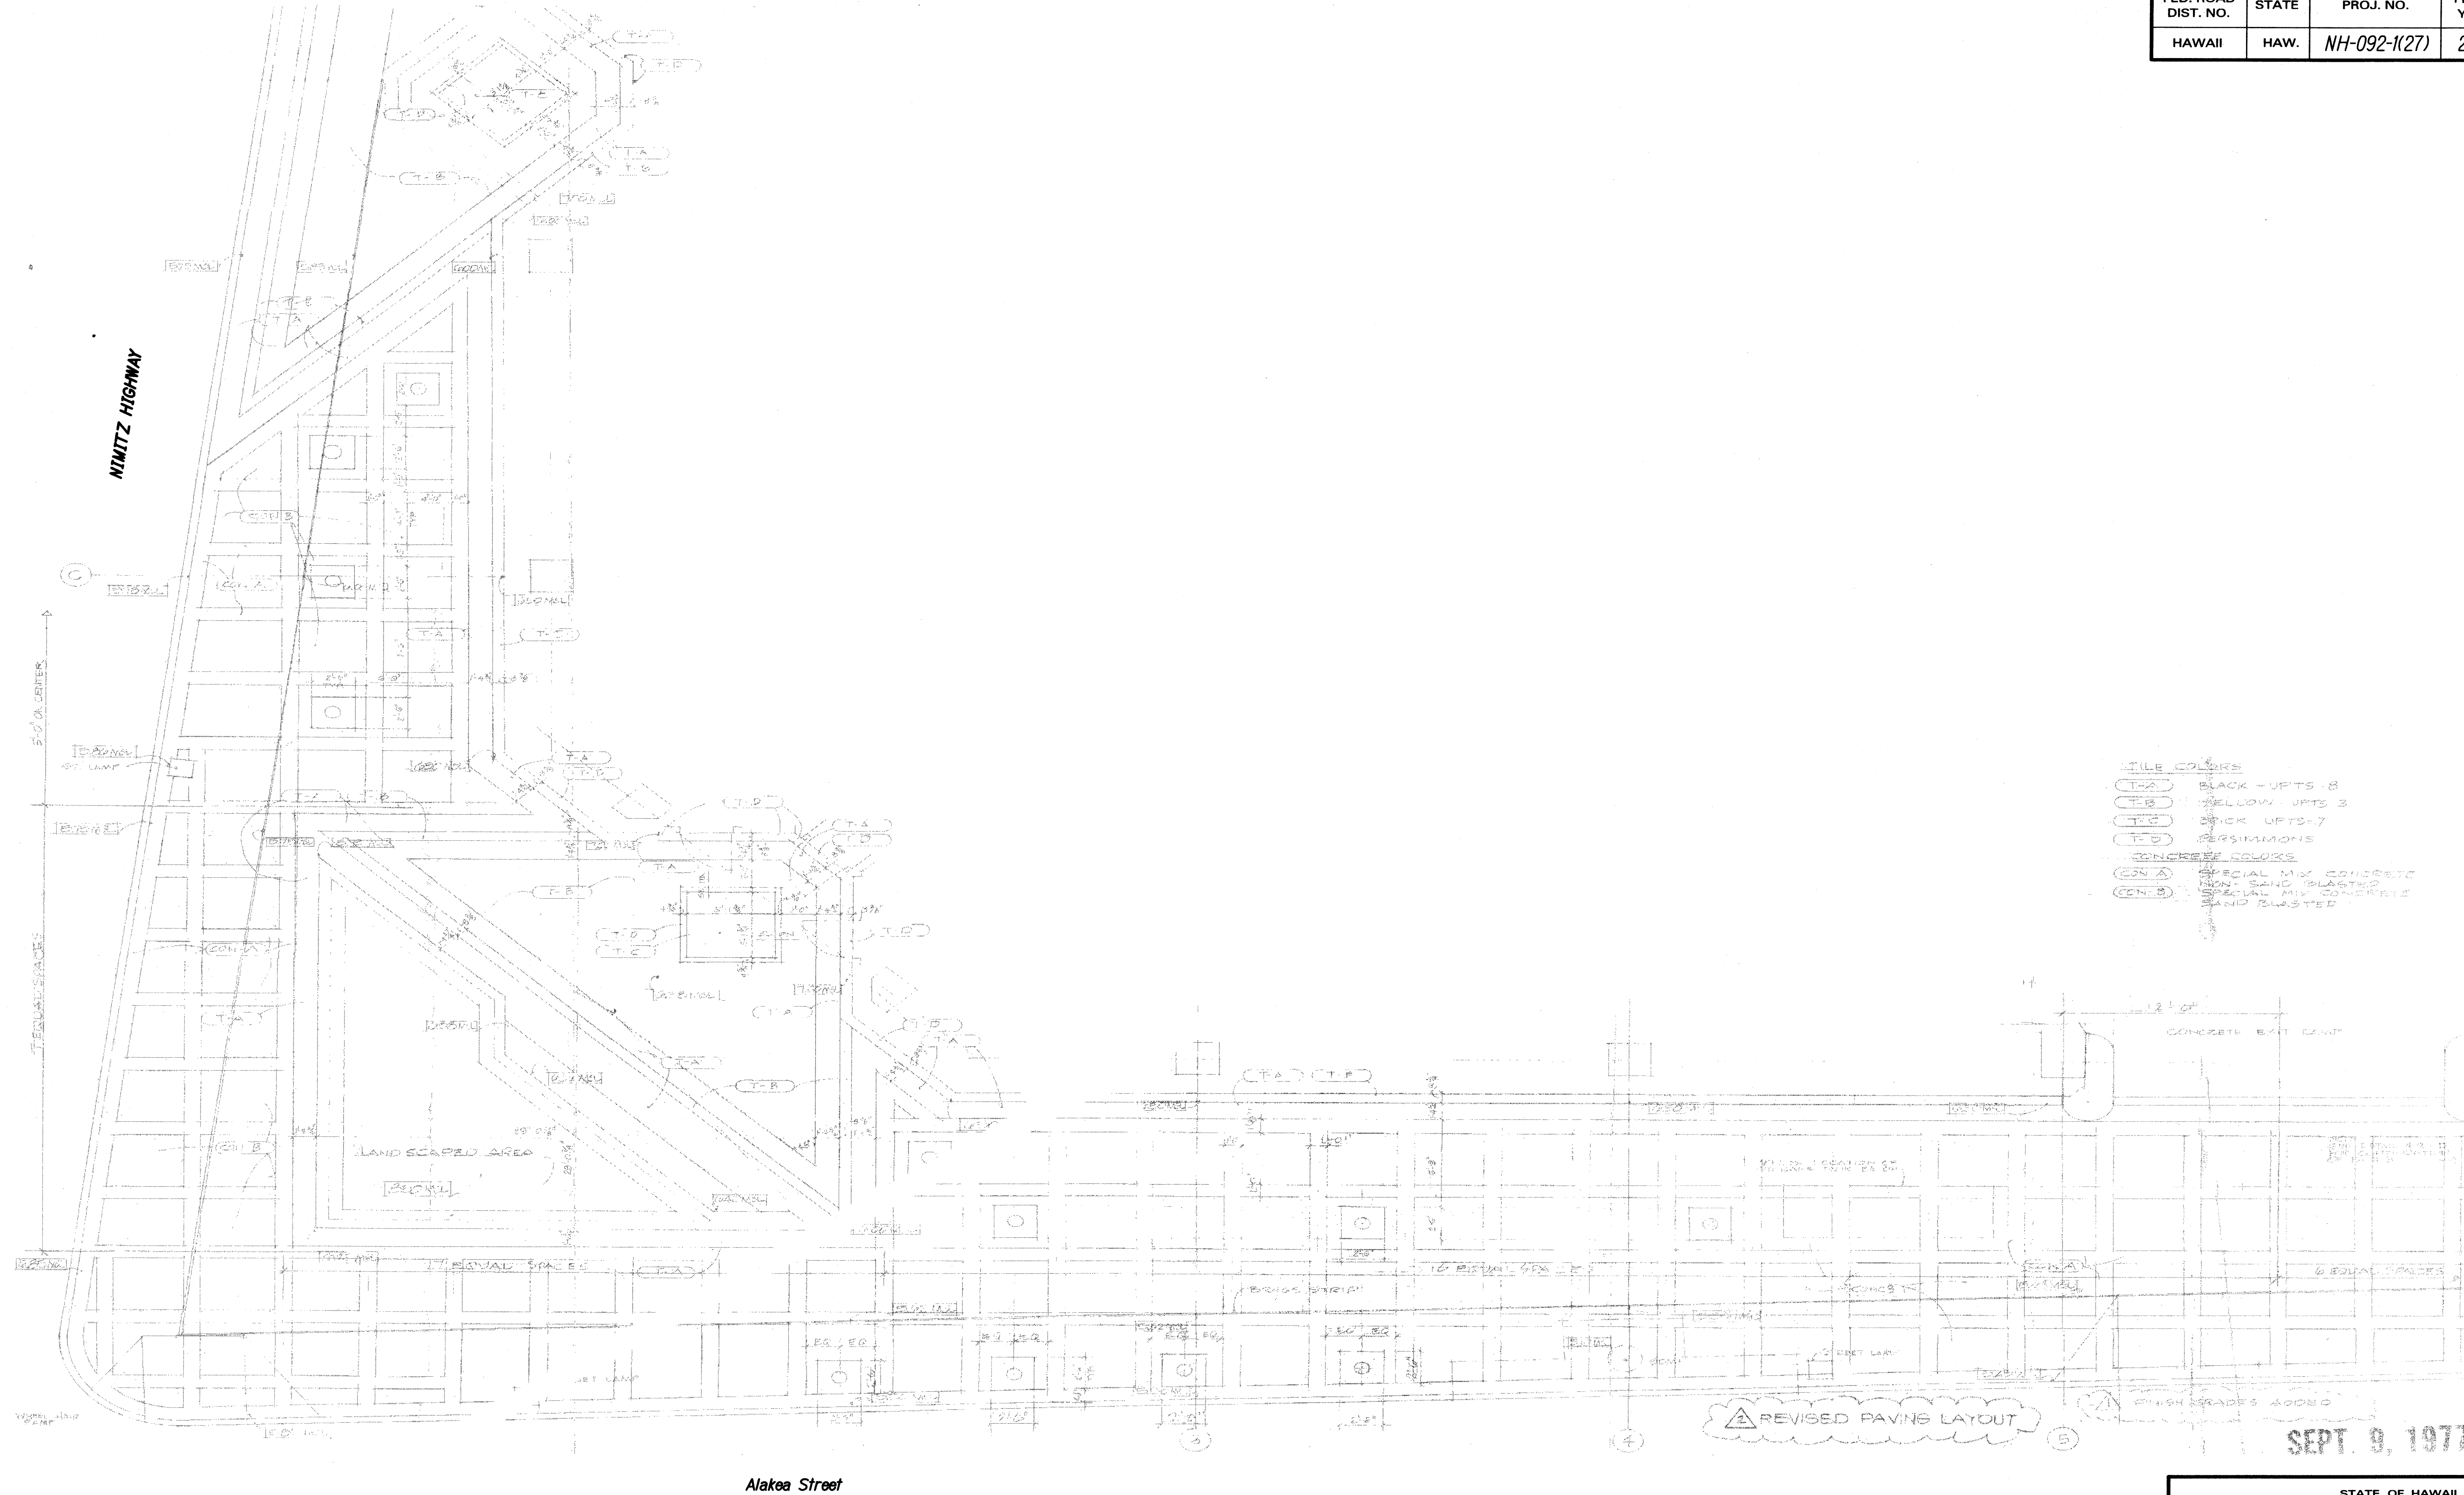

- TILE COLORS**
- CTA BLACK - UPTS. 1-8
  - CTB YELLOW - UPTS. 3
  - CTC BLACK - UPTS. 7
  - CTD PERIMETER
- CONCRETE COLORS**
- CEN A SPECIAL MIX CONCRETE
  - CEN B SPECIAL MIX CONCRETE
  - CEN C SAND BLASTER

735

DAVID L. SMITH  
ENGINEER  
STATE OF HAWAII  
LICENSE NO. 10000  
EXPIRATION DATE 12/31/2010

|               |                   |      |
|---------------|-------------------|------|
| ORIGINAL PLAN | SURVEY PLOTTED BY | DATE |
| NOTE BOOK     | DESIGNED BY       |      |
| 000           | QUANTITIES BY     |      |
| NH-092-36.dgn | CHECKED BY        |      |

**FOR INFORMATION ONLY**

**NOT TO SCALE**

*Grosvenor Center Sidewalk*

STATE OF HAWAII  
DEPARTMENT OF TRANSPORTATION  
HIGHWAYS DIVISION

**CONCRETE SIDEWALK PLANS**

**NIMITZ HIGHWAY AND  
ALA MOANA BOULEVARD RESURFACING  
AND HIGHWAY LIGHTING REPLACEMENT**

**Fort Street to Kalakaua Avenue**

**Federal Aid Project No. NH-092-1(27)**

Not to Scale      Date: January 2009

SHEET No. 2 OF 2 SHEETS