




## TREE PROTECTION ZONE

- All trees identified on the plans should be protected. All trees 6" caliper or greater (as measured at 4 1/2 feet height) shall be protected. If trees other than those designated for removal are damaged beyond survival condition as determined by the Engineer, the Contractor shall remove such trees and replace with a tree of the same specie and size and maintain for the duration of the construction or 12 months whichever is greater at no cost to the state.
- The recommended Tree Protection Zone should be located at the outer drip line of the canopy of the tree. However, the minimum protection zone around a tree should be at least 20 feet from the external surface of the tree's trunk.
- All trees shall remain unless shown for removal. All protected trees shall be listed on the roadway plans. If there is a discrepancy, contractor shall contact the Engineer immediately.
- Protective fences shall be erected around trees identified on the plans or trees with a trunk diameter greater than 6 inches (as measured at a height of 4 1/2 feet.) Protective fence shall be 4 feet high orange plastic mesh or approved equivalent supported on #6 Rebar a minimum of 6 feet long. Protective fence shall surround the tree at a minimum of 5 feet from the tree trunk with #6 Rebar at a minimum of 5 feet on center. Fence shall be installed and approved by Landscape Architect or Engineer prior to any demolition work and shall remain in place until site work is completed. Signs shall be posted on all four sides to read "Tree Protection Zone (TPZ) - No Grade Changed, Storage or Equipment Permitted Within TPZ."
- For the duration of construction within the drip line of the trees to remain, there must be :
  - No changed, alternation or disturbance to the grade by adding fill, excavating or scraping except as noted on plans;
  - No storage on construction materials or equipment;
  - No stockpiling of any construction materials or excavated materials;
  - No disposal of any liquids example concrete sleuth, gas, oil or paint;
  - No vehicular traffic, equipment or excessive pedestrian traffic;
  - No attachment of any wires, ropes, lights or any other such attachment other than those of a protective nature to any tree to be preserved, and
  - No cleaning of equipment or material under the canopy of any tree or group of trees to be preserved.

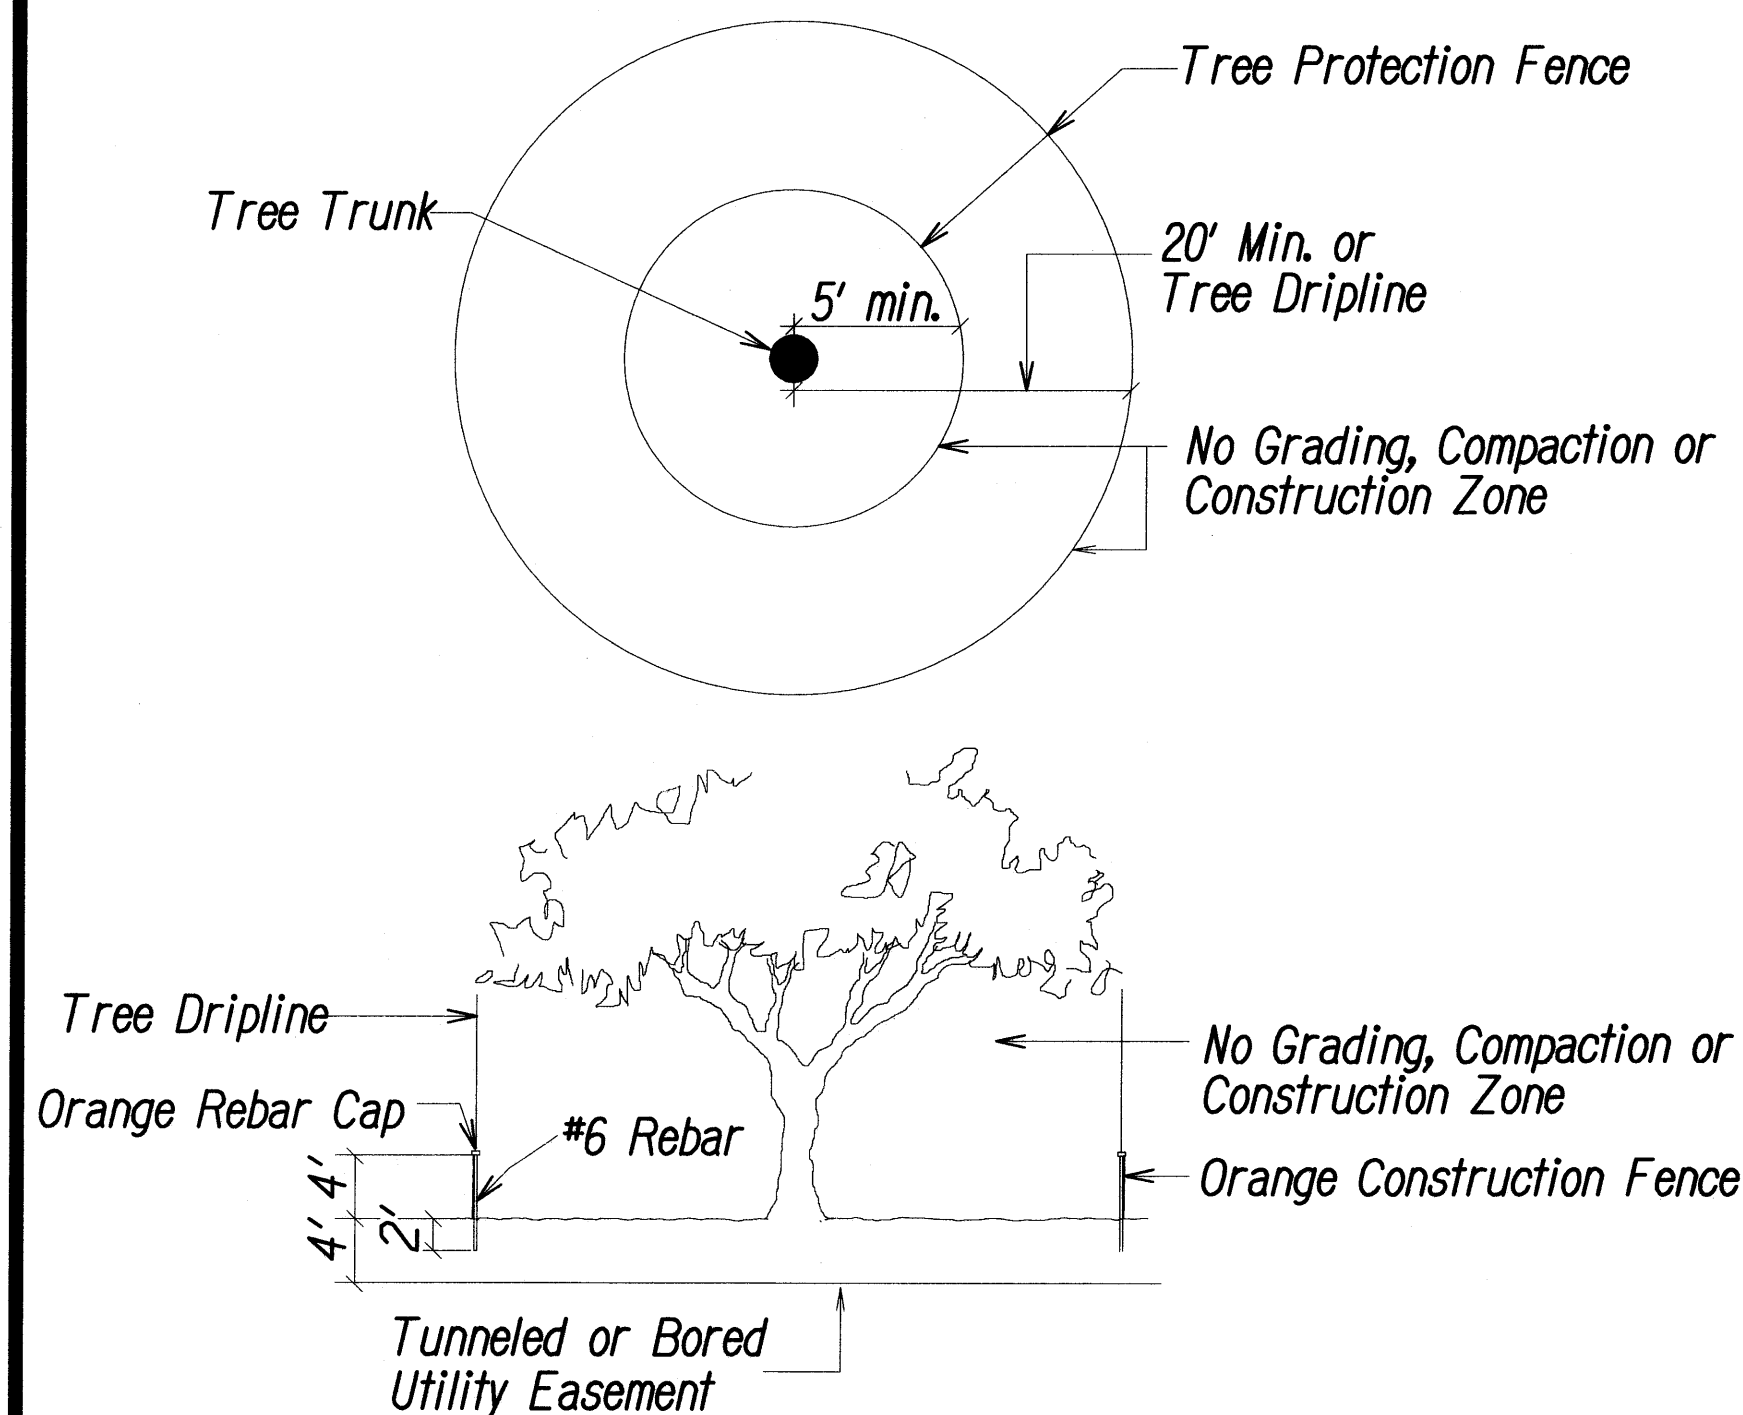

TREE PROTECTION ZONE (TPZ) DETAIL

Not to Scale

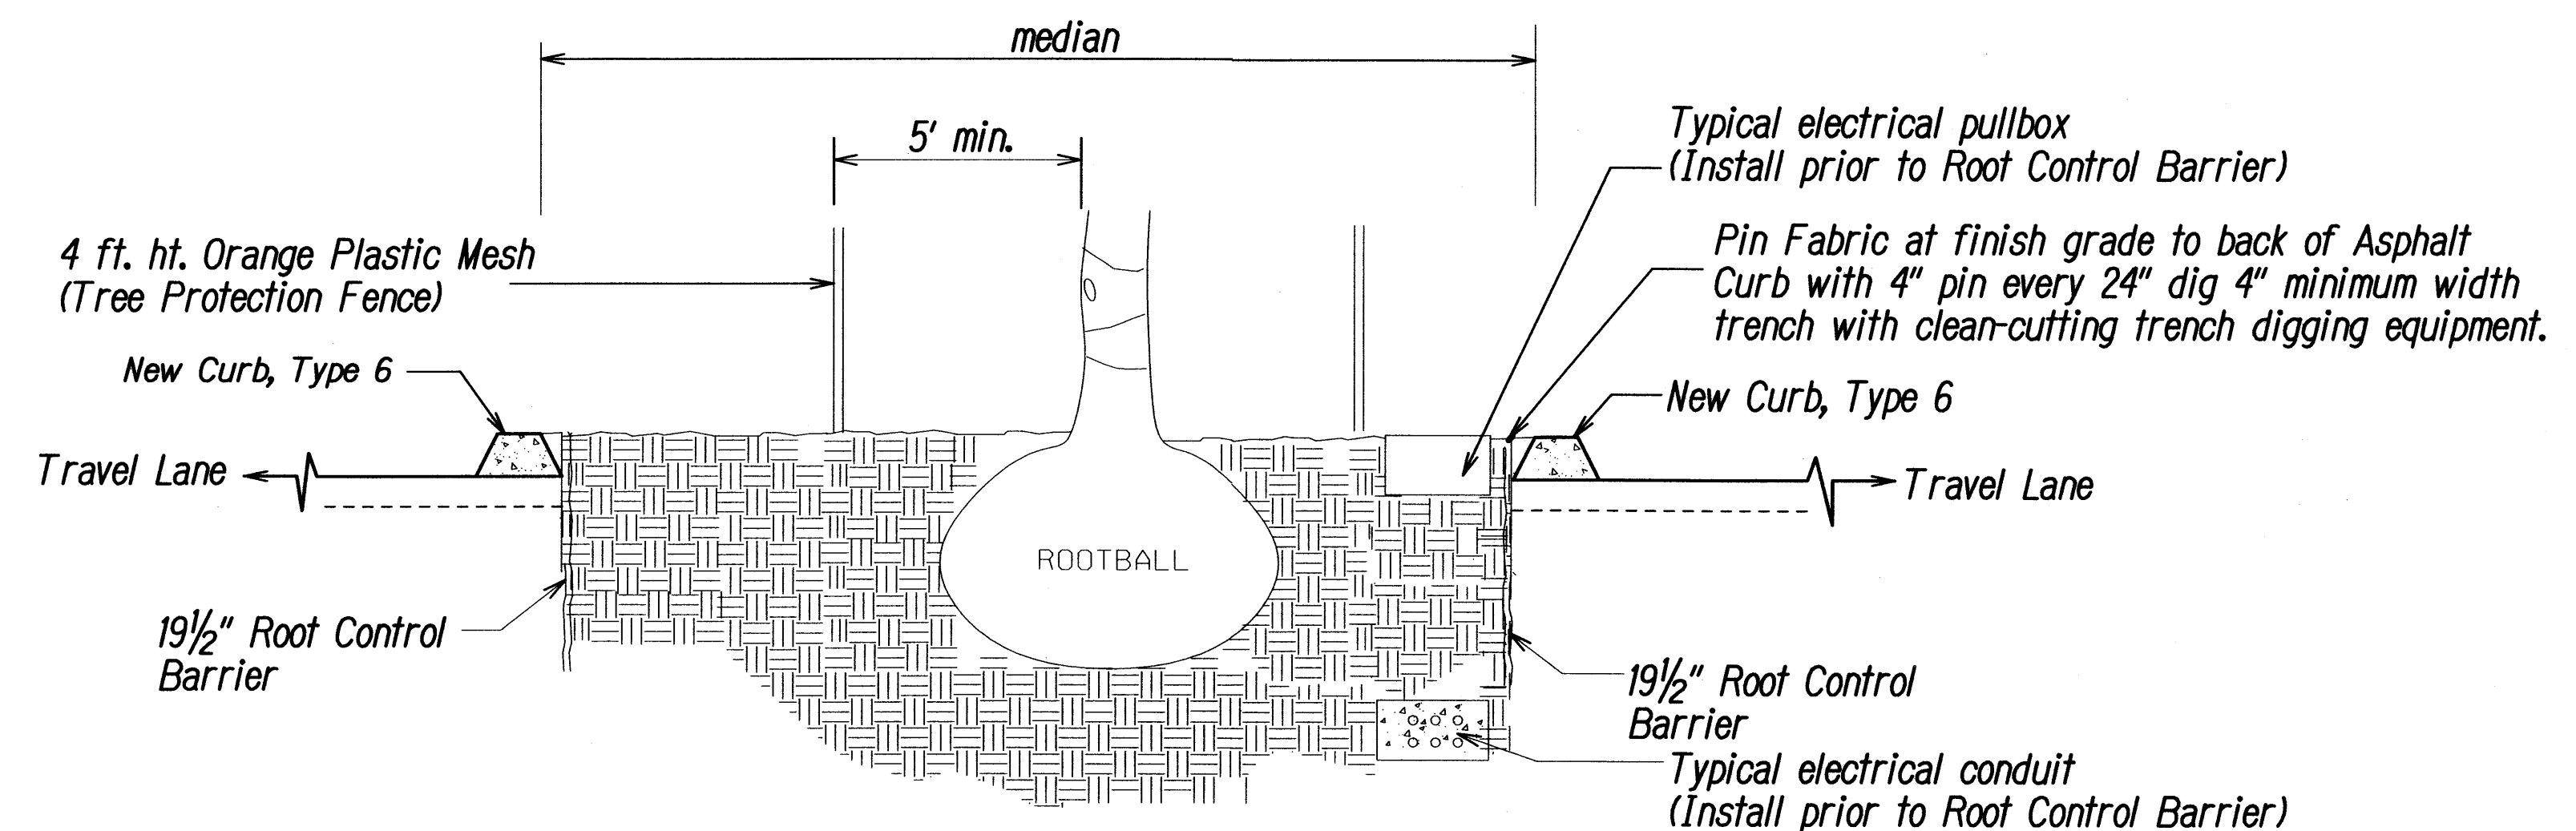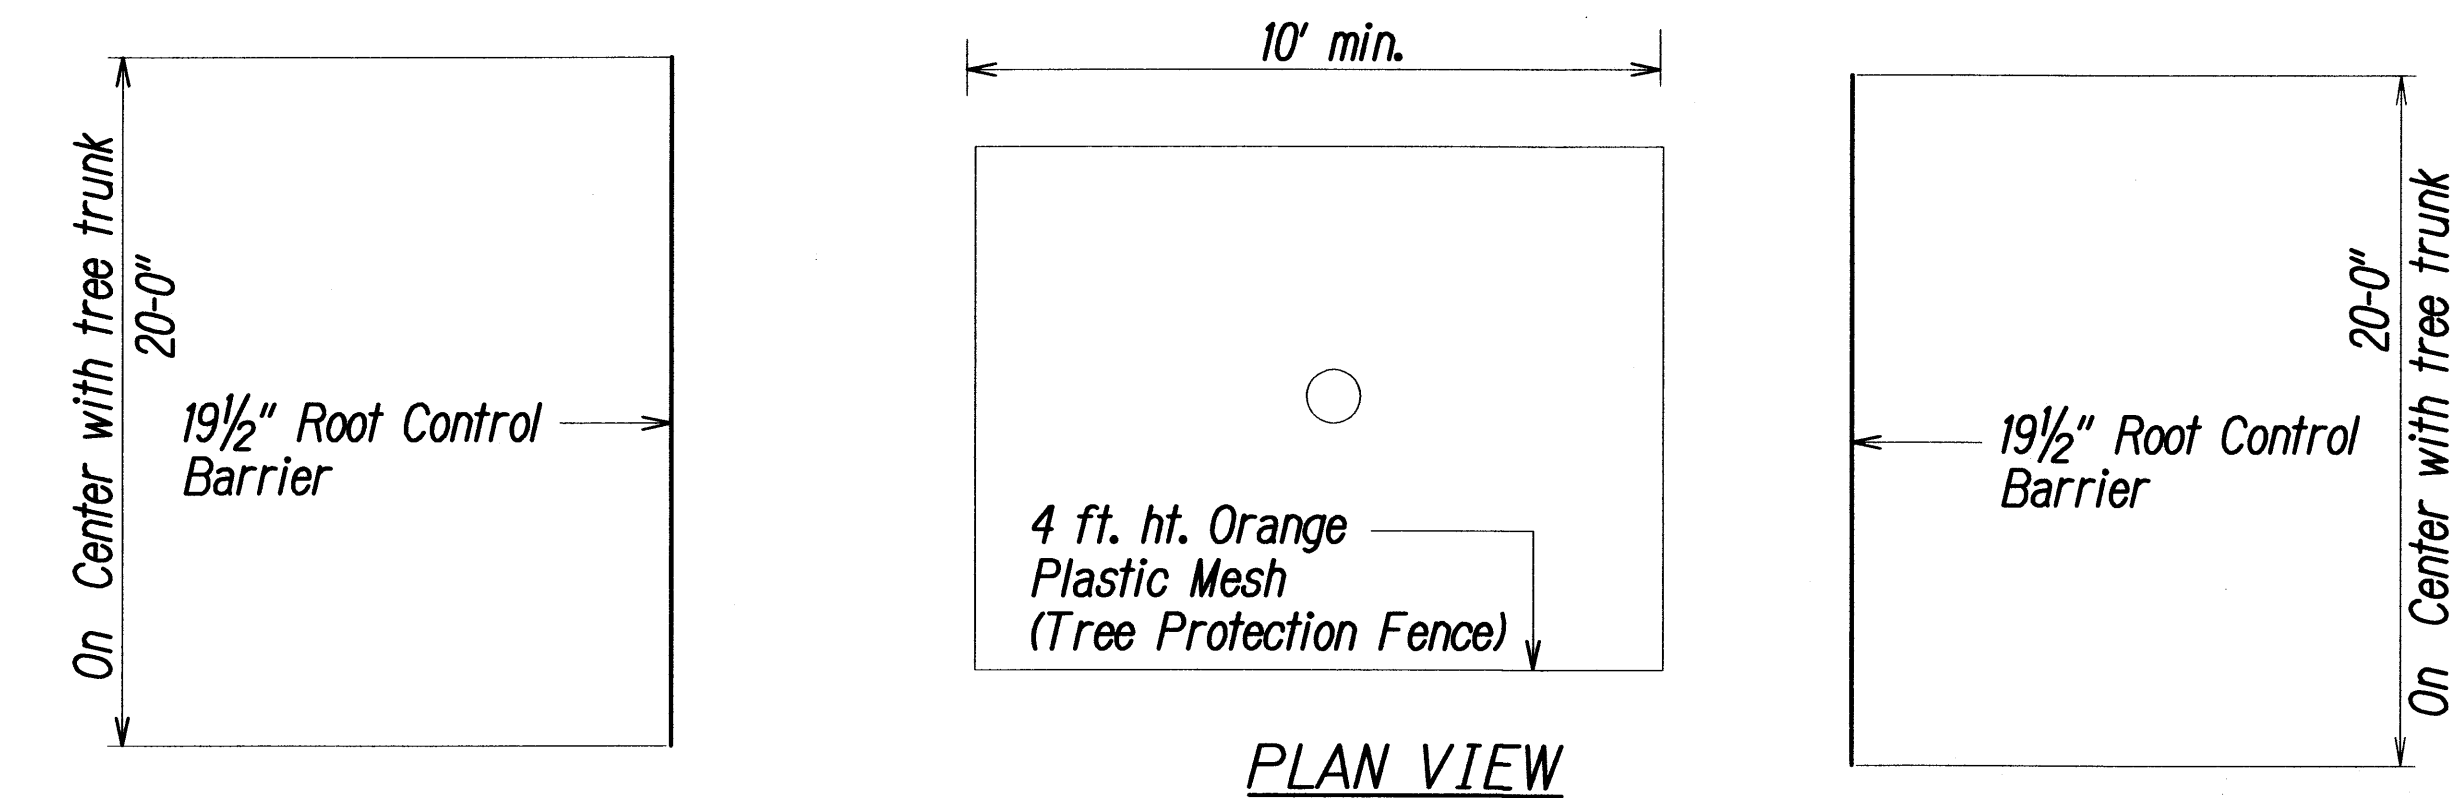


### Note :

Nodules to face tree. Place top edge of root control barrier at finish grade and secure with manufacturer provided pins. Seams shall have minimum 3 inches overlap. Refer to manufacturer instructions for bonding the seam. Do not allow gaps in fabric during installation or backfilling. Root control barrier should not be left exposed to surface water or sunlight for more than 12 hours since high temperatures and sunlight reduce effective life of product label and MSDS sheet for safety information.

MEDIAN DETAIL WITH ROOT CONTROL BARRIER INSTALLATION DETAIL

Not to Scale

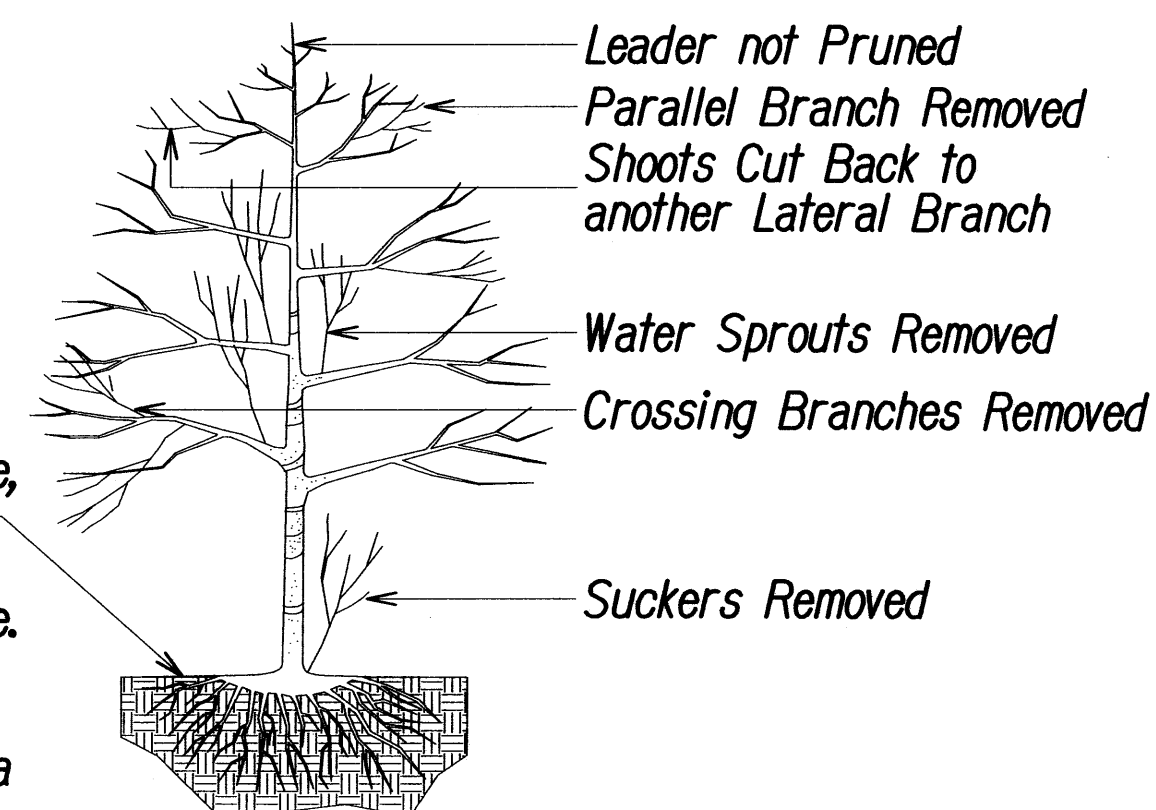


TREE PRUNING DETAIL

Not to Scale

### Note :

- Positions of first and second cuts may be reversed in some cases, particularly when cutting a large branch with a chainsaw.
- Do not make flush cuts or leave stubs.
- Do not paint cuts.
- Remove dead, broken or malformed branches.
- Remove all vines entwined in the tree or around its trunk.
- All pruning shall be completed using clean sharp tools. All cuts shall be clean and smooth, with the bark intact with no rough edges or tears.
- Dispose of all cuttings outside of right of way.
- Retain the normal shape of the plant.

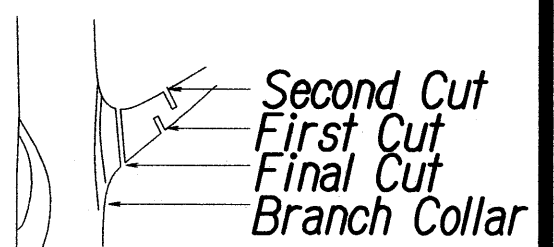

FED. ROAD DIST. NO.	STATE	PROJ. NO.	FISCAL YEAR	SHEET NO.	TOTAL SHEETS
HAWAII	HAW.	NH-092-1(27)	2009	29	302

SURVEY PLOTTED BY	DATE
DRAWN BY	
DESIGNED BY	
NOTED BY	
CHECKED BY	
ORIGINAL PLAN	
NOTE BOOK	
QUANTITIES BY	
CHECKED BY	

STATE OF HAWAII  
DEPARTMENT OF TRANSPORTATION  
HIGHWAYS DIVISION


**LANDSCAPING DETAILS**

NIMITZ HIGHWAY AND  
ALA MOANA BOULEVARD RESURFACING  
AND HIGHWAY LIGHTING REPLACEMENT  
Fort Street to Kalakaua Avenue  
Federal Aid Project No. NH-092-1(27)

Scale: Not to Scale Date: February 2008


SHEET No. 1 OF 3 SHEETS

FED. ROAD DIST. NO.	STATE	PROJ. NO.	FISCAL YEAR	SHEET NO.	TOTAL SHEETS
HAWAII	HAW.	NH-092-1(27)	2009	30	302

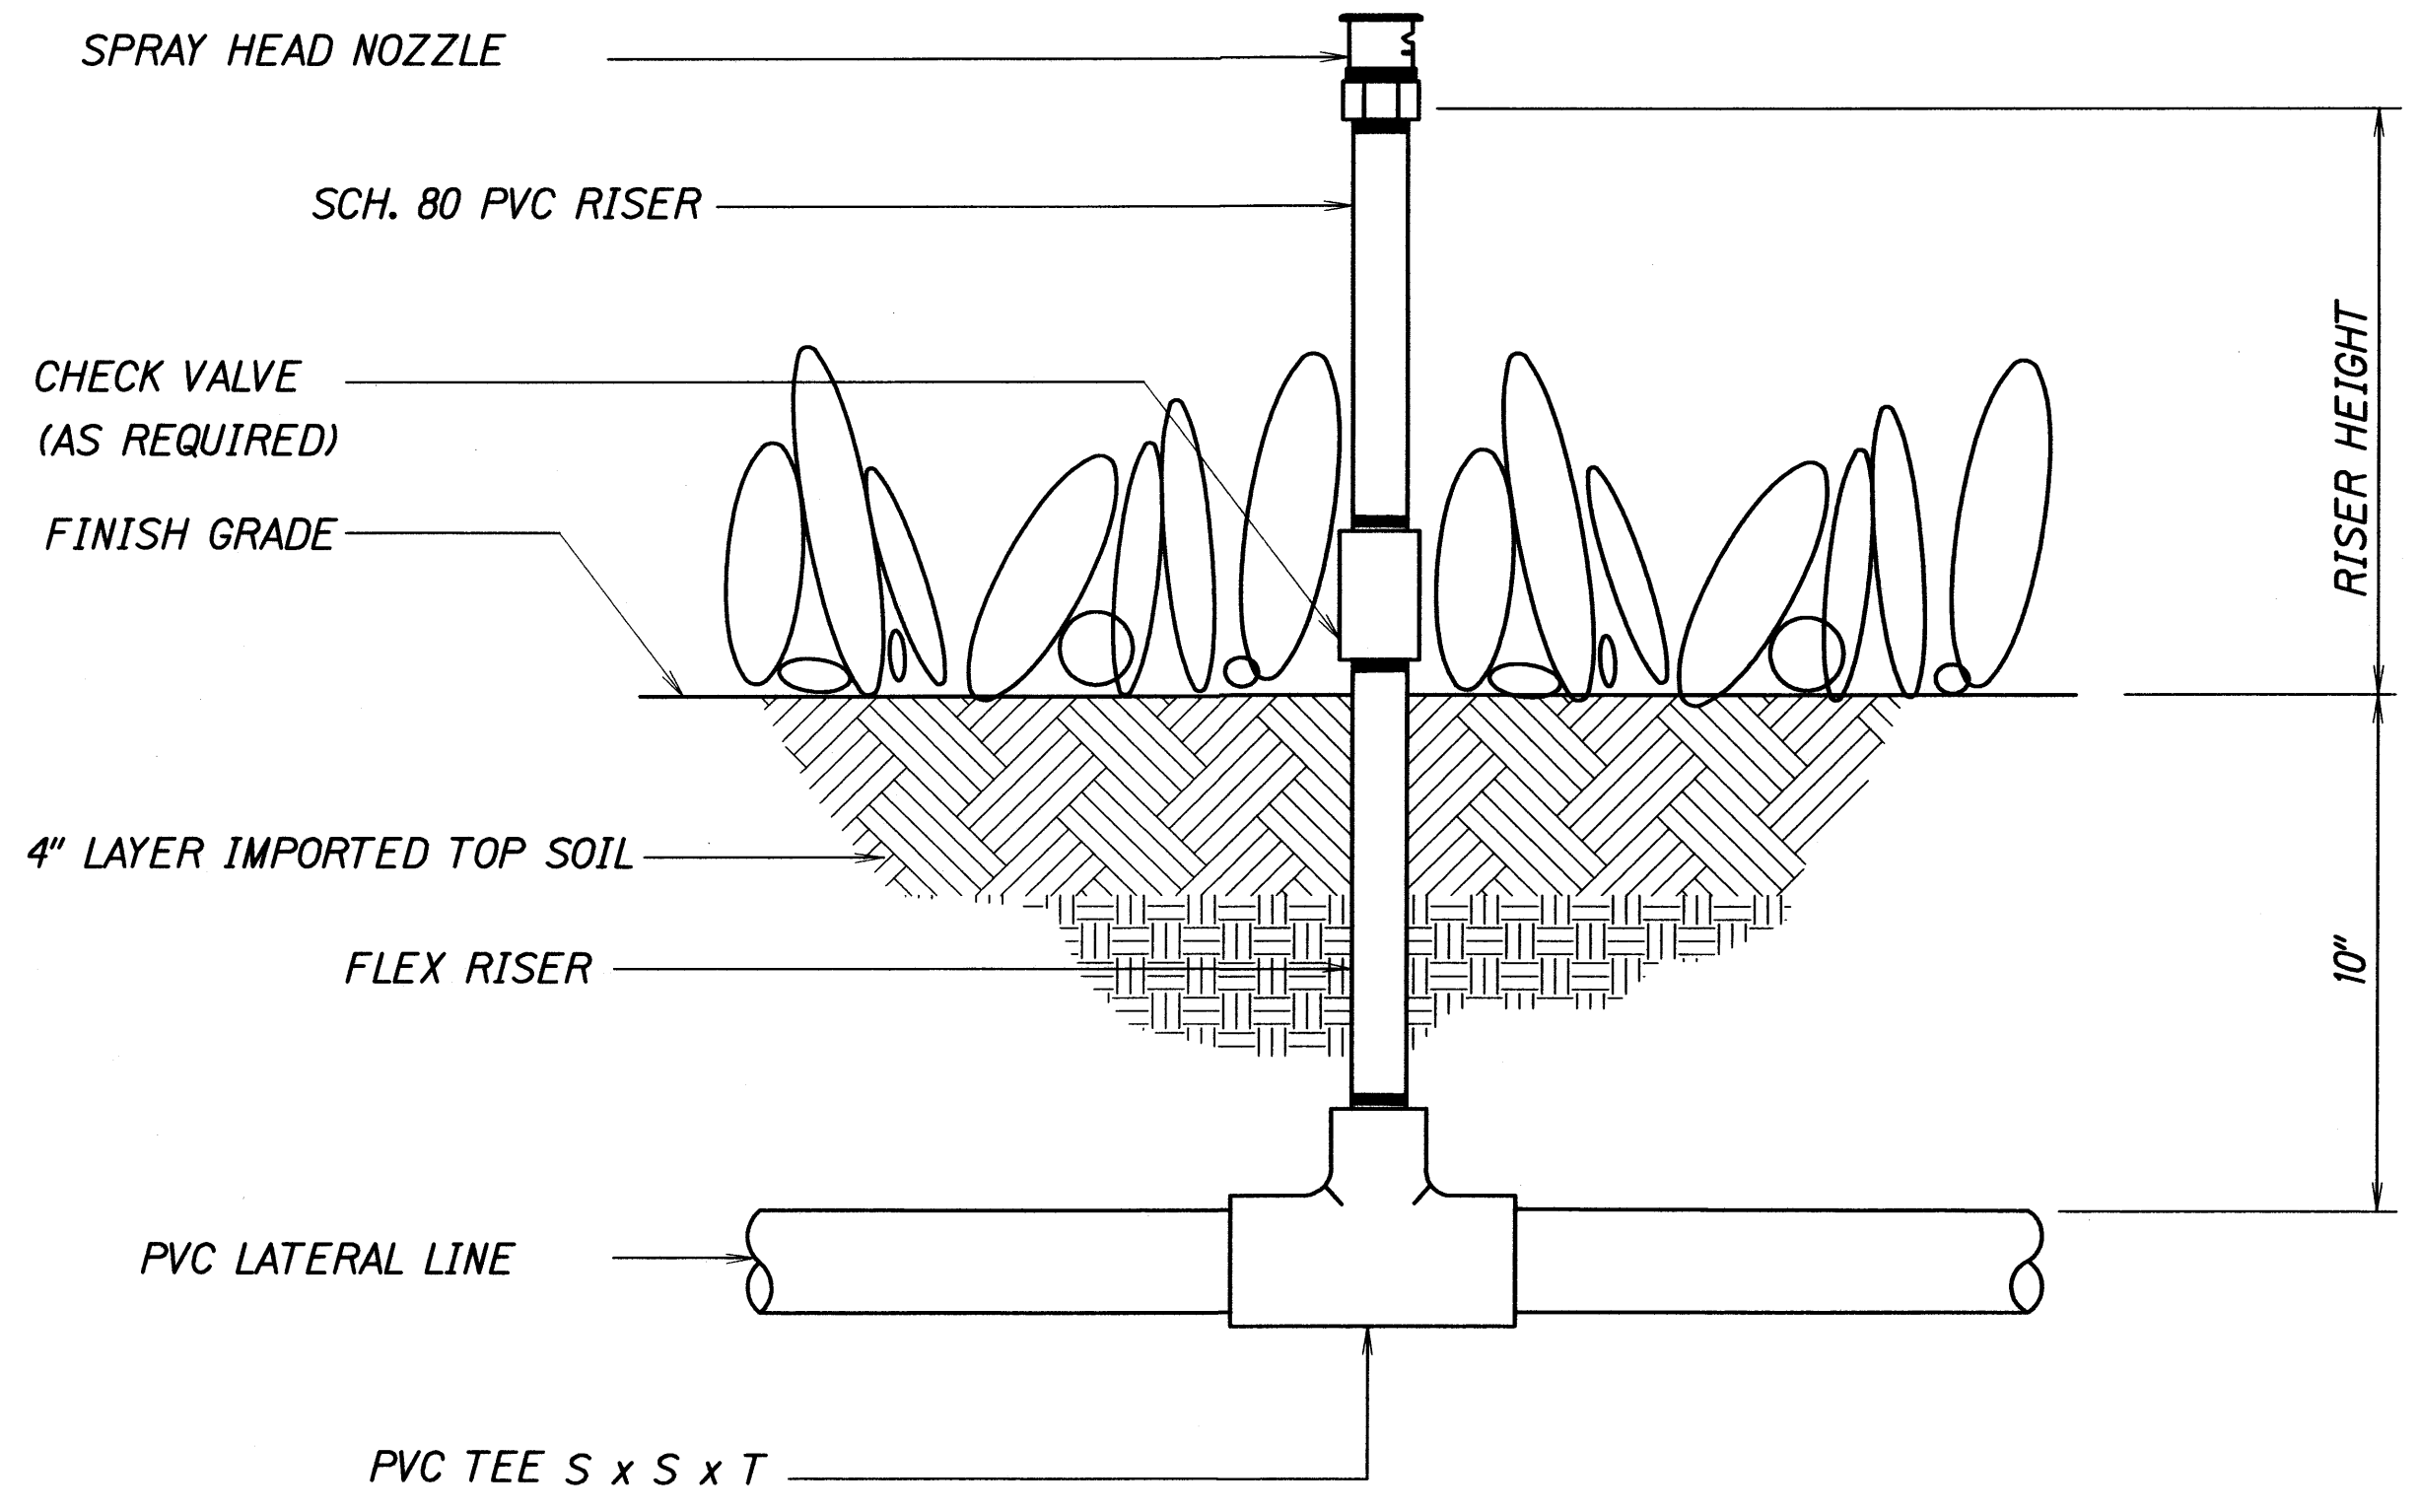


NOTE: LOCATE SHRUB SPRAY HEADS ON RISER 12" FROM BUILDING WALL LINES UNLESS OTHERWISE DIRECTED BY ENGINEER.

ON RISER DETAIL  
SPRAY HEAD  
Not to Scale

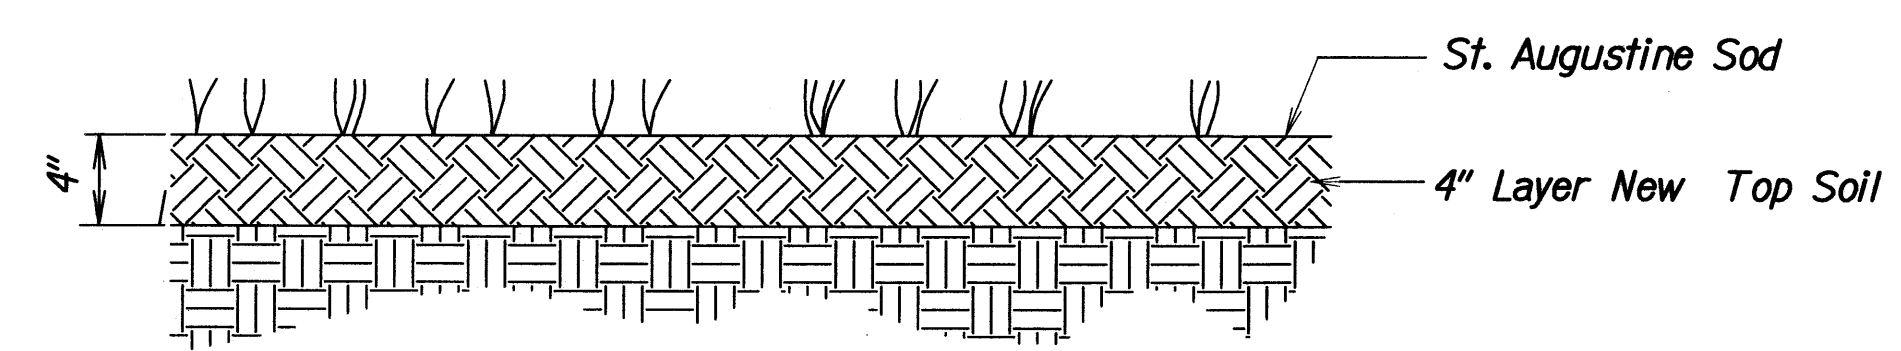

GRASS SOD DETAIL  
Not to Scale

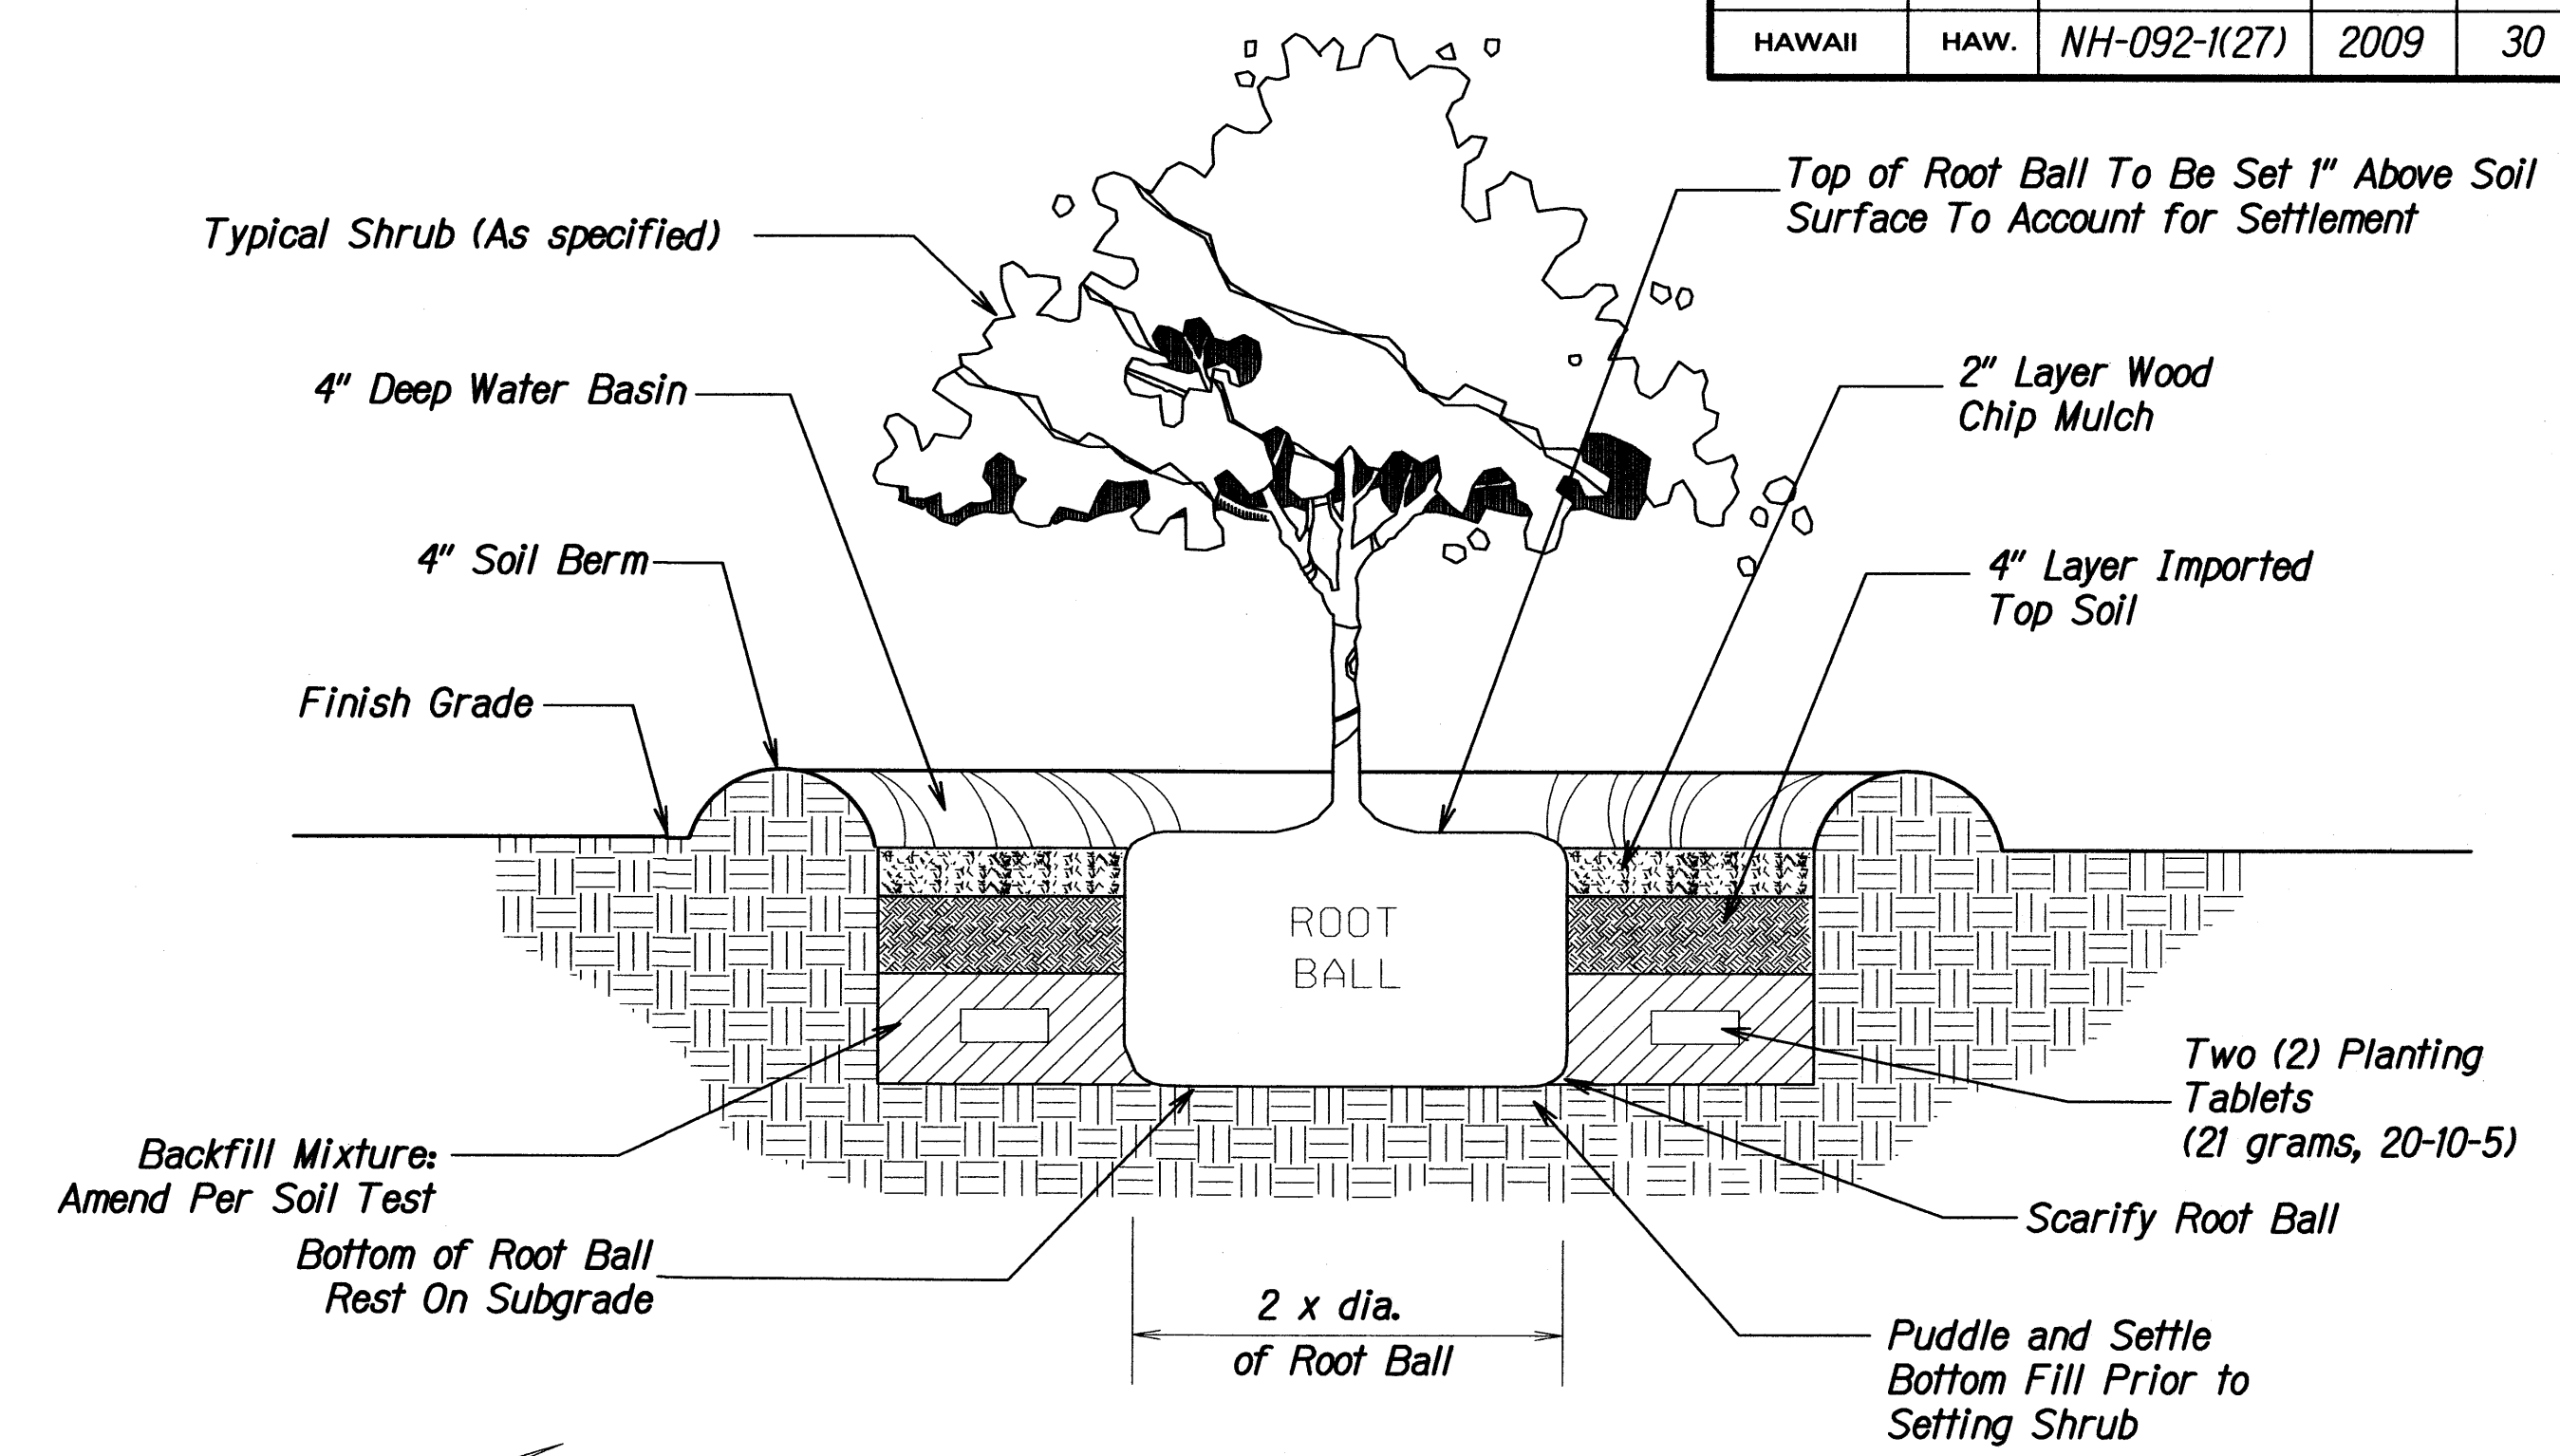


SHRUB PLANTING DETAIL  
Not to Scale



Notes for Multi-Trunk Palm Planting Detail:

1. Trunks must be protected from rope sling burns and abrasions during moving.
2. Prune off all dead fronds.
3. Water heavily to insure soil settles around roots.
4. Tree shall be plumb. If there is leaning at the end of the plant establishment period, the tree shall be rejected.

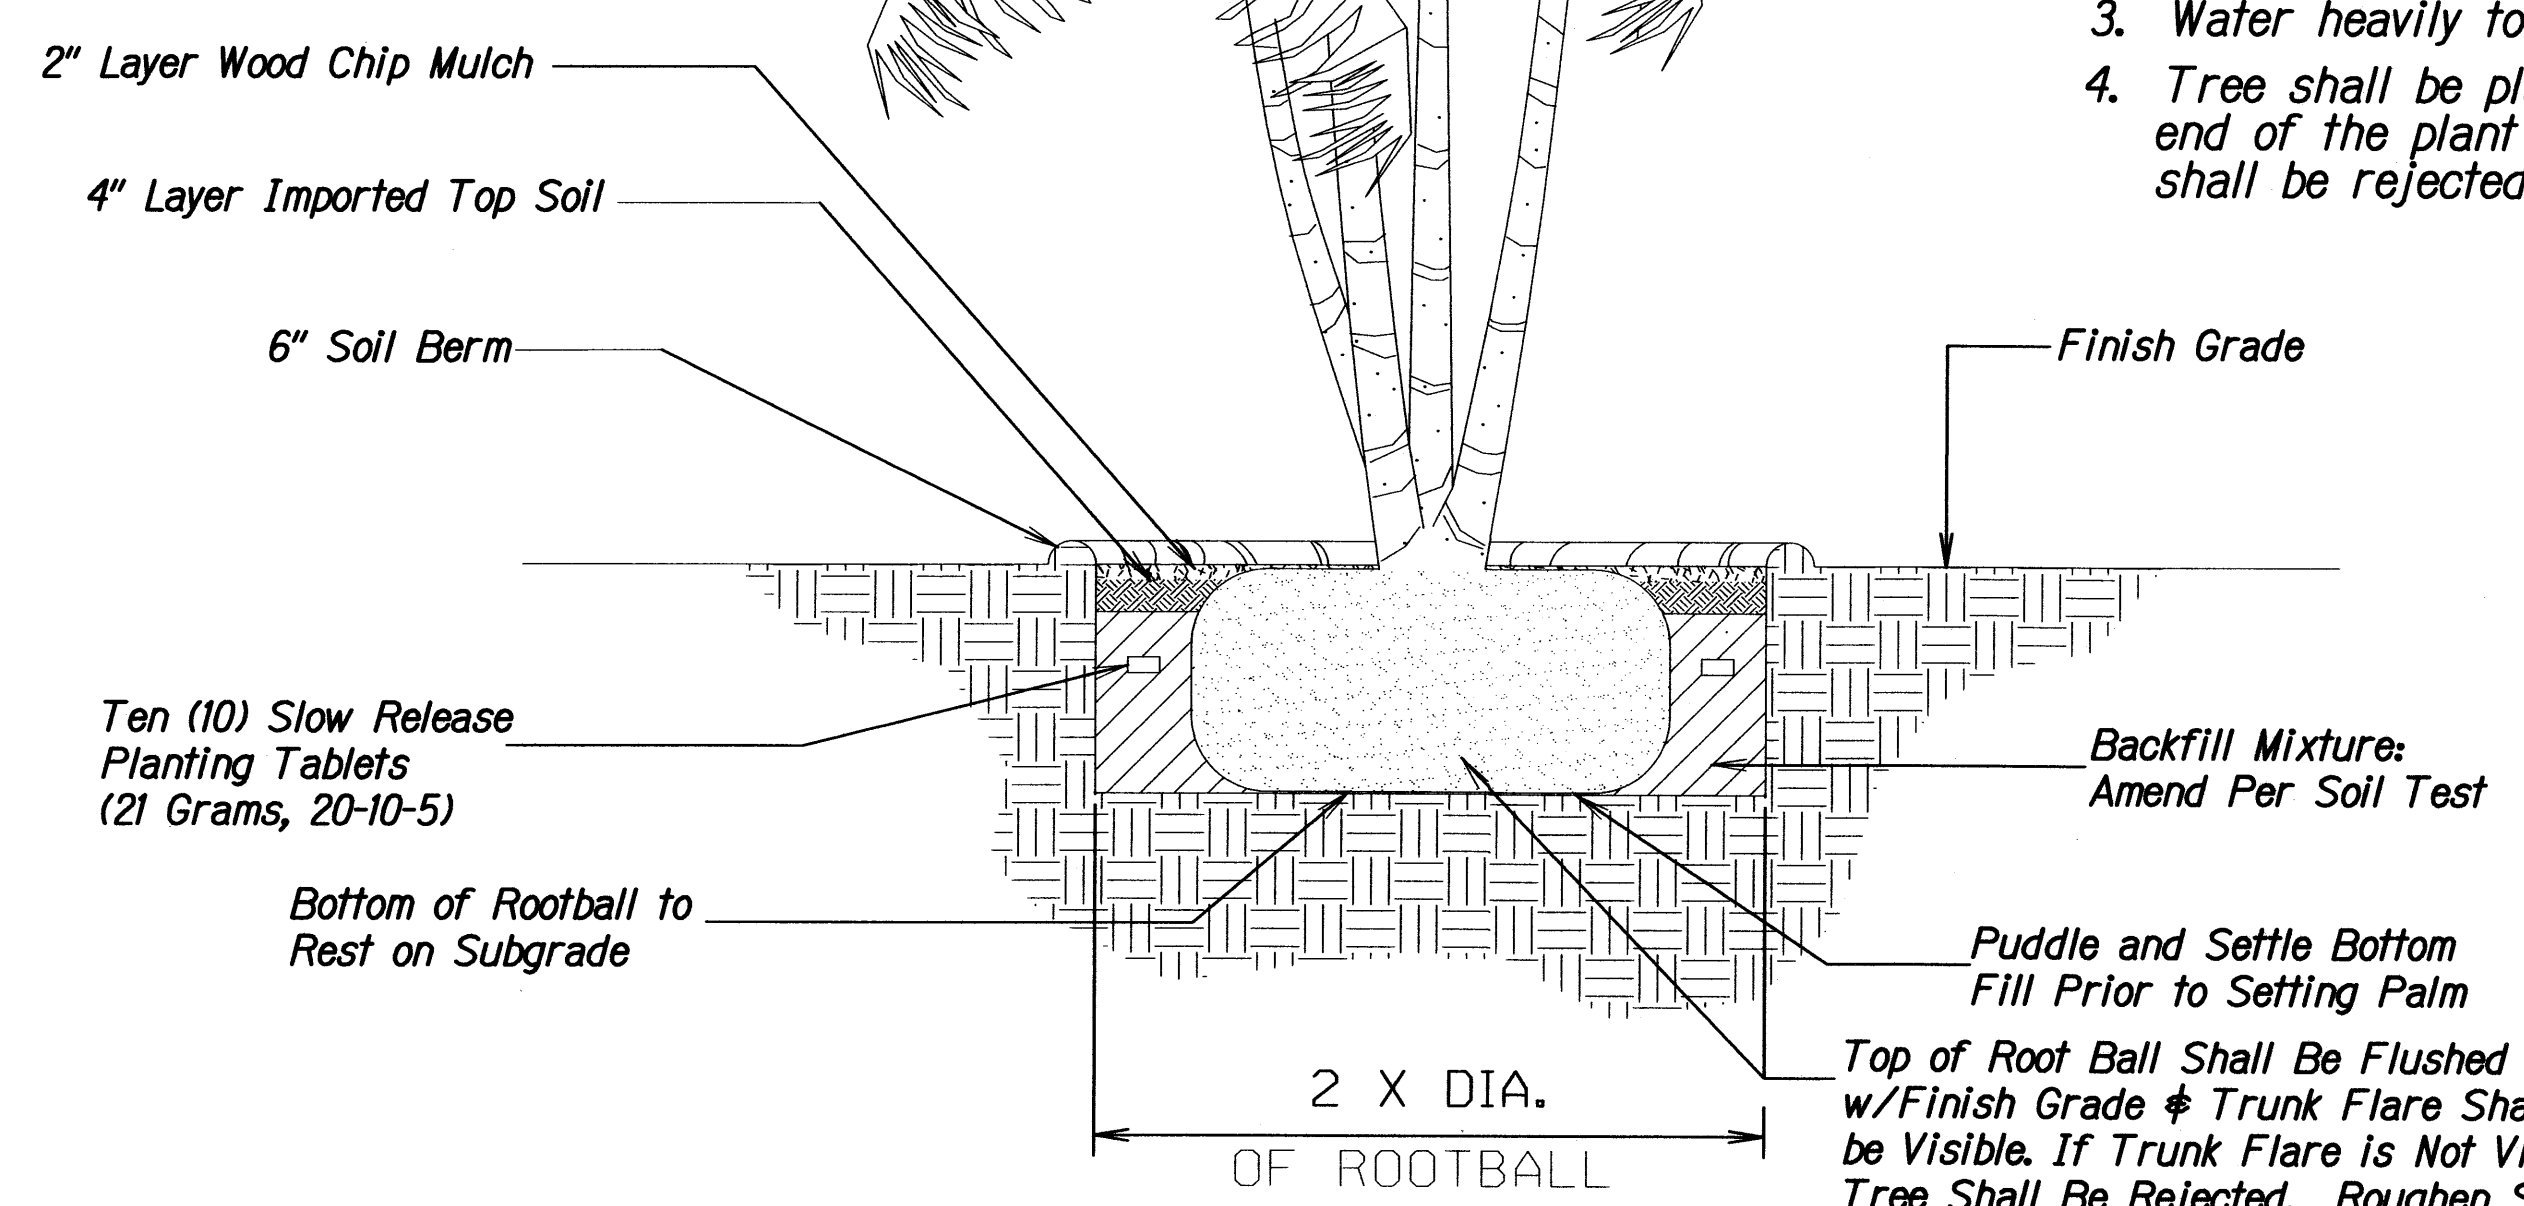

MULTI-TRUNK PALM PLANTING DETAIL  
Not to Scale

STATE OF HAWAII  
DEPARTMENT OF TRANSPORTATION  
HIGHWAYS DIVISION


**LANDSCAPING DETAILS**  
**NIMITZ HIGHWAY AND**  
**ALA MOANA BOULEVARD RESURFACING**  
**AND HIGHWAY LIGHTING REPLACEMENT**  
**Fort Street to Kalakaua Avenue**  
**Federal Aid Project No. NH-092-1(27)**  
Scale: Not to Scale      Date: February 2008

SHEET No. 2 OF 3 SHEETS

SURVEY PLOTTED BY	DATE
DRAWN BY	
DESIGNED BY	
QUANTITIES BY	
CHECKED BY	
ORIGINAL PLAN	
NOTE BOOK	
DATE	
BY	




FED. ROAD DIST. NO.	STATE	PROJ. NO.	FISCAL YEAR	SHEET NO.	TOTAL SHEETS
HAWAII	HAW.	NH-092-K(27)	2009	31	302

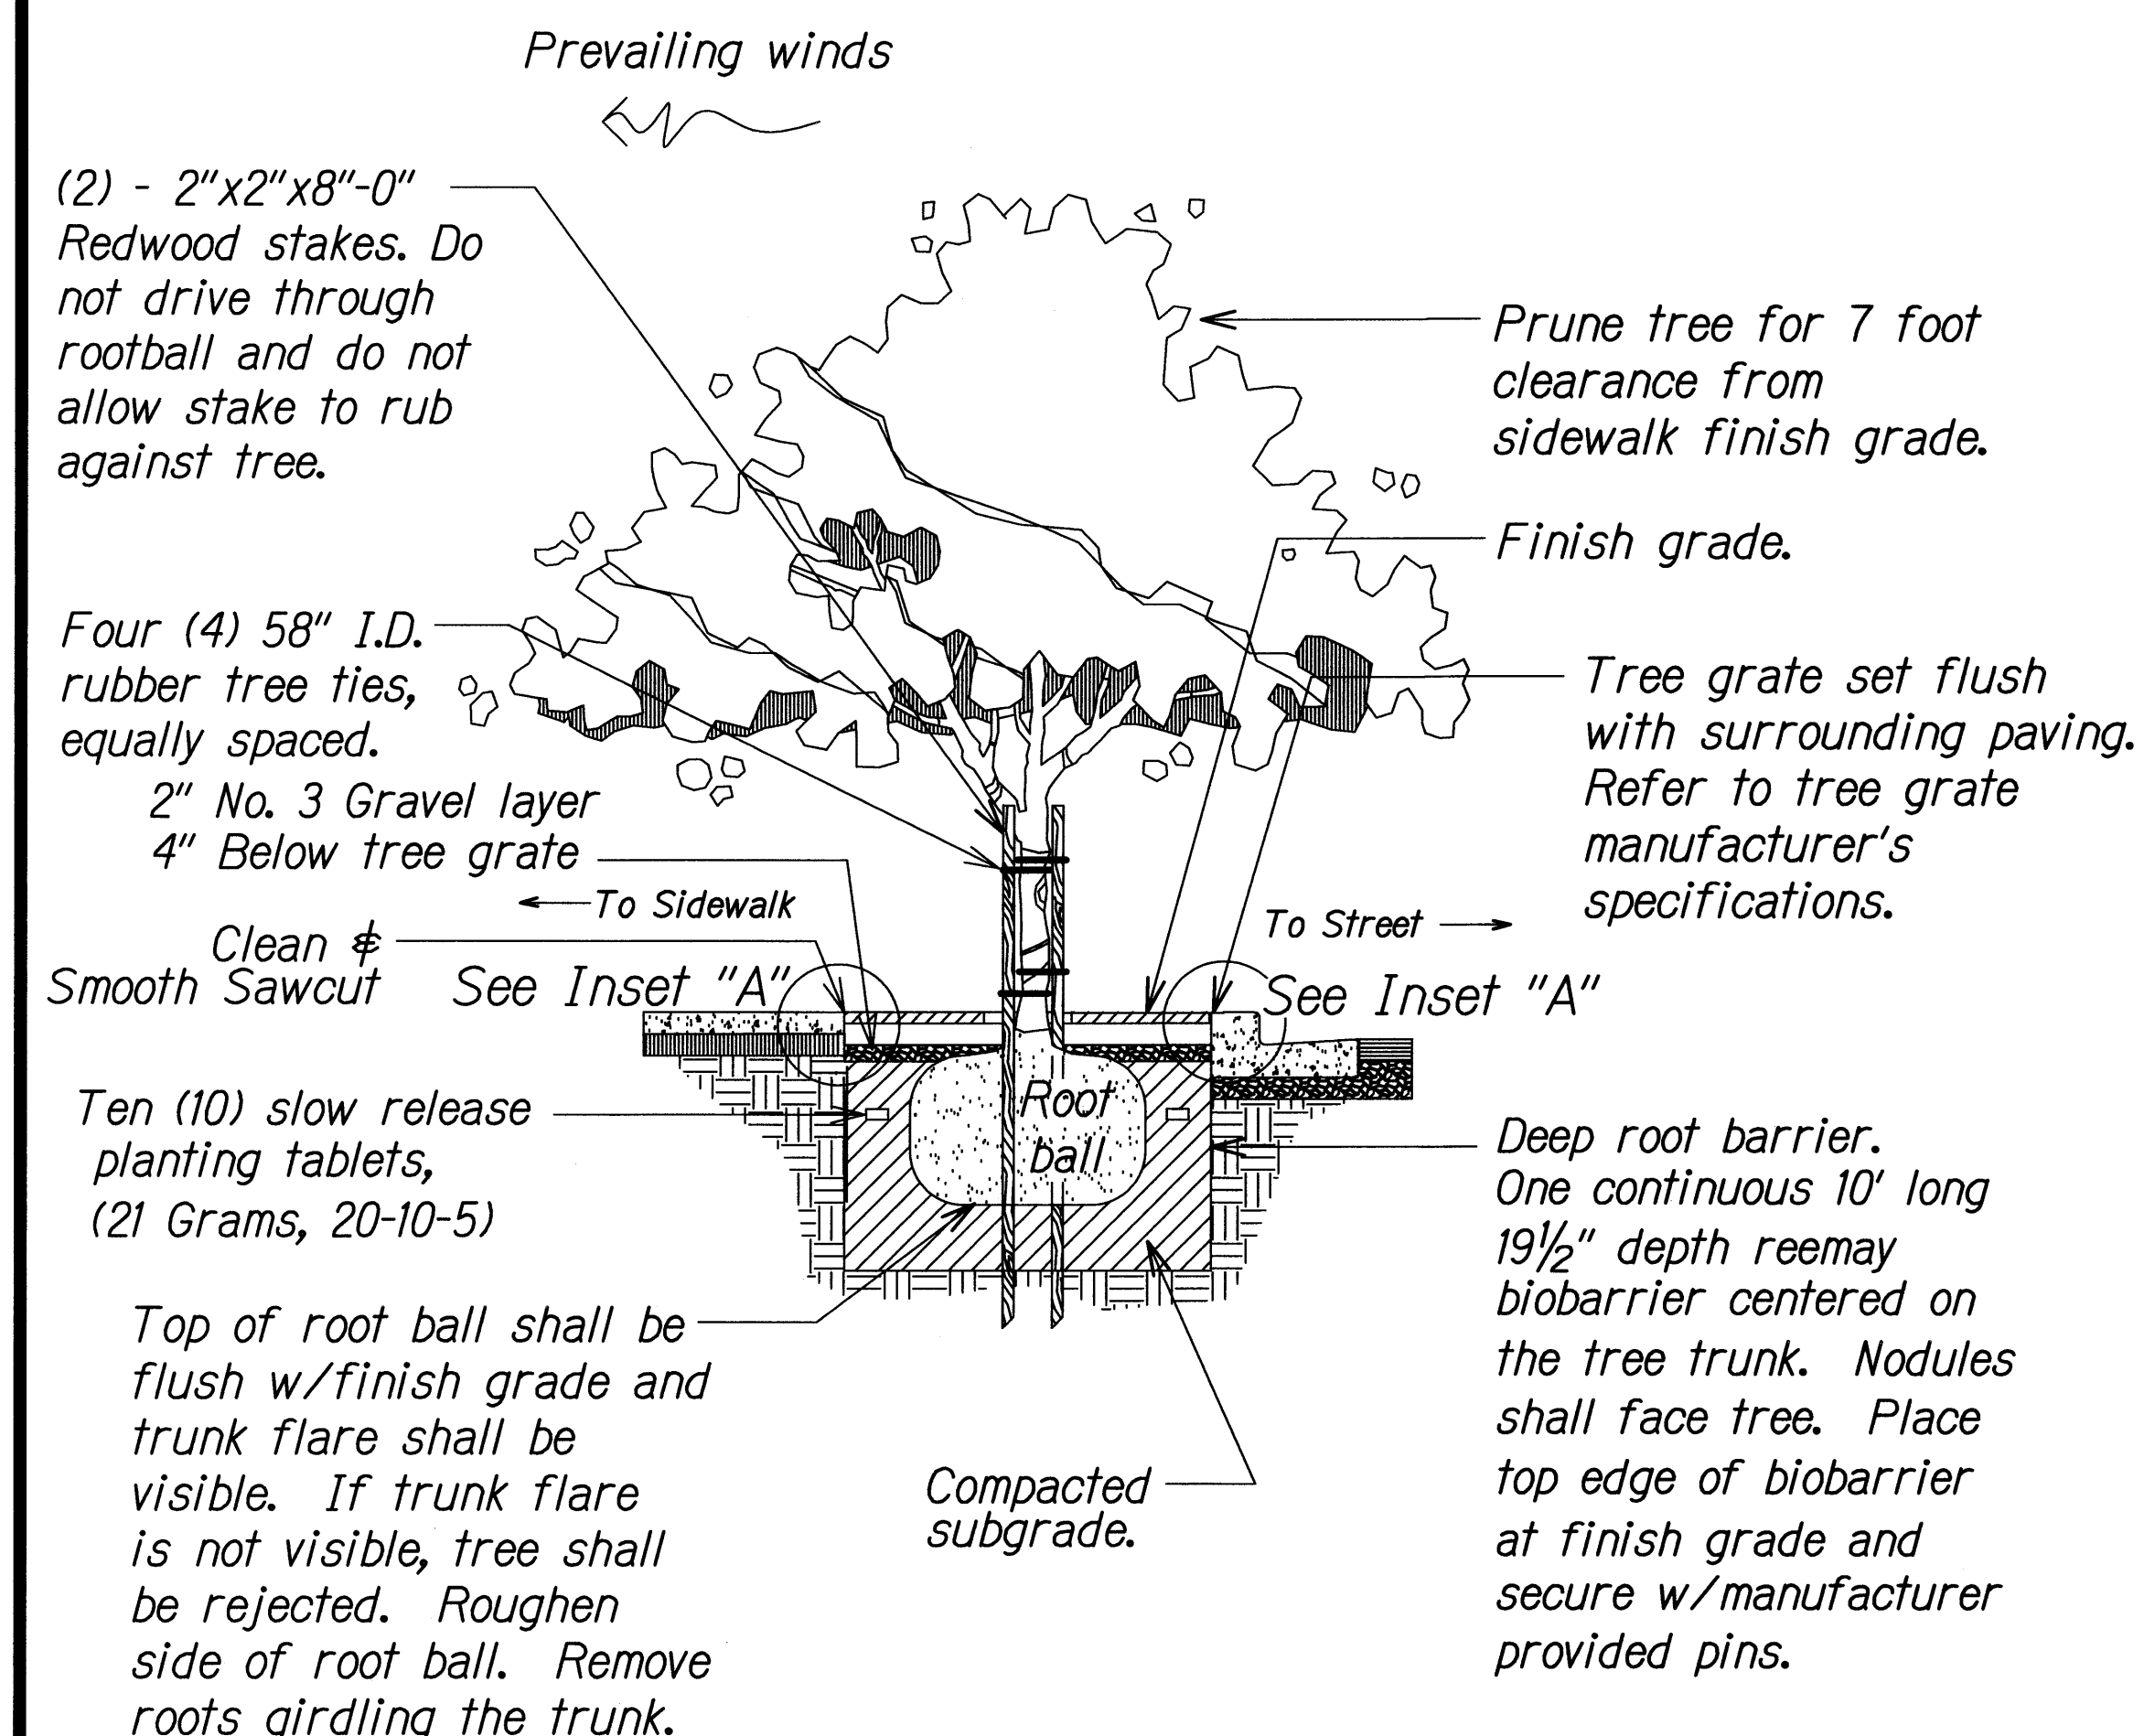

### STREET TREE PLANTING IN TREE GRATE




Not to Scale

Note:  
Rotate tree so the direction of the main branching is parallel to the street.

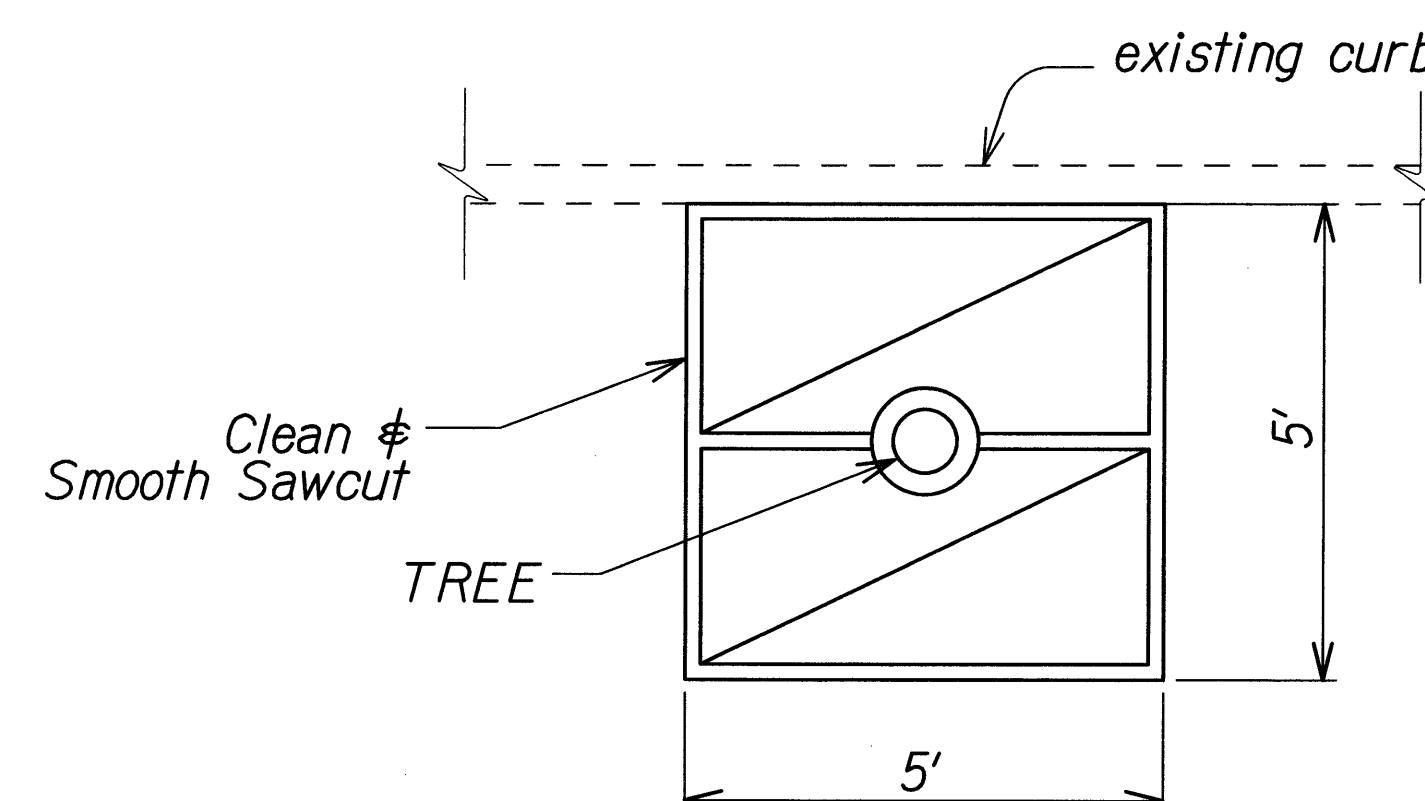

### TYPICAL METAL GRATE AT SHOWER TREE

Not to Scale

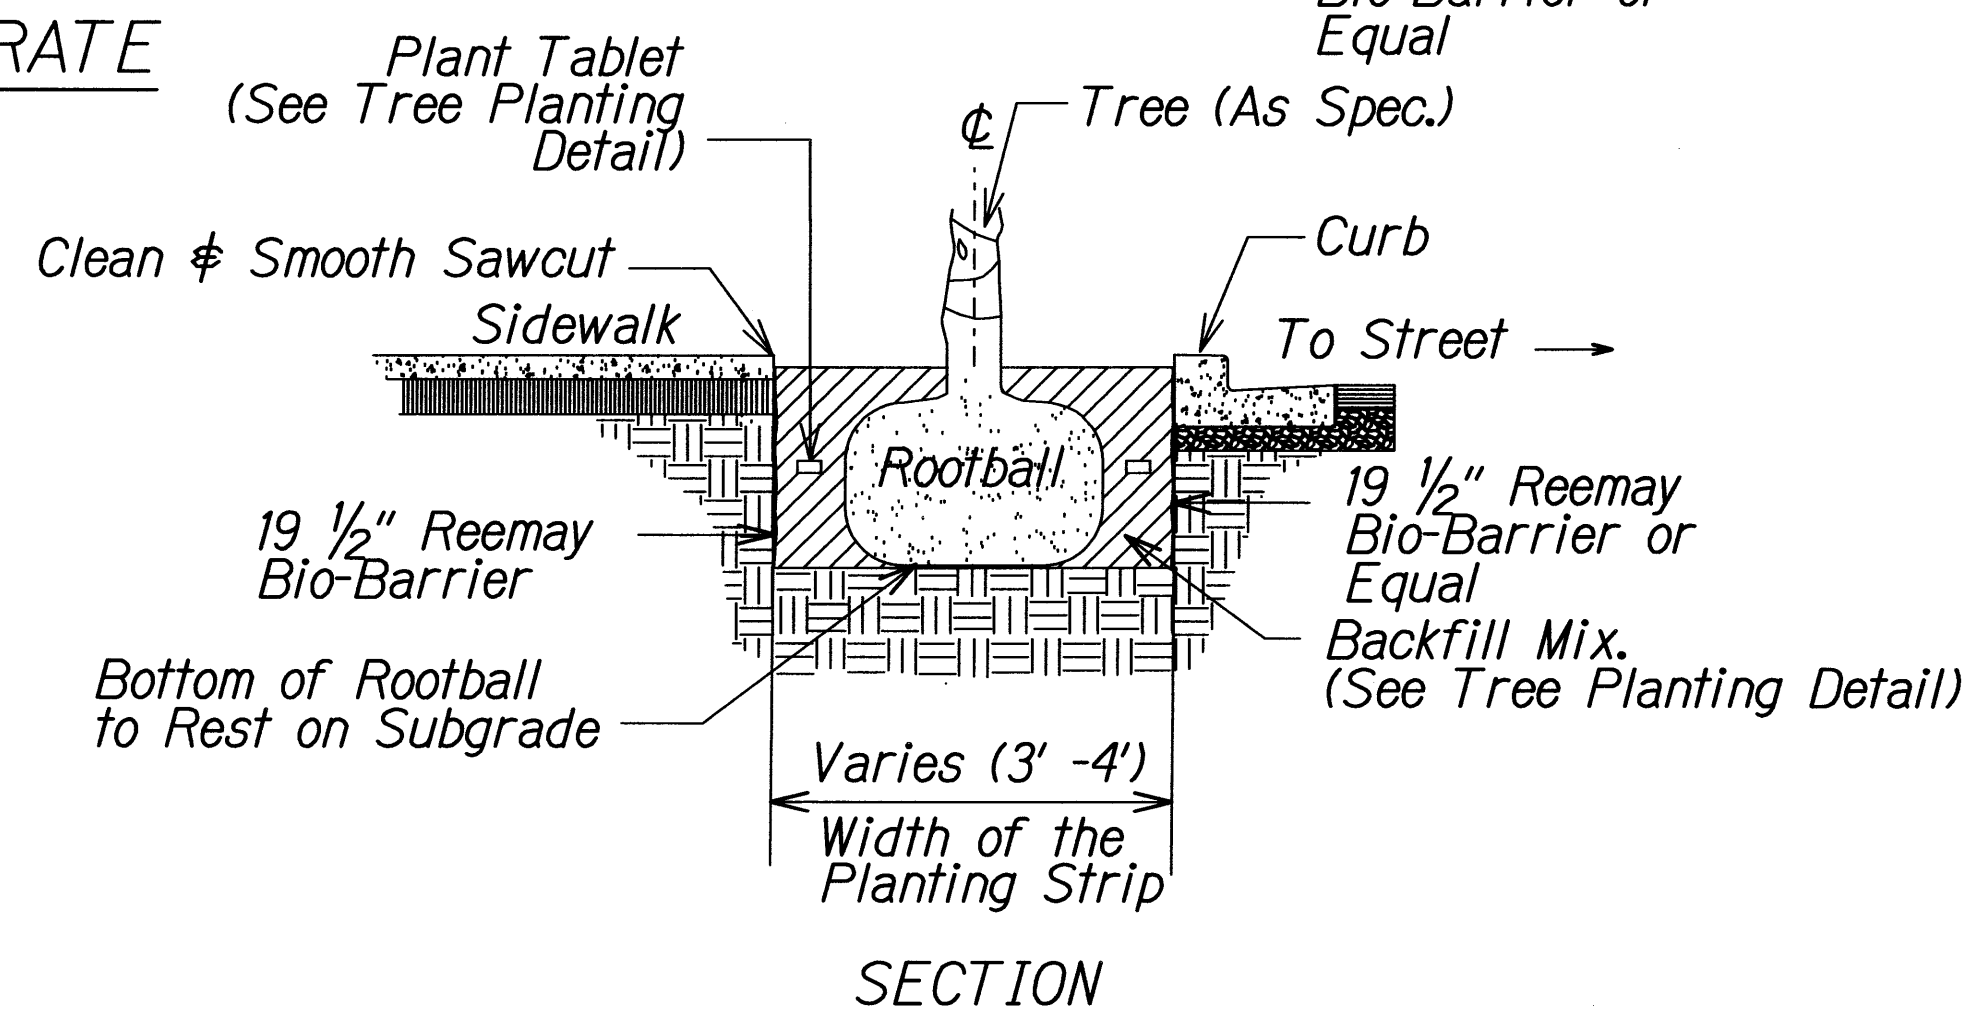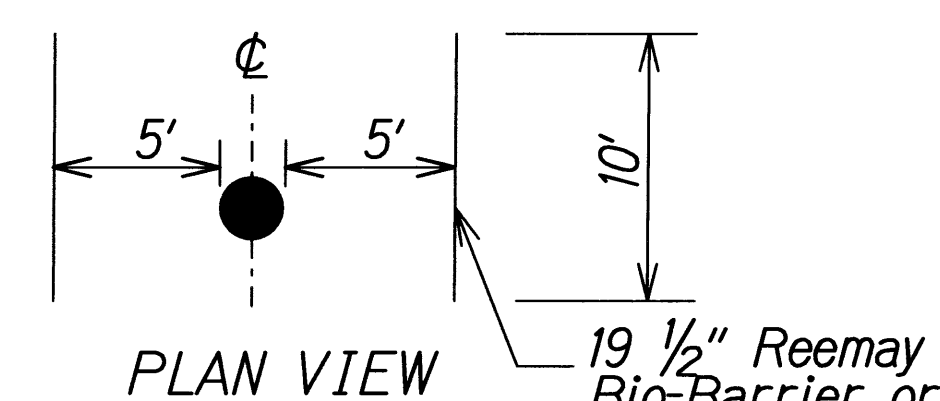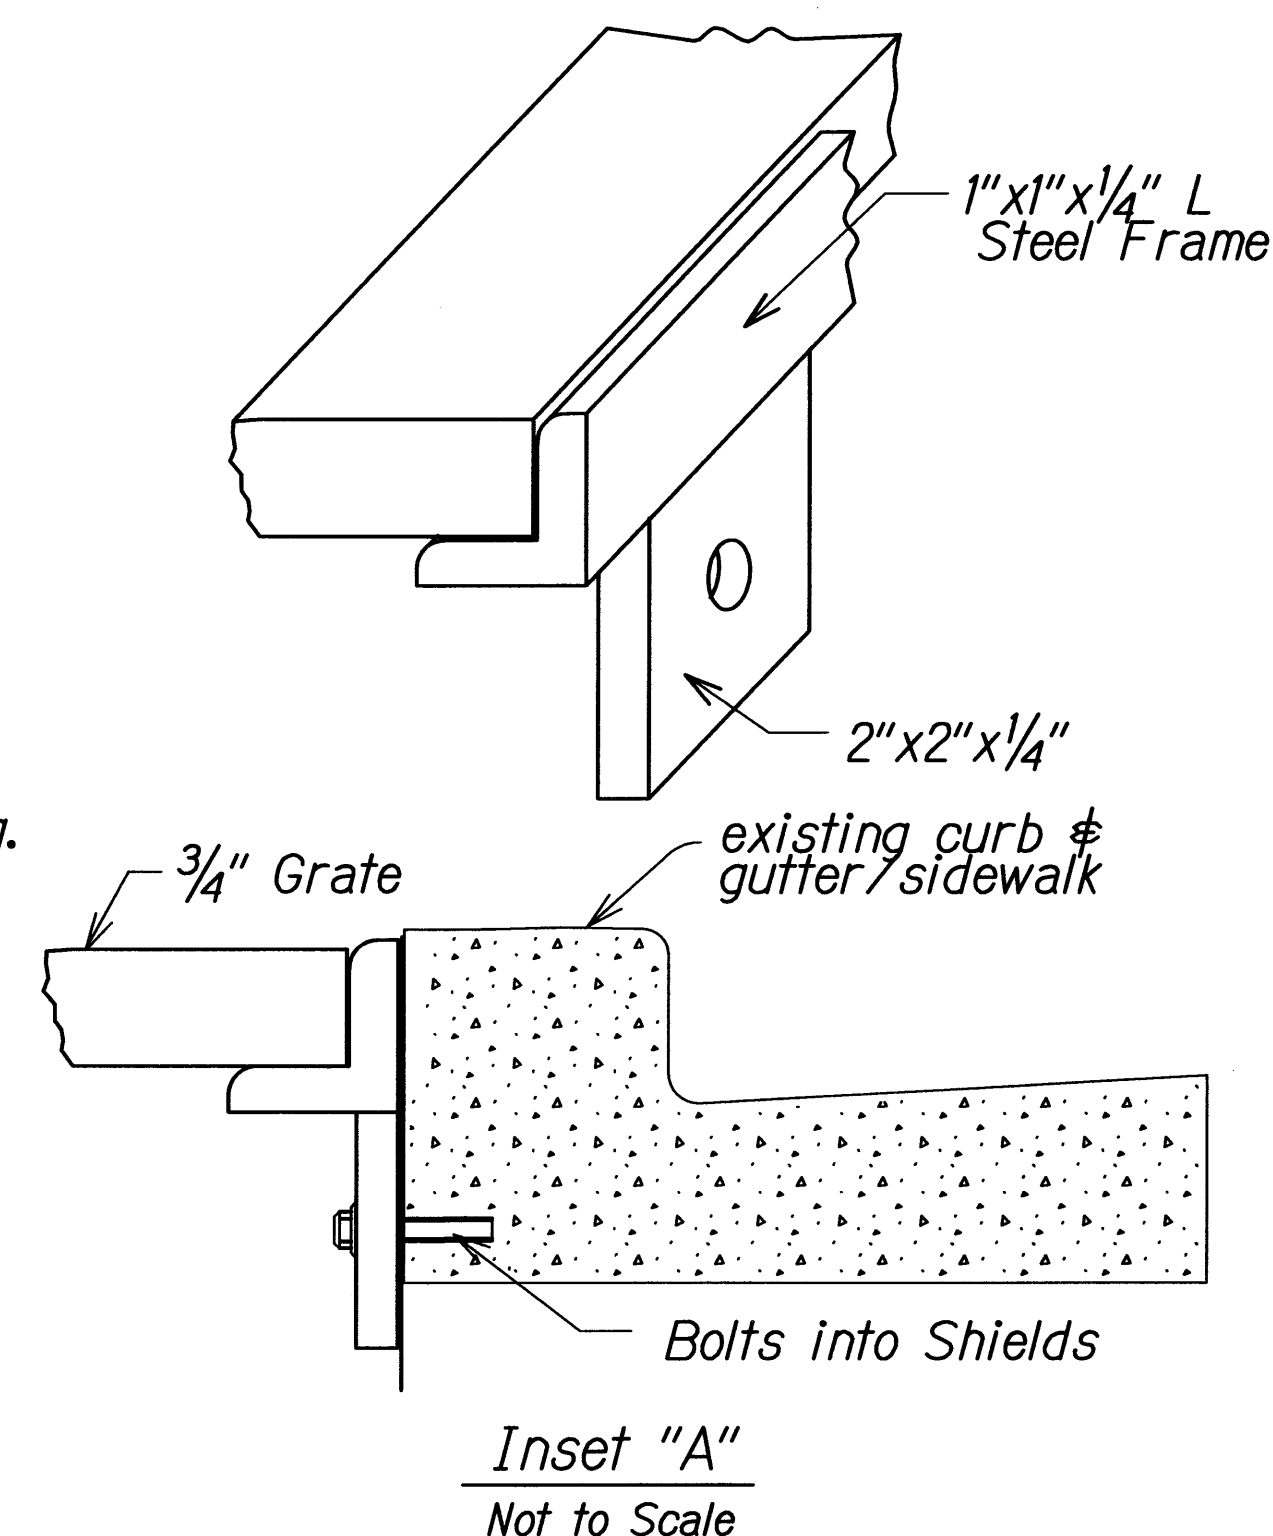


### STREET TREE PLANTING DETAIL

@ STA. 144+50 TO @ STA. 149+50

Not to Scale

Notes:

1. Nodules to face tree place top edge of bio-barrier at finish grade and secure with manufacturer provided pins. Seams shall have minimum 3" overlap. Refer to manufacturer instructions for bonding the seam. Do not allow gaps in fabric during installation or backfilling. Bio-barrier should not be left exposed to surface water or sunlight for more than 12 hours since high temperatures and sunlight reduce effective life of product. Refer to product label and MSDS sheet for safety information.

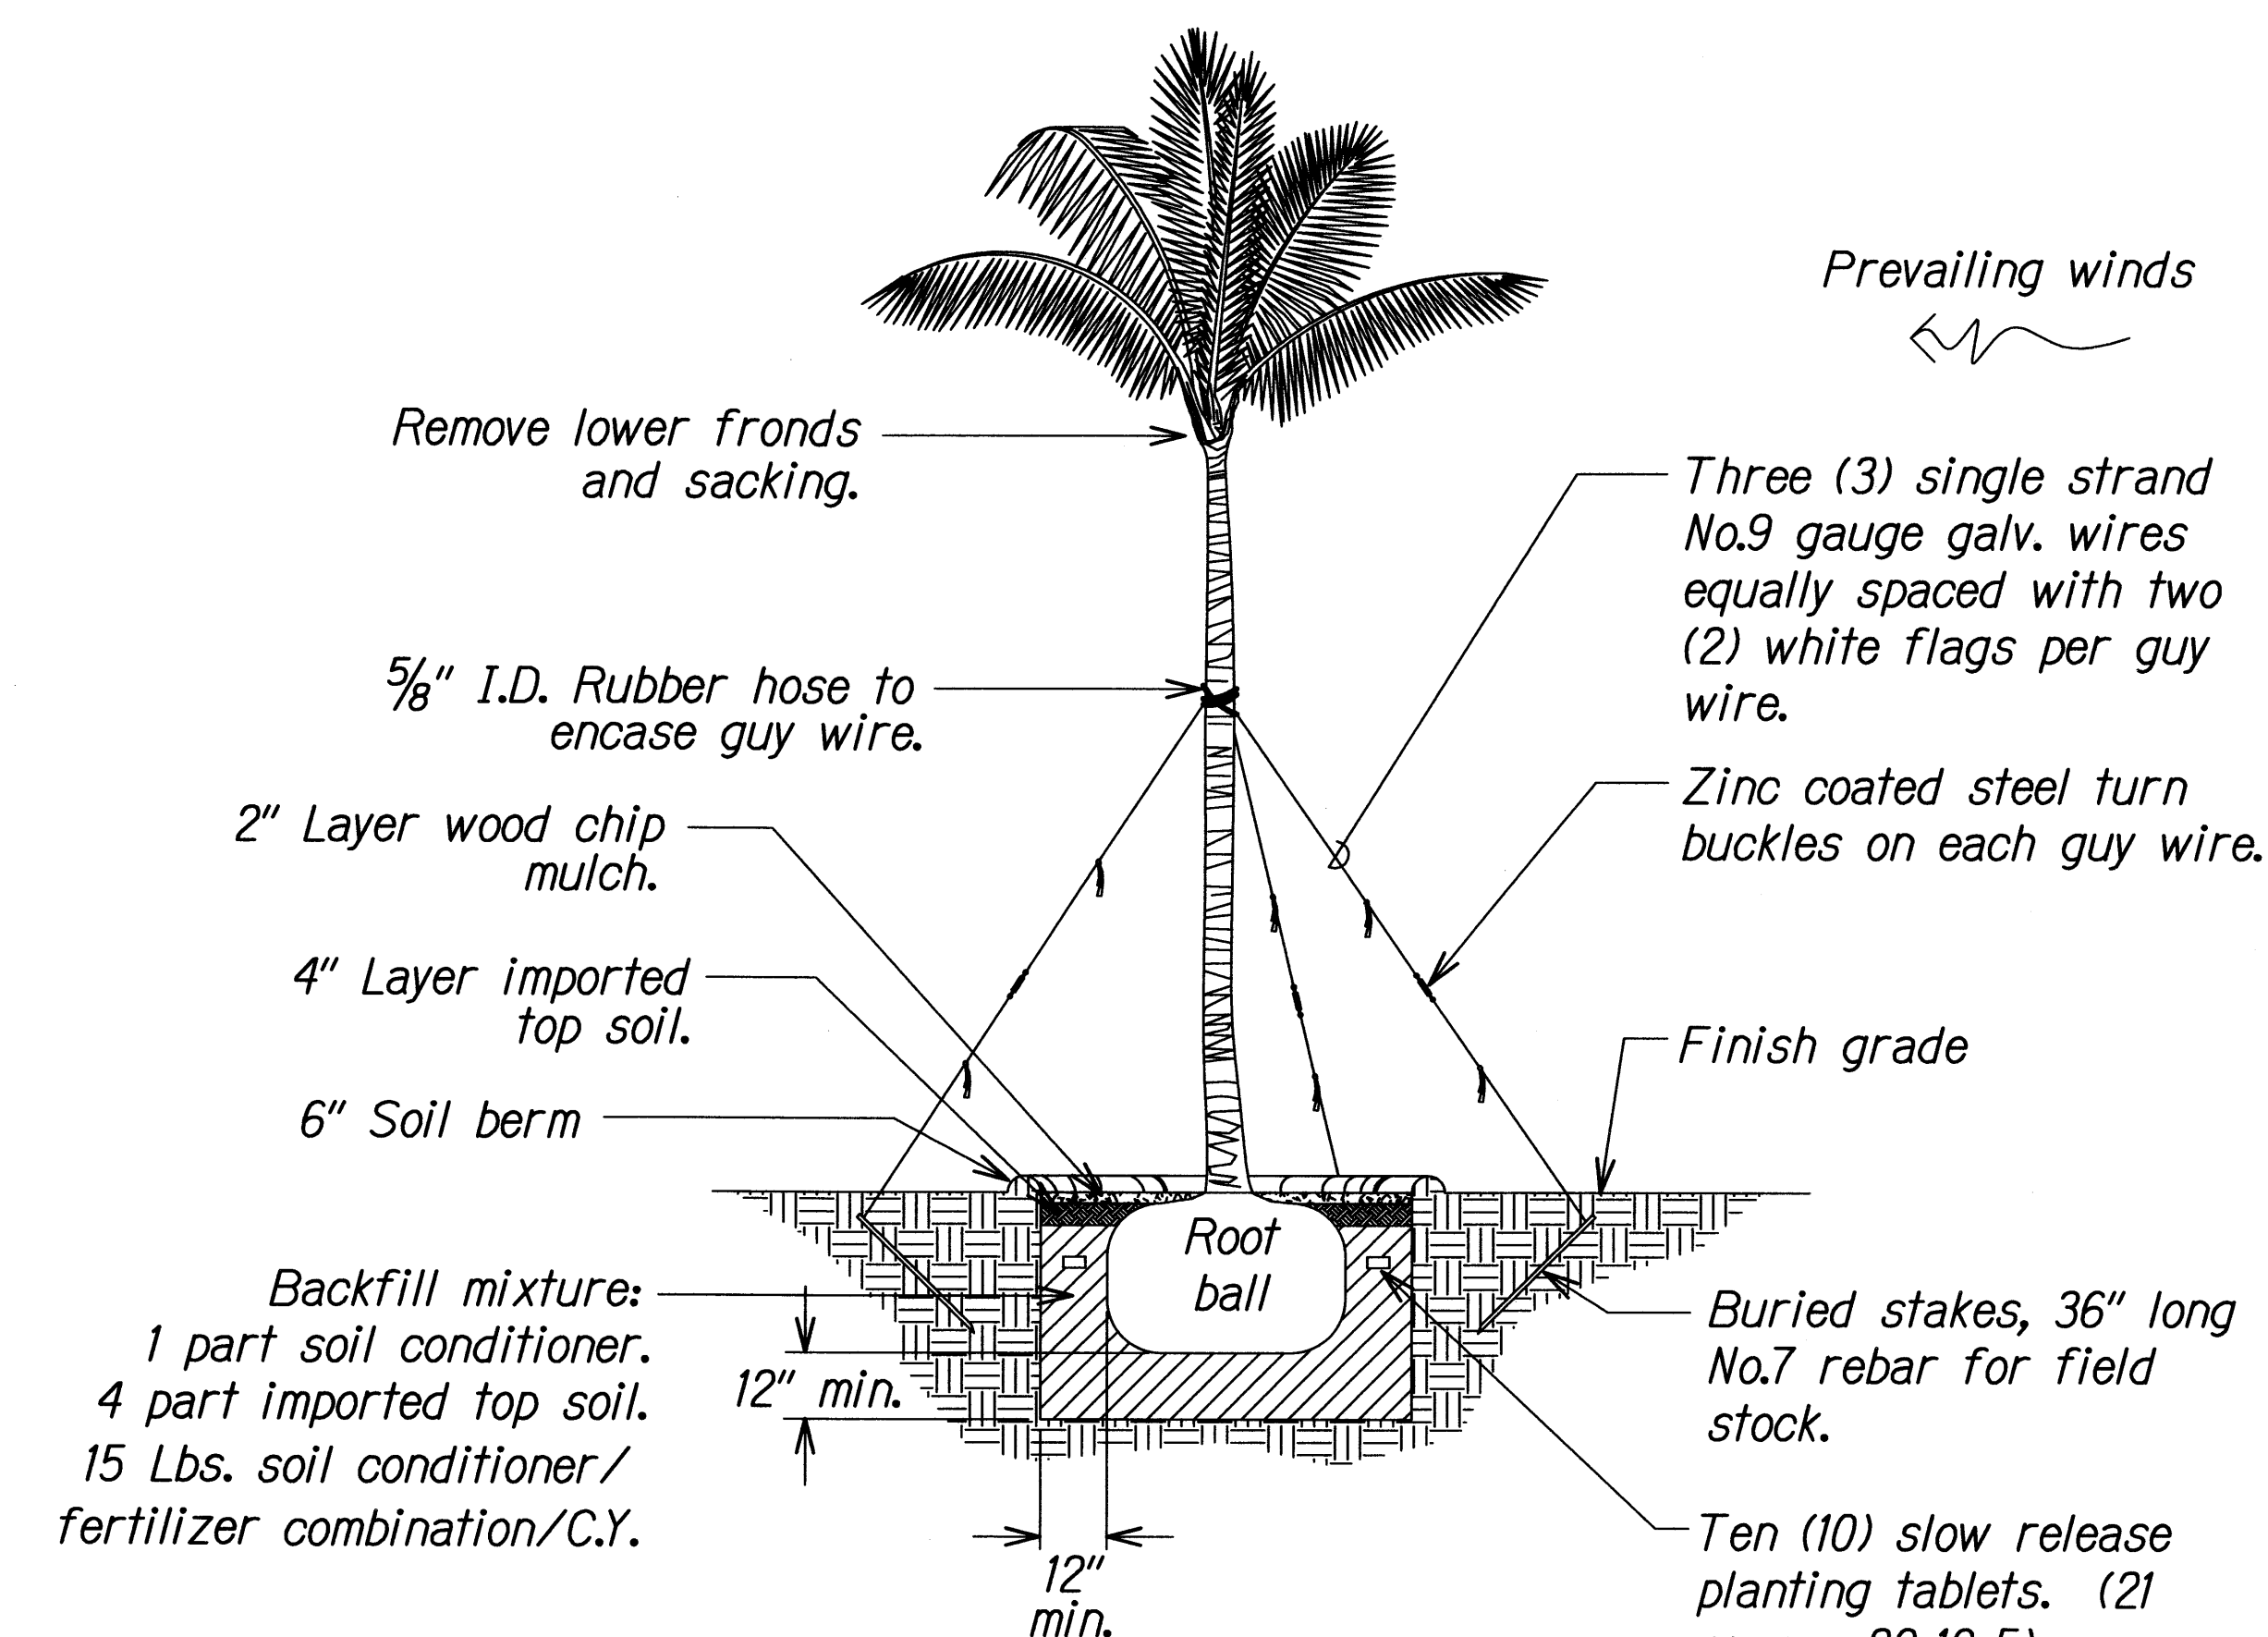

Notes:

1. Trunk must be protected from rope sling burns and abrasions during moving.
2. Water heavily to insure soil settles around roots.
3. Tree shall be plumb, if there is leaning at the end of the plant establishment period, the tree shall be rejected.
4. Protect heart and tip from damage and breakage during transporting and transplanting.

### PALM PLANTING DETAIL

Not to Scale

STATE OF HAWAII DEPARTMENT OF TRANSPORTATION HIGHWAYS DIVISION	
<b>LANDSCAPING DETAILS</b>	
<b>NIMITZ HIGHWAY AND ALA MOANA BOULEVARD RESURFACING AND HIGHWAY LIGHTING REPLACEMENT</b>	
<b>Fort Street to Kalakaua Avenue</b>	
<b>Federal Aid Project No. NH-092-K(27)</b>	
Scale: Not to Scale	Date: February, 2008
SHEET No. 3 OF 3 SHEETS	

FED. ROAD DIST. NO.	STATE	PROJ. NO.	FISCAL YEAR	SHEET NO.	TOTAL SHEETS
HAWAII	HAW.	NH-092-1(27)	2009	32	302

PLANT NOTES:

1. Landscape Contractor shall field verify all plant quantities and dimensions prior to installation. Quantities shown on plant list are for reference only, verify actual quantities as shown on plan. If there is a discrepancy, the planting plan shall take precedence. Plans shall govern.
2. Landscape contractor shall be responsible for locating and protecting existing utilities.
3. Prior to tree and shrub hole excavation, all planting locations shall be staked out by contractor for approval by Engineer. Do not plant until ground has been prepared and free of stones greater than 1/2" dia., site is neat, orderly, and the Engineer accepts site for planting.
4. Notify Engineer of any discrepancies in plant locations or insufficient plant quantities due to difference in plans and actual field conditions.
5. Notify Engineer 30 days prior to planting operations for approval of all plant material at place of growth. All plant material not approved by the Engineer will be subject to rejection.
6. The Engineer will inspect plants at the place of growth and after the delivery to the project. Each tree shall be tagged by the Engineer with a consecutively numbered plastic tamper-resistant and self-locking seal. Seals shall remain on trees and only be removed by the Engineer at the completion of the plant establishment period. Trees delivered to the project without Engineers seal will be rejected.
7. Plants shall meet size indicated by minimum height and spread. Plants shall be straight and uniformly shaped, unless unique or special sharakteristics are specified, and shall be undamaged, sound, healthy, vigorous and free of disease and insect infestation. Plants not conforming to these requirements on delivery to the project and at the end of the palnt establishment period will be rejected.
8. Contractor shall be solely responsible for the complete removal and damages resulting from planting any plant species listed on the Hawaii Department of Agriculture 'noxious weed rules' as defined in the statute, Hawaii Administrative rules 4-68:1 or the 'federal noxious weed list' as defined in Title 7 of the Code of Federal Regulations (CFR), parts 360 and 361.
9. All tree work must adhere to American National Standard Institute (or ANSI) - A300 tree care standards and ANSI-Z133 safety standards for tree work. Work shall be contracted to Arborists that have been certified in good standing as an ISA certified Arborist for at least 5 years to assure that tree work is performed properly and trees are not damaged by practices such as topping, flush cuts, over-thinning,or climbing with spikes. Contractor shall submit a copy of the ISA Arborist certification of good standing of 5 years to the Engineer minimum 7 days prior to tree pruning.

10. If trees other than those specifically designated for removal are damaged beyond survival conditions as determined by Engineer, the Contractor shall remove such trees and replace the tree with a same species and size and maintain for the duration of construction or 12 months whichever is greater at no cost to the State.
11. Guy wires, flagging, stakes, windbreakers, etc. shall be maintained and replaced if necessary by the Contractor until the tree or shrub is able to stand by itself. The Contractor shall remove and dispose at the end of plant establishment period.
12. Any planting that obstructs sight distance, signs or traffic lights shall be relocated or removed as determined by the Engineer.
13. Removal of existing trees shall be considered incidental to new plants.
14. The roots of the removed existing trees shall be a minimum of 12" below finish grade.
15. For the duration of construction within the drip line of trees to remain there must be: No changes, alterations or disturbance to the grade by adding fill, excavating or scraping except as noted on plans; No storage of construction material or equipment: No stockpiling of any construction material, or any excavated material. No disposal of any liquids (E.G. concrete sluice, gas, oil, paint); No vehicular traffic, equipment or excessive pedestrian traffic. No attachment of any wires, ropes, lights, or any other such attachment other than those of protective nature to any tree to be preserved; and No cleaning of equipment or material under the canopy of any tree or group of trees to remain.


16. Provide even four-inch layer of planting soil over all planting area. Representative samples of soil from project site shall be submitted to the University of Hawaii Agricultural Extention Service or laboratory acceptable to the engineer for analysis of required soil amendmets. Test results and fertilization schedule shall be presented to the engineer for review and acceptance before placing planting soil. Uniformly distrubute fertilizer and amendmets over planting areas as recommended by the soil analysis report. Rototill top four-inches of soil to evenly incorporate fertilizer and amendmets. After completion of soil amendmets, retest to meet soil analysis. Continue amended until test meets soil test recommendations. Provide copy of all soil test to engineer.

PLANT LIST			
QUANTITY	COMMON NAME	BOTANICAL NAME	SIZE & REMARKS
10	Coconut	Cocos Nucifera	12-14 ft brown trunk
7	Areca Palm	Chysalidocarpus lutescens	50 gal. Multistem, Minimum 6' ht. Plant 10' o.c.
	Saint Augustine grass	Stenotaphrum secundatum	4" plugs or well rooted springs
16	Rainbow Shower Tree	Cassia Fistula X C. Javanica	35 gal., 10-12' ht., 6'-8' spd, 7 ft clearance, tree grate
8	Rainbow Shower Tree	Cassia Fistula X C. Javanica	35 gal., 10-12' ht., 6'-8' spd, 7 ft clearance

STATE OF HAWAII  
DEPARTMENT OF TRANSPORTATION  
HIGHWAYS DIVISION  
**LANDSCAPING NOTES**  
NIMITZ HIGHWAY AND  
ALA MOANA BOULEVARD RESURFACING  
AND HIGHWAY LIGHTING REPLACEMENT  
Fort Street to Kalakaua Avenue  
Federal Aid Project No. NH-092-1(27)  
Scale: Not to Scale      Date: March, 2008  
SHEET No. 1 OF 1 SHEETS

ORIGINAL PLAN	SURVEY PLOTTED BY	DATE
	DRAWN BY	
	DESIGNED BY	
	QUANTITIES BY	
NOTE BOOK 6/20/08	CHECKED BY	



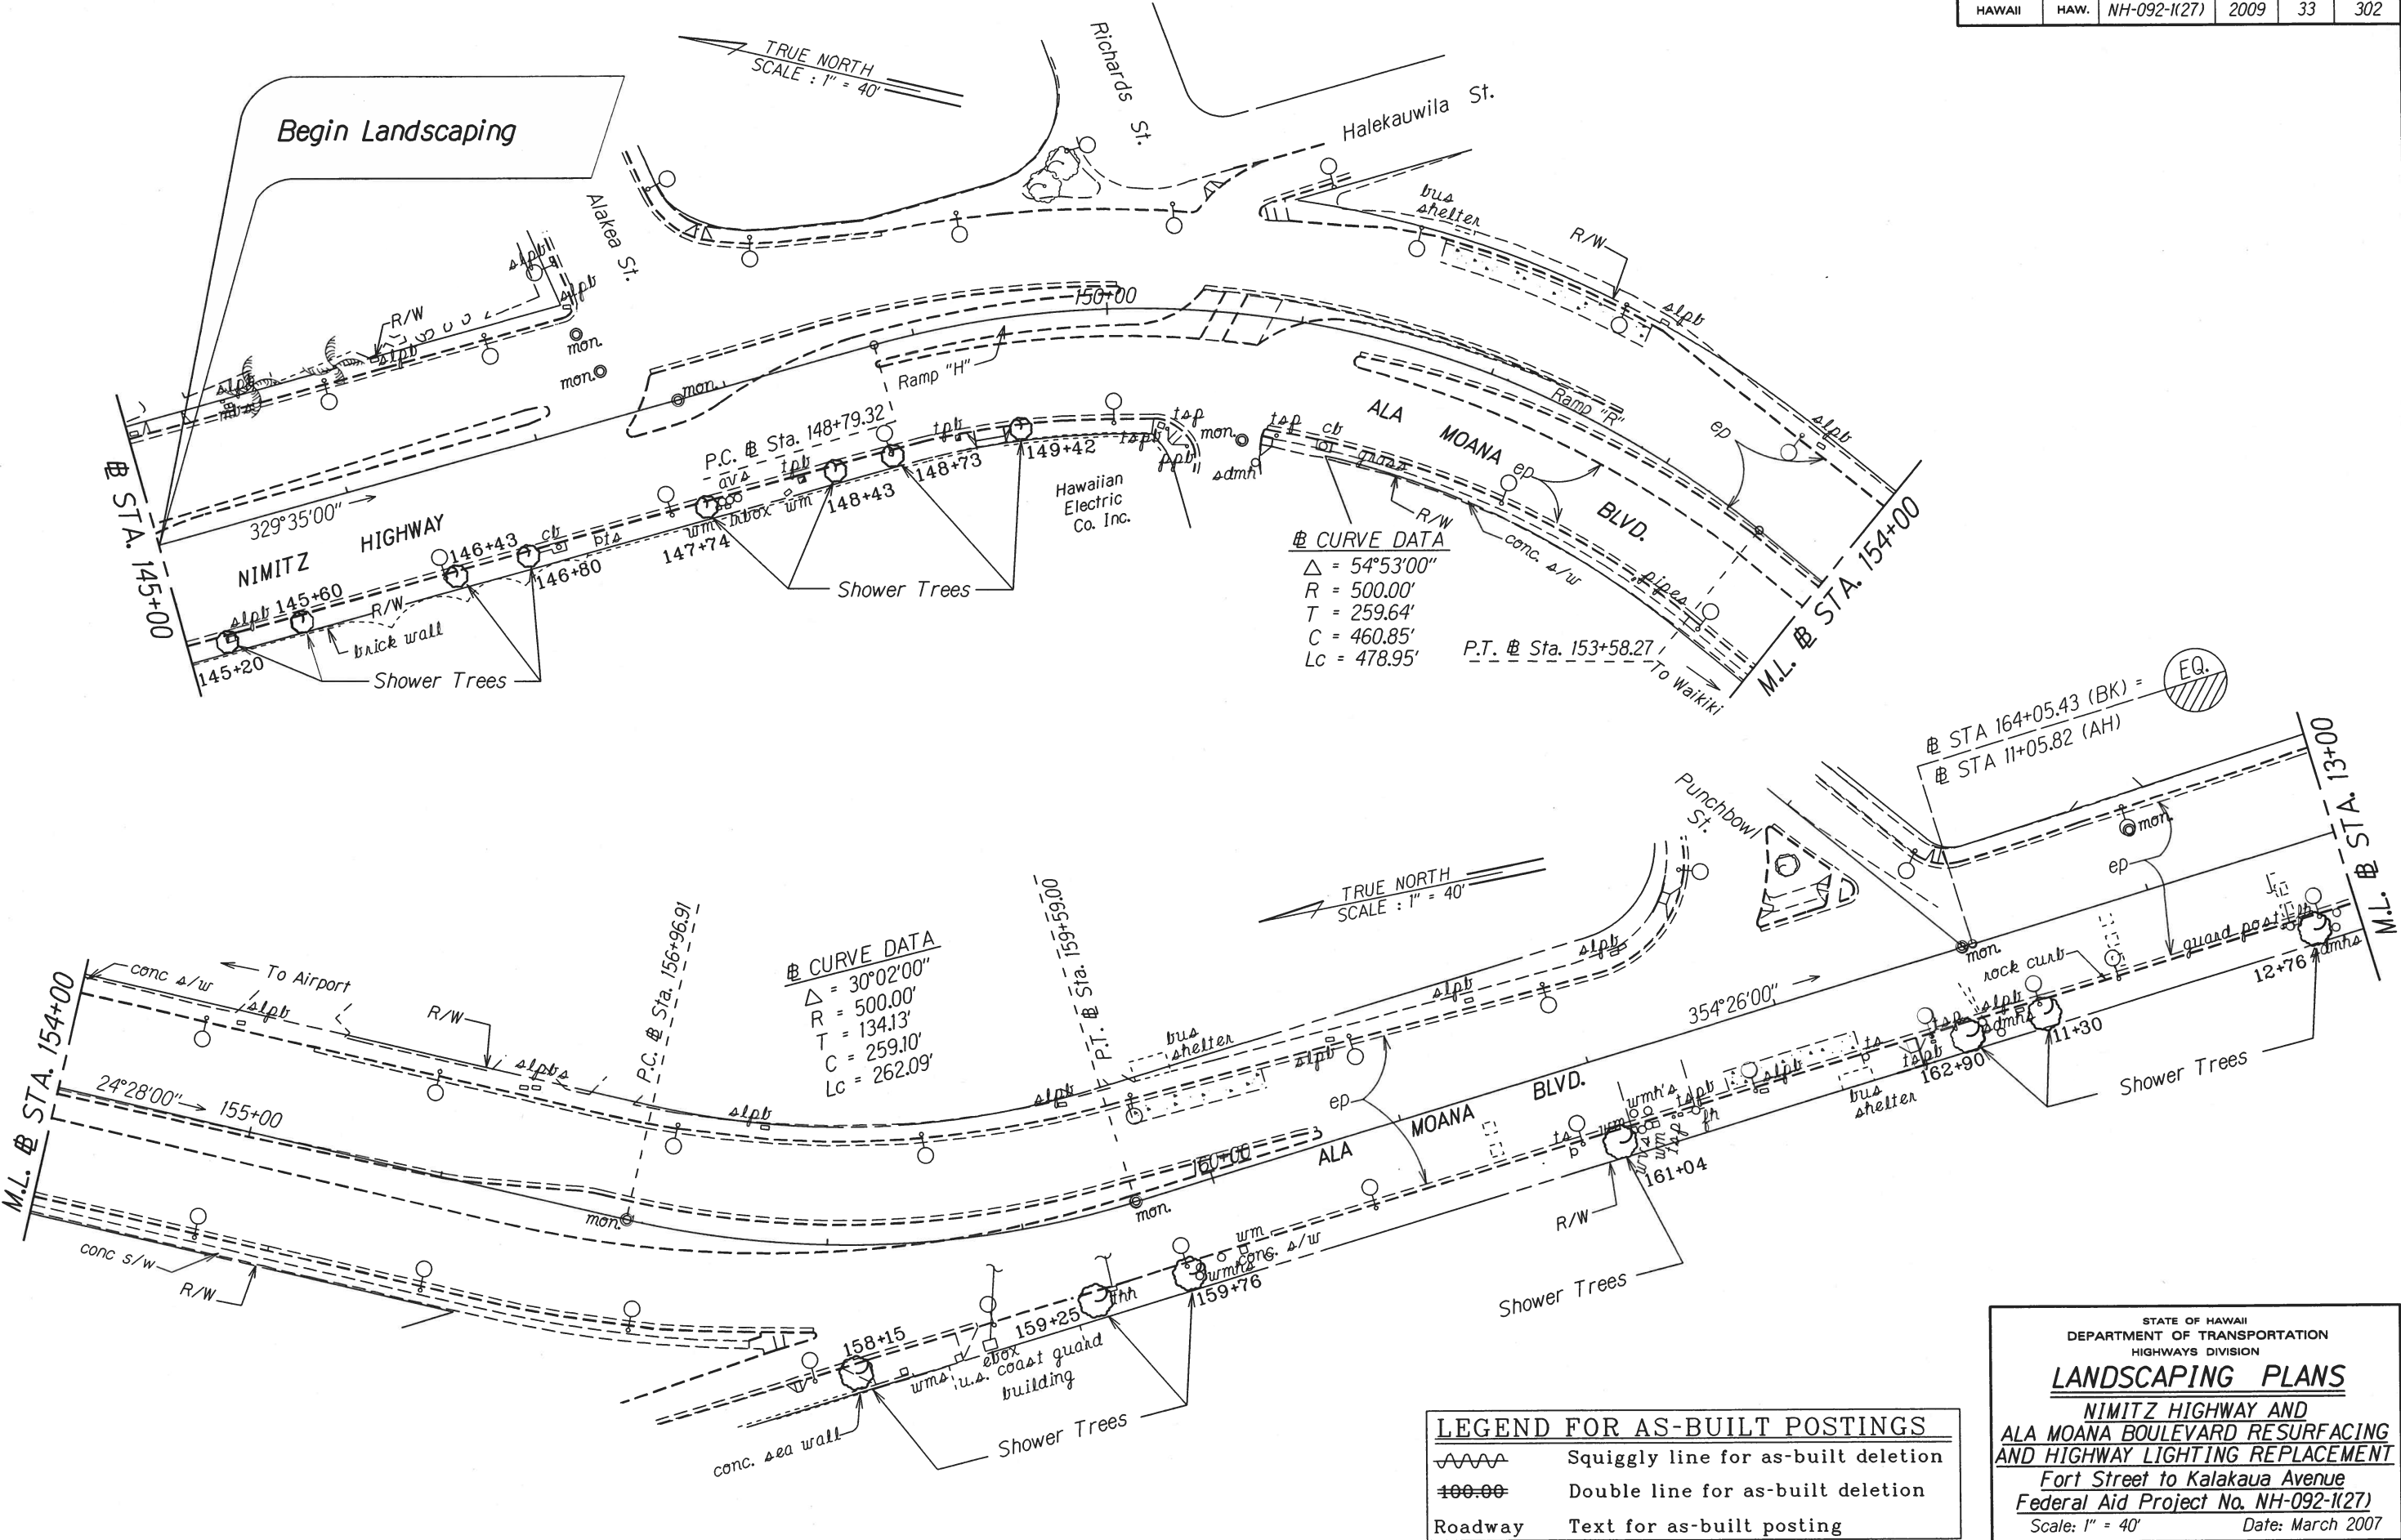

ORIGINAL PLAN	SURVEY PLOTTED BY	DATE
NOTE BOOK	DRAWN BY	
DESIGNED BY	CHECKED BY	
DATE		

LEGEND FOR AS-BUILT POSTINGS	
	Squiggly line for as-built deletion
	Double line for as-built deletion
Roadway	Text for as-built posting

STATE OF HAWAII  
DEPARTMENT OF TRANSPORTATION  
HIGHWAYS DIVISION



### LANDSCAPING PLANS

NIMITZ HIGHWAY AND  
ALA MOANA BOULEVARD RESURFACING  
AND HIGHWAY LIGHTING REPLACEMENT  
Fort Street to Kalakaua Avenue  
Federal Aid Project No. NH-092-K(27)

Scale: 1" = 40'      Date: March 2007


SHEET No. 1 OF 8 SHEETS

FED. ROAD DIST. NO.	STATE	PROJ. NO.	FISCAL YEAR	SHEET NO.	TOTAL SHEETS
HAWAII	HAW.	NH-092-K(27)	2009	34	302

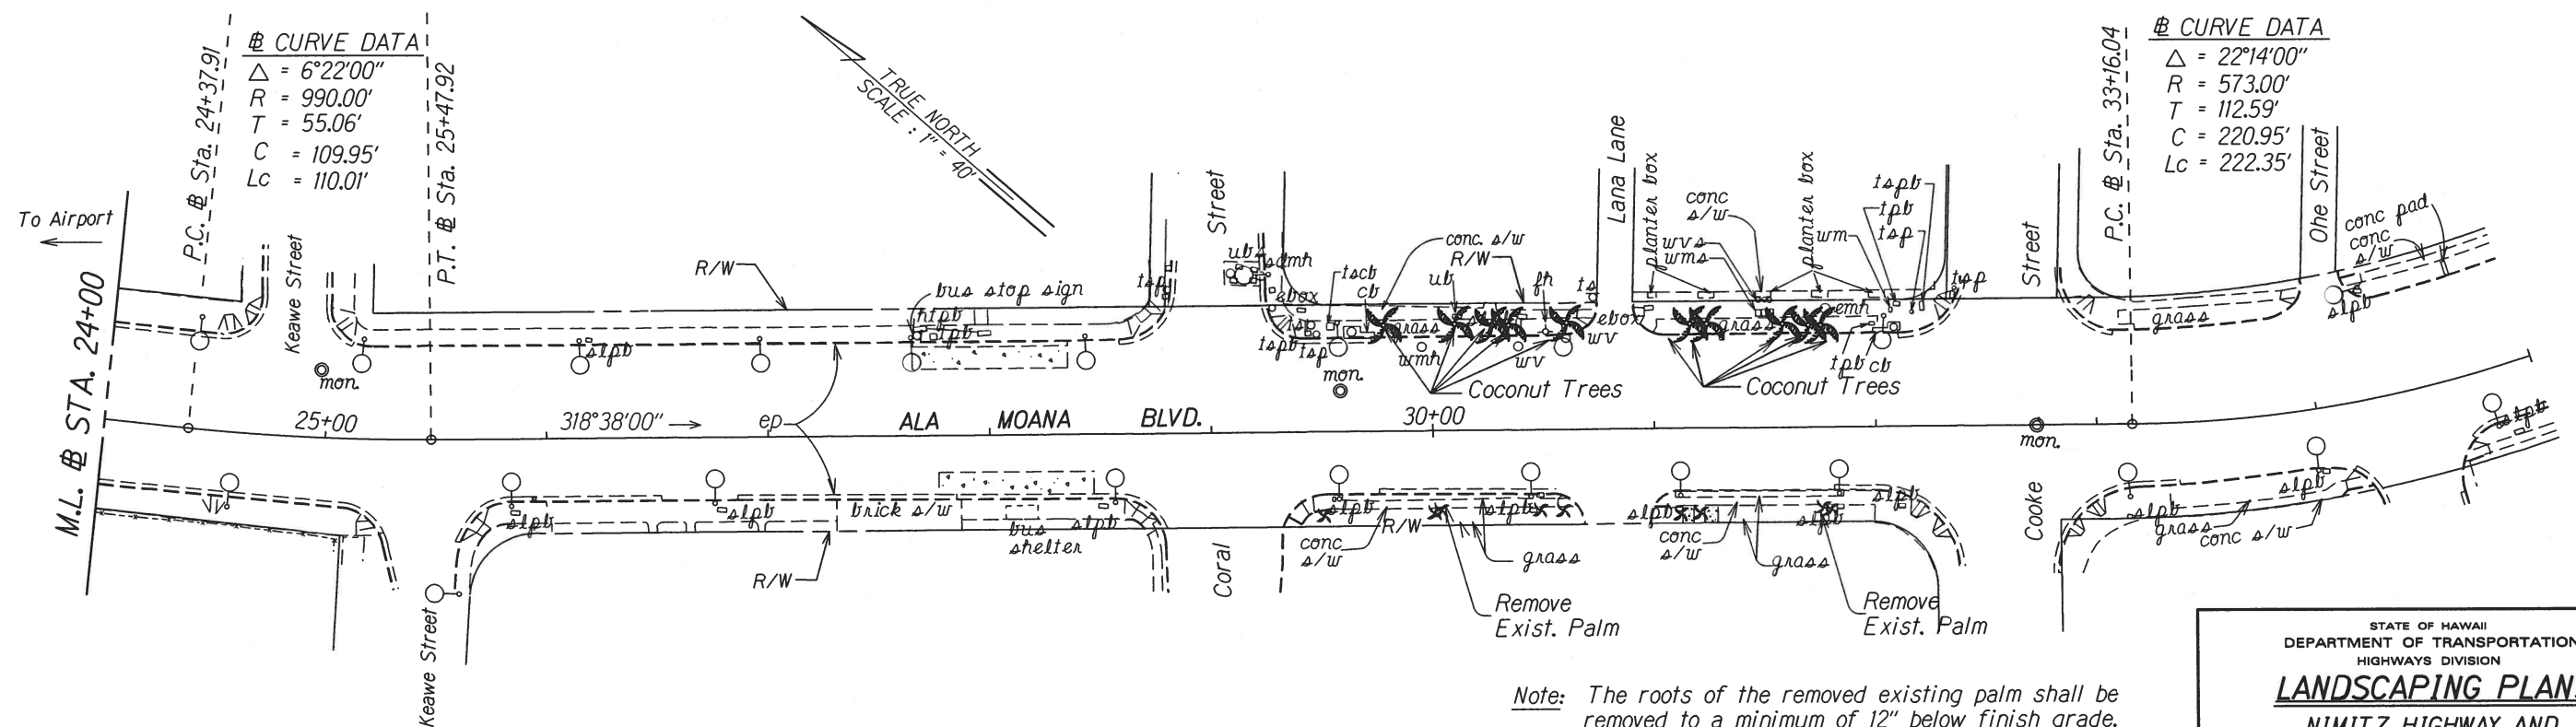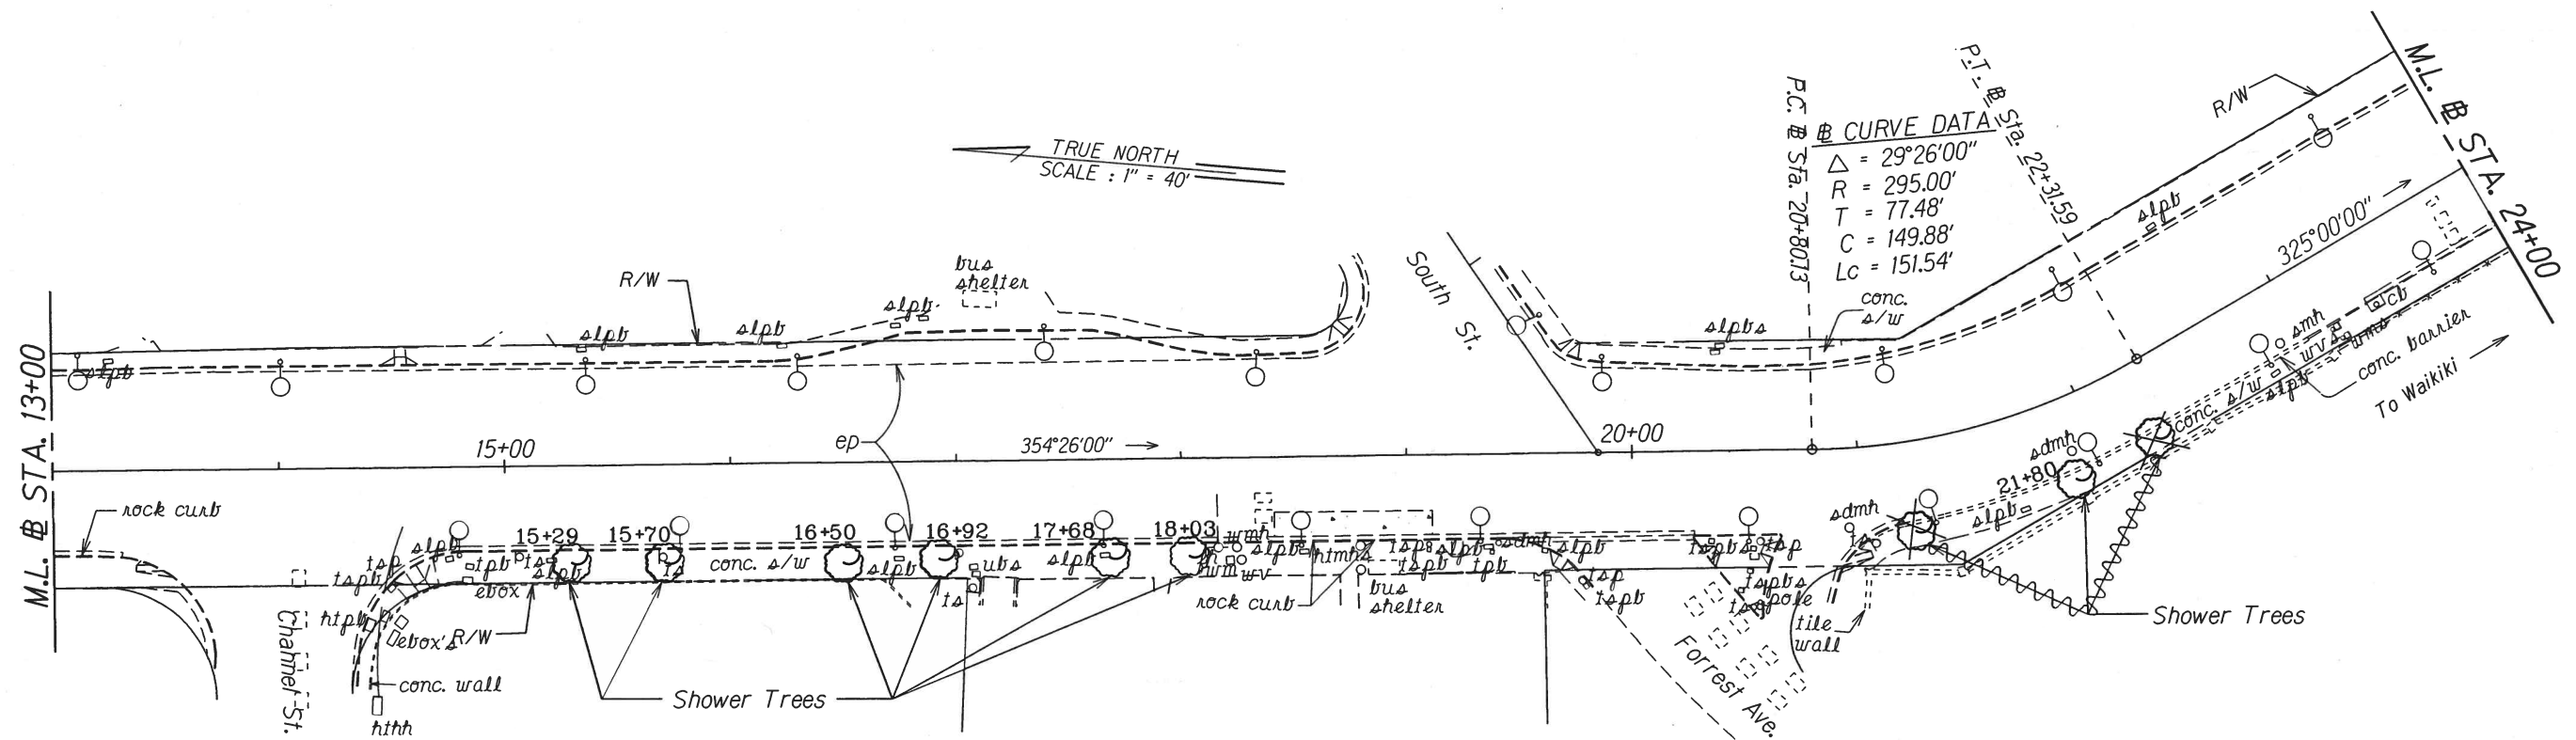

Note: The roots of the removed existing palm shall be removed to a minimum of 12" below finish grade.

### LEGEND FOR AS-BUILT POSTINGS

	Squiggly line for as-built deletion
<del>100.00</del>	Double line for as-built deletion
Roadway	Text for as-built posting

STATE OF HAWAII  
DEPARTMENT OF TRANSPORTATION  
HIGHWAYS DIVISION

**LANDSCAPING PLANS**


*NIMITZ HIGHWAY AND  
ALA MOANA BOULEVARD RESURFACING  
AND HIGHWAY LIGHTING REPLACEMENT*

*Fort Street to Kalakaua Avenue  
Federal Aid Project No. NH-092-1(27)*

*Scale: 1" = 40'                      Date: March 2007*

ORIGINAL PLAN	SURVEY PLOTTED BY _____ DATE _____
NOTE BOOK	DRAWN BY _____
dd6	TRACED BY _____
6ambd5p02	DESIGNED BY _____
6ambd5p02	QUANTITIES BY _____
	CHECKED BY _____

FED. ROAD DIST. NO.	STATE	PROJ. NO.	FISCAL YEAR	SHEET NO.	TOTAL SHEETS
HAWAII	HAW.	NH-092-1(27)	2009	35	302

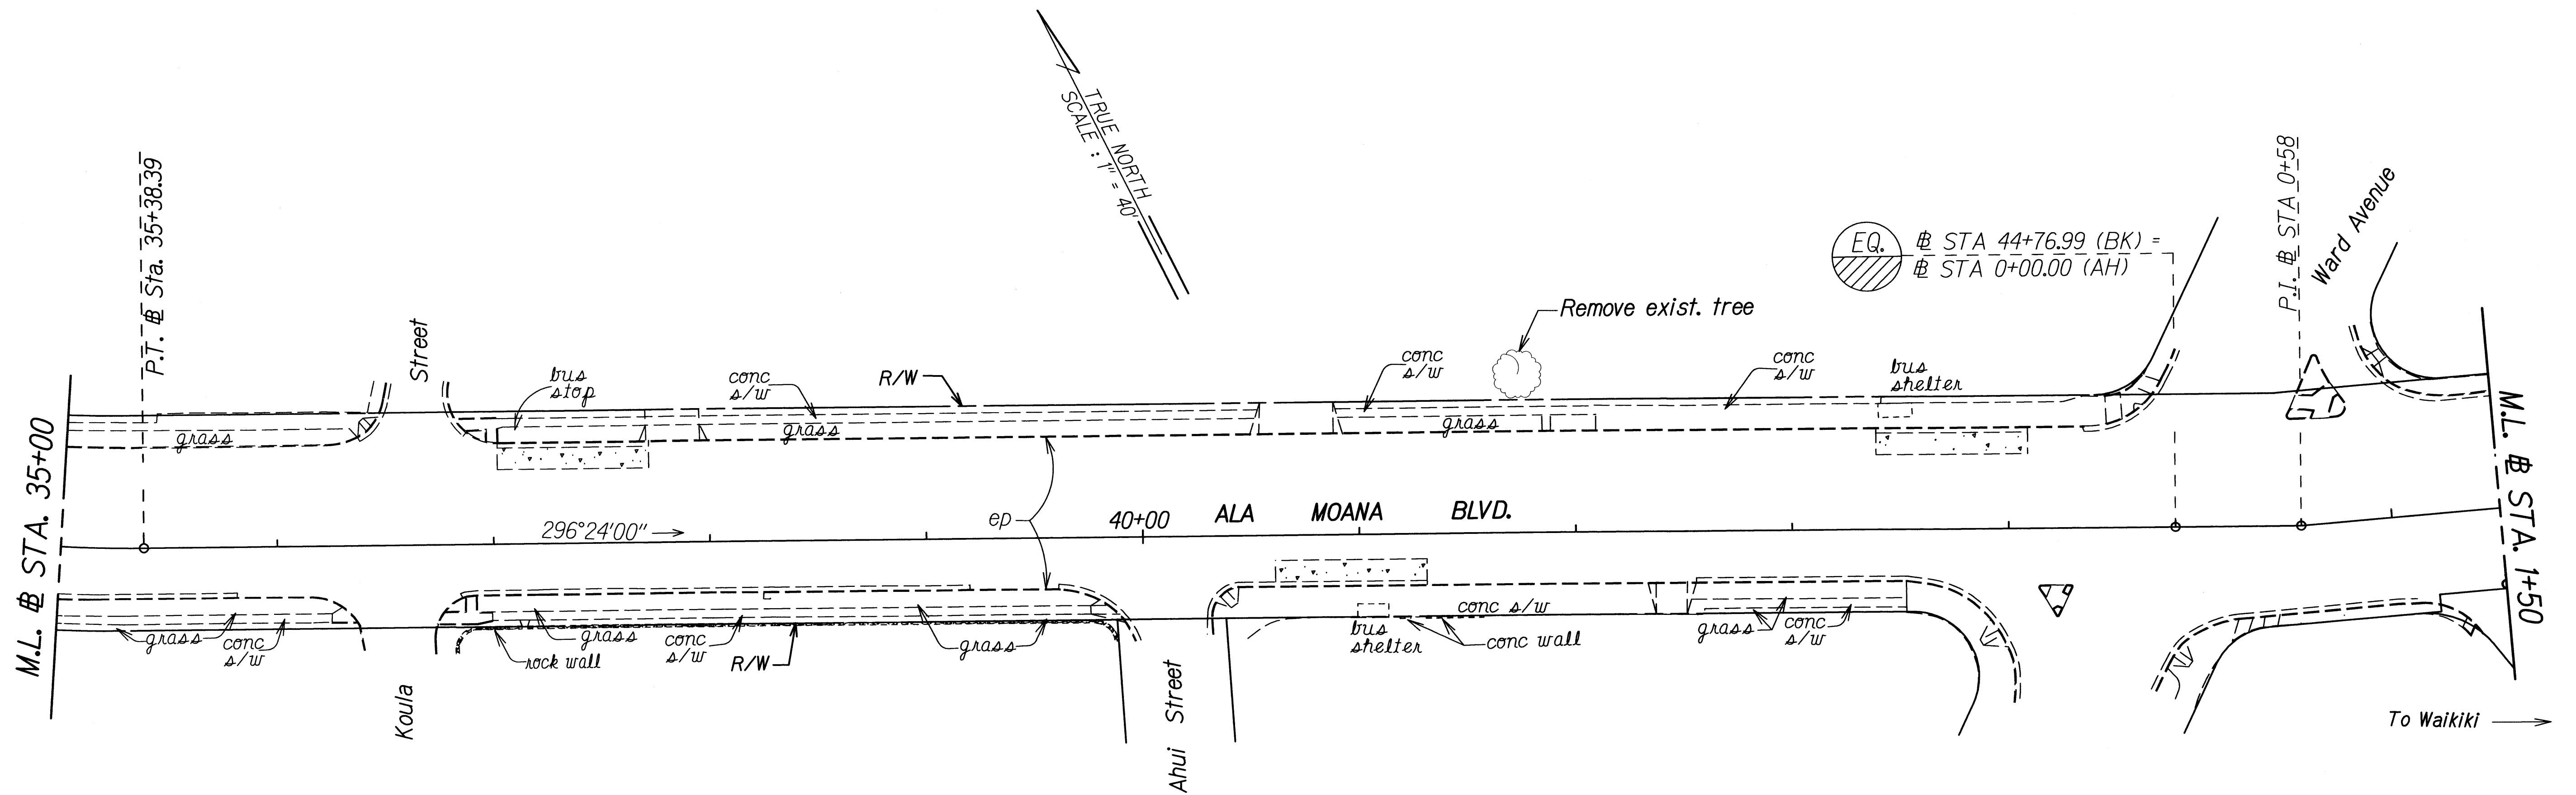

ORIGINAL PLAN	SURVEY PLOTTED BY	DATE
NOTE BOOK	DRAWN BY	
DESIGNED BY	DESIGNED BY	
QUANTITIES BY	QUANTITIES BY	
CHECKED BY	CHECKED BY	

STATE OF HAWAII  
DEPARTMENT OF TRANSPORTATION  
HIGHWAYS DIVISION

**LANDSCAPING PLANS**

**NIMITZ HIGHWAY AND  
ALA MOANA BOULEVARD RESURFACING  
AND HIGHWAY LIGHTING REPLACEMENT**


**Fort Street to Kalakaua Avenue**

**Federal Aid Project No. NH-092-1(27)**

Scale: 1" = 40' Date: March 2007

SHEET No. 3 OF 8 SHEETS

FED. ROAD DIST. NO.	STATE	PROJ. NO.	FISCAL YEAR	SHEET NO.	TOTAL SHEETS
HAWAII	HAW.	NH-092-1(27)	2009	36	302

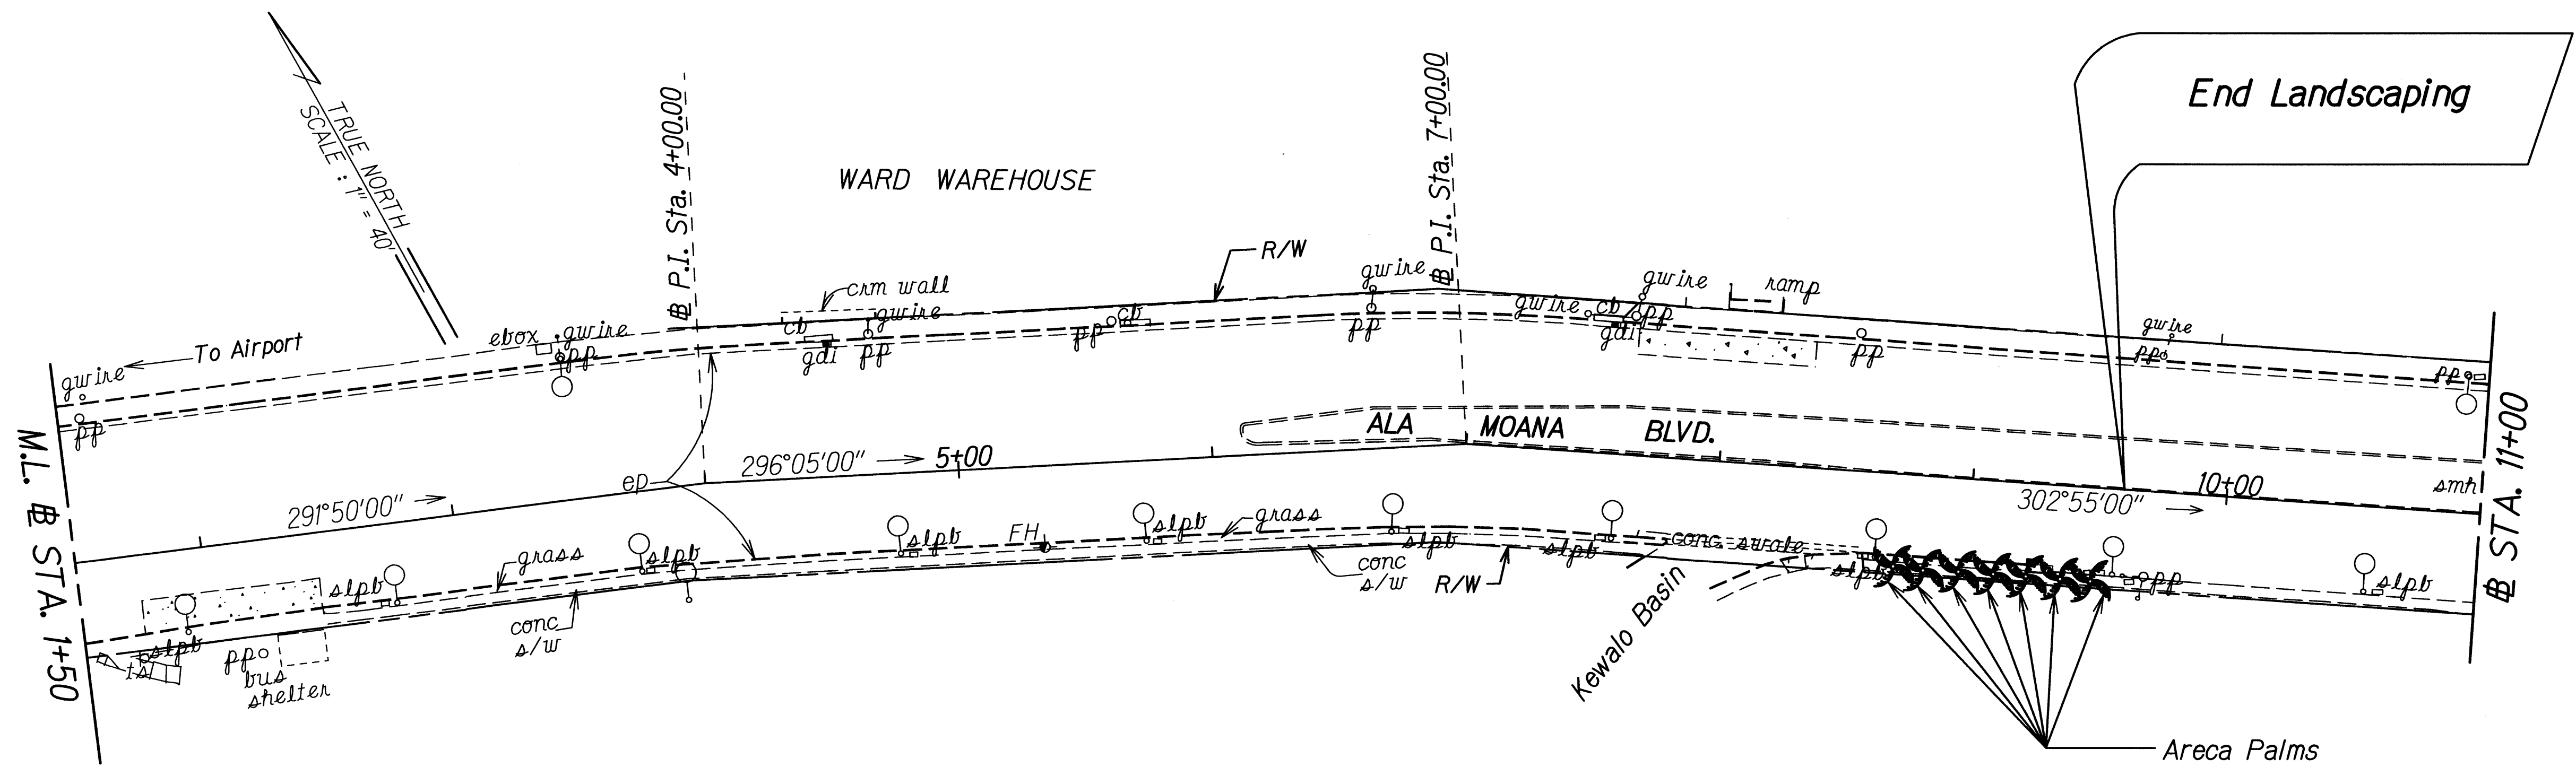

Notes

1. Replace all disturbed areas with Saint Augustine grass.
2. Adjust existing irrigation system to accomodate new utilities and planting. Replace broken components to match existing.
3. Water as necessary.
4. Remove 5 existing Areca palms.

ORIGINAL PLAN	SURVEY PLOTTED BY	DATE
NOTE BOOK	DRAWN BY	
5/5/00/04	DESIGNED BY	
	QUANTITIES BY	
	CHECKED BY	

STATE OF HAWAII  
DEPARTMENT OF TRANSPORTATION  
HIGHWAYS DIVISION

**LANDSCAPING PLANS**

**NIMITZ HIGHWAY AND  
ALA MOANA BOULEVARD RESURFACING  
AND HIGHWAY LIGHTING REPLACEMENT  
Fort Street to Kalakaua Avenue  
Federal Aid Project No. NH-092-1(27)**


Scale: 1" = 40' Date: March 2008

SHEET No. 4 OF 8 SHEETS



U-29 Schedule of Plants				
	Common Name	Botanical Name	Size	Remarks
11	Red Spider Lily	Crinum asiaticum var. procerum 'red form'	25 gallon	
50	Pohinahina	Vitex rotundifolia	1 gallon	Plant 24" o.c.
	Saint Augustine Grass	Stenotaphrum secundatum	4" plugs or well rooted sprigs	Plant 12" o.c.
U-29 Notes				
1	Replace all disturbed areas with Saint Augustine grass.			
2	New removable and stationary post barrier to match existing pipe barrier height (37"), pipe size (4½" o.d.) and color (teal green). Post barrier top shall be rounded dome top. Paint utility boxes to match existing utility boxes.			
3	Adjust existing irrigation system to accomodate new utilities and planting. Replace broken components to match existing.			
4	Water as necessary.			

FED. ROAD DIST. NO.	STATE	PROJ. NO.	FISCAL YEAR	SHEET NO.	TOTAL SHEETS
HAWAII	HAW.	NH-092-1(27)	2009	37	302

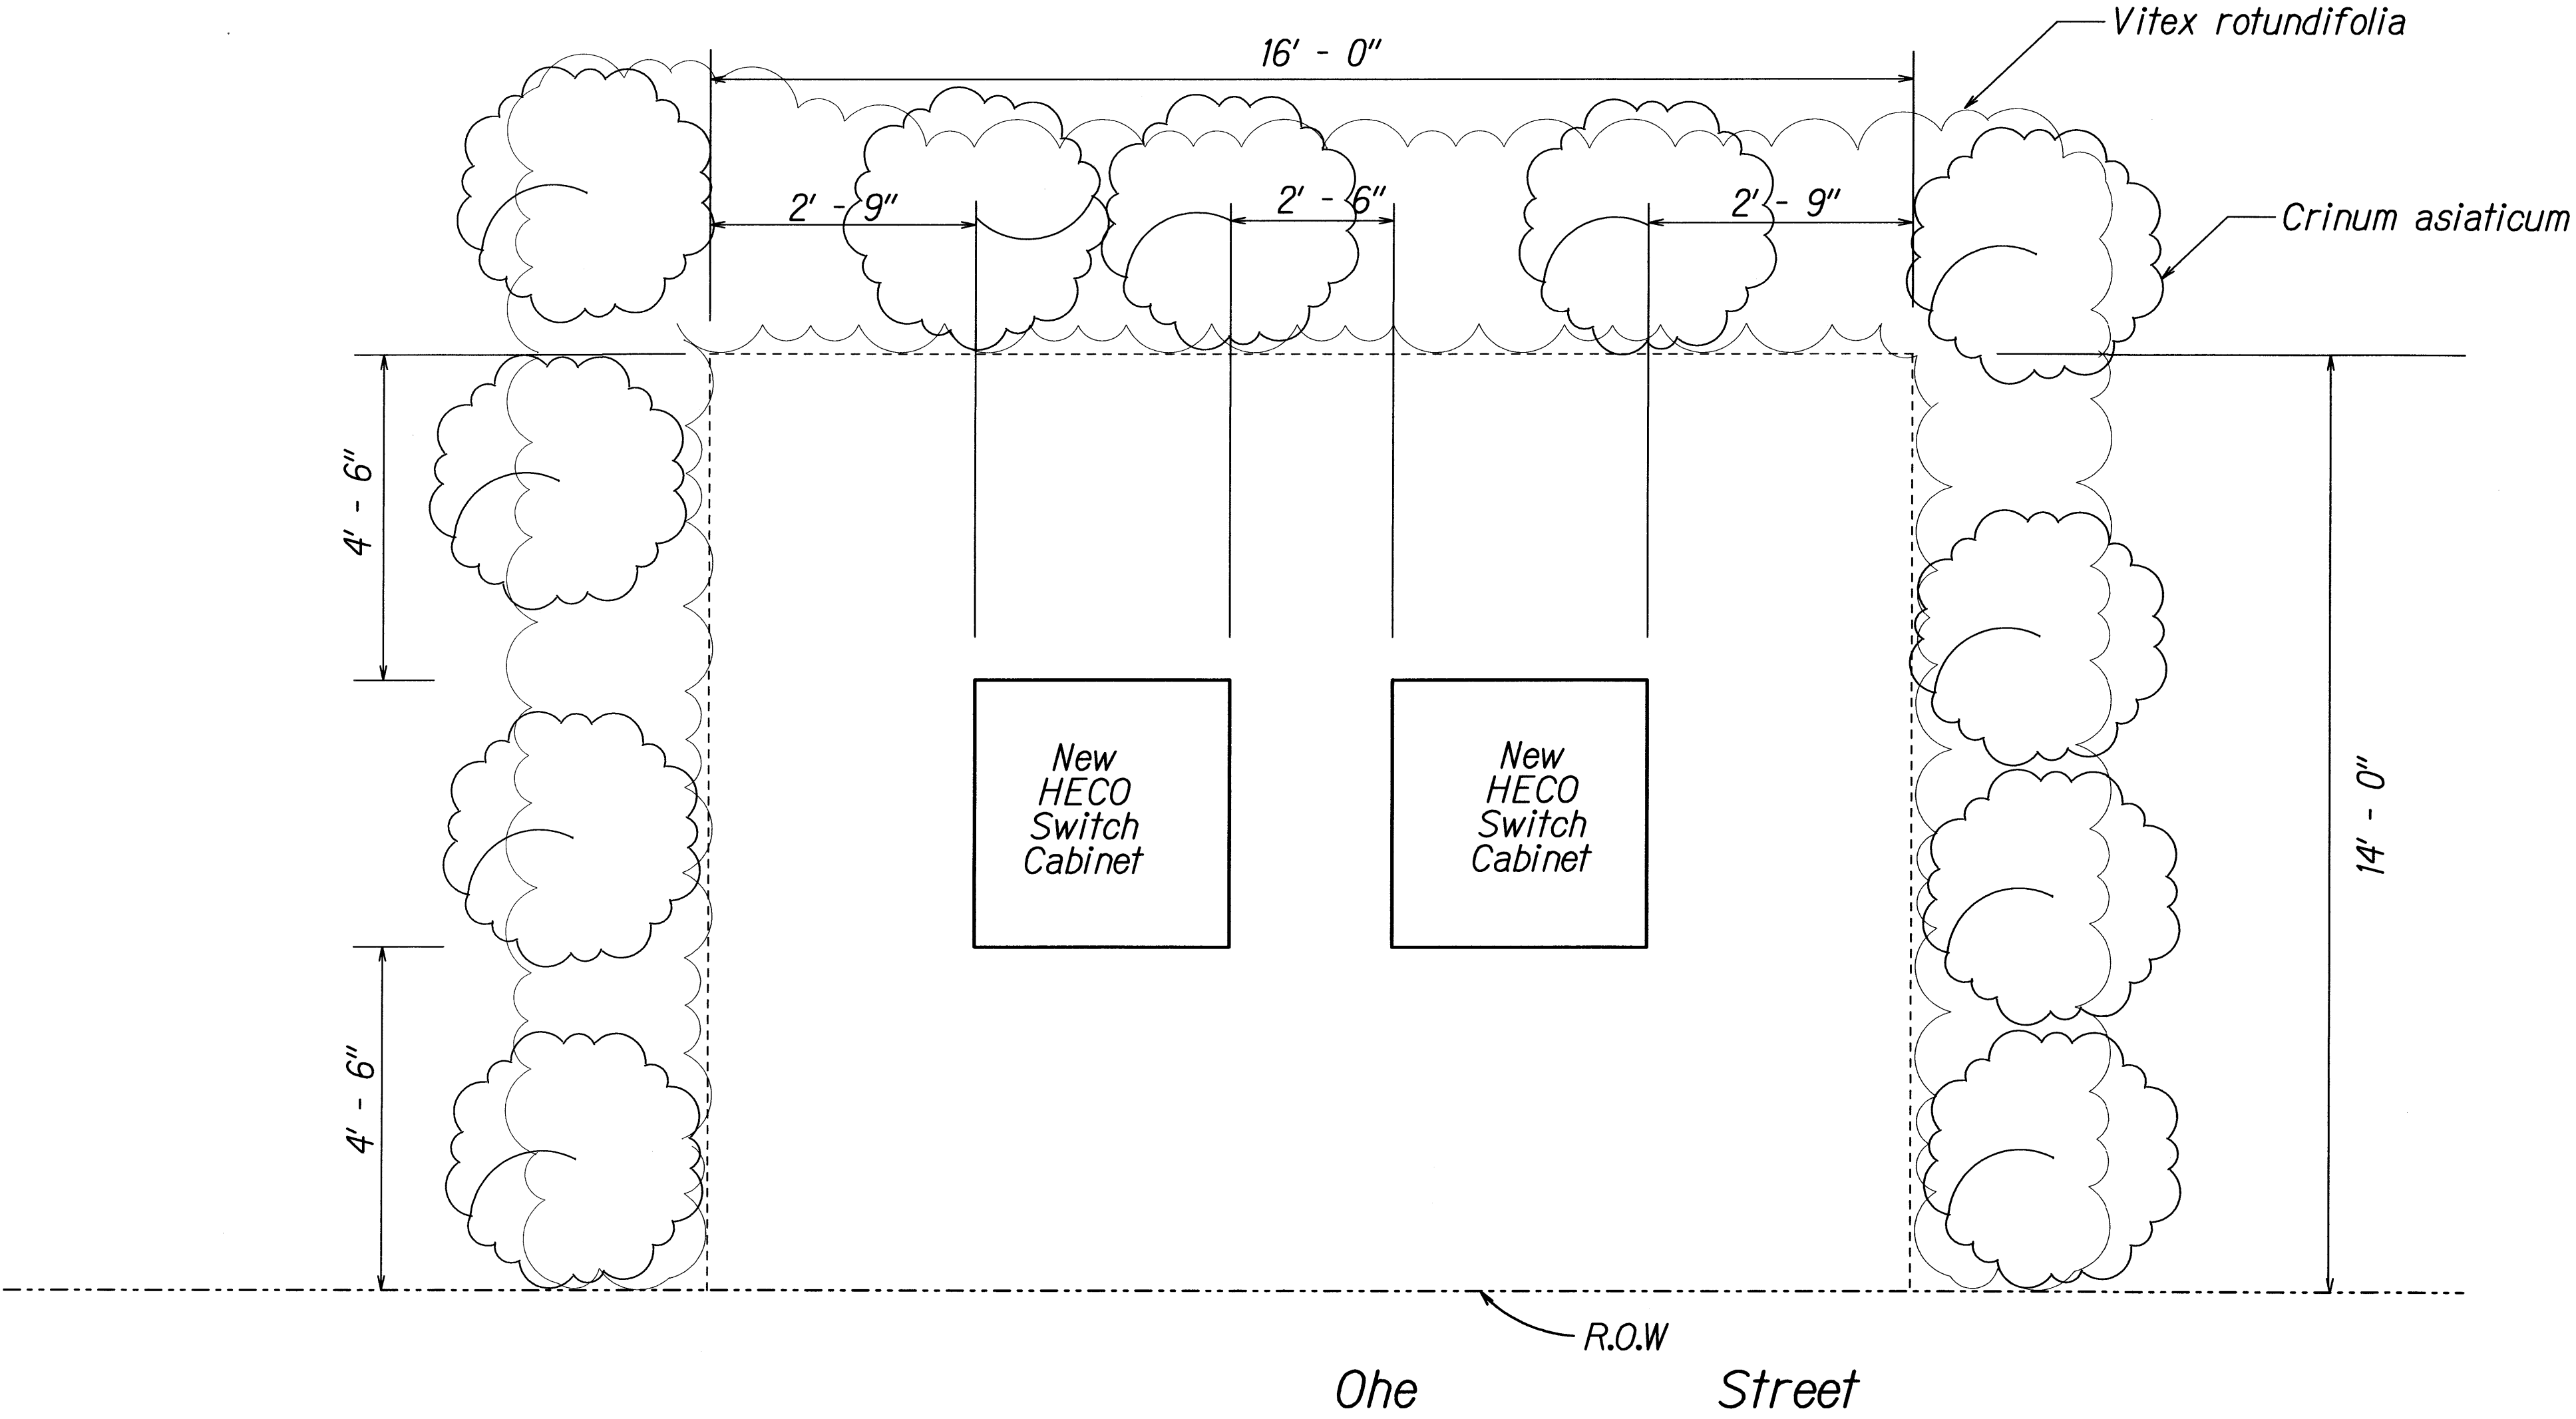

LANDSCAPING PLAN FOR HECO SWITCHES

STATE OF HAWAII  
DEPARTMENT OF TRANSPORTATION  
HIGHWAYS DIVISION  
**LANDSCAPING PLANS**  
NIMITZ HIGHWAY AND  
ALA MOANA BOULEVARD RESURFACING  
AND HIGHWAY LIGHTING REPLACEMENT  
Fort Street to Kalakaua Avenue  
Federal Aid Project No. NH-092-1(27)  
Scale: Not to Scale      Date: November 2008  
SHEET No. 5 OF 8 SHEETS

SURVEY PLOTTED BY	DATE
DRAWN BY	
DESIGNED BY	
QUANTITIES BY	
CHECKED BY	
ORIGINAL PLAN	
NOTE BOOK	
6cmhdspp04.dgn	
No.	


U-14 Schedule of Plants

	Common Name	Botanical Name	Size	Remarks
69	Beach Naupaka	Scaevola Sericea	1 gallon	Minimum 24" ht. Plant 24" o.c.
	Saint Augustine grass	Stenotaphrum secundatum	4" plugs or well rooted sprigs	Plant 12" o.c.

U-14 Notes

1	Replace all disturbed areas with Saint Augustine grass.
2	Adjust existing irrigation system to accomodate new utilities and planting. Replace broken components to match existing.
3	Water as necessary.



FED. ROAD DIST. NO.	STATE	PROJ. NO.	FISCAL YEAR	SHEET NO.	TOTAL SHEETS
HAWAII	HAW.	NH-092-1(27)	2009	38	302

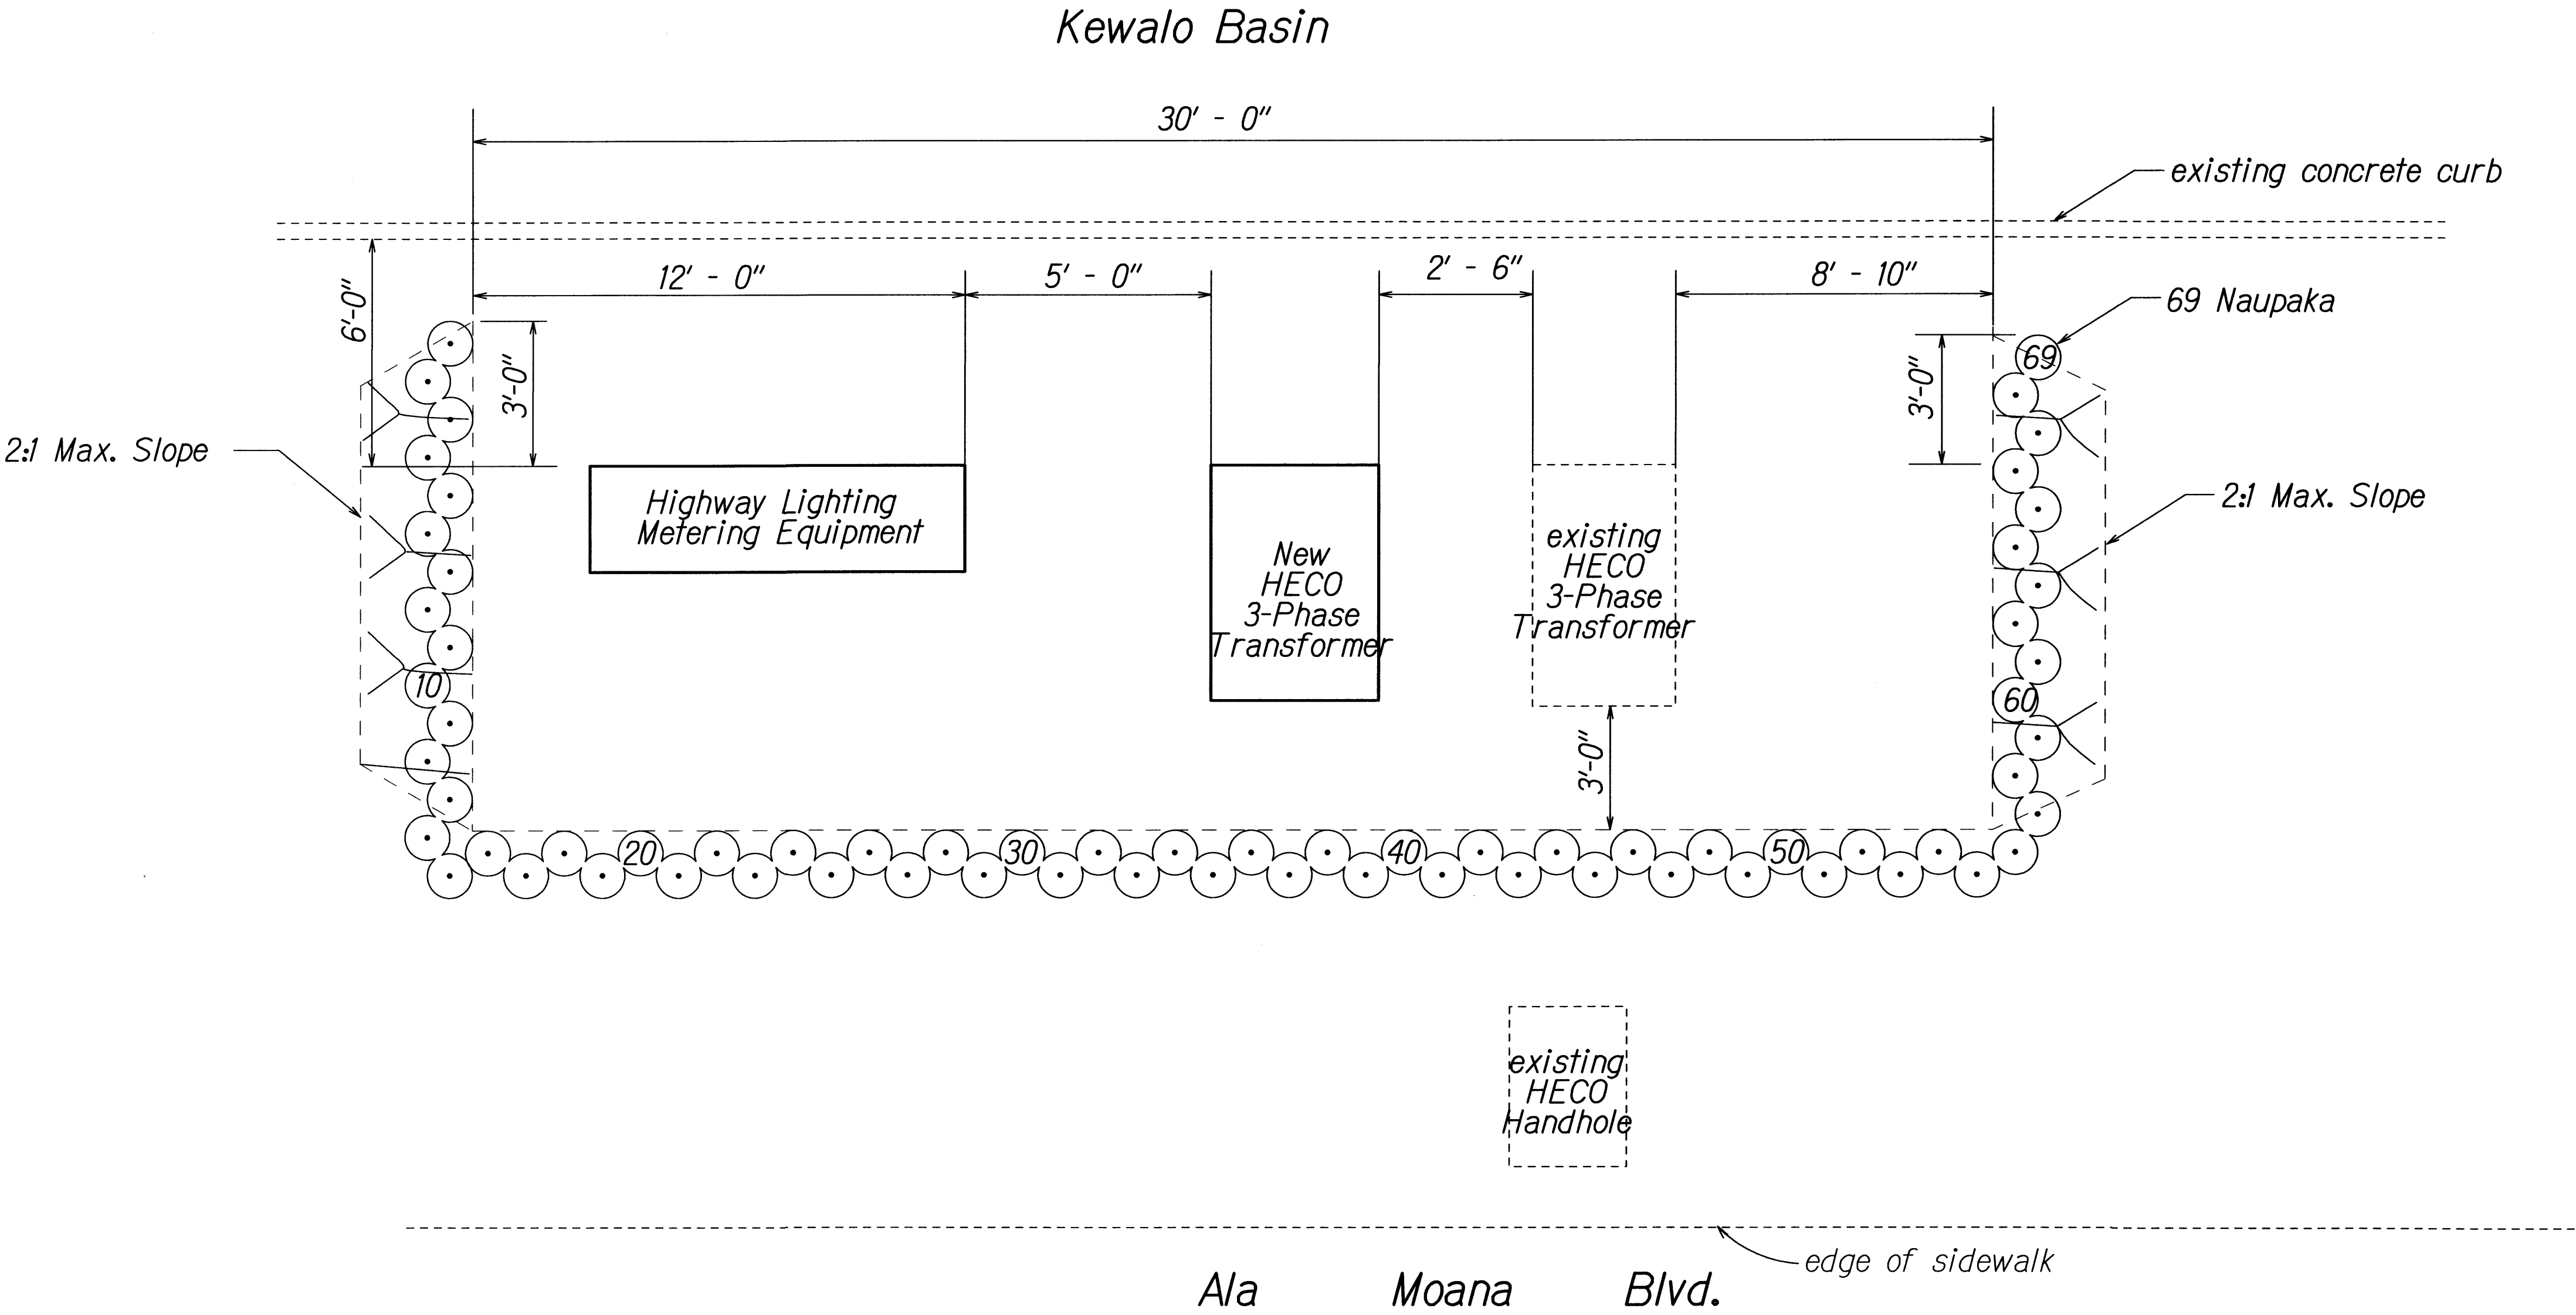

**LANDSCAPING PLAN FOR HECO EQUIPMENTS**  
**I.B. # Sta. 5+33± to I.B. # Sta. 5+70±, o/s 37' ± Rt.**

STATE OF HAWAII  
DEPARTMENT OF TRANSPORTATION  
HIGHWAYS DIVISION  
**LANDSCAPING PLANS**  
NIMITZ HIGHWAY AND  
ALA MOANA BOULEVARD RESURFACING  
AND HIGHWAY LIGHTING REPLACEMENT  
Fort Street to Kalakaua Avenue  
Federal Aid Project No. NH-092-1(27)  
Scale: Not to Scale      Date: November 2008  
SHEET No. 6 OF 8 SHEETS

FED. ROAD DIST. NO.	STATE	PROJ. NO.	FISCAL YEAR	SHEET NO.	TOTAL SHEETS
HAWAII	HAW.	NH-092-1(27)	2009	39R	302

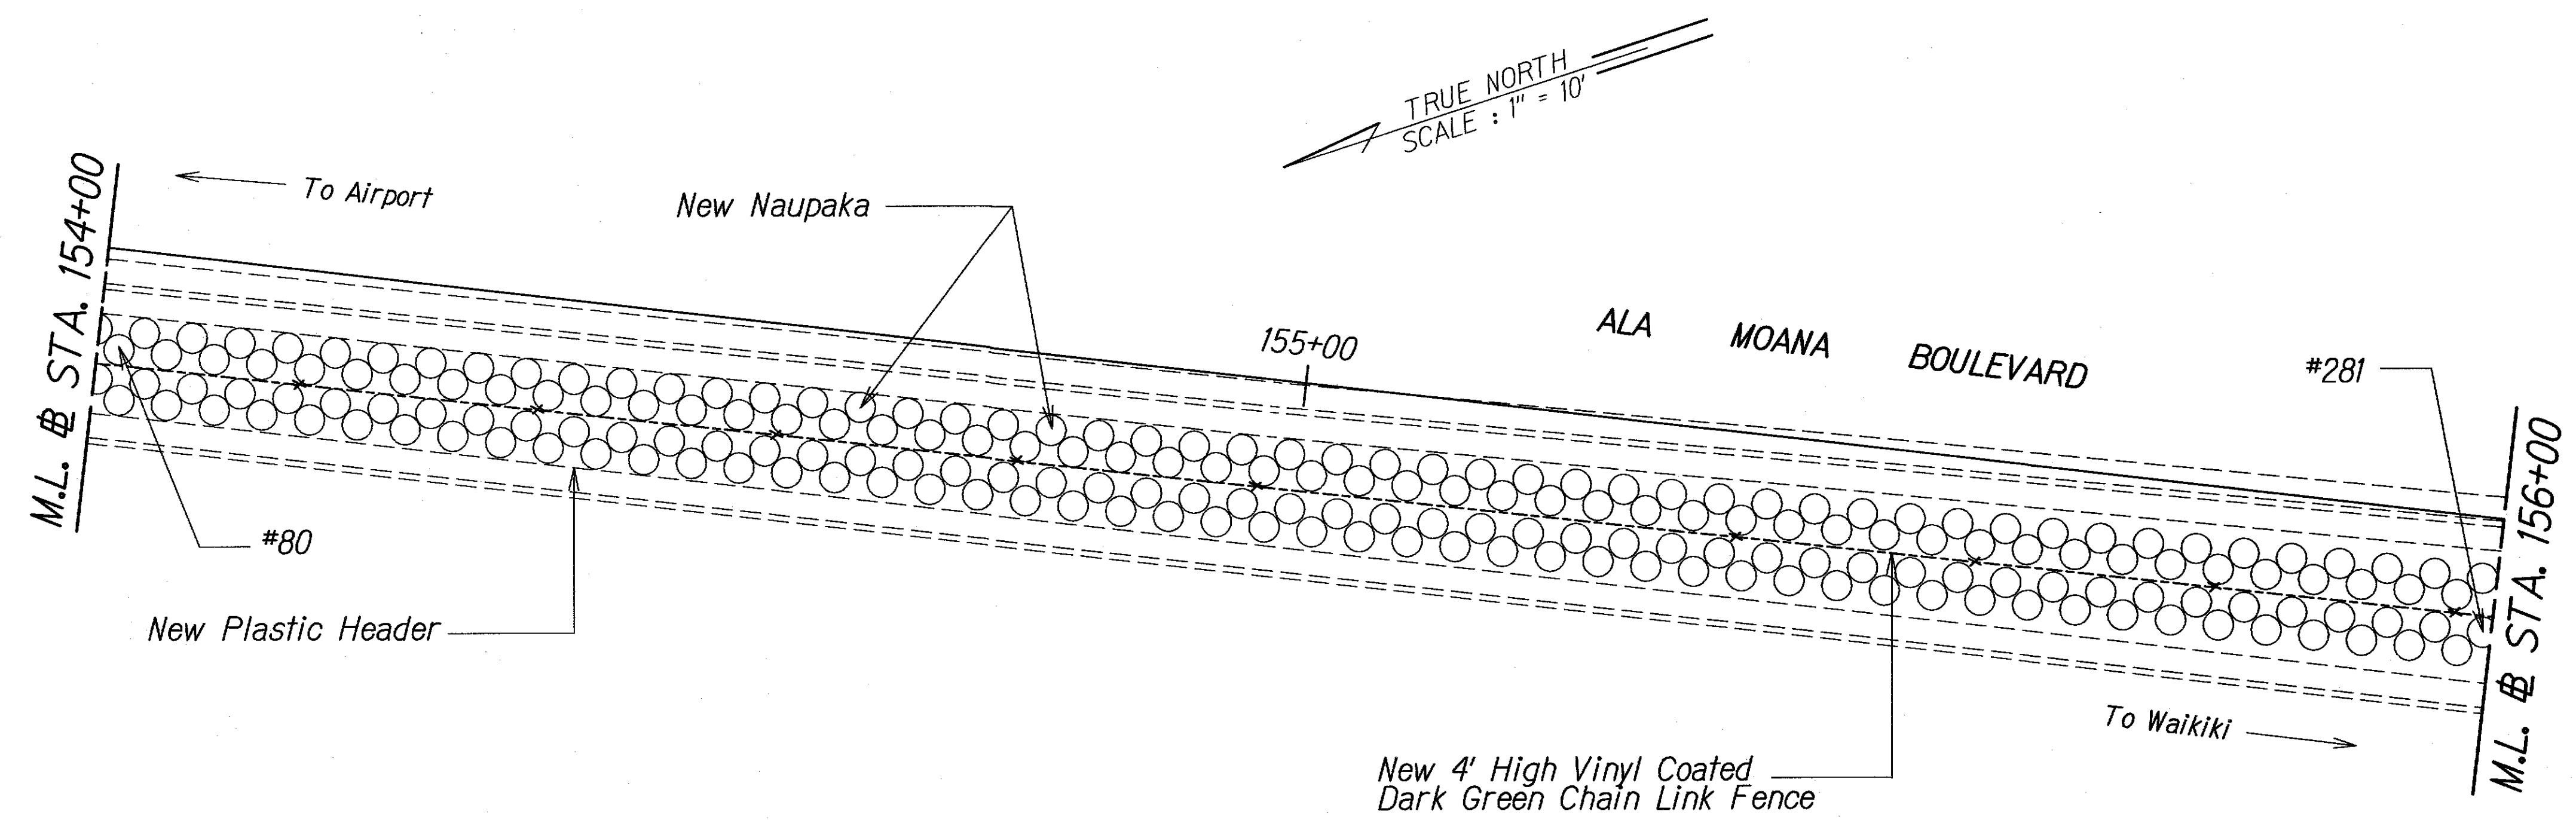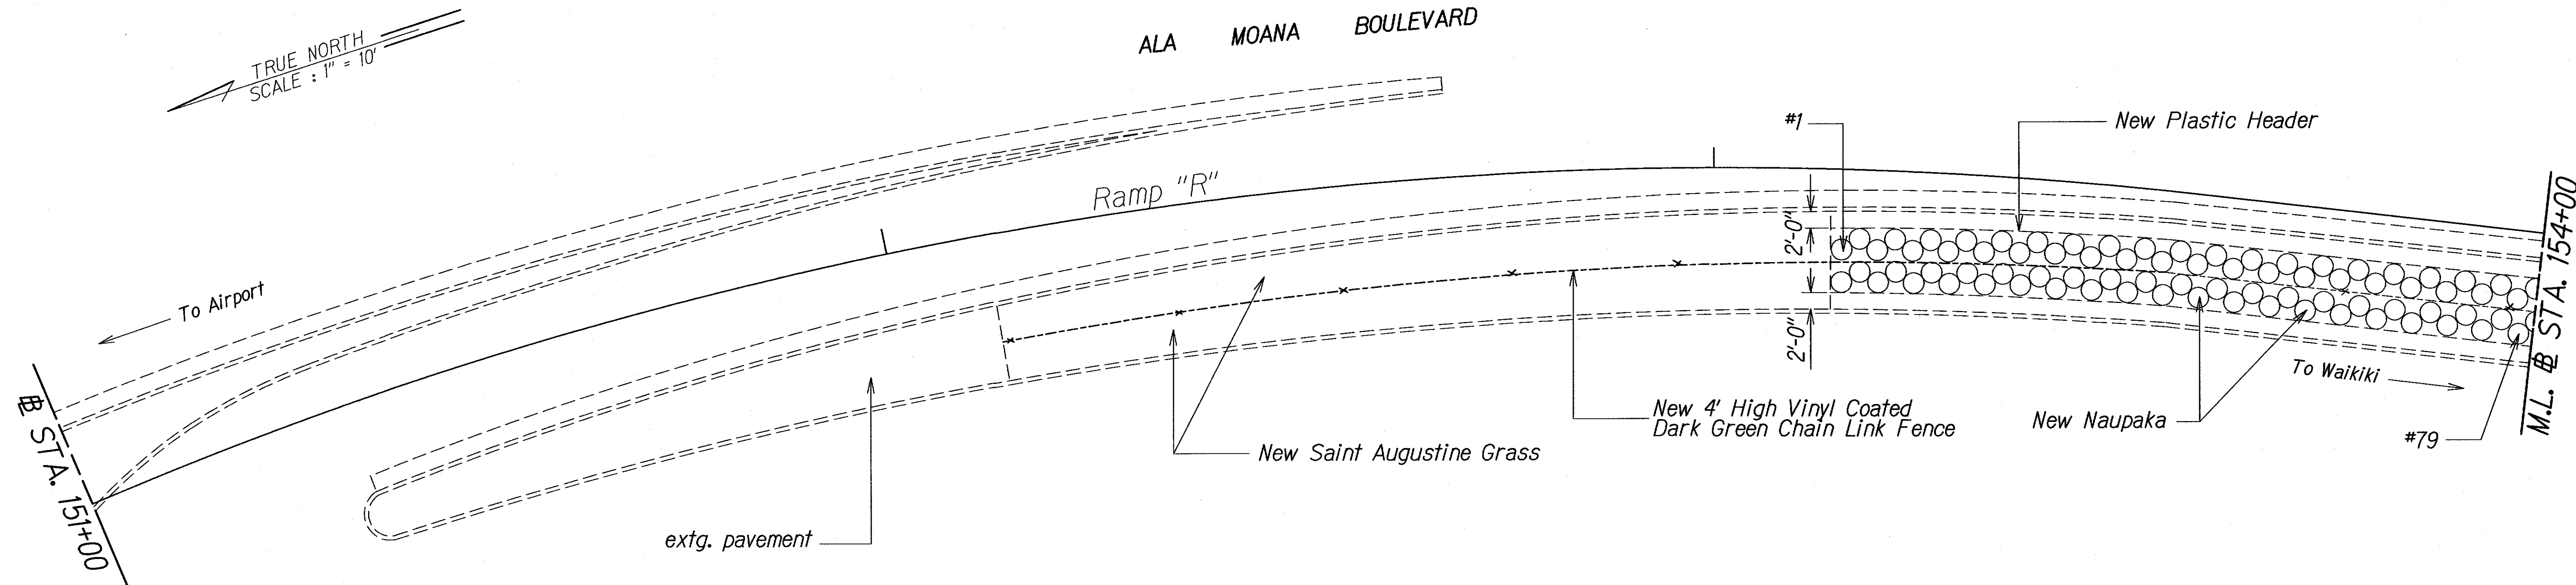


PLAN	DATE	BY
DRAWN BY	2/11/10	gdb
DESIGNED BY		
QUANTITIES BY		
CHECKED BY		

2/11/10	Revise scale.
DATE	REVISION
STATE OF HAWAII DEPARTMENT OF TRANSPORTATION HIGHWAYS DIVISION <b>LANDSCAPING PLANS</b> <b>NIMITZ HIGHWAY AND</b> <b>ALA MOANA BOULEVARD RESURFACING</b> <b>AND HIGHWAY LIGHTING REPLACEMENT</b> <b>Fort Street to Kalakaua Avenue</b> <b>Federal Aid Project No. NH-092-1(27)</b> Scale: 1" = 10'      Date: July 2009	
SHEET No. 7 OF 8 SHEETS	




FED. ROAD DIST. NO.	STATE	PROJ. NO.	FISCAL YEAR	SHEET NO.	TOTAL SHEETS
HAWAII	HAW.	NH-092-K27	2009	40R	302

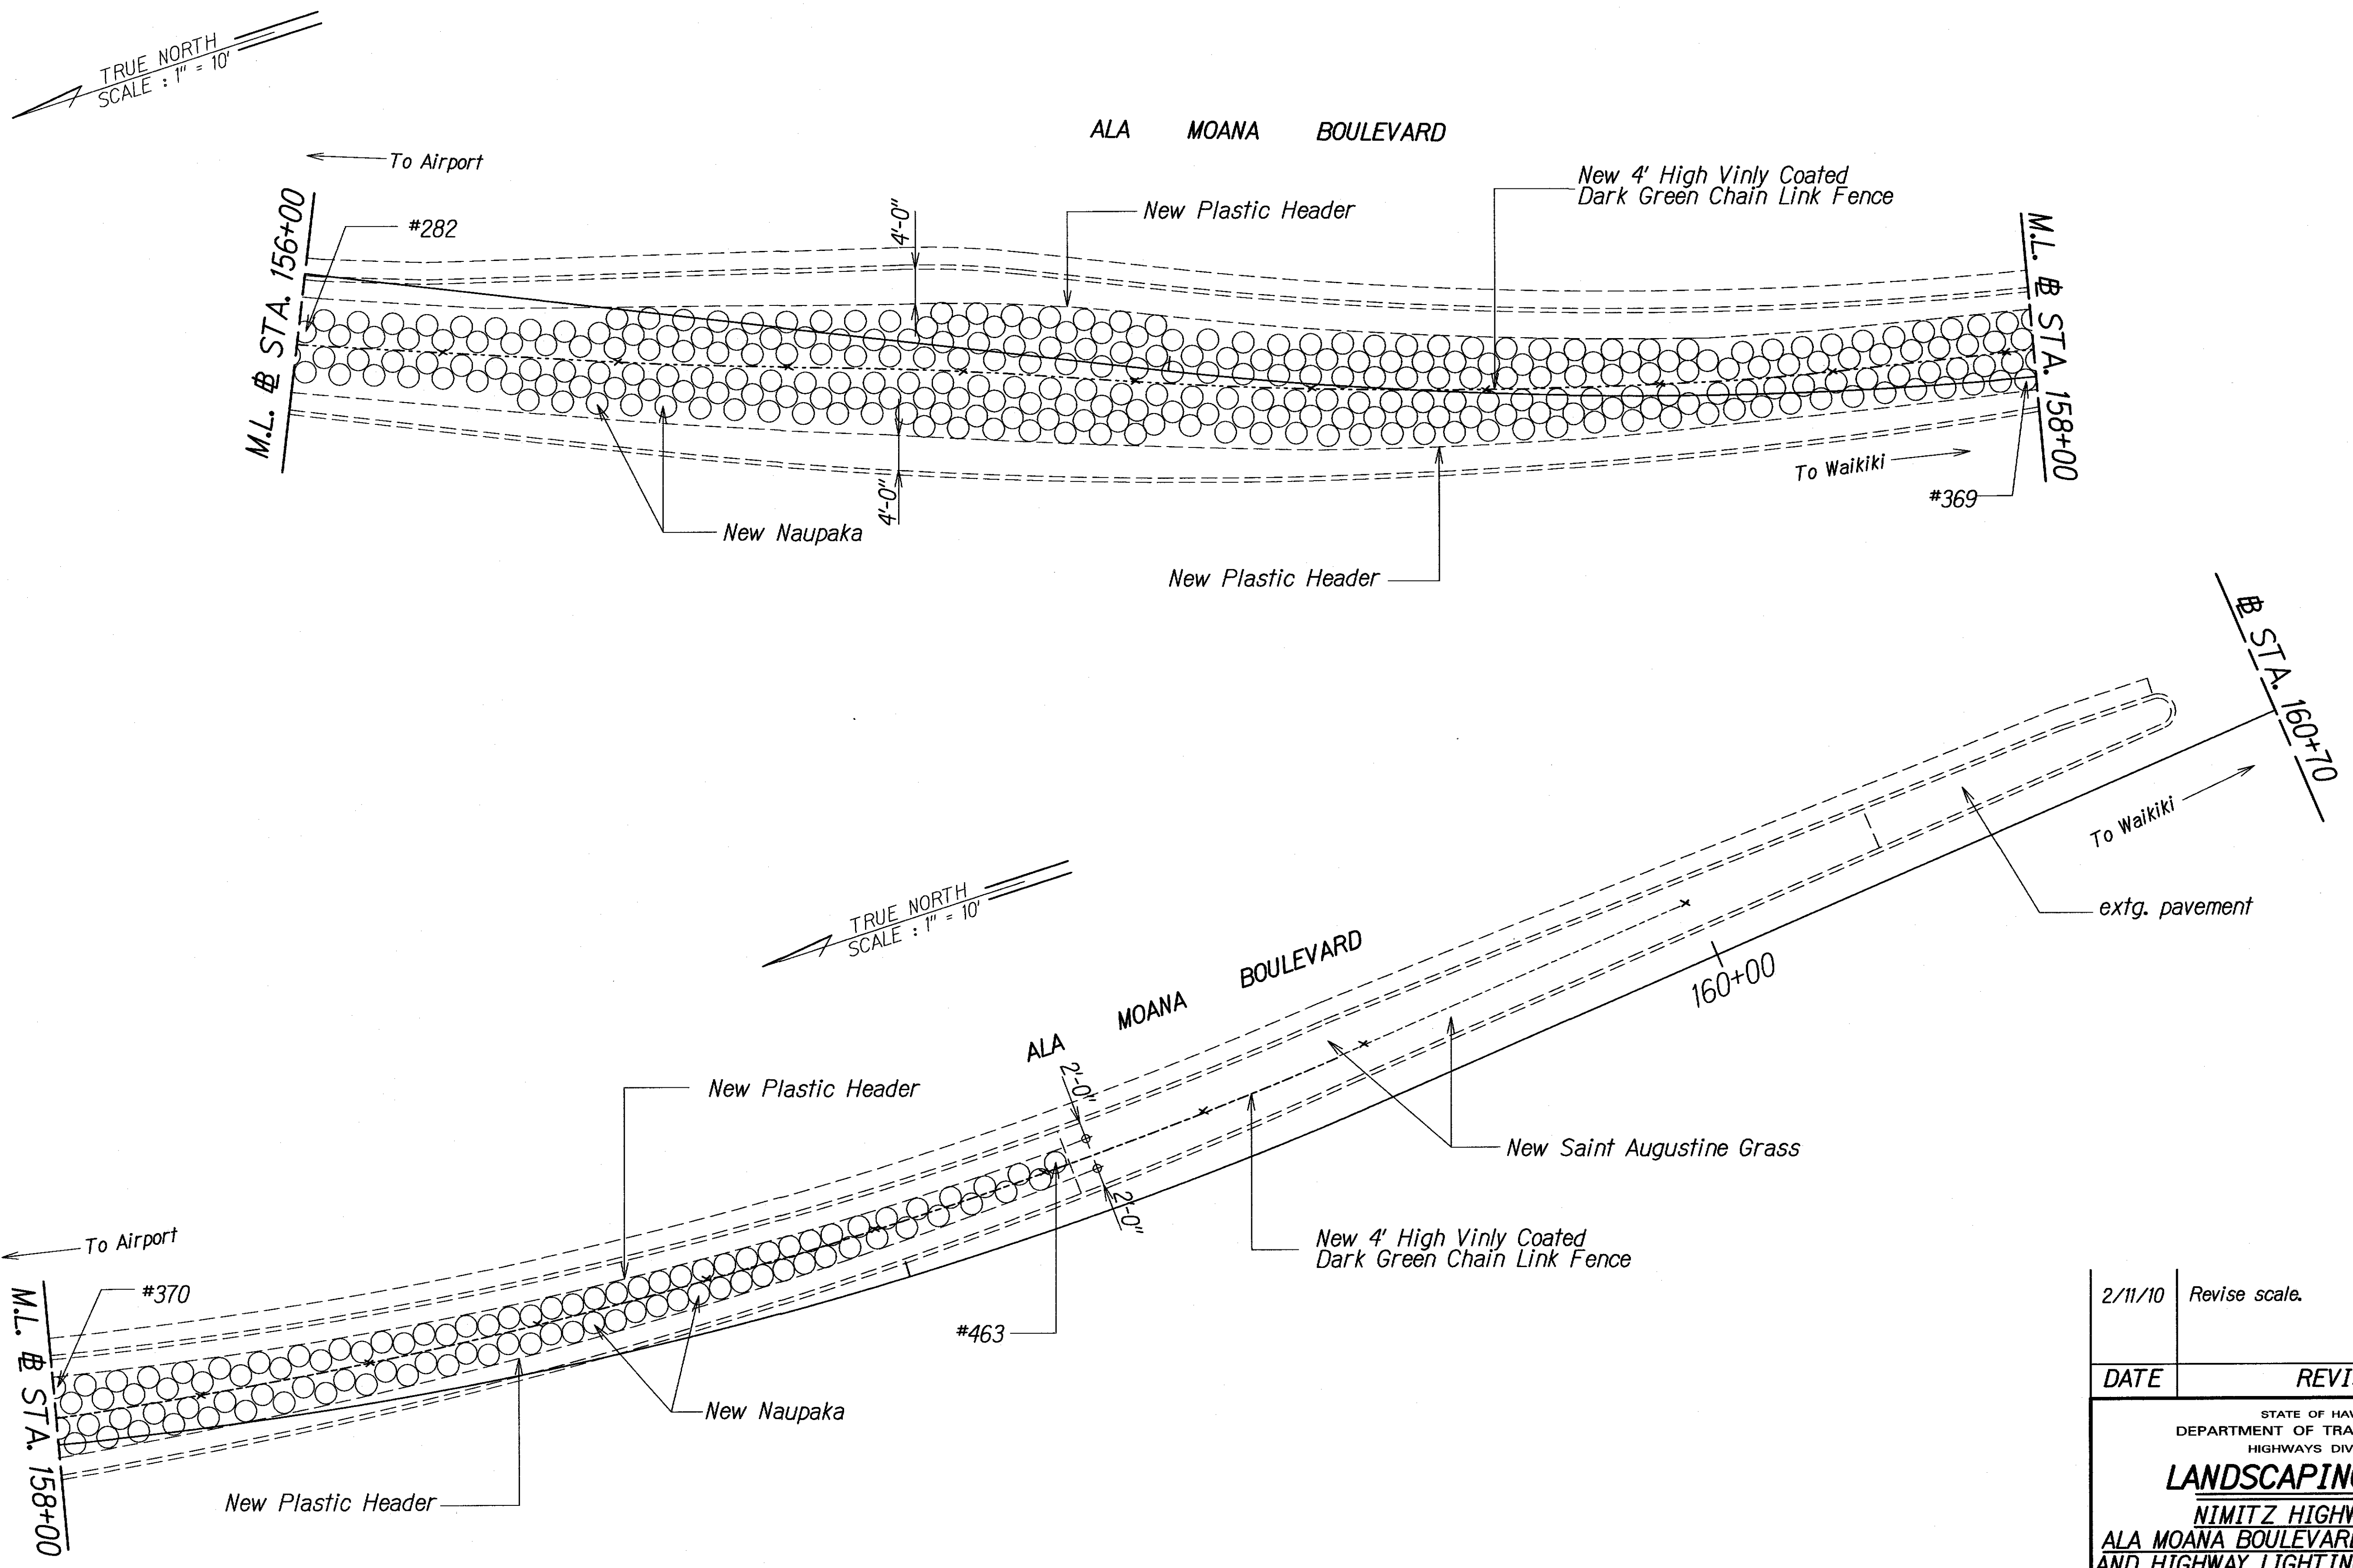

SURVEY PLOTTED BY	DATE
DRAWN BY	
DESIGNED BY	
QUANTITIES BY	
CHECKED BY	
ORIGINAL PLAN	
NOTE BOOK	
446 600000000	
No.	

2/11/10	Revise scale.
DATE	REVISION
STATE OF HAWAII DEPARTMENT OF TRANSPORTATION HIGHWAYS DIVISION <b>LANDSCAPING PLANS</b> <b>NIMITZ HIGHWAY AND</b> <b>ALA MOANA BOULEVARD RESURFACING</b> <b>AND HIGHWAY LIGHTING REPLACEMENT</b> <b>Fort Street to Kalakaua Avenue</b> <b>Federal Aid Project No. NH-092-K27)</b> Scale: 1" = 10'      Date: July 2009	
SHEET No. 8 OF 8 SHEETS	

FED. ROAD DIST. NO.	STATE	PROJ. NO.	FISCAL YEAR	SHEET NO.	TOTAL SHEETS
HAWAII	HAW.	NH-092-K(27)	2009	41R	302

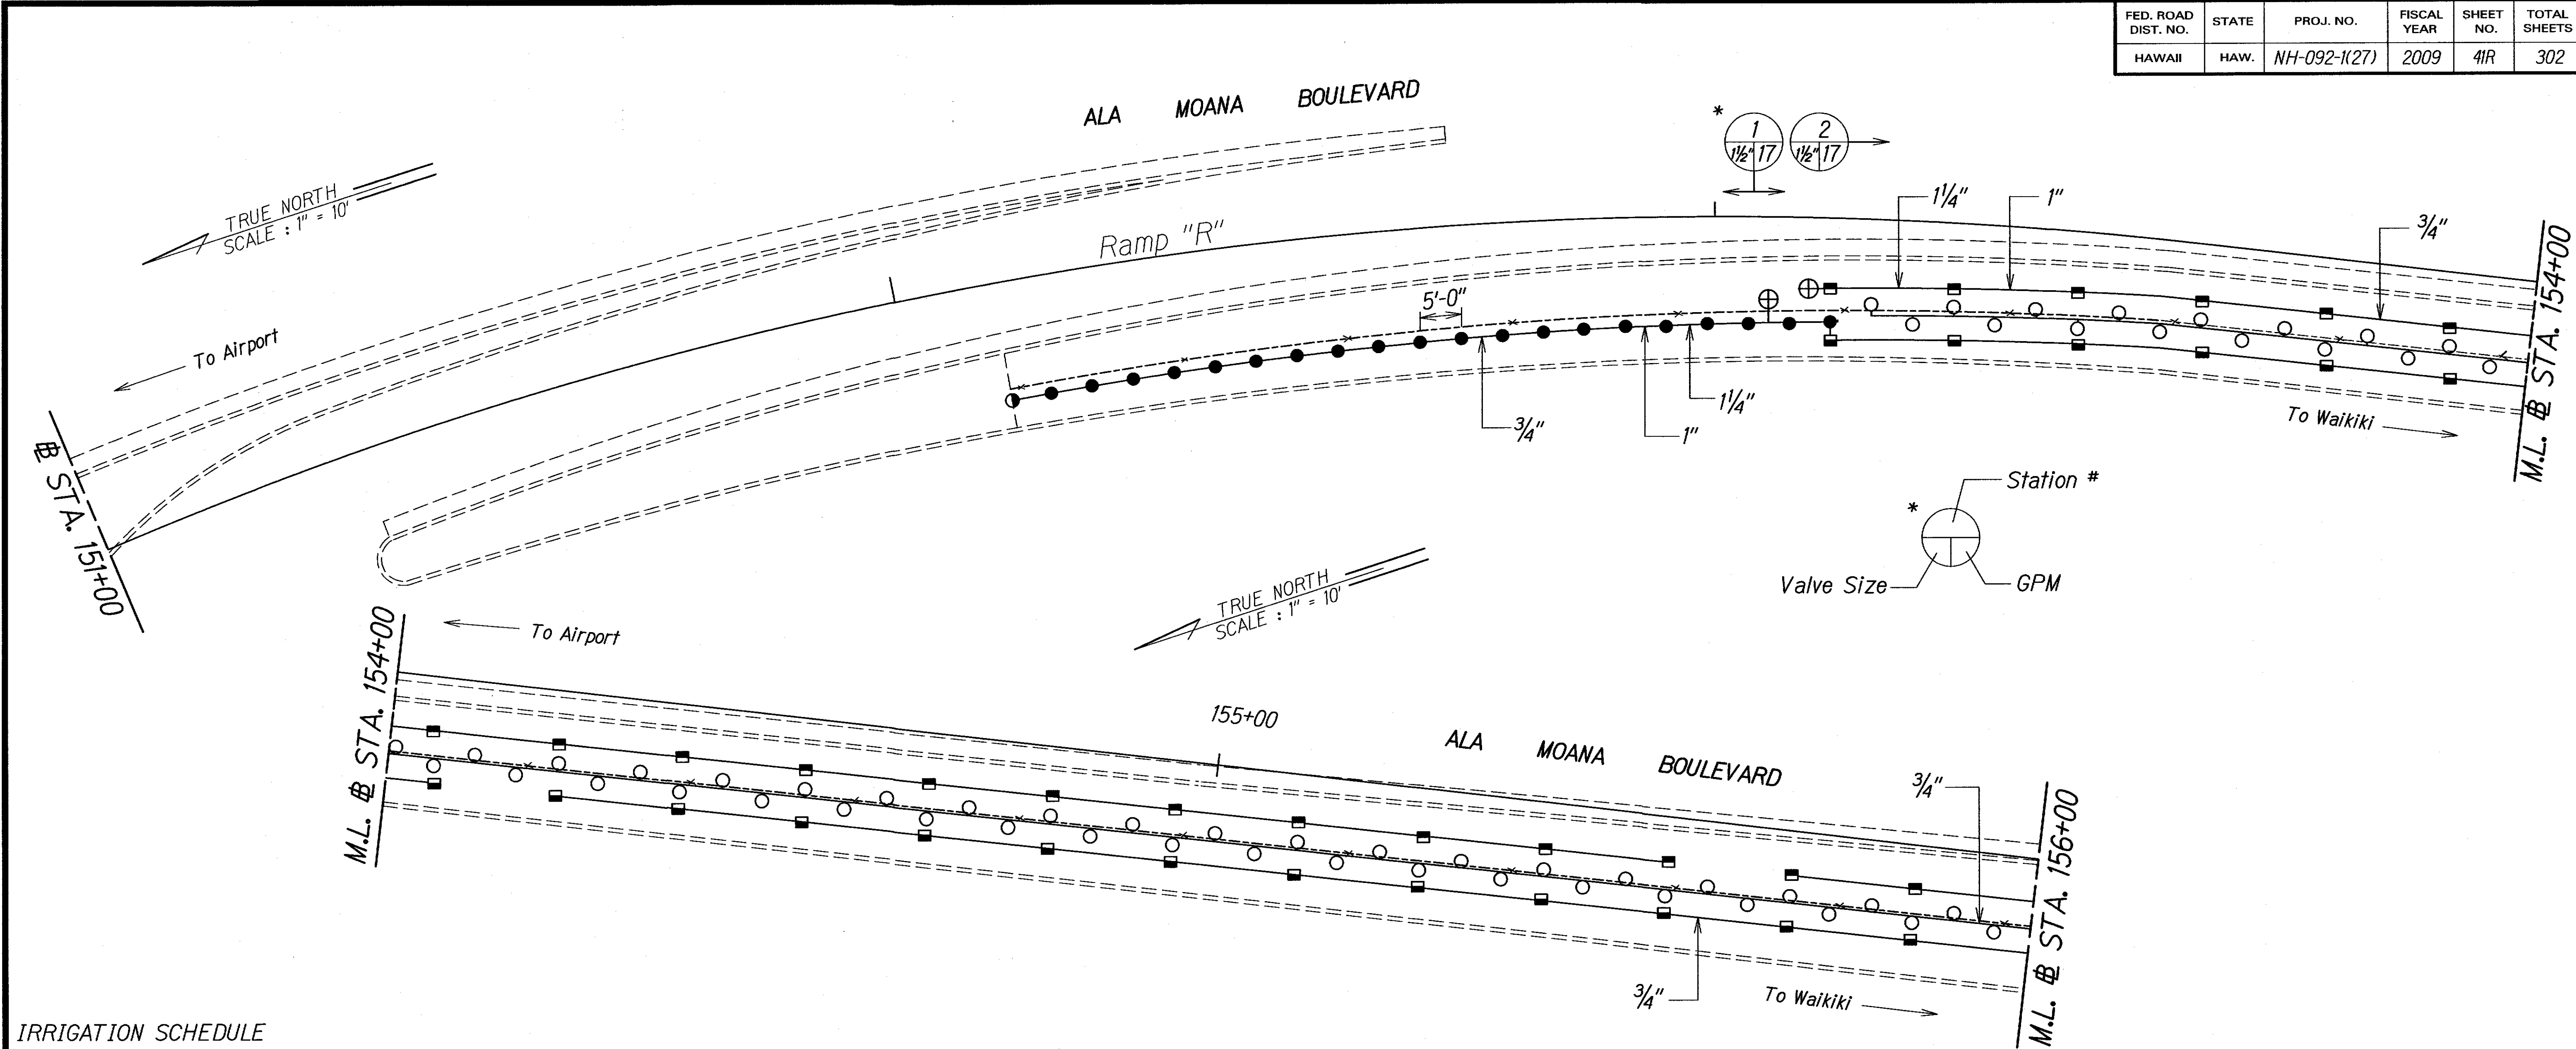

# IRRIGATION SCHEDULE

SYMBOL	QUANTITY	CATALOG NUMBER	DESCRIPTION	G.P.M.	RADIUS	P.S.I.
●	40	Rainbird 1804-SAM-PRS-5F	4" Pop-Up Nozzle Full Circle	0.41	5	30
◐	3	Rainbird 1804-SAM-PRS-5H	4" Pop-Up Nozzle Half Circle	0.21	5	30
■	68	Rainbird 1804-SAM-PRS-15SST	4" Pop-Up Nozzle Side Strip	1.21	4x30	30
○	71	Rainbird 1804-SAM-PRS-5F	Spray Head on Riser Detail	0.41	5	30
□	17	Rainbird 1804-SAM-PRS-8F	Spray Head on Riser Detail	1.05	8	30
⊕	8	Rainbird 150-PEB-PRS-D with LEMA 1600HE Solenoid with 30-921 Plastic Adapter	1'-1/2" Remote Control Valve w/ actuator			
		Rainbird 33-DRC with LEEMCO LS-120	3/4" Quick Coupler Valve			
⌘	1	1 1/2" Watts 009QT-125-RPB or B.W.S. approved equal with security enclosure - Factory Present - 50 P.S.I.	Backflow preventer with security enclosure with Model 600-Pressure Reducing Valve			
■	1	DIG ENCLX LEITX series stainless steel enclosure, MV/P Sensor adapter SKIT8821-4 adapter LEMA 1600HE with Sensor Hunter Mini Click II-Rainbird RSD	Irrigation Controller X10-MCOLXL Mounting Column 51" (long) Model SKIT8821-4			
△	1	U.S. Bronze NIBCO T113 Gate Valve	Gate Valve			
T	1	U.S. Bronze NIBCO "T"-Size to Exist. (Price 2" dia)	Brass "T"			
—		PVC Schedule 40	Irrigation Pipe			

2/11/10	Revise scale.
---------	---------------


DATE	REVISION
------	----------

STATE OF HAWAII  
DEPARTMENT OF TRANSPORTATION  
HIGHWAYS DIVISION

**IRRIGATION LAYOUT PLANS**  
NIMITZ HIGHWAY AND  
ALA MOANA BOULEVARD RESURFACING  
AND HIGHWAY LIGHTING REPLACEMENT  
Fort Street to Kalakaua Avenue  
Federal Aid Project No. NH-092-K(27)  
Scale: 1" = 10' Date: July 2009

SHEET No. 1 OF 2 SHEETS

FED. ROAD DIST. NO.	STATE	PROJ. NO.	FISCAL YEAR	SHEET NO.	TOTAL SHEETS
HAWAII	HAW.	NH-092-1(27)	2009	42R	302

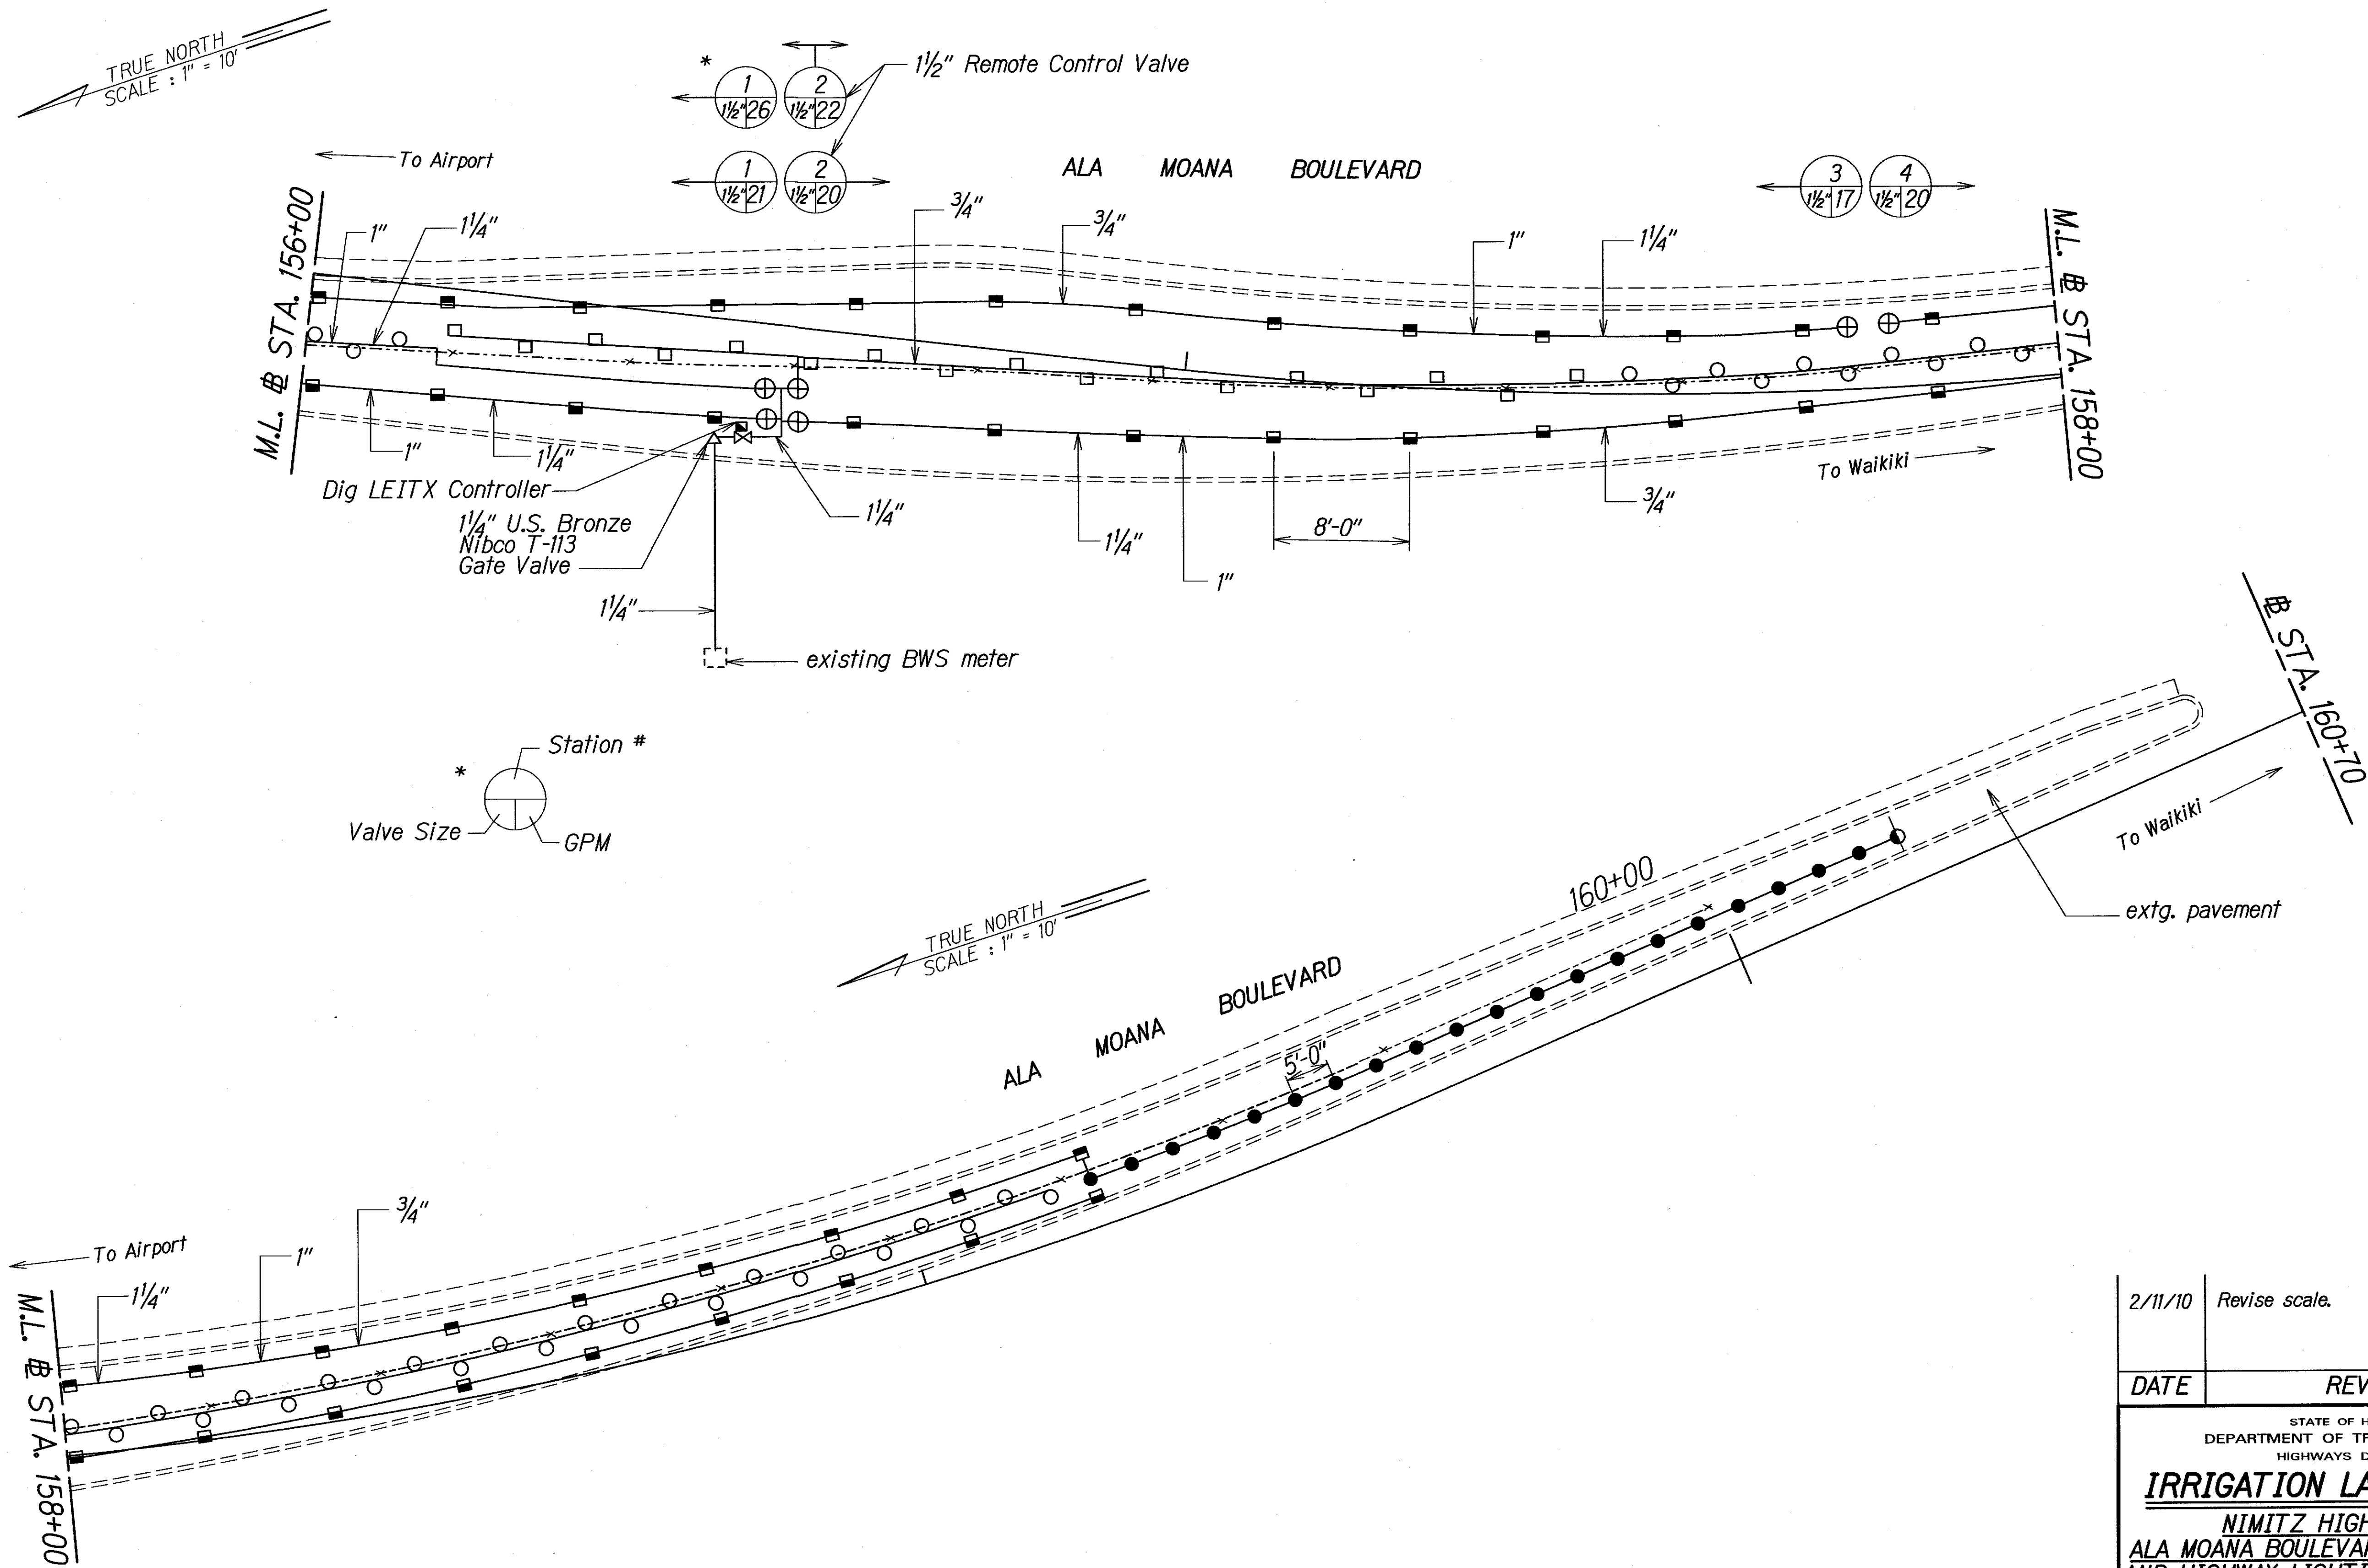

ORIGINAL PLAN	DATE
SURVEY PLOTTED BY	
DESIGNED BY	
NOTED BY	
CHECKED BY	
DATE	

2/11/10	Revise scale.
DATE	REVISION
STATE OF HAWAII DEPARTMENT OF TRANSPORTATION HIGHWAYS DIVISION <b>IRRIGATION LAYOUT PLANS</b> NIMITZ HIGHWAY AND ALA MOANA BOULEVARD RESURFACING AND HIGHWAY LIGHTING REPLACEMENT Fort Street to Kalakaua Avenue Federal Aid Project No. NH-092-1(27) Scale: 1" = 10' Date: July 2009	
SHEET No. 2 OF 2 SHEETS	