
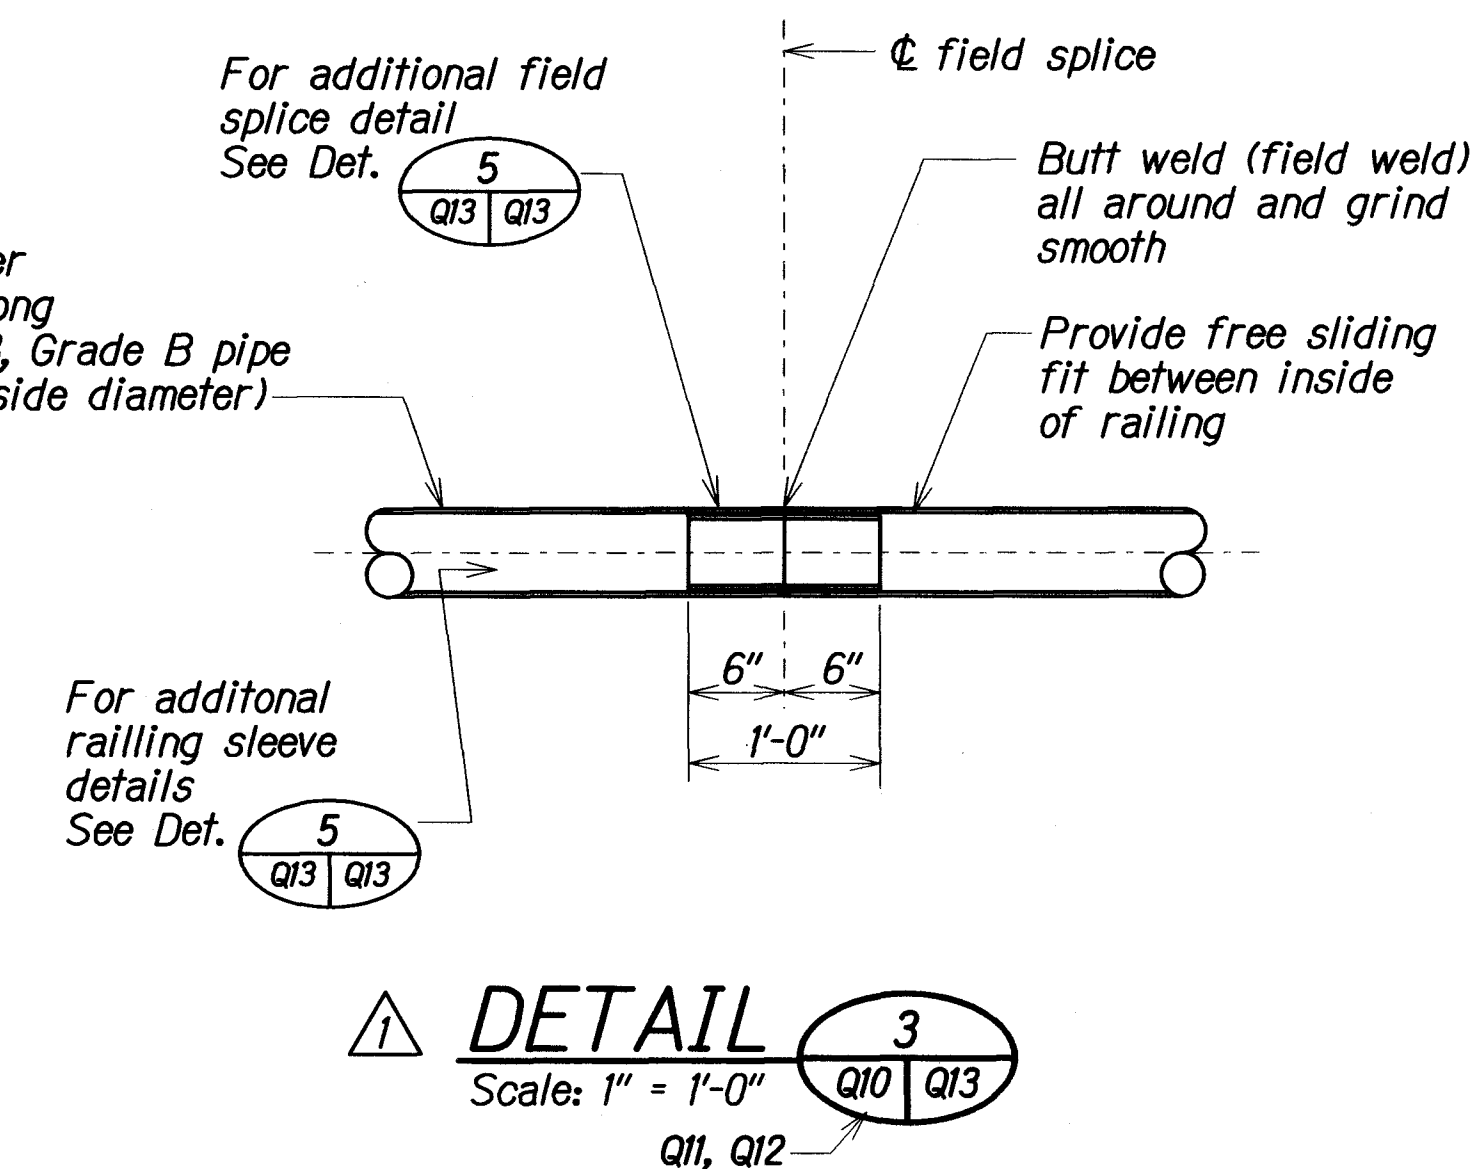
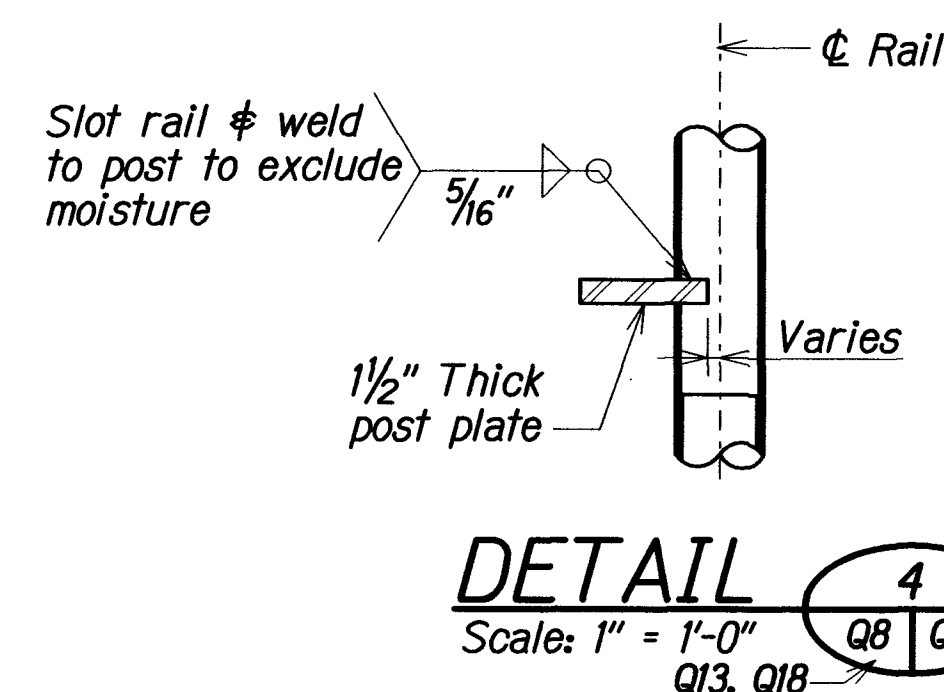
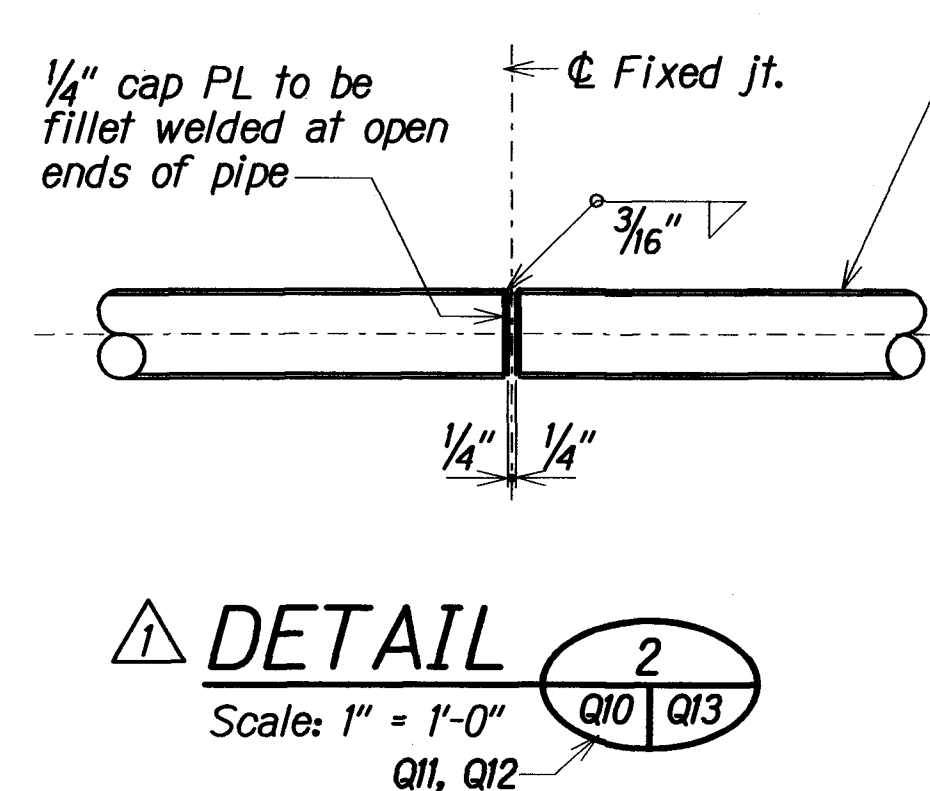
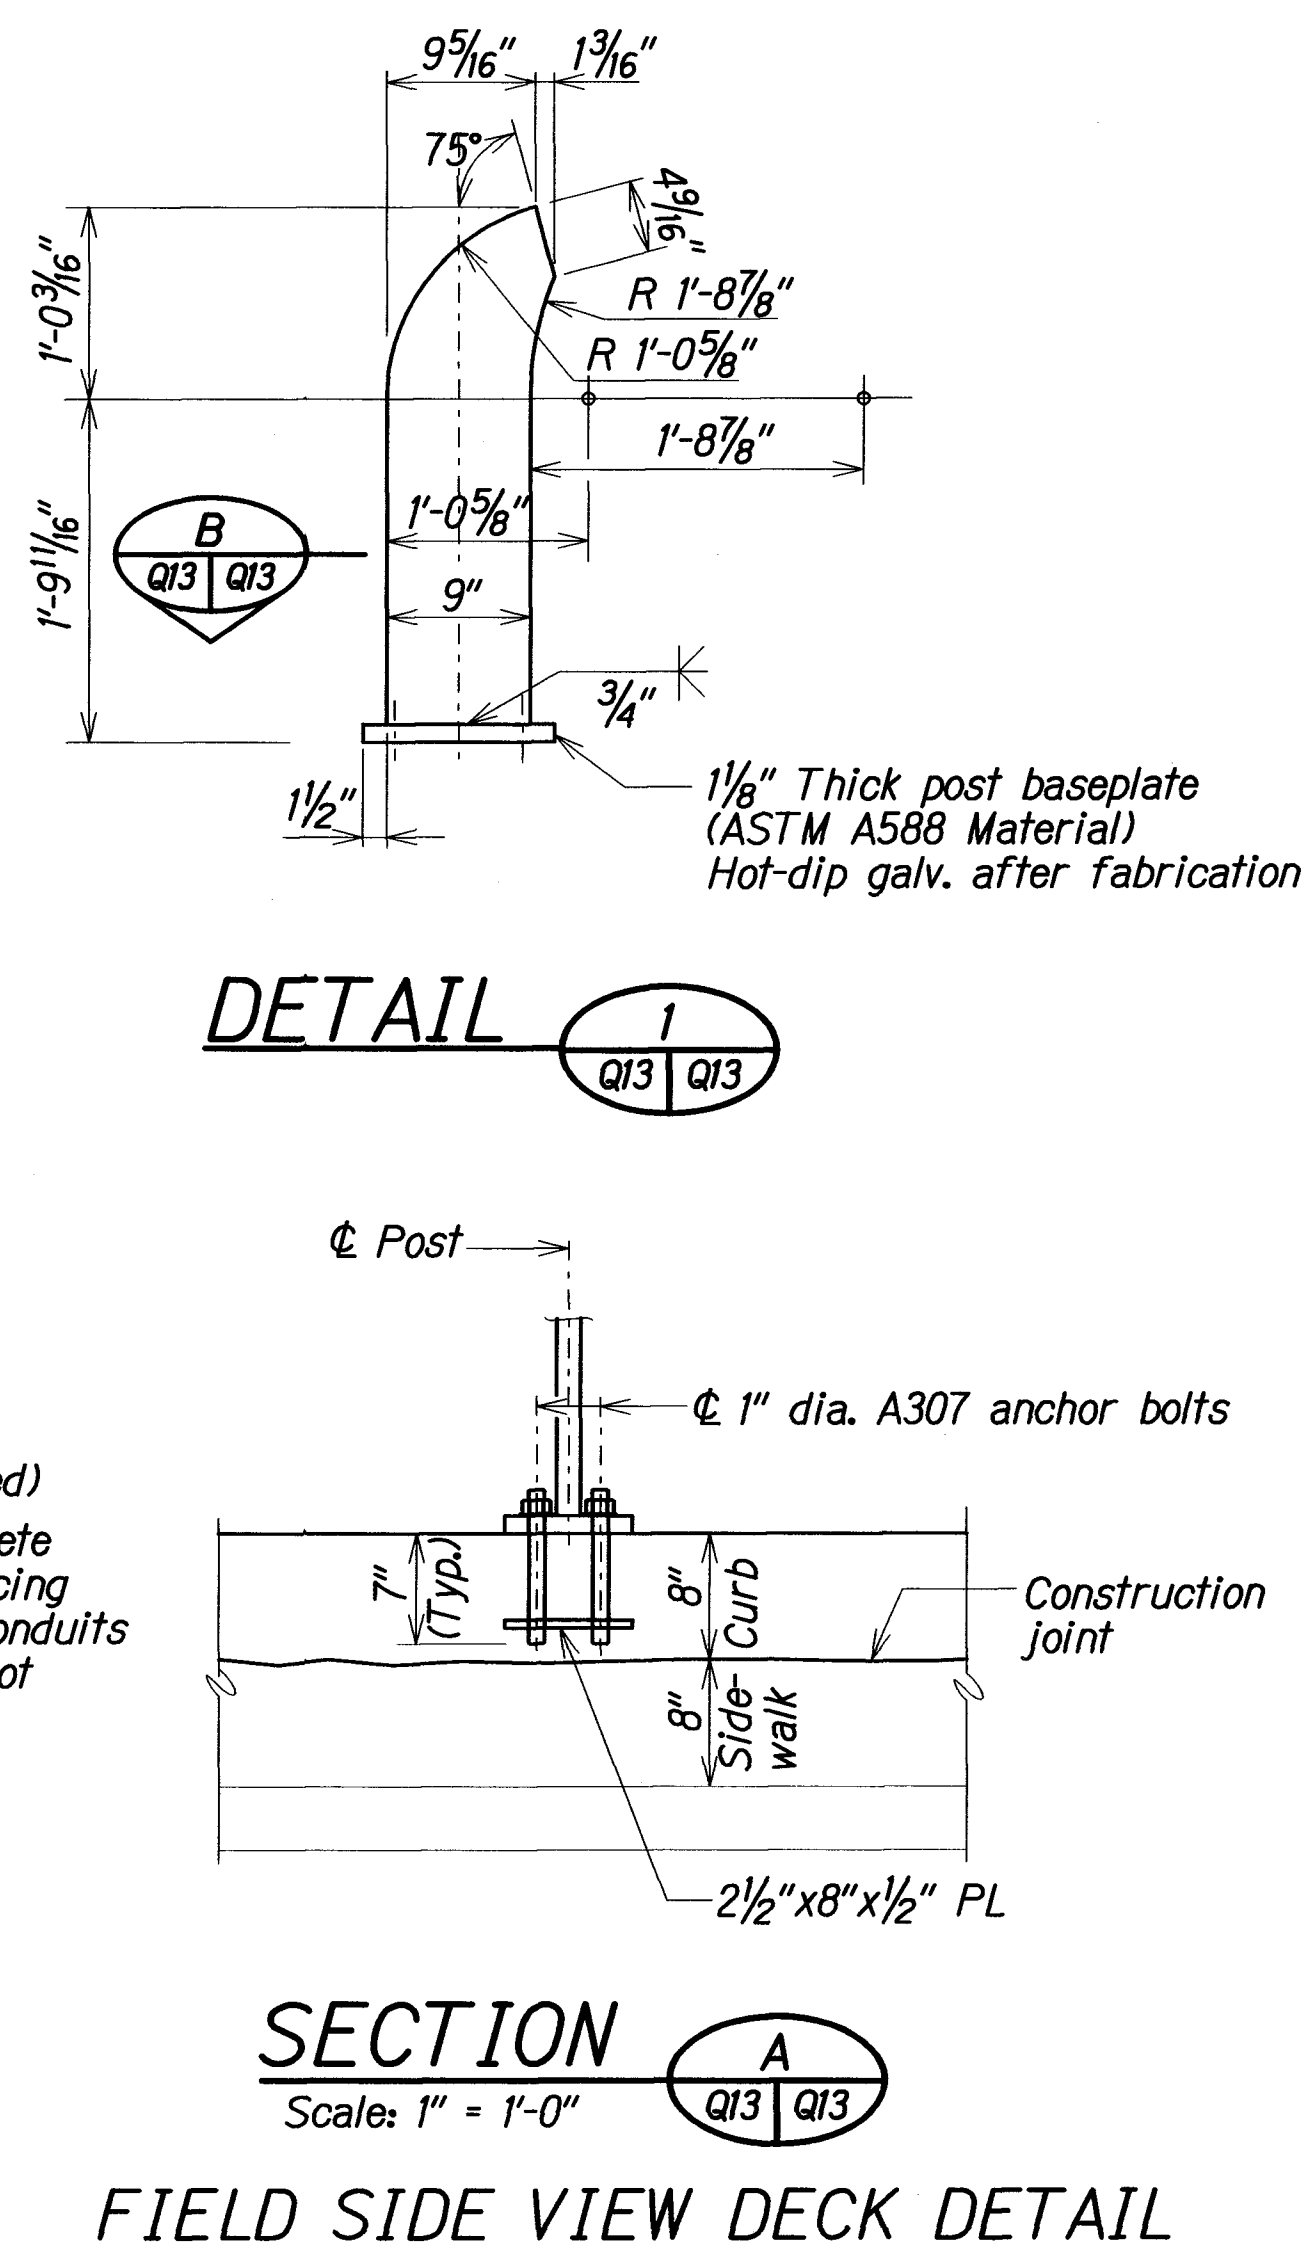
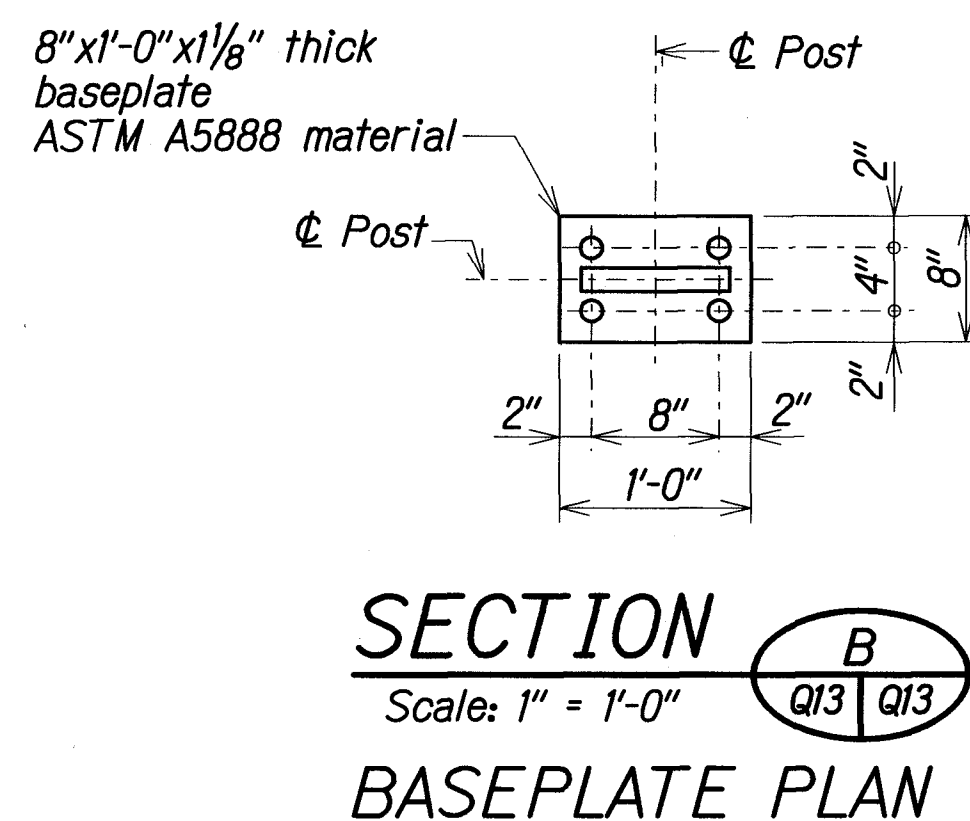


FED. ROAD DIST. NO.	STATE	FED. AID PROJ. NO.	FISCAL YEAR	SHEET NO.	TOTAL SHEETS
HAWAII	HAW.	NH-092-1(27)	2010	ADD 55	302

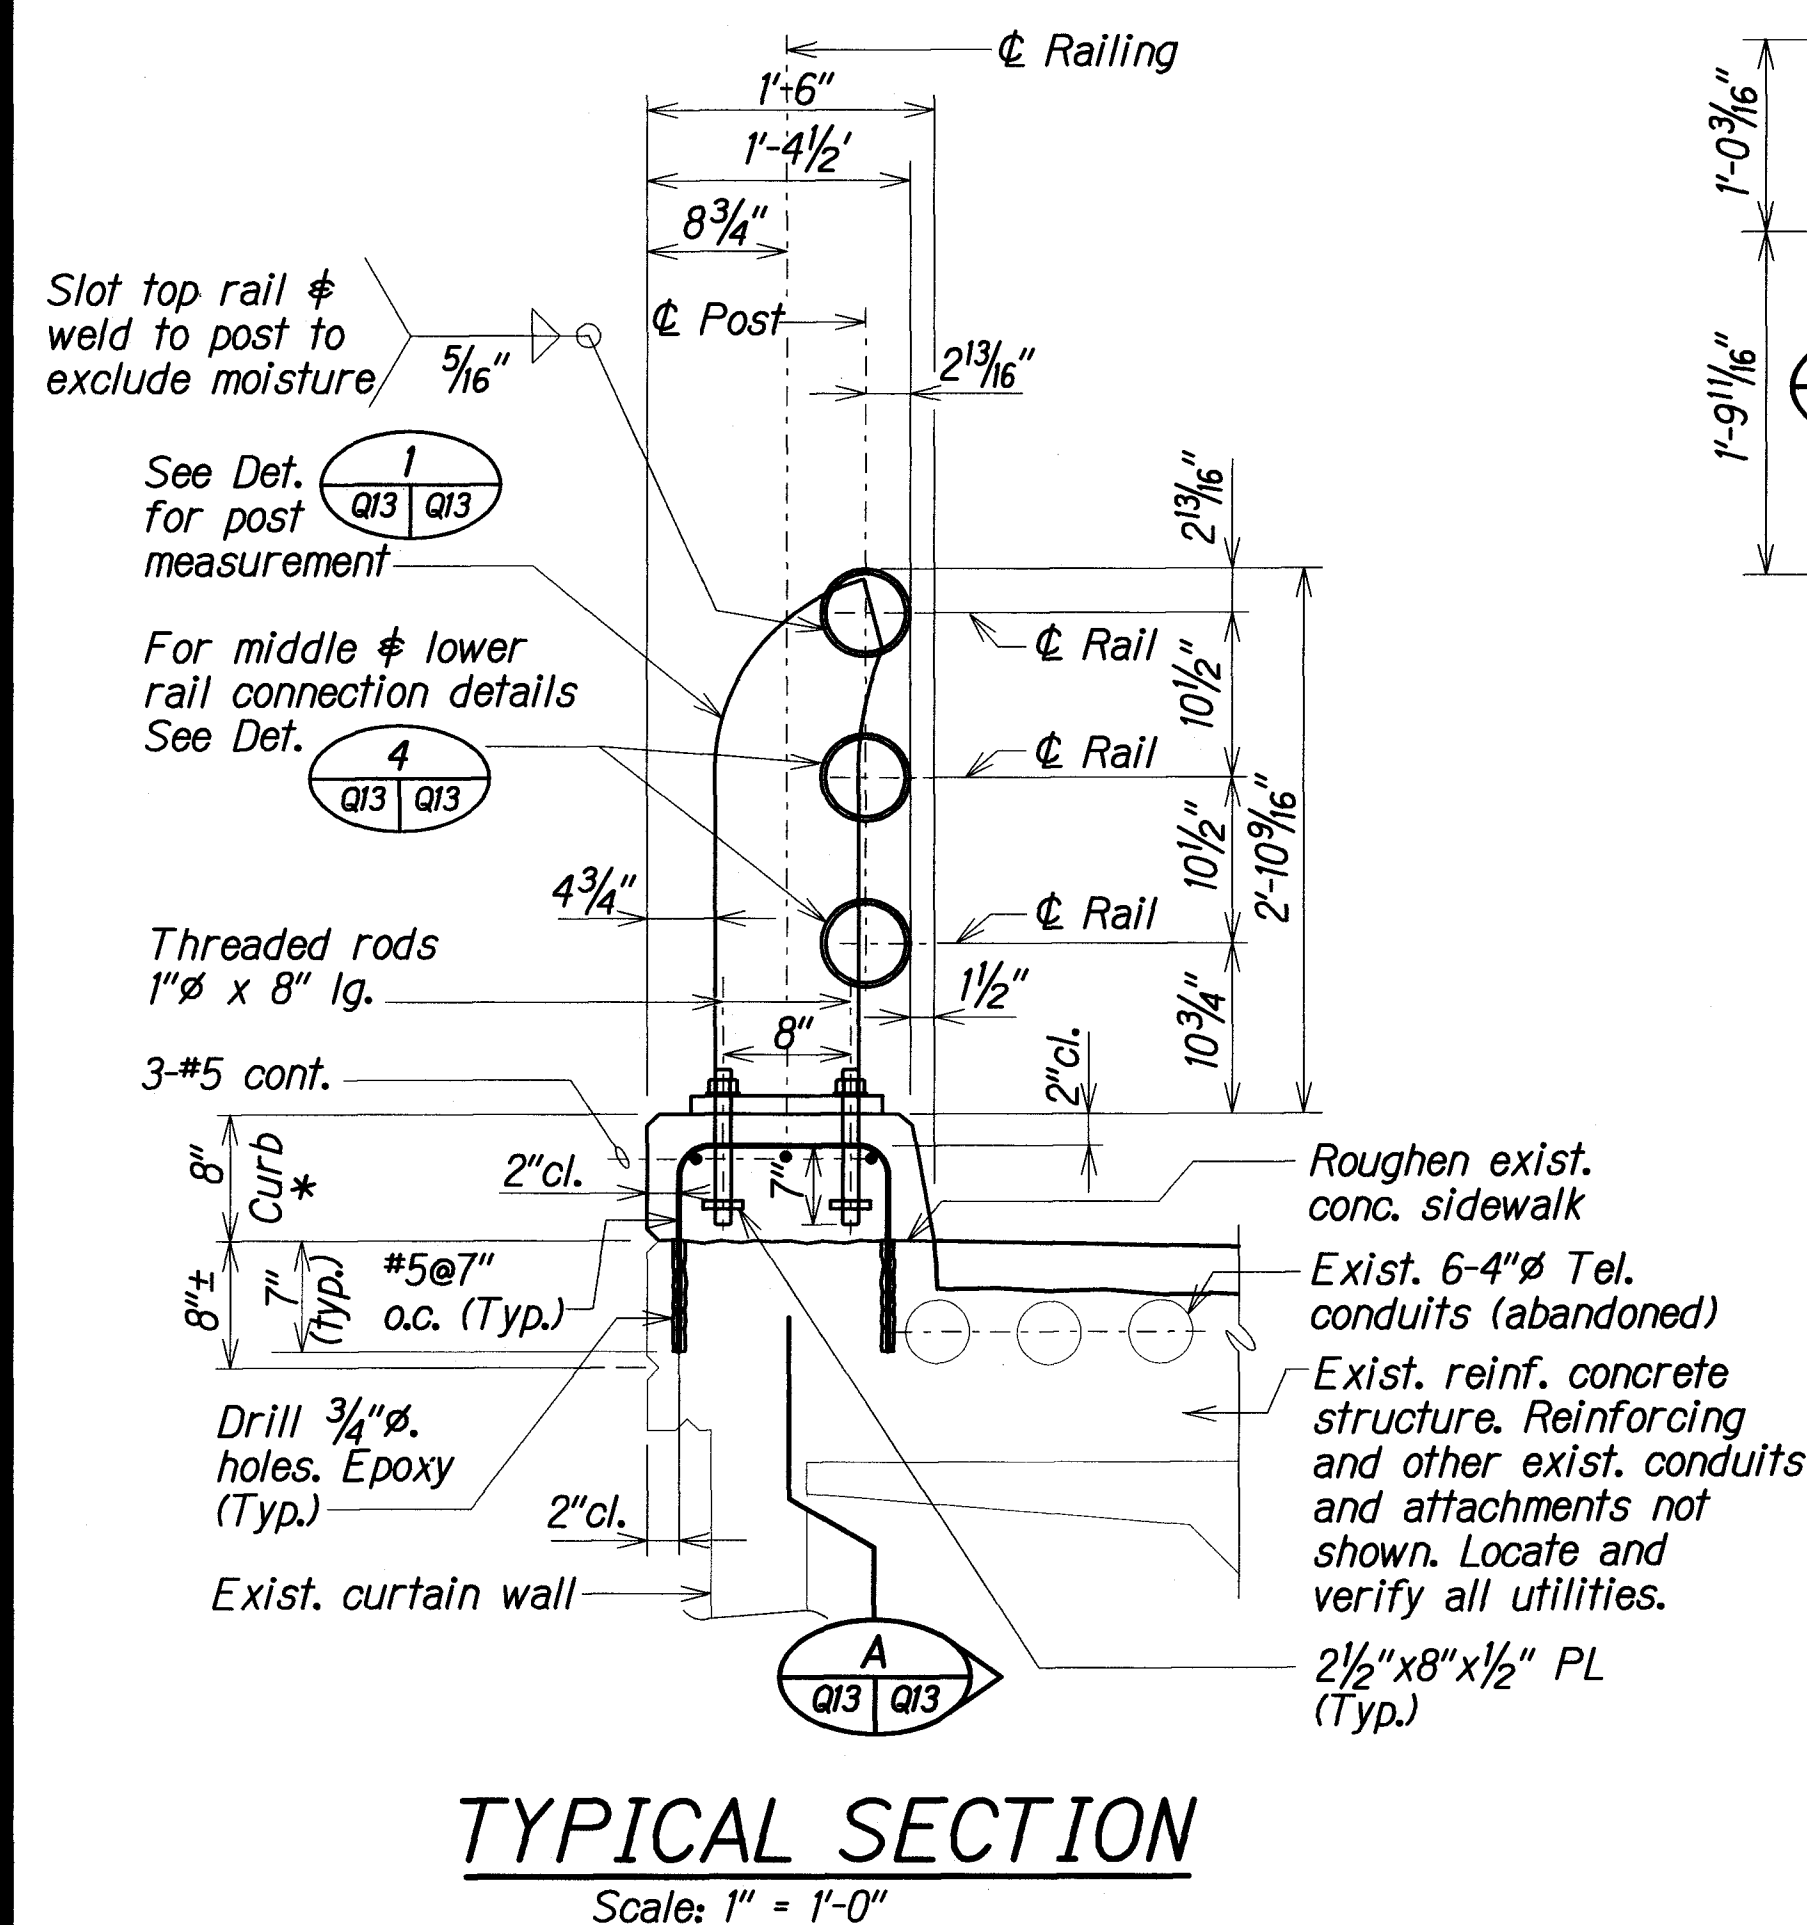

STEEL PIPE BRIDGE RAIL DETAILS

NOTE:

- * 1. Curb to be included under Item No. 676.1000 Concrete Repair for Sidewalk on Bridge.

3/10/10	Revised Det. 2 and Det. 3.
DATE	REVISION

STATE OF HAWAII
DEPARTMENT OF TRANSPORTATION
HIGHWAYS DIVISION

ALA WAI CANAL BRIDGE
STEEL PIPE BRIDGE RAIL DETAILS
NIMITZ HIGHWAY AND
ALA MOANA BOULEVARD RESURFACING
AND HIGHWAY LIGHTING REPLACEMENT
Federal Aid Project No. NH-092-1(27)

Scale: As Noted
Date: Jun, 2009

SHEET No. Q13 OF 23 SHEETS