


INDEX TO DRAWINGS	
SHEET NO.	DESCRIPTION
1	TITLE SHEET
2	STANDARD PLANS SUMMARY
5 - 6	GENERAL NOTES AND LEGEND
3 - 4	WATER POLLUTIONS AND EROSION CONTROL NOTES
7 - 13	UTILITY NOTES
14 - 16	TYPICAL SECTIONS AND DETAILS
17	P.C.C. BUS PAD PAVEMENT DETAIL
18	P.C.C. PAVEMENT JOINT DETAILS & LAYOUT
19	SIDEWALK AND WALL DETAILS
20 - 21	CONCRETE SIDEWALK PLANS
22	CURB RAMP & DRIVEWAY PLANS
23 - 28	ROADWAY PLANS
29 - 31	LANDSCAPING DETAILS
32 - 40	LANDSCAPING NOTES AND PLANS
41 - 42	IRRIGATION LAYOUT PLANS
43 - 62	ALA WAI CANAL BRIDGE
63	TYPICAL CONCRETE FOUNDATION AND TRANSFORMER BASE DETAILS
64	LIGHT STANDARD SPECIAL FOOTING
65	RETAINING WALL DETAILS
66	SIGN GENERAL NOTES AND KEY
67	PAVEMENT MARKING, LEGEND, DETAILS & NOTES
68	WORK ZONE SIGNING PLAN, NOTES & DETAILS
69 - 74	PAVEMENT MARKING & SIGNALING PLAN
75 - 77	LOOP DETECTOR PLAN
78	SCHEDULE
79	SWING SIGN BRACKET DETAIL
80 - 85	MISCELLANEOUS SIGN DETAILS
86 - 177	HIGHWAY LIGHTING AND TRAFFIC SIGNAL PLANS, NOTES AND DETAILS
178 - 302	UTILITY UNDERGROUNDING PLANS, NOTES AND DETAILS

Sheet Nos. ① ADD 22S-1 to ADD 22S-2; ② C.O. 57S-1 thru C.O. 57S-3; ③ C.O. 58S-1; and ④ C.O. ADD. 64S-1 are Supplementary sheets to this Project. Total Sheet Count After "AS-BUILT" Posting 309 Sheets.

DEC 2009
DATE
692-7570
PHONE
HWY-DD
MANAGED BY
DESIGNED BY



FED. ROAD DIST. NO.	STATE	PROJ. NO.	FISCAL YEAR	SHEET NO.	TOTAL SHEETS
HAWAII	HAW.	NH-092-1(27)	2010	1R	302

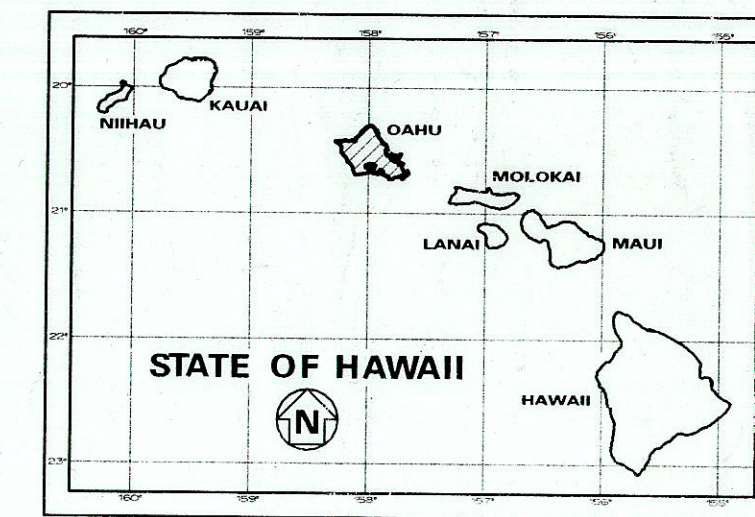

MILE POST 6.20 TO MILE POST 9.24

CHANGES MADE DURING CONSTRUCTION HAVE BEEN INCORPORATED ON THESE PLANS EXCEPT CHANGES IN THE ORIGINAL THEORETICAL QUANTITIES. FOR ACTUAL QUANTITIES, REFER TO PROJECT LEDGER AND/OR COMPUTATION BOOK.

Resident Engineer
DATE

APPROVED:

3/10/10
DIRECTOR, DEPT. OF PLANNING & PERMITTING
(For Work Within City R/W only)

1/4/2010	Dept. of Planning & Permitting
DATE	Approval Signature
REVISION	
DEPARTMENT OF TRANSPORTATION	
STATE OF HAWAII	
APPROVED:	
DIRECTOR OF TRANSPORTATION	DEC 10 2009
DATE	

ADD 1R