

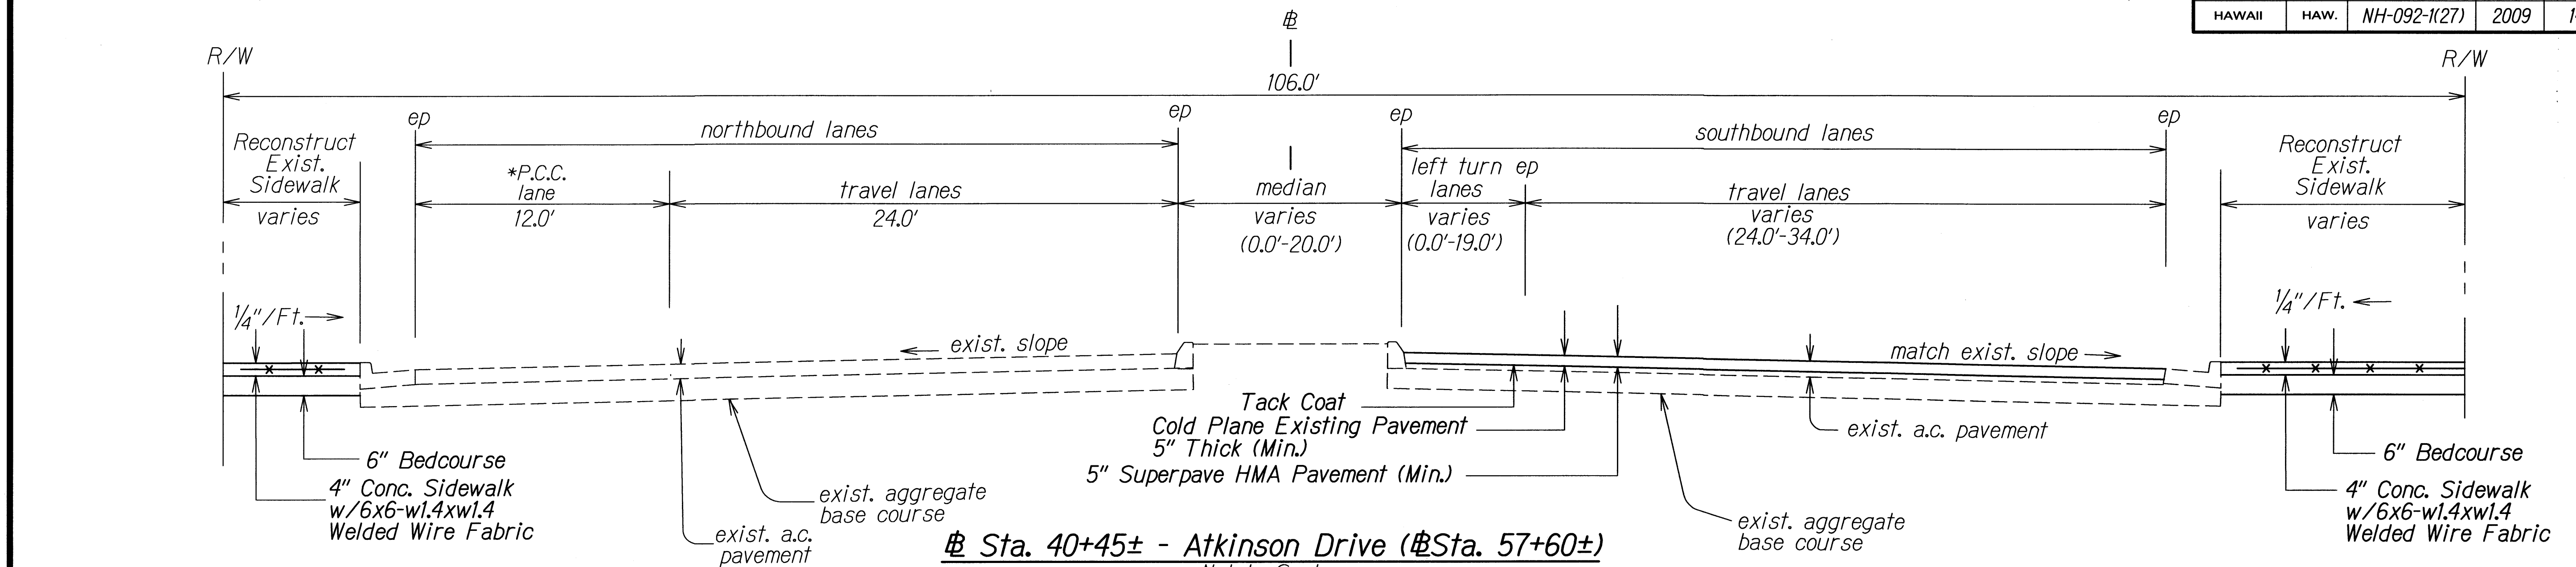


FED. ROAD DIST. NO.	STATE	PROJ. NO.	FISCAL YEAR	SHEET NO.	TOTAL SHEETS
HAWAII	HAW.	NH-092-1(27)	2009	14	302

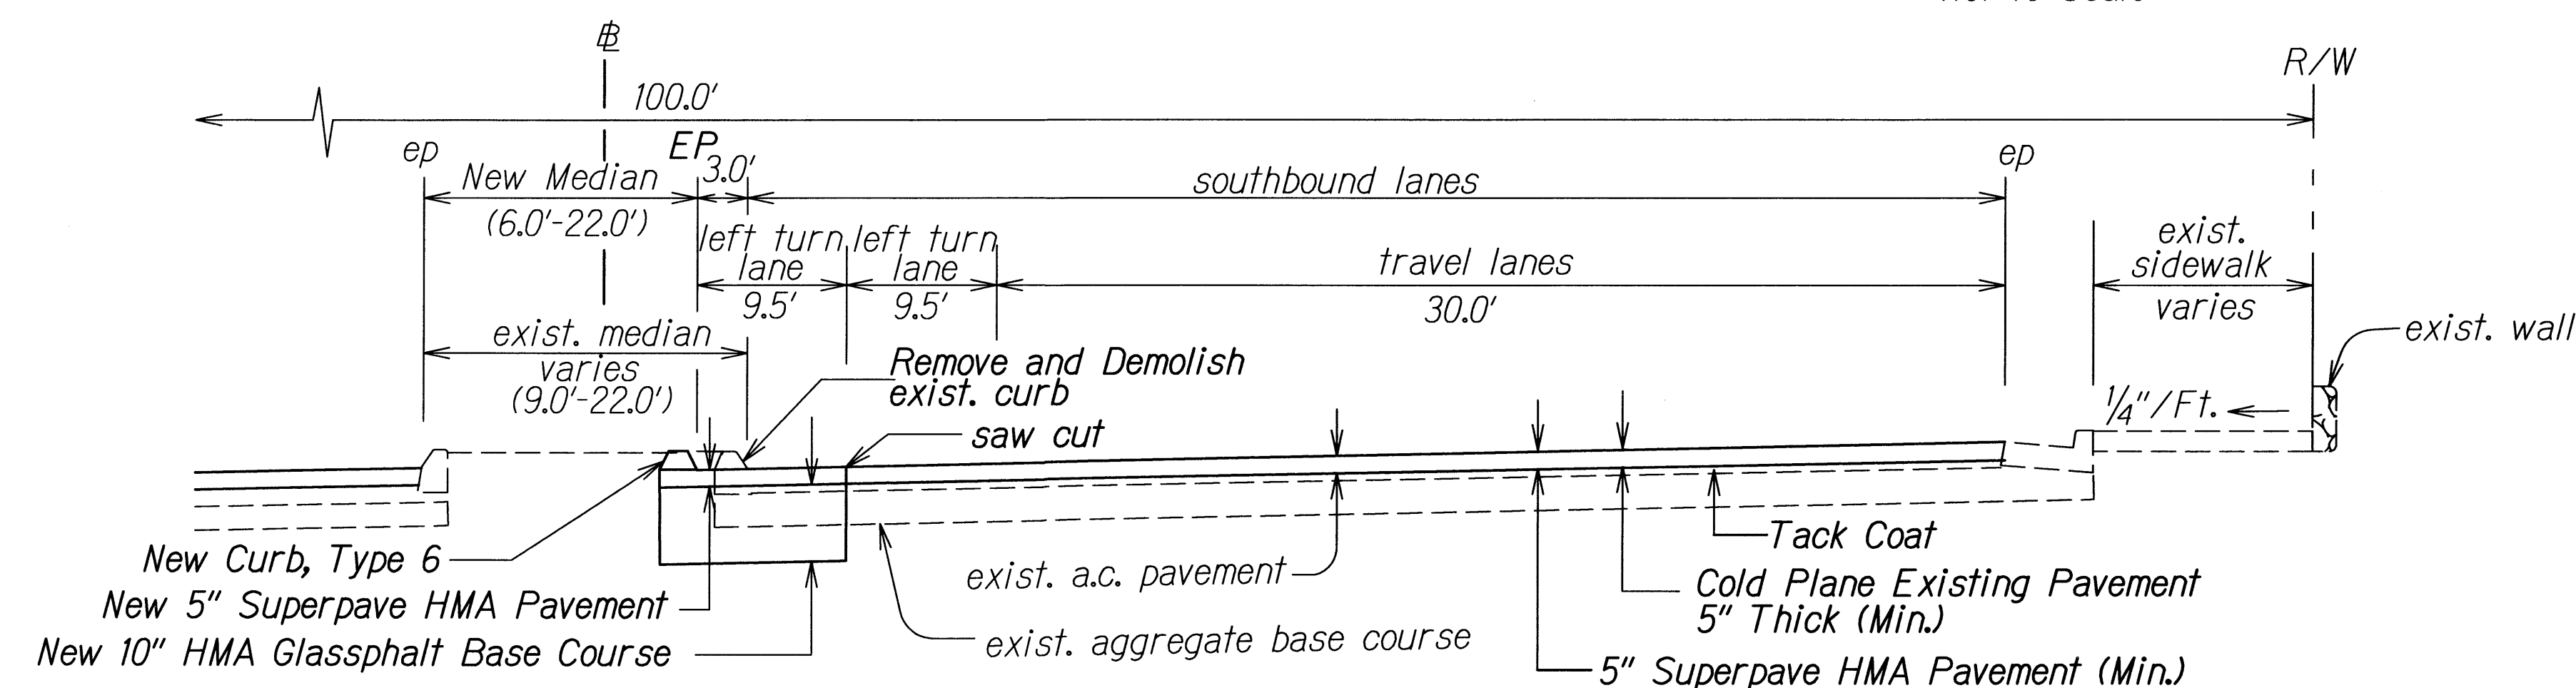

* For limits of P.C.C. repair, see Plan Sht. No. 27 & 28

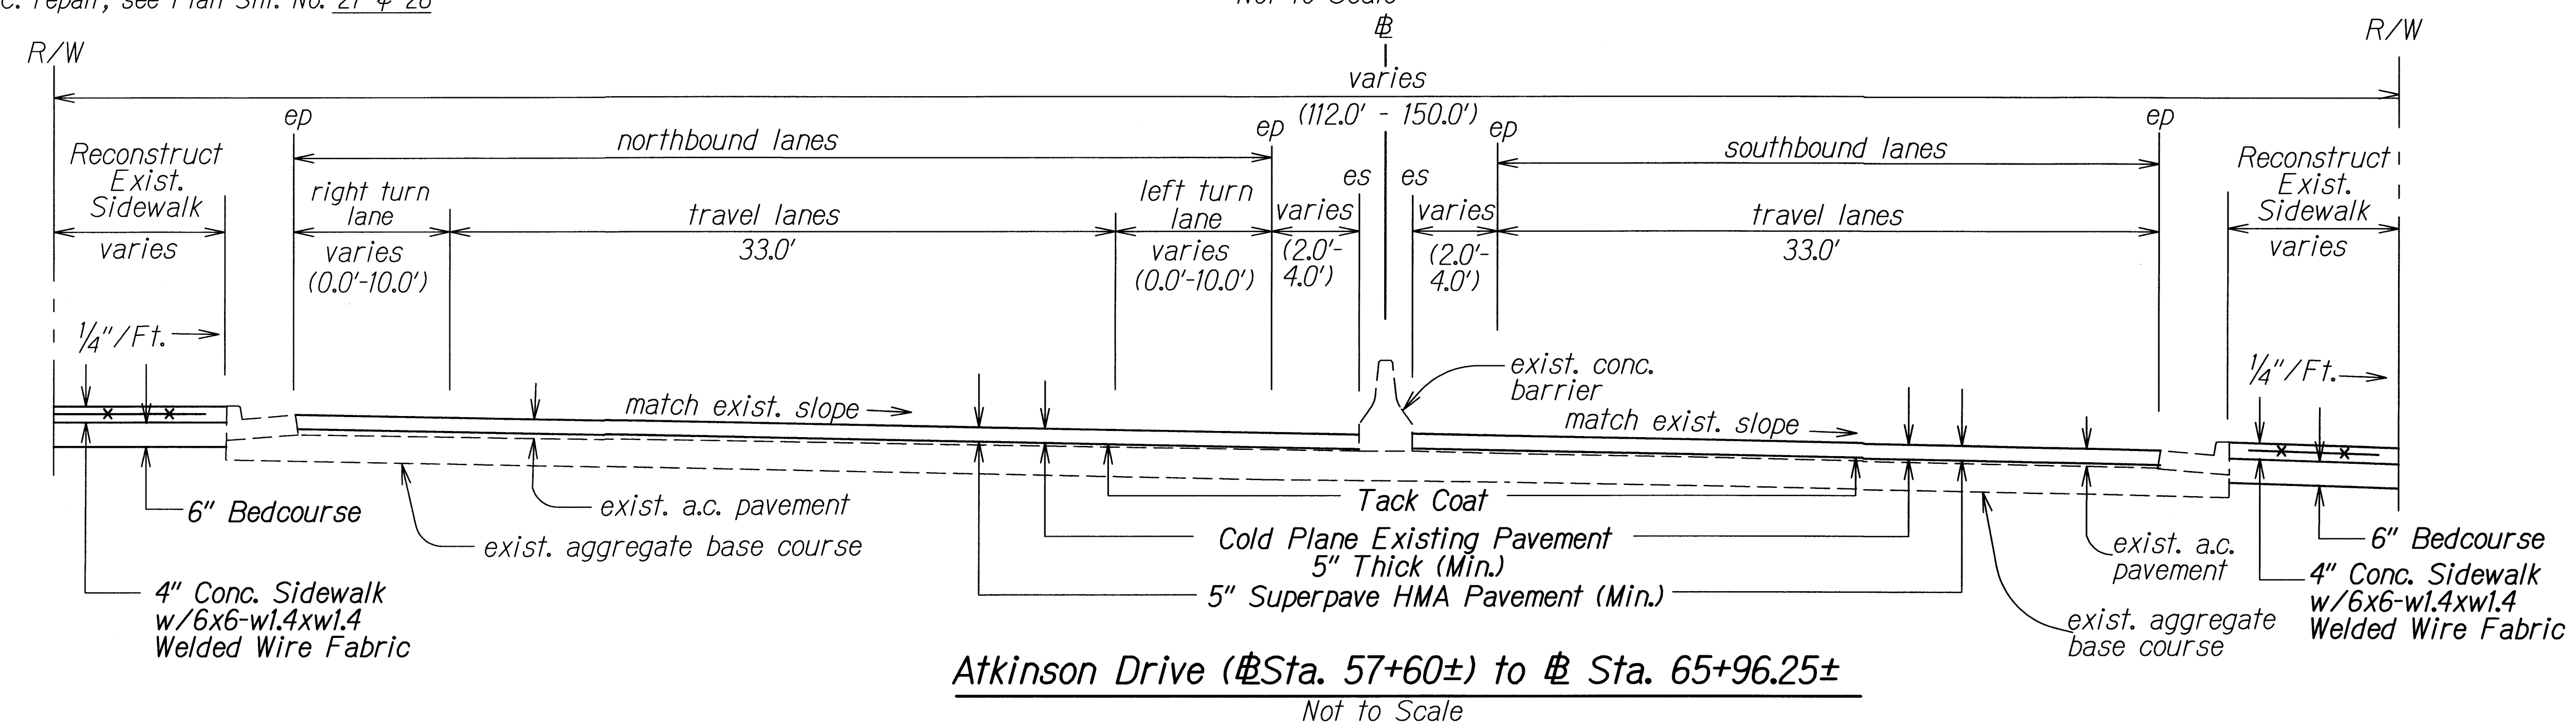

PARTIAL TYPICAL SECTION
I.B. @ Sta. 42+73± - I.B. @ Sta. 44+05±
Not to Scale

- Notes:
1. *For limits of sidewalk reconstruction, see Roadway Plans.*
 2. *Pavement Design for Atkinson Drive: Cold Plane Existing pavement, 5" thick (Min.) and use 5" Superpave HMA Pavement (Min.). See Roadway Plan Sheet No. 28, for limits of Resurfacing.*

ORIGINAL PLAN	SURVEY PLOTTED BY _____ DATE _____
	DRAWN BY _____ *
NOTE BOOK	TRACED BY _____ *
d06	DESIGNED BY _____ *
60m0501.dgn	QUANTITIES BY _____ *
	CHECKED BY _____ *


STATE OF HAWAII
DEPARTMENT OF TRANSPORTATION
HIGHWAYS DIVISION

TYPICAL SECTION
NIMITZ HIGHWAY AND
ALA MOANA BOULEVARD RESURFACING
AND HIGHWAY LIGHTING REPLACEMENT
Fort Street to Kalakaua Avenue
Federal Aid Project No. NH-092-K27)


Scale: Not to Scale Date: March 2008

SHEET No. 1 OF 3 SHEETS

FED. ROAD DIST. NO.	STATE	PROJ. NO.	FISCAL YEAR	SHEET NO.	TOTAL SHEETS
HAWAII	HAW.	NH-092-1(27)	2009	15R	302

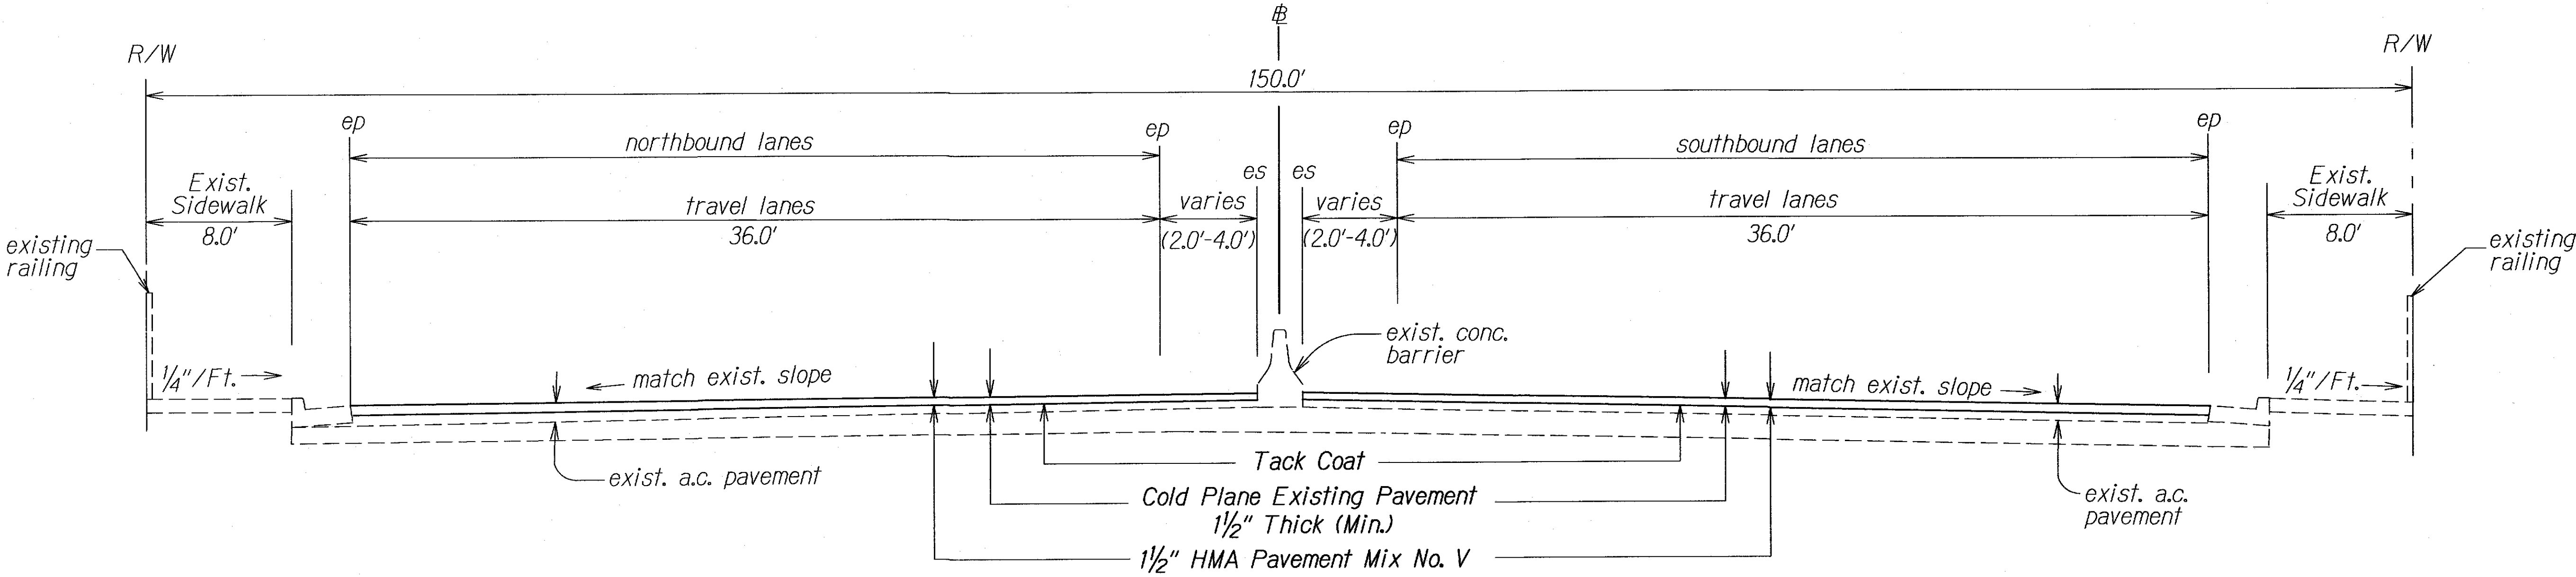

Ala Wai Canal Bridge
 # Sta. 65+96.25± to # Sta. 67+62.94±
 Not to Scale

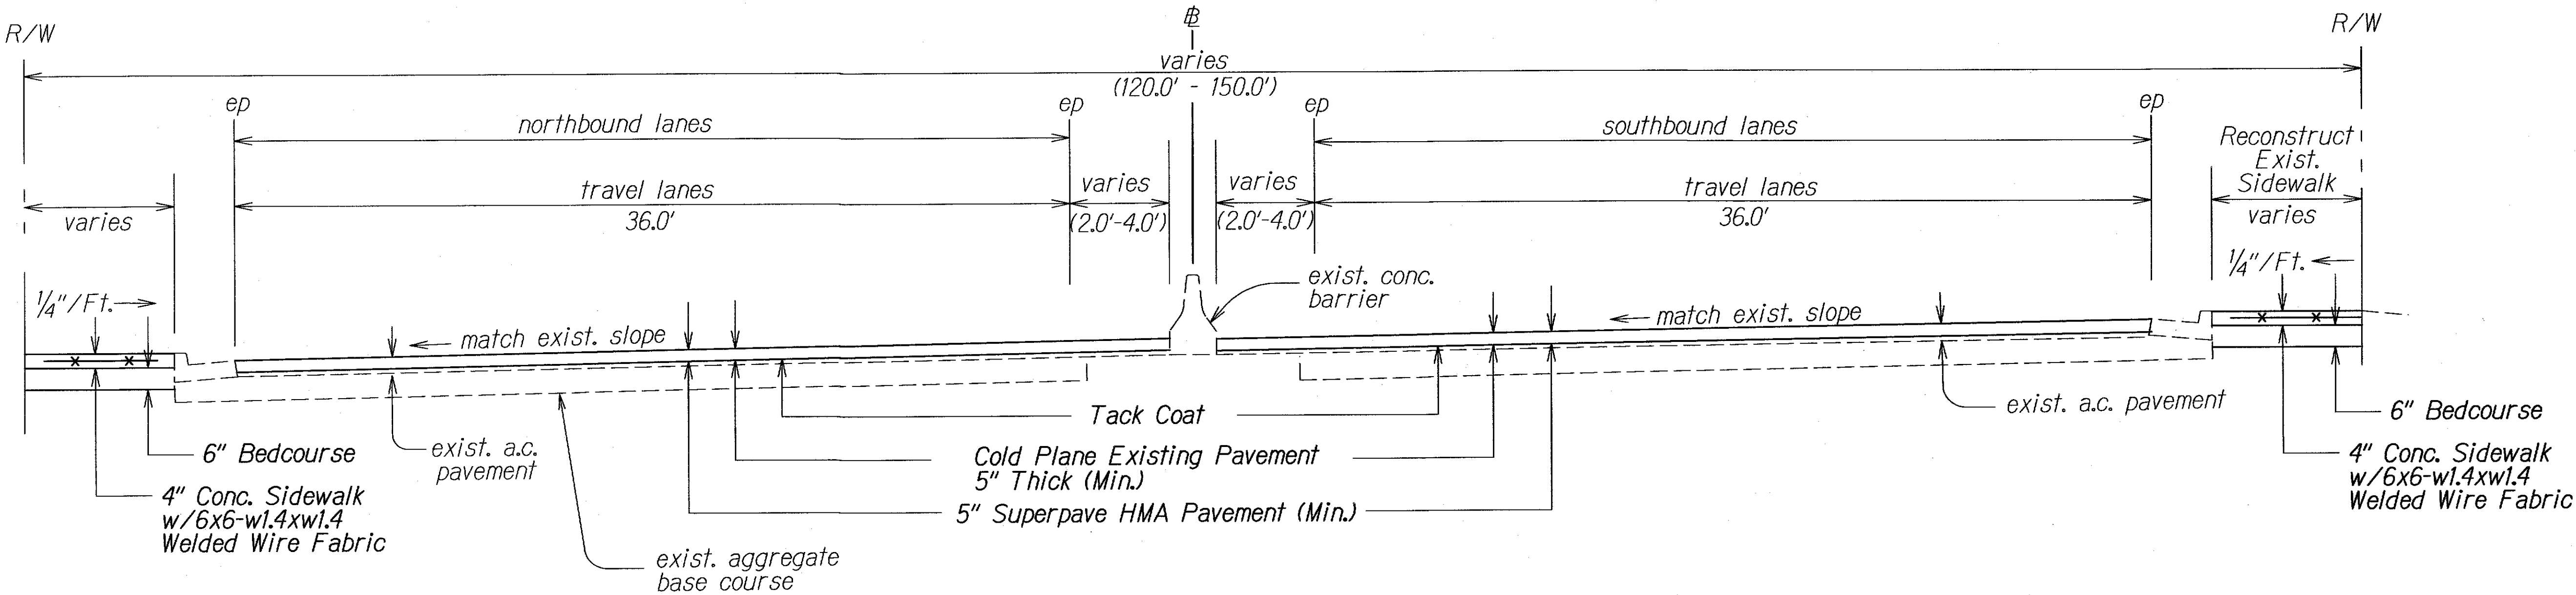

Sta. 67+62.94± to # Sta. 71+00±
 Not to Scale

Note: For limits of sidewalk reconstruction, see Roadway Plans.

2/11/10	Revise pavement mix for Ala Wai canal bridge.
DATE	REVISION


STATE OF HAWAII
DEPARTMENT OF TRANSPORTATION
HIGHWAYS DIVISION

TYPICAL SECTION
NIMITZ HIGHWAY AND
ALA MOANA BOULEVARD RESURFACING
AND HIGHWAY LIGHTING REPLACEMENT
Fort Street to Kalakaua Avenue
Federal Aid Project No. NH-092-1(27)
Scale: Not to Scale Date: March 2008

SHEET No. 2 OF 3 SHEETS


SURVEY PLOTTED BY	DATE
DESIGNED BY	
DESIGNED BY	
QUANTITIES BY	
CHECKED BY	
ORIGINAL PLAN	
NOTE BOOK	
6/10/08	
6/10/08	

FED. ROAD DIST. NO.	STATE	PROJ. NO.	FISCAL YEAR	SHEET NO.	TOTAL SHEETS
HAWAII	HAW.	NH-092-1(27)	2009	ADD. 16	302

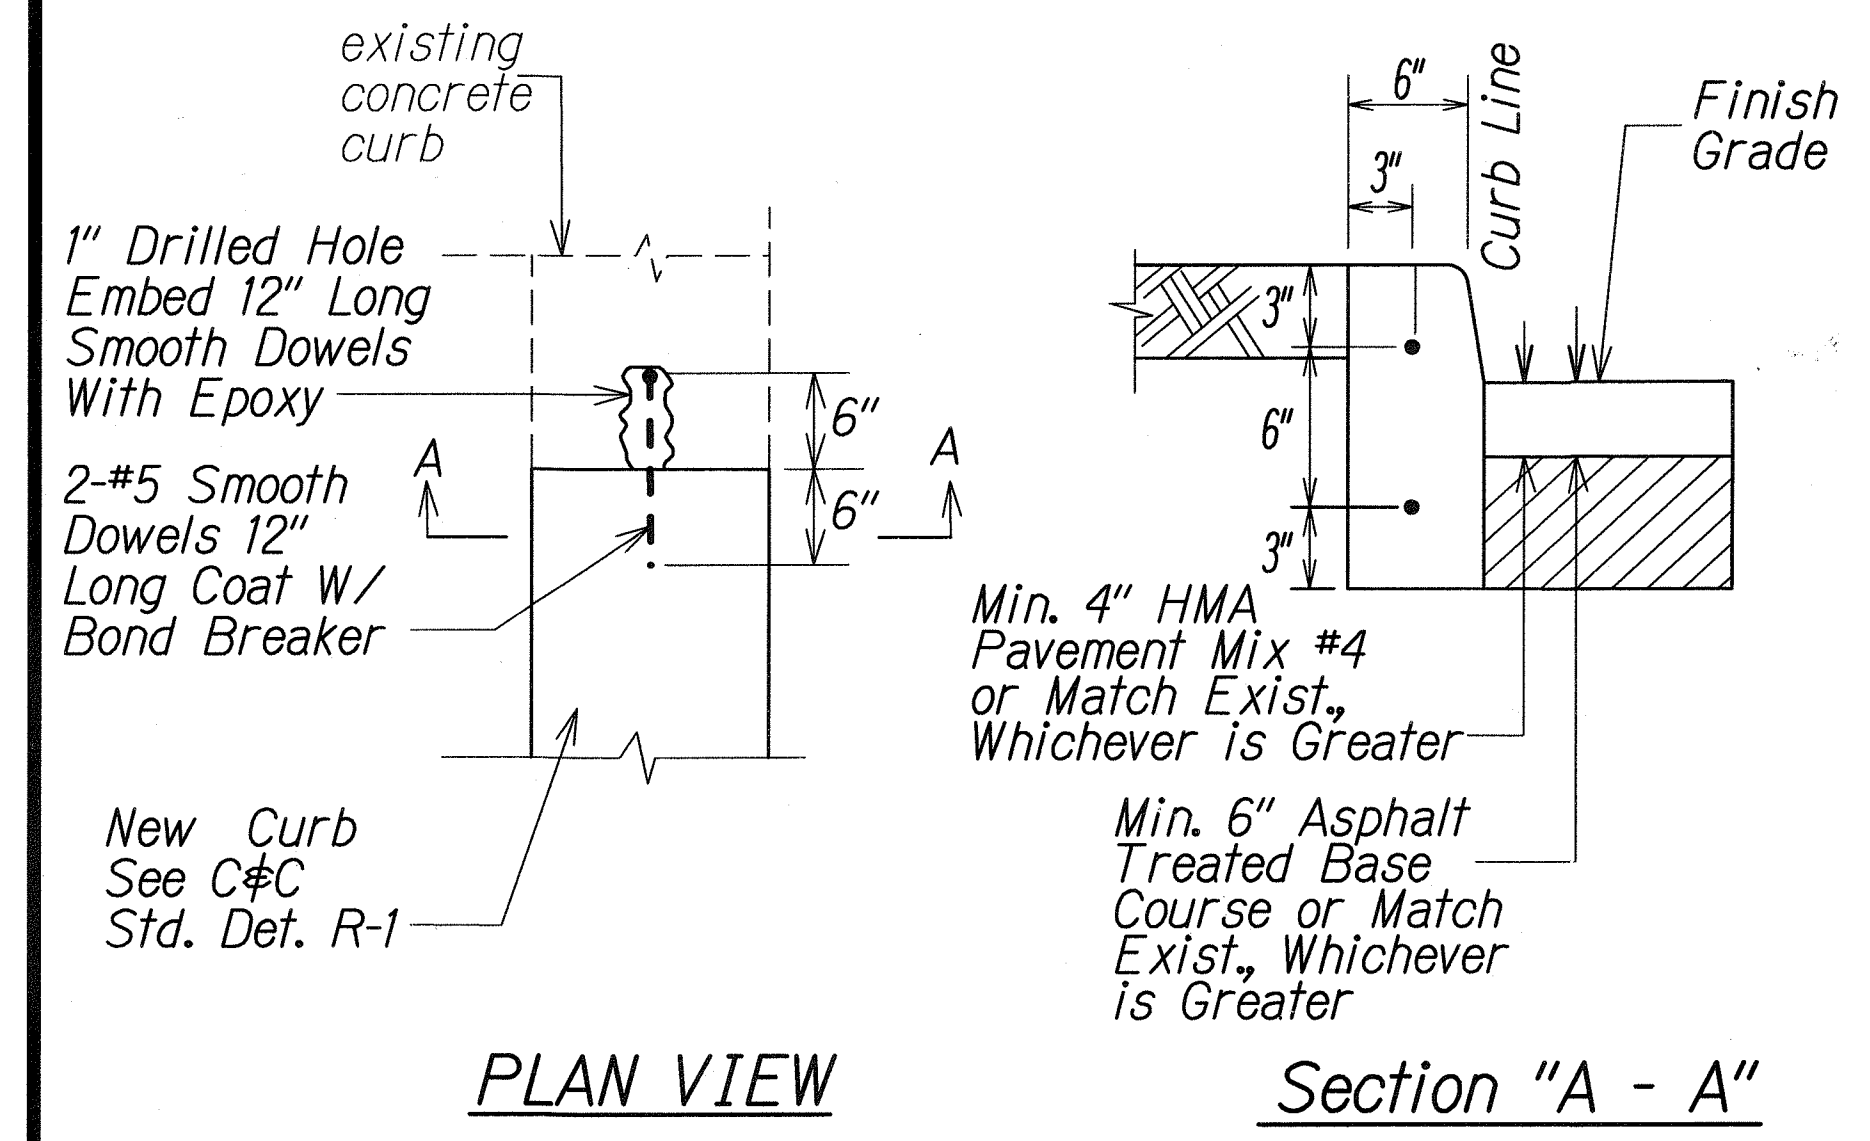


PLAN VIEW Section "A - A"

CITY & COUNTY CAST IN PLACE CURB
Not to Scale

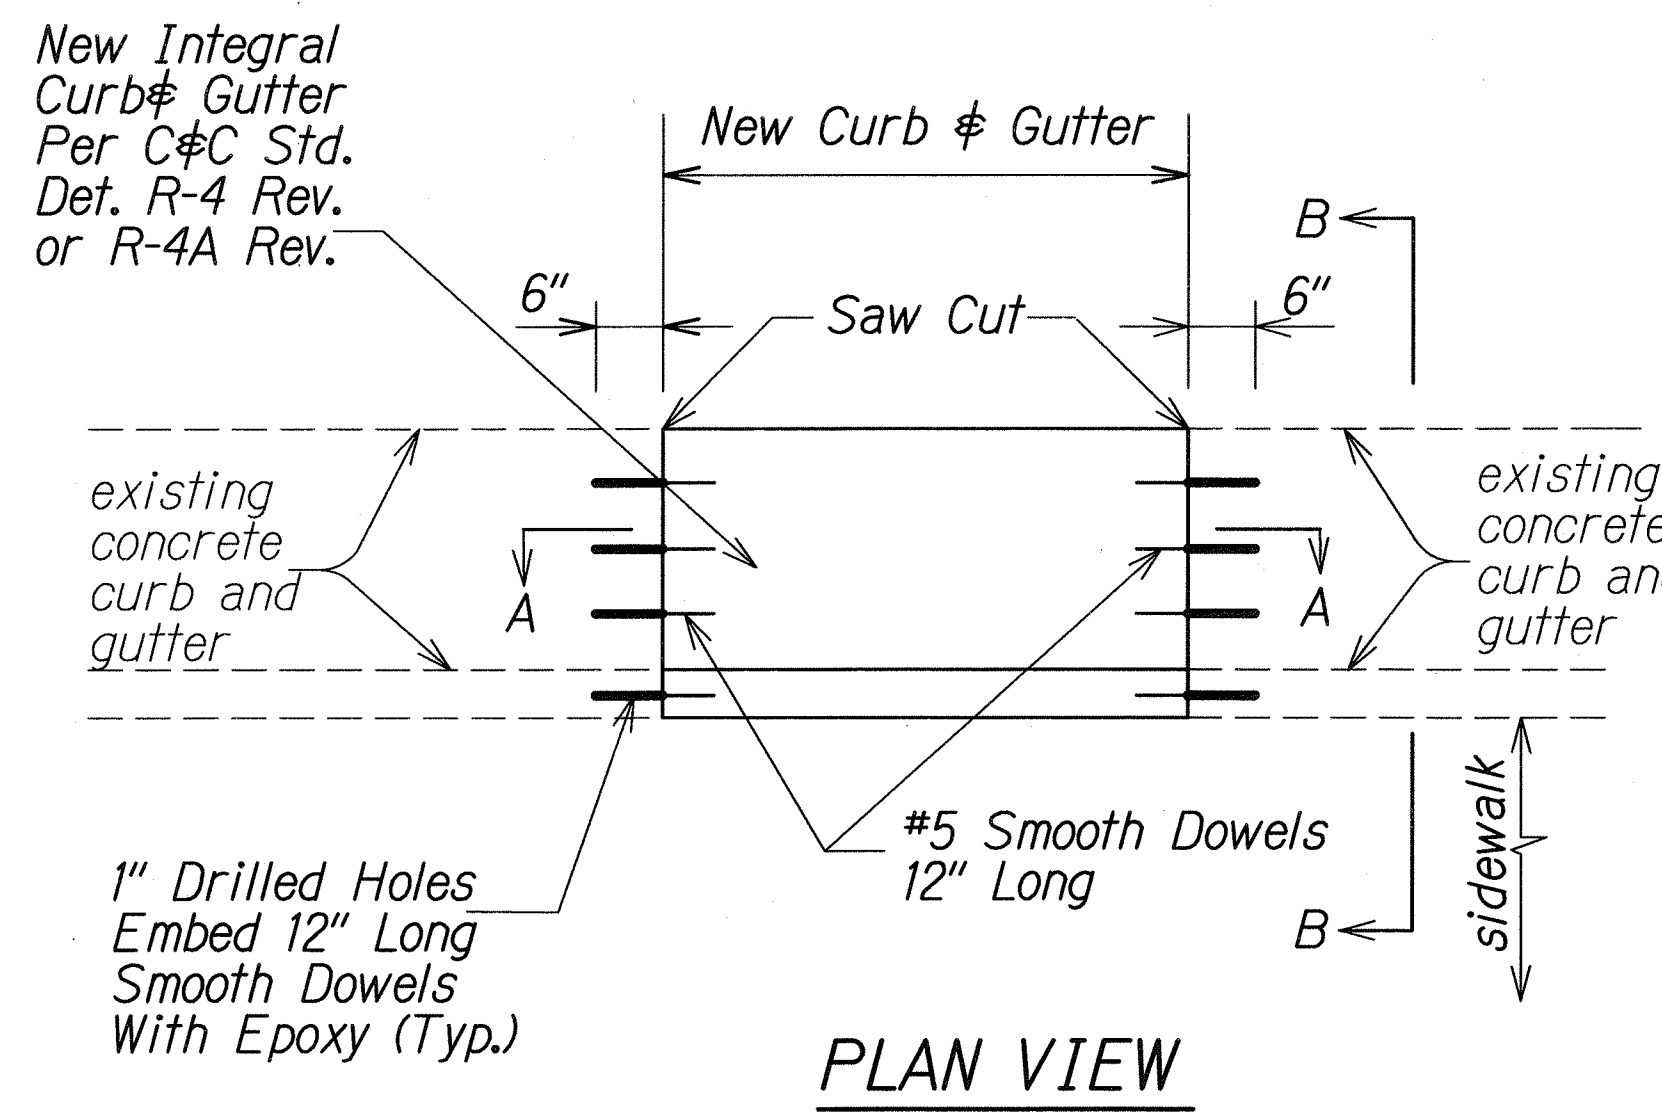


PLAN VIEW


CITY & COUNTY CAST IN PLACE CURB & GUTTER
Not to Scale

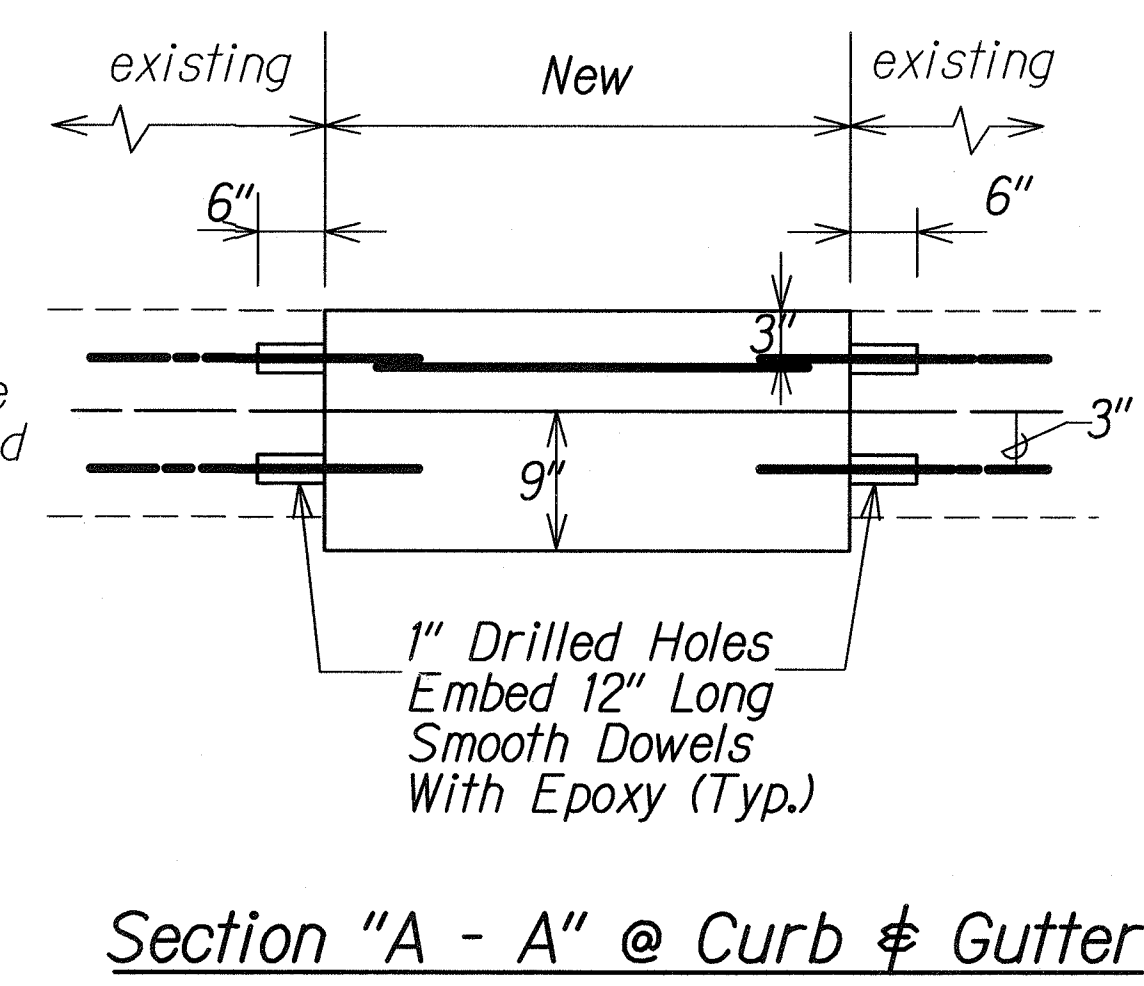


Section "A - A" @ Curb & Gutter

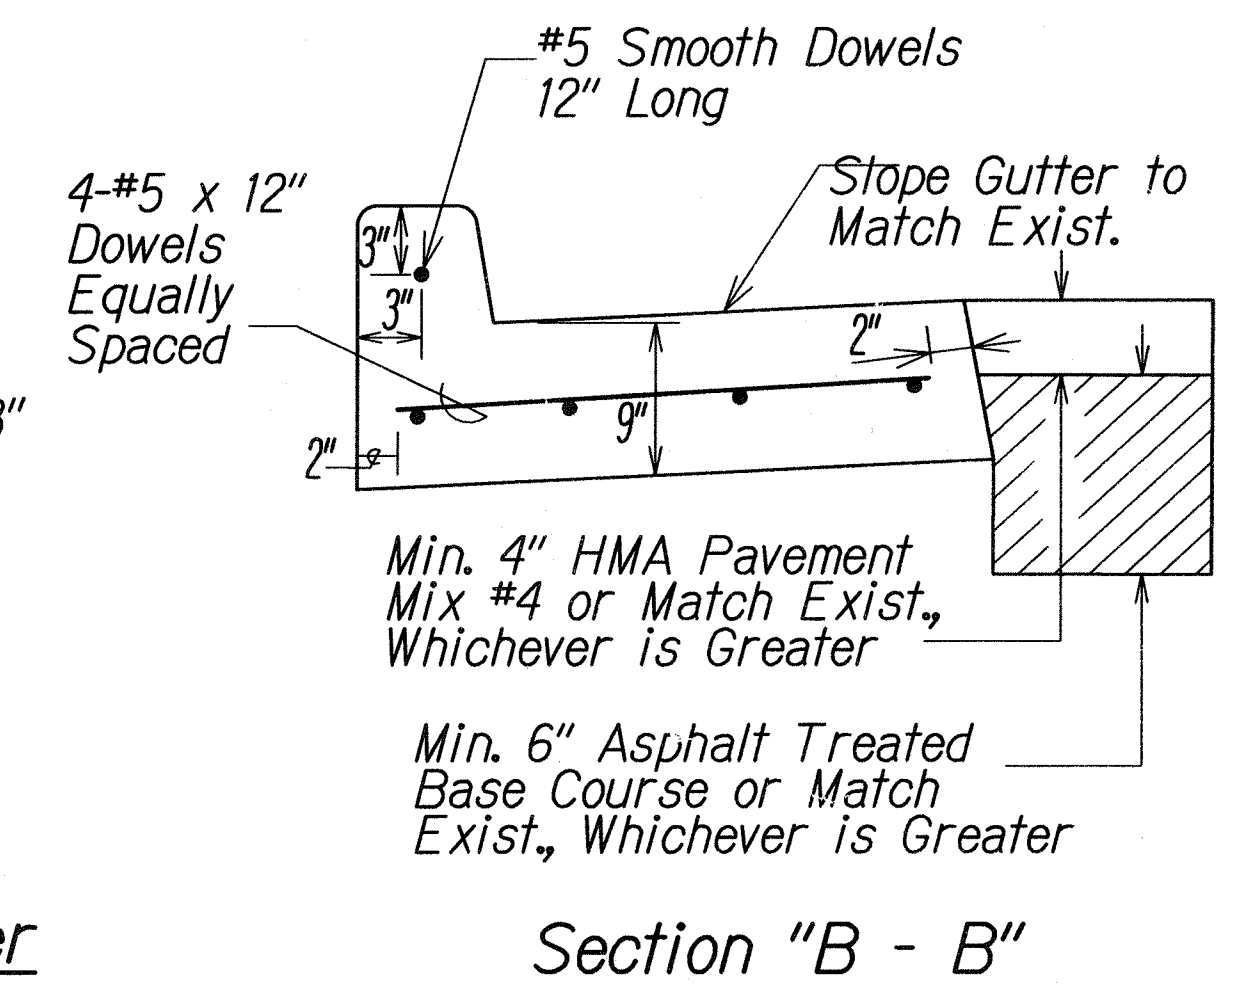


Section "B - B"

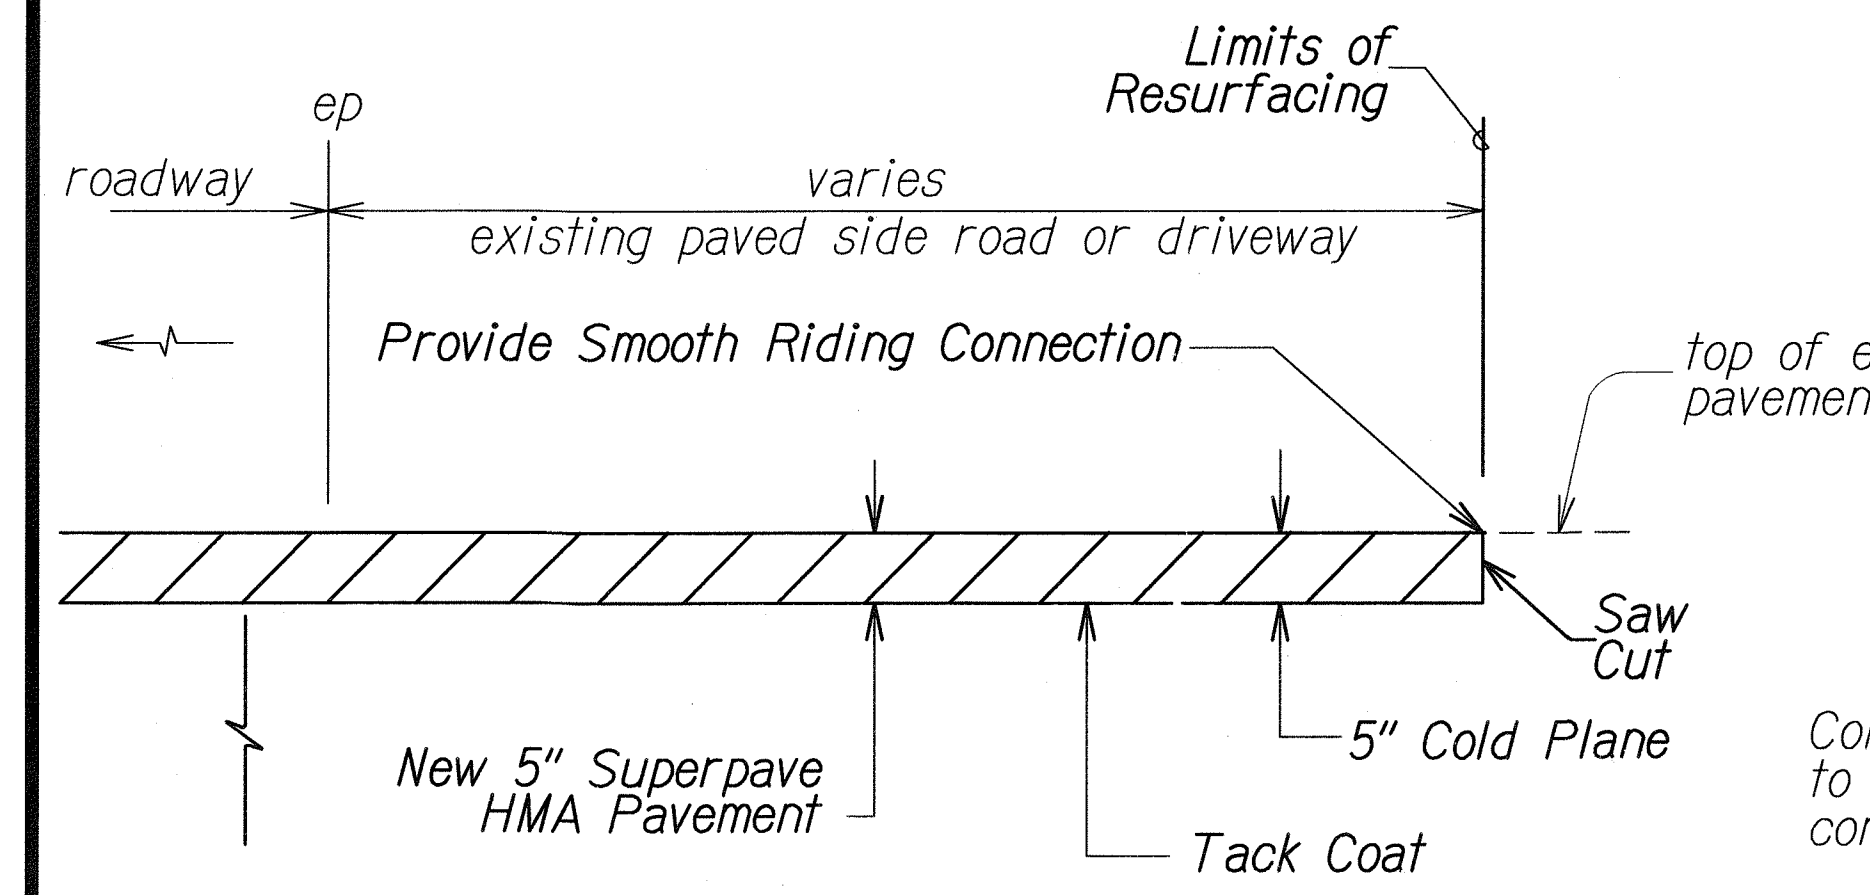


A.C. RESURFACING AT PAVED SIDE ROAD OR PAVED DRIVEWAY DETAIL (STATE)
Not to Scale

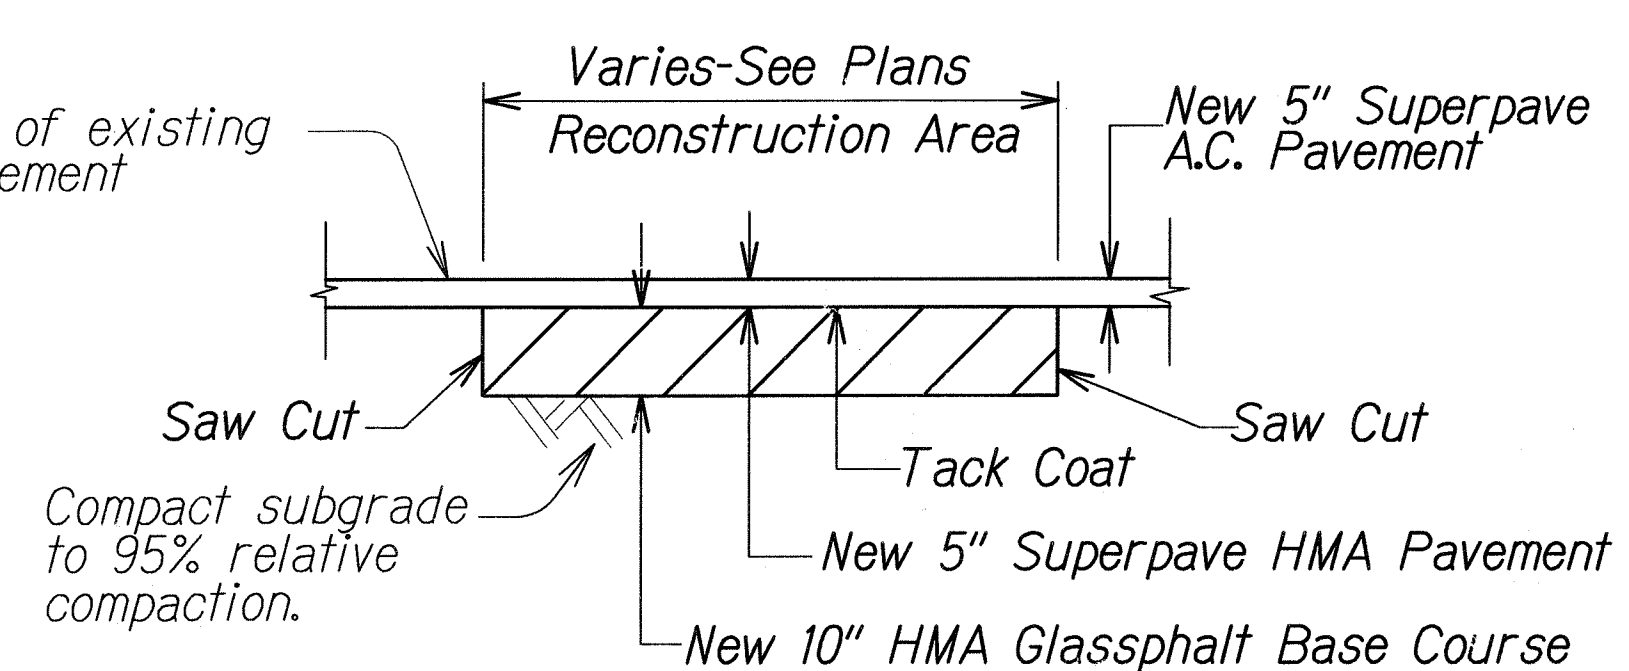

A.C. PAVEMENT RECONSTRUCTION DETAIL (STATE)
Not to Scale

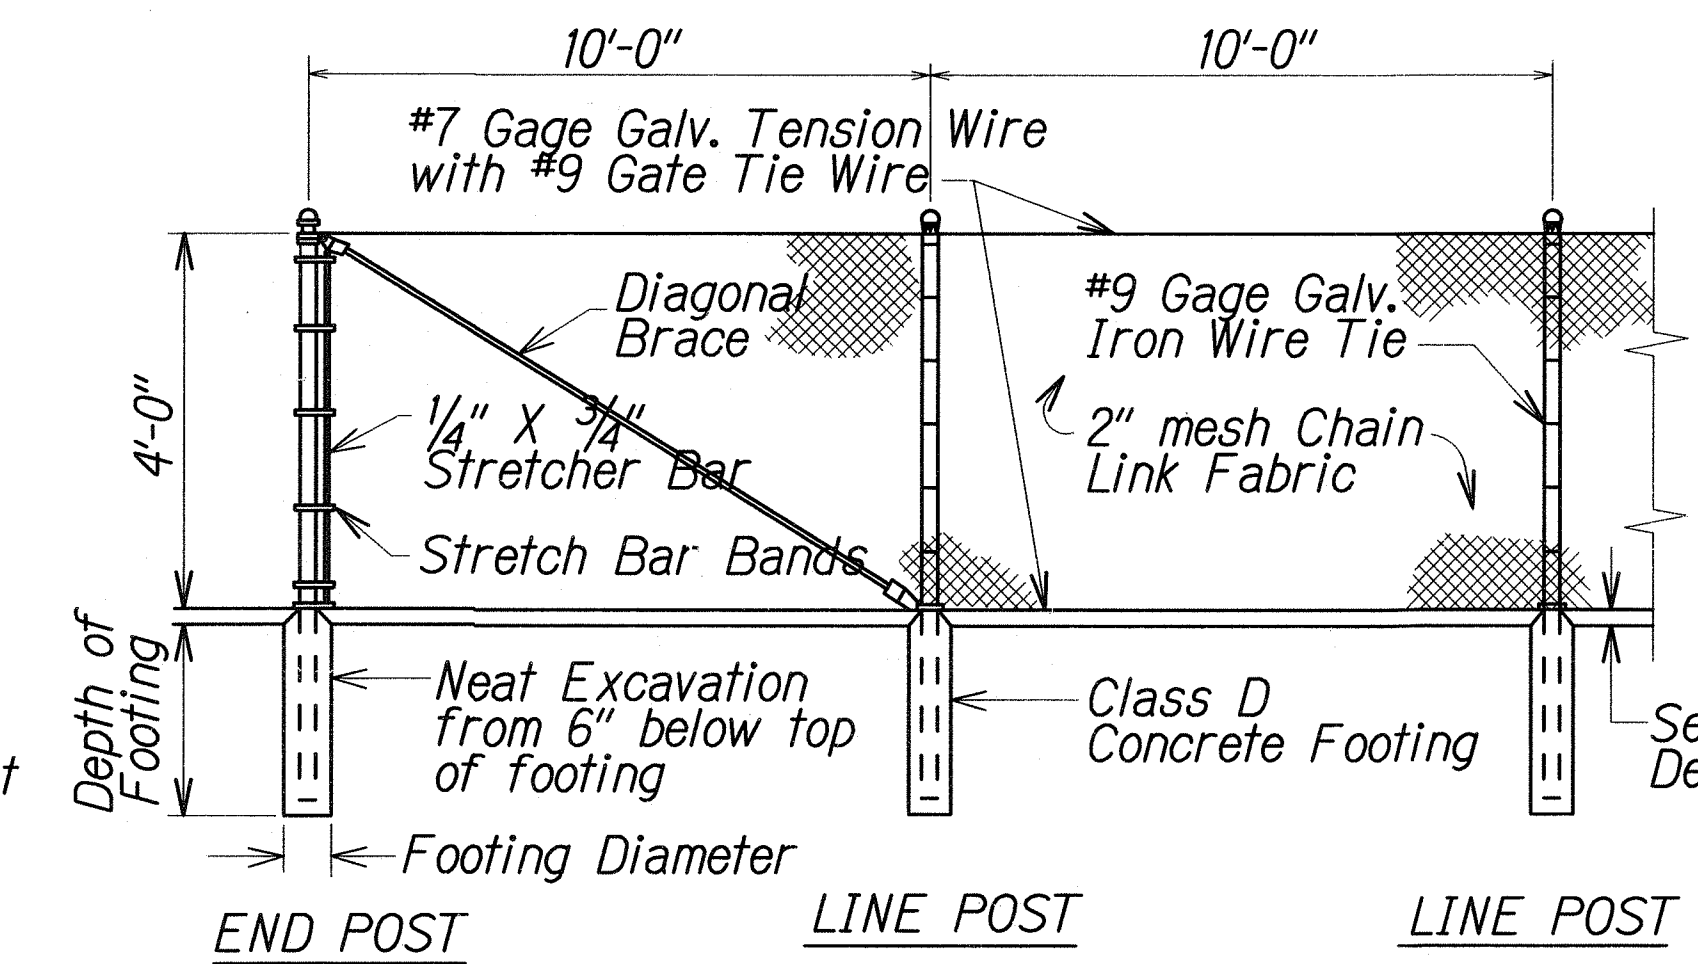


CHAIN LINK FENCE DETAILS (STATE)
Not to Scale

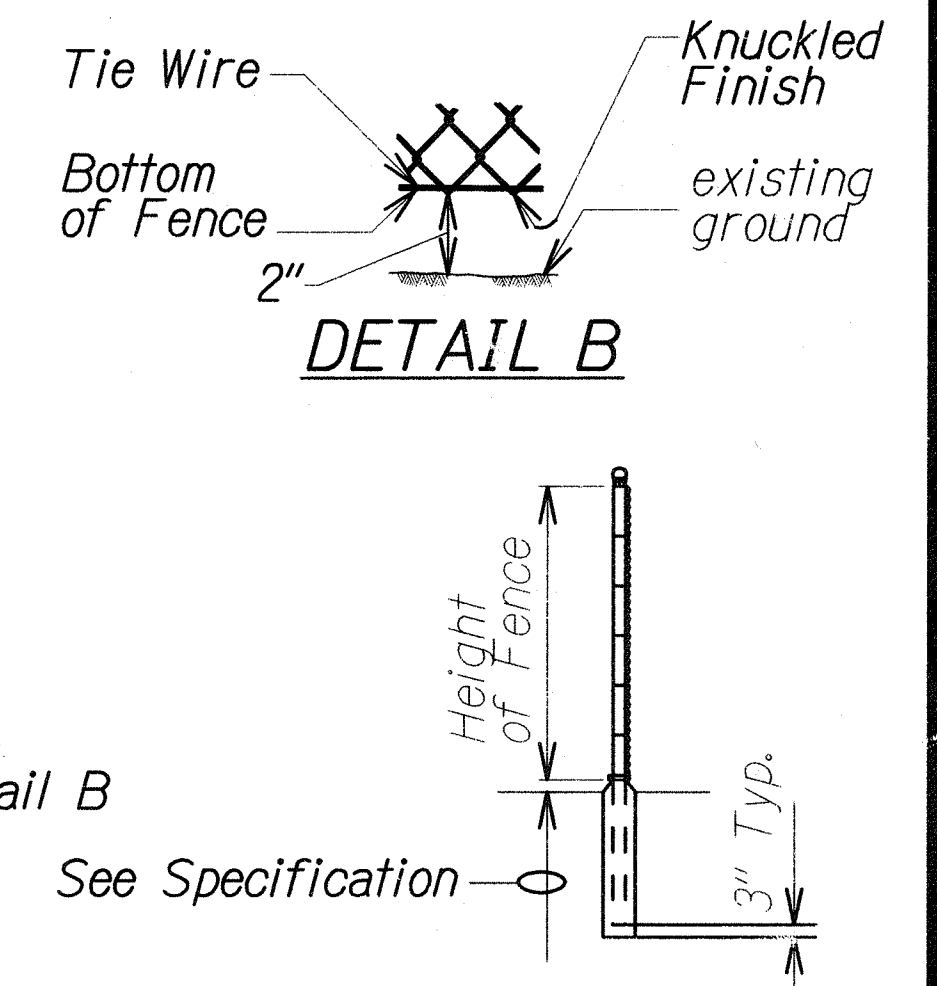


TYPICAL SECTION (With Concrete Footing)


Note: Chain Link Fence without Toprail to be used within Clear Zone.

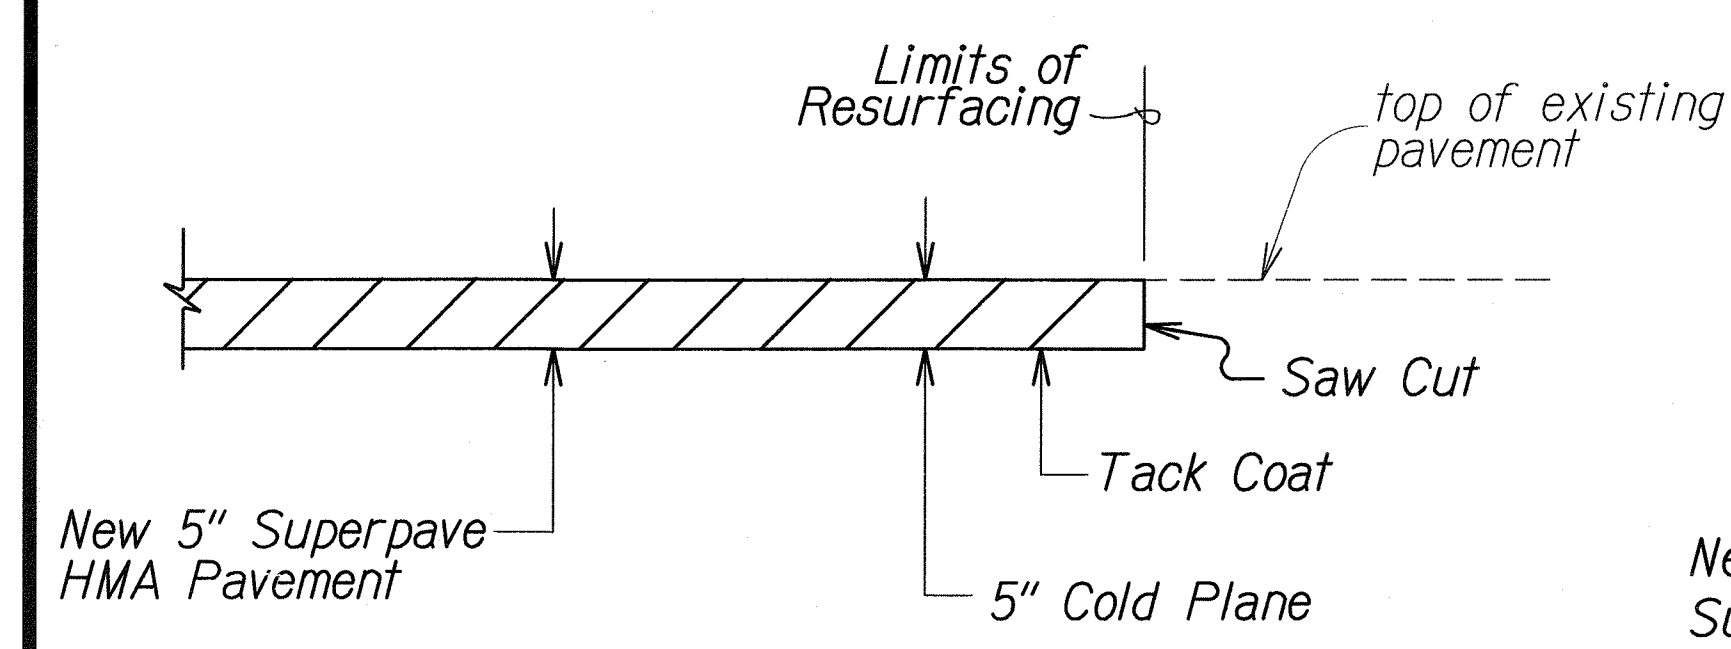

TRANSITION TO EXISTING A.C. PAVEMENT BEGIN AND END PROJECT (STATE)
Not to Scale

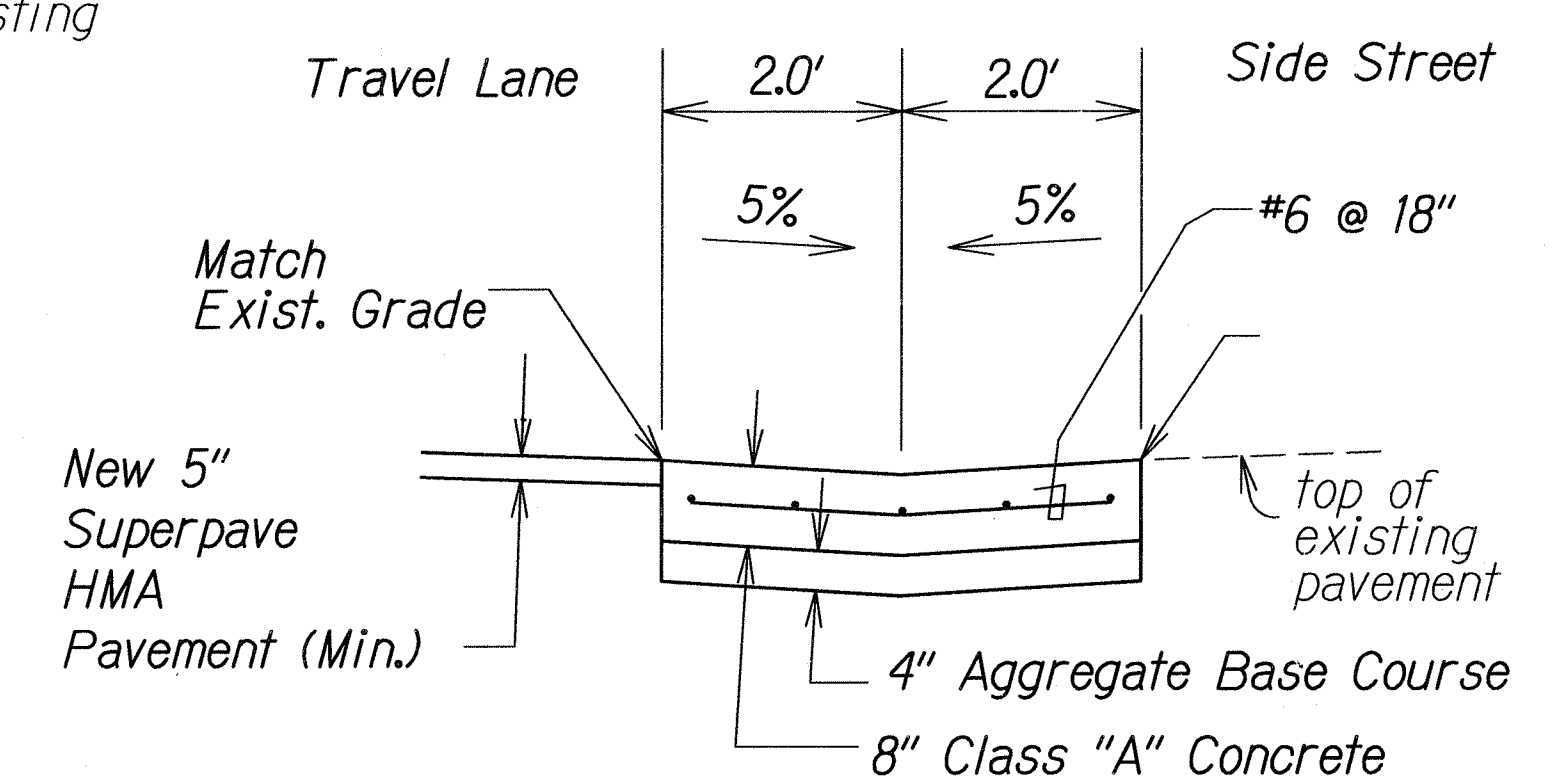

TYPICAL DETAIL THRU GUTTER (STATE)
Not to Scale

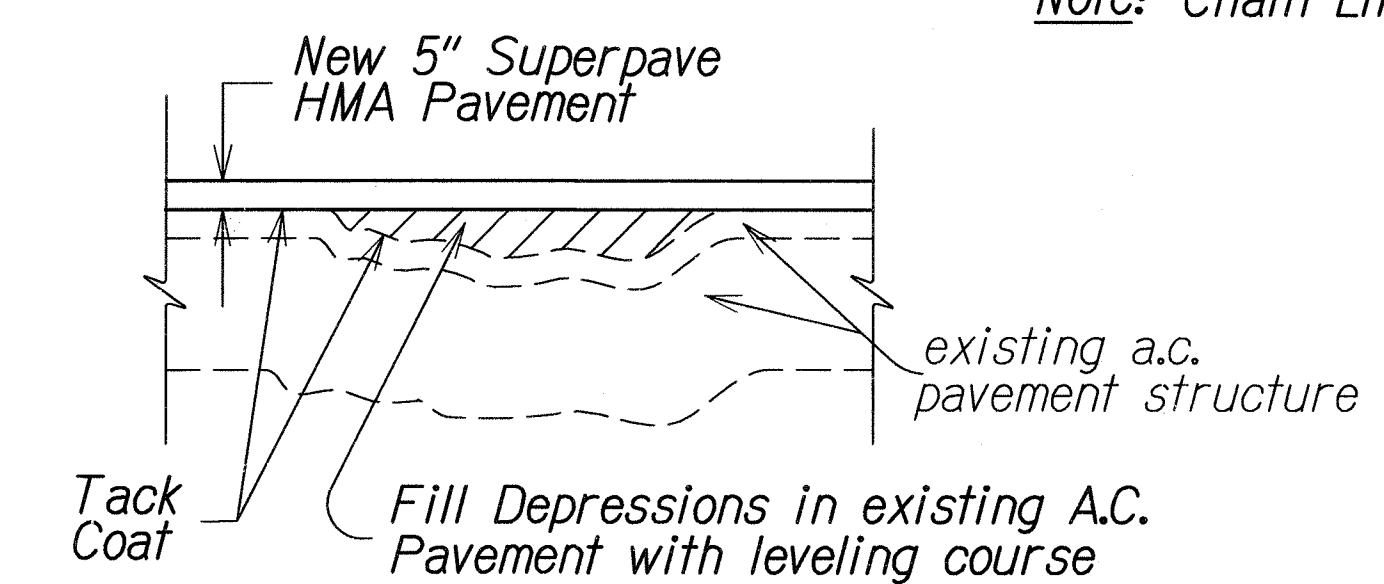

LEVELING COURSE DETAIL (STATE)
Not To Scale

Approved :
M. [Signature]
CHIEF, CIVIL ENGINEERING BRANCH, DPBL Date 1/29/10
(For work within City R/W only)

1/14/2010	Add City and County Cast in Place Curb Detail and Civil Engineering Branch Approval Signature.
DATE	REVISION
STATE OF HAWAII DEPARTMENT OF TRANSPORTATION HIGHWAYS DIVISION TYPICAL DETAILS NIMITZ HIGHWAY AND ALA MOANA BOULEVARD RESURFACING AND HIGHWAY LIGHTING REPLACEMENT Fort Street to Kalakaua Avenue Federal Aid Project No. NH-092-1(27) Scale: Not to Scale Date: March 2008 SHEET No. 3 OF 3 SHEETS	