
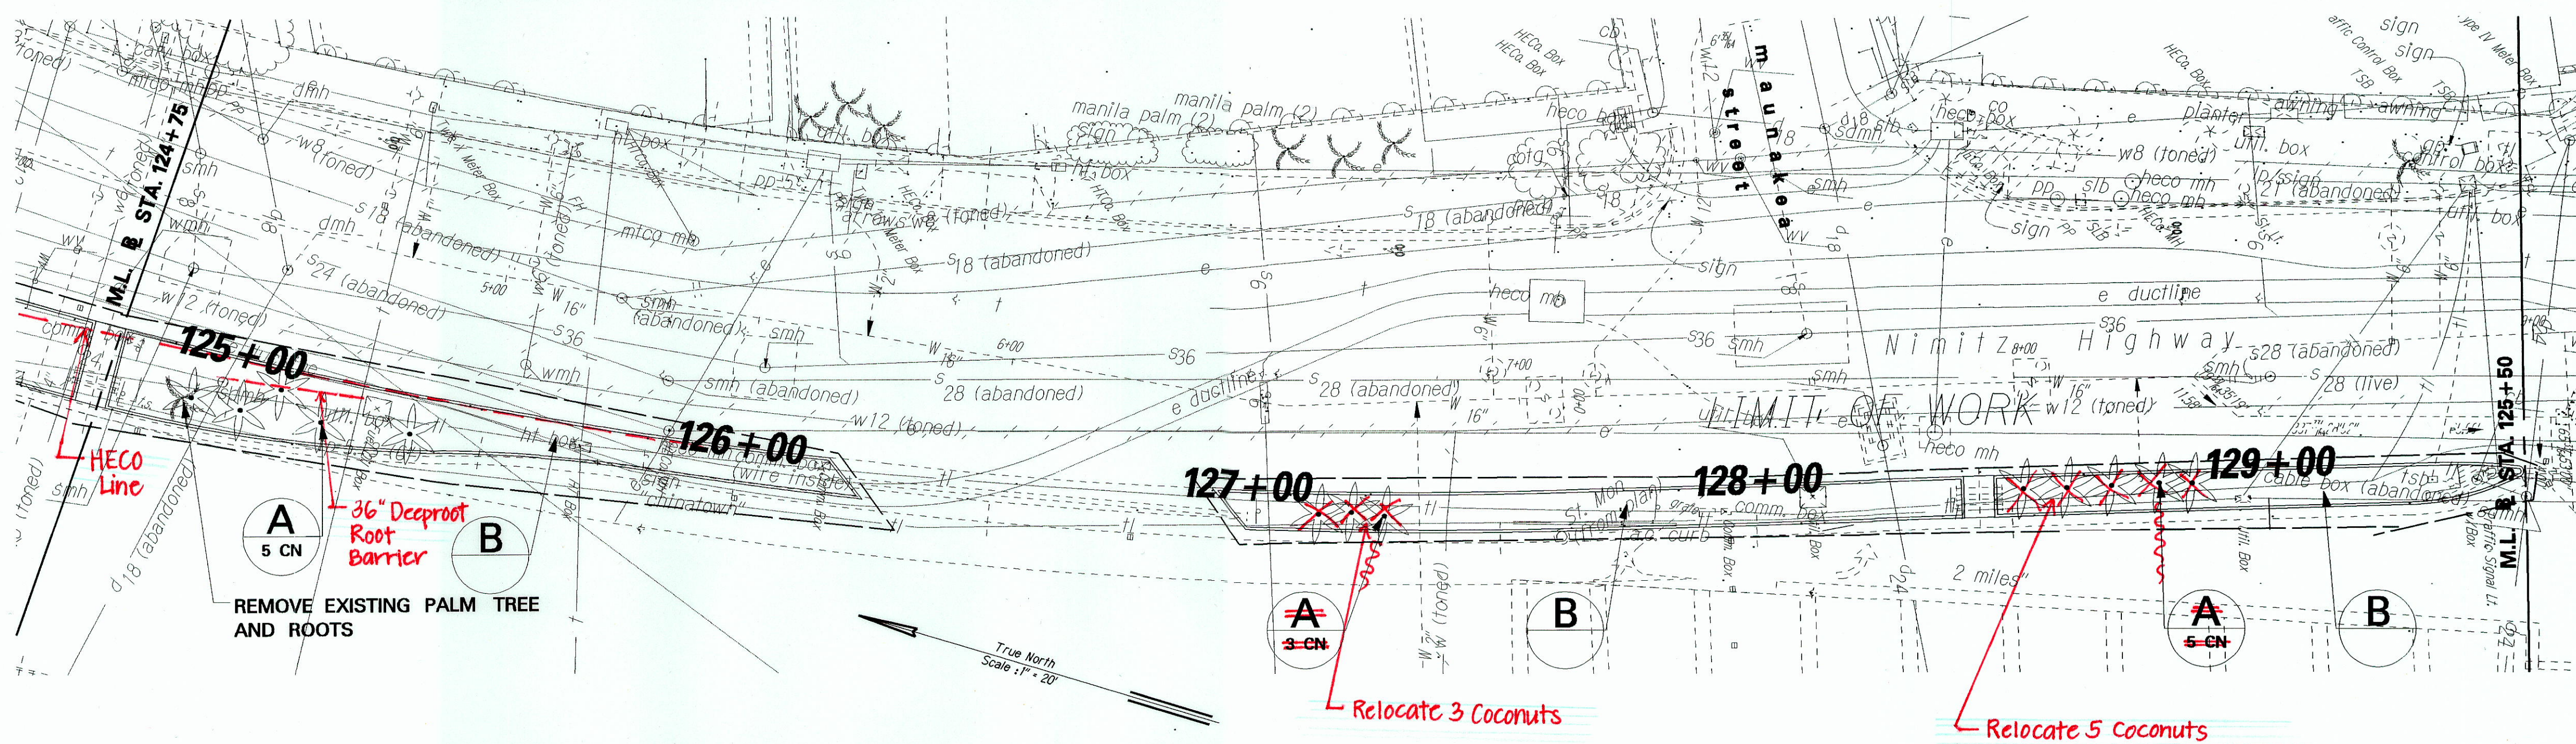


FED. ROAD DIST. NO.	STATE	PROJ. NO.	FISCAL YEAR	SHEET NO.	TOTAL SHEETS
HAWAII	HAW.	92A-01-07M	2007	7	17

Note: For next project with excavation work in the median of Nimitz Highway, contact HECO for actual fuel line location.

BEGIN PROJECT
Project No. 92A-01-07M
Sta. 120+10

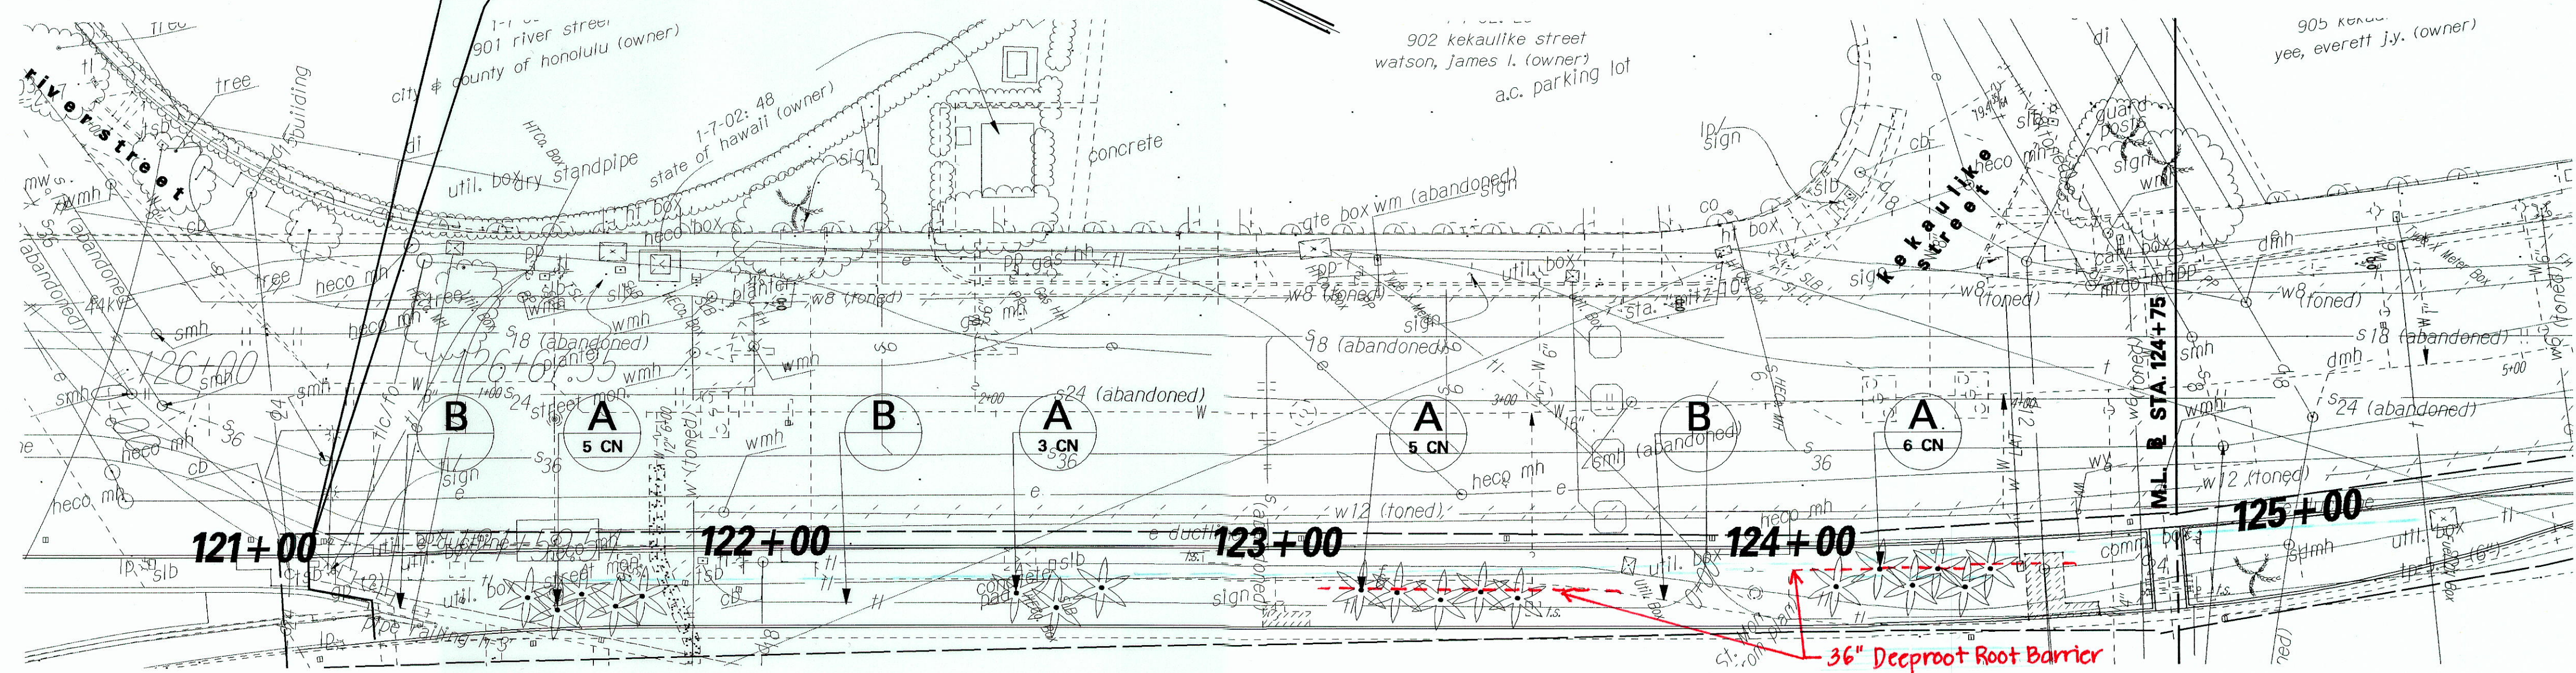

REMOVE EXISTING PALM TREE
AND ROOTS

Tree Planting Note:
All trees shall be a minimum of 4' from the HECO Pipeline. A 3' depth deeproot root barrier by 12' long shall be a minimum of 2' from HECO Pipeline on side facing tree. Root barrier shall be installed per the manufacturer's Recommendations. Adjust Irrigation Tree Sprinklers for New Tree Locations Accordingly.

STATE OF HAWAII
DEPARTMENT OF TRANSPORTATION
HIGHWAYS DIVISION

LANDSCAPE PLAN


NIMITZ HIGHWAY BEAUTIFICATION
NUUANU STREAM BRIDGE TO BETHEL STREET
PROJECT NO. 92A-01-07M

Scale: 1" = 20' Date: March, 2007

SHEET No. 7 OF 17 SHEETS

"AS-BUILT"

FED. ROAD DIST. NO.	STATE	PROJ. NO.	FISCAL YEAR	SHEET NO.	TOTAL SHEETS
HAWAII	HAW.	92A-01-07M	2007	7S-1	17

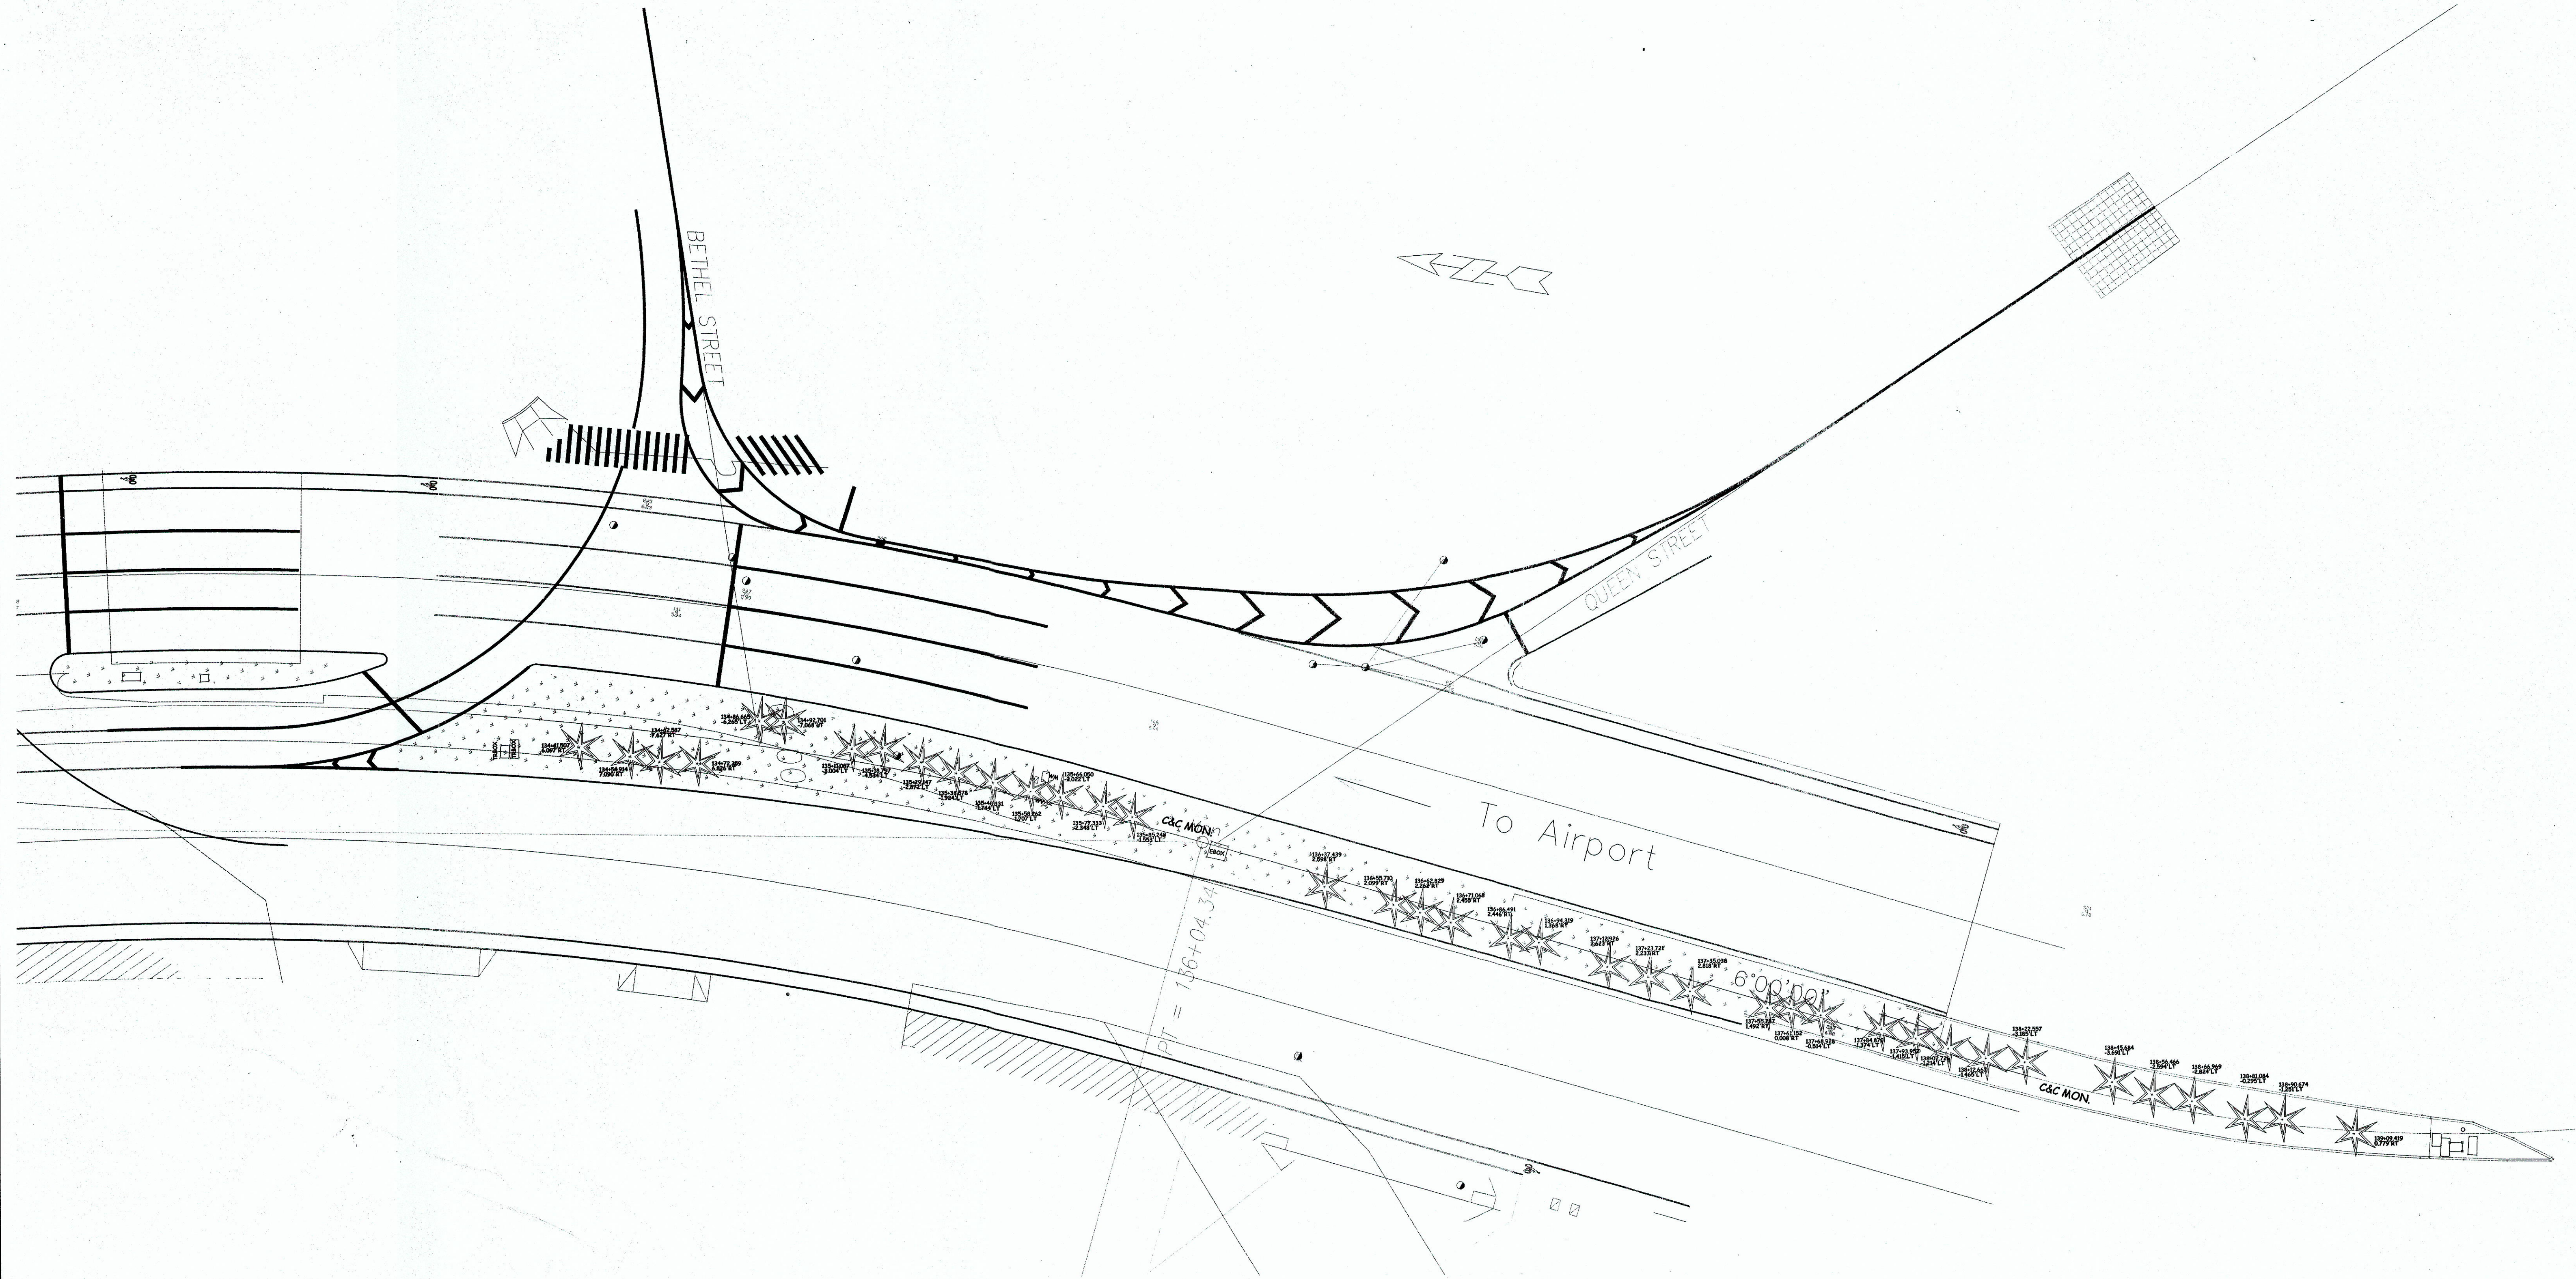

ORIGINAL PLAN	SURVEY PLOTTED BY	DATE
NOTE BOOK	DRAWN BY	
	DESIGNED BY	
	QUANTITIES BY	
	CHECKED BY	

FOR REFERENCE ONLY

STATE OF HAWAII
DEPARTMENT OF TRANSPORTATION
HIGHWAYS DIVISION



LANDSCAPE PLAN

*NIMITZ HIGHWAY BEAUTIFICATION
Nuuanu Stream Bridge to Bethel Street
Project No. 92A-01-07M*

Scale: Not To Scale Date: December 2, 2015

SHEET No. 1 OF 1 SHEETS

FED. ROAD DIST. NO.	STATE	PROJ. NO.	FISCAL YEAR	SHEET NO.	TOTAL SHEETS
HAWAII	HAW.	92A-01-07M	2007	8	17

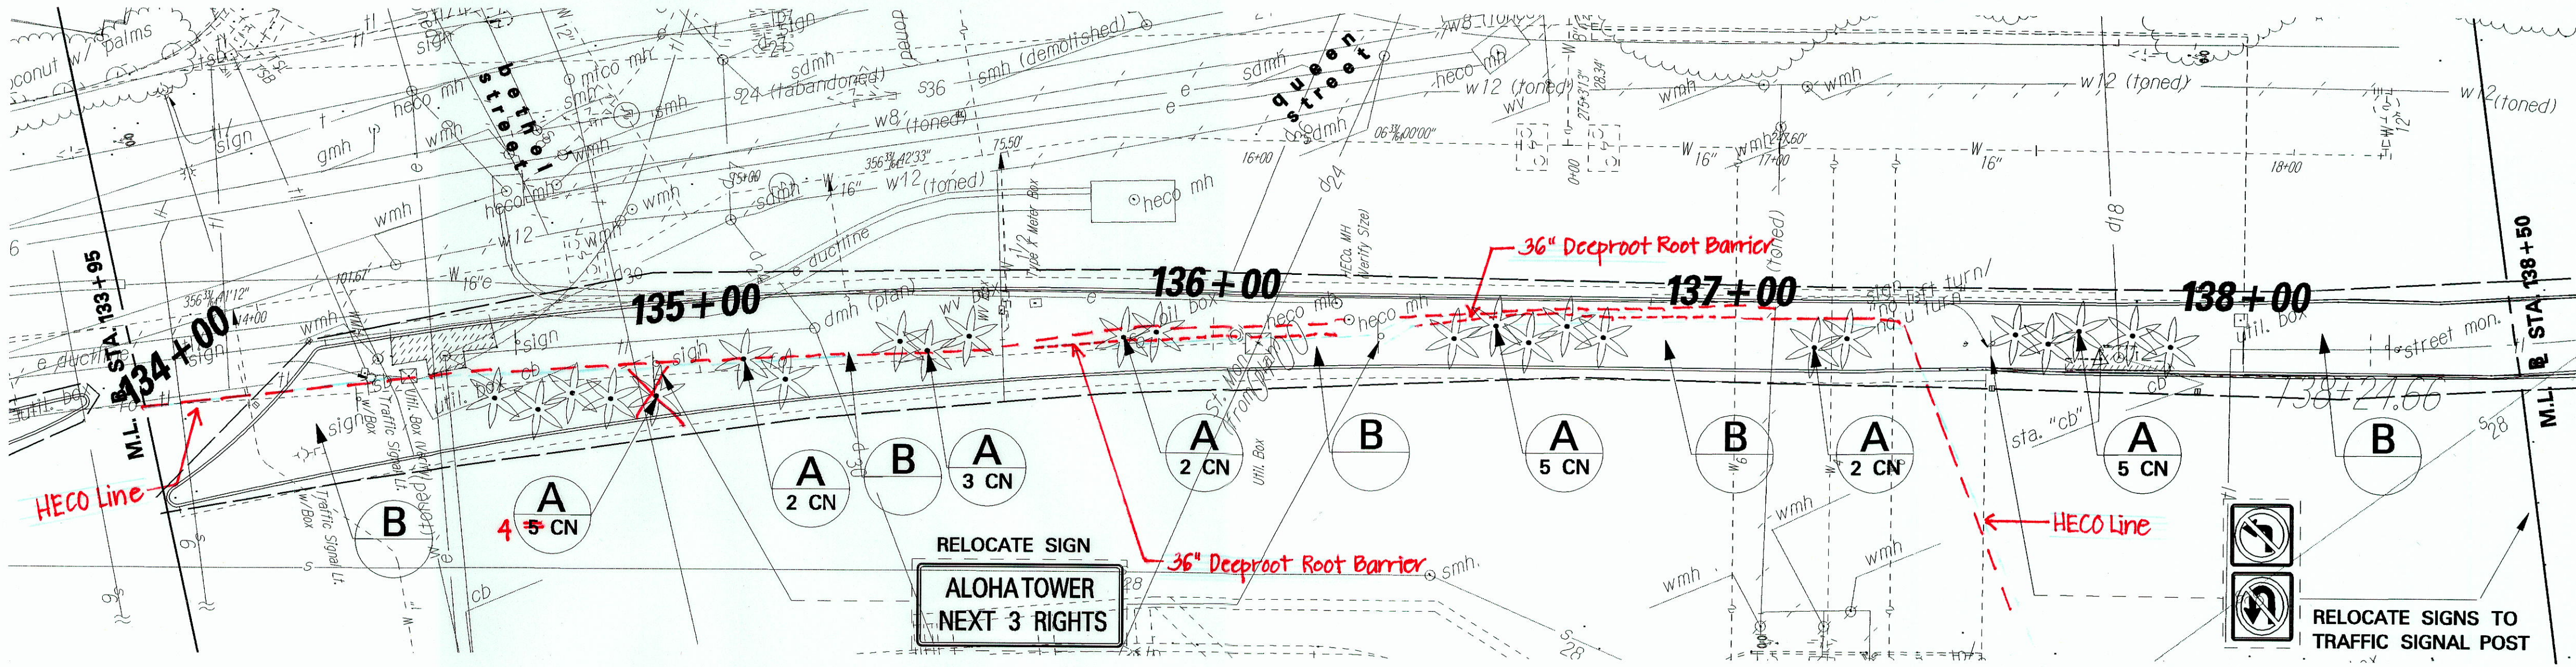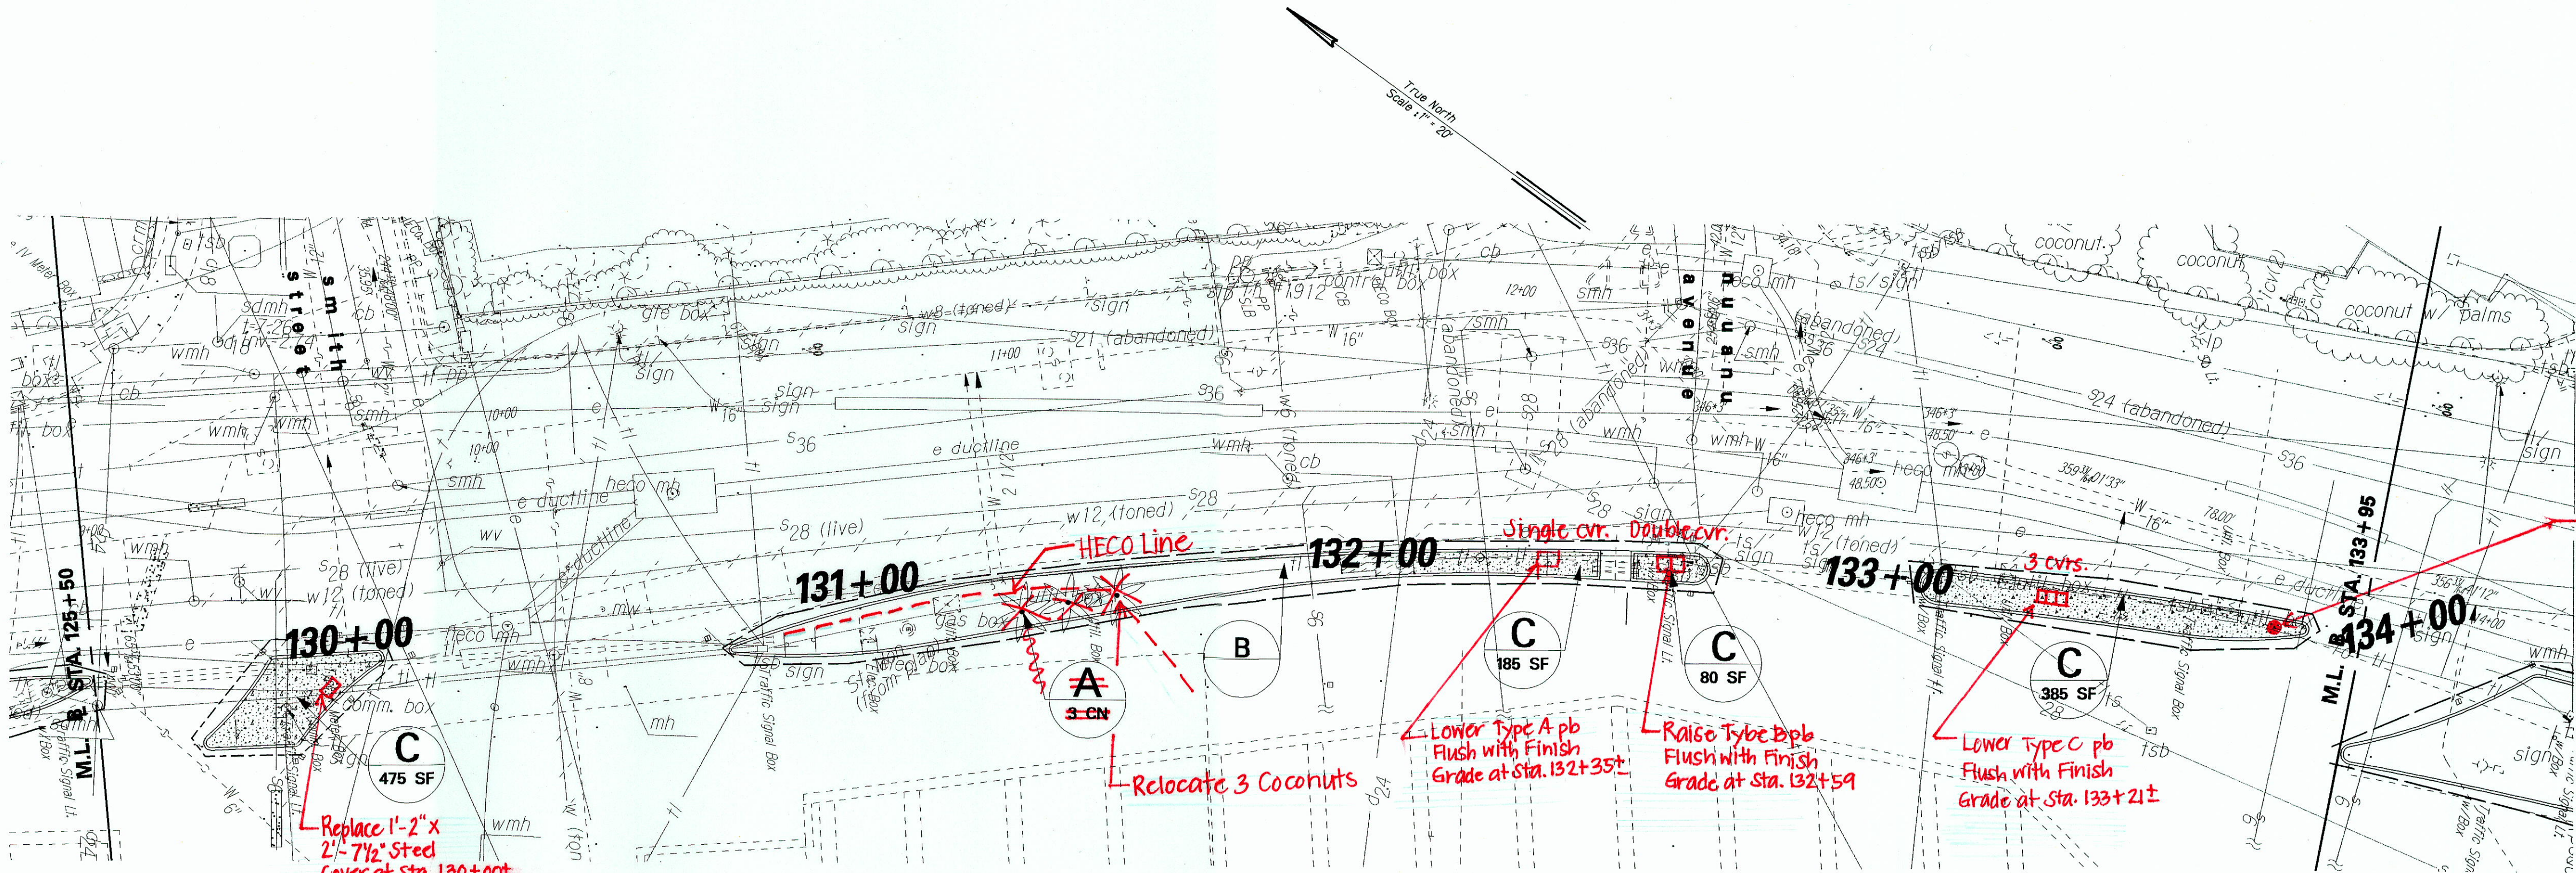

Note: For next project with excavation work in the median of Nimitz Highway, contact HECO for actual fuel line location.

Tree Planting Note:
 All trees shall be a minimum of 4' from the HECO pipeline.
 A 3' depth deeproot root barrier by 12' long shall be used for each tree. Root barrier shall be a minimum of 2' from HECO pipeline on side facing tree. Root barrier shall be installed per the manufacturer's recommendations.
 Adjust irrigation tree sprinklers for new trees location accordingly.


STATE OF HAWAII
DEPARTMENT OF TRANSPORTATION
HIGHWAYS DIVISION

LANDSCAPE PLAN
NIMITZ HIGHWAY BEAUTIFICATION
NUUANU STREAM BRIDGE TO BETHEL STREET
PROJECT NO. 92A-01-07M

Date: March, 2007

"AS-BUILT"

FED. ROAD DIST. NO.	STATE	PROJ. NO.	FISCAL YEAR	SHEET NO.	TOTAL SHEETS
HAWAII	HAW.	92A-01-07M	2007	8S-1	17

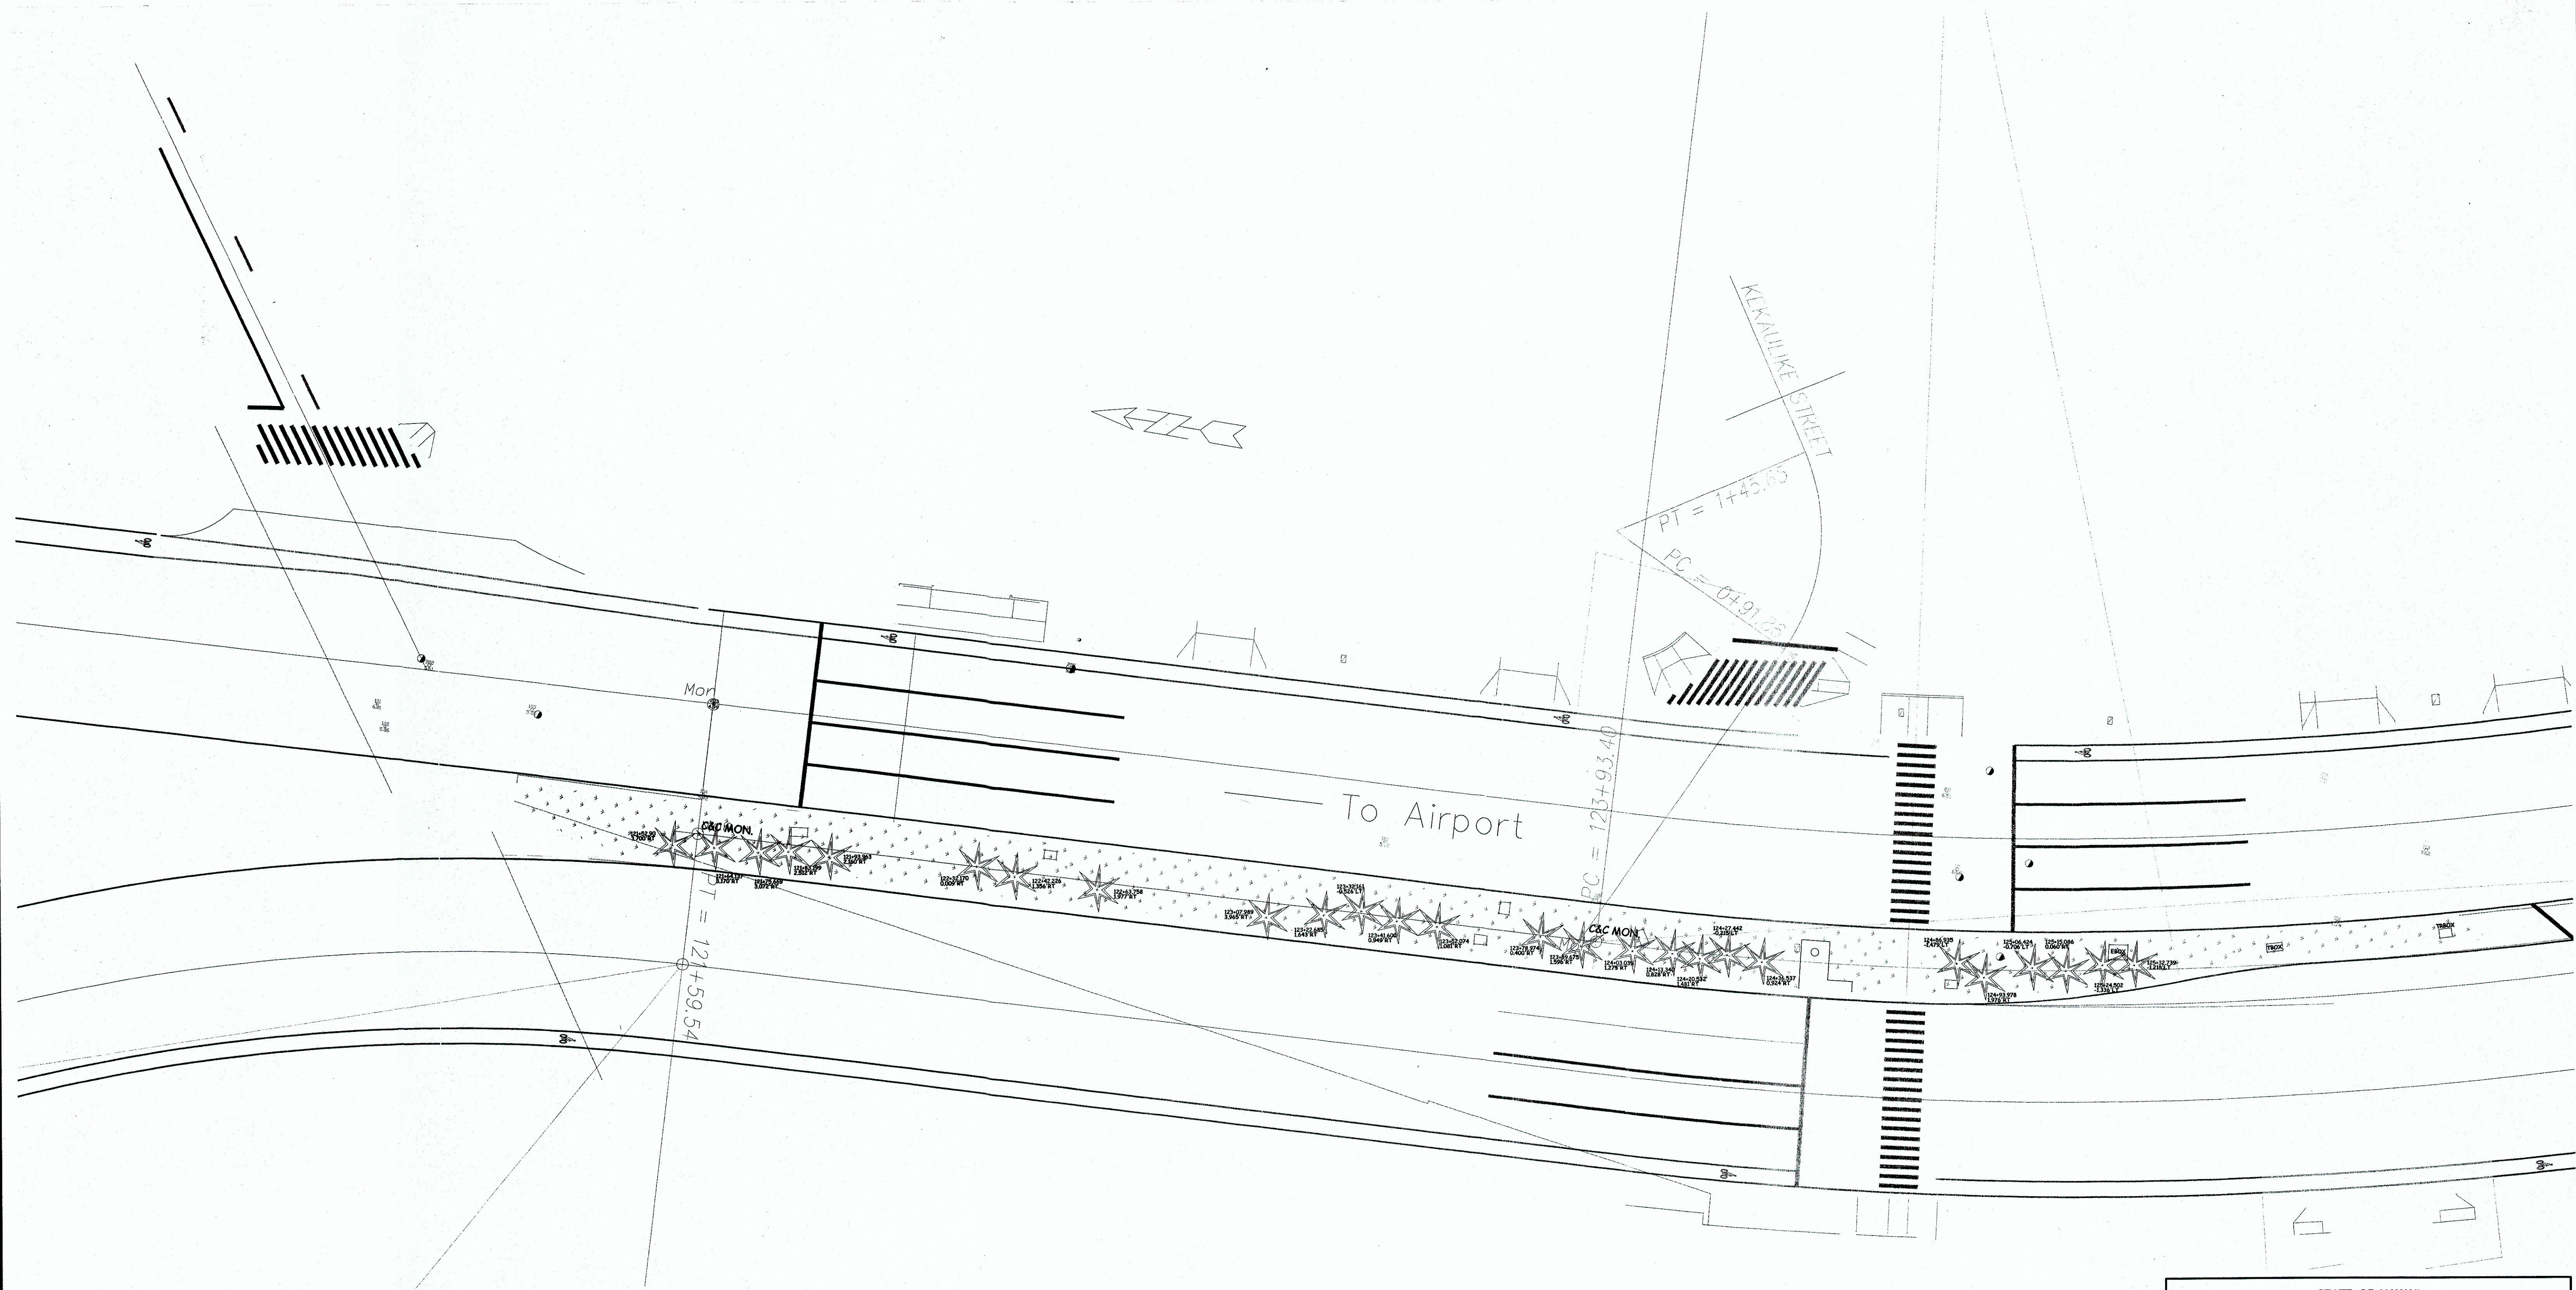

ORIGINAL PLAN	SURVEY PLOTTED BY	DATE
NOTE BOOK	DRAWN BY	
	DESIGNED BY	
	QUANTITIES BY	
	CHECKED BY	

FOR REFERENCE ONLY

STATE OF HAWAII
DEPARTMENT OF TRANSPORTATION
HIGHWAYS DIVISION


LANDSCAPE PLAN

NIMITZ HIGHWAY BEAUTIFICATION
Nuanu Stream Bridge to Bethel Street
Project No. 92A-01-07M

Scale: Not To Scale Date: December 2, 2015

SHEET No. 1 OF 1 SHEETS

FED. ROAD DIST. NO.	STATE	PROJ. NO.	FISCAL YEAR	SHEET NO.	TOTAL SHEETS
HAWAII	HAW.	92A-01-07M	2007	9	17

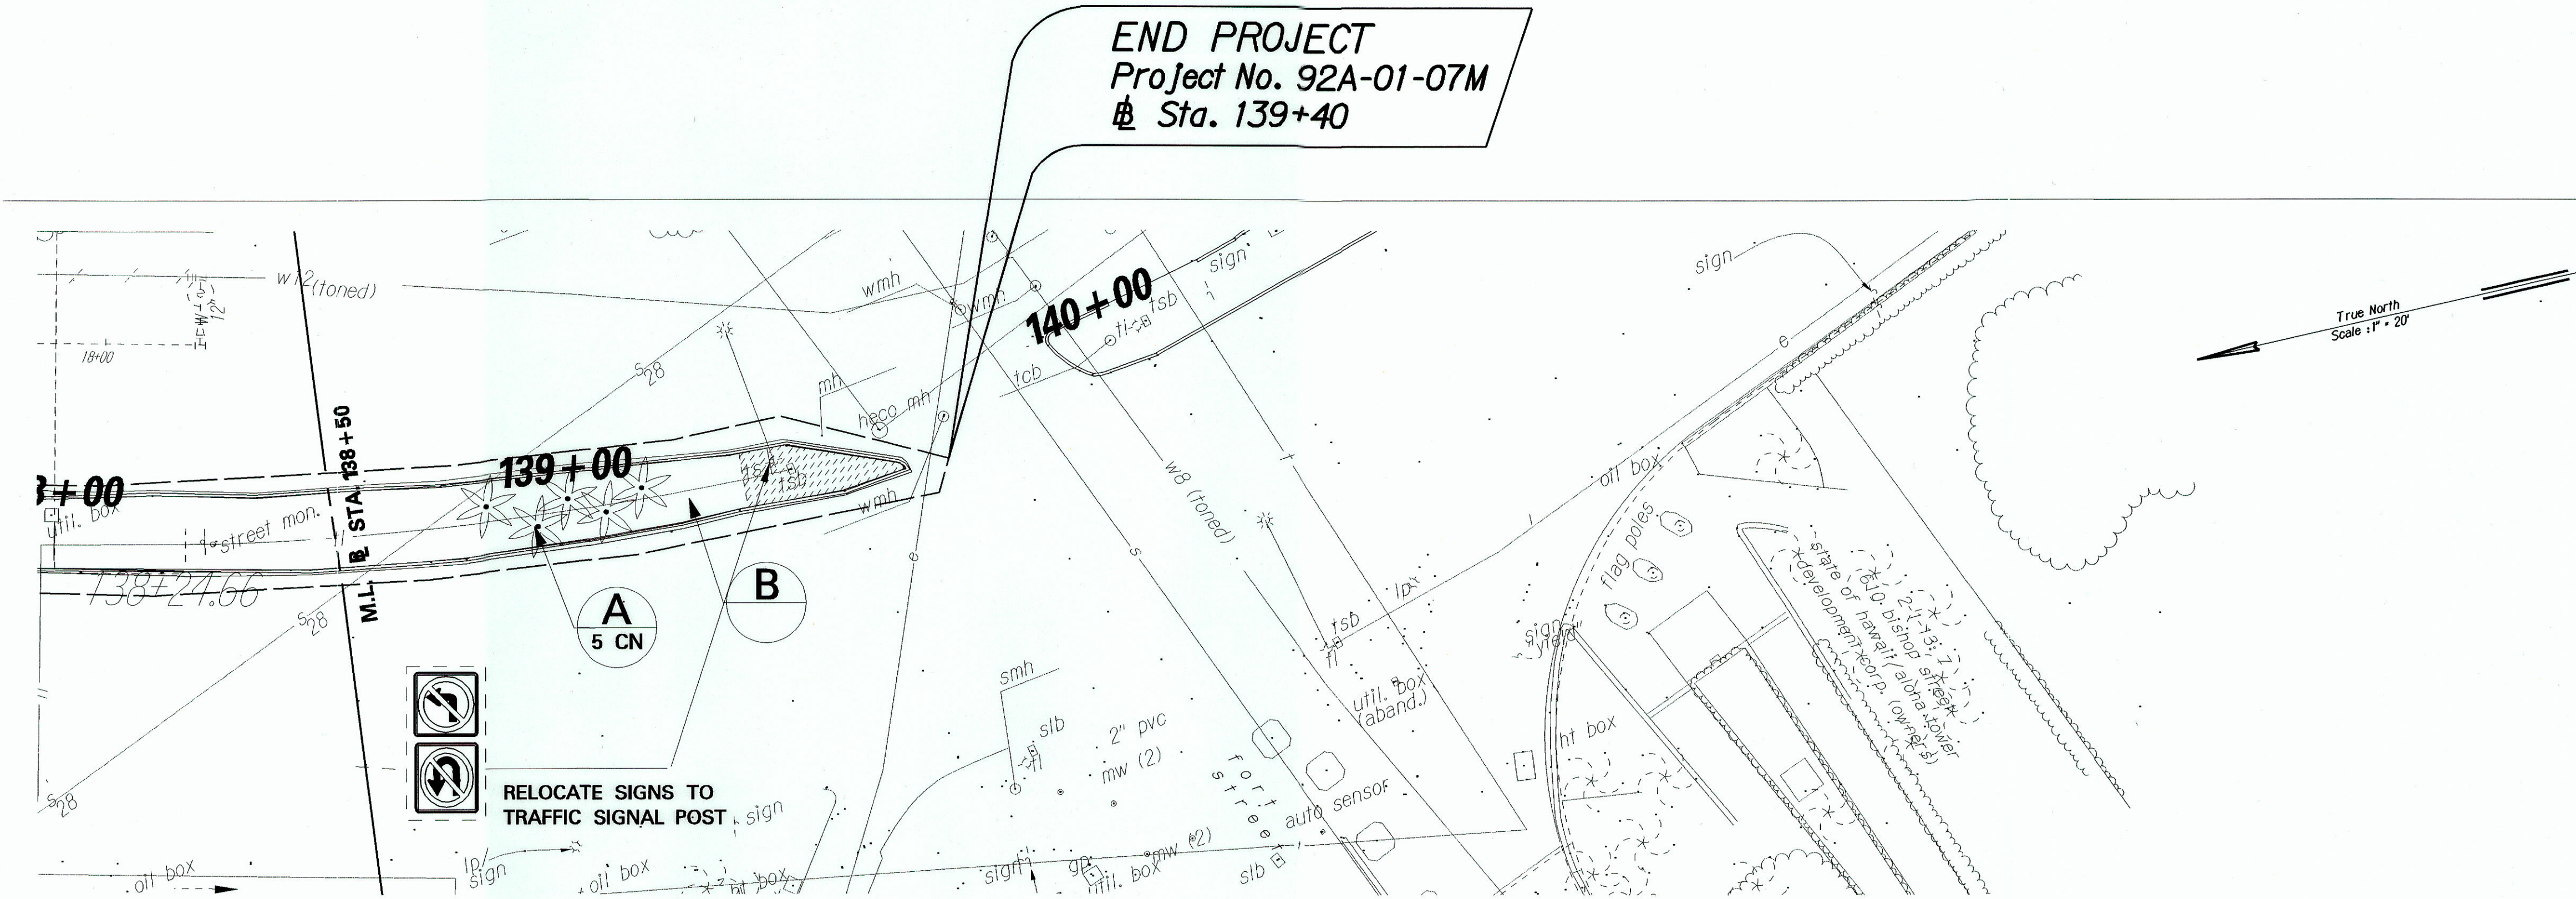

Tree Planting Note:
 All trees shall be a minimum of 4' from the HECO pipeline.
 A 3' depth deeproot root barrier by 12' long shall be used
 for each tree. Root barrier shall be a minimum of 2' from
 HECO pipeline on side facing tree. Root barrier shall be
 installed per the manufacturer's recommendations.
 Adjust irrigation tree sprinklers for new tree locations
 accordingly.

DESIGNED BY	DATE
TRACED BY	
NOTED BY	
CHECKED BY	
DATE	

STATE OF HAWAII
 DEPARTMENT OF TRANSPORTATION
 HIGHWAYS DIVISION

LANDSCAPE PLAN
 NIMITZ HIGHWAY BEAUTIFICATION
 NUUANU STREAM BRIDGE TO BETHEL STREET
 PROJECT NO. 92A-01-07M
 Date: March, 2007

SHEET No. 9 OF 17 SHEETS