

INDEX TO DRAWINGS	
SHEET NO.	DESCRIPTION
1	TITLE SHEET
2	GENERAL NOTES & LEGEND
3 - 4	UTILITY NOTES
5 - 6 ①	WATER POLLUTION & EROSION CONTROL NOTES
② 7 - 9 ③	LANDSCAPE PLANS
10 - 12	IRRIGATION PLANS
13 - 15	TREE BUBBLER IRRIGATION PLANS
16 - 17	LANDSCAPE & IRRIGATION DETAILS

Sheet Nos. ① 6S-1; ② 7S-1 and ③ 8S-1 are Supplementary Sheets to this Project. Total sheet count after "AS-BUILT" posting 20 sheets.

STATE OF HAWAII

DEPARTMENT OF TRANSPORTATION

HIGHWAYS DIVISION

HONOLULU, HAWAII

"AS-BUILT"

PLANS FOR

NIMITZ HIGHWAY BEAUTIFICATION




NUUANU STREAM BRIDGE TO BETHEL STREET

PROJECT NO. 92A-01-07M

DISTRICT OF HONOLULU

ISLAND OF OAHU

FED. ROAD DIST. NO.	STATE	PROJ. NO.	FISCAL YEAR	SHEET NO.	TOTAL SHEETS
HAWAII	HAW.	92A-01-07M	2007	1	17

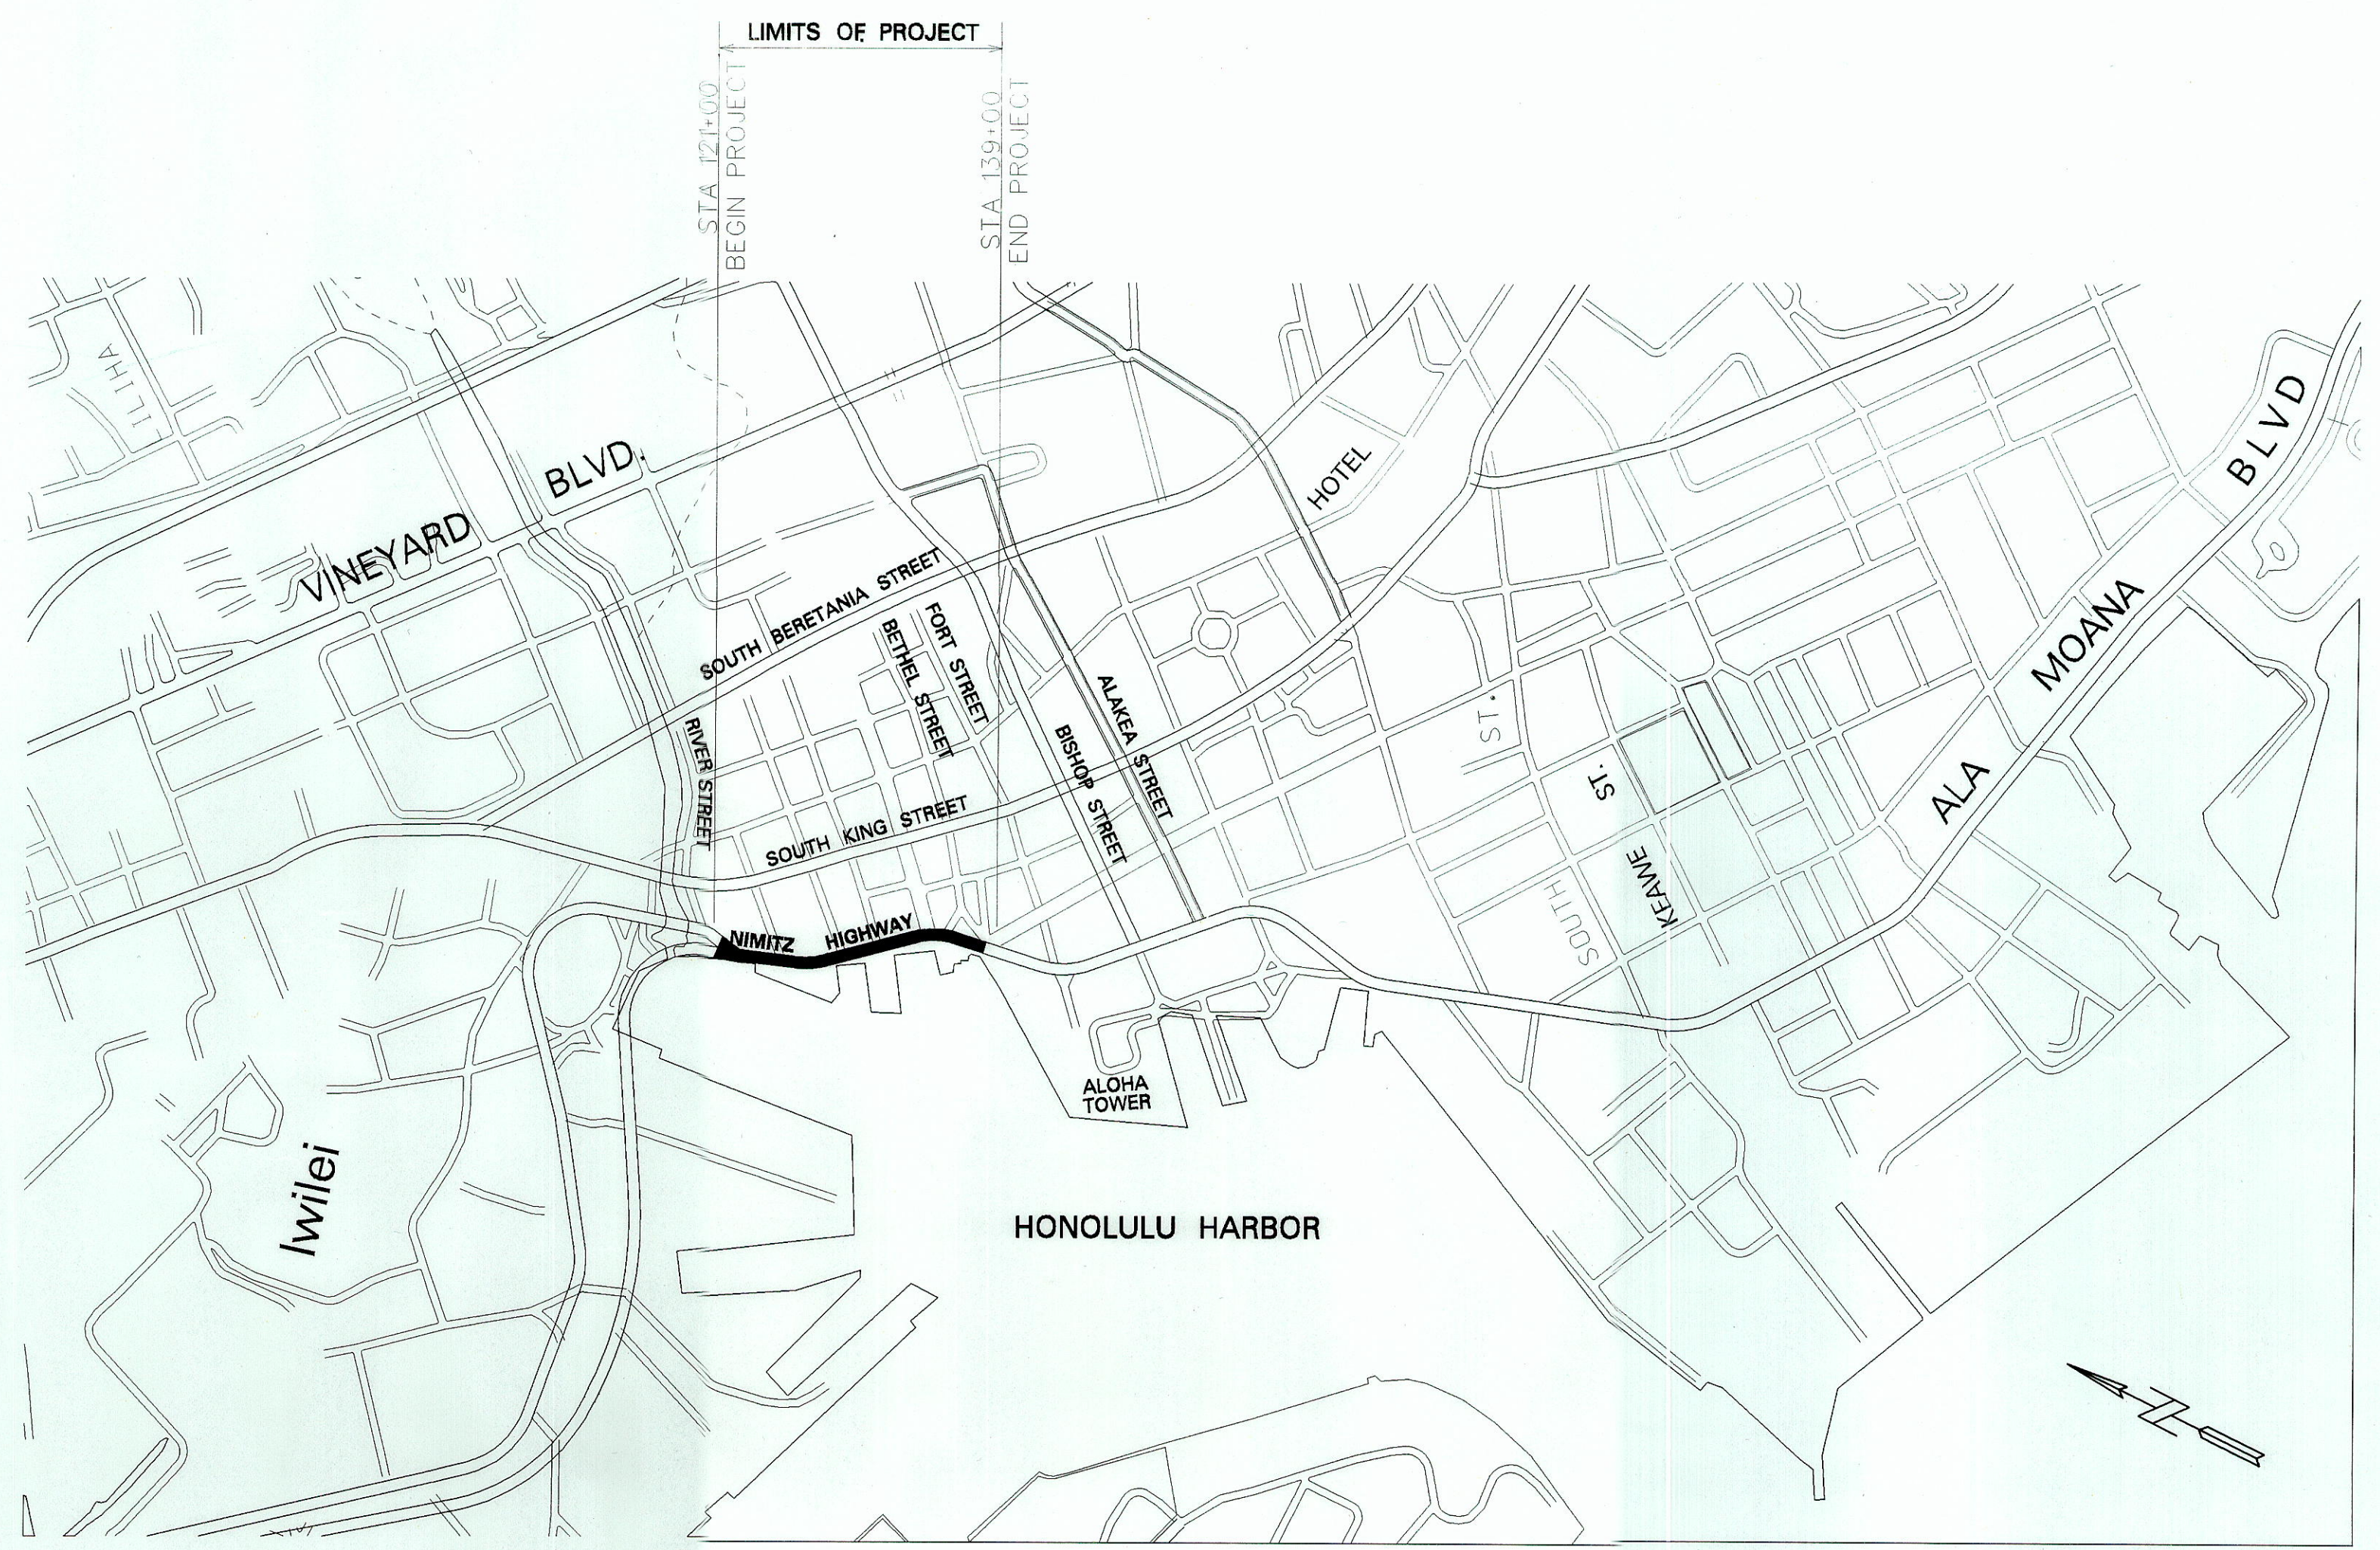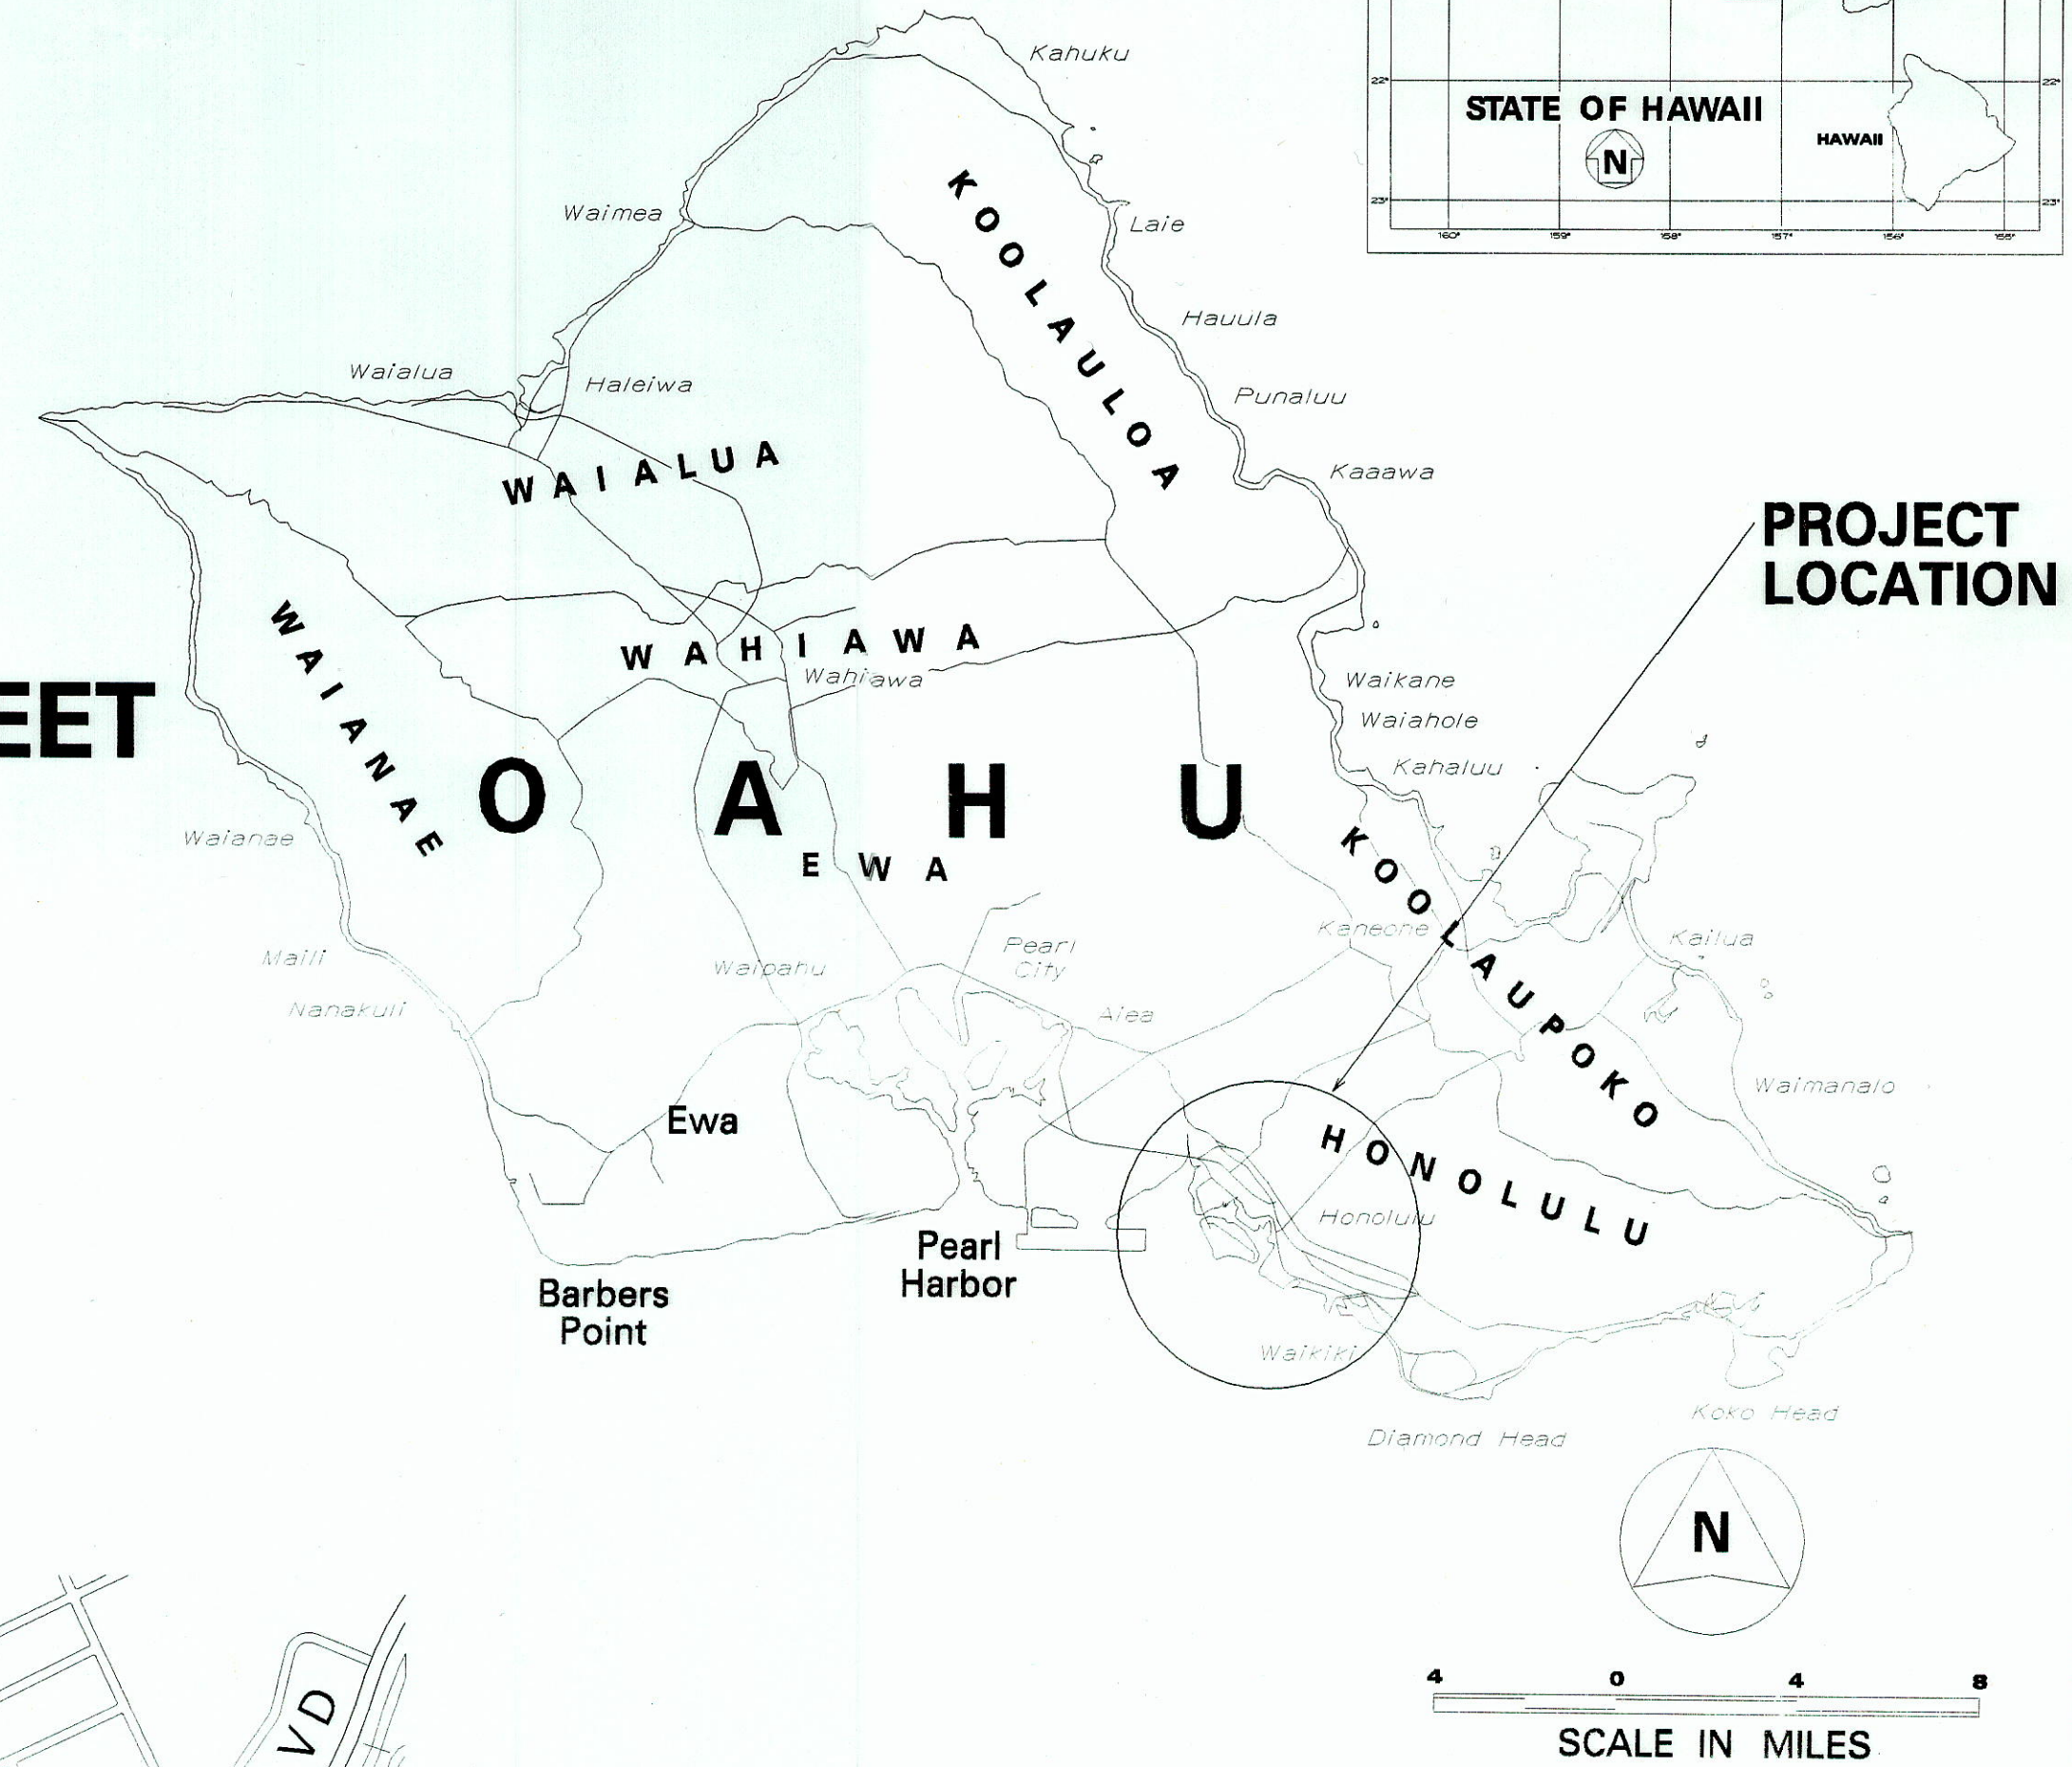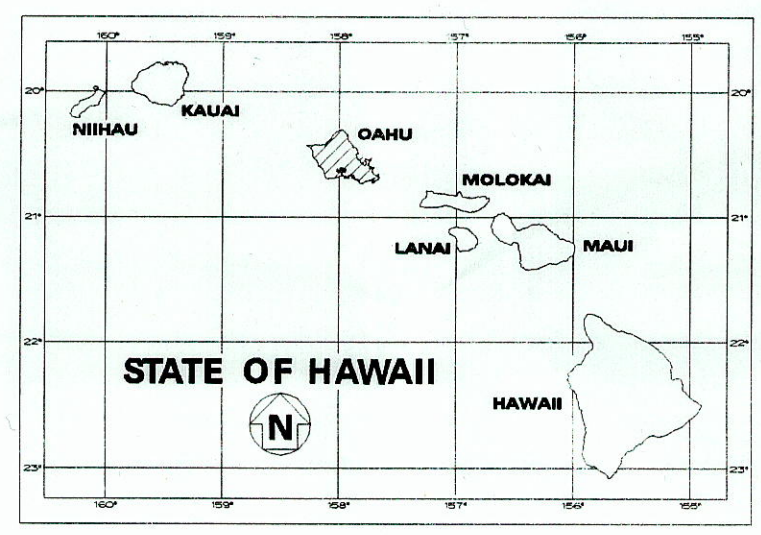

PROJECT LOCATION


GROSS LENGTH OF PROJECT.....0.40 MILES

1 0 1 2 3

SCALE IN THOUSAND FEET

MILE POST 5.87 TO MILE POST 6.27

ACRES: 0.38 AC

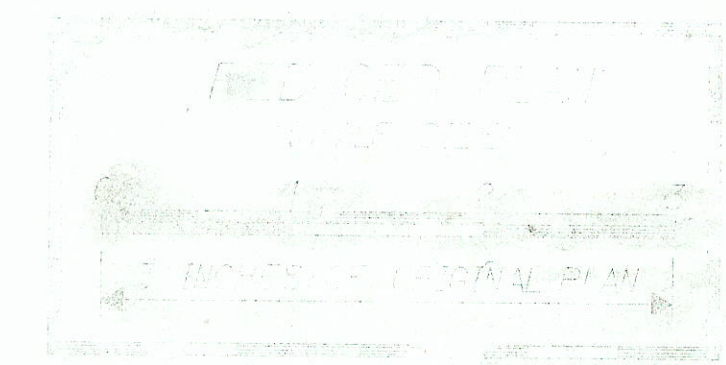

CHANGES MADE DURING CONSTRUCTION HAVE BEEN INCORPORATED ON THESE PLANS EXCEPT CHANGES IN THE ORIGINAL THEORETICAL QUANTITIES. FOR ACTUAL QUANTITIES, REFER TO PROJECT LEDGER AND/OR COMPUTATION BOOK.

*Mervin C. H. [Signature]* 12-15-2015  
RESIDENT ENGINEER DATE

DEPARTMENT OF TRANSPORTATION

STATE OF HAWAII

APPROVED:

*[Signature]* 4/25/07

For DIR. OF TRANSPORTATION DATE

HWY DL

DESIGNED BY

CHRIS DACUS

P. S. & E. BY

692-7600

PHONE

MAR. 2007

DATE