

FED. ROAD DIST. NO.	STATE	FED. AID PROJ. NO.	FISCAL YEAR	SHEET NO.	TOTAL SHEETS
HAWAII	HAW.	92A-02-09M	2009	11	18

**IRRIGATION NOTES:**

- Contractor shall install irrigation lines, wires, valves and heads per specifications. Existing gate valves, point of connection, etc. are derived from the best available information and on-site inspection. The Contractor shall verify those points of connection noted and report any discrepancies to the Engineer
- This plan is diagrammatic. Irrigation system is subject to field adjustments due to unanticipated site conditions. Locate all mainlines, laterals, valves and sprinklers heads within planting areas, unless otherwise noted. Place mainline in planting areas where no sleeves are shown. Avoid any conflict between underground utilities, structures and plantings. The Contractor shall be responsible for locating and protecting all existing utilities. Bury pressure mainlines 18" and lateral lines 10" deep minimum.
- This irrigation system was designed with a minimum static water pressure of 75 psi at the point of connection. Notify the Project Engineer, if water pressure is less than psi or greater than 50 psi.
- Contractor shall secure all necessary permits and observe all local codes and regulations. The Contractor shall confirm all sites dimensions and conditions, and report any discrepancies to the Engineer.
- Contractor shall coordinate the installation of all sleeves, conduits, mainlines and laterals under pavement and through walls. Contractor shall assure that these items are laid prior to placement of pavement or wall structures.
- Locate and install all sprinkler heads 6" from sidewalks, curbs, driveways, building and wall unless otherwise noted. Flex tubing shall be installed on all sprinkler head along sidewalks, driveways, and parking spaces. Adjust all sprinkler heads and flow control for maximum coverage and minimum overthrow and misting. Operate only one valve at a time per controller.
- Within 30 days after award of the contract, submit for the Engineer's acceptance six (6) copies of detailed scaled drawings and wiring diagrams for permanent and temporary irrigation systems. Not proposed deviations from the contract. Include samples of materials, if required by contract.
- Perform hydrostatic test by applying continuous static pressure of 60 psi for one (1) hour. Notify the Engineer at least three (3) days in advance of test. Repair leaks that develop and repeat test. Do not backfill until there is no further sign of leakage.
- Perform operability test by opening remote control valve and test circuits for leaks around barbed and threaded pvc fittings. Repair leaks and repeat tests. Notify the Engineer at least three (3) days in advance of test. Do not backfill until there is no further sign of leakage.
- Perform coverage test. Before planting period, run automatic controller through all it's cycles. Check watering for coverage and uniformity in company of the Engineer. Run system until there are puddles or there is sheet flow to determine initial irrigation time and number of cycles per week needed to water requirements of plants.
- Locate valve boxes so that the outer edges are no closer than five feet to roadway pavement. Group valve boxes where feasible.
- If plans do not specify depth of excavation, provide minimum cover to finish grade as follows.
  - 4 inches for drip irrigation main.
  - 18 inches for irrigation main.
  - 10 inches for irrigation lateral.
  - 24 inches for sleeve or conduit under landscape pavement.
  - 36 inches for sleeve or conduit under roadway pavement.
  - For controller wires and conduits in unpaved areas, depth equal to that pressure irrigation pipe.

**Irrigation Schedule**


Symbol	Quantity	Catalog Number	Description	G.P.M.	Radius (ft.)	P.S.I.
□	<del>7</del>	Rainbird 1804-SAM-R17-24F	Stream Rotary			
○	<del>66</del>	Rainbird 1804-SAM-PRS-UI0F	4" Pop-Up Nozzle Full Circle	1.60	10	30
▲	<del>6</del>	Rainbird 1804-SAM-PRS-UI0Q	4" Pop-Up Nozzle Quarter Circle	0.75	10	30
●	<del>0</del>	Rainbird 1804-SAM-PRS-5F	4" Pop-Up Nozzle Full Circle	0.41	5	30
◐	<del>9</del>	Rainbird 1804-SAM-PRS-8H	4" Pop-Up Nozzle Half Circle Tree Bubbler	1.05	8	30
⊕	<del>4</del>	Rainbird 150-PEB-PRS-D with LEMA 1600HE Solenoid with 30-921 Plastic Adapter	1 1/2" Remote Control Valve w/actuator			
⊕	<del>0</del>	Rainbird 100-PEB-PRS-D with LEMA 1600HE Solenoid with 30-921 Plastic Adapter	1" Remote Control Valve w/actuator			
	3	Rainbird 33-DRC with LEEMCO LS-120	3/4" Quick Coupler Valve			
⌘	3	1 1/4" WATTS 009QT-125-RPB or B.W.S. approved equal with security enclosure	Backflow preventer with security enclosure			
■	3	DIG LEIT 4004 on 4000 series mounting column with LEIT Stainless Steel Enclosure ENCL 4000 with Hunter Mini-Click2 Rain Sensor with LEIT Switch Sensor Adapter SKIT8821-4 with V.I.T. Strongbox Rain Sensor Enclosure RGVRS	Irrigation controller and rain sensor in stainless enclosure			
		3M Scotchcast 3570G Electrical insulating resin sealing pact per each connection with Scotchlok Y wirenut	Wire connectors			
○	3	U.S. Bronze NIBCO T113 Gate Valve	Gate Valve			
T	1	U.S. Brass NIBCO "T"- Size to Exist. (Price 2" dia.)	Brass "T"			
—		PVC Schedule 40	Irrigation Pipe			

ORIGINAL PLAN	SURVEY PLOTTED BY	DATE
NOTE BOOK	DRAWN BY	
DESIGNED BY		
CHECKED BY		


LEGEND FOR AS-BUILT POSTINGS	
	Squiggly line for as-built deletion
	Double line for as-built deletion
Roadway	Text for as-built posting

STATE OF HAWAII  
DEPARTMENT OF TRANSPORTATION  
HIGHWAYS DIVISION  
**IRRIGATION NOTES**  
NIMITZ HIGHWAY  
MEDIAN EROSION CONTROL  
Sumner Street to Richards Street  
Project No. 92A-02-09M  
Scale: NTS Date: April, 2009


"AS-BUILT"

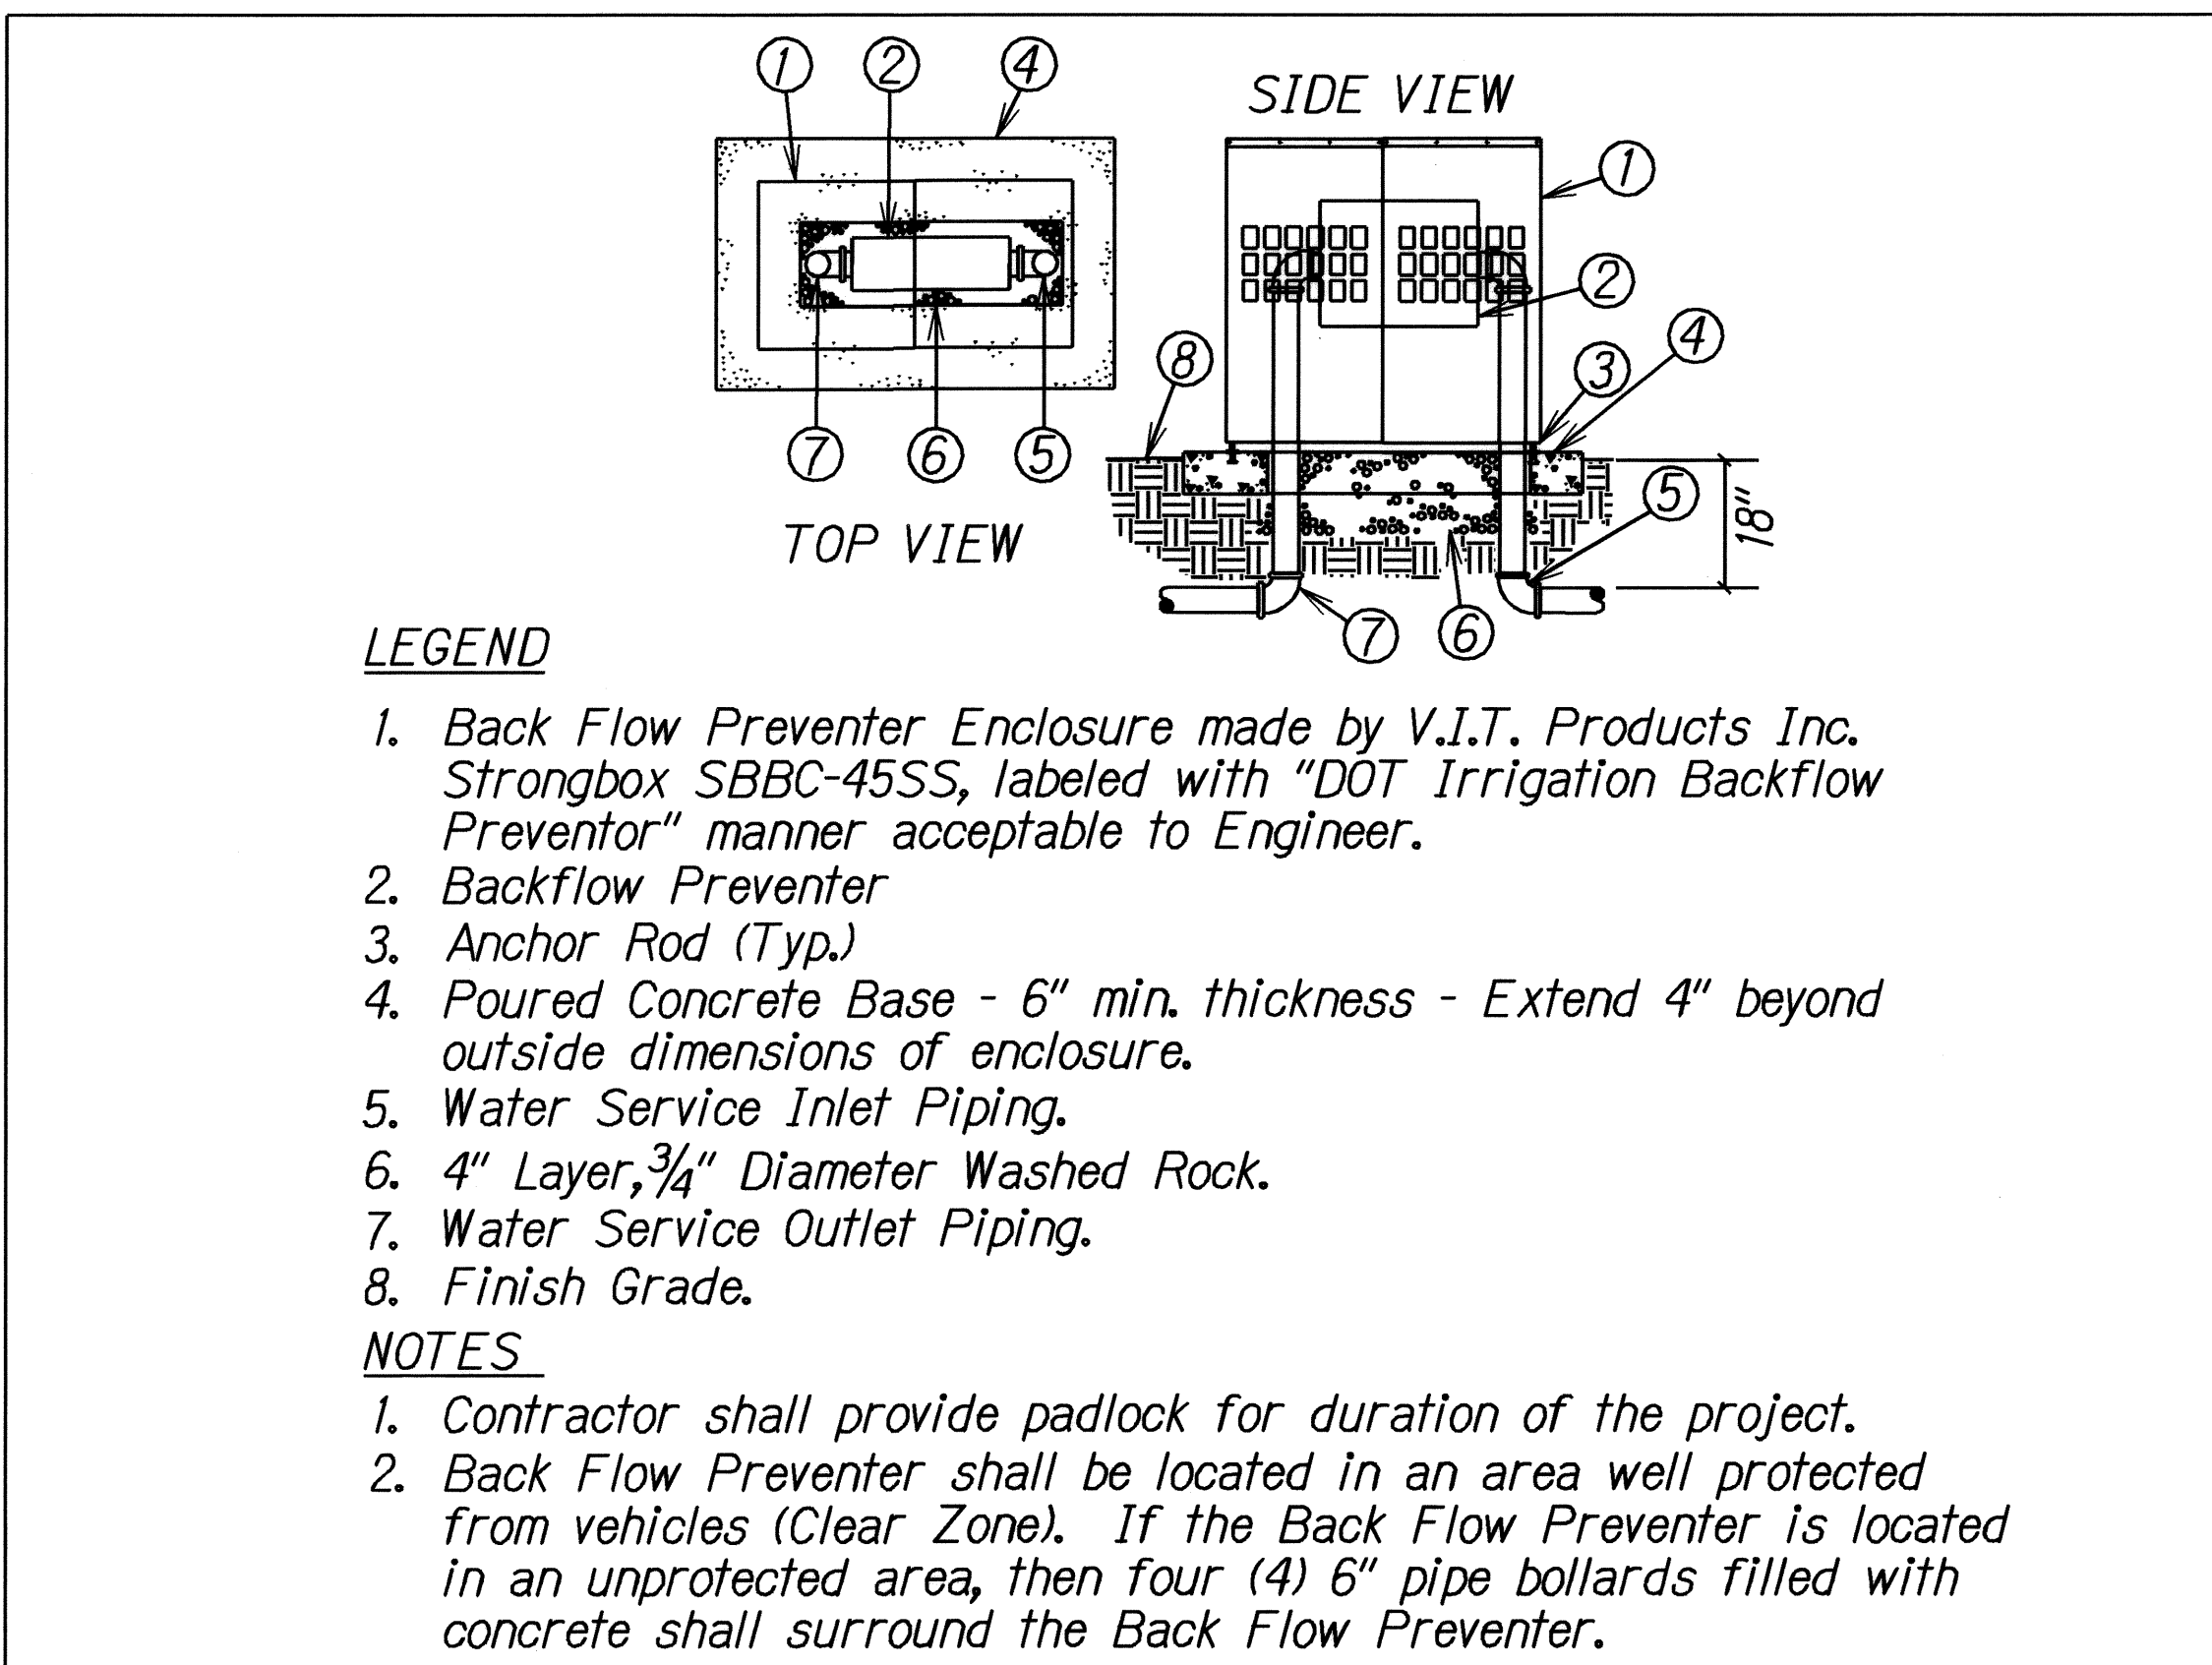


**A** B.F.P. ENCLOSURE DETAIL N.T.S.

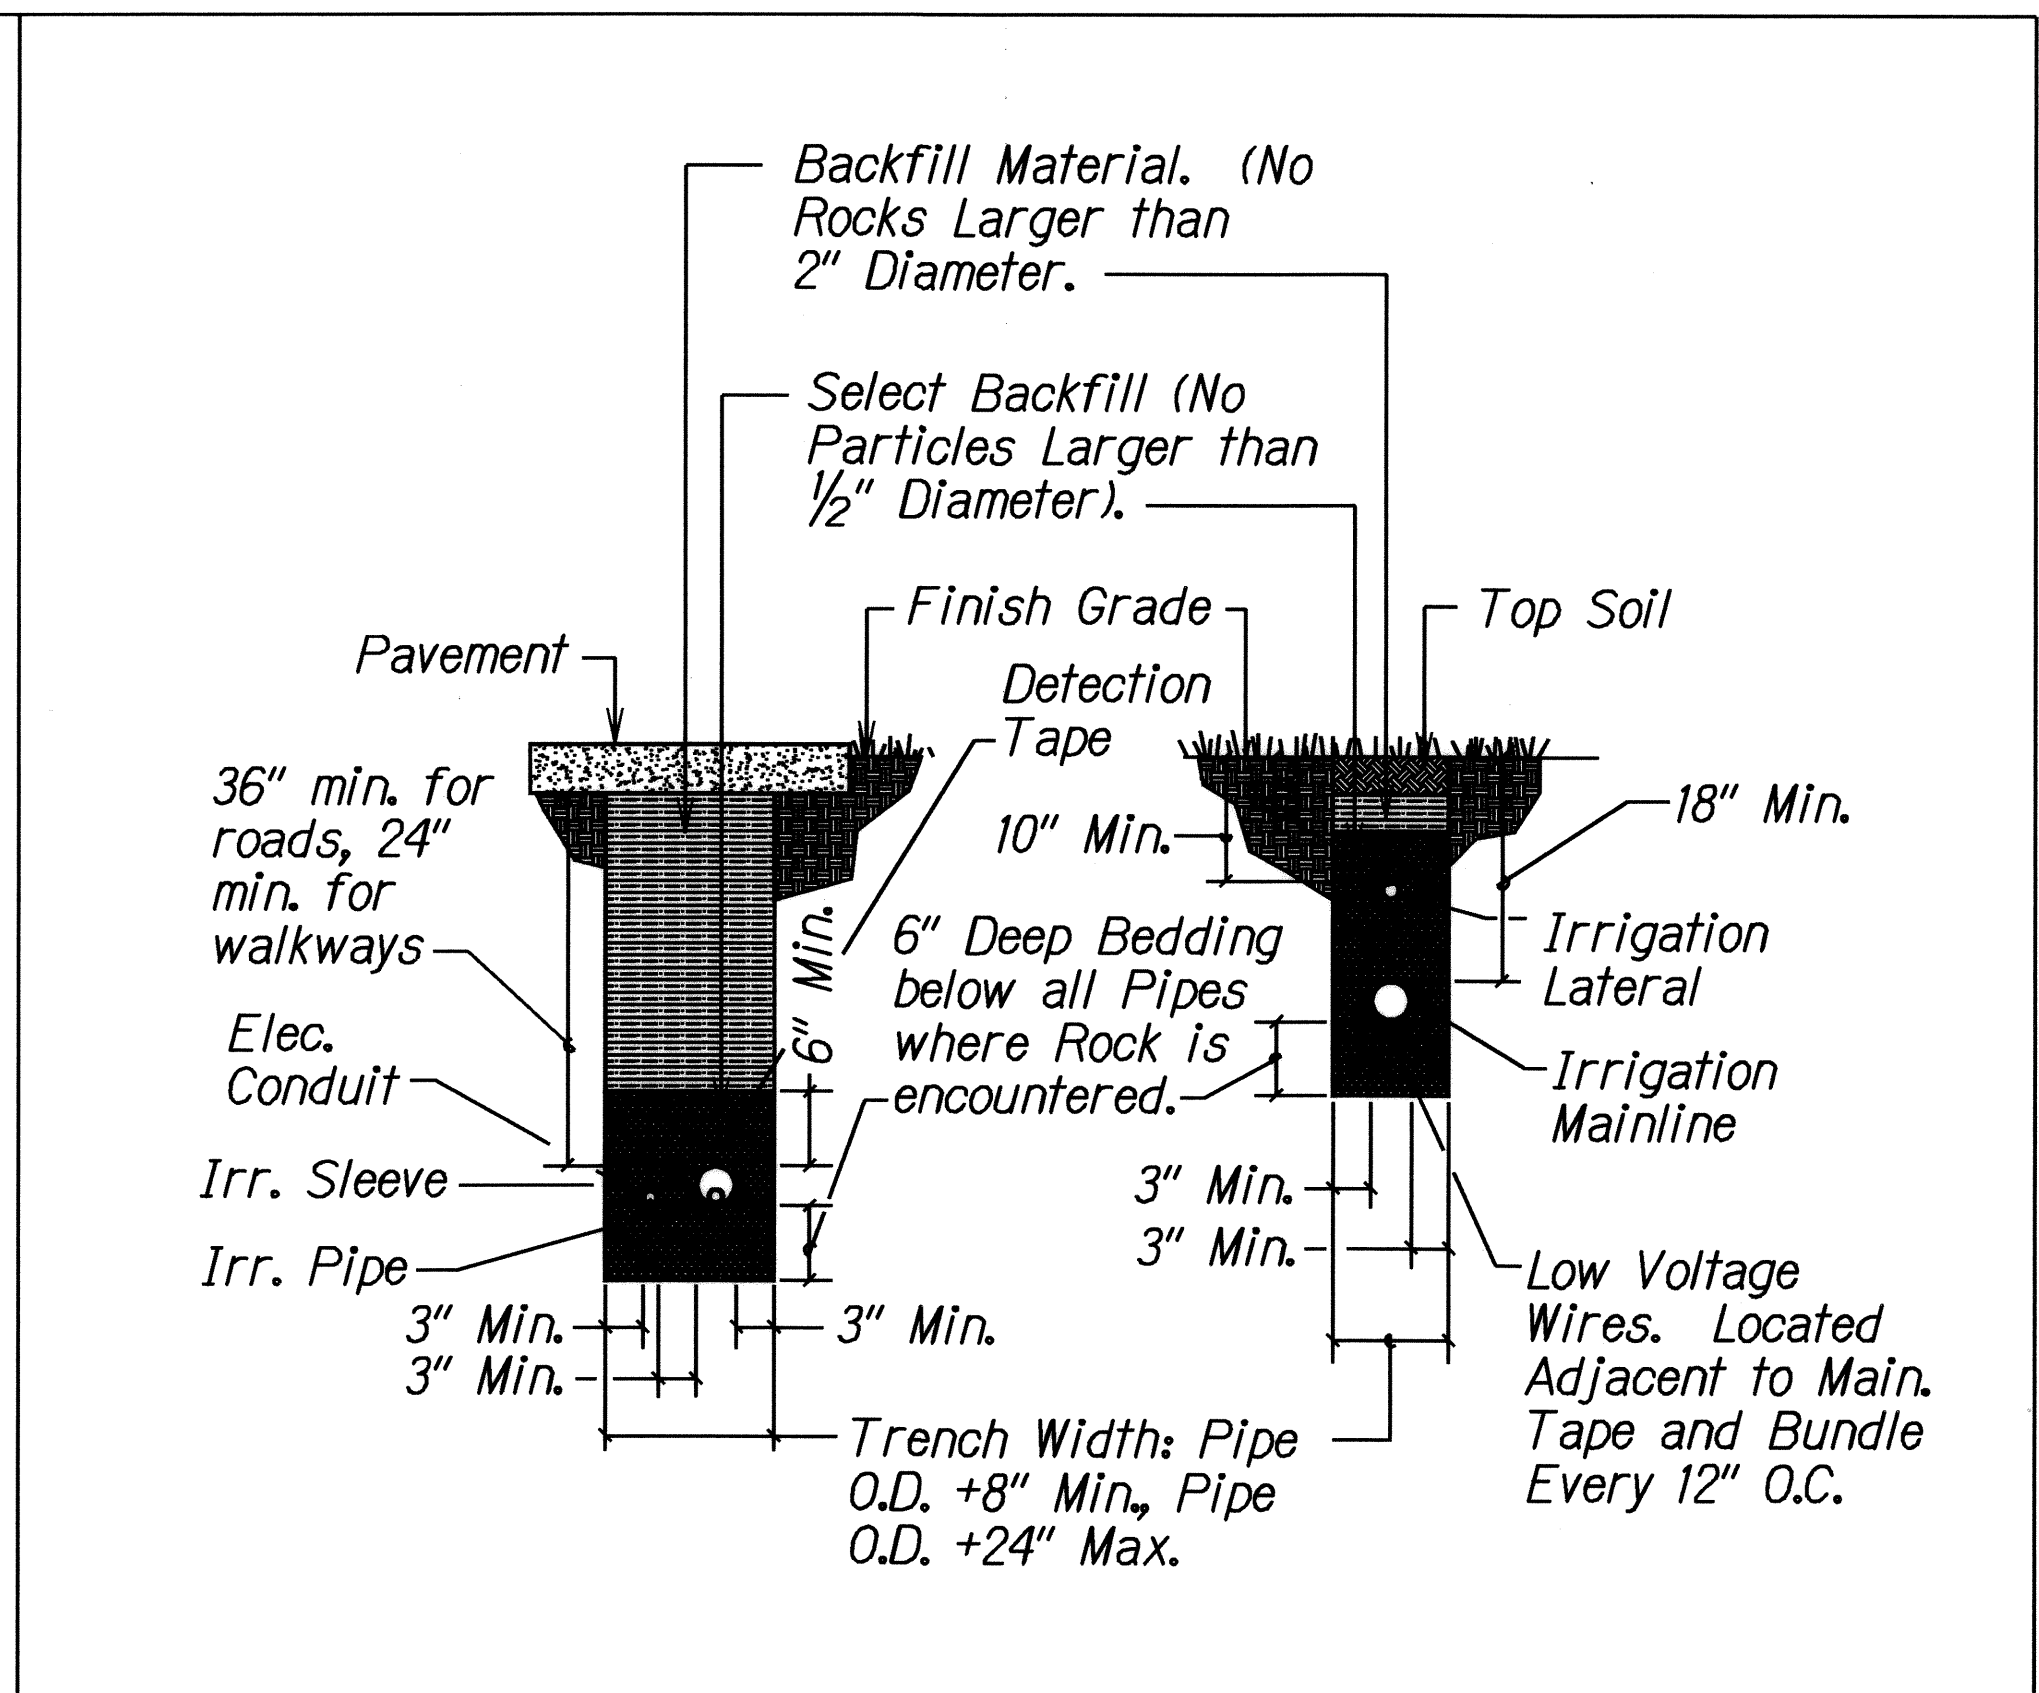

**B** IRRIGATION TRENCH DETAIL N.T.S.

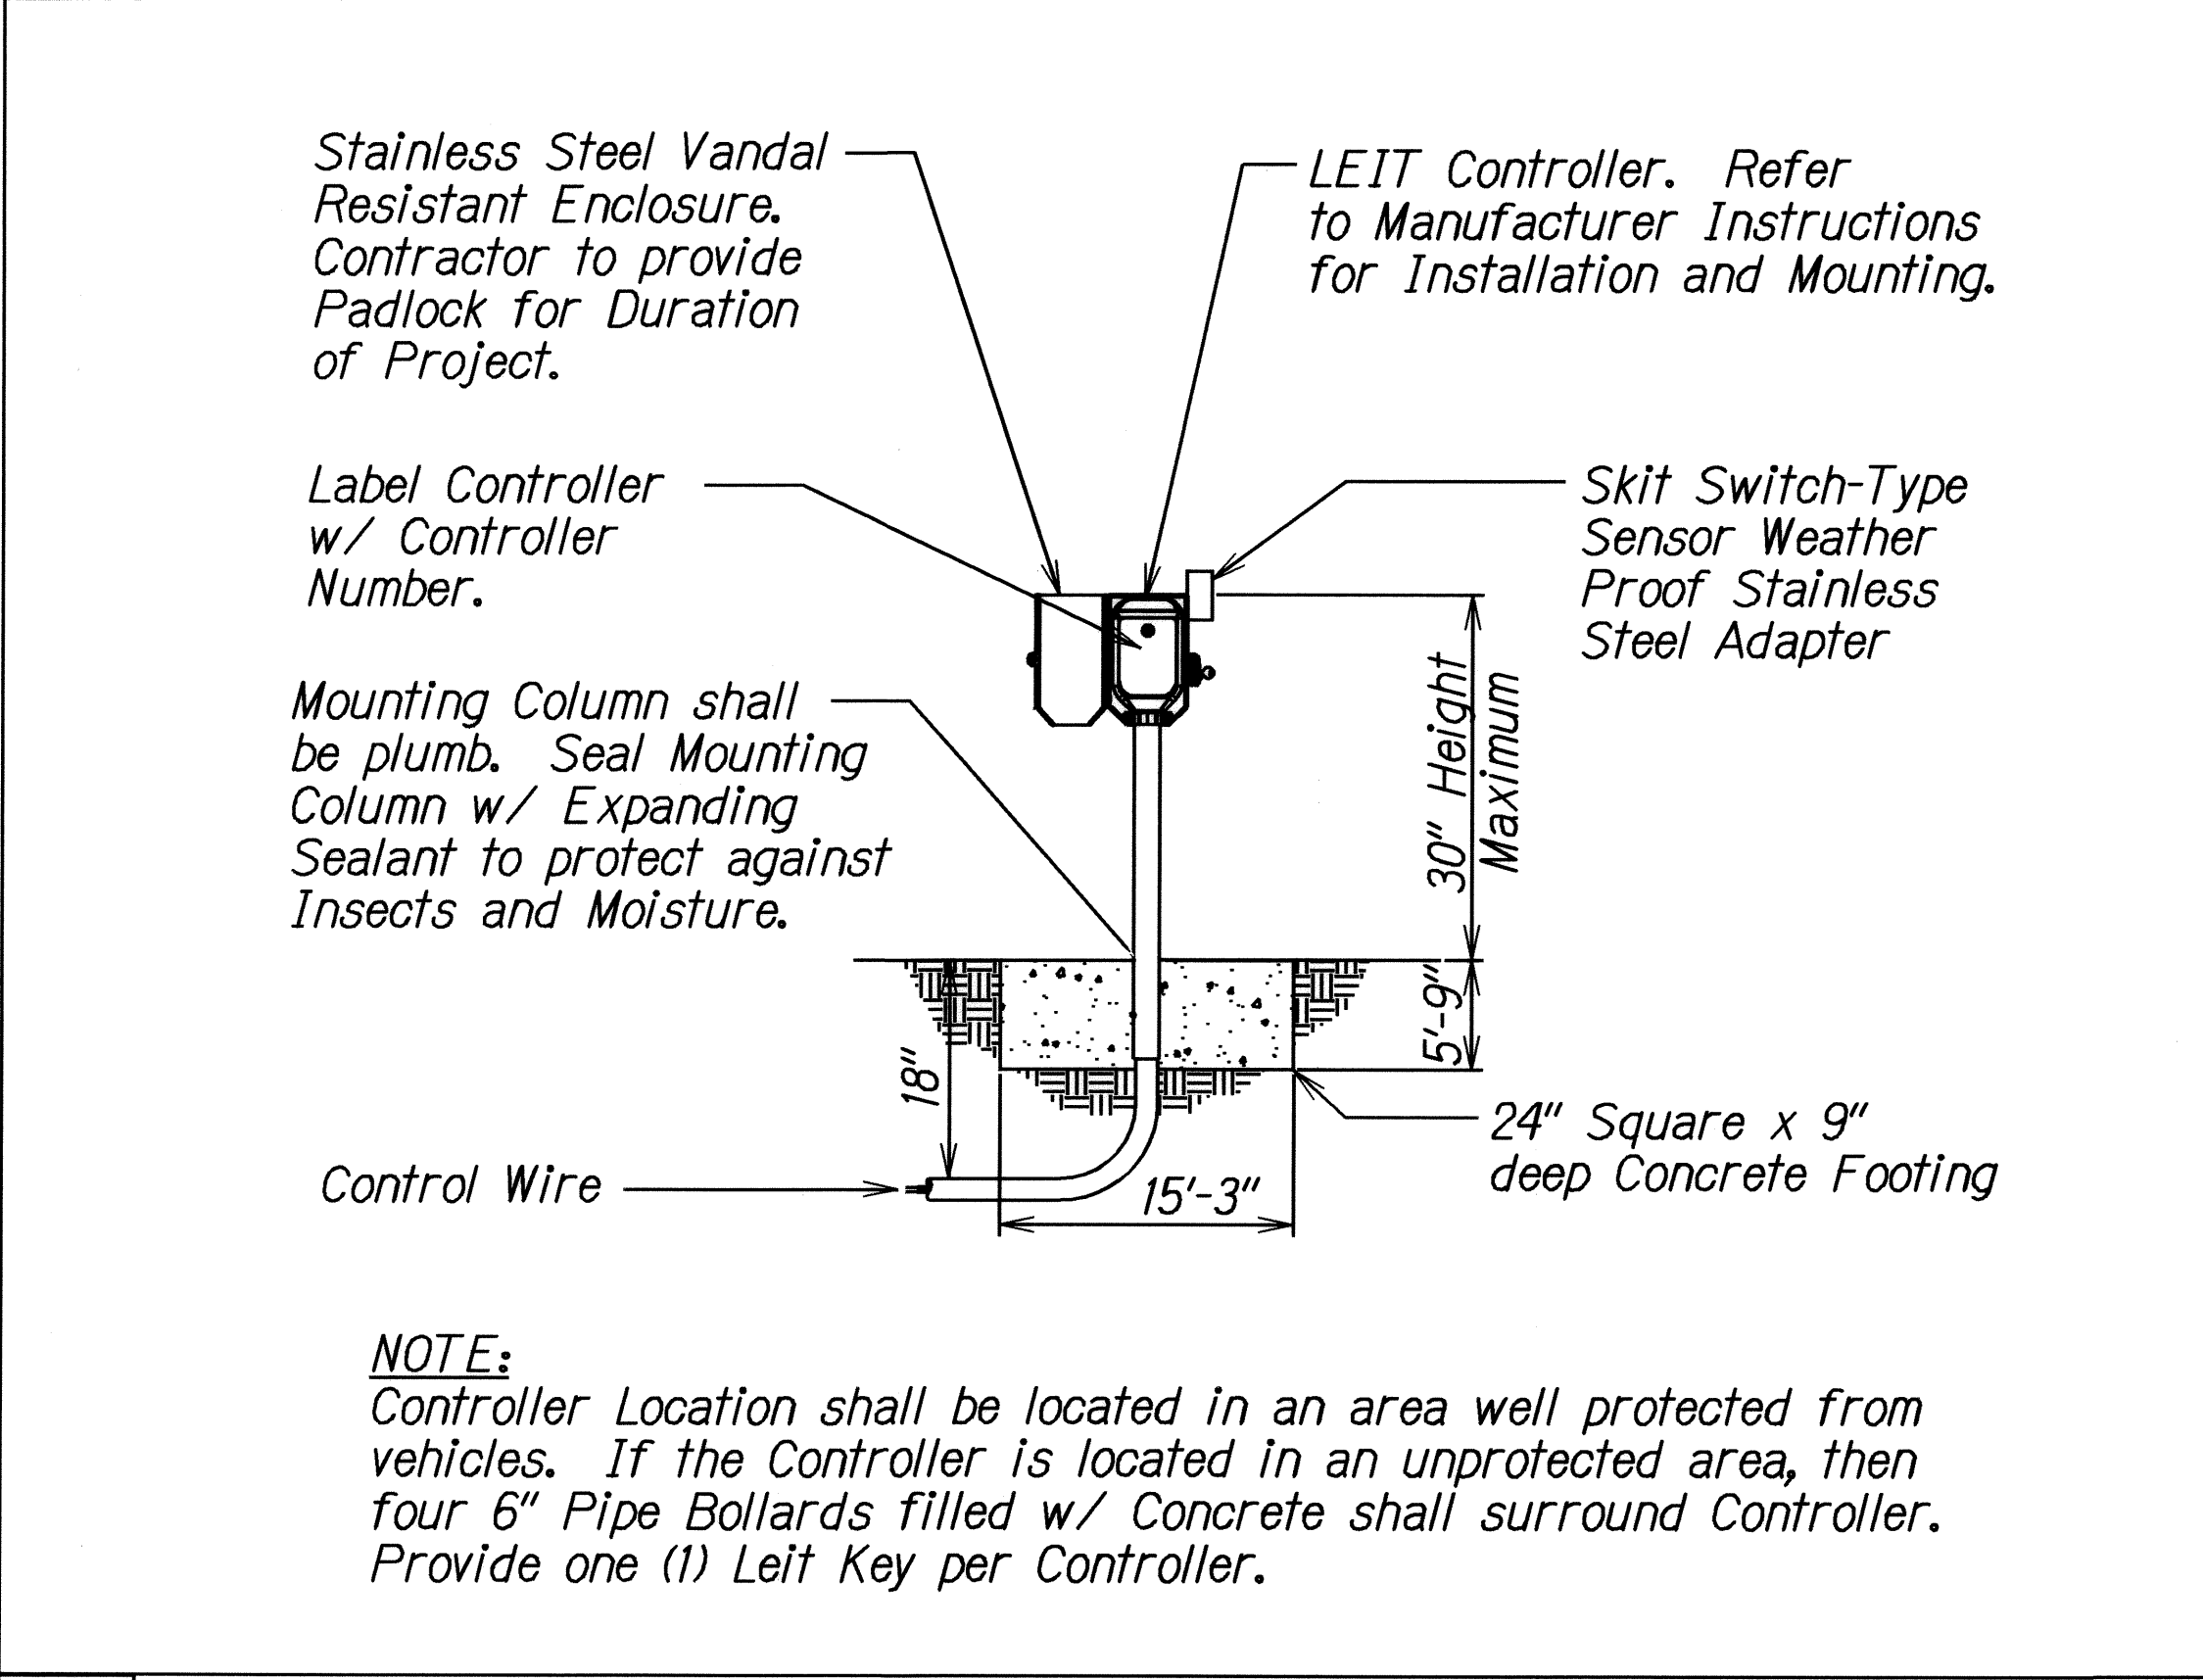

**C** SOLAR POWERED CONTROLLER DETAIL N.T.S.

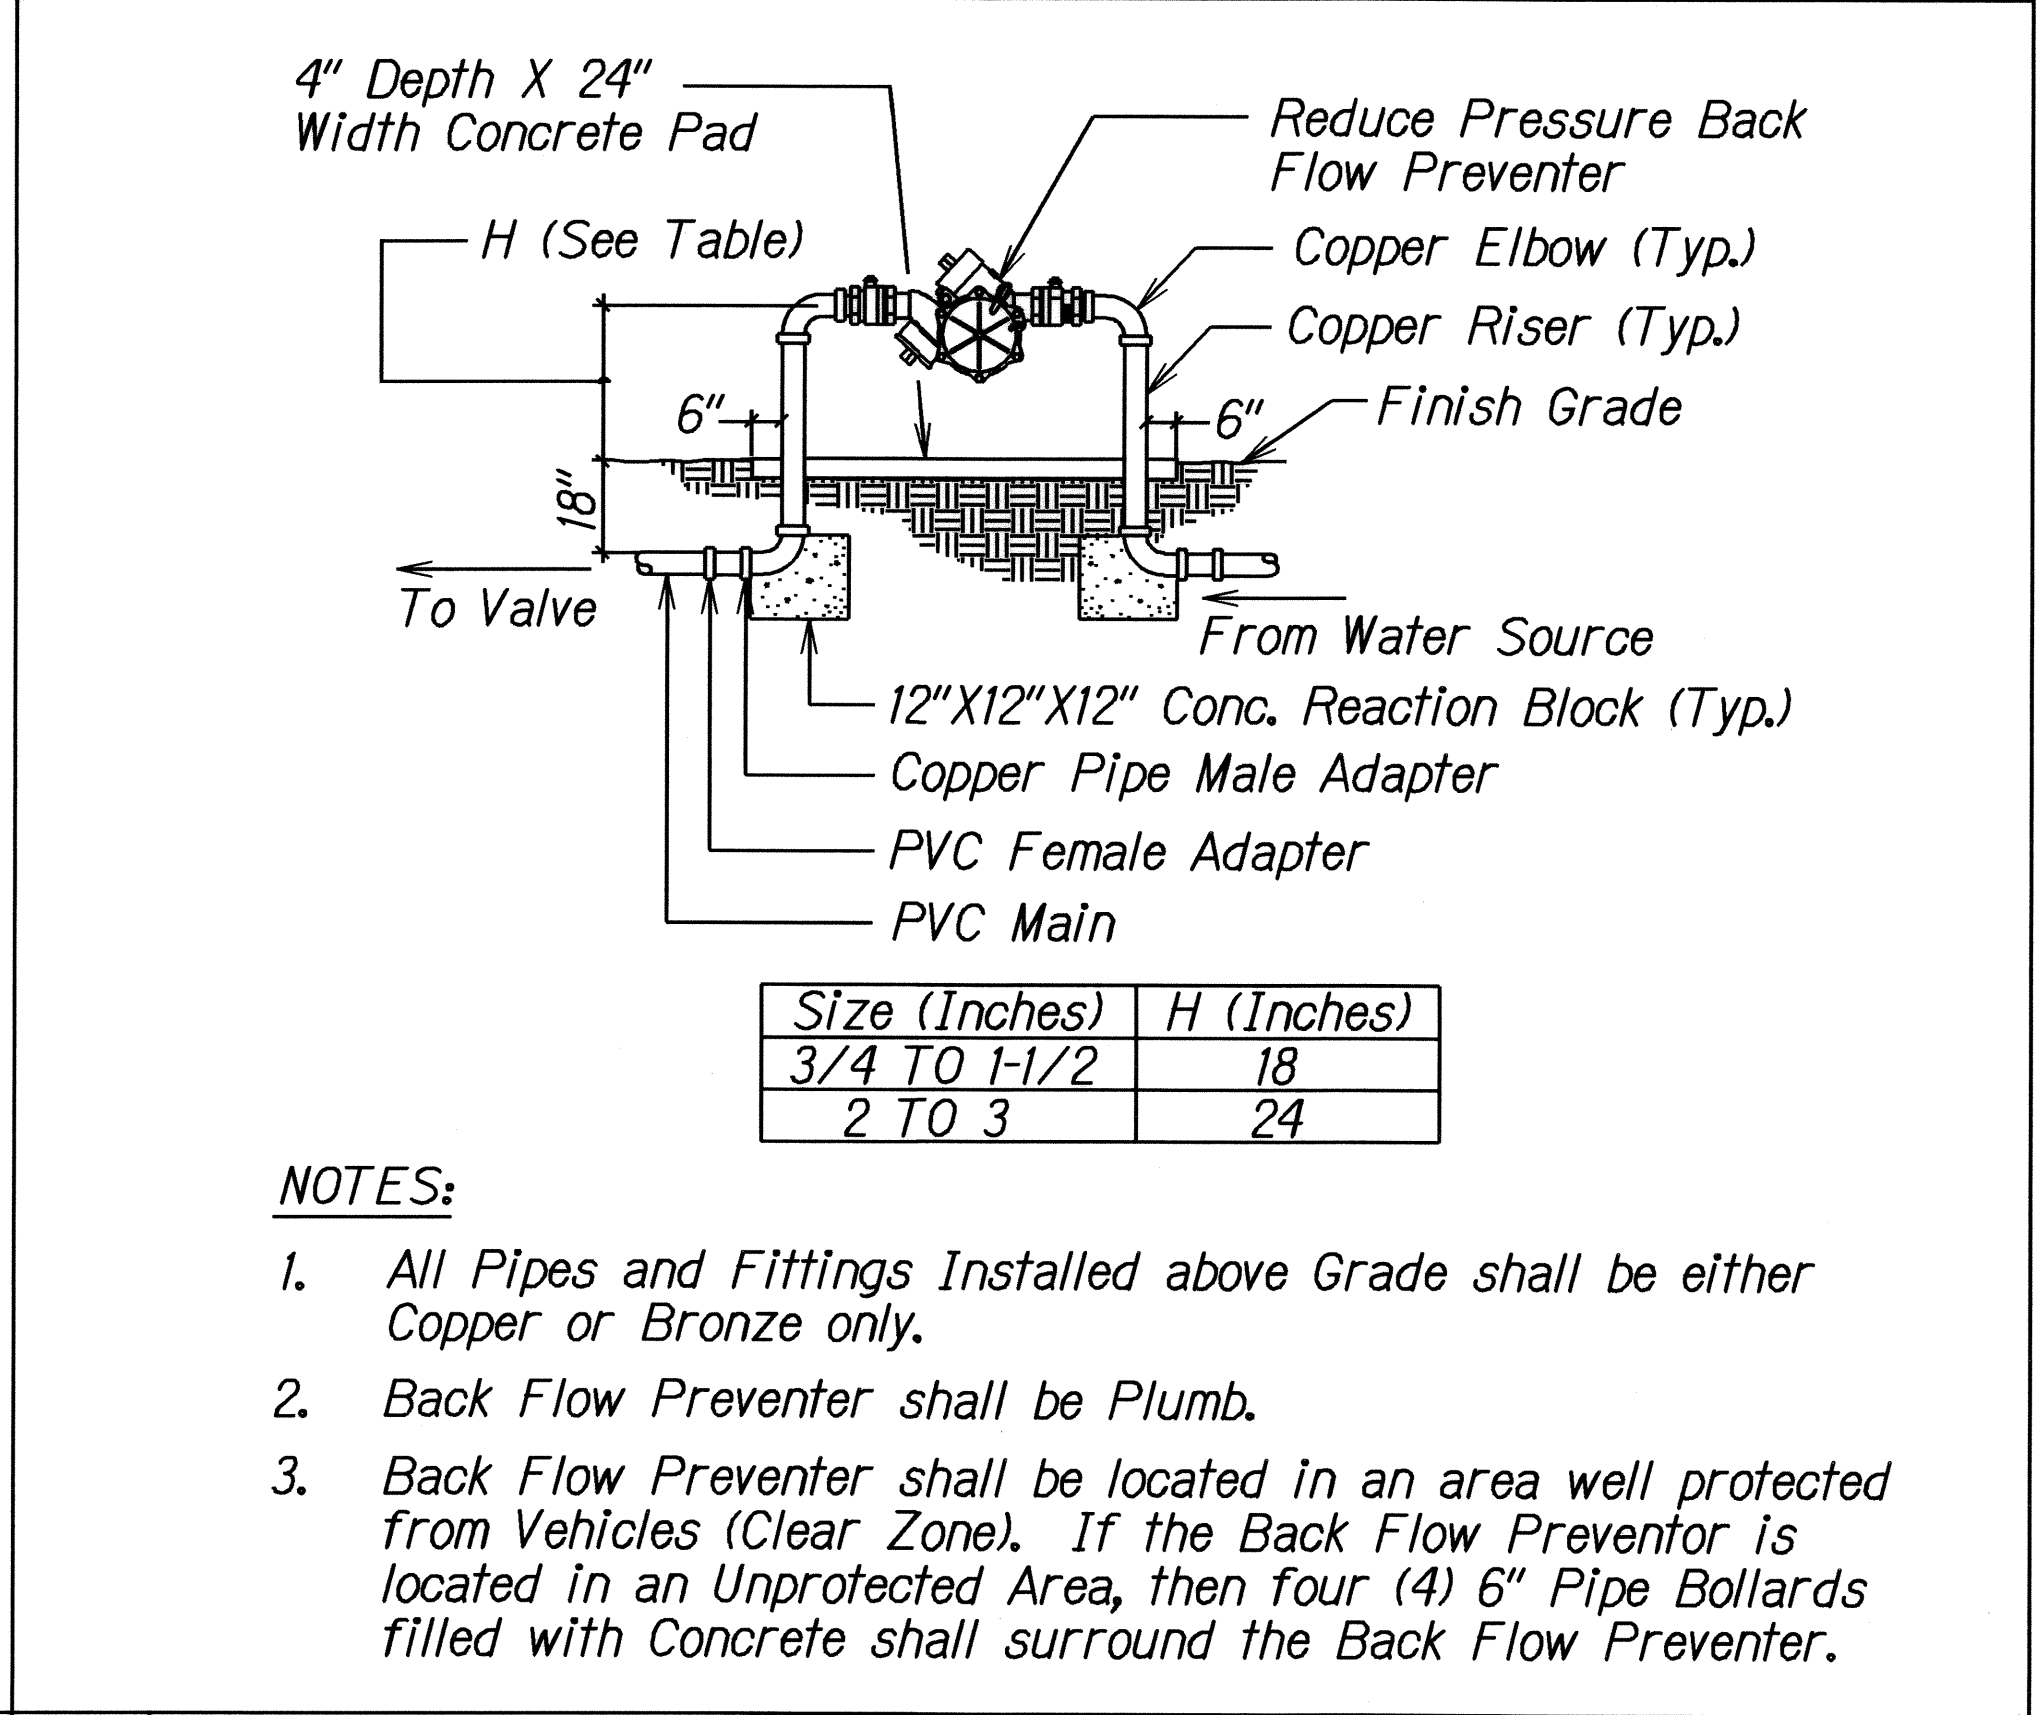

**D** REDUCED PRESSURE B.F.P DETAIL N.T.S.

SURVEY PLOTTED BY	DATE
DRAWN BY	
DESIGNED BY	
QUANTITIES BY	
CHECKED BY	
ORIGINAL PLAN	
NOTE BOOK	
DATE	
NO.	


STATE OF HAWAII  
DEPARTMENT OF TRANSPORTATION  
HIGHWAYS DIVISION

**IRRIGATION DETAILS**


NIMITZ HIGHWAY  
MEDIAN EROSION CONTROL  
Sumner Street to Richards Street  
Project No. 92A-02-09M

Scale: NTS Date: April, 2009

SHEET No. 2 OF 3 SHEETS

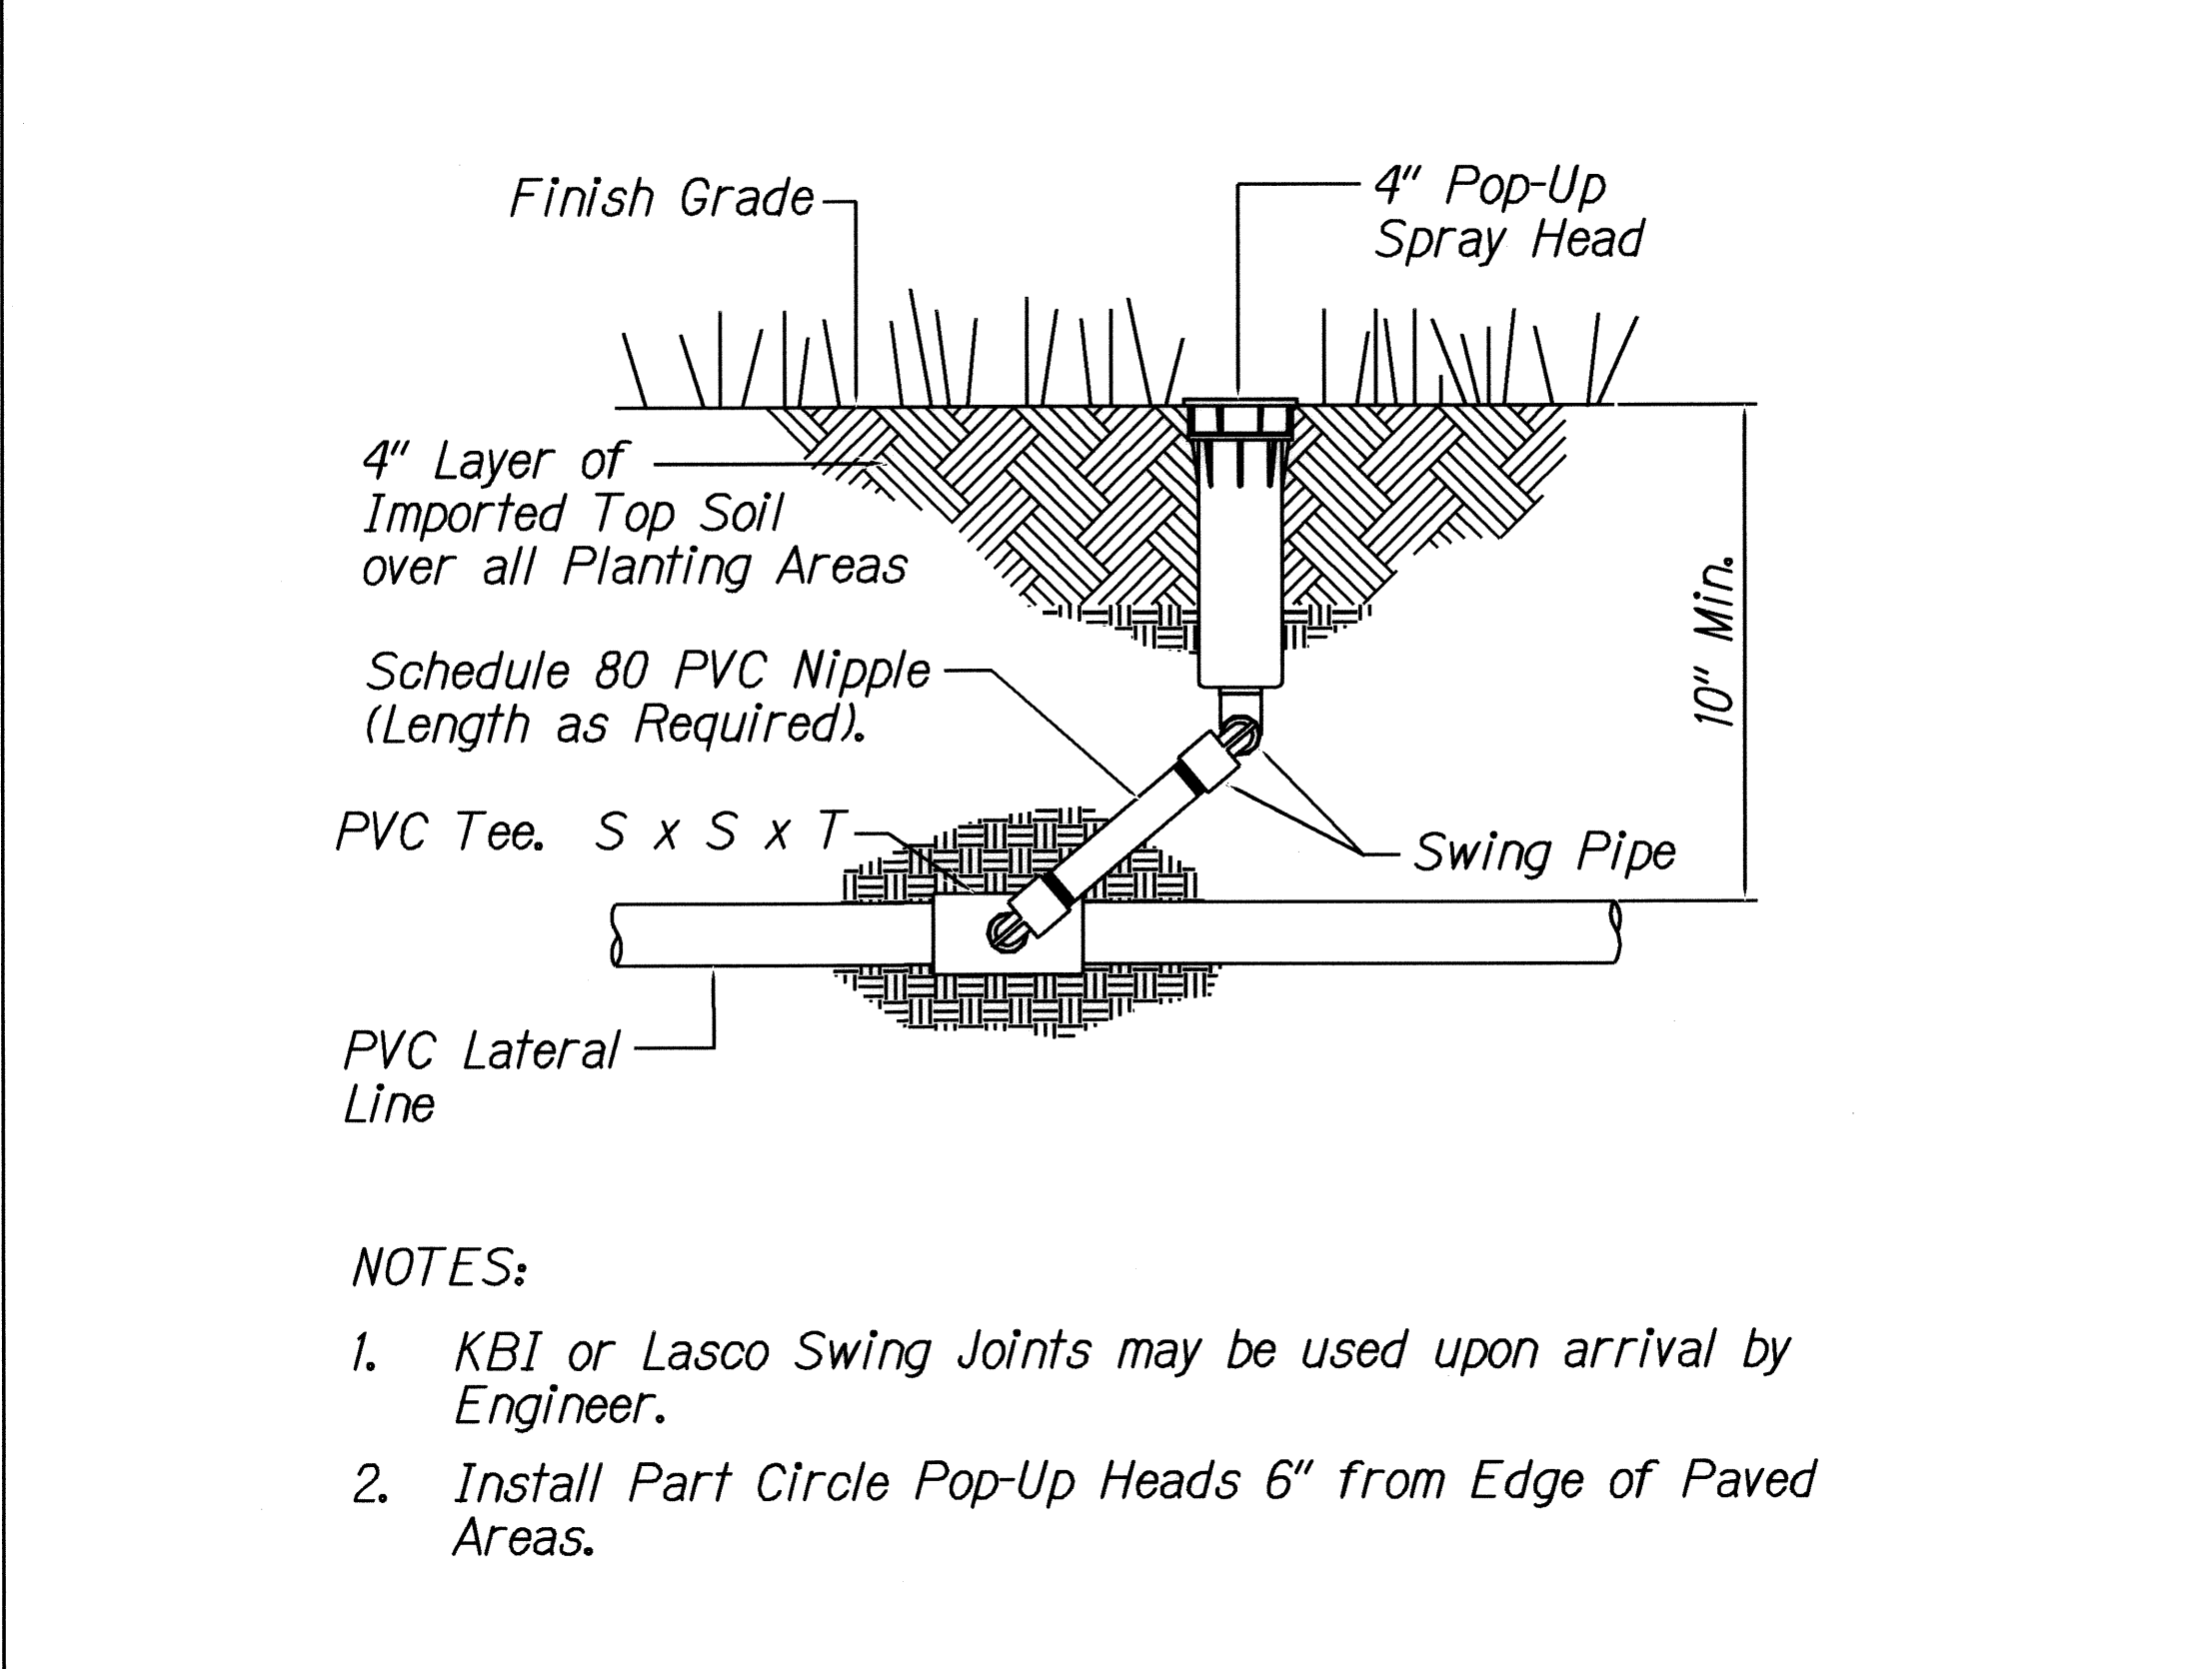

**E** **LAWN SPRAY POP-UP SPRINKLER DETAIL** **N.T.S.**

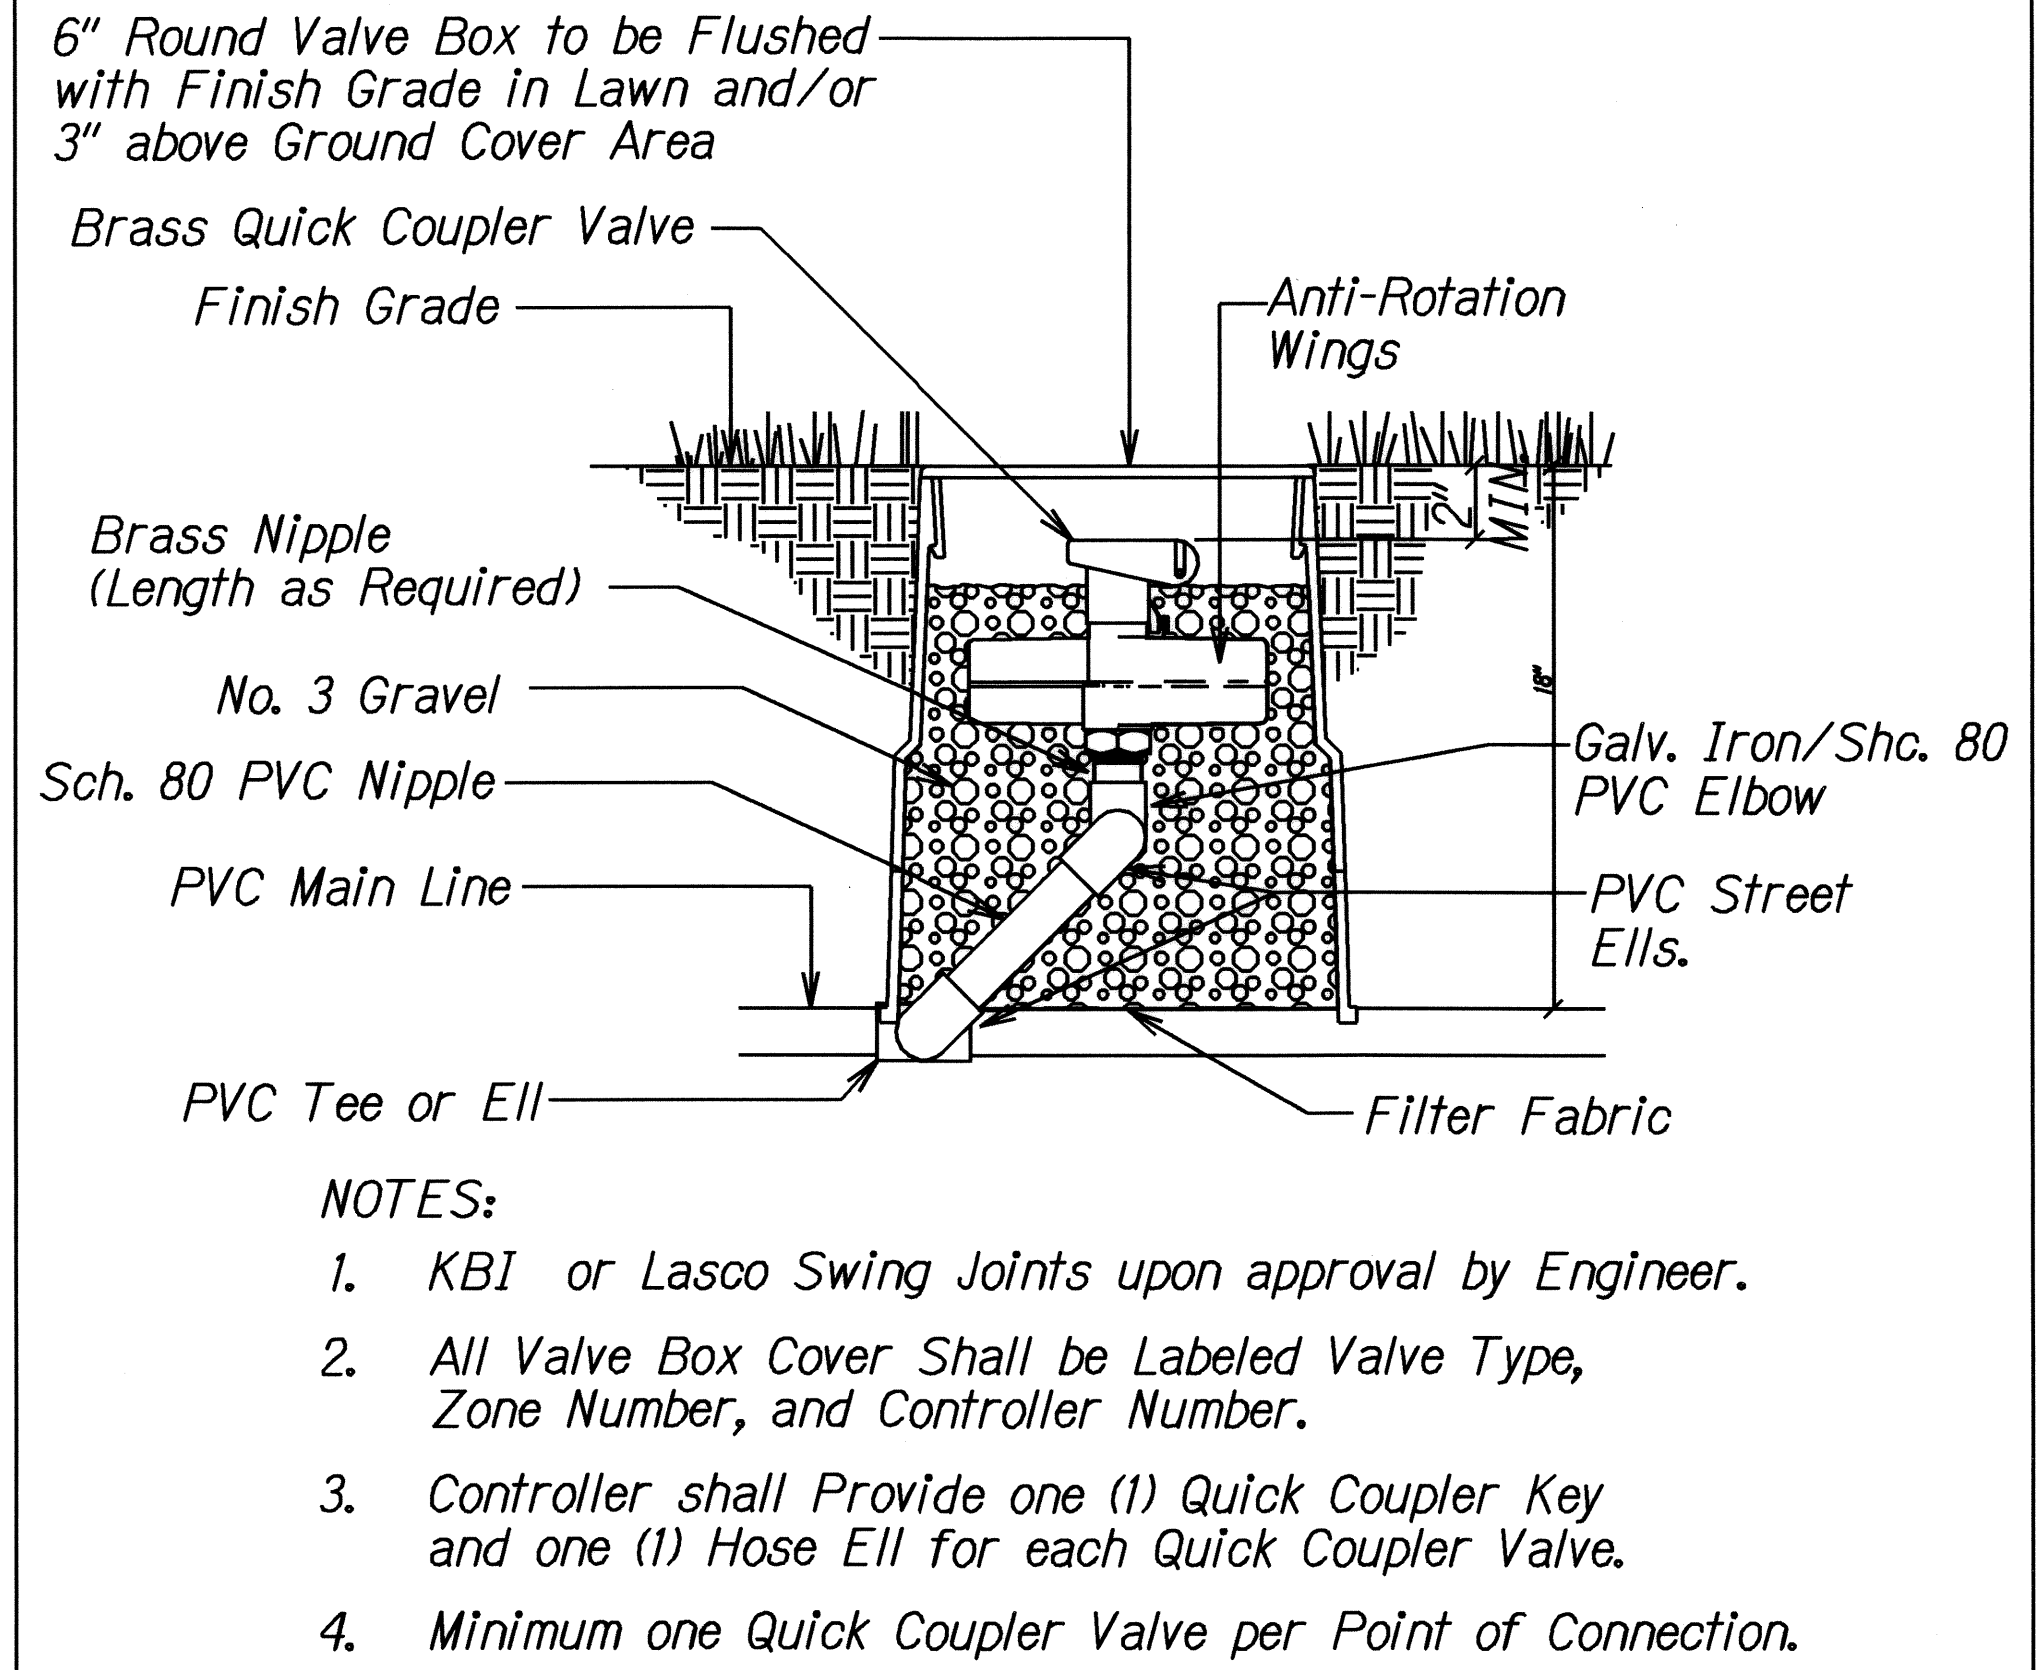


**F** **QUICK COUPLER VALVE DETAIL** **N.T.S.**


THRUST BLOCK BEARING AREA (SQ. FT.)				
PIPE SIZE	1 1/4" - 2 1/2"	3"	4"	6"
Tees/Ells	1.00	1.00	1.25	3.2
90 Bends	1.00	1.25	2.00	4.5
45 Bends	1.00	1.00	1.00	2.4

NOTES:

1. Install Thrust Block at all Machine Bends, Tees or Ells as shown below. Thrust Blocks shall be minimum of (1) cu. ft. Redi-Mix Concrete or 2500 PSI 28 Day Concrete.
2. Set all Thrust Blocks against Undisturbed Soil.

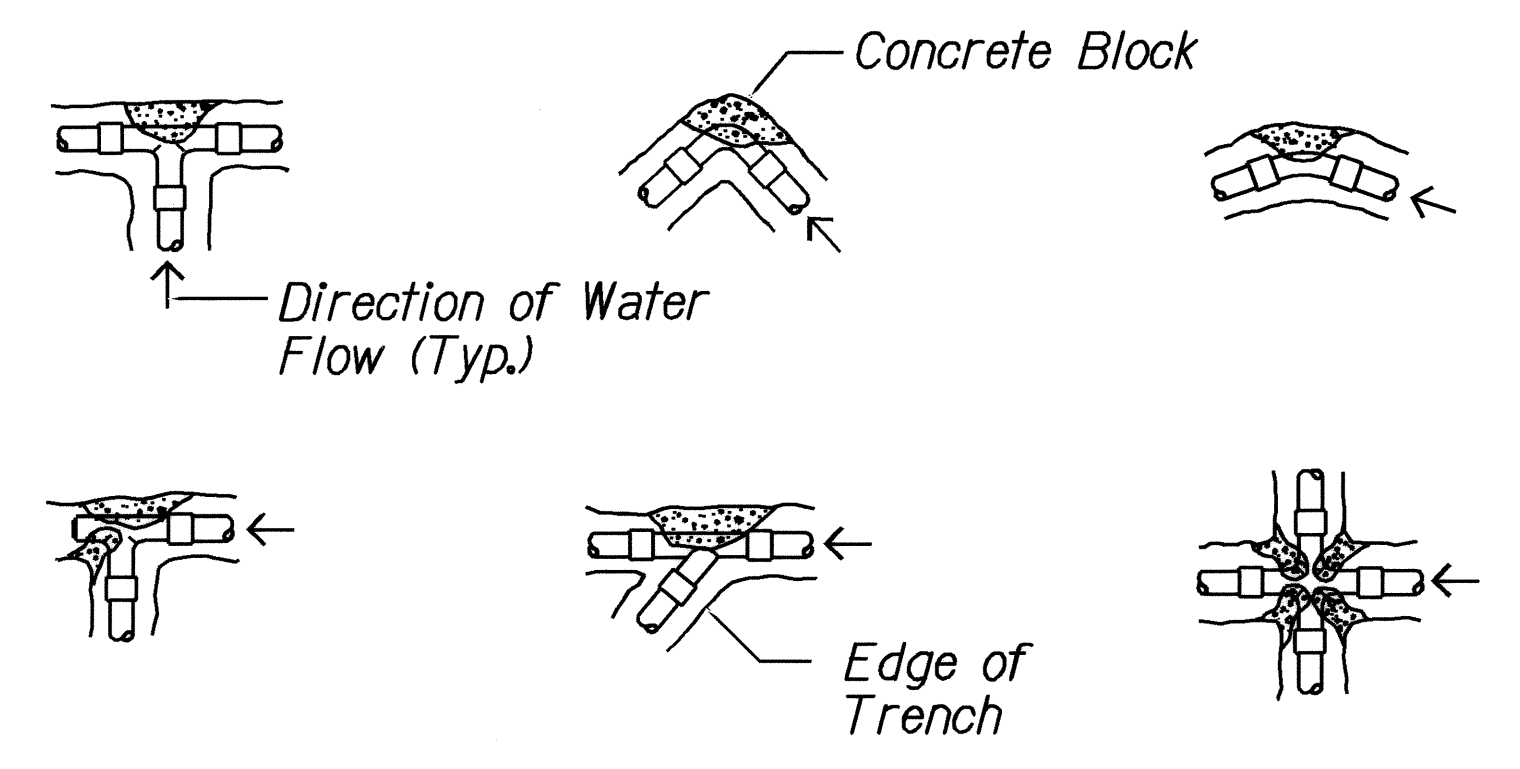

**G** **THRUST BLOCK DETAIL** **N.T.S.**

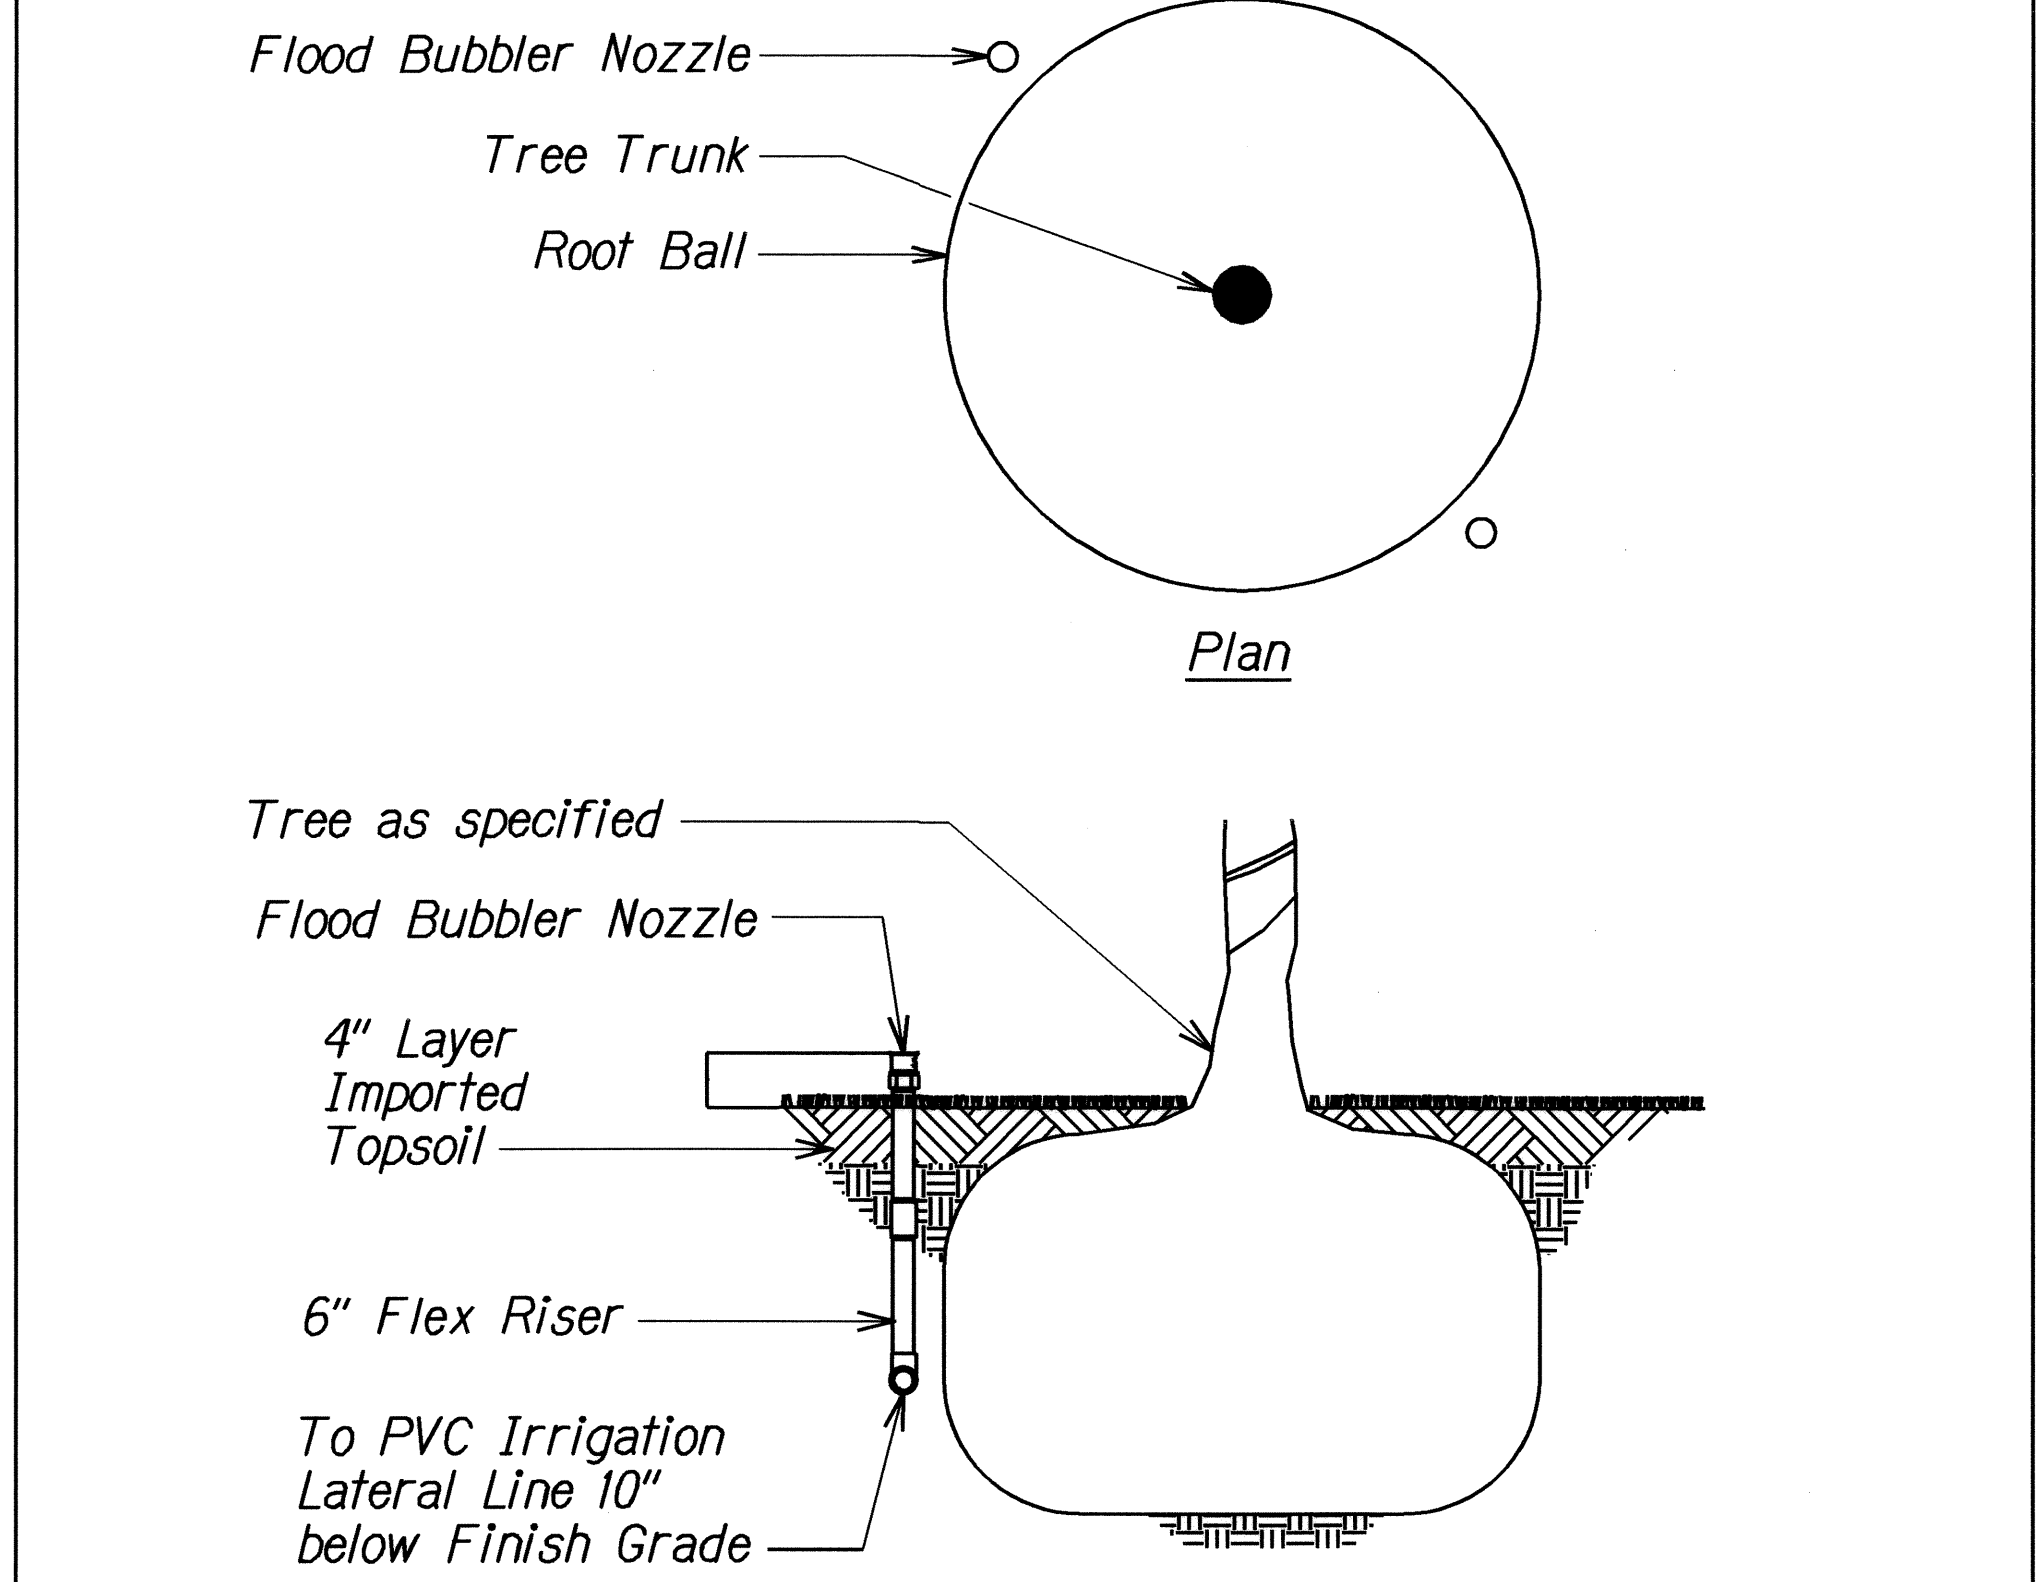

**H** **TREE BUBBLER DETAIL** **N.T.S.**

SURVEY PLOTTED BY \_\_\_\_\_ DATE \_\_\_\_\_  
 DRAWN BY \_\_\_\_\_  
 CHECKED BY \_\_\_\_\_  
 ORIGINAL PLAN FOR \_\_\_\_\_  
 NOTE BOOK \_\_\_\_\_  
 QUANTITIES BY \_\_\_\_\_  
 CHECKED BY \_\_\_\_\_

STATE OF HAWAII  
 DEPARTMENT OF TRANSPORTATION  
 HIGHWAYS DIVISION  
**IRRIGATION DETAILS**  
 NIMITZ HIGHWAY  
 MEDIAN EROSION CONTROL  
 Sumner Street to Richards Street  
 Project No. 92A-02-09M  
 Scale: NTS Date: April, 2009  
 SHEET No. 3 OF 3 SHEETS