


FED. ROAD DIST. NO.	STATE	PROJ. NO.	FISCAL YEAR	SHEET NO.	TOTAL SHEETS
HAWAII	HAW.	92A-02-09M	2009	8	18

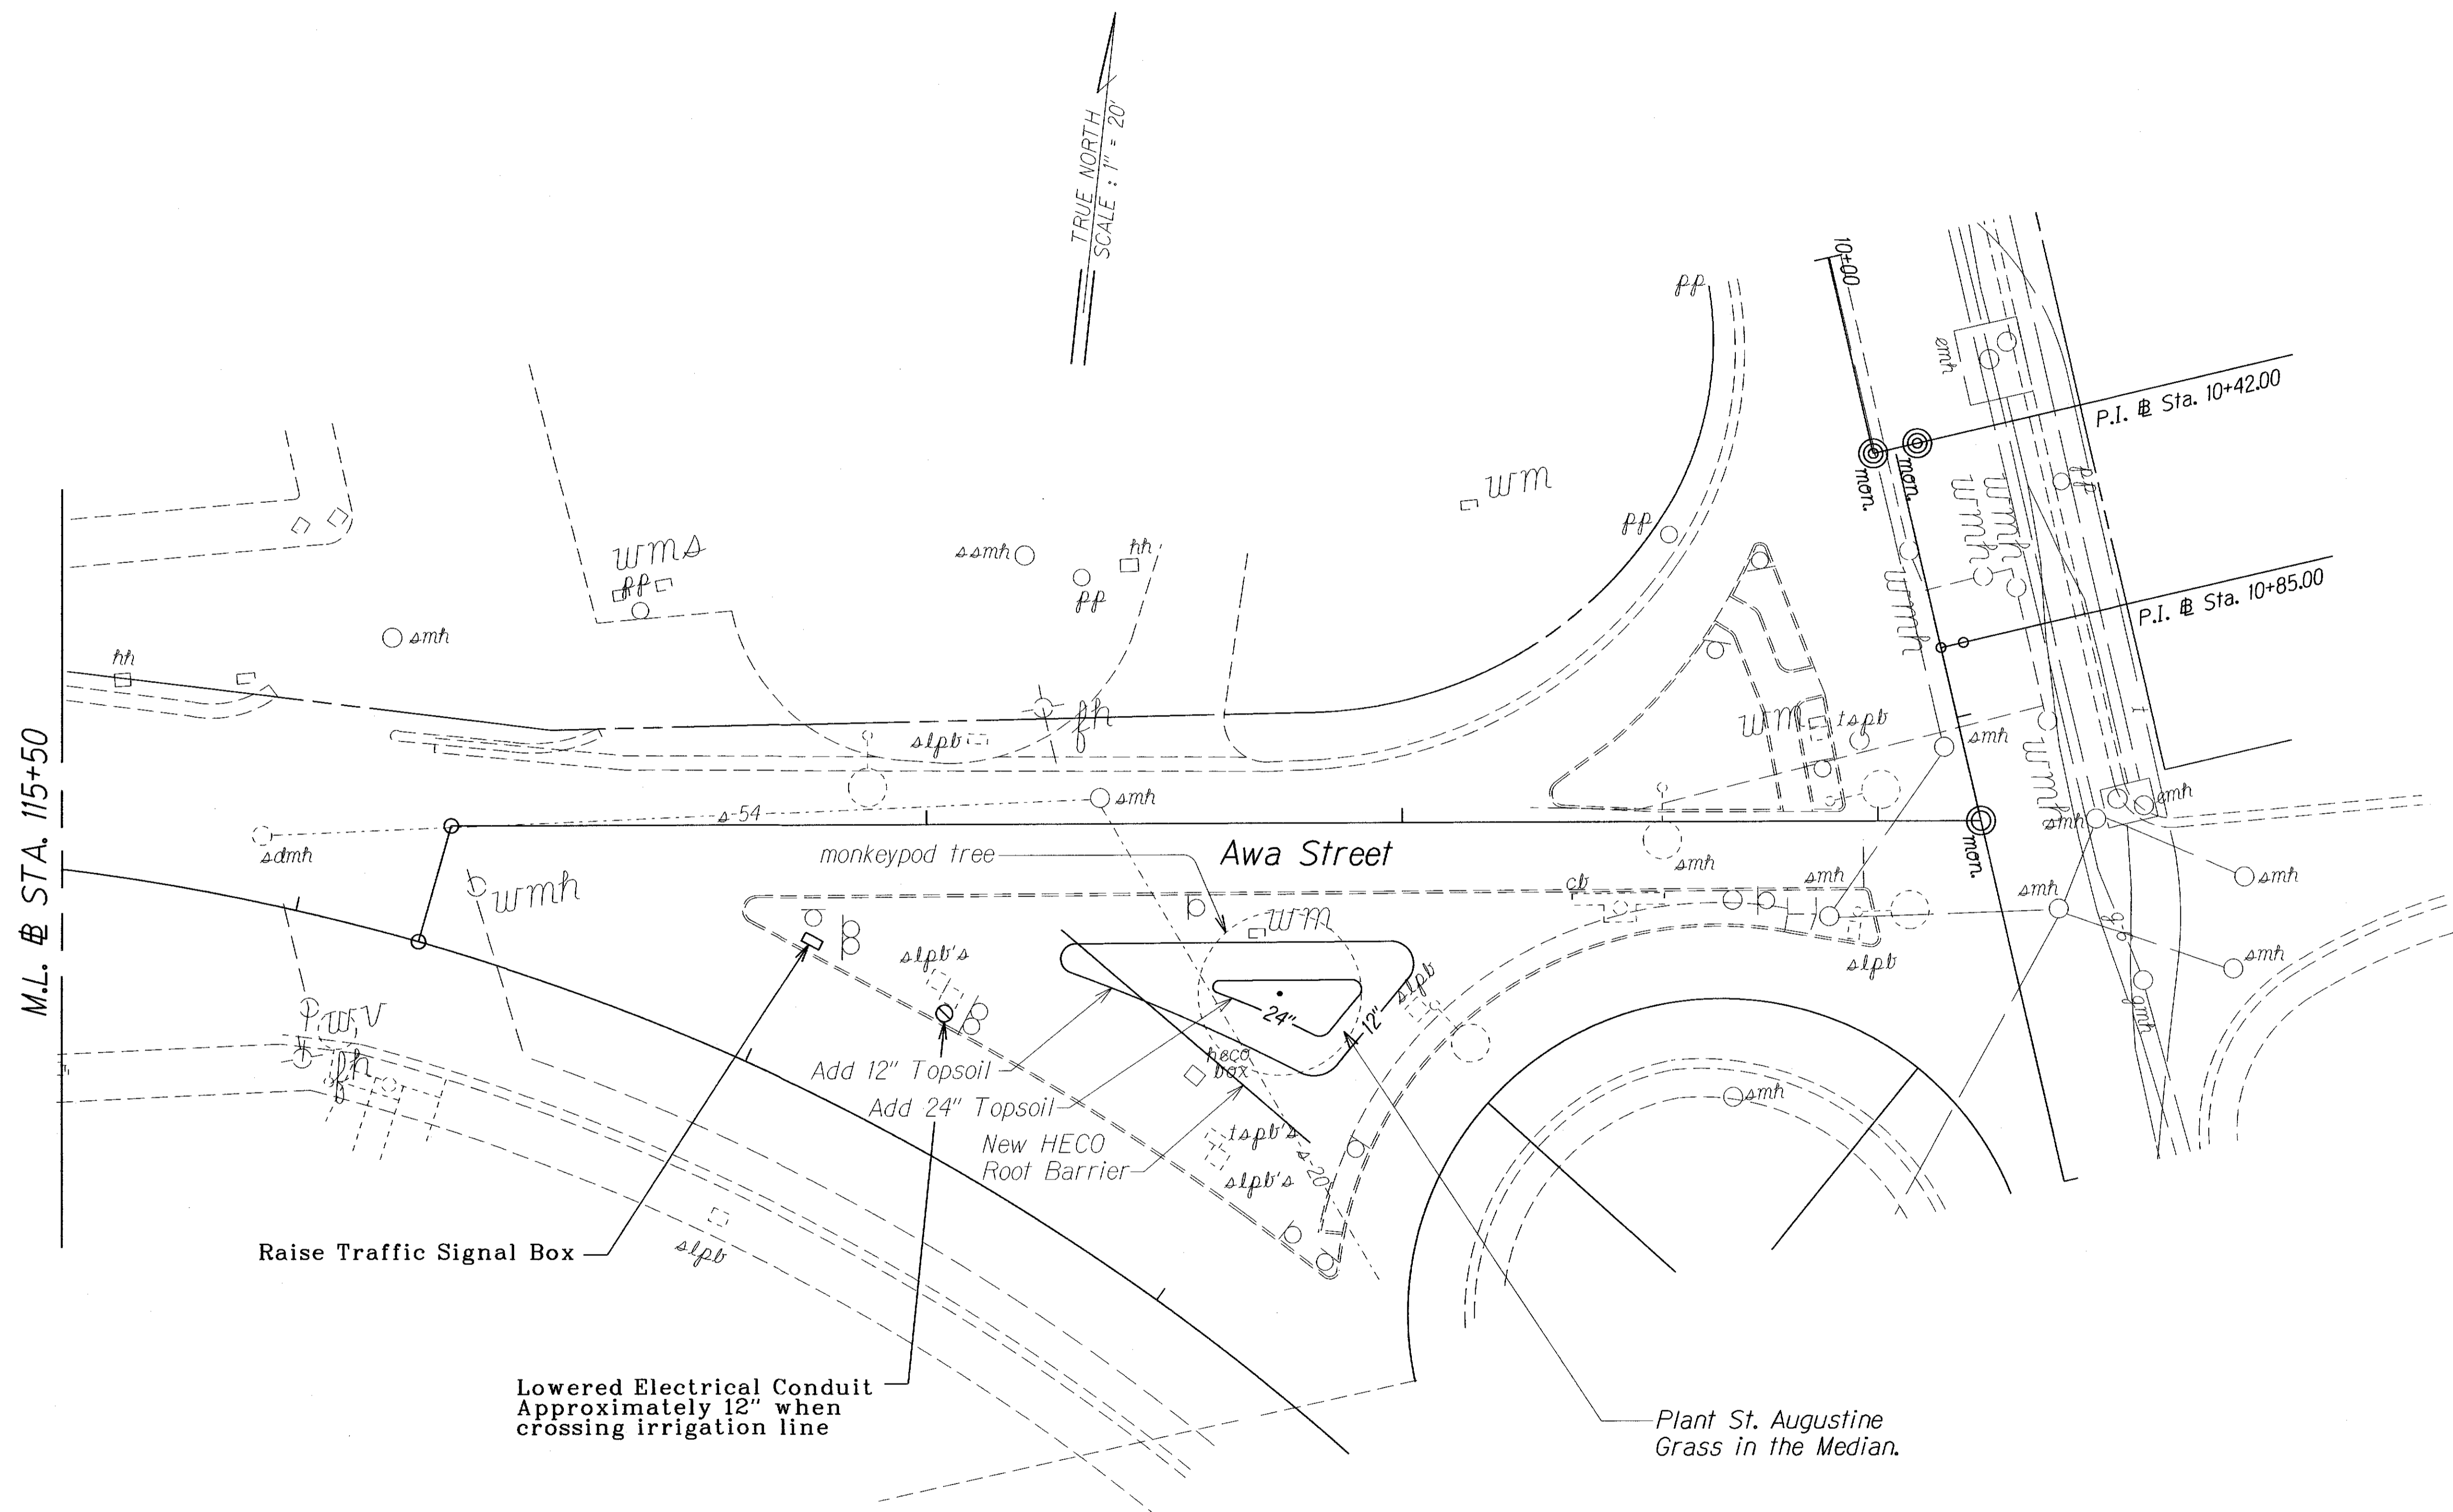

ORIGINAL PLAN	DATE
SURVEY PLOTTED BY	
DRAWN BY	
REGISTERED BY	
QUANTITIES BY	
CHECKED BY	

LEGEND FOR AS-BUILT POSTINGS	
	Squiggly line for as-built deletion
	Double line for as-built deletion
Roadway	Text for as-built posting

STATE OF HAWAII
DEPARTMENT OF TRANSPORTATION
HIGHWAYS DIVISION


LANDSCAPE PLANS

NIMITZ HIGHWAY
MEDIAN EROSION CONTROL
Summer Street to Richards Street
Project No. 92A-02-09M
Scale: 1" = 20' Date: April, 2009

SHEET No. 1 OF 3 SHEETS

"AS-BUILT"

FED. ROAD DIST. NO.	STATE	PROJ. NO.	FISCAL YEAR	SHEET NO.	TOTAL SHEETS
HAWAII	HAW.	92A-02-09M	2009	9	18

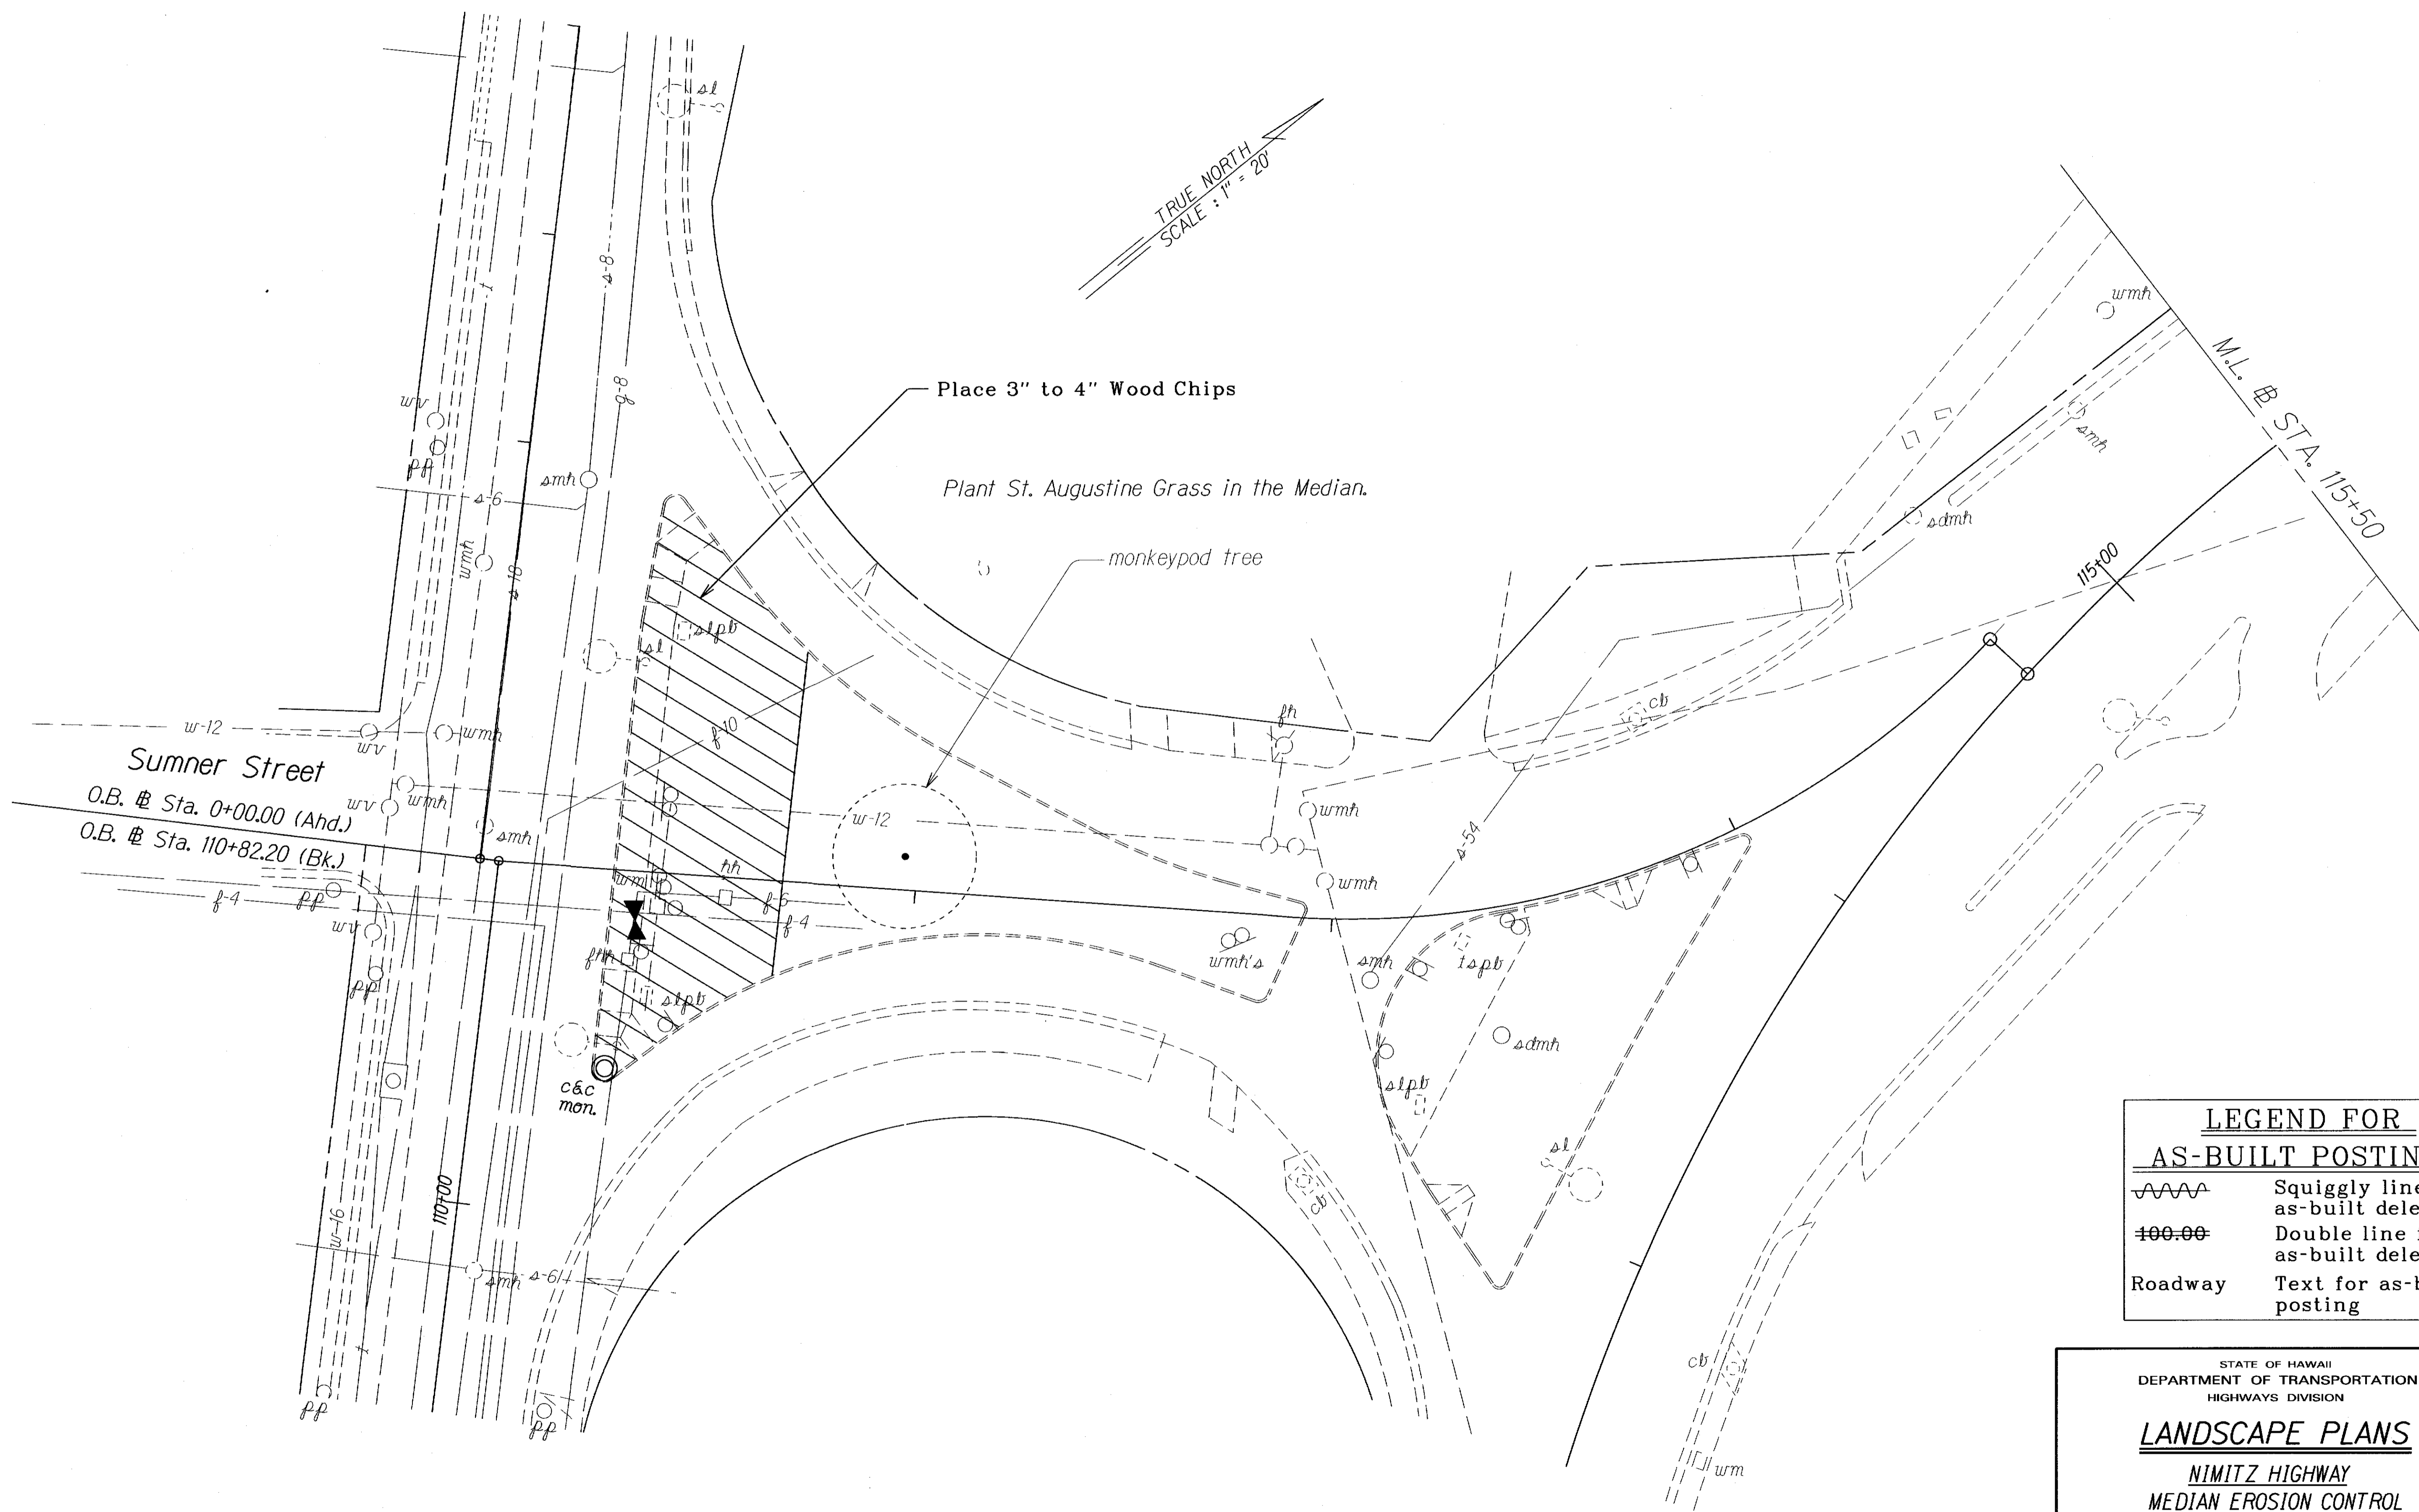

ORIGINAL PLAN	SURVEY PLOTTED BY	DATE
NOTE BOOK	DRAWN BY	
DESIGNED BY	QUANTITIES BY	
CHECKED BY		

LEGEND FOR AS-BUILT POSTINGS	
	Squiggly line for as-built deletion
	Double line for as-built deletion
Roadway	Text for as-built posting

STATE OF HAWAII
DEPARTMENT OF TRANSPORTATION
HIGHWAYS DIVISION


LANDSCAPE PLANS

NIMITZ HIGHWAY
MEDIAN EROSION CONTROL
Sumner Street to Richards Street
Project No. 92A-02-09M

Scale: 1" = 20' Date: April, 2009

"AS-BUILT"

FED. ROAD DIST. NO.	STATE	PROJ. NO.	FISCAL YEAR	SHEET NO.	TOTAL SHEETS
HAWAII	HAW.	92A-02-09M	2009	10	18

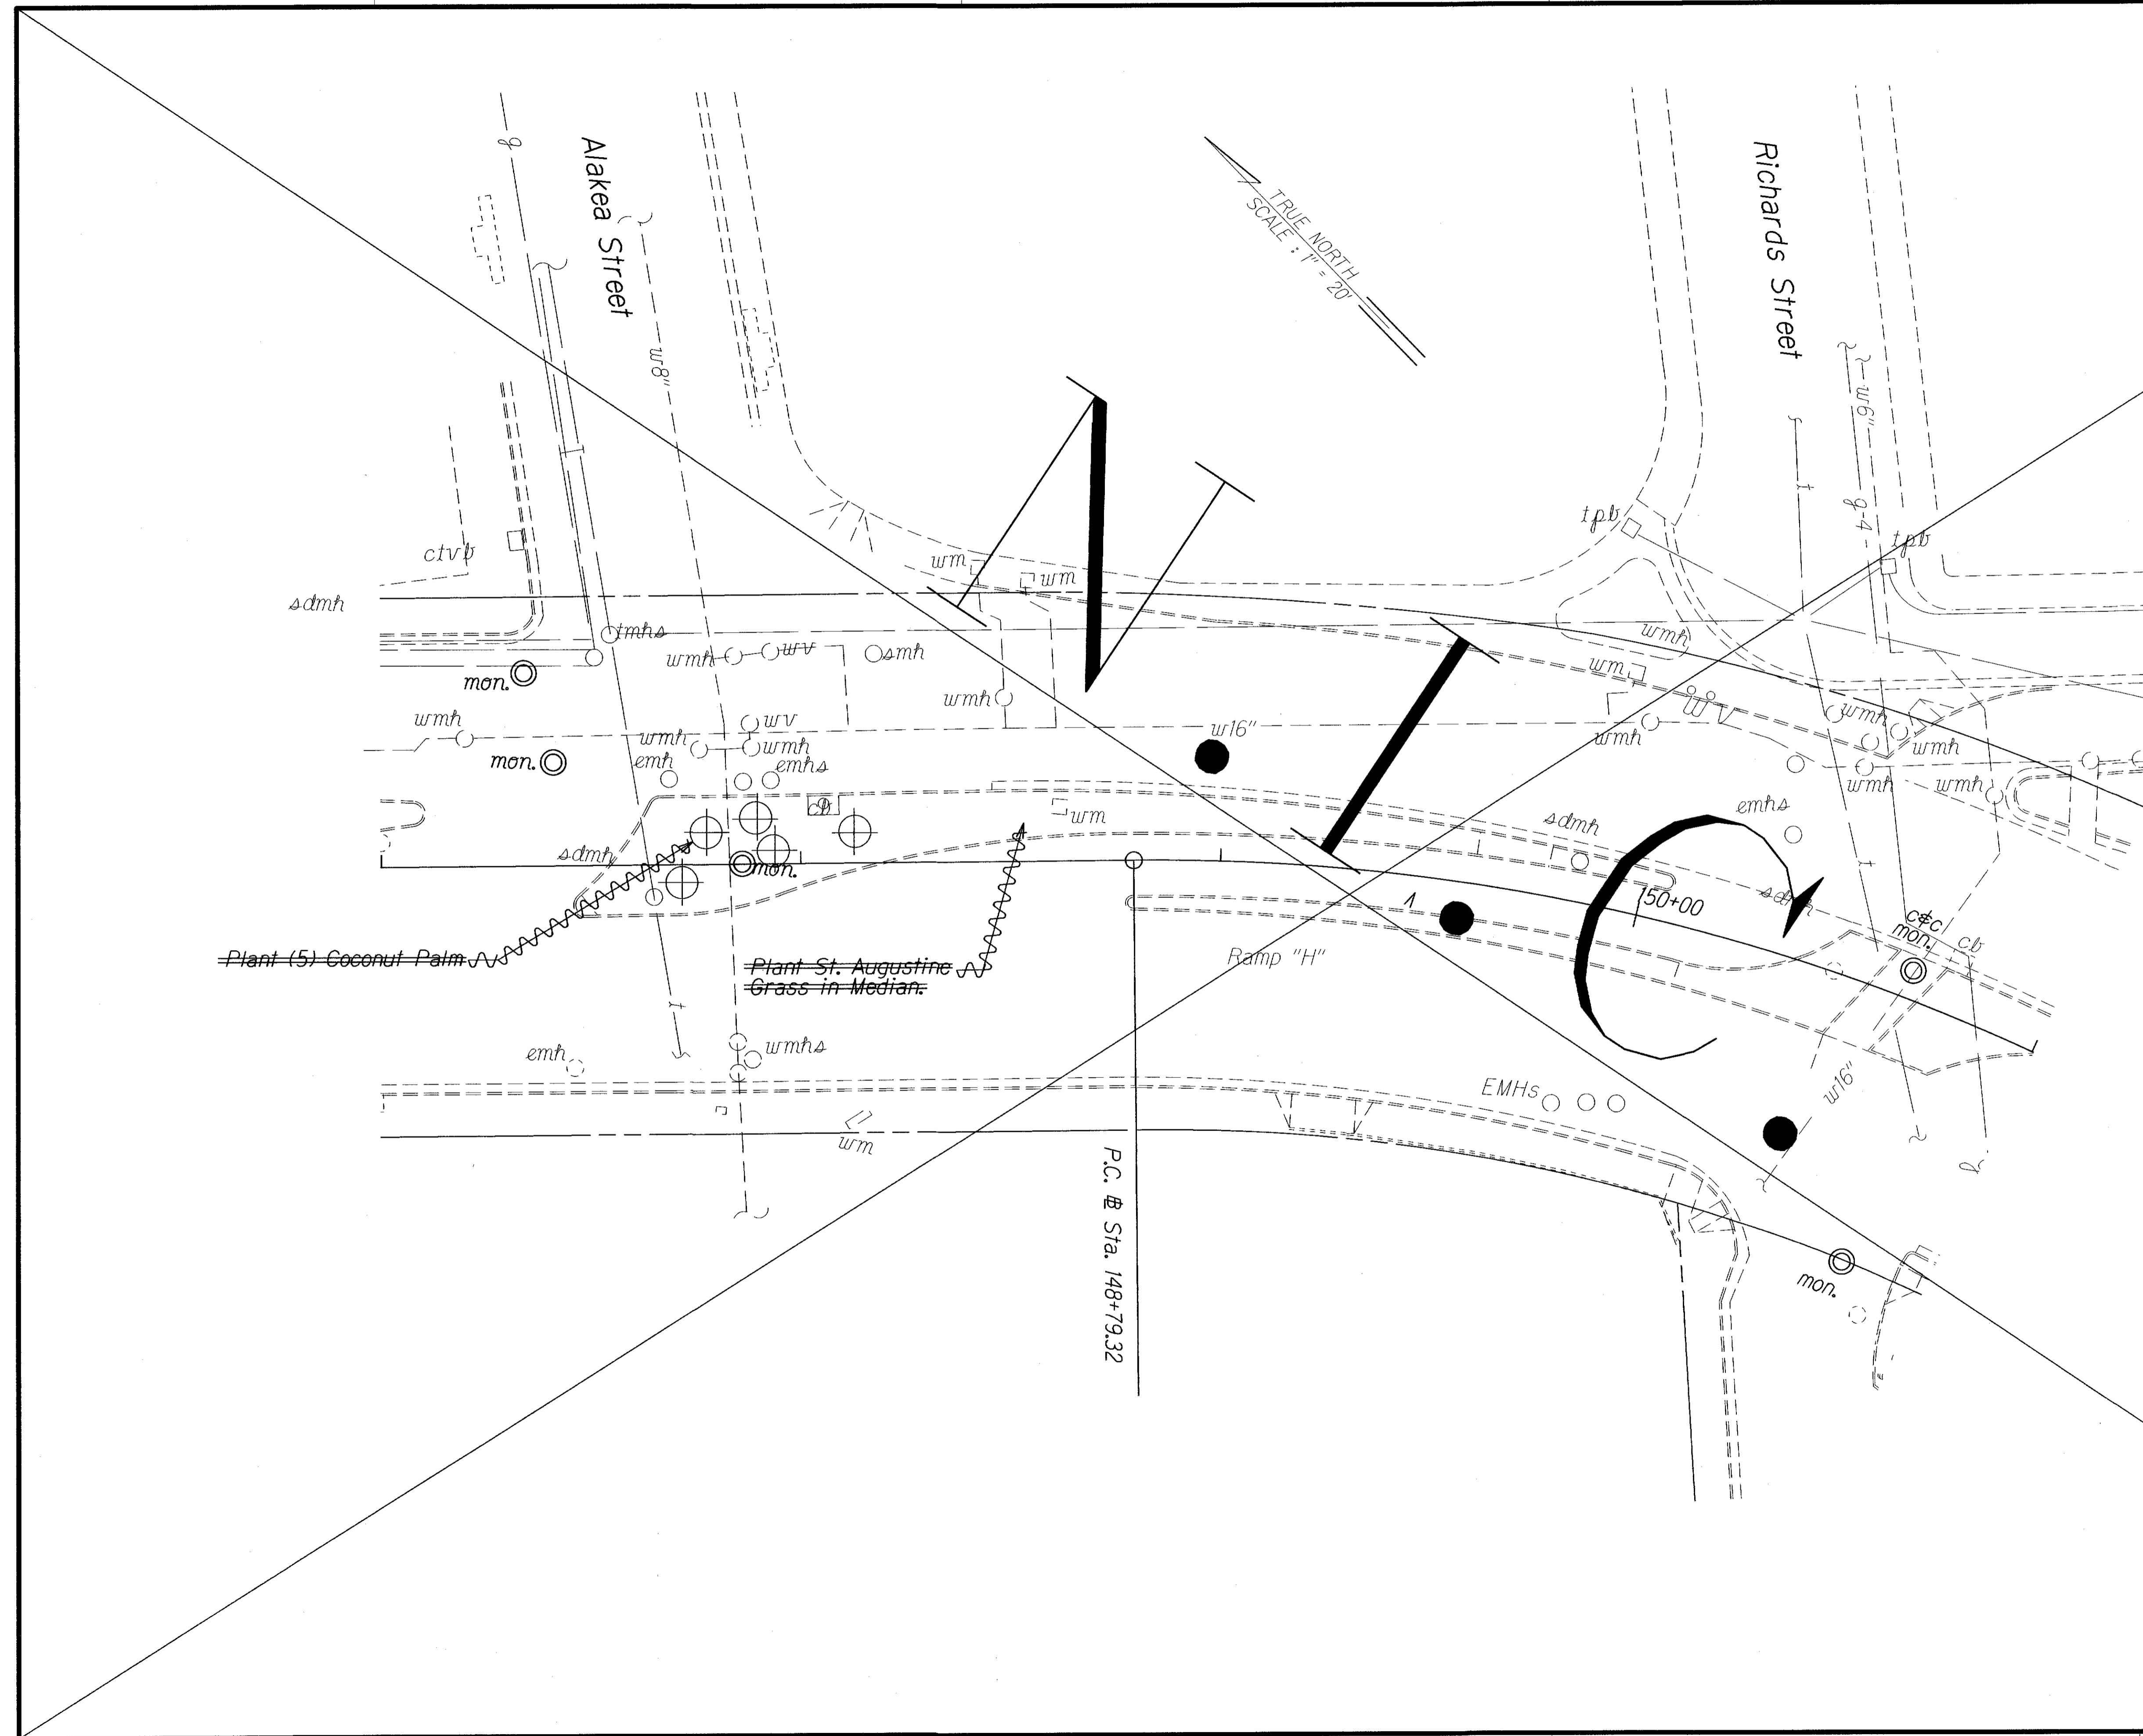

SURVEY PLOTTED BY	DATE
DRAWN BY	
DESIGNED BY	
QUANTITIES BY	
CHECKED BY	
ORIGINAL PLAN	
NOTE BOOK	
ANIMDP03	
N.	

LEGEND FOR AS-BUILT POSTINGS	
	Squiggly line for as-built deletion
	Double line for as-built deletion
Roadway	Text for as-built posting

STATE OF HAWAII
DEPARTMENT OF TRANSPORTATION
HIGHWAYS DIVISION

LANDSCAPE PLANS
NIMITZ HIGHWAY
MEDIAN EROSION CONTROL
Sumner Street to Richards Street
Project No. 92A-02-09M

Scale: 1" = 20' Date: April, 2009