
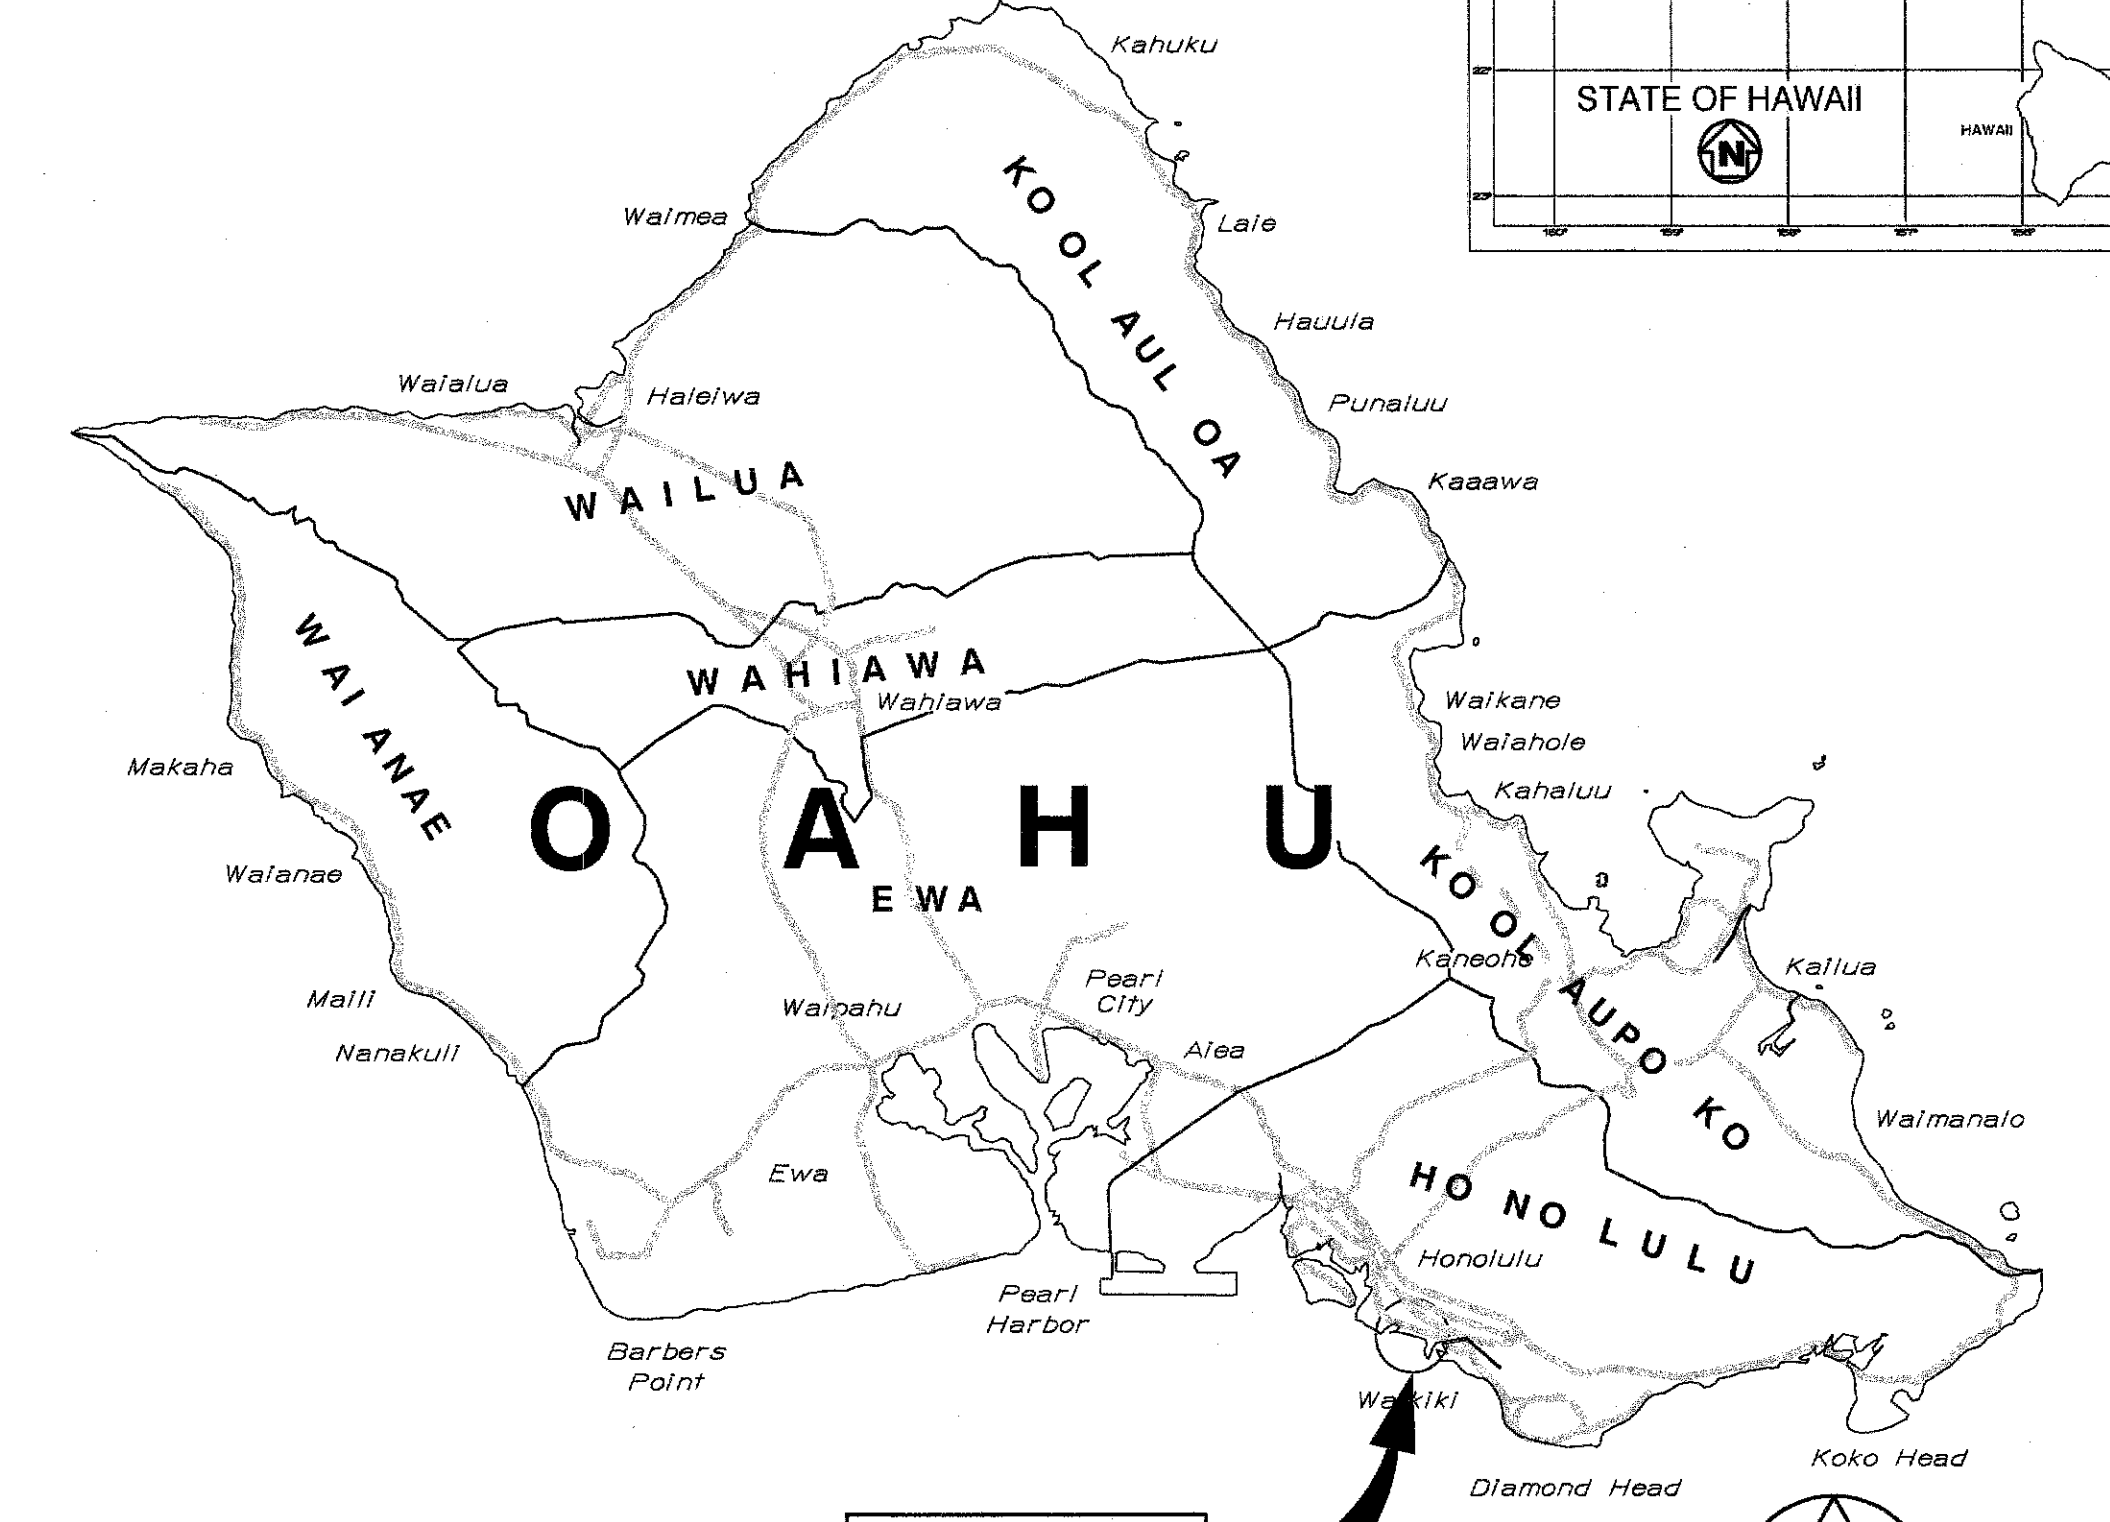



| INDEX TO DRAWINGS |  |
|-------------------|--|
| SHEET NO.         | DESCRIPTION  |
| 1                 | TITLE SHEET  |
| 2                 | STANDARD PLANS SUMMARY                                   |
| 3                 | GENERAL NOTES  |
| 4                 | STRUCTURAL NOTES   |
| 5 - 6             | WATER POLLUTION & EROSION CONTROL NOTES                  |
| 7                 | U.S. FISH & WILDLIFE SERVICE NOTES                       |
| 8 - 9             | HONOLULU SLIP COVER PLANS                                |
| 10 - 12           | SLIP COVER #3 PLANS                                      |
| 13                | HONOLULU SLIP COVER SECTIONS & AC PAVEMENT REPAIR DETAIL |
| 14                | SLIP COVER #3 - SECTIONS                                 |
| 15 - 16           | REPAIR SCHEDULES   |
| 17 - 21           | REPAIR DETAILS   |
| 22 - 27           | TRAFFIC CONTROL  |
| 28 - 44           | REFERENCE DRAWINGS                                       |

STATE OF HAWAII  
DEPARTMENT OF TRANSPORTATION  
HIGHWAYS DIVISION  
HONOLULU, HAWAII  
**"AS-BUILT"**  
PLANS FOR  
**NIMITZ HIGHWAY**  
REHABILITATION OF HONOLULU SLIP COVER AND SLIP COVER #3  
**PROJECT NO. 92A-01-10M**  
DISTRICT OF HONOLULU  
ISLAND OF OAHU

| FED. ROAD DIST. NO. | STATE | PROJ. NO.  | FISCAL YEAR | SHEET NO. | TOTAL SHEETS |
|---------------------|-------|------------|-------------|-----------|--------------|
| HAWAII              | HAW.  | 92A-01-10M | 2010        | 1         | 44           |

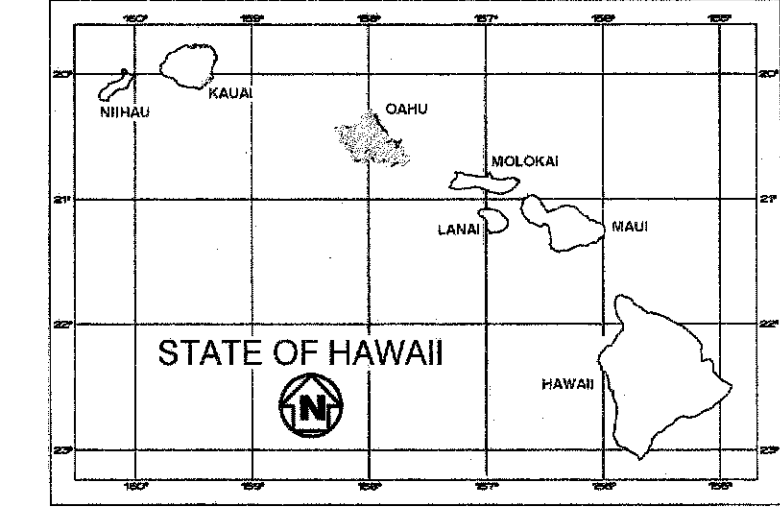


PROJECT LOCATION

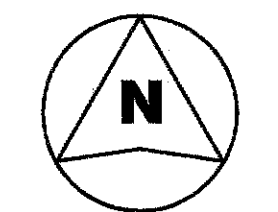

SCALE IN MILES  
0 4 8

MILE POST 5.78 AND MILE POST 6.16

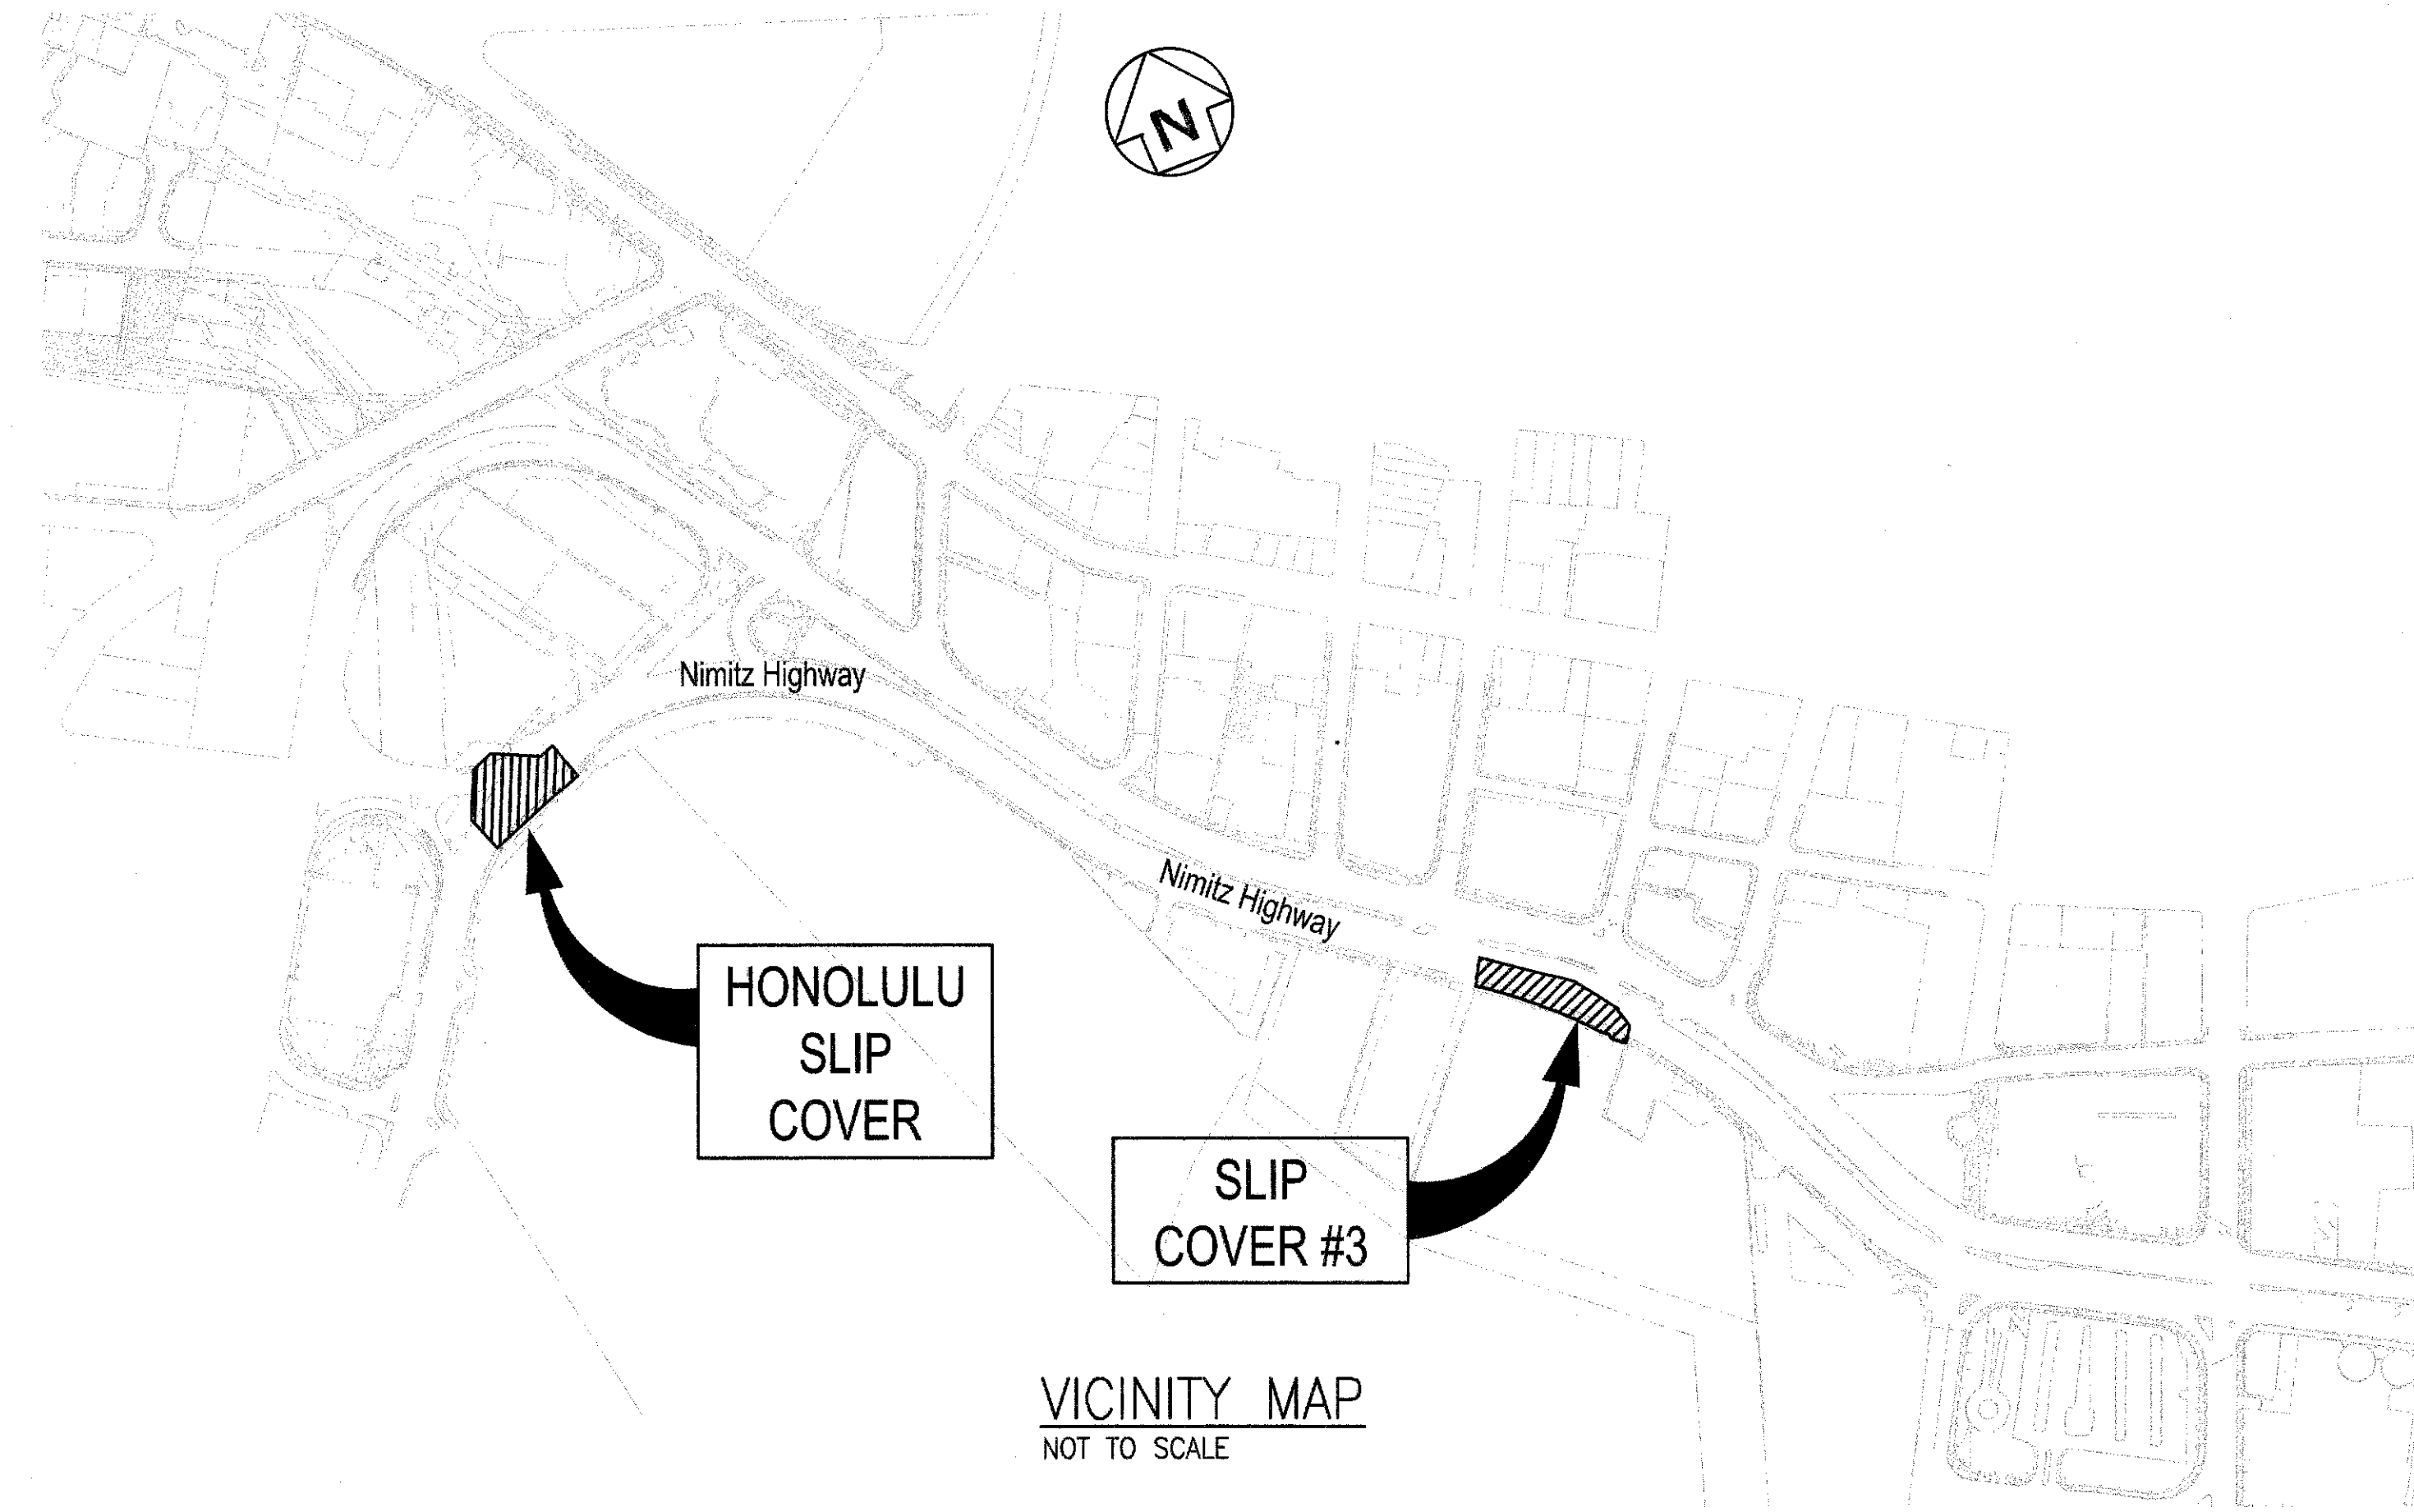

HONOLULU  
SLIP  
COVER

SLIP  
COVER #3

VICINITY MAP  
NOT TO SCALE

CHANGES MADE DURING CONSTRUCTION HAVE BEEN INCORPORATED ON THESE PLANS EXCEPT CHANGES IN THE ORIGINAL THEORETICAL QUANTITIES. FOR ACTUAL QUANTITIES, REFER TO PROJECT LEDGER AND/OR COMPUTATION BOOK.

*Merrin Juchfield* 10-3-2014  
RESIDENT ENGINEER DATE

DEPARTMENT OF TRANSPORTATION  
STATE OF HAWAII  
APPROVED:  
*J. H. Ho* 5/1/10  
DIR. OF TRANSPORTATION DATE

NAGAMINE OKAWA ENGINEERS, INC. DESIGNED BY  
HWY-DD MANAGED BY  
692-7570 PHONE  
MAY 2010 DATE